


HILL VIEW ACRES SUBDIVISION 3RD AMENDMENT

ALL OF LOT 6, HILL VIEW ACRES SUBDIVISION
PART OF THE SOUTHEAST QUARTER OF SECTION 22, T.5N., R.1W., S.L.B.&M., U.S. SURVEY
WEBER COUNTY, UTAH
APRIL, 2105

FOUND 2001 WEBER COUNTY BRASS CAP MONUMENT AT CENTER 1/4 OF SECTION 22


1,366.52'
BASIS OF BEARINGS S0°20'49"E 2672.98' (2673.12' RECORD)

FOUND 1966 WEBER COUNTY BRASS CAP MONUMENT AT SOUTH 1/4 OF SECTION 22

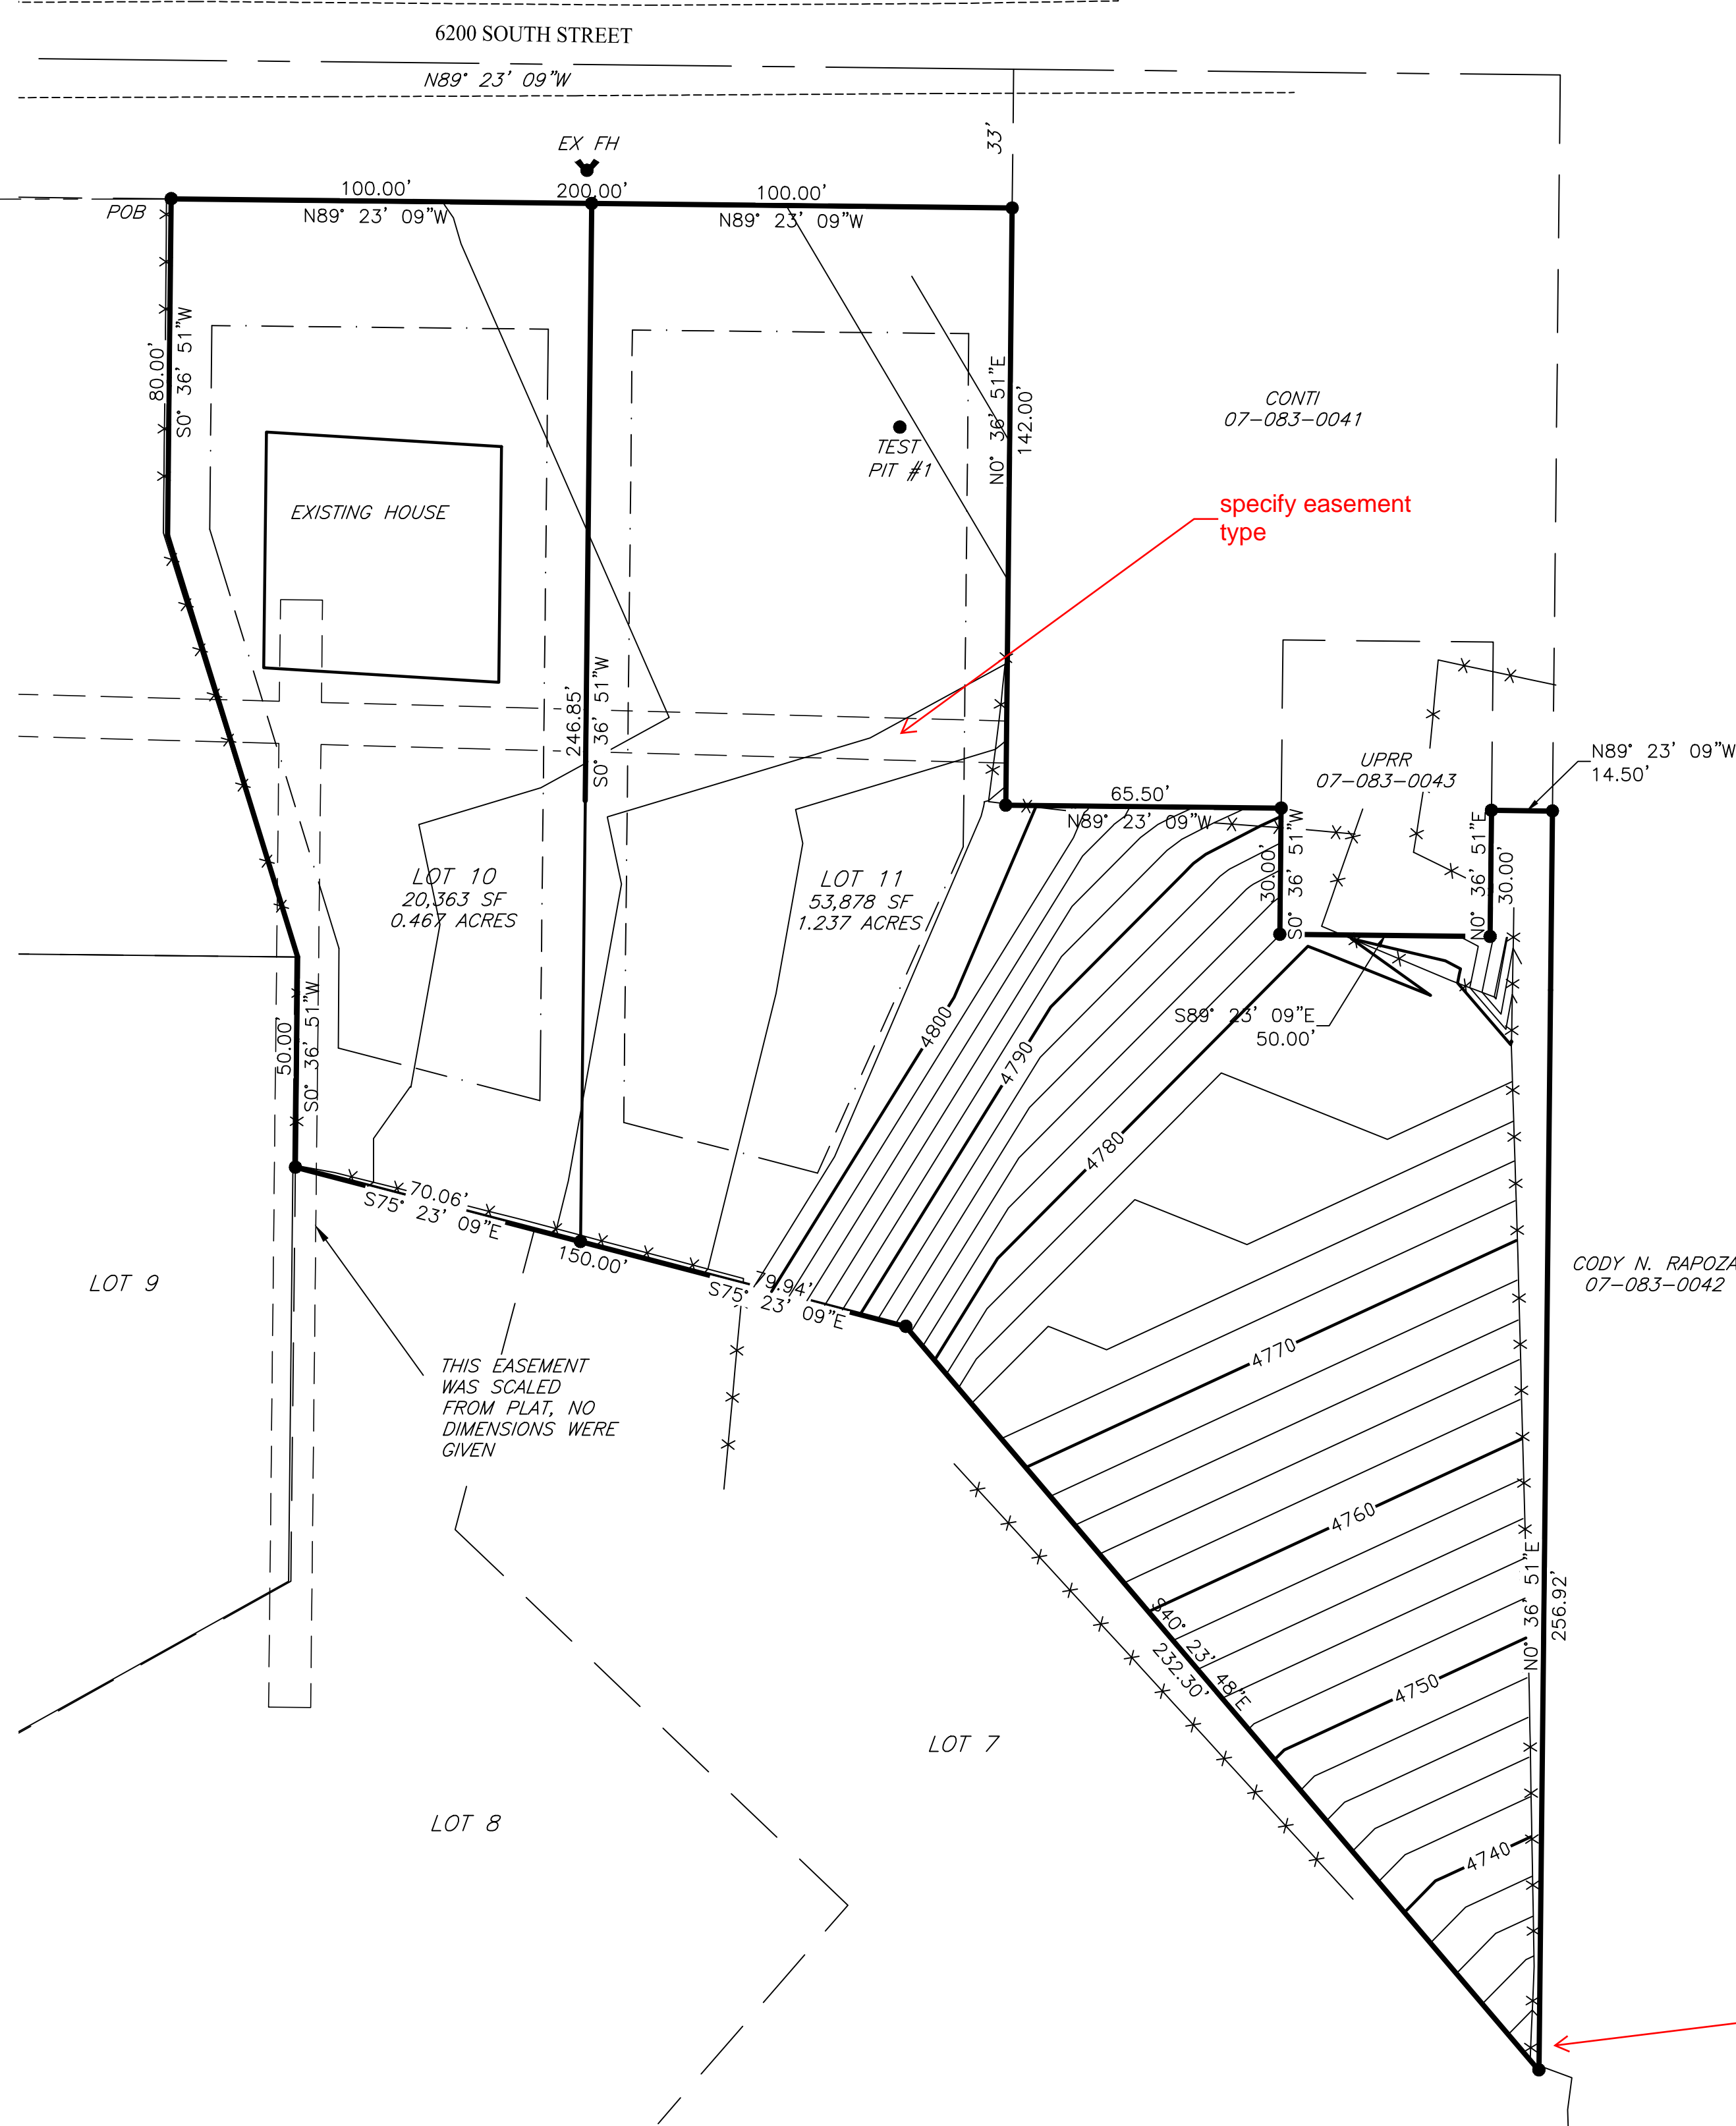

LEGEND

- = SECTION CORNER
- = SET 5/8" X 24" REBAR AND PLASTIC CAP STAMPED "REEVE & ASSOCIATES"
- = FOUND RIGHT OF WAY MONUMENT
- = BOUNDARY LINE
- = LOT LINE
- = ADJOINING PROPERTY
- = EASEMENTS
- = SECTION TIE LINE
- = ROAD CENTERLINE
- = EXISTING FENCELINE
- = EXISTING PAVEMENT
- = BUILDING SETBACK

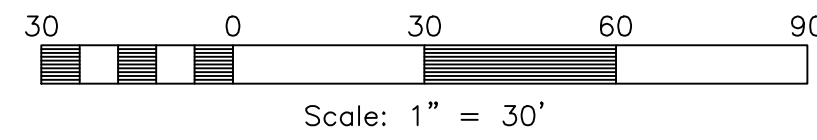

BASIS OF BEARINGS

THE BASIS OF BEARINGS FOR THIS PLAT IS THE SECTION LINE BETWEEN THE CENTER QUARTER CORNER AND THE SOUTH QUARTER OF SECTION 22, T.5N., R.1W., S.L.B.&M., U.S. SURVEY, SHOWN HEREON AS S00°20'49"E, UTAH STATE PLANE NORTH AS PER WEBER COUNTY SURVEY.

NARRATIVE

THE PURPOSE OF THIS SURVEY WAS TO AMEND LOT 6 OF HILL VIEW ACRES SUBDIVISION AND CREATE TWO LOTS THEREFROM. THE ORIGINAL PLAT DOESN'T MATCH EXISTING OCCUPATION OR MONUMENTATION. THERE HAVE BEEN SEVERAL SURVEYS AND AMENDED PLATS IN THE SUBDIVISION ALREADY. THE BOUNDARY FOLLOWS LARGELY THE BOUNDARY DETERMINED BY HILL VIEW ACRES SUBDIVISION 2ND AMENDMENT. NO EVIDENCE OF SAID SUBDIVISION WAS FOUND INSIDE THE SUBDIVISION, BUT USING THEIR TIES FROM EXISTING MONUMENTS, THIS BOUNDARY FITS OCCUPATION AND OTHER FOUND BOUNDARY EVIDENCE REASONABLE WELL. THERE IS A RAILROAD PARCEL (PARCEL ID # 07-083-0043) WHICH WAS NOT SHOWN ON THE ORIGINAL HILL VIEW ACRES SUBDIVISION PLAT. THE OCCUPATION RECORD CALLS FOR THE RAILROAD PARCEL DID NOT MATCH, BASED ON CONVERSATIONS WITH MR. AND MRS. CHASE, WHO ARE LONG TIME RESIDENTS, IT IS BELIEVED THAT THE INTENDED LOCATION IS WHAT IS SHOWN HEREON, WHICH MATCHES OWNERSHIP PLATS AND THE LOCATION GIVEN FOR SAID PARCEL IN THE DEED FOR PARCEL #07-083-0041 (RECORDED AS ENTRY #2574590). ALL CORNERS WERE SET WITH 24" X 3/8" REBAR WITH PLASTIC CAP STAMPED "REEVE AND ASSOCIATES."

BOUNDARY DESCRIPTION

ALL OF LOT 6, HILL VIEW ACRES SUBDIVISION, ACCORDING TO THE OFFICIAL PLAT RECORDED IN THE OFFICE OF THE WEBER COUNTY RECORDER, LESS AND EXCEPTING THEREFROM THAT PORTION THEREOF CONVEYED TO THE UNION PACIFIC RAILROAD COMPANY BY DEED RECORDED IN BOOK 82 OF DEEDS, PAGE 232.

DEVELOPER:
KAREN & DALE CHASE
1575 EAST 6200 SOUTH
OGDEN UT, 84405

SURVEYOR'S CERTIFICATE

I, TREVOR J. HATCH, DO HEREBY CERTIFY THAT I AM A REGISTERED PROFESSIONAL LAND SURVEYOR IN THE STATE OF UTAH IN ACCORDANCE WITH TITLE 58, CHAPTER 22, PROFESSIONAL ENGINEERS AND LAND SURVEYORS ACT; AND THAT I HAVE COMPLETED A SURVEY OF THE PROPERTY DESCRIBED ON THIS PLAT IN ACCORDANCE WITH SECTION 17-23-17 AND HAVE VERIFIED ALL MEASUREMENTS, AND HAVE PLACED MONUMENTS AS REPRESENTED ON THIS PLAT, AND THAT THIS PLAT OF HILL VIEW ACRES SUBDIVISION 3RD AMENDMENT IN WEBER COUNTY, UTAH, HAS BEEN DRAWN CORRECTLY TO THE DESIGNATED SCALE AND IS A TRUE AND CORRECT REPRESENTATION OF THE HEREIN DESCRIBED LANDS INCLUDED IN SAID SUBDIVISION, BASED UPON DATA COMPILED FROM RECORDS IN THE WEBER COUNTY RECORDER'S OFFICE AND FROM SAID SURVEY MADE BY ME ON THE GROUND. I FURTHER CERTIFY THAT THE REQUIREMENTS OF ALL APPLICABLE STATUTES AND ORDINANCES OF WEBER COUNTY CONCERNING ZONING REQUIREMENTS REGARDING LOT MEASUREMENTS HAVE BEEN COMPLIED WITH.

SIGNED THIS _____ DAY OF _____, 20____.

9031945
UTAH LICENSE NUMBER TREVOR J. HATCH

OWNERS DEDICATION AND CERTIFICATION

WE THE UNDERSIGNED OWNERS OF THE HEREIN DESCRIBED TRACT OF LAND, DO HEREBY SET APART AND SUBDIVIDE THE SAME INTO LOTS AND STREETS (PRIVATE STREETS, PRIVATE RIGHTS-OF-WAY) AS SHOWN ON THE PLAT AND NAME SAID TRACT HILL VIEW ACRES 3RD AMENDMENT, AND DO HEREBY DEDICATE TO PUBLIC USE ALL THOSE PARTS OR PORTIONS OF SAID TRACT OF LAND DESIGNATED AS STREETS, THE SAME TO BE USED AS PUBLIC THOROUGHFARES AND ALSO TO GRANT AND DEDICATE A PERPETUAL RIGHT AND EASEMENT OVER, UPON AND UNDER THE LANDS DESIGNATED HEREON AS PUBLIC UTILITY, STORM WATER DETENTION PONDS DRAINAGE EASEMENTS AND CANAL MAINTENANCE EASEMENT, THE SAME TO BE USED FOR THE INSTALLATION MAINTENANCE AND OPERATION OF PUBLIC UTILITY SERVICE LINE, STORM DRAINAGE FACILITIES, IRRIGATION CANALS OR FOR THE PERPETUAL PRESERVATION OF WATER CHANNELS IN THEIR NATURAL STATE WHICHEVER IS APPLICABLE AS MAY BE AUTHORIZED BY THE GOVERNING AUTHORITY, WITH NO BUILDINGS OR STRUCTURES BEING ERRECTED WITHIN SUCH EASEMENTS.

SIGNED THIS _____ DAY OF _____, 20____.

DALE CHASE _____
KAREN CHASE _____

ACKNOWLEDGMENT

STATE OF UTAH)ss.
COUNTY OF _____)

ON THE _____ DAY OF _____, 20____, PERSONALLY APPEARED BEFORE ME, THE UNDERSIGNED NOTARY PUBLIC, _____ (AND) _____ SIGNER(S) OF THE ABOVE OWNER'S DEDICATION AND CERTIFICATION, WHO BEING BY ME DULY SWORN, DID ACKNOWLEDGE TO ME _____ SIGNED IT FREELY, VOLUNTARILY, AND FOR THE PURPOSES THEREIN MENTIONED.

COMMISSION EXPIRES _____ NOTARY PUBLIC _____

ACKNOWLEDGMENT

STATE OF UTAH)ss.
COUNTY OF _____)

ON THE _____ DAY OF _____, 20____, PERSONALLY APPEARED BEFORE ME, THE UNDERSIGNED NOTARY PUBLIC, _____ (AND) _____ BEING BY ME DULY SWORN, ACKNOWLEDGED TO ME THEY ARE _____ OF SAID CORPORATION AND THAT THEY SIGNED THE ABOVE OWNER'S DEDICATION AND CERTIFICATION FREELY, VOLUNTARILY, AND IN BEHALF OF SAID CORPORATION FOR THE PURPOSES THEREIN MENTIONED.

COMMISSION EXPIRES _____ NOTARY PUBLIC _____

Project Info.

Surveyor: T. HATCH
Designer: _____
Begin Date: 4-3-15
Name: HILL VIEW ACRES 3RD AMENDMENT
Number: 6536
Revision: _____
Scale: 1"=30'
Checked: _____

4155 S. HARRISON BLVD., SUITE 310, OGDEN, UTAH 84403
TEL: (801) 621-3100 FAX: (801) 621-2666 www.reeve-assoc.com

WEBER COUNTY PLANNING COMMISSION APPROVAL

THIS IS TO CERTIFY THAT THIS SUBDIVISION PLAT WAS DULY APPROVED BY THE WEBER COUNTY PLANNING COMMISSION. SIGNED THIS _____ DAY OF _____, 20____.

CHAIRMAN, WEBER COUNTY PLANNING COMMISSION _____

WEBER COUNTY ENGINEER

I HEREBY CERTIFY THAT THE REQUIRED PUBLIC IMPROVEMENT STANDARDS AND DRAWINGS FOR THIS SUBDIVISION CONFORM WITH THE COUNTY STANDARDS AND THE AMOUNT OF THE FINANCIAL GUARANTEE IS SUFFICIENT FOR THE INSTALLATION OF THESE IMPROVEMENTS.

WEBER COUNTY ENGINEER _____

WEBER COUNTY COMMISSION ACCEPTANCE

THIS IS TO CERTIFY THAT THIS SUBDIVISION PLAT, THE DEDICATION OF STREETS AND OTHER PUBLIC WAYS AND FINANCIAL GUARANTEE OF PUBLIC IMPROVEMENTS ASSOCIATED WITH THIS SUBDIVISION, THEREON ARE HEREBY APPROVED AND ACCEPTED BY THE COMMISSIONERS OF WEBER COUNTY, UTAH. SIGNED THIS _____ DAY OF _____, 20____.

CHAIRMAN, WEBER COUNTY COMMISSION _____

ATTEST _____

WEBER COUNTY SURVEYOR

I HEREBY CERTIFY THAT THE WEBER COUNTY SURVEYOR'S OFFICE HAS REVIEWED THIS PLAT FOR MATHEMATICAL CORRECTNESS, SECTION CORNER DATA, AND FOR HARMONY WITH LINES AND MONUMENTS ON RECORD IN COUNTY OFFICES. THE APPROVAL OF THIS PLAT BY THE WEBER COUNTY SURVEYOR DOES NOT RELIEVE THE LICENSED LAND SURVEYOR WHO EXECUTED THIS PLAT FROM THE RESPONSIBILITIES AND/OR LIABILITIES ASSOCIATED THEREWITH. SIGNED THIS _____ DAY OF _____, 20____.

WEBER COUNTY SURVEYOR _____

WEBER COUNTY ATTORNEY

I HAVE EXAMINED THE FINANCIAL GUARANTEE AND OTHER DOCUMENTS ASSOCIATED WITH THIS SUBDIVISION PLAT, AND IN MY OPINION THEY CONFORM WITH THE COUNTY ORDINANCE APPLICABLE THERETO AND NOW IN FORCE AND AFFECT. SIGNED THIS _____ DAY OF _____, 20____.

WEBER COUNTY ATTORNEY _____

WEBER-MORGAN HEALTH DEPARTMENT

I HEREBY CERTIFY THAT THE SOILS, PERCOLATION RATES, AND SITE CONDITIONS FOR THIS SUBDIVISION HAVE BEEN INVESTIGATED BY THIS OFFICE AND ARE APPROVED FOR ON-SITE WASTEWATER DISPOSAL SYSTEMS. SIGNED THIS _____ DAY OF _____, 20____.

WEBER-MORGAN HEALTH DEPARTMENT _____

Weber County Recorder

Entry No. _____ Fee Paid _____
Filed For Record _____
And Recorded, _____
At _____ In Book _____
Of The Official Records, Page _____
Recorded For: _____
Weber County Recorder _____
Deputy: _____