

Scale: 1"=100'

6700 WEST ST.

NorthWest Corner Section 13, Township 6 North, Range 3 West, S.L.B.&M. Weber County Surveyor's Brass Cap Mon., Dated 1963. Monument in Good Condition and at Road Surface.

2640.82' (2643.354' Deed 1/4 Corner) 2685.81' Prior Survey of 1992

North Quarter Corner Section 13, Township 6 North, Range 3 West, S.L.B.&M. Per Butters Survey 1992.

(158 Rods/2607') Calc'd./Meas'd 2563.6'

**Strahan Place Subdivision #2**  
PART OF NW QUARTER OF SECTION 13,  
TOWNSHIP 6 NORTH, RANGE 3 WEST, S.L.B.&M.  
WEBER COUNTY, UTAH  
2 Aug, 2015

**OWNERS DEDICATION**

WE, THE UNDERSIGNED OWNERS OF THE HEREIN DESCRIBED TRACT OF LAND, DO HEREBY SET APART AND SUBDIVIDE THE SAME INTO LOTS AND STREETS AS SHOWN ON THE PLAT AND NAME SAID TRACT Strahan Place Subdivision #2, AND DO HEREBY DEDICATE, GRANT AND CONVEY TO PUBLIC USE ALL THOSE PARTS OR PORTIONS OF SAID TRACT OF LAND DESIGNATED AS STREETS THE SAME TO BE USED AS PUBLIC THOROUGHFARES FOREVER. AND ALSO DO HEREBY GRANT AND DEDICATE A PERPETUAL RIGHT AND EASEMENT OVER, UPON AND UNDER THE LANDS DESIGNATED ON THE PLAT AS PUBLIC UTILITY, STORM WATER DETENTION PONDS AND DRAINAGE EASEMENTS, THE SAME TO BE USED FOR THE INSTALLATION, MAINTENANCE AND OPERATION OF PUBLIC UTILITY SERVICE LINES, STORM DRAINAGE FACILITIES OR FOR THE PERPETUAL PRESERVATION OF WATER DRAINAGE CHANNELS IN THEIR NATURAL STATE WHICHEVER IS APPLICABLE AS MAY BE AUTHORIZED BY GOVERNMENTAL AUTHORITY WITH NO BUILDINGS OR STRUCTURES BEING ERRECTED WITHIN SUCH EASEMENTS.

SIGNED THIS \_\_\_\_\_ DAY OF \_\_\_\_\_, 20\_\_\_\_  
\_\_\_\_\_  
XXXXXXXXXXXXXXXXXXXX  
\_\_\_\_\_

**ACKNOWLEDGEMENT**

STATE OF UTAH }  
COUNTY OF WEBER }  
ON THIS \_\_\_\_\_ DAY OF \_\_\_\_\_, 20\_\_\_\_  
PERSONALLY APPEARED \_\_\_\_\_, AND  
SIGNER(S) OF THE ADJACENT INSTRUMENT, WHO DULY ACKNOWLEDGED TO ME THAT THEY EXECUTED THE SAME.  
NOTARY PUBLIC \_\_\_\_\_ RESIDING AT \_\_\_\_\_  
MY COMMISSION EXPIRES: \_\_\_\_\_

**WEBER COUNTY ATTORNEY**

I HAVE EXAMINED THE FINANCIAL GUARANTEE AND OTHER DOCUMENTS ASSOCIATED WITH THIS SUBDIVISION PLAT AND IN MY OPINION THEY CONFORM WITH THE COUNTY ORDINANCE APPLICABLE THERETO AND NOW IN FORCE AND AFFECT.  
SIGNED THIS \_\_\_\_\_ DAY OF \_\_\_\_\_, 20\_\_\_\_  
\_\_\_\_\_  
SIGNATURE \_\_\_\_\_

**WEBER COUNTY ENGINEER**

I HEREBY CERTIFY THAT THE REQUIRED PUBLIC IMPROVEMENT STANDARDS AND DRAWINGS FOR THIS SUBDIVISION CONFORM WITH COUNTY STANDARDS AND THE AMOUNT OF FINANCIAL GUARANTEE IS SUFFICIENT FOR THE INSTALLATION OF THESE IMPROVEMENTS.  
SIGNED THIS \_\_\_\_\_ DAY OF \_\_\_\_\_, 20\_\_\_\_  
\_\_\_\_\_  
SIGNATURE \_\_\_\_\_

**WEBER COUNTY COMMISSION ACCEPTANCE**

THIS IS TO CERTIFY THAT THIS SUBDIVISION PLAT, THE DEDICATION OF STREETS AND OTHER PUBLIC WAYS AND FINANCIAL GUARANTEE OF PUBLIC IMPROVEMENTS ASSOCIATED WITH THIS SUBDIVISION, THEREON ARE HEREBY APPROVED AND ACCEPTED BY THE COMMISSIONERS OF WEBER COUNTY, UTAH THIS \_\_\_\_\_ DAY OF \_\_\_\_\_, 20\_\_\_\_  
\_\_\_\_\_  
TITLE \_\_\_\_\_  
CHAIRMAN, WEBER COUNTY COMMISSION

**WEBER-MORGAN HEALTH DEPARTMENT**

I HEREBY CERTIFY THAT THE SOILS, PERCOLATION RATES AND SITE CONDITIONS FOR THIS SUBDIVISION HAVE BEEN INVESTIGATED BY THIS OFFICE AND ARE APPROVED FOR ON-SITE WASTEWATER DISPOSAL SYSTEMS.  
SIGNED THE \_\_\_\_\_ DAY OF \_\_\_\_\_, 20\_\_\_\_  
\_\_\_\_\_  
DIRECTOR, WEBER-MORGAN HEALTH DEPARTMENT

**WEBER COUNTY PLANNING COMMISSION APPROVAL**

THIS IS TO CERTIFY THAT THIS SUBDIVISION PLAT WAS DULY APPROVED BY THE WEBER COUNTY PLANNING COMMISSION ON THE \_\_\_\_\_ DAY OF \_\_\_\_\_, 20\_\_\_\_  
\_\_\_\_\_  
CHAIRMAN, WEBER COUNTY PLANNING COMMISSION

**WEBER COUNTY SURVEYOR**

I HEREBY CERTIFY THAT THE WEBER COUNTY SURVEYOR'S OFFICE HAS REVIEWED THIS PLAT FOR MATHEMATICAL CORRECTNESS, SECTION CORNER DATA, AND FOR HARMONY WITH LINES AND MONUMENTS ON RECORD IN COUNTY OFFICES. THE APPROVAL OF THIS PLAT BY THE WEBER COUNTY SURVEYOR DOES NOT RELIEVE THE LICENSED LAND SURVEYOR WHO EXECUTED THIS PLAT FROM THE RESPONSIBILITIES AND/OR LIABILITIES ASSOCIATED THEREWITH.  
SIGNED THIS \_\_\_\_\_ DAY OF \_\_\_\_\_, 20\_\_\_\_  
\_\_\_\_\_  
COUNTY SURVEYOR

**NOTE:**  
AGRICULTURE IS THE PREFERRED USE IN THE AGRICULTURAL ZONES. AGRICULTURAL OPERATIONS AS SPECIFIED IN THE ZONING ORDINANCE FOR A PARTICULAR ZONE ARE PERMITTED AT ANY TIME INCLUDING THE OPERATION OF FARM MACHINERY AND NO ALLOWED AGRICULTURAL SHALL BE SUBJECT TO RESTRICTION ON THE BASIS THAT IT INTERFERES WITH ACTIVITIES OF FUTURE RESIDENTS OF THIS SUBDIVISION.

**PRELIMINARY #2**

**NARRATIVE**


THE PURPOSE OF THIS SURVEY WAS TO CREATE A SUBDIVISION FOR MIKE STRAHAN, FOR A BUILDING. THE BASIS OF BEARINGS FOR THIS SURVEY IS STATE PLANE GRID, WHICH BEARS N024°09'E (PER WEBER COUNTY SURVEY DATA), ALONG THE AS MONUMENTED WEST SECTION LINE OF THE NORTHWEST QUARTER OF SECTION 13, TOWNSHIP 6 NORTH RANGE 3 WEST, S.L.B.&M.  
DURING THE COURSE OF RETRACEMENT OF THIS PROPERTY, WE FOUND REBARS AND CAPS AT CERTAIN LOCATIONS ALONG ITS BOUNDARY BY MILLER & ASSOCIATES, NO SURVEY ON FILE.  
THREE WEEKS AGO I CONTACTED THE SURVEYOR IN ORDER TO GET A COPY, NO WORD AS YET. APPARENTLY A FENCE WAS BUILT TO THE REBARS AND THE REBARS MARKED A OLDER FENCE LINE AND IT WAS ASKED OF THE ADJACENT PROPERTY OWNERS TO DO A BOUNDARY LINE AGREEMENT ON THE EXISTING LINE, WHICH WAS NOT DONE AT THAT TIME.  
A BOUNDARY LINE AGREEMENT HAS BEEN PROVIDED TO MY CLIENT FOR THE PURPOSE MENTIONED ABOVE. THIS SAME FENCE RUNS TO THE NORTH AND APPARENTLY IS THE SAME FENCE USED IN THE 1992 BUTTARS SURVEY FOR THE CHURCH PROPERTY AND THIS SURVEY ALSO SHOWS WHAT IS BEING USED AS THE NORTH QUARTER CORNER OF SAID SECTION 13. THIS SAME FENCE DOES NOT RUN ANY FURTHER SOUTH THAN SHOWN.  
THE INTERSECTION OF THE NORTH 1/4 - SOUTH 1/4 CORNER AND THE WEST 1/4 CORNER - EAST 1/4 CORNER LIES NEARLY 34 FEET TO THE WEST OF THE SOUTHWEST CORNER OF THIS PROPERTY, AS SHOWN.  
IN THE REMAINING PARCEL DESCRIPTION OF STRAHAN PLACE SUBDIVISION (2008 SUBDIVISION), THERE IS AN ERROR IN ITS DESCRIPTION, PRIOR ADMINISTRATION DIDN'T CATCH IT. THE ORIGINAL DISTANCE OF THIS PARCEL READS S88°44'44"E 576.16 FEET. STRAHAN PLACE SUB'S FIRST CALL ALONG ITS BOUNDARY IS S88°44'44"E 276.70 FEET, LEAVING A DISTANCE ALONG THAT DEED LINE OF 299.46 FEET, NOT 301.46 FEET AS STATED WITHIN THE REMAINING PARCEL OF THAT 2008 SUBDIVISION.  
WE HAVE ADJUSTED THE POSITION OF THE WEST QUATER CORNER IN ORDER TO ALLOW THE DEED DISTANCES TO BE RECOGNIZED IN THEIR FULL LENGTHS BY 0.03' FEET, AND HOLDING TO THE DEED DISTANCE OF 2115.06 FEET FROM THE NW CORNER OF SAID SECTION, PER STRAHAN PLACE SUB.

**SURVEYOR'S CERTIFICATE**

I, CYNTHIA L. SEGRIF DO HEREBY CERTIFY THAT I AM A REGISTERED LAND SURVEYOR, AND THAT I HOLD CERTIFICATE No. 7511(170143) IN ACCORDANCE WIT TITLE 58, CHAPTER 22, PROFESSIONAL ENGINEERS AND LAND SURVEYORS LICENSING ACT; AND THAT I HAVE COMPLETED A SURVEY OF THE PROPERTY DESCRIBED ON THIS PLAT IN ACCORDANCE WITH SECTION 17-23-17 AND HAVE VERIFIED ALL MEASUREMENTS AND HAVE PLACED MONUMENTS AS REPRESENTED ON THIS PLAT, AND FURTHER CERTIFY THAT ALL LOTS IN Strahan Place Subdivision #2 HEREBY MEET ALL CURRENT LOT WIDTH AND AREA REQUIREMENTS OF THE WEBER COUNTY ZONING ORDINANCE.  
CYNTHIA L. SEGRIF P.L.S. 7511(170143)

**BOUNDARY DESCRIPTION**

A PART OF THE NORTHWEST QUARTER OF SECTION 13, TOWNSHIP 6 NORTH, RANGE 3 WEST, SALT LAKE BASE AND MERIDIAN:  
BEGINNING AT A POINT ON THE EAST RIGHT OF WAY LINE OF 6700 WEST STREET LOCATED S 0°24'09" W 2115.06 FEET ALONG THE WEST LINE OF SAID NORTHWEST QUARTER AND S 89°35'51" W 33.00 FEET AND S 88°44'44" E 276.70 FEET FROM THE NORTHWEST CORNER OF SAID NORTHWEST QUARTER AND RUNNING THENCE S 88°44'44" E 299.46 FEET, THENCE S 51°33'54" E 29.52 FEET, THENCE S 88°44'44" E 20.00 FEET, THENCE N 43°59'46" E 24.29 FEET, THENCE S 88°44'44" E (1969.95 FEET) 2018.41 FEET, MORE OR LESS TO AN EXISTING FENCE, THENCE S 0°15'44" W 220.03 FEET (S 0°24'09" W 920.00 FEET) ALONG SAID FENCE TO A FOUND REBAR AND CAP, THENCE N 88°44'44" W (2298.17 FEET) 2344.44 FEET MORE OR LESS, TO A POINT WHICH BEARS S 88°44'44" E 344.14 FEET FROM THE WEST QUATER CORNER OF SAID SECTION, THENCE N 88°44'44" W (10115.16 FEET) 70.00 FEET, THENCE N 88°44'44" W (511.14 FEET) 311.41 FEET TO SAID EAST RIGHT OF WAY LINE, THENCE N 0°24'09" E 300.00 FEET ALONG SAID RIGHT OF WAY, THENCE S 88°44'44" E 276.70 FEET, THENCE N 0°24'09" E 150.00 FEET TO THE POINT OF BEGINNING.  
CONTAINING 30.223 Acres, more or less.

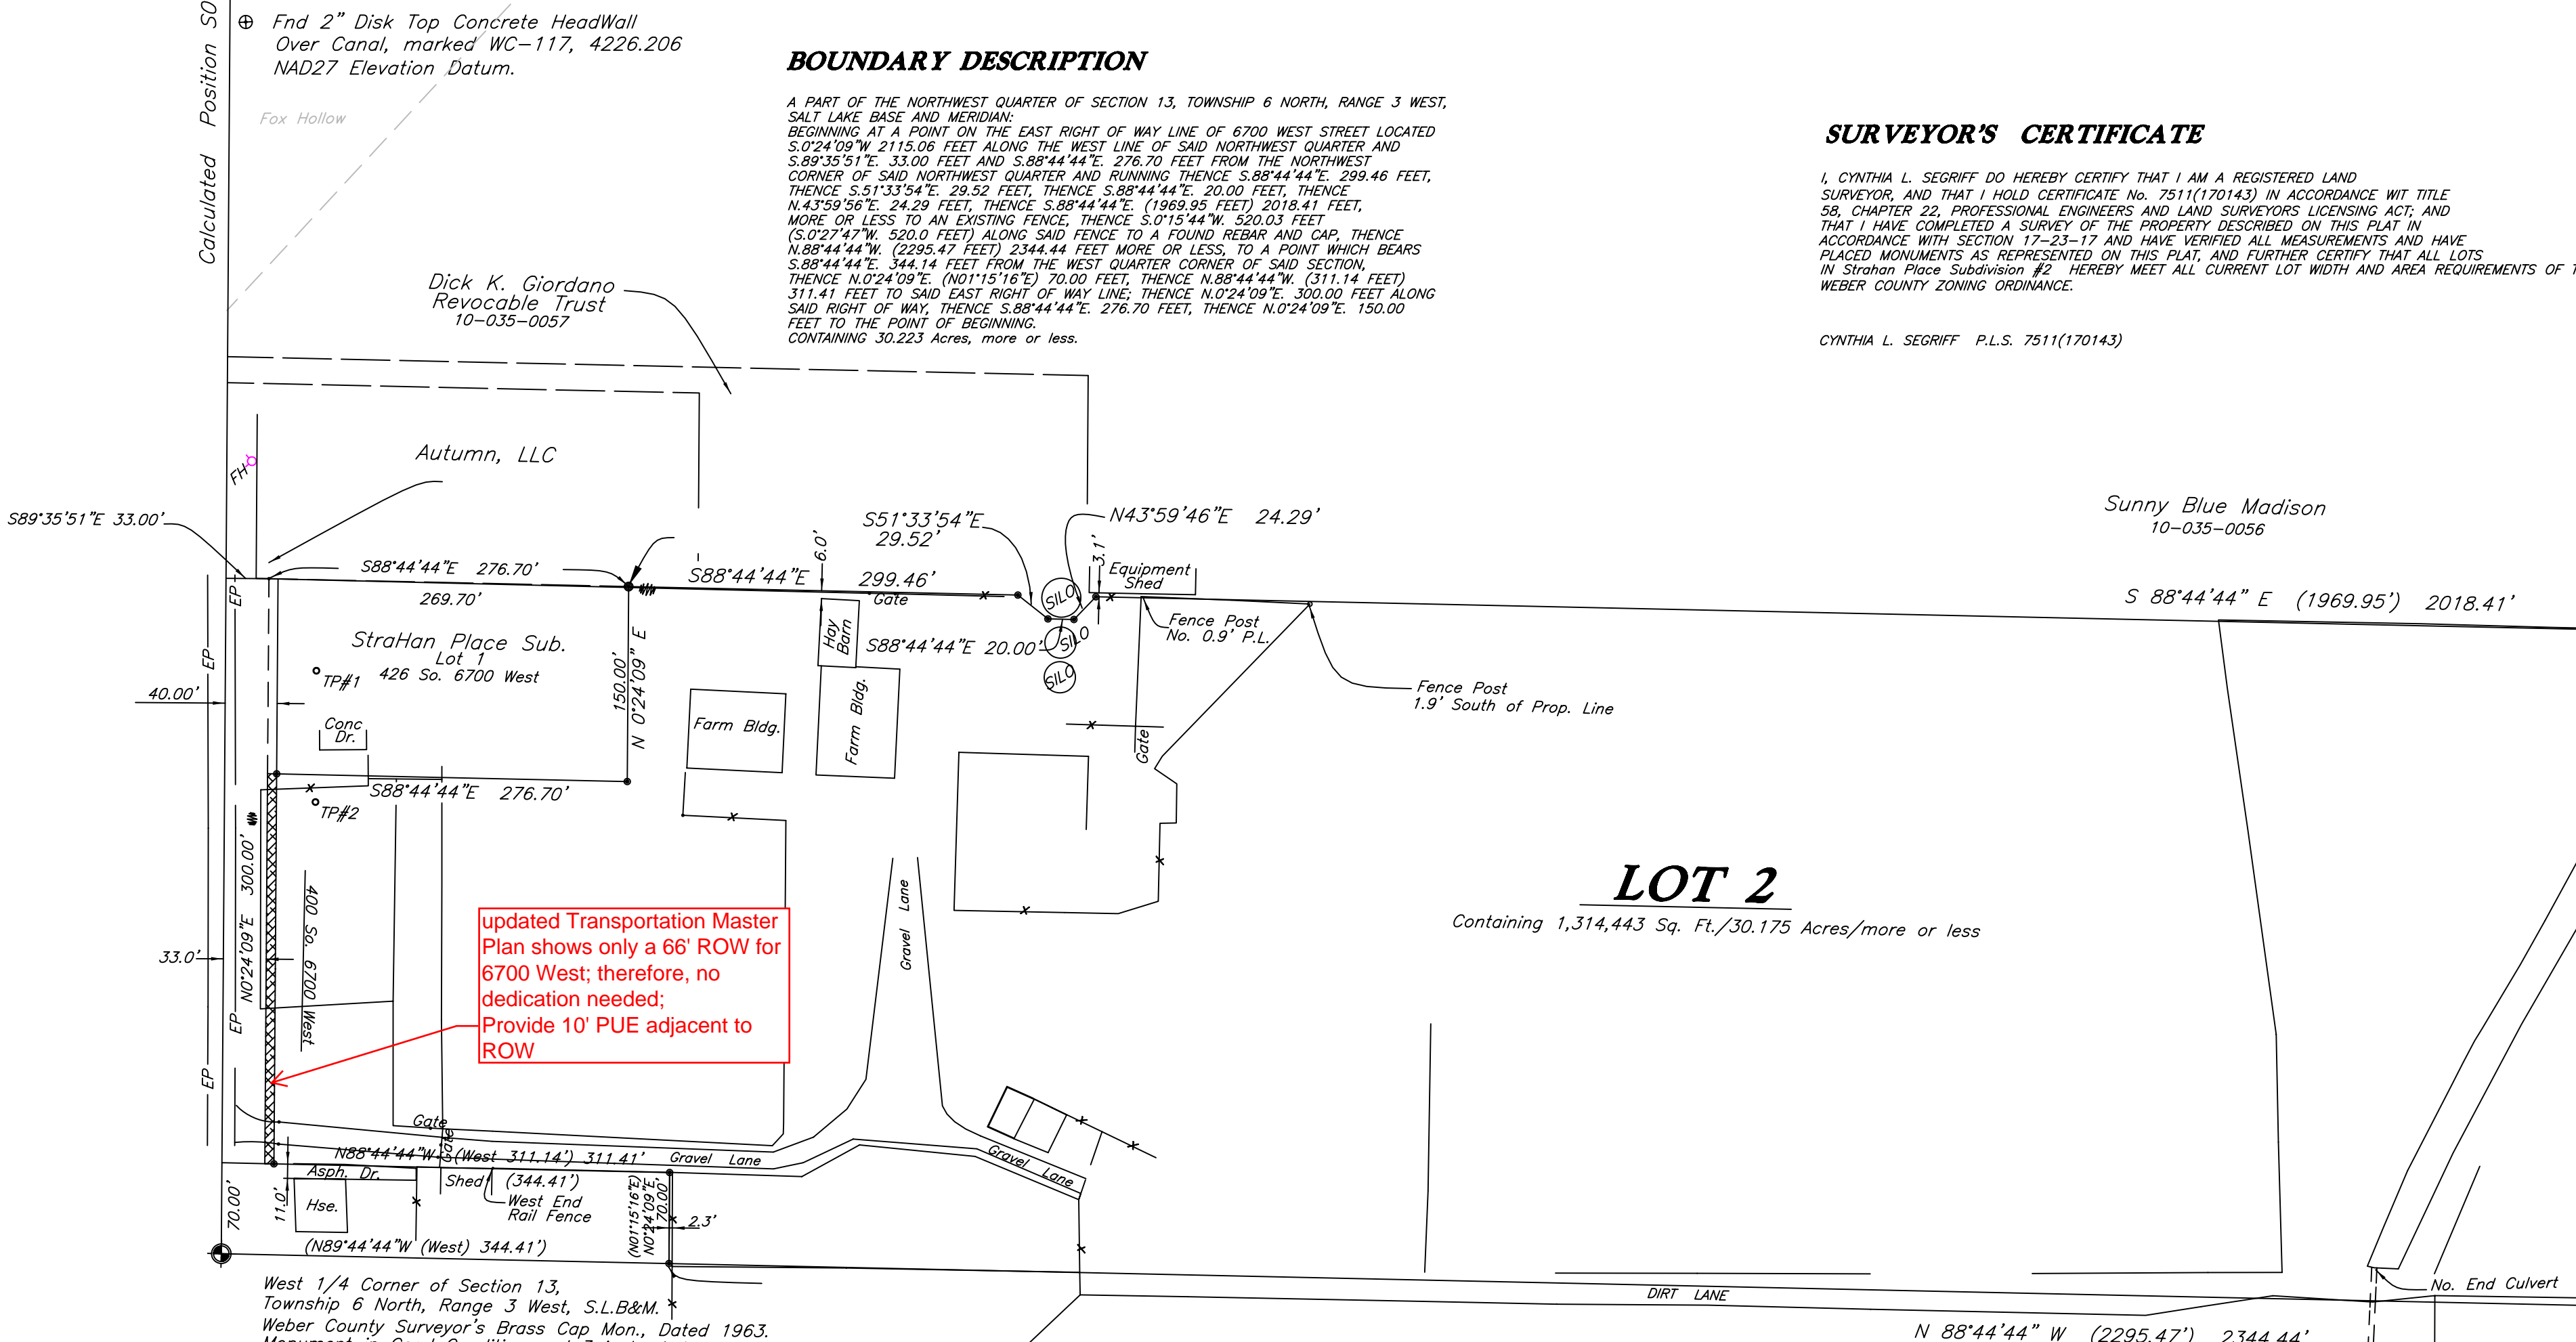

updated Transportation Master Plan shows only a 66' ROW for 6700 West; therefore, no dedication needed; Provide 10' PUE adjacent to ROW

spelling error

Webster County maintains this drainage; please provide drainage easement, including 10' offset from top of bank, each side.

Recommend changing color so it shows up during plotting hard copy

**LEGEND:**

- ( ) DISTANCE AND OR BEARING PER DEED OR PLAT.
- NO PARENTHESIS IS MEASURED DISTANCE OR ROTATED PLAT OR DEED BEARING TO STATE PLANE GRID BEARING.
- EXISTING FENCES.
- SET 5/8" REBAR (24x5/8") & C.&L.S. CAP.
- STREET DEDICATION - 2,100 Sq. Ft.
- EP EDGE PAVEMENT.
- SW SECONDARY WATER
- Tele Ped. TELEPHONE
- EB ELECTRICAL BOX
- SPP SERVICE POWER POLE
- BM WC-117 4226.206
- PL PROPERTY LINE

COUNTY RECORDER

ENTRY No. _____	FEE PAID _____
FILED FOR RECORD AND RECORDED:	
_____	20____ AT _____
IN BOOK _____ PAGE _____	
OF OFFICIAL RECORDS.	
RECORDED FOR:	
COUNTY RECORDER:	
BY:	