
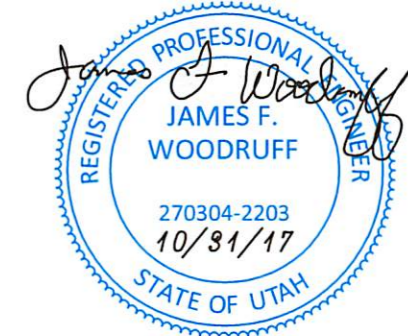
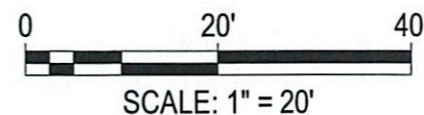


C:\1\2015\DOC-707-1510 Edgewater Beach Renovation CAD\03 Exhibit\PHASE 2 GRADING EXH.dwg Sam Burke 10/31/2017 3:48 PM

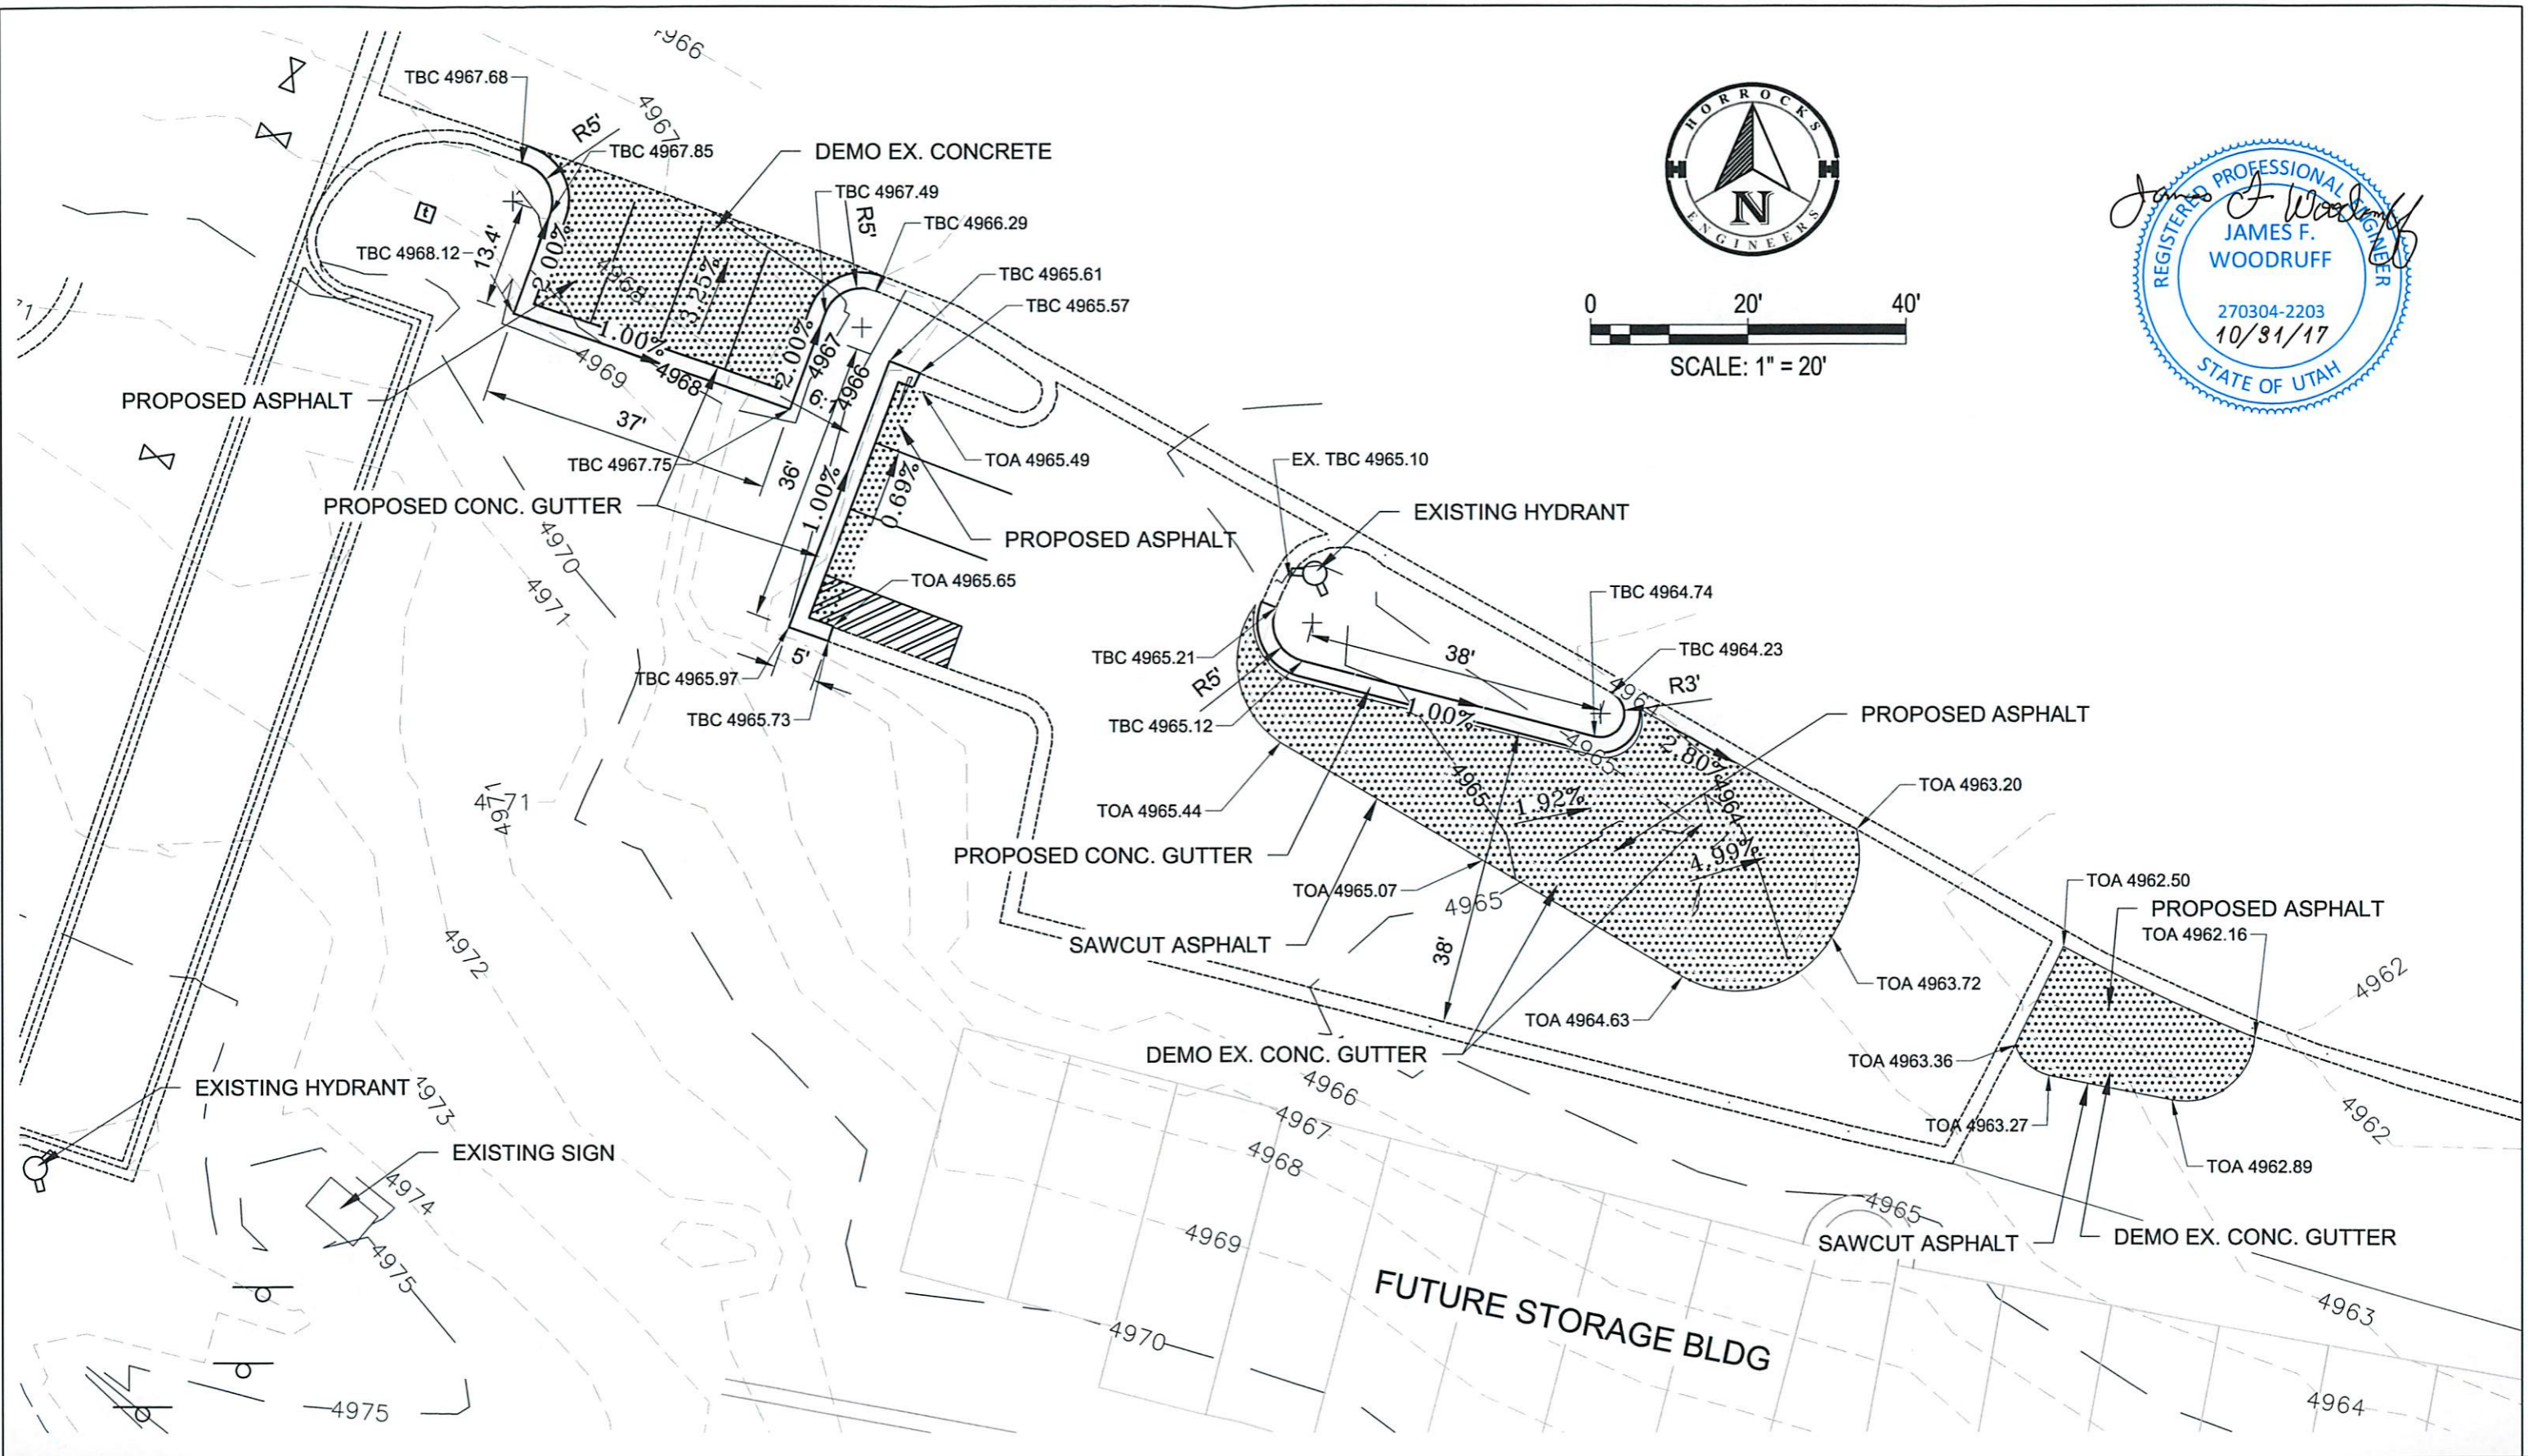

HORROCKS ENGINEERS
 2162 West Grove Pkwy., Suite 400
 Pleasant Grove, UT 84062
 (801) 763-5100
 www.horrocks.com

OWNER: _____ CITY: _____

WARNING

 IF THIS BAR DOES NOT MEASURE 1" THEN DRAWING IS NOT TO SCALE

EDGEWATER PHASE 2 AS-BUILT EXHIBIT

SITE & GRADING

DRAWING INFO	
DATE	10/31/17
SCALE	1" = 20'
REV #	DATE
*SEE 2nd SHEET FOR LISTING PROJ. NO.	

1

PAGE 01