

# EDGEWATER BEACH RESORT PHASE 3

A PLANNED RESIDENTIAL UNIT DEVELOPMENT (P.R.U.D.)

PART OF THE SOUTHWEST QUARTER OF SECTION 13, TOWNSHIP 6 NORTH, RANGE 1 EAST, SALT LAKE BASE AND MERIDIAN, U.S. SURVEY  
WEBER COUNTY, UT  
OCT 2017

YOU HAVE SAID YOU ARE DEDICATING ALL THESE PRIVATE STREET TO THE PUBLIC IN THE OTHER PHASES. IS THIS THE INTENT OR IS IT TO BE PRIVATE?

Owner's Dedication Certificate shall include the following Common Open Space dedication as applicable:  
"Grant and convey to the subdivision lot (unit) owners association, all those parts or portions of said tract of land designated as common areas to be used for recreational and open space purposes for the benefit of each lot (unit) owners association member in common with all others in the subdivision and grant and dedicate to the county a perpetual open space right and easement on and over the common areas to guarantee to Weber County that the common areas remain open and undeveloped except for approved recreational, parking and open space purposes."  
WCO 106-7-1

IF YOU COULD ALSO ADD THIS ONTO THE OTHER PHASES I SENT BACK (WHAT IS IN THE RED)


**BASIS OF BEARING**

THE BASIS OF BEARING IS N.00°25'49"E. (RECORD N.00°25'44"E.) 5316.87' BETWEEN THE SOUTHWEST AND THE NORTHWEST CORNER OF SECTION 13, T.6N., R.1E., S13&M.

**NARRATIVE**

THE PURPOSE OF THIS SURVEY IS TO CREATE A SUBDIVISION PLAT TO BE KNOWN AS "EDGEWATER BEACH RESORT PHASE 3". FOUND SECTION CORNERS AND REFERENCE MONUMENTS WERE USED TO DETERMINE THE BASIS OF BEARING. THE BEARING ALONG THE WEST LINE OF SECTION 13 AS IT IS SHOWN ON A RECORD OF SURVEY TITLED "A PORTION OF THE PINEVIEW FEDERAL BOUNDARY PROJECT FOR PROPOSED EDGEWATER BEACH RESORT AT SNOWBASIN ROAD & LAKESIDE VILLAGE CONDOMINIUMS", SURVEY FILING NO. 003429, WAS HELD AS THE BASIS OF BEARING. THE PROPERTY IS BOUNDED BY THE USA LAND ON THE EAST, EDGEWATER BEACH RESORT PHASE 1-1ST AMENDMENT ON THE WEST, AND STATE HIGHWAY 39 ON THE SOUTH. HIGHWAY RIGHT OF WAY MARKERS WERE FOUND ON THE GROUND AND HELD FOR THE LOCATION OF THE HIGHWAY AND THE NORTH LINE OF THIS SURVEY WAS ESTABLISHED BY THE PROPERTY OWNER TO BE THE NORTH LINE OF THIS SUBDIVISION.

- ALL PATIOS, DECKS AND DRIVEWAYS TO PADS ARE DEDICATED LIMITED COMMON AREAS. THEY ARE SET ASIDE AND RESERVED FOR THE OWNERS OF THE RESPECTIVE PAD TO WHICH THEY ARE ATTACHED.
- ALL OTHER AREAS CONTAINED WITHIN THE PROJECT, BUT NOT SHOWN WITH DIAGONAL STRIPE OR CROSS HATCHED LINES ARE DEDICATED AS COMMON AREA, INCLUDING PARKING, PRIVATE STREETS, PUBLIC UTILITY, STORM WATER DETENTION AND DRAINAGE EASEMENT AREA. COMMON AREAS ARE "TO BE USED FOR RECREATIONAL AND OPEN SPACE PURPOSES FOR THE BENEFIT OF EACH EDGEWATER BEACH RESORT HOA, INC. MEMBER IN COMMON AND GRANT AND DEDICATE TO THE GOVERNING AUTHORITY A PERPETUAL OPEN SPACE RIGHT AND EASEMENT ON AND OVER THE COMMON AREA TO GUARANTEE THAT THE COMMON AREAS REMAIN OPEN AND UNDEVELOPED EXCEPT FOR APPROVED RECREATIONAL, PARKING AND OPEN SPACE PURPOSES".
- CULINARY WATERLINE AND THE SANITARY SEWER MAIN TO BE OWNED AND MAINTAINED BY LAKEVIEW WATER SYSTEM AND MOUNTAIN SEWER CORPORATION RESPECTIVELY.
- THERE ARE NO CONVERTIBLE OR WITHDRAWALABLE AREAS IN THIS PROJECT PHASE.
- ALL BUILDING TIE DIMENSIONS ARE PERPENDICULAR TO BOUNDARY LINE OR ROAD CENTERLINE.
- ALL AREAS LABELED AS COMMON AREA, INCLUDING PRIVATE STREETS ARE TO BE DESIGNATED AS A PUBLIC UTILITY EASEMENT. SEE OWNERS DEDICATION AND CONSENT TO RECORD FOR ADDITIONAL INFORMATION.
- SEE "NATURAL HAZARDS DISCLOSURE" DOCUMENT AND AGEC GEOLOGICAL HAZARD REPORT DATED JANUARY 3RD 2018, AND MAY 2ND, 2017 IDENTIFIED AS PROJECT #1170319.

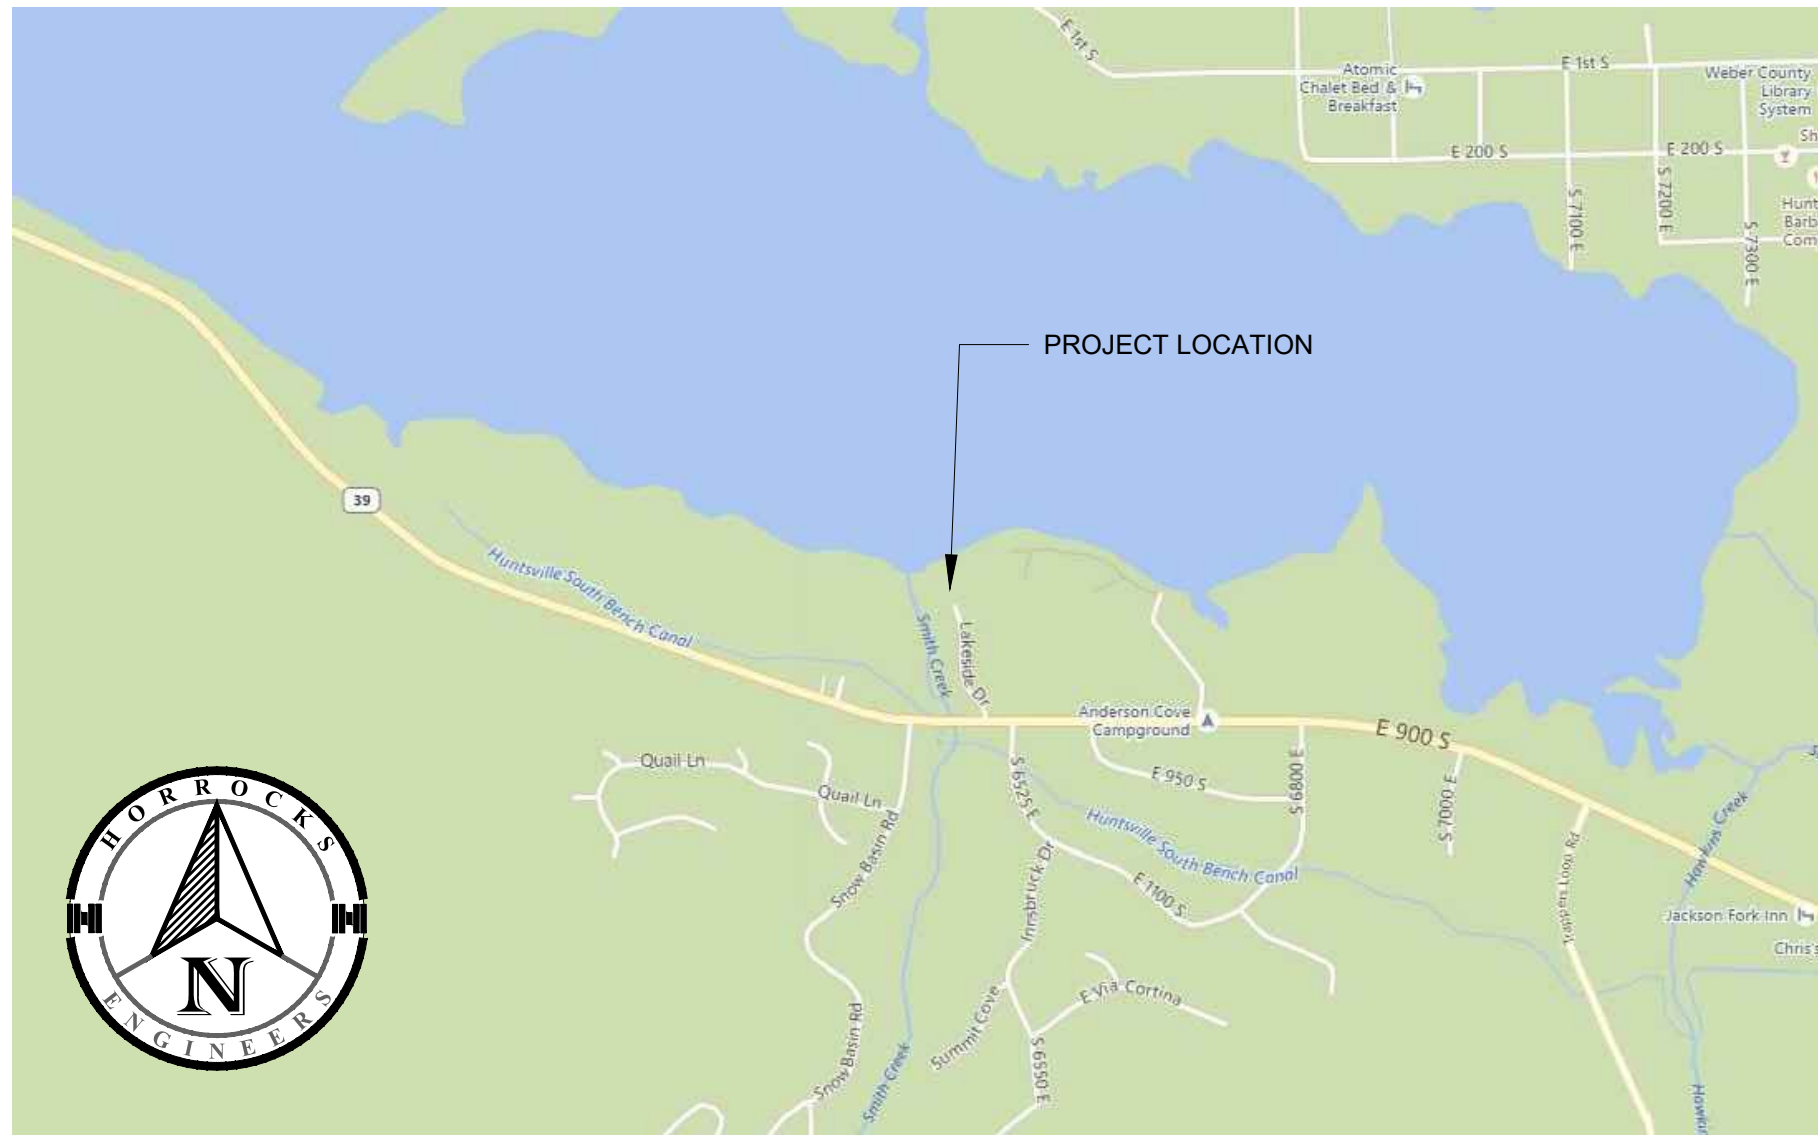

VICINITY MAP  
NO SCALE

**DEVELOPER**

JACK FISHER HOMES  
BROCK LOOMIS  
1148 W LEGACY CROSSING BLVD., STE 400  
CENTERVILLE, UTAH 84014  
801-335-8500

**LAND USE**

TOTAL AREA ..... 208,800 S.F. (4.79 ACRES)  
COMMON AREA ..... 149,140 S.F. (3.42 ACRES) 71%  
ROAD AREA ..... 49,420 S.F. (1.13 ACRES)  
OPEN AREA ..... 99,720 S.F. (2.29 ACRES)  
PRIVATELY OWNED BUILDING ..... 59,660 S.F. (1.37 ACRES) 29%

PLEASE SHOW ALL EASEMENTS AS SHOWN ON TITLE COMMITMENT. IF LOCATION IS UNCLEAR PLEASE NOT EASEMENT EXISTS ON PLAT.

**OWNERS DEDICATION AND CONSENT TO RECORD**

KNOW ALL MEN BY THESE PRESENTS: \_\_\_\_\_ WHICH IS THE OWNER OF THE TRACT OF LAND DESCRIBED HEREON MAKE THIS CERTIFICATE FOR AND ON BEHALF OF SAID CORPORATION AND HAVE CAUSED; 1. A SURVEY TO BE MADE AND 2. THIS PLANNED RESIDENTIAL UNIT DEVELOPMENT PLAT, CONSISTING OF (2) SHEETS. WE THE UNDERSIGNED OWNERS OF THE HEREIN DESCRIBED TRACT OF LAND, DO HEREBY SET APART AND SUBDIVIDE THE SAME INTO UNITS AND PADS AND PUBLIC AND PRIVATE STREETS AS SHOWN HEREON AND NAME SAID TRACT EDGEWATER BEACH RESORT PHASE 3, A PLANNED RESIDENTIAL UNIT DEVELOPMENT, AND DO HEREBY:

DEDICATE TO PUBLIC USE ALL THOSE PARTS OR PORTIONS OF SAID TRACT OF LAND DESIGNATED AS PRIVATE STREETS, THE SAME TO BE USED AS PUBLIC THOROUGHFARES. DEDICATE AND RESERVE UNTO THEMSELVES, THEIR HEIRS, THEIR GRANTEEES AND ASSIGNS, A RIGHT-OF-WAY TO BE USED IN COMMON WITH ALL OTHERS WITHIN SAID SUBDIVISION (AND THOSE ADJOINING SUBDIVISIONS THAT MAY BE SUBDIVIDED BY THE UNDERSIGNED OWNERS, THEIR SUCCESSORS, OR ASSIGNS) ON, OVER AND ACROSS ALL THOSE PORTIONS OR PARTS OF SAID TRACT OF LAND DESIGNATED ON SAID PLAT AS PRIVATE STREETS AS ACCESS TO THE INDIVIDUAL UNITS AND PADS, TO BE MAINTAINED BY A UNIT AND PAD OWNERS ASSOCIATION WHOSE MEMBERSHIP CONSISTS OF SAID OWNERS, THEIR GRANTEEES, SUCCESSORS, OR ASSIGNS. GRANT AND CONVEY TO EDGEWATER BEACH RESORT HOA, INC., ALL THOSE PARTS OR PORTIONS OF SAID TRACT OF LAND DESIGNATED AS COMMON AREAS TO BE USED FOR RECREATIONAL AND OPEN SPACE PURPOSES FOR THE BENEFIT OF EACH EDGEWATER BEACH RESORT HOA, INC. MEMBER IN COMMON WITH ALL OTHERS IN THE SUBDIVISION, THE SAME TO BE USED FOR THE INSTALLATION MAINTENANCE AND OPERATION OF PUBLIC UTILITY SERVICE LINE, STORM DRAINAGE FACILITIES, IRRIGATION CANALS OR FOR THE PERPETUAL PRESERVATION OF WATER CHANNELS IN THEIR NATURAL STATE WHICHEVER IS AUTHORIZED AS MAY BE AUTHORIZED BY THE GOVERNING AUTHORITY, WITH NO BUILDINGS OR STRUCTURES BEING ERCTED WITHIN SUCH EASEMENTS. GRANT AND DEDICATE UNTO ALL OWNERS OF UNITS AND PADS UPON SUCH LAND DRAINS, AN EASEMENT OVER SUCH LAND DRAINS FOR THE PURPOSE OF PERPETUAL MAINTENANCE AND OPERATION. DEDICATE, GRANT AND CONVEY TO THE GOVERNING AUTHORITY, OR ITS DESIGNEE, ALL THOSE PARTS OR PORTIONS OF SAID TRACT OF LAND DESIGNATED AS PARKS THE SAME TO BE USED AS A PUBLIC OPEN SPACE. ALL COMMON AREA, INCLUDING THE PRIVATE STREETS, IS CONSIDERED TO BE AN EASEMENT FOR PUBLIC UTILITY AND DRAINAGE PURPOSES.

SIGNED THIS \_\_\_\_\_ DAY OF \_\_\_\_\_, 20\_\_\_\_.

**BOUNDARY DESCRIPTION**

PART OF THE SOUTHWEST QUARTER OF SECTION 13, TOWNSHIP 6 NORTH, RANGE 1 EAST, SALT LAKE BASE AND MERIDIAN, U.S. SURVEY. DESCRIBED AS FOLLOWS:

BEGINNING AT A POINT ON THE NORTH RIGHT OF WAY LINE OF STATE HIGHWAY 39, SAID POINT BEING THE NORTHWEST CORNER OF EDGEWATER BEACH RESORT PHASE 1 - 1ST AMENDMENT AND LIES N00°25'49"E 602.20 FEET AND N69°34'11"E 7.10 FEET FROM THE SOUTHWEST CORNER OF SECTION 13; THENCE CONTINUING N00°09'59"E 302.43 FEET ALONG THE WESTERLY BOUNDARY OF SAID SUBDIVISION; THENCE NORTH 63°12'30" EAST 319.26 FEET; THENCE SOUTH 79°03'30" EAST 319.70 FEET; THENCE SOUTH 35°45'20" EAST 101.60 FEET; THENCE SOUTH 0°20'30" WEST 183.33 FEET TO THE NORTH PROPERTY LINE OF EDGEWATER PHASE 2; THENCE ALONG SAID BOUNDARY NORTH 89°39'30" WEST 47.12 FEET; THENCE NORTH 60°22'18" WEST 75.49 FEET; THENCE SOUTH 72°01'51" WEST 211.70 FEET TO A POINT ON A 66.72 FOOT RADIUS NON-TANGENT CURVE TO THE RIGHT (CENTER BEARS S9°42'22"W); THENCE RUNNING SOUTHWESTERLY ALONG SAID CURVE 147.18 FEET THROUGH A CENTRAL ANGLE OF 126°22'53" (CHORD S72 54°23'W 119.10') TO A POINT ON A LINE; THENCE S65°29'31"W 139.65 FEET; THENCE NORTH 89°34'11" WEST 103.01 FEET TO THE POINT OF BEGINNING.

CONTAINING 208,760 SQUARE FEET OR 4.793 ACRES.

**SURVEYOR'S CERTIFICATE**

I, C. DAVID MCKINNEY, DO HEREBY CERTIFY THAT I AM A PROFESSIONAL LAND SURVEYOR, AND THAT I HOLD A LICENSE IN ACCORDANCE WITH TITLE 58, CHAPTER 22, PROFESSIONAL ENGINEERS AND PROFESSIONAL LAND SURVEYORS LICENSING ACT, UTAH CODE ANNOTATED, 1953 AS AMENDED CERTIFICATE NUMBER 5251295. I FURTHER CERTIFY THAT BY AUTHORITY OF THE OWNERS, I HAVE MADE A SURVEY OF THE TRACT OF LAND SHOWN ON THIS PLAT AND DESCRIBED BELOW, HAVE SUBDIVIDED SAID TRACT OF LAND INTO LOTS, STREETS, AND EASEMENTS, HAVE COMPLETED A SURVEY OF THE PROPERTY DESCRIBED ON THIS PLAT IN ACCORDANCE WITH SECTION 17-23-17, UTAH CODE ANNOTATED, 1953 AS AMENDED, HAVE VERIFIED ALL MEASUREMENTS, AND WILL PLACE MONUMENTS AS REPRESENTED ON THE PLAT. I FURTHER CERTIFY THAT ALL LOTS MEET THE REQUIREMENTS OF THE WEBER COUNTY LAND USE CODE.

C. DAVID MCKINNEY  
LIC. 5251295

**WEBER COUNTY SURVEYOR:**

I HEREBY CERTIFY THAT THE WEBER COUNTY SURVEYOR'S OFFICE HAS REVIEWED THIS PLAT AND ALL CONDITIONS FOR APPROVAL BY THIS OFFICE HAVE BEEN SATISFIED. THE APPROVAL OF THIS PLAT BY THE WEBER COUNTY SURVEYOR DOES NOT RELIEVE THE LICENSED LAND SURVEYOR WHO EXECUTED THIS PLAT FROM THE RESPONSIBILITIES AND/OR LIABILITIES ASSOCIATED THEREWITH.

SIGNED THIS \_\_\_\_\_ DAY OF \_\_\_\_\_.

**ACKNOWLEDGMENT**

STATE OF UTAH )  
COUNTY OF \_\_\_\_\_ )ss.  
ON THE \_\_\_\_\_ DAY OF \_\_\_\_\_, 20\_\_\_\_, PERSONALLY APPEARED BEFORE ME, THE UNDERSIGNED NOTARY PUBLIC, SIGNER(S) OF THE ABOVE OWNER'S DEDICATION AND CERTIFICATION, WHO BEING BY ME DULY SWORN, DID ACKNOWLEDGE TO ME \_\_\_\_\_ SIGNED IT FREELY, VOLUNTARILY, AND FOR THE PURPOSES THEREIN MENTIONED.

\_\_\_\_\_  
COMMISSION EXPIRES NOTARY PUBLIC

**ACKNOWLEDGMENT**

STATE OF UTAH )  
COUNTY OF \_\_\_\_\_ )ss.  
ON THE \_\_\_\_\_ DAY OF \_\_\_\_\_, 20\_\_\_\_, PERSONALLY APPEARED BEFORE ME, THE UNDERSIGNED NOTARY PUBLIC, \_\_\_\_\_ BEING BY ME DULY SWORN, ACKNOWLEDGED TO ME THEY ARE \_\_\_\_\_ AND \_\_\_\_\_ OF SAID CORPORATION AND THAT THEY SIGNED THE ABOVE OWNER'S DEDICATION AND CERTIFICATION FREELY, VOLUNTARILY, AND IN BEHALF OF SAID CORPORATION FOR THE PURPOSES THEREIN MENTIONED.

\_\_\_\_\_  
COMMISSION EXPIRES NOTARY PUBLIC

**WEBER COUNTY PLANNING COMMISSION APPROVAL**

THIS IS TO CERTIFY THAT THIS SUBDIVISION PLAT WAS DULY APPROVED BY THE WEBER COUNTY PLANNING COMMISSION. SIGNED THIS \_\_\_\_\_ DAY OF \_\_\_\_\_, 20\_\_\_\_.

\_\_\_\_\_  
CHAIRMAN, WEBER COUNTY PLANNING COMMISSION

**WEBER COUNTY ENGINEER**

I HEREBY CERTIFY THAT THE REQUIRED PUBLIC IMPROVEMENT STANDARDS AND DRAWINGS FOR THIS SUBDIVISION CONFORM WITH THE COUNTY STANDARDS AND THE AMOUNT OF THE FINANCIAL GUARANTEE IS SUFFICIENT FOR THE INSTALLATION OF THESE IMPROVEMENTS.

SIGNED THIS \_\_\_\_\_ DAY OF \_\_\_\_\_, 20\_\_\_\_

\_\_\_\_\_  
WEBER COUNTY ENGINEER

**WEBER COUNTY COMMISSION ACCEPTANCE**

THIS IS TO CERTIFY THAT THIS SUBDIVISION PLAT, THE DEDICATION OF STREETS AND OTHER PUBLIC WAYS AND FINANCIAL GUARANTEE OF PUBLIC IMPROVEMENTS ASSOCIATED WITH THIS SUBDIVISION, THEREON ARE HEREBY APPROVED AND ACCEPTED BY THE COMMISSIONERS OF WEBER COUNTY, UTAH. SIGNED THIS \_\_\_\_\_ DAY OF \_\_\_\_\_, 20\_\_\_\_.

\_\_\_\_\_  
CHAIRMAN, WEBER COUNTY COMMISSION

ATTEST  
\_\_\_\_\_  
TITLE

**WEBER COUNTY RECORDER**

ENTRY NO. \_\_\_\_\_ FEE PAID \_\_\_\_\_  
FILED FOR RECORD AND RECORDED \_\_\_\_\_ AT \_\_\_\_\_ IN BOOK \_\_\_\_\_ OF THE OFFICIAL RECORDS, PAGE \_\_\_\_\_

RECORDED FOR: \_\_\_\_\_

\_\_\_\_\_  
WEBER COUNTY RECORDER

\_\_\_\_\_  
DEPUTY

**WEBER COUNTY ATTORNEY**

I HAVE EXAMINED THE FINANCIAL GUARANTEE AND OTHER DOCUMENTS ASSOCIATED WITH THIS SUBDIVISION PLAT, AND IN MY OPINION THEY CONFORM WITH THE COUNTY ORDINANCE APPLICABLE THERETO AND NOW IN FORCE AND AFFECT. SIGNED THIS \_\_\_\_\_ DAY OF \_\_\_\_\_, 20\_\_\_\_.

\_\_\_\_\_  
WEBER COUNTY ATTORNEY

**WEBER-MORGAN HEALTH DEPARTMENT**

I HEREBY CERTIFY THAT THE SOILS, PERCOLATION RATES, AND SITE CONDITIONS FOR THIS SUBDIVISION HAVE BEEN INVESTIGATED BY THIS OFFICE AND ARE APPROVED FOR ON-SITE WASTEWATER DISPOSAL SYSTEMS. SIGNED THIS \_\_\_\_\_ DAY OF \_\_\_\_\_, 20\_\_\_\_.

\_\_\_\_\_  
DIRECTOR, WEBER-MORGAN HEALTH DEPARTMENT

ENTRY NO.: \_\_\_\_\_  
FEE PAID: \_\_\_\_\_  
FILED FOR RECORD AND RECORDED.

AT \_\_\_\_\_ OF \_\_\_\_\_ IN BOOK \_\_\_\_\_ OF THE OFFICIAL RECORDS,

PAGE \_\_\_\_\_

RECORDED FOR: \_\_\_\_\_

\_\_\_\_\_  
WEBER COUNTY RECORDER

\_\_\_\_\_  
DEPUTY




2162 West Grove Pkwy., Suite 400  
Pleasant Grove, UT 84062  
(801) 763-5100

# EDGEWATER BEACH RESORT PHASE 3

A PLANNED RESIDENTIAL UNIT DEVELOPMENT (P.R.U.D.)


PART OF THE SOUTHWEST QUARTER OF SECTION 13, TOWNSHIP 6  
NORTH, RANGE 1 EAST, SALT LAKE BASE AND MERIDIAN, U.S. SURVEY  
WEBER COUNTY, UT  
OCT 2017

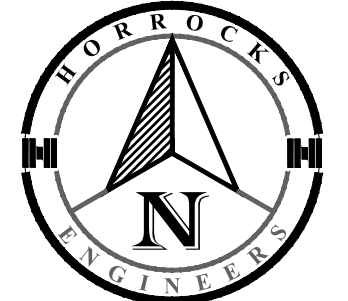

0 30' 60'  
SCALE: 1" = 30'

CURVE DATA						
#	Delta	Radius	Length	Tangent	Chord	CH Length
C1	90°00'00"	3.00'	4.71'	3.00'	S62°58'09"E	4.24'
C2	90°00'00"	3.00'	4.71'	3.00'	N27°01'51"E	4.24'
C3	90°00'00"	3.00'	4.71'	3.00'	S62°58'09"E	4.24'
C4	89°53'38"	3.00'	4.71'	2.99'	N26°58'40"E	4.24'
C5	8°37'36"	36.00'	5.42'	2.72'	N67°36'42"E	5.42'
C6	85°35'18"	3.00'	4.48'	2.78'	S73°54'27"E	4.08'
C7	25°27'53"	54.00'	24.00'	12.20'	N46°09'15"E	23.80'
C8	167°16'03"	4.50'	13.14'	40.33'	N27°03'20"E	8.94'
C9	25°27'53"	54.00'	24.00'	12.20'	N7°57'25"E	23.80'
C10	82°59'43"	5.00'	7.24'	4.42'	N53°16'40"W	6.63'
C11	6°11'20"	36.00'	3.89'	1.95'	N14°52'29"W	3.89'
C12	60°45'21"	73.00'	77.41'	42.79'	N48°20'49"W	73.83'
C13	33°42'31"	113.00'	66.48'	34.23'	S84°25'14"W	65.53'
C14	35°00'38"	87.00'	53.16'	27.44'	N83°46'11"E	52.34'
C15	75°34'51"	15.00'	19.79'	11.63'	S40°56'05"E	18.38'
C16	14°49'29"	214.00'	55.37'	27.84'	S10°33'24"E	55.22'
C17	90°00'00"	15.00'	23.56'	15.00'	S27°01'51"W	21.21'
C18	60°26'24"	23.00'	24.26'	13.40'	N77°44'56"W	23.15'
C19	120°52'49"	52.00'	109.71'	91.69'	S72°01'51"W	90.46'
C20	60°26'24"	23.00'	24.26'	13.40'	S41°48'39"W	23.15'
C21	90°00'00"	3.00'	4.71'	3.00'	N62°58'09"W	4.24'
C22	91°08'34"	3.00'	4.77'	3.06'	S27°36'08"W	4.28'
C23	91°33'23"	15.00'	23.97'	15.41'	N61°02'53"W	21.50'
C24	12°02'57"	136.00'	28.60'	14.35'	N9°14'43"W	28.55'
C25	55°19'20"	74.00'	71.45'	38.79'	N30°52'54"W	68.71'
C26	26°23'44"	89.02'	41.01'	20.88'	N71°26'29"W	40.65'
C27	85°04'17"	28.00'	41.57'	25.69'	N42°06'19"W	37.86'
C28	71°20'43"	28.00'	34.87'	20.10'	N36°06'10"E	32.66'
C29	123°50'43"	4.00'	8.64'	7.49'	S46°22'23"E	7.05'
C30	109°33'31"	5.00'	9.56'	7.08'	N70°15'28"E	8.17'
C31	51°44'32"	46.00'	41.54'	22.31'	S29°05'30"E	40.14'
C32	12°02'57"	164.00'	34.49'	17.31'	S9°14'43"E	34.43'
C33	96°08'35"	15.00'	25.17'	16.70'	S32°48'06"W	22.32'
C34	9°33'26"	286.00'	47.71'	23.91'	S85°39'06"W	47.65'
C35	90°00'00"	3.00'	4.71'	3.00'	S44°34'11"E	4.24'
C36	11°05'04"	340.00'	65.78'	32.99'	N84°53'17"E	65.67'
C37	89°27'28"	3.00'	4.68'	2.97'	N34°04'29"E	4.22'
C38	4°49'25"	314.00'	26.43'	13.22'	N76°23'30"E	26.43'
C39	89°09'16"	5.00'	7.78'	4.93'	S61°26'34"E	7.02'
C40	1°03'05"	321.00'	5.89'	2.95'	N72°33'24"E	5.89'
C41	90°00'00"	2.00'	3.14'	2.00'	N27°01'51"E	2.83'
C42	60°26'24"	23.00'	24.26'	13.40'	S77°44'56"E	23.15'
C43	30°52'49"	52.00'	28.03'	14.36'	S62°58'09"E	27.69'
C44	60°26'24"	23.00'	24.26'	13.40'	S48°11'21"E	23.15'
C45	24°13'26"	66.72'	28.21'	14.32'	N72°01'51"E	28.00'
C46	60°26'24"	23.00'	24.26'	13.40'	N12°15'04"E	23.15'
C47	30°52'49"	52.00'	28.03'	14.36'	N27°01'51"E	27.69'
C48	60°26'24"	23.00'	24.26'	13.40'	N41°48'39"E	23.15'
C49	60°43'10"	45.50'	48.22'	26.65'	N47°59'40"W	46.00'
C50	90°00'00"	3.00'	4.71'	3.00'	S56°16'30"W	4.24'
C51	90°00'00"	3.00'	4.71'	3.00'	N33°43'30"W	4.24'
C52	104°25'09"	15.00'	27.34'	19.34'	S49°03'55"W	23.71'
C53	90°00'00"	3.00'	4.71'	3.00'	S48°08'39"E	4.24'
C54	90°00'00"	3.00'	4.71'	3.00'	S41°51'21"W	4.24'
C55	14°49'29"	186.00'	48.13'	24.20'	S10°33'24"E	47.99'
C56	90°00'00"	15.00'	23.56'	15.00'	S62°58'09"E	21.21'
C57	90°00'00"	15.00'	23.56'	15.00'	N27°01'51"E	21.21'
C58	50°12'12"	66.72'	58.46'	31.26'	N34°49'02"E	56.61'
C59	51°57'15"	66.72'	60.50'	32.51'	S69°52'48"E	58.45'

LINE TABLE		
LINE #	LENGTH	DIRECTION
L1	15.68	N72°01'51"E
L3	4.00	S17°58'09"E
L4	66.00	N72°01'51"E
L5	4.00	N17°58'09"W
L7	14.00	N72°01'51"E
L9	4.00	S17°58'09"E
L10	110.00	N72°01'51"E
L11	4.00	N17°58'09"W
L15	15.12	S31°06'48"E
L17	13.67	N56°34'42"W
L19	13.67	S69°18'38"E
L21	13.31	S85°13'29"W
L24	46.47	N17°58'09"W
L26	163.93	N78°43'30"W
L28	28.10	S18°16'10"E
L30	3.94	S78°43'30"E
L32	81.84	S3°08'39"E
L34	5.85	S17°58'09"E
L36	28.17	S72°01'51"W
L40	25.46	S72°01'51"W
L42	13.00	N17°58'09"W
L43	27.00	S72°01'51"W
L44	13.00	S17°58'09"E
L47	4.99	N15°16'12"W
L49	61.04	N3°13'14"W
L51	3.90	N58°32'34"W
L54	18.19	N0°25'49"E
L55	20.00	N89°34'11"W
L56	12.00	N0°25'49"W
L57	20.00	S89°34'11"E
L58	17.35	N0°25'49"E
L61	13.40	S15°28'42"W
L62	25.00	S74°31'18"E
L63	11.68	N15°28'42"E
L66	61.04	S3°13'14"E
L68	4.50	S15°16'12"E
L71	19.64	N89°34'11"W
L72	28.00	S0°25'49"W
L73	5.00	S89°34'11"E
L75	23.00	S0°25'49"W
L76	11.64	S89°34'11"E
L78	23.01	N10°39'15"W
L82	2.03	S16°51'56"E
L84	61.99	N72°01'51"E
L85	5.00	N17°58'09"W
L87	10.48	N72°01'51"E
L95	21.96	N78°43'30"W
L96	17.50	S11°16'30"W
L97	58.00	N78°43'30"W
L98	17.50	N11°16'30"E
L99	11.83	N78°43'30"W
L100	9.75	S3°08'39"E
L101	17.50	N86°51'21"E
L102	31.00	S3°08'39"E
L103	17.53	S86°51'21"W
L104	19.86	S3°08'39"E
L105	5.85	S17°58'09"E
L106	123.44	N72°01'51"E
L107	39.47	N17°58'09"W

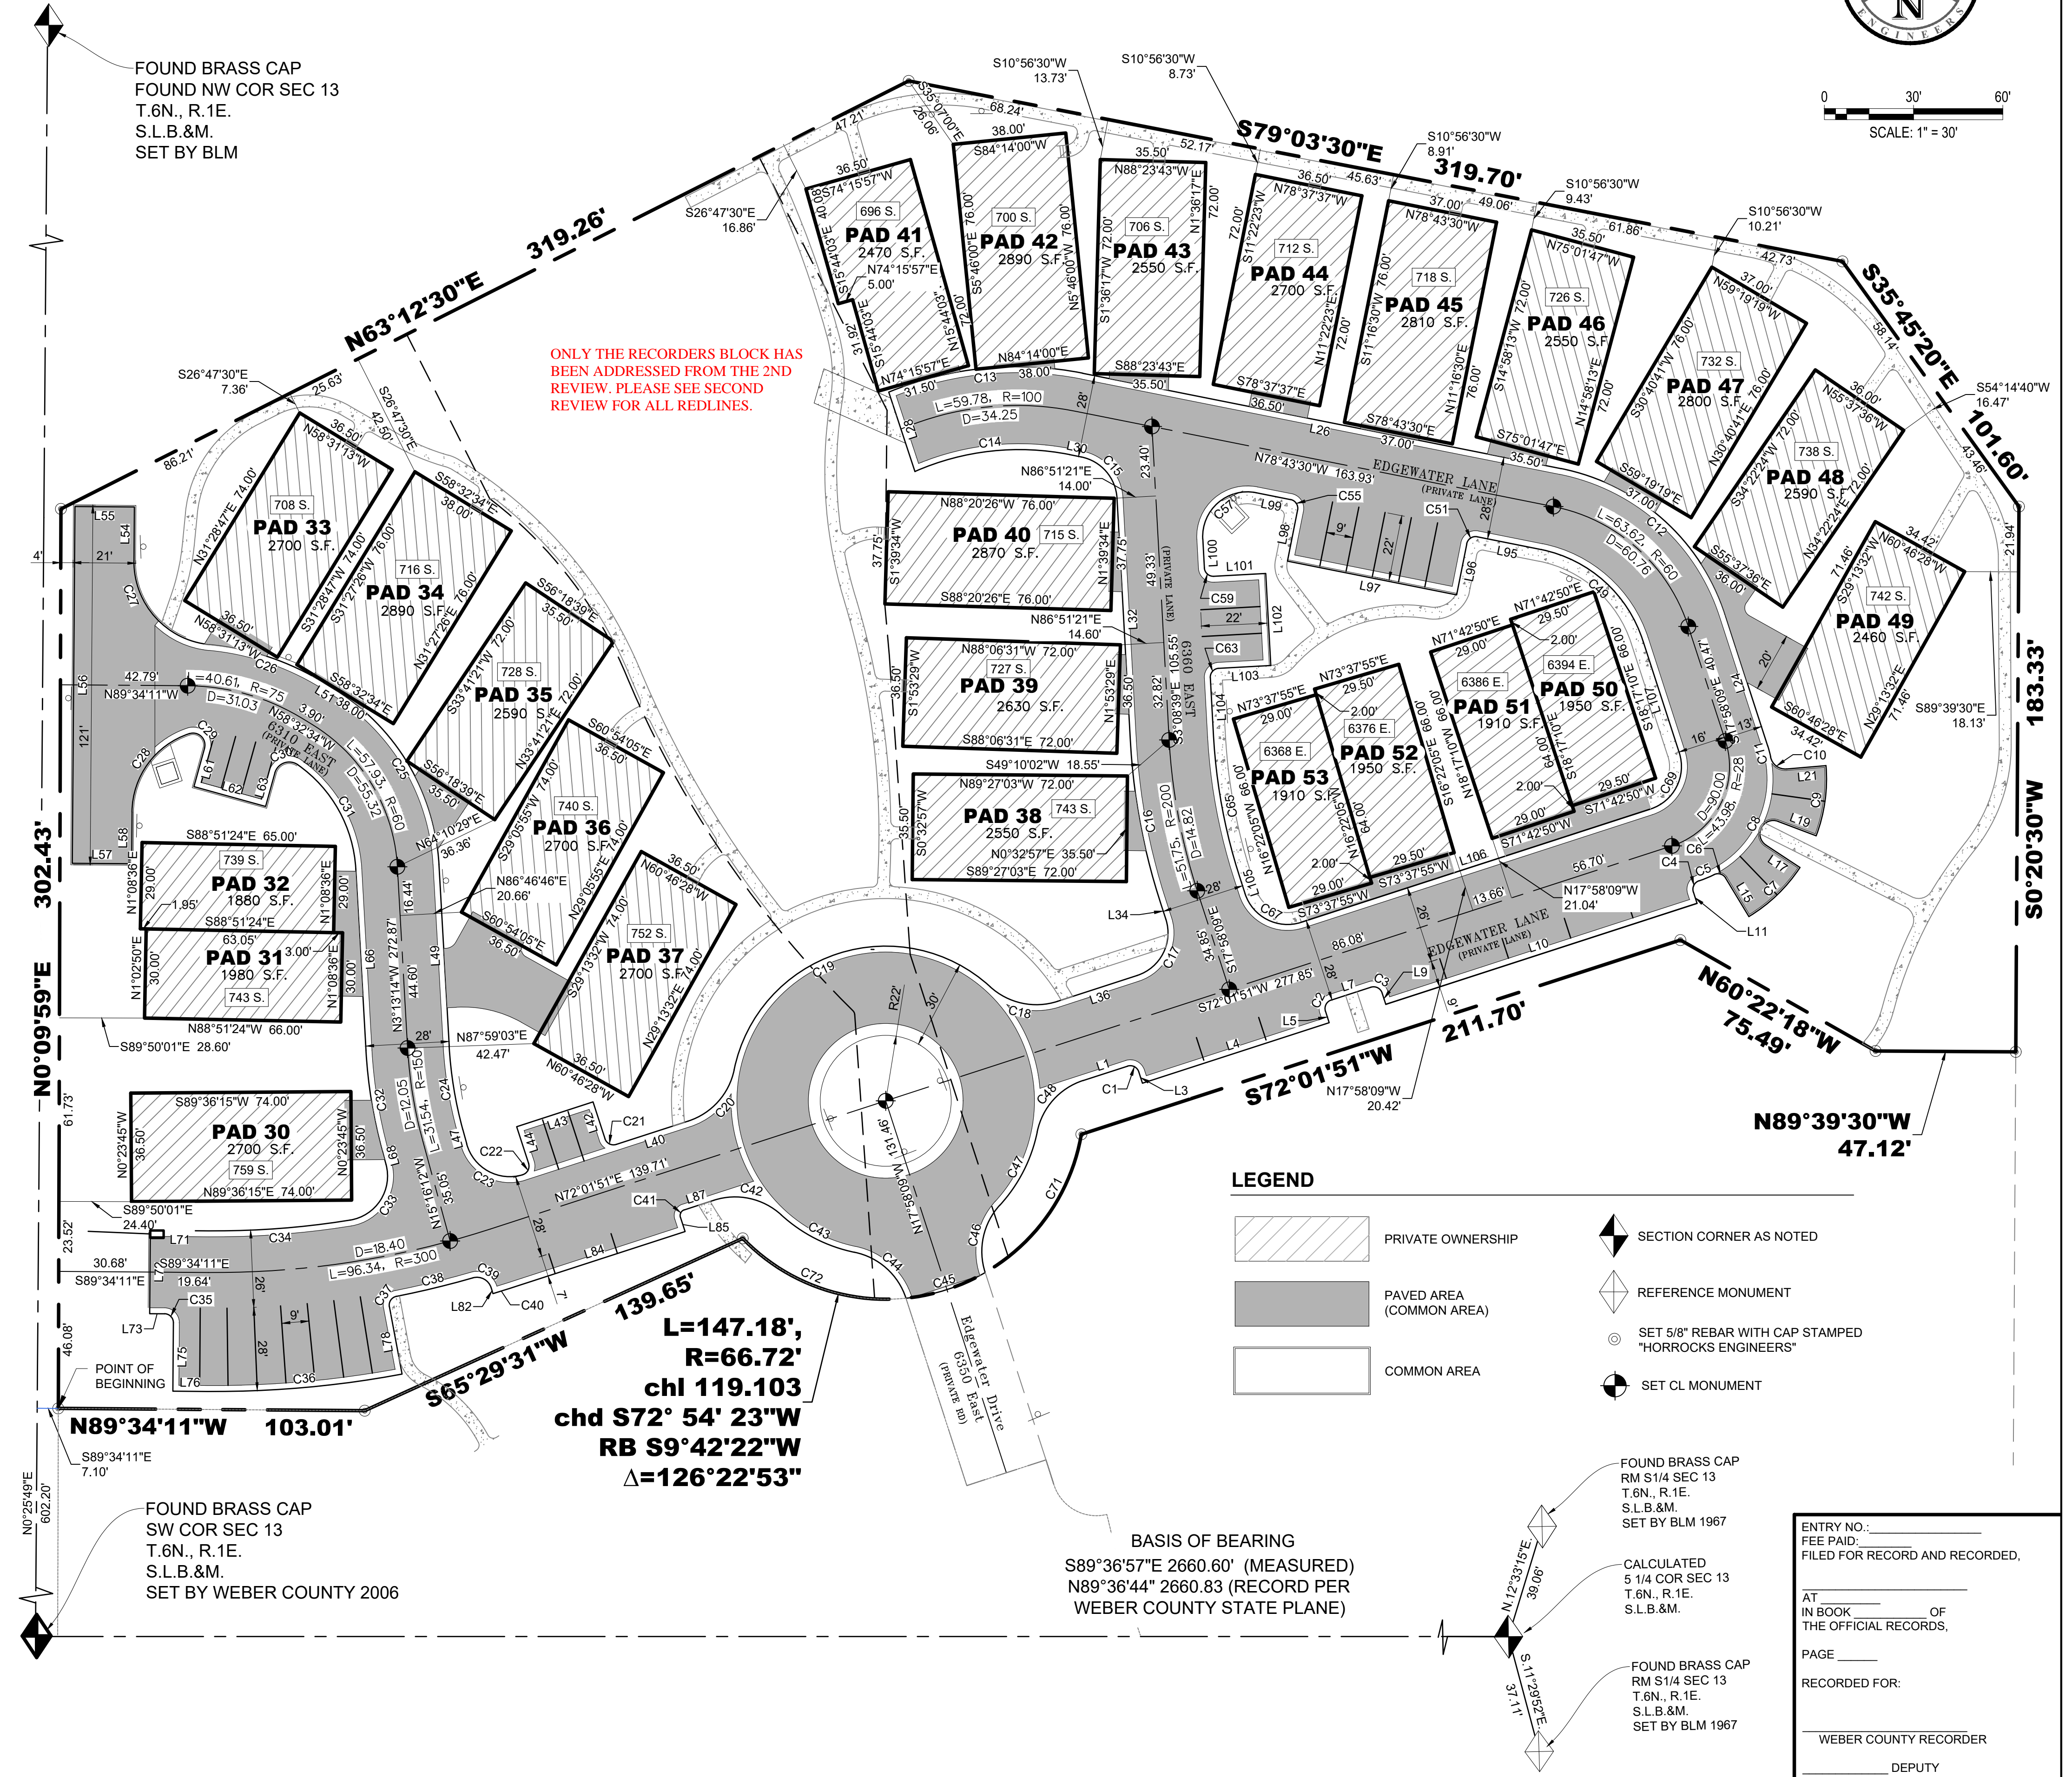

C:\Users\samban\appdata\local\temp\AspPublish\_14644\EDGEWATER PHASE 3 SET.dwg - PLAT 2 - 4/19/2018 12:24pm samb

