


February 08, 2019
Issued for Construction Rev 02

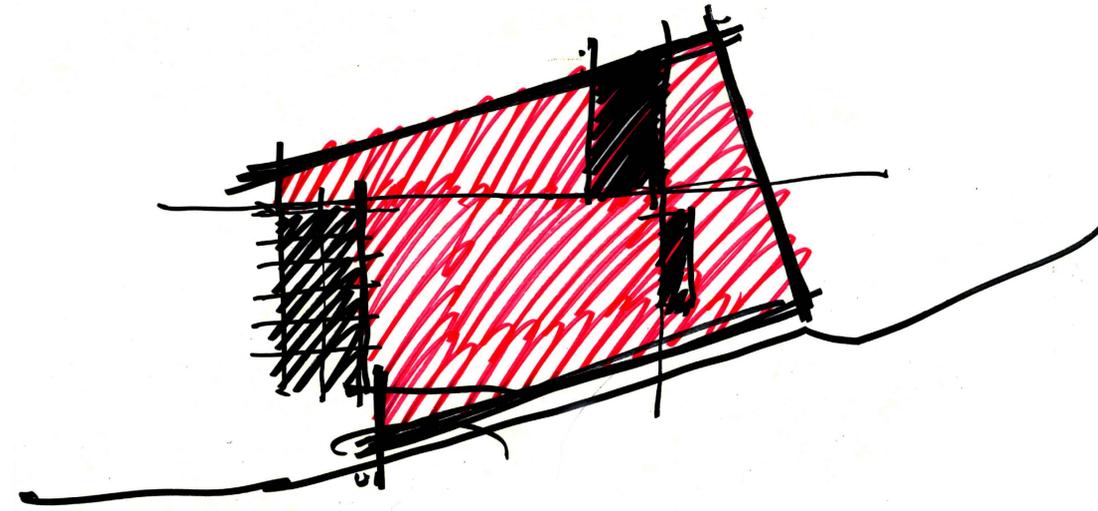

MacKay-Lyons Sweetapple
 Architects Limited
 2188 Gottingen Street
 Halifax, Nova Scotia Canada B3K 3B4
 ph: (902) 429-1867 fax: (902) 429-6276

Blackwell
 Structural Engineers
 19 Duncan Street, Suite 405
 Toronto, Ontario Canada M5H 3H1
 ph: (416) 593-5300 fax: (416) 593-4840

Talisman Civil Engineers
 Civil Engineers
 5217 S State St #200
 Murray, Utah, United States 84107
 ph: (801) 743-1300

IGES
 Geotechnical Engineers
 12429 South Street 300 East, Suite 100
 Draper, Utah, United States 84020-8770
 ph: (801) 748-4045

Edge Builders LLC
 Construction Management
 P.O. Box 17404,
 Salt Lake City, Utah, United States 84117
 ph: (801) 879-6200

CIVIL	ARCHITECTURAL	STRUCTURAL
C101 General Notes and Legend	A001 Partition Types	S-001 General Notes
C201 Site and Utility Plan	A002 Key Plan, Abbreviations, Schedules	S-002 General Notes Cont'd
C202 Horizontal Control Plan	A100 Site Plan	S-003 Typical Details
C301 Grading Plan	A201 Level 1 & 2 Floor Plans	S-004 Typical Details Continued
C601 Erosion Control Plan	A202 Level 3 & 4 Floor Plans	S-100 Foundation Plan
C701 Details	A300 Exterior Elevations	S-101 Level 2 Framing Plan
	A301 Exterior Elevations	S-102 Level 3 Framing Plan
	A400 Building Sections	S-103 Level 4 Framing Plan
	A401 Building Sections	S-104 Roof Framing Plan
	A500 Plan Details	S-105 Column Schedule
	A510 Section Details	S-200 Steel Elevations
	A511 Section Details	S-201 Steel Elevations Cont'd
	A600 Millwork - Ground Floor	S-202 Steel Elevations Cont'd
	A601 Millwork - Second Floor	S-203 Steel Connections
	A602 Millwork - Third & Fourth Floor	S-204 Wood Shear Wall Elevations
	A603 Millwork - Fourth Floor	S-205 Wood Shear Wall Elevations
	A604 Millwork Details	S-300 Wall Sections
	A610 Stair	S-301 Foundation Sections
	A611 Stair	S-400 Framing Sections
	A800 Level 1 & 2 Electrical Plans	S-401 Framing Sections Cont'd
	A801 Level 3 & 4 Electrical Plans	S-402 Framing Sections Cont'd
	A802 Level 4 Electrical Plan	
	A900 Window/Door Schedule	

Lot 71R
 Village House
 Summit Powder Mountain
 8488 E. Spring Park
 Eden, UT
 84310

EROSION CONTROL GENERAL NOTES:

THE CONTRACTOR TO USE BEST MANAGEMENT PRACTICES FOR PROVIDING EROSION CONTROL FOR CONSTRUCTION OF THIS PROJECT. ALL MATERIAL AND WORKMANSHIP SHALL CONFORM TO WEBER COUNTY ORDINANCES AND ALL WORK SHALL BE SUBJECT TO INSPECTION BY THE COUNTY. ALSO, INSPECTORS WILL HAVE THE RIGHT TO CHANGE THE FACILITIES AS NEEDED.

CONTRACTOR SHALL KEEP THE SITE WATERED TO CONTROL DUST. CONTRACTOR TO LOCATE A NEARBY HYDRANT FOR USE AND TO INSTALL TEMPORARY METER. CONSTRUCTION WATER COSTS TO BE INCLUDED IN BID.

WHEN GRADING OPERATIONS ARE COMPLETED AND THE DISTURBED GROUND IS LEFT "OPEN" FOR 14 DAYS OR MORE, THE AREA SHALL BE FURROWED PARALLEL TO THE CONTOURS.

THE CONTRACTOR SHALL MODIFY EROSION CONTROL MEASURES TO ACCOMMODATE PROJECT PLANNING.

ALL ACCESS TO PROPERTY WILL BE FROM PUBLIC RIGHT-OF-WAYS.

THE CONTRACTOR IS REQUIRED BY STATE AND FEDERAL REGULATIONS TO PREPARE A STORM WATER POLLUTION PREVENTION PLAN AND FILE A "NOTICE OF INTENT" WITH THE UTAH DIVISION OF WATER QUALITY.

MAINTENANCE:

ALL BEST MANAGEMENT PRACTICES (BMP'S) SHOWN ON THIS PLAN MUST BE MAINTAINED AT ALL TIMES UNTIL VEGETATION IS RE-ESTABLISHED.

THE CONTRACTOR'S RESPONSIBILITY SHALL INCLUDE MAKING BI-WEEKLY CHECKS ON ALL EROSION CONTROL MEASURES TO DETERMINE IF REPAIR OR SEDIMENT REMOVAL IS NECESSARY. CHECKS SHALL BE DOCUMENTED AND COPIES OF THE INSPECTIONS KEPT ON SITE.

SEDIMENT DEPOSITS SHOULD BE REMOVED AFTER EACH RAINFALL. THEY MUST BE REMOVED WHEN THE LEVEL OF DEPOSITION REACHES APPROXIMATELY ONE-HALF THE HEIGHT OF BARRIER.

SEDIMENT TRACKED ONTO PAVED ROADS MUST BE CLEANED UP AS SOON AS PRACTICAL, BUT IN NO CASE LATER THAN THE END OF THE NORMAL WORK DAY. THE CLEAN UP WILL INCLUDE SWEEPING OF THE TRACKED MATERIAL, PICKING IT UP, AND DEPOSITING IT TO A CONTAINED AREA.

EXPOSED SLOPES:

ANY EXPOSED SLOPE THAT WILL REMAIN UNTOUCHED FOR LONGER THAN 14 DAYS MUST BE STABILIZED BY ONE OR MORE OF THE FOLLOWING METHODS:

- A) SPRAYING DISTURBED AREAS WITH A TACKIFIER VIA HYDROSEED
- B) TRACKING STRAW PERPENDICULAR TO SLOPES
- C) INSTALLING A LIGHT-WEIGHT, TEMPORARY EROSION CONTROL BLANKET

SCOPE OF WORK:

PROVIDE, INSTALL AND/OR CONSTRUCT THE FOLLOWING PER THE SPECIFICATIONS GIVEN OR REFERENCED, THE DETAILS NOTED, AND/OR AS SHOWN ON THE CONSTRUCTION DRAWINGS:

HATCHING INDICATES AREAS TO RECEIVE 4" TOPSOIL AND TO BE SEED FOR NATURAL REVEGETATION. AREAS RECEIVING SEEDING FOR NATURAL REVEGETATION ON SLOPES OF 3:1 OR STEEPER MUST BE COVERED WITH AN EROSION CONTROL BLANKET AFTER THE FINAL GRADING AND SEEDING ARE FINISHED. INSTALL NORTH AMERICAN GREEN SC-150 BLANKET OR APPROVED EQUAL. FOLLOW MANUFACTURER'S SPECIFICATIONS.


INSTALL INLET PROTECTION IN FORM OF CONCRETE BLOCKS / FILTER CLOTH / GRAVEL OR SILT SACK AT EXISTING AND PROPOSED CATCH BASINS AS SHOWN ON PLAN. SEE EROSION CONTROL DETAILS ON SHEET C701.

INSTALL SILT FENCE ALONG DOWN GRADIENT LIMITS OF DISTURBANCE AS SHOWN ON PLAN. SEE EROSION CONTROL DETAILS ON SHEET C701.

INSTALL ORANGE SAFETY FENCING AROUND OUTER LIMITS OF PROJECT PRIOR TO GRADING.

- SEED MIXTURE FOR REVEGETATION
- 40% MOUNTAIN BROME (*BROMUS MARGINATUS*)
 - 25% SLENDER WHEATGRASS (*ELYMUS TRACHYCAULUS* SPP. *TRACHYCAULUS*)
 - 5% SHEEP FESCUE (*FESTUCA OVINA* SPP. *DURIUSCULA*)
 - 5% ALPINE BLUEGRASS (*POA ALPINE*)
 - 25% THICKSPIKE WHEATGRASS (*ELYMUS LANCEOLATUS* SPP. *LANCEOLATUS*)

SEEDING RATE IS 40 POUNDS PER ACRE.

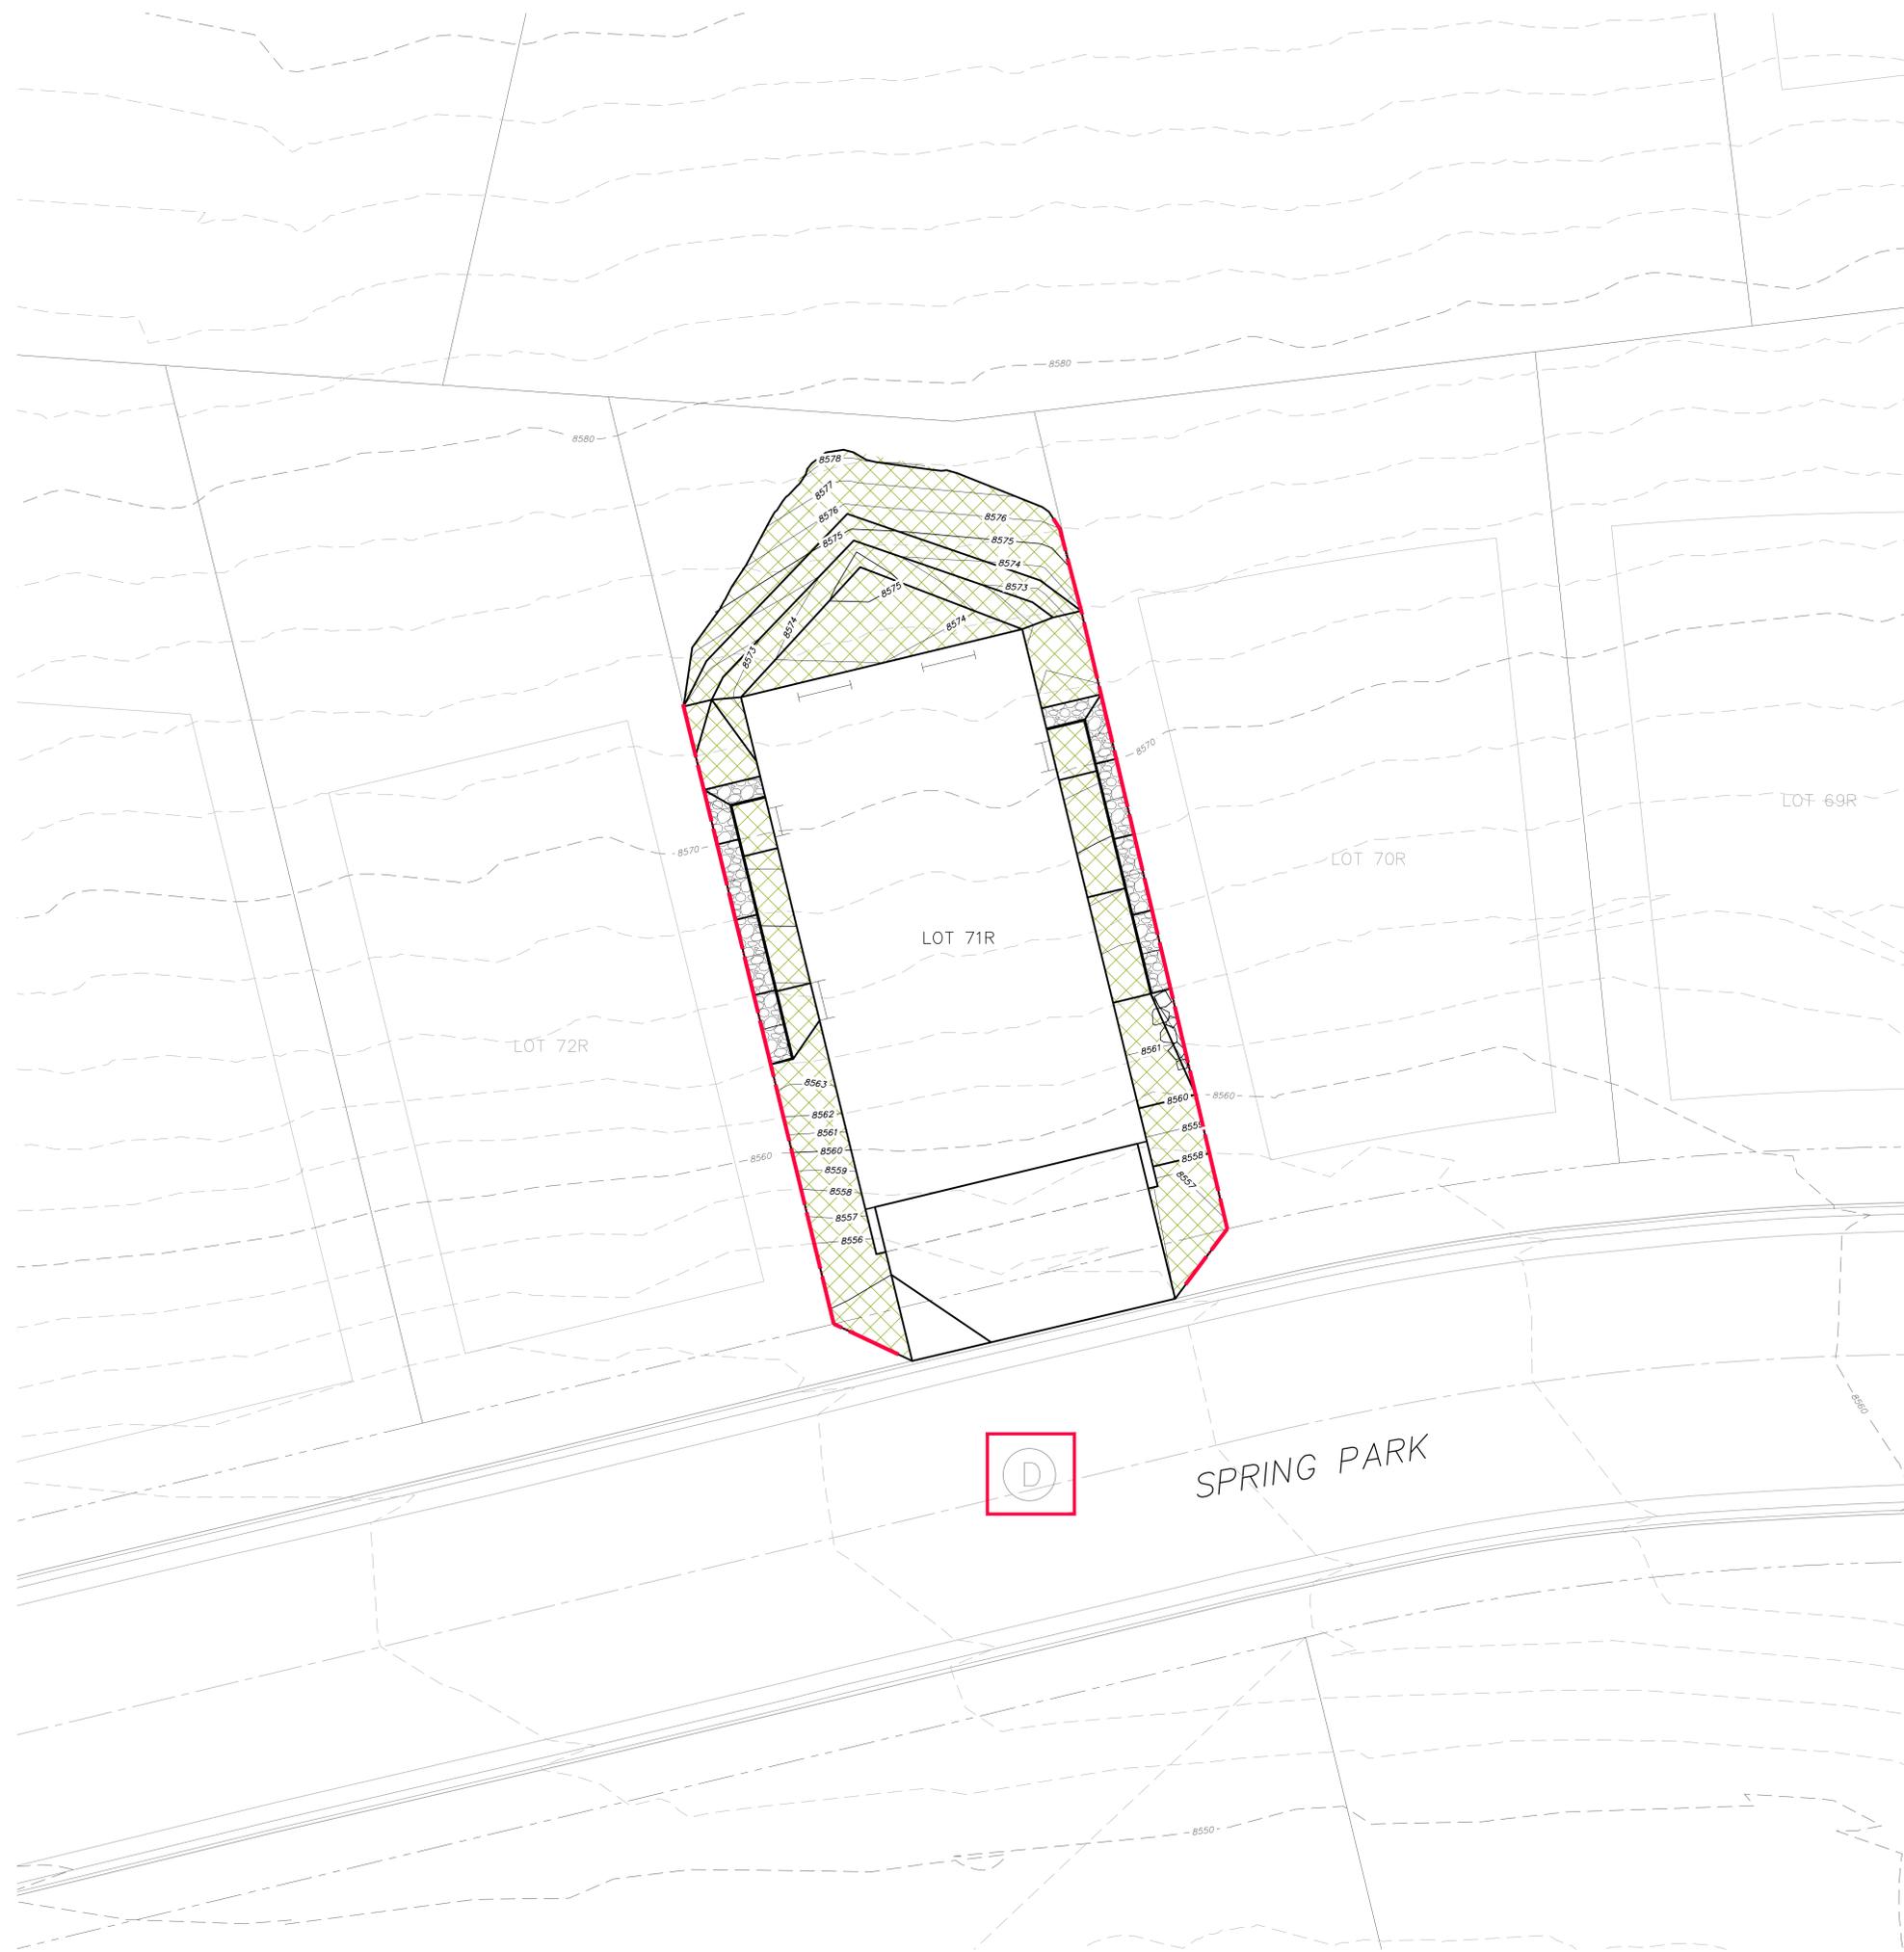

TALISMAN
CIVIL CONSULTANTS

5217 SOUTH STATES STREET
SUITE 200
MURRAY, UT 84107
801.743.1300

McKay Lynn
Sweeney
Architects
Limited

2198 Colquhoun Dr.
Heber, Utah 84304
Canada (313) 384

ph: (802) 429 1807
fax: (802) 429 6276



No.	Description	Date

NOTES:

COPYRIGHT RELATED TO THE USE OF THIS DRAWING:
The use of this drawing shall be governed by standard copyright law as generally accepted in architectural practice.

ARCHITECT'S REQUIREMENTS AND APPROVALS:
It is the Builder's responsibility to notify McKay Lynn Sweeney Architects Ltd. and to seek prior written approval for materials and workmanship which deviates from instructions provided by the Architect.

ENGINEER'S REQUIREMENTS AND APPROVALS:
It is the Builder's responsibility to notify McKay Lynn Sweeney Architects Ltd. and to seek prior written approval for materials and workmanship which deviates from instructions provided by the Engineer.

AUTHORITY'S REQUIREMENTS AND APPROVALS:
All materials and workmanship must comply with the requirements of all authorities having jurisdiction over the work. It is the Builder's responsibility to gain necessary approval from all relevant Authorities.

DIMENSIONS:
All dimensions must be verified on site. Do not scale off drawings. Plans take precedent over elevations. In the absence of dimensions, all dimensions shall be as shown on drawings. All minimum dimensions are to comply with the International Building Code, 2009 Edition.

SHOP DRAWINGS:
Submit shop drawings to the Architect and Engineer for approval prior to installation of prefabricated elements of the building.

Scale: 1"=10'

Date: 06/28/18

Drawn by: JLB

Checked by: RWC

Project No.: C601



Silt fence

- GENERAL**
 - Description. A temporary sediment barrier consisting of a filter fabric stretched across and attached to supporting posts and entrenched.
 - Application. To intercept sediment from disturbed areas of limited extent.
 - Perimeter Control. Place barrier at down gradient limits of disturbance.
 - Sediment Barrier. Place barrier at toe of slope or soil stockpile.
 - Protection of Existing Waterways. Place barrier at top of stream bank.
 - Inlet Protection.
- PRODUCTS**
 - Fabric. Synthetic filter fabric shall be a pervious sheet of polypropylene, nylon, polyester, or polyethylene yarn. Synthetic filter fabric shall contain ultraviolet ray inhibitors and stabilizers to provide a minimum of 6 months of expected usable construction life at a temperature range of 0 deg F to 120 deg F.
 - Burlap. 10 ounces per square yard of fabric.
 - Posts. Either 2" x 4" diameter wood, or 1.33 pounds per linear foot steel with a minimum length of 5 feet, or steel posts with projections for fastening wire to them.
- EXECUTION**
 - Cut the fabric on site to desired width, unroll, and drape over the barrier. Secure the fabric toe with rocks or dirt and secure the fabric to the mesh with twin, staples or similar devices.
 - When attaching two silt fences together, place the end post of the second fence inside the end post of the first fence. Rotate both posts at least 180 degrees on a clockwise direction to create a tight seal with the filter fabric. Drive both posts into the ground and bury the flap.
 - When used to control sediments from a steep slope, place silt fences away from the toe of the slope for increased holding capacity.
 - Maintenance.
 - Inspect immediately after each rainfall and at least daily during prolonged rainfall.
 - Should the fabric on a silt fence or filter barrier decompose or become ineffective before the end of the expected usable life and the barrier still be necessary, replace the fabric promptly.
 - Remove sediment deposits after each storm event. They must be removed when deposits reach approximately one-half the height of the barrier.
 - Re-anchor fence as necessary to prevent shortcutting.
 - Inspect for runoff bypassing ends of barriers or undercutting barriers.

Inlet protection - fence or straw bale

- GENERAL**
 - Description. A temporary sediment barrier around storm drain inlet.
 - Application. At inlets in paved or unpaved areas where up gradient area is to be disturbed by construction activities.
- PRODUCT** (Not used)
- EXECUTION**
 - Installation and application criteria.
 - Provide up gradient sediment controls, such as silt fence during construction of inlet.
 - When construction of inlet is complete erect straw bale barrier, silt fence or other approved sediment barrier surrounding perimeter of inlet.
 - Install filter fabric completely around grate.
 - Maintenance.
 - Inspect inlet protection after every large storm event and at a minimum of once monthly.
 - Remove sediment accumulated when it reaches 4-inches in depth.
 - Repair or re-align barrier or fence as needed.
 - Look for bypassing or undercutting and re-compact soil around barrier or fence as required.

Sewer lateral connection

- GENERAL**
 - Before installation, secure acceptance by ENGINEER for all pipe, fittings, and couplings to be used.
 - Before backfilling, secure inspection of installation by ENGINEER. Give at least 24 hours notice.
 - Verify if CONTRACTOR or agency is to install the wye.
- PRODUCTS**
 - Base Course: Untreated base course, APWA Section 32 11 23. Do not use gravel as a base course without ENGINEER'S permission.
 - Backfill: Common fill, APWA Section 31 05 13. Maximum particle size 2-inches.
 - Provide agency approved wye or tee with appropriate donut.
 - Stainless steel straps required.
- EXECUTION**
 - Tape wrap pipe as required by soil conditions.
 - Remove core plug from sewer main. Do not break into sewer main to make connection.
 - Base Course and Backfill Placement: Maximum lift thickness is 8-inches before compaction. Compaction is 95 percent or greater relative to a standard proctor density, APWA Section 31 23 26.


3/4" and 1" meter

- GENERAL**
 - In street surfaces or other vehicular traffic areas (like driveway approaches), install the same type of meter box as required for 1 1/2" and 2" service meters. See Plan 522.
 - Before backfilling, secure inspection of installation by ENGINEER.
- PRODUCTS**
 - Base Course: Untreated base course, APWA Section 32 11 23. Do not use gravel as a base course without ENGINEER'S permission.
 - Backfill: Common fill, APWA Section 31 05 13. Maximum particle size 2-inches.
 - Castings: Grey iron class 35 minimum per ASTM A 48, coated with asphalt based paint or better.
- EXECUTION**
 - Meter Placement:
 - All meters are to be installed in the park strip or within 7 feet of the property line (street side).
 - Do not install meters under driveway approaches, sidewalks, or curb and gutter.
 - Meter Box. Set box so grade of the frame and cover matches the grade of the surrounding surface.
 - Pipe Outside of Right-of-Way: Coordinate with utility agency or adjacent property owner for type of pipe to be used outside of right-of-way.
 - Inspection: Before backfilling around meter box, secure inspection of installation by ENGINEER.
 - Base Course and Backfill Placement: Compaction is 95 percent or greater relative to a modified proctor density, APWA Section 31 23 26. Maximum lift thickness before compaction is 8-inches.

Cover collar for water valve box


- GENERAL**
 - In a pavement surface, fill an annular space around a frame and cover casting with concrete. The concrete will support the casting under traffic loadings.
- PRODUCTS**
 - Base Course: Untreated base course, APWA Section 32 11 23. Do not use gravel as a base course without ENGINEER'S permission.
 - Concrete: Class 4000, APWA Section 03 30 04.
 - Concrete Curing Agent: Type 10 Class A (clear with fugitive dye), membrane forming compound, APWA Section 03 39 00.
- EXECUTION**
 - Base Course: Maximum lift thickness is 8-inches before compaction. Compaction is 95 percent or greater relative to a modified proctor density, APWA Section 31 23 26.
 - Pavement Preparation: Provide a neat vertical and concentric joint between concrete collar and existing asphalt concrete surface. Clean edges of all dirt, oil, and loose debris.

NARRATIVE: THIS PLAN MAY BE USED FOR THE CONSTRUCTION OF A STORM WATER BEST MANAGEMENT PRACTICE (BMP). IT IS NOT INCLUSIVE OF ALL PRACTICES AVAILABLE AND IS ONLY SPECIFIC TO THE CONSTRUCTION OF THIS TYPE. MAINTENANCE OF THIS TYPE OF INSTALLATION IS IMPORTANT AND SHOULD BE CONTINUOUSLY MONITORED BY THE CONTRACTOR AND ENGINEER. DETAILS SHOWN HERE HIGHLIGHT IMPORTANT PARTS OF CONSTRUCTION, AND SHOULD BE MODIFIED AS NEEDED.

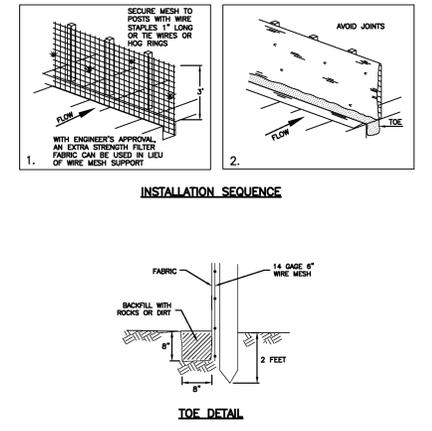


Silt fence Plan 122
February 2008 7


NARRATIVE: THIS PLAN MAY BE USED FOR THE CONSTRUCTION OF A STORM WATER BEST MANAGEMENT PRACTICE (BMP). IT IS NOT INCLUSIVE OF ALL PRACTICES AVAILABLE AND IS ONLY SPECIFIC TO THE CONSTRUCTION OF THIS TYPE. MAINTENANCE OF THIS TYPE OF INSTALLATION IS IMPORTANT AND SHOULD BE CONTINUOUSLY MONITORED BY THE CONTRACTOR AND ENGINEER. DETAILS SHOWN HERE HIGHLIGHT IMPORTANT PARTS OF CONSTRUCTION, AND SHOULD BE MODIFIED AS NEEDED.

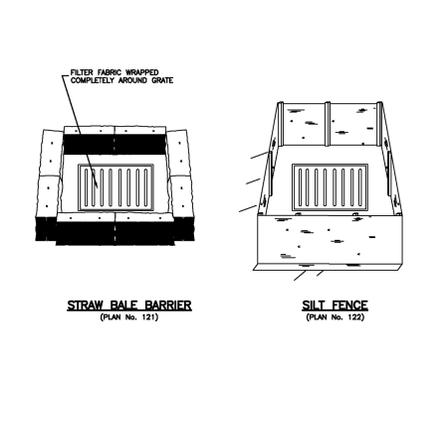


Inlet protection - fence or straw bale Plan 124
February 2008 15

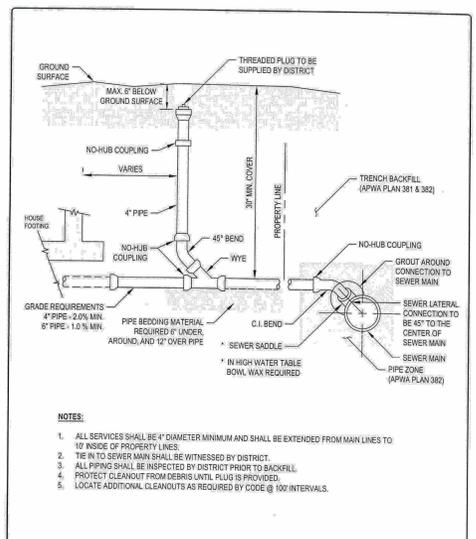


SEWER LATERAL CONNECTION PLAN NO. 431S

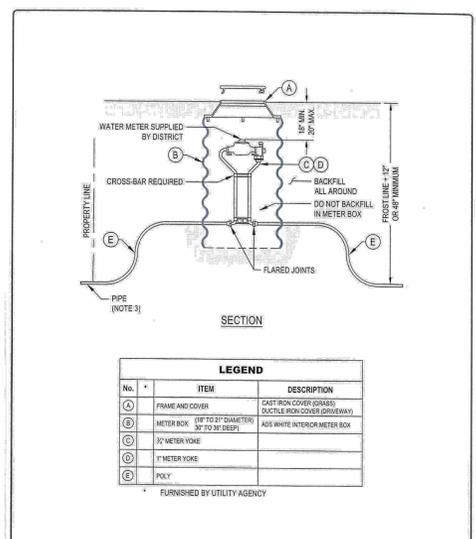


3/4" AND 1" METER PLAN NO. 521S

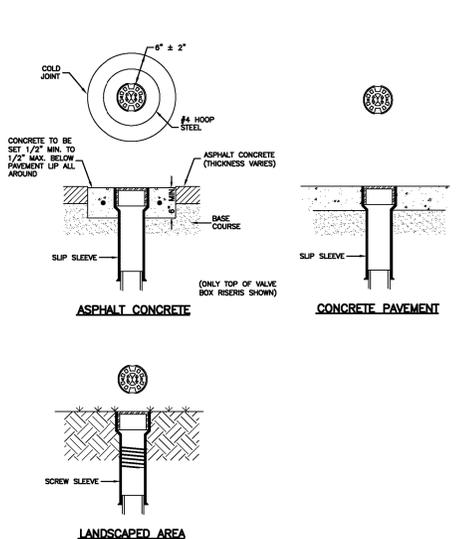

Cover collar for water valve box Plan 574
August 2010 277

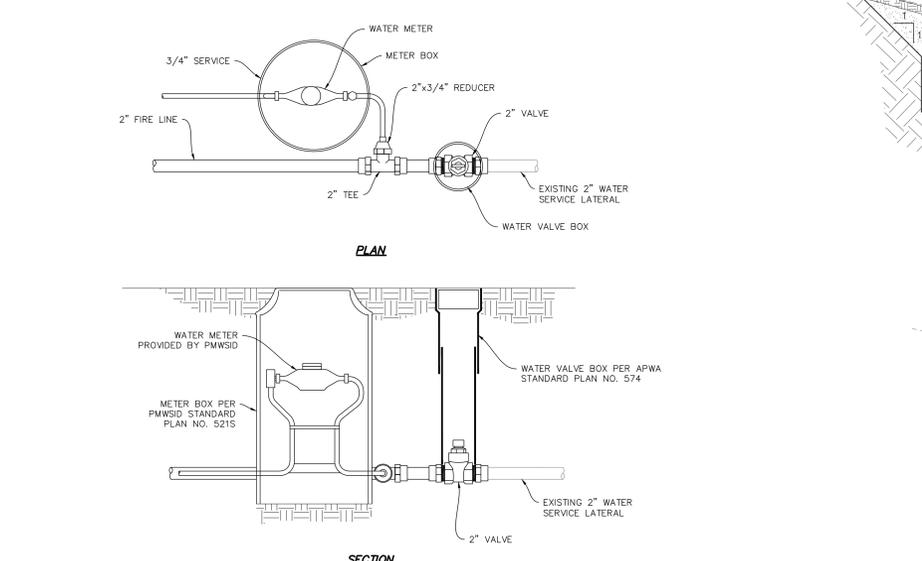

FIRE LINE AND WATER METER DETAIL NTS

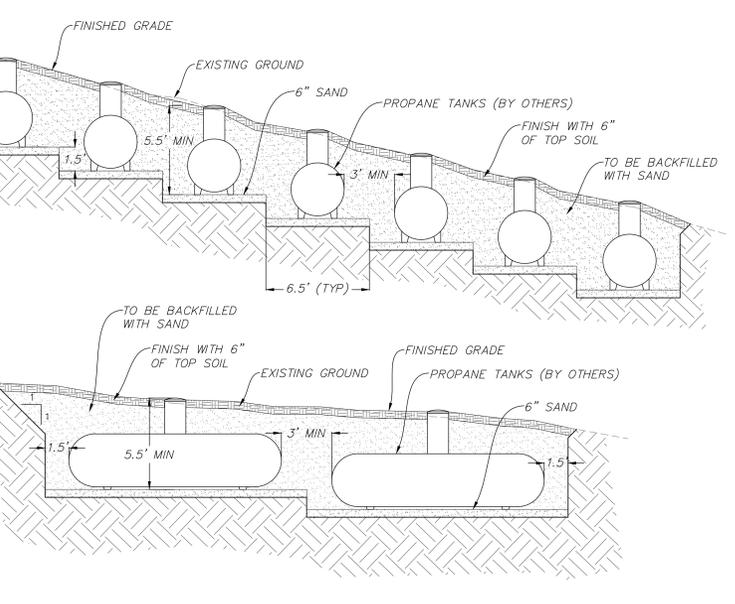

PROPANE TANK PIT TYPICAL DETAIL NTS



CONCRETE DRIVEWAY PAVEMENT SECTION NTS



NOTES:

COPYRIGHT RELATED TO THE USE OF THIS DRAWING:
The use of this drawing shall be governed by standard copyright law as generally accepted in architectural practice.

ARCHITECT'S REQUIREMENTS AND APPROVALS:
It is the Architect's responsibility to notify Mackay-Lyons Sweetapple Architects Ltd. and to seek prior written approval for materials and workmanship which deviates from instructions provided by the Architect.

ENGINEER'S REQUIREMENTS AND APPROVALS:
It is the Engineer's responsibility to notify Mackay-Lyons Sweetapple Architects Ltd. and to seek prior written approval for materials and workmanship which deviates from instructions provided by the Engineer.

AUTHORITY'S REQUIREMENTS AND APPROVALS:
All materials and workmanship must comply with the requirements of all authorities having jurisdiction over the work. It is the Builder's responsibility to gain necessary approval from all relevant Authorities.

DIMENSIONS:
All dimensions must be verified on site. Do not scale off drawings. Plans take precedence over elevations. In the absence of dimensions, all dimensions shall be as shown on the drawings. All minimum dimensions are to comply with the International Building Code, 2009 Edition.

SHOP DRAWINGS:
Submit shop drawings to the Architect and Engineer for approval prior to manufacture of prefabricated elements of the building.

Details

scale: N/A
date: 10/22/2017
drawn: J.B.
checked: R.W.C.

C701

TYPE	INTERIOR WALL TYPE DESCRIPTION
P1	+ 1/2" GWB to u/s of structure, PTD + 2x4 studs on a common 2x6 plate @ 16" o.c. + acoustic batt to fill cavity + 1/2" GWB to u/s of structure, PTD
P2	+ 1/2" GWB to u/s of structure, PTD + 2x6 studs @ 16" o.c. + 5 1/2" acoustic batt in cavity + 1/2" GWB to u/s of structure, PTD
P3	+ 1/2" GWB to u/s of structure, PTD + 2x6 studs @ 16" o.c. + 1/2" GWB to u/s of structure, PTD
P4	+ 1/2" GWB to u/s of structure, PTD + 2x4 studs @ 16" o.c. + 1/2" GWB to u/s of structure, PTD
P5	+ tile TBD + 5/8" tile backer board to u/s of structure + 2x4 studs @ 16" o.c. + 3 1/2" acoustic batt in cavity + 1/2" GWB to u/s of structure, PTD
P6	+ tile TBD + 5/8" tile backer board to u/s of structure + 2x4 studs on common 2x6 plate @ 16" o.c. + 5 1/2" acoustic batt in cavity + 5/8" tile backer board to u/s of structure + tile TBD
P7	+ tile TBD + 5/8" tile backer board to u/s of structure + 2x6 studs @ 16" o.c. + 5 1/2" acoustic batt in cavity + 1/2" GWB to u/s of structure, PTD
P8	+ 1/2" GWB, PTD + 1/2" plywood, as per structural + 2x6 studs @ 16" o.c. + furring as req'd. + 1/2" GWB + Backsplash, refer to spec

Floor Assembly Type 4 System Components: <ul style="list-style-type: none"> min. 4" reinforced concrete slab on grade as per structural, slope min. 2% to drain, refer to finish schedule for finish 10 mil. poly underslab vapor retarder (seal all joints) 2" XPS rigid insulation (R10) 6" compacted gravel base 	
Floor Assembly Type 5 System Components: <ul style="list-style-type: none"> Thinslet tile TBC Anti-fracture membrane, TBC 1 1/2" gyp-crete over-pour w/ in-floor heating, refer to specification 3/4" sheathing as per structural 14" I-Joists, refer to structural Acoustic insulation Furring as req'd. 5/8" gypsum, ceiling finish as noted 	
Floor Assembly Type 6 System Components: <ul style="list-style-type: none"> Thinslet tile Anti-fracture membrane 1 1/2" gyp-crete over-pour w/ in-floor heating, refer to specification 3/4" sheathing, refer to structural 14" I-Joists, refer to structural 5/8" gypsum, ceiling finish as noted 	
Floor Assembly Type 7 System Components: <ul style="list-style-type: none"> 2" concrete topping w/ in-floor heating, refer to specification 10 mil. vapor retarder (seal all joints) 2" XPS rigid insulation (R10) 4" reinforced concrete slab on grade as per structural 6" compacted gravel base 	
Floor Assembly Type 8 System Components: <ul style="list-style-type: none"> Thinslet tile TBC Ditra-heat Schluter assembly, refer to specification Over-pour to achieve slope 3/4" sheathing as per structural 14" I-Joists, refer to structural Acoustic insulation 5/8" gypsum, ceiling finish as noted 	
Floor Assembly Type 9 System Components: <ul style="list-style-type: none"> Thinslet tile TBC Ditra-heat Schluter assembly, refer to specification Over-pour to achieve slope 3/4" sheathing as per structural 14" I-Joists, refer to structural Acoustic insulation Furring as req'd 5/8" gypsum, ceiling finish as noted 	

EXTERIOR ROOF TYPE DESCRIPTION	
Roof Assembly Type 1 (Sloped Roof) System Components: <ul style="list-style-type: none"> Snow retention system, refer to spec. Standing-seam metal roofing system (Class A roof covering), refer to specification 2 layers of alternating 1x4 strapping 2" vapor-open mineral wool insulation board (R8), refer to specification Vapor open roof membrane, refer to spec 3/4" exterior grade sheathing as per structural 14" I-Joists, refer to structural 6" 2lb. closed-cell sprayfoam insulation (R36) Furring as req'd 5/8" gypsum board, painted finish 	
Roof Assembly Type 2 System Components: <ul style="list-style-type: none"> Concrete paver, refer to specification (Class A roof covering) Pedestal system, refer to specification PVC low-slop roofing membrane (Class A roof covering) Tapered insulation sloped to drain 1-1/2" XPS insulation (R7.5) Self-adhered air/vapor barrier 3/4" exterior grade sheathing as per structural 11 7/8" I-Joists, refer to structural 6" 2lb. closed-cell sprayfoam insulation (R36) Furring as req'd 5/8" gypsum board, painted finish 	
EXTERIOR WALL TYPE DESCRIPTION	
Exterior Wall Assembly 1 System Components: <ul style="list-style-type: none"> Metal cladding system, refer to specification 2 layers alternating 2x4 strapping 2" vapor-open mineral wool insulation board (R8), refer to specification Self-adhered vapor-open air barrier, refer to specification 1/2" exterior grade sheathing as per structural 2x6 wood studs as per structural 5" 2lb. closed-cell sprayfoam cavity insulation (R30) 2x4 stud wall, hold stud wall 1" from conc. wall below 1/2" gypsum board, painted finish 	
Exterior Wall Assembly 2 System Components: <ul style="list-style-type: none"> Metal cladding system, refer to specification 2 layers alternating 2x4 strapping 2" vapor-open mineral wool insulation board (R8), refer to specification Self-adhered vapor-open air barrier, refer to specification 1/2" exterior grade sheathing as per structural 2x6 wood studs as per structural 5" 2lb. closed-cell sprayfoam cavity insulation (R30) 1/2" gypsum board, painted finish 	
Exterior Wall Assembly 3 System Components: <ul style="list-style-type: none"> Metal Composite panel TBC Vertical strapping 1-1/4" vapor-open mineral wool insulation board (R5), refer to specification self-adhered vapor-open air barrier, refer to specification 1/2" exterior grade gypsum sheathing 2x6 wood studs as per structural 5" 2lb. closed-cell sprayfoam cavity insulation (R30) 1/2" exterior grade sheathing as per structural 1/2" gypsum board, painted finish 	

Exterior Wall Assembly 5 System Components: <ul style="list-style-type: none"> Reinforced boardform concrete wall as per structural 4-1/2" 2lb. closed-cell spray foam insulation (R27) 2x4 stud wall, hold stud wall 1" from conc. wall below 1/2" gypsum board, painted finish 	
Exterior Wall Assembly 6 System Components: <ul style="list-style-type: none"> Standing-seam metal cladding system, refer to specification 2 layers of alternating 1x4 strapping 2" vapor-open mineral wool insulation board (R8), refer to specification Vapor-open roof membrane, refer to specification 3/4" exterior grade sheathing as per structural 2x6 wood studs as per structural 5" 2lb. closed-cell spray foam insulation (R30) 1/2" gypsum board, painted finish 	
Exterior Wall Assembly 7 System Components: <ul style="list-style-type: none"> Aluminum panel, refer to specification 1x4 vertical strapping Vapor-open roof membrane, refer to specification 3/4" exterior grade sheathing as per structural 2x6 wood studs as per structural 4" 2lb. closed-cell spray foam insulation (R24) 1/2" gypsum board, painted finish 	
Foundation Wall Assembly 1 System Components: <ul style="list-style-type: none"> 6" gravel backfill Foundation waterproofing system, refer to specification Reinforced concrete boardform foundation wall as per structural 4 1/2" 2lb. closed cell sprayfoam insulation (R27) 2x4 studs wall, hold stud wall 1" from wall and insulate behind 1/2" gypsum board, painted finish 	
Foundation Wall Assembly 2 System Components: <ul style="list-style-type: none"> 6" gravel backfill Foundation waterproofing system, refer to specification Reinforced boardform concrete foundation wall as per structural 	

FLOOR TYPE DESCRIPTION	
Floor Assembly Type 1 System Components: <ul style="list-style-type: none"> Thinslet tile, refer to specification 4" reinforced concrete slab on grade as per structural w/ hydronic in-floor heating system, refer to finish schedule for finish 10 mil. poly under slab vapor retarder (seal all joints) 2" XPS rigid insulation (R10) 6" compacted gravel base 	
Floor Assembly Type 2 System Components: <ul style="list-style-type: none"> Thinslet tile, refer to specification Anti-fracture membrane, refer to specification 1 1/2" gyp-crete over-pour w/ in-floor heating, refer to specification 3/4" sheathing as per structural 14" I-Joists, refer to structural Acoustic insulation, refer to specification 5/8" gypsum, ceiling finish as noted 	
Floor Assembly Type 3 - 1 HR FRR Required System Components: <ul style="list-style-type: none"> Thinslet tile TBC Anti-fracture membrane, TBC 1 1/2" gyp-crete over-pour w/ hydronic in-floor heating, refer to specification 3/4" plywood sub floor as per structural 14" I-Joists, refer to structural 6" 2lb. closed cell spray foam insulation (R36) 5/8" Type X Exterior Grade Gypsum sheathing Strapping as required Metal composite panel TBD 	

Floor Assembly Type 8 System Components: <ul style="list-style-type: none"> Thinslet tile TBC Ditra-heat Schluter assembly, refer to specification Over-pour to achieve slope 3/4" sheathing as per structural 14" I-Joists, refer to structural Acoustic insulation 5/8" gypsum, ceiling finish as noted 	
Floor Assembly Type 9 System Components: <ul style="list-style-type: none"> Thinslet tile TBC Ditra-heat Schluter assembly, refer to specification Over-pour to achieve slope 3/4" sheathing as per structural 14" I-Joists, refer to structural Acoustic insulation Furring as req'd 5/8" gypsum, ceiling finish as noted 	

Exterior Wall Assembly 4 <p style="text-align: center; font-size: 2em; font-weight: bold;">NOT USED</p>	
---	--

1 A001	Partition Type Legend Scale 1 1/2" = 1'-0"
-----------	--

Lot 71R
Village House

Summit Powder Mountain
Evan, Utah

MackKay-Lyons
Sweetapple
Architects
Limited

2188 Göttingen St.
Halifax, Nova Scotia
Canada B3K 3B4

ph: (902) 429.1867
fax: (902) 429.6276

STATE OF UTAH

Brian MackKay-Lyons

No. 9809836

LICENSED ARCHITECT

No.	Description	Date
5	IFC Rev 02	2019.02.08
4	IFC Rev 01	2018.06.29
3	Issued for Construction	2018.03.13
2	Issued for Tender	2017.12.22
1	for coordination	2017.12.1

Revision:

NOTES:

COPYRIGHT RELATED TO THE USE OF THIS DRAWING:
The use of this drawing shall be governed by standard copyright law as generally accepted in architectural practice.

ARCHITECT'S REQUIREMENTS AND APPROVALS:
It is the Builder's responsibility to notify MackKay-Lyons Sweetapple Architects Ltd. and to seek prior written approval for materials and workmanship which deviates from instructions provided by the Architect.



ENGINEER'S REQUIREMENTS AND APPROVALS:
It is the Builder's responsibility to notify MackKay-Lyons Sweetapple Architects Ltd. and to seek prior written approval for materials and workmanship which deviates from instructions provided by the Engineer.

AUTHORITIES' REQUIREMENTS AND APPROVALS:
All materials and workmanship must comply with the requirements of all authorities having jurisdiction over the work. It is the Builder's responsibility to gain necessary approval from all relevant Authorities.

DIMENSIONS:
All dimensions must be verified on site. Do not scale off drawings. Plans take precedent over elevations. In the absence of dimensions, or if discrepancies exist, consult Architect. All minimum dimensions are to comply with the International Residential Code.

SHOP DRAWINGS:
Submit shop drawings to the Architect and Engineer for approval prior to manufacture of prefabricated elements of the building.

Partition Types	A001
scale: as noted date: 17-11-23 drawn: WPI/RD ch'g'd: BML	

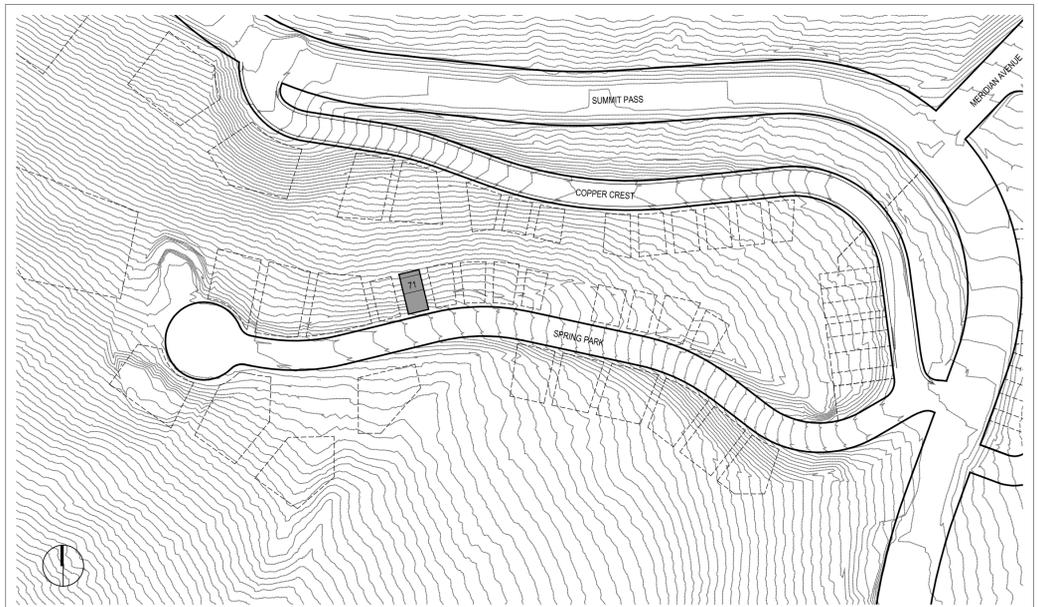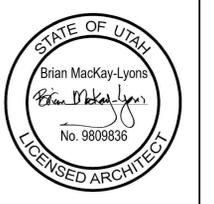

5
A002 Key Plan
NTS

Room	Mark	Fixture	Manufacturer	Model
KITCHEN	1	Fridge	Thermador	T3688920S 36-inch built-in 2-door bottom freezer
	2	Dishwasher	Thermador	DWH440MPR
	3	Microwave	Thermador	MBES built-in microwave
	4	Oven	Thermador	ME30J5 30-inch built-in single oven
	7	Cooktop	Thermador	CT16SKM 36-inch induction cooktop
	10	Vent Hood	Thermador	VCM36IP 36-inch custom insert
	8	Dumb-waiter	Inclinor	Homewaiter
	MUD ROOM	5	Washer	Maytag
6		Dryer	Maytag	MGD8200FC
POWDER ROOM		Toilet	Duravit	Floor Standing Blissless #216709_92
		Sink	Catalano	Premium 60x47 #160VPOD
		Faucet	Hansgrohe	Talis S #32146001
BATHROOM 1-4		Toilet	Duravit	Floor Standing Blissless #216709_92
		Sink	Catalano	Premium 60x47 #160VPOD
		Faucet	Hansgrohe	Talis S #32146001
		Overhead Shower	Hansgrohe	Raindance E #27381000
		Hand Shower	Hansgrohe	Raindance Select E #26520000
SHOWER ROOM		Shower Controls	Hansgrohe	Shower Select #15761000
		Overhead Shower	Hansgrohe	Raindance E #27381000
		Hand Shower	Hansgrohe	Raindance Select E #26520000
		Shower Controls	Hansgrohe	Shower Select #15761000

4
A002 Fixture Schedule

	Baseboard		North Wall		East Wall		South Wall		West Wall		Floors		Ceiling	
	Material	Finish	Material	Finish	Material	Finish	Material	Finish	Material	Finish	Material	Finish	Material	Finish
GROUND LEVEL														
Garage	N/A	N/A	GWB	PT-C1	CONC	BF	CONC	BF	CONC	BF	CONC/ST	MTL	SAT	
Entry	PVC	PT-C1	GWB	PT-C1	GWB	PT-C1	GWB	PT-C1	GWB	PT-C1	CONC/POB	GWB	PT-C1	
WC	PVC	PT-C1	GWB	PT-C1	GWB	PT-C1	GWB	PT-C1	GWB	PT-C1	CONC/POB	GWB	PT-C1	
SECOND LEVEL														
Living Room	PVC	PT-C1	GWB	PT-C1	GLZ/GWB	PT-C1	GLZ	N/A	GLZ/GWB	PT-C1	CONC/CT3	GWB	PT-C1	
Bathroom 3	PVC	PT-C1	GWB	PT-C1	CT1/GWB	PT-C1	CT1/GWB	PT-C1	CT1/GWB	PT-C1	CONC/CT2	GWB	PT-C1	
Bathroom 2	PVC	PT-C1	GWB	PT-C1	CT1/GWB	PT-C1	CT1/GWB	PT-C1	CT1/GWB	PT-C1	CONC/CT2	GWB	PT-C1	
Bedroom 1	PVC	PT-C1	GWB	PT-C1	GWB	PT-C1	GWB	PT-C1	GLZ/GWB	PT-C1	CONC/CT3	GWB	PT-C1	
Bedroom 2	PVC	PT-C1	GWB	PT-C1	GLZ/GWB	PT-C1	GLZ	GWB	PT-C1	CONC/CT3	GWB	PT-C1		
THIRD LEVEL														
Kitchen	PVC	PT-C1	GWB	PT-C1	GLZ/GWB	PT-C1	GLZ	N/A	GLZ/GWB	PT-C1	CONC/CT3	GWB	PT-C1	
Bathroom 3	PVC	PT-C1	GWB	PT-C1	CT1/GWB	PT-C1	CT1/GWB	PT-C1	CT1/GWB	PT-C1	CONC/CT2	GWB	PT-C1	
Bathroom 4	PVC	PT-C1	GWB	PT-C1	CT1/GWB	PT-C1	CT1/GWB	PT-C1	CT1/GWB	PT-C1	CONC/CT2	GWB	PT-C1	
Bedroom 3	PVC	PT-C1	GLZ/GWB	PT-C1	GWB	PT-C1	GLZ/GWB	PT-C1	GLZ/GWB	PT-C1	CONC/CT3	GWB	PT-C1	
Bedroom 4	PVC	PT-C1	GLZ/GWB	PT-C1	GLZ/GWB	PT-C1	GLZ	GWB	PT-C1	CONC/CT3	GWB	PT-C1		
FOURTH LEVEL														
Lounge	PVC	PT-C1	GWB	PT-C1	GLZ/GWB	PT-C1	GLZ/GWB	PT-C1	GLZ/GWB	PT-C1	CONC/CT3	GWB	PT-C1	
Shower	N/A	N/A	CT1/GWB	PT-C1	CT1/GWB	PT-C1	CT1/GWB	PT-C1	CT1/GWB	PT-C1	CONC/CT2	CT1/GWB	CT1/GWB	
WC	PVC	PT-C1	GWB	PT-C1	GWB	PT-C1	GWB	PT-C1	GWB	PT-C1	CONC/CT3	GWB	PT-C1	


3
A002 Room Finish Schedule

AD	AREA DRAIN	DN	DOWN	LO	LOW	RM	ROOM	WD	WOOD
ADJ	ADJACENT	DR	DOOR	MAX	MAXIMUM	SC	SAW CUT		
AFF	ABOVE FINISHED FLOOR	DWG	DRAWING	MO	MASONRY OPENING	SM	SIMILAR		
ALUM	ALUMINUM	EA	EACH	MECH	MECHANICAL	SPEC	SPECIFIED OR SPECIFICATION		
ANOD	ANODIZED	EL	ELEVATION	MEMB	MEMBRANE	SPK	SPRINKLER		
BSMT	BASSEMENT	ELEC	ELECTRICAL	MN	MINIMUM	STL STL	STAINLESS STEEL		
BYOND	BEYOND	ELEV	ELEVATOR/ELEVATION	MRGB	MOISTURE-RESISTANT	STC	SOUND TRANSMISSION COEFFICIENT		
BOT	BOTTOM	EQ	EQUAL	MSWB	MOISTURE WALL BOARD	STL	STEEL		
BTW	BETWEEN	FOC	FACE OF CONCRETE	MTL	METAL	STRUCT	STRUCTURAL		
CHNL	CHANNEL	FOP	FACE OF WOOD FRAMING	NIC	NOT IN CONTRACT	TELE	TELEPHONE DATA		
CJ	CONTROL JOINT	FDN	FOUNDATION	NOM	NOMINAL	TLT	TOILET		
CLG	CEILING	GA	GUAGE	OC	ON CENTER	TOFF	TOP OF FINISHED FLOOR		
CLR	CLEAR	GALV	GALVANIZED	OC	OPPOSITE HAND	TOS	TOP OF CONCRETE		
CMU	CONCRETE MASONRY UNIT	GWB	GYPSSUM WALL BOARD	OZ	OUNCE	TOS	TOP OF STEEL		
COF	CENTERLINE OF WOOD FRAMING	HC	HOLLOW CORE	PC	PRE-CAST CONCRETE	TP	TOILET PAPER DISPENSER		
COL	COLUMN	H	HIGH	PVD	POLYVINYL CHLORIDE	TID	TELEPHONE DATA		
CONC	CONCRETE	HM	HOLLOW METAL	PT	PRESSURE TREATED	UN	UNLESS OTHERWISE NOTED		
CONT	CONTINUOUS	HP	HIGH POINT	PTD	PAINTED	UOS	UNDERSIDE		
OPT	CORRET	HVAC	HEATING VENTILATING AND AIR CONDITIONING	PVC	POLYVINYL CHLORIDE	VF	VERIFY IN FIELD		
CT	CERAMIC TILE	IN LIEU OF		RCP	REFLECTED CEILING PLAN	VP	VISION PANEL		
DL	DOUBLE	INSUL	INSULATED	RD	ROOF DRAIN	YP	TYPICAL		
DIA	DIAMETER	INT	INTERIOR	REQD	REQUIRED	VF	VERIFY IN FIELD		
DIMS	DIMENSIONS	INT	INTERIOR	REV	REVERSE	W/	WITH		

2
A002 Abbreviations

building number	northwest corner natural grade elevation	northeast corner natural grade elevation	southwest corner natural grade elevation	southeast corner natural grade elevation	upper level floor elevation	height to building ridge	average building height (less than 35')
71R	8573.37	8573.37	8557.28	8558.86	8584.38	8598.44	32.325

1
A002 Height Restriction Chart

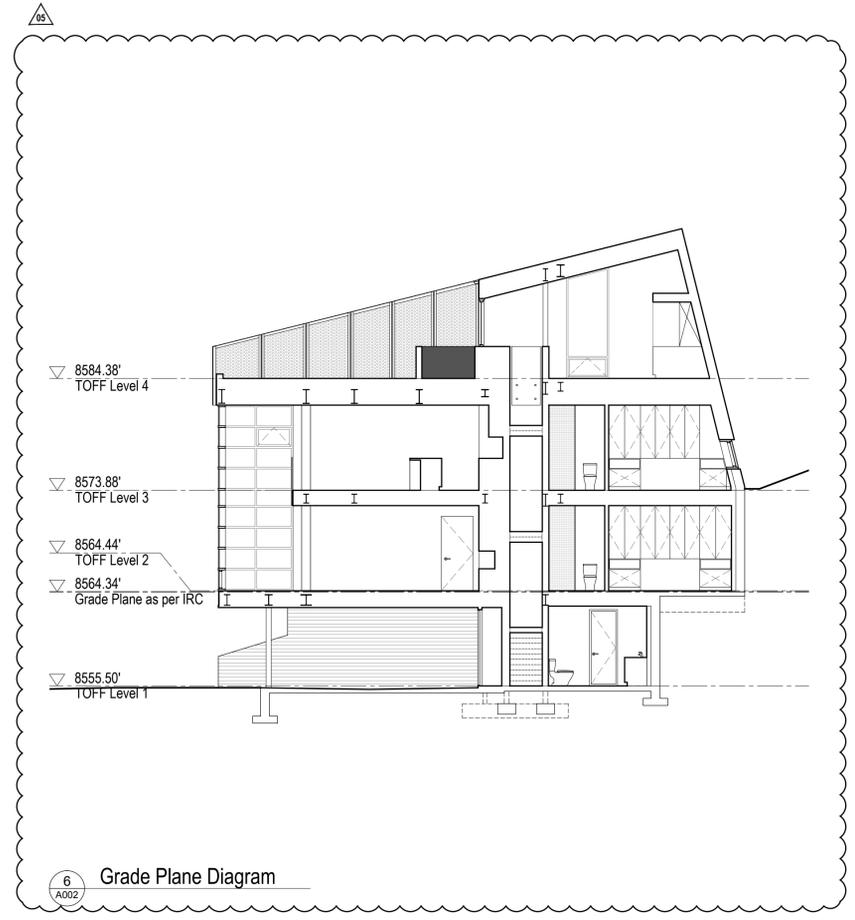

6
A002 Grade Plane Diagram

5	IFC Rev 02	2019.02.08
4	IFC Rev 01	2018.06.29
3	Issued for Construction	2018.03.13
2	Issued for Tender	2017.12.22
1	for coordination	2017.12.11

No. Description Date

Revision:

NOTES:
COPYRIGHT RELATED TO THE USE OF THIS DRAWING:
The use of this drawing shall be governed by standard copyright law as generally accepted in architectural practice.

ARCHITECT'S REQUIREMENTS AND APPROVALS:
It is the Builder's responsibility to notify Mackay-Lyons Sweetapple Architects Ltd. and to seek prior written approval for materials and workmanship which deviates from instructions provided by the Architect.

ENGINEER'S REQUIREMENTS AND APPROVALS:
It is the Builder's responsibility to notify Mackay-Lyons Sweetapple Architects Ltd. and to seek prior written approval for materials and workmanship which deviates from instructions provided by the Engineer.

AUTHORITIES' REQUIREMENTS AND APPROVALS:
All materials and workmanship must comply with the requirements of all authorities having jurisdiction over the work. It is the Builder's responsibility to gain necessary approval from all relevant Authorities.

DIMENSIONS:
All dimensions must be verified on site. Do not scale off drawings. Plans take precedent over elevations. In the absence of dimensions, or if discrepancies exist, consult Architect. All minimum dimensions are to comply with the International Residential Code.

SHOP DRAWINGS:
Submit shop drawings to the Architect and Engineer for approval prior to manufacture of prefabricated elements of the building.

Abbreviations & Key Plan



Site Plan Notes:

- + Provide native revegetation seed for all disturbed areas
- + See Civil Engineering drawings for information relating but not limited to:
 - site location.
 - site boundaries.
 - rights-of-way, easements.
 - geodetic elevations, site grading, earthwork.
 - all underground and aboveground services including fire hydrants, maintenance access covers, transformers, air condensers.
 - paved areas such as driveways, curbs, curb cutouts.
- + See Structural Engineering drawings for reference to Geotechnical Report.
- + Refer to Structural Engineering drawings for Foundation Plan

Lot 71R
Village House

Summit Power Mountain
Evan, Utah

Mackay-Lyons
Sweetapple
Architects
Limited

2188 Göttingen St.
Halifax, Nova Scotia
Canada B3K 3B4

ph: (902) 429.1867
fax: (902) 429.6276



5	IFC Rev 02	2019.02.08
4	IFC Rev 01	2018.06.29
3	Issued for Construction	2018.03.13
2	Issued for Tender	2017.12.22
1	for coordination	2017.12.1

NOTES:

COPYRIGHT RELATED TO THE USE OF THIS DRAWING:
The use of this drawing shall be governed by standard copyright law as generally accepted in architectural practice.

ARCHITECT'S REQUIREMENTS AND APPROVALS:
It is the Builder's responsibility to notify Mackay-Lyons Sweetapple Architects Ltd. and to seek prior written approval for materials and workmanship which deviates from instructions provided by the Architect.

ENGINEER'S REQUIREMENTS AND APPROVALS:
It is the Builder's responsibility to notify Mackay-Lyons Sweetapple Architects Ltd. and to seek prior written approval for materials and workmanship which deviates from instructions provided by the Engineer.

AUTHORITIES' REQUIREMENTS AND APPROVALS:
All materials and workmanship must comply with the requirements of all authorities having jurisdiction over the work. It is the Builder's responsibility to gain necessary approval from all relevant Authorities.

DIMENSIONS:
All dimensions must be verified on site. Do not scale off drawings. Plans take precedent over elevations. In the absence of dimensions, or if discrepancies exist, consult Architect. All minimum dimensions are to comply with the International Residential Code.

SHOP DRAWINGS:
Submit shop drawings to the Architect and Engineer for approval prior to manufacture of prefabricated elements of the building.

LEGEND

(X)	Window / Door Type
(X)	Partition Type
(□)	Roof Drain
(CJ)	Control Joint
(//)	Shear Wall (refer to structural)

SQUARE FOOTAGES



LIVABLE (ANSI Z765-2003)	
Ground Floor Plan	265 square feet
Second Floor Plan	1254 square feet
Third Floor Plan	1008 square feet
Fourth Floor Plan	535 square feet
Below Grade Livable Total:	1,519 square feet
Above Grade Livable Total:	1,543 square feet
Total:	3,062 square feet

Mechanical / Storage:	164 square feet
Viewing Deck:	662 square feet
Covered Parking:	512 square feet
GROSS (excluding exterior spaces):	3,329 square feet

NOTE: Finished square footage calculations were made based on plan dimensions only and may vary from the finished square footage of the house as built.

MECHANICAL AND PLUMBING NOTES:

- + All work shall be performed in accordance with 2015 International Residential Code, 2015 International Mechanical Code, 2015 International Plumbing Code, and 2015 International Energy Code, including state and local amendments, subject to authority having jurisdiction interpretation.
- + For plumbing fixtures that are located below the elevation level of the nearest upstream man hole cover, a backwater valve is required. Fixtures that are above the elevation level of the manhole cover shall not discharge through the backwater valve per IRC P3008.1.
- + Closely coordinate new mechanical and plumbing construction with all mechanical, electrical, architectural, and structural members. Provide alternate routing, offsets, and transitions as required for coordination of all work without additional cost.
- + Do not shut-off / put out any systems / services without first coordinating all downtime with the owner's personnel.
- + Submit all equipment, air devices, valves, fittings, pipe materials, insulation, and accessories to be used in this project. Submit electronic submittal to architect for review and approval. Do not place order until reviewed and approved.
- + Contractor shall provide 1 year standard warranty.
- + Install all equipment in accordance with manufacturer's installation instructions.
- + Project Elevation is 8,555.5 ft for equipment selection.
- + Provide all duct in accordance with SMACNA standards for 2" WC pressure class. Seal all transverse and longitudinal seams and joints except for welded or locking-type longitudinal joints.
- + Dryers located in closets shall be provided with make-up air, per IRC G2439.5
- + If a single duct will be used for combustion air, provide a minimum duct size of 1 sq. inch per 3000 Btu/hour input. The one opening must be in the top 12 inches of the room, per IRC G2407.6.2.

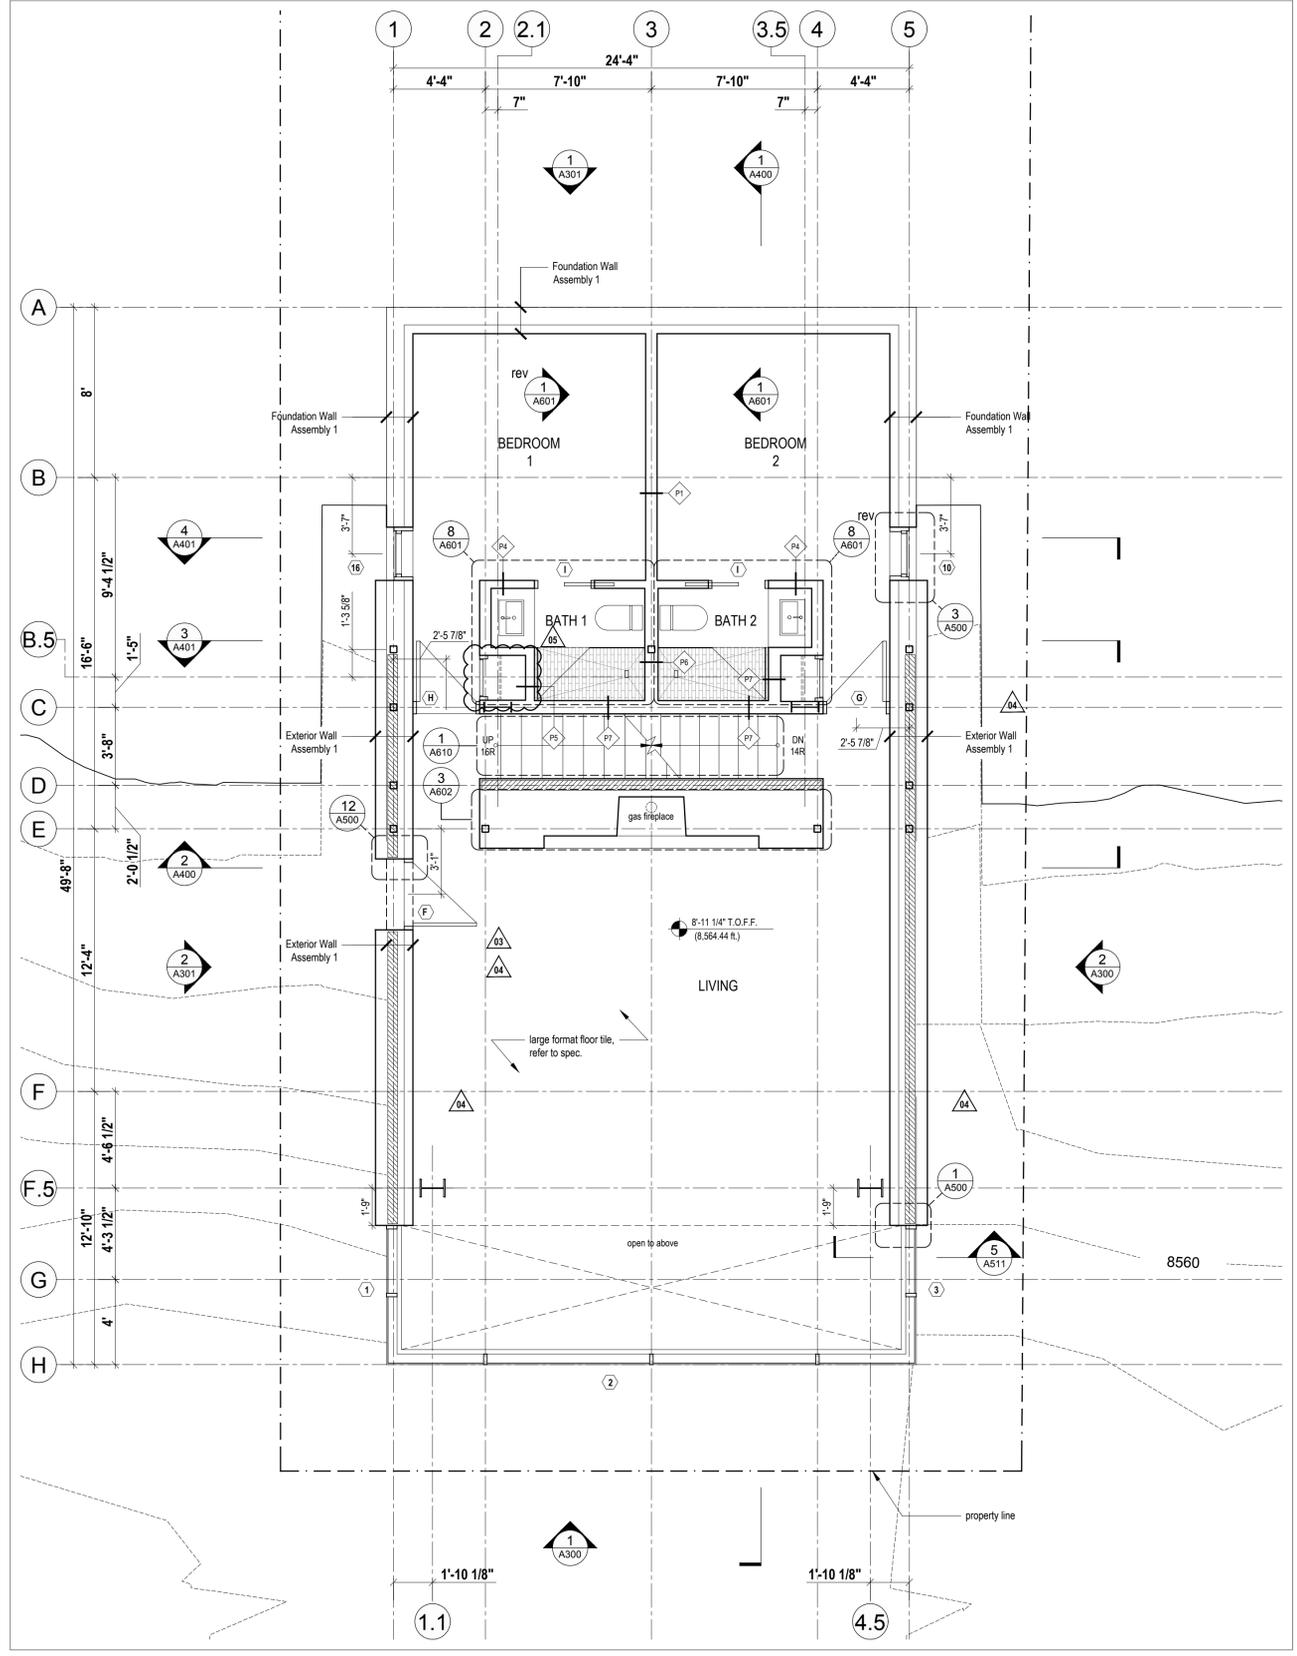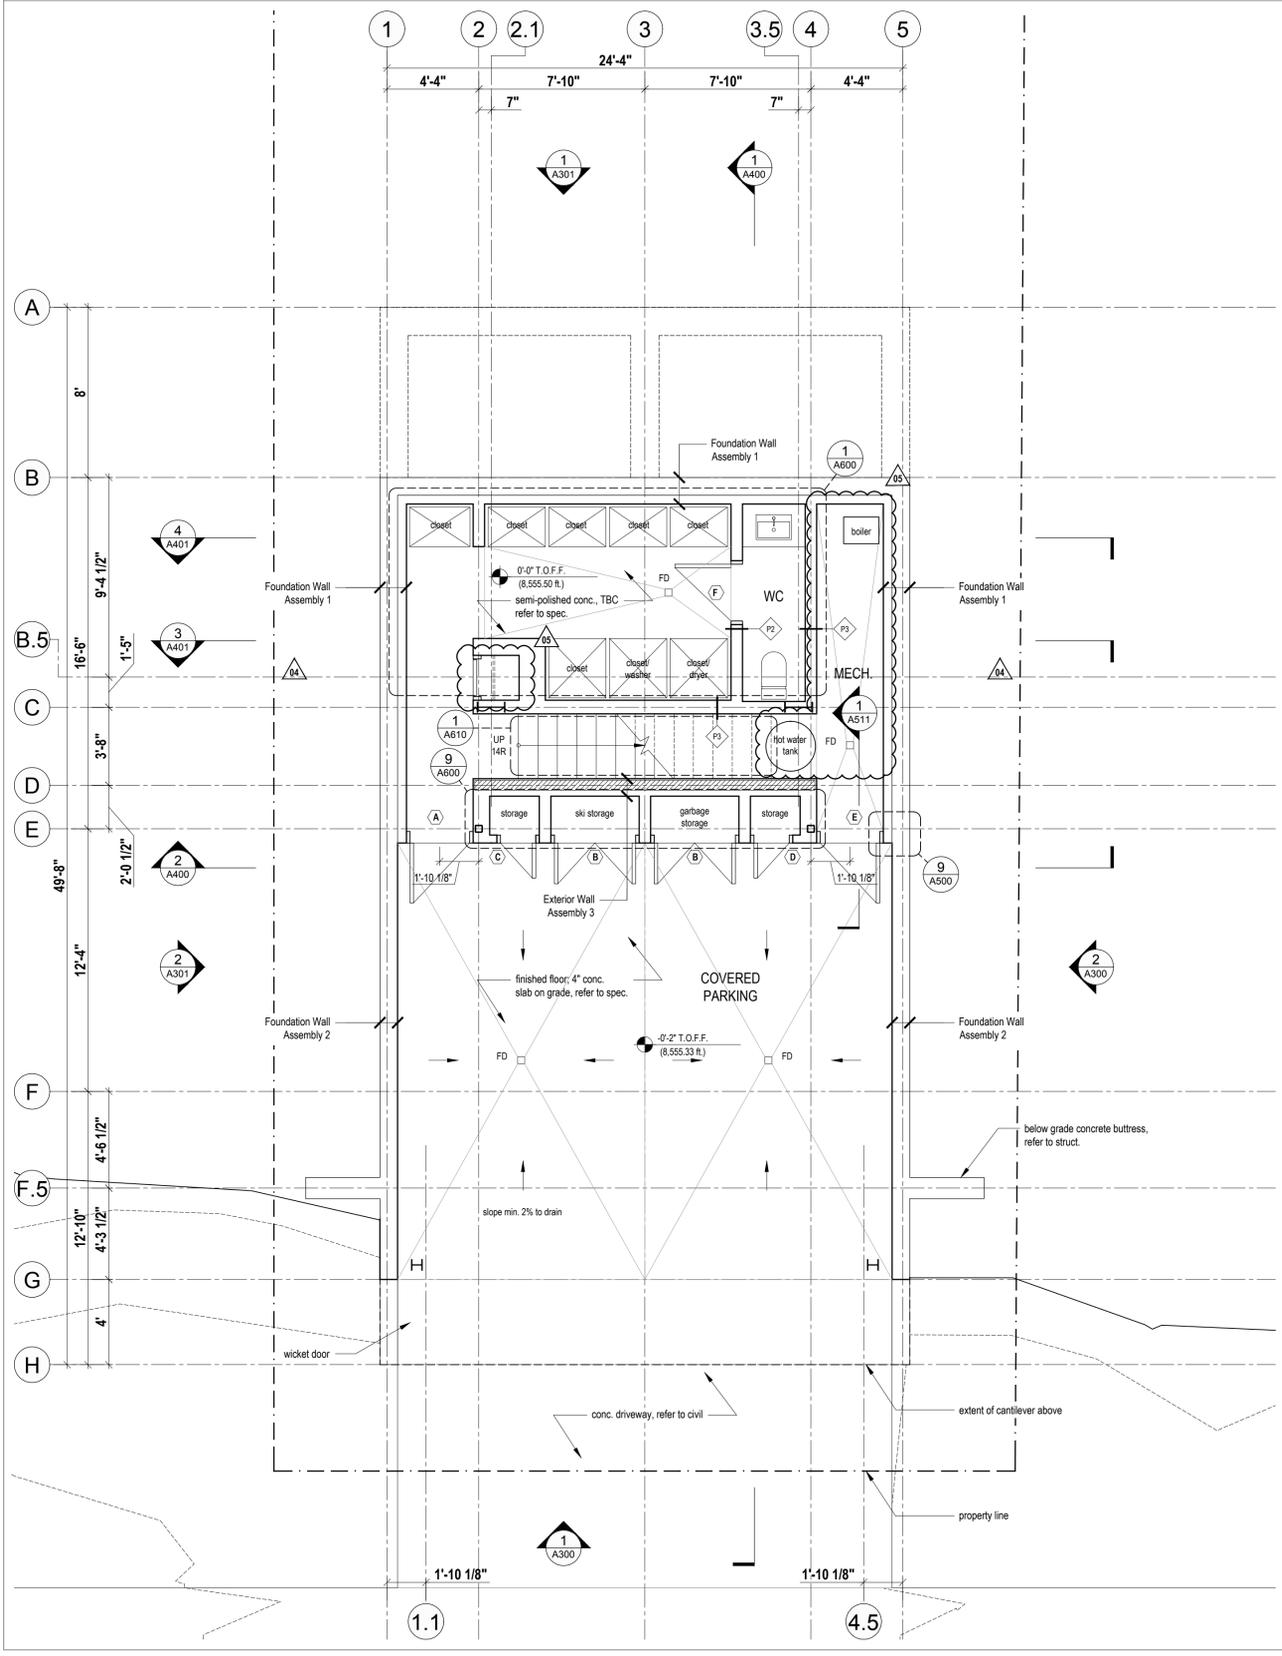

2 Ground Floor Plan
Scale 1/4" = 1'-0"

1 Second Floor Plan
Scale 1/4" = 1'-0"

Lot 71R
Village House

Summit Power, Mountain Earth

Mackay-Lyons
Sweetapple
Architects
Limited

2188 Göttingen St.
Halifax, Nova Scotia
Canada B3K 3B4

ph: (902) 429.1867
fax: (902) 429.6276



5	IFC Rev 02	2019.02.08
4	IFC Rev 01	2018.06.29
3	Issued for construction	2018.03.13
2	Issued for Tender	2017.12.22
1	for coordination	2017.12.1
No.	Description	Date

NOTES:

COPYRIGHT RELATED TO THE USE OF THIS DRAWING:
The use of this drawing shall be governed by standard copyright law as generally accepted in architectural practice.

ARCHITECT'S REQUIREMENTS AND APPROVALS:
It is the Builder's responsibility to notify Mackay-Lyons Sweetapple Architects Ltd. and to seek prior written approval for materials and workmanship which deviates from instructions provided by the Architect.

ENGINEER'S REQUIREMENTS AND APPROVALS:
It is the Builder's responsibility to notify Mackay-Lyons Sweetapple Architects Ltd. and to seek prior written approval for materials and workmanship which deviates from instructions provided by the Engineer.

AUTHORITIES' REQUIREMENTS AND APPROVALS:
All materials and workmanship must comply with the requirements of all authorities having jurisdiction over the work. It is the Builder's responsibility to gain necessary approval from all relevant Authorities.

DIMENSIONS:
All dimensions must be verified on site. Do not scale off drawings. Plans take precedent over elevations. In the absence of dimensions, or if discrepancies exist, consult Architect. All minimum dimensions are to comply with the International Residential Code.

SHOP DRAWINGS:
Submit shop drawings to the Architect and Engineer for approval prior to manufacture of prefabricated elements of the building.

Ground & Second Floor Plans

scale: 1/4" = 1'-0"
date: 17-11-23
drawn: WPIRD
chk'd: BML

A201

LEGEND

(X)	Window / Door Type
(PK)	Partition Type
(□)	Roof Drain
(CJ)	Control Joint
(//)	Shear Wall (refer to structural)

SQUARE FOOTAGES



LIVABLE (ANSI Z765-2003)	
Ground Floor Plan	265 square feet
Second Floor Plan	1254 square feet
Third Floor Plan	1008 square feet
Fourth Floor Plan	535 square feet
Below Grade Livable Total:	1,519 square feet
Above Grade Livable Total:	1,543 square feet
Total:	3,062 square feet

Mechanical / Storage:	164 square feet
Viewing Deck:	662 square feet
Covered Parking:	512 square feet
GROSS (excluding exterior spaces):	3,329 square feet

NOTE: Finished square footage calculations were made based on plan dimensions only and may vary from the finished square footage of the house as built.

MECHANICAL AND PLUMBING NOTES:

- + All work shall be performed in accordance with 2015 International Residential Code, 2015 International Mechanical Code, 2015 International Plumbing Code, and 2015 International Energy Code, including state and local amendments, subject to authority having jurisdiction interpretation.
- + For plumbing fixtures that are located below the elevation level of the nearest upstream man hole cover, a backwater valve is required. Fixtures that are above the elevation level of the manhole cover shall not discharge through the backwater valve per IRC P3008.1.
- + Closely coordinate new mechanical and plumbing construction with all mechanical, electrical, architectural, and structural members. Provide alternate routing, offsets, and transitions as required for coordination of all work without additional cost.
- + Do not shut-off / put out any systems / services without first coordinating all downtime with the owner's personnel.
- + Submit all equipment, air devices, valves, fittings, pipe materials, insulation, and accessories to be used in this project. Submit electronic submittal to architect for review and approval. Do not place order until reviewed and approved.
- + Contractor shall provide 1 year standard warranty.
- + Install all equipment in accordance with manufacturer's installation instructions.
- + Project Elevation is 8,555.5 ft for equipment selection.
- + Provide all duct in accordance with SMACNA standards for 2" WC pressure class. Seal all transverse and longitudinal seams and joints except for welded or locking-type longitudinal joints.
- + Dryers located in closets shall be provided with make-up air, per IRC G2439.5
- + If a single duct will be used for combustion air, provide a minimum duct size of 1 sq. inch per 3000 Btu/hour input. The one opening must be in the top 12 inches of the room, per IRC G2407.6.2.

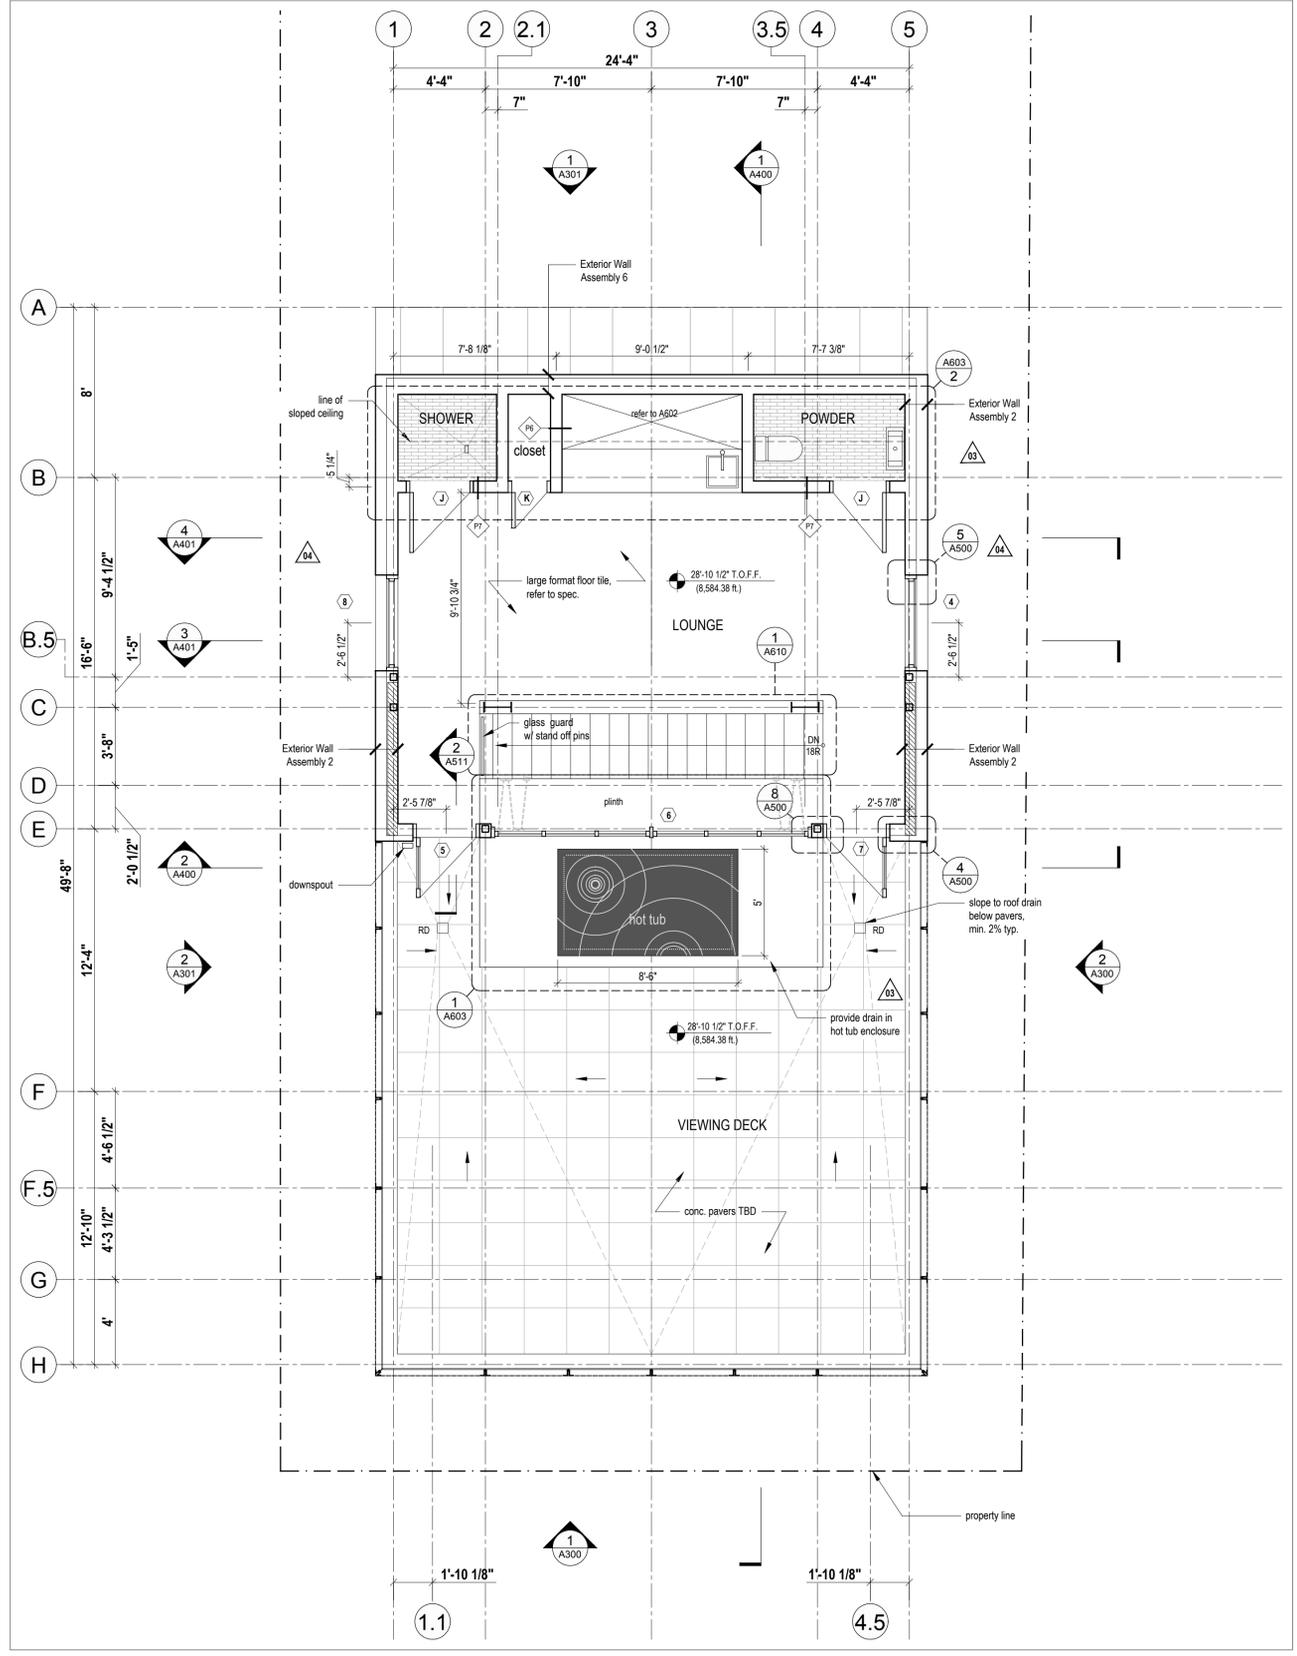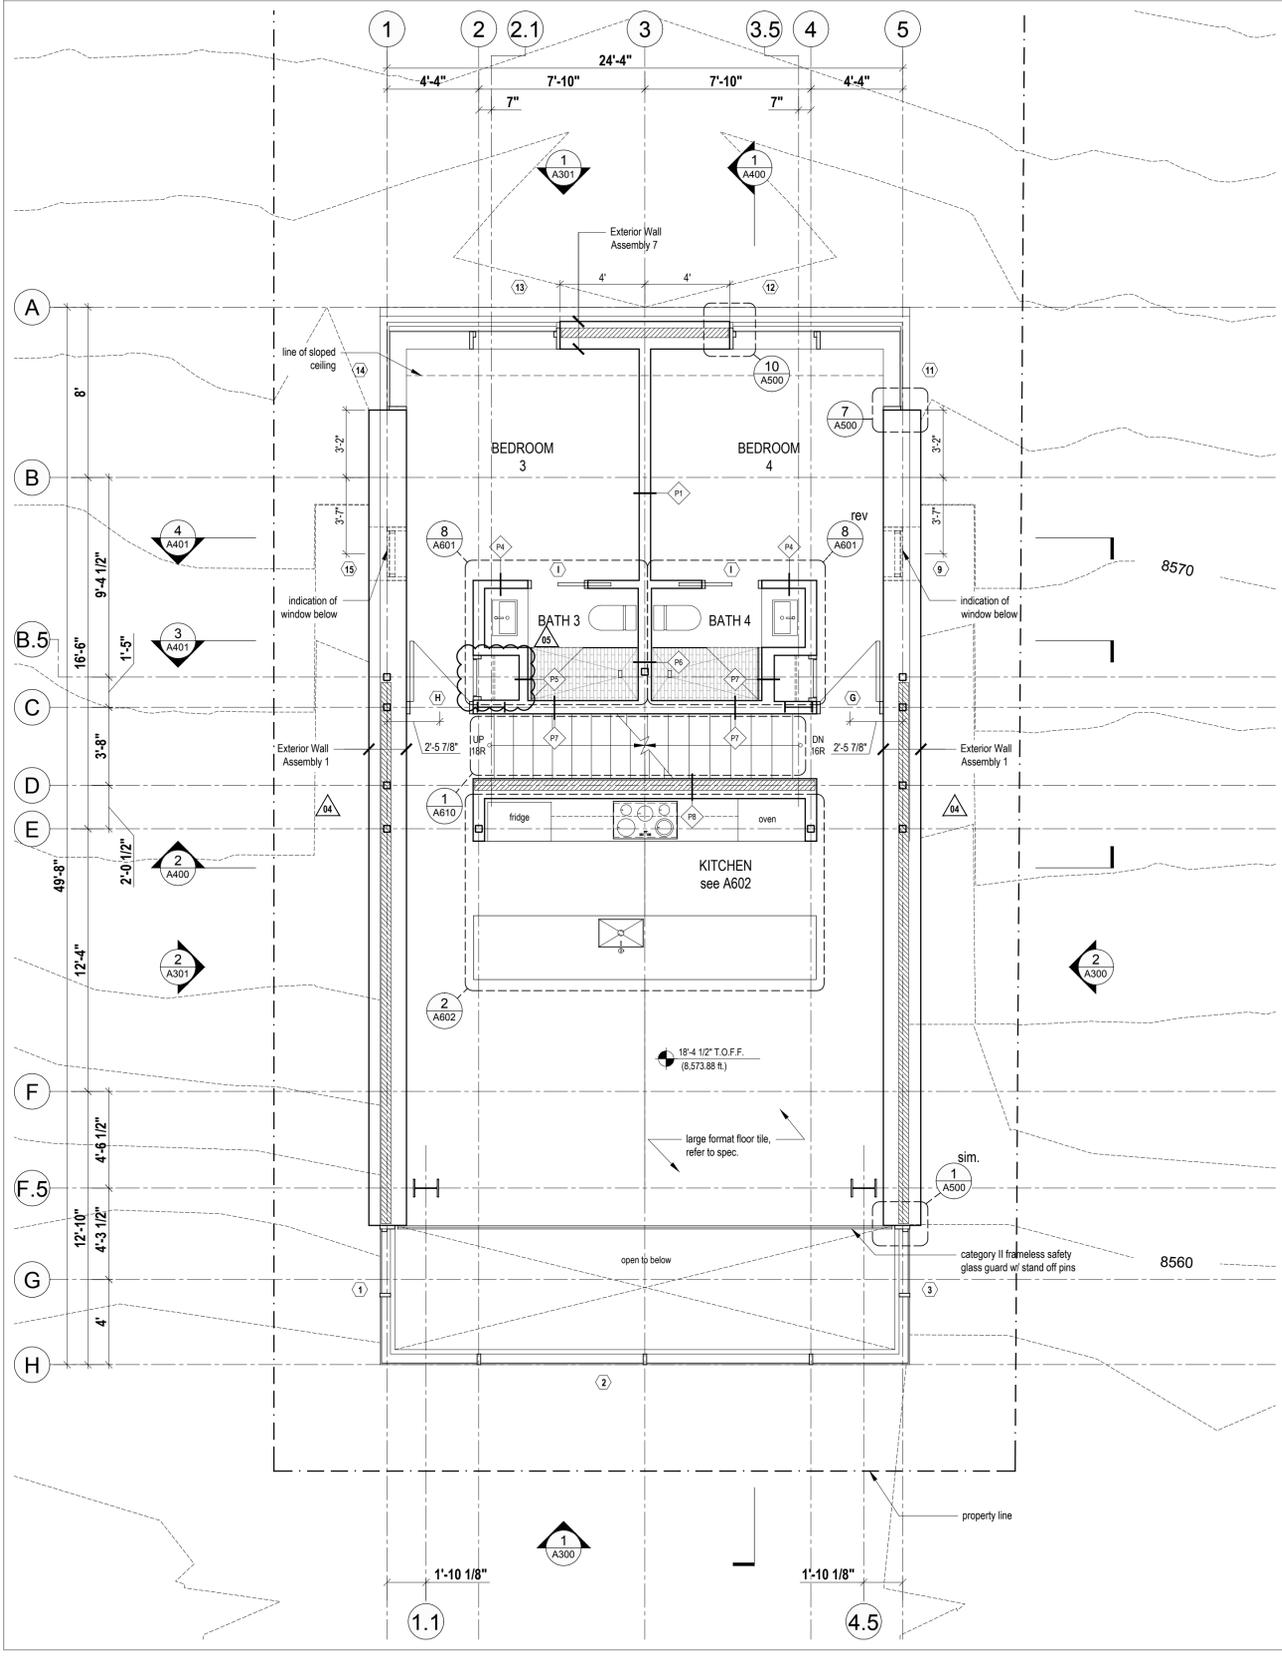


Lot 71R
Village House

Summit Power, Mountain
Econ. Utah

MackKay-Lyons
Sweetapple
Architects
Limited

2188 Göttingen St.
Halifax, Nova Scotia
Canada B3K 3B4

ph: (902) 429.1867
fax: (902) 429.6276

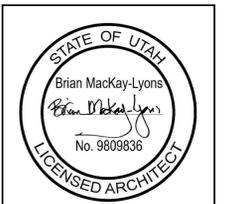

No.	Description	Date
5	IFC Rev 02	2019.02.08
4	IFC Rev 01	2018.06.29
3	Issued for construction	2018.03.13
2	Issued for Tender	2017.12.22
1	for coordination	2017.12.1

NOTES:

COPYRIGHT RELATED TO THE USE OF THIS DRAWING:
The use of this drawing shall be governed by standard copyright law as generally accepted in architectural practice.

ARCHITECT'S REQUIREMENTS AND APPROVALS:
It is the Builder's responsibility to notify MackKay-Lyons Sweetapple Architects Ltd. and to seek prior written approval for materials and workmanship which deviates from instructions provided by the Architect.

ENGINEER'S REQUIREMENTS AND APPROVALS:
It is the Builder's responsibility to notify MackKay-Lyons Sweetapple Architects Ltd. and to seek prior written approval for materials and workmanship which deviates from instructions provided by the Engineer.

AUTHORITIES' REQUIREMENTS AND APPROVALS:
All materials and workmanship must comply with the requirements of all authorities having jurisdiction over the work. It is the Builder's responsibility to gain necessary approval from all relevant Authorities.

DIMENSIONS:
All dimensions must be verified on site. Do not scale off drawings. Plans take precedent over elevations. In the absence of dimensions, or if discrepancies exist, consult Architect. All minimum dimensions are to comply with the International Residential Code.

SHOP DRAWINGS:
Submit shop drawings to the Architect and Engineer for approval prior to manufacture of prefabricated elements of the building.


Third & Fourth Floor Plans

scale: 1/4" = 1'-0"
date: 17-11-23
drawn: WPI/RD
chk'd: BML


A202

LEGEND

- | | | | |
|-------------------------|-------------------------------------|--|--|
| 1 flat seam zinc panel | 4 metal panel to match curtain wall | 7 garage door TBD | 10 Galvanized steel column, as per structural |
| 2 perforated zinc panel | 5 boardform concrete wall | 8 "Nana Wall" Window System, refer to spec | 11 Galvanized steel storm door, refer to door schedule |
| 3 curtain wall system | 6 standing seam zinc | 9 Glazed Spandrel Panel | |

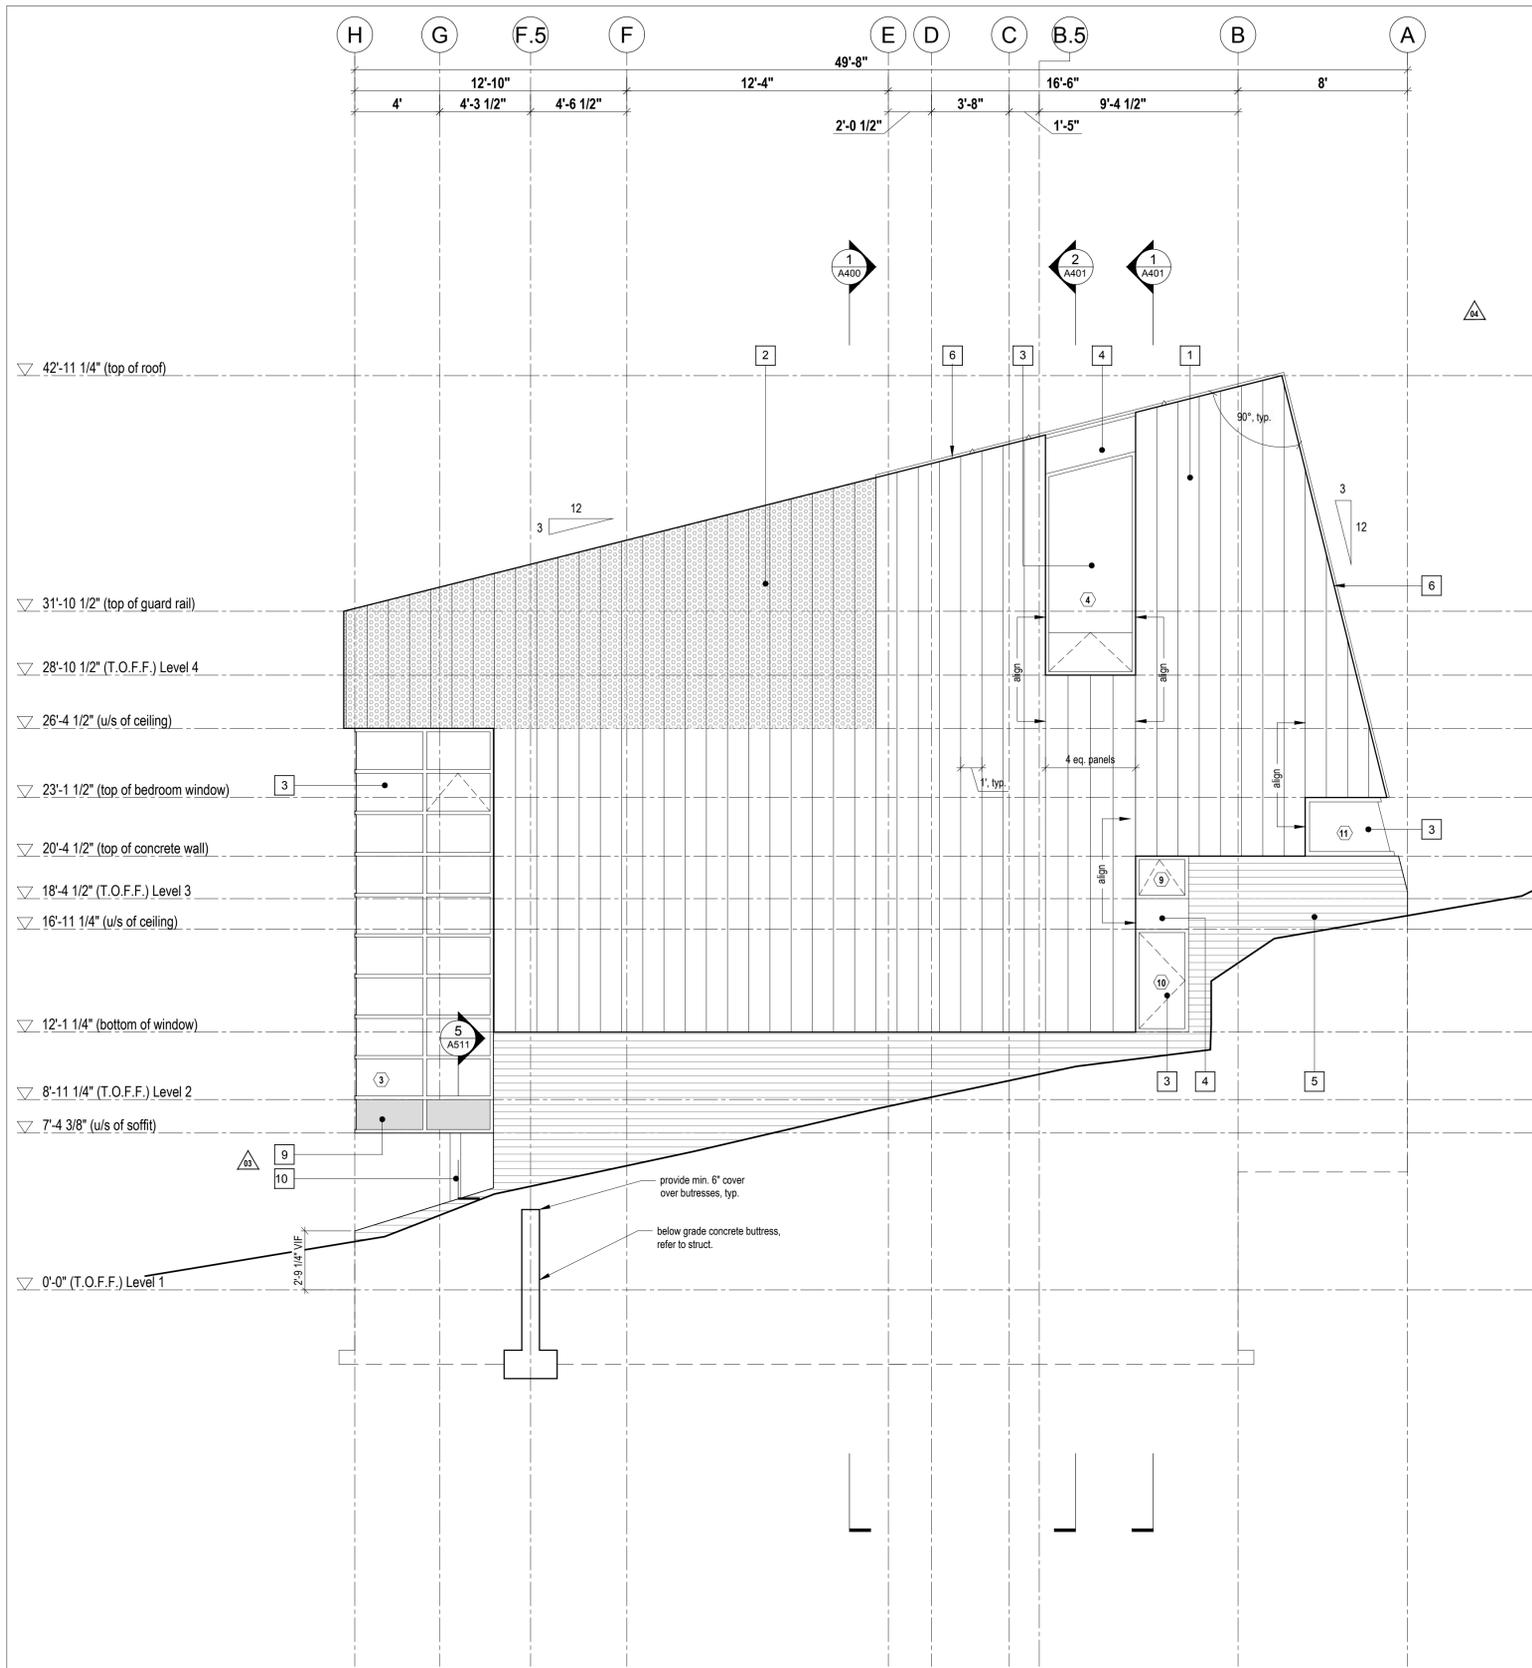


2 East Elevation
Scale 1/4" = 1'-0"

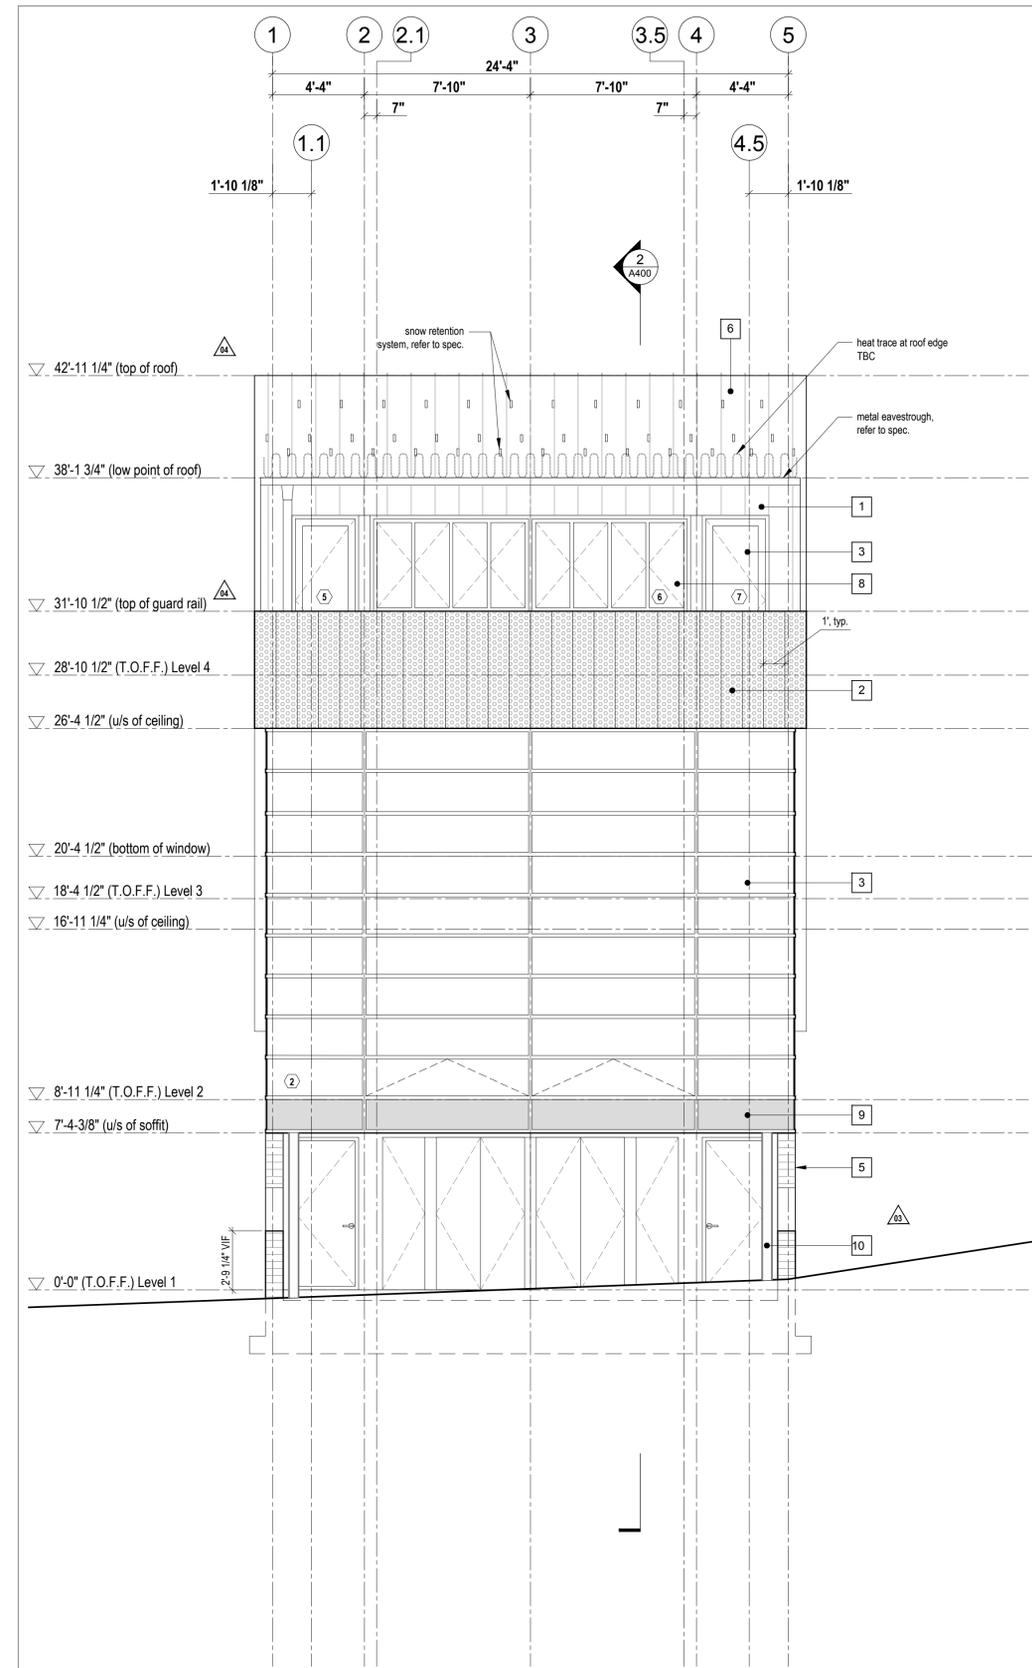

1 South Elevation
Scale 1/4" = 1'-0"

Mackay-Lyons
Sweetapple
Architects
Limited
2188 Göttingen St.
Halifax, Nova Scotia
Canada B3K 3B4
ph: (902) 429.1867
fax: (902) 429.6276

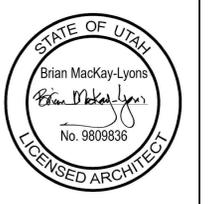

No.	Description	Date
5	IFC Rev 02	2019.02.08
4	IFC Rev 01	2018.06.29
3	Issued for Construction	2018.03.13
2	Issued for Tender	2017.12.22
1	for coordination	2017.12.1

NOTES:

COPYRIGHT RELATED TO THE USE OF THIS DRAWING:
The use of this drawing shall be governed by standard copyright law as generally accepted in architectural practice.

ARCHITECT'S REQUIREMENTS AND APPROVALS:
It is the Builder's responsibility to notify Mackay-Lyons Sweetapple Architects Ltd. and to seek prior written approval for materials and workmanship which deviates from instructions provided by the Architect.

ENGINEER'S REQUIREMENTS AND APPROVALS:
It is the Builder's responsibility to notify Mackay-Lyons Sweetapple Architects Ltd. and to seek prior written approval for materials and workmanship which deviates from instructions provided by the Engineer.


AUTHORITIES' REQUIREMENTS AND APPROVALS:
All materials and workmanship must comply with the requirements of all authorities having jurisdiction over the work. It is the Builder's responsibility to gain necessary approval from all relevant Authorities.

DIMENSIONS:
All dimensions must be verified on site. Do not scale off drawings. Plans take precedent over elevations. In the absence of dimensions, or if discrepancies exist, consult Architect. All minimum dimensions are to comply with the International Residential Code.


SHOP DRAWINGS:
Submit shop drawings to the Architect and Engineer for approval prior to manufacture of prefabricated elements of the building.

LEGEND

- | | | | |
|-------------------------|-------------------------------------|--|--|
| 1 flat seam zinc panel | 4 metal panel to match curtain wall | 7 garage door TBD | 10 Galvanized steel column, as per structural |
| 2 perforated zinc panel | 5 boardform concrete wall | 8 "Nana Wall" Window System, refer to spec | 11 Galvanized steel storm door, refer to door schedule |
| 3 curtain wall system | 6 standing seam zinc | 9 Glazed Spandrel Panel | |

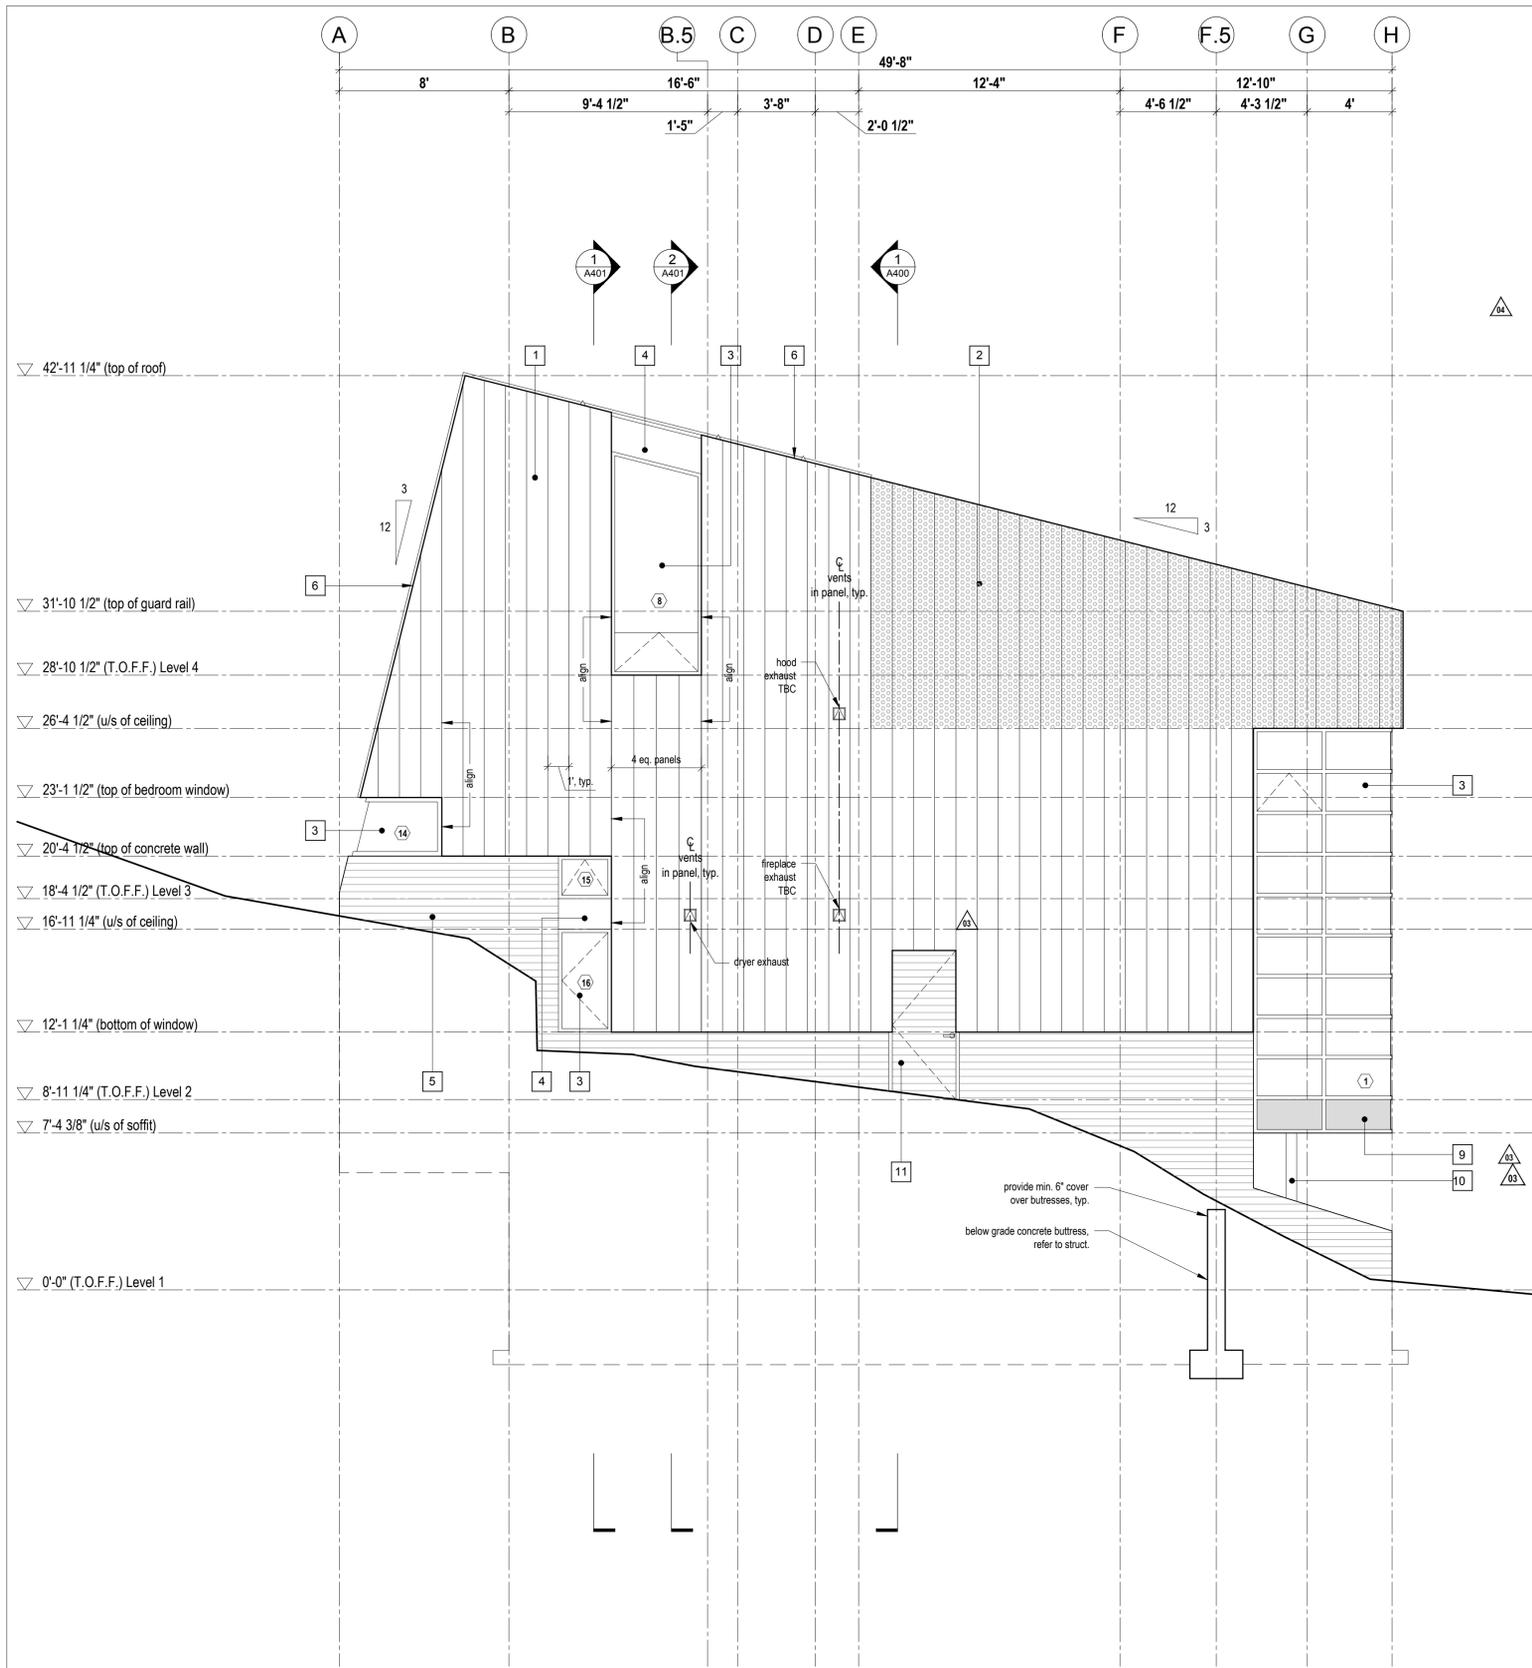

2 West Elevation
Scale 1/4" = 1'-0"

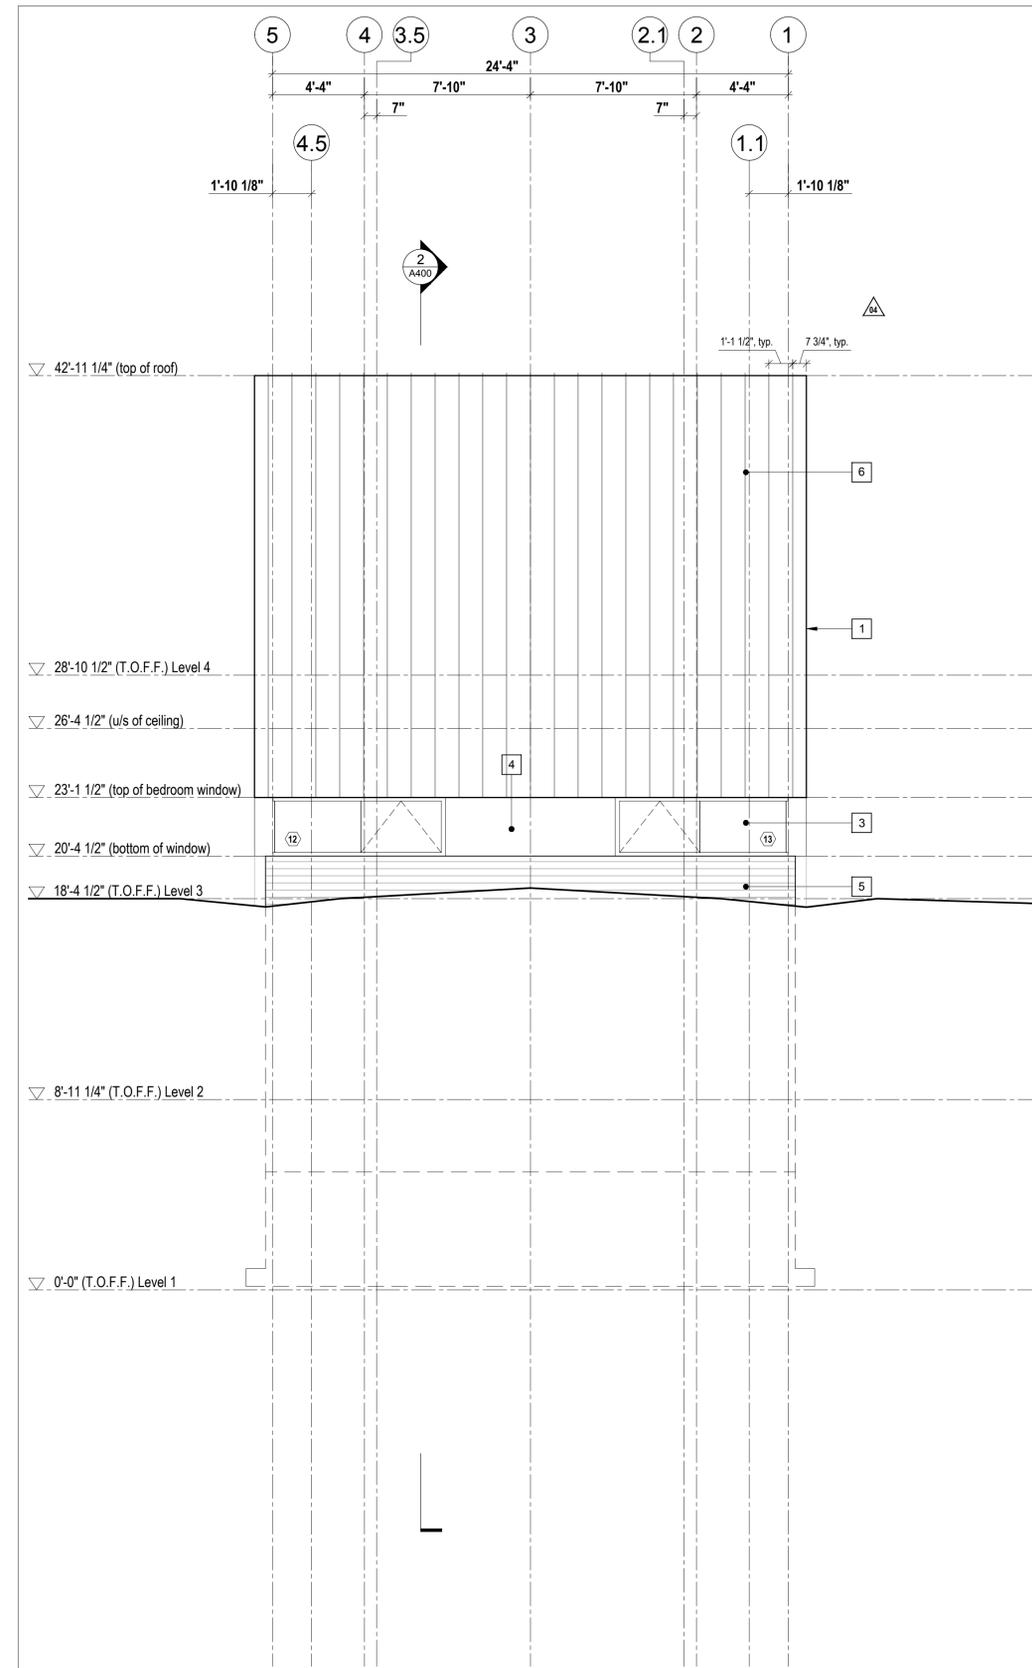

1 North Elevation
Scale 1/4" = 1'-0"

MackKay-Lyons
Sweetapple
Architects
Limited

2188 Göttingen St.
Halifax, Nova Scotia
Canada B3K 3B4

ph: (902) 429-1867
fax: (902) 429-6276



No.	Description	Date
5	IFC Rev 02	2019.02.08
4	IFC Rev 01	2018.06.29
3	Issued for Construction	2018.03.13
2	Issued for Tender	2017.12.22
1	for coordination	2017.12.1

NOTES:

COPYRIGHT RELATED TO THE USE OF THIS DRAWING:
The use of this drawing shall be governed by standard copyright law as generally accepted in architectural practice.

ARCHITECT'S REQUIREMENTS AND APPROVALS:
It is the Builder's responsibility to notify MackKay-Lyons Sweetapple Architects Ltd. and to seek prior written approval for materials and workmanship which deviates from instructions provided by the Architect.

ENGINEER'S REQUIREMENTS AND APPROVALS:
It is the Builder's responsibility to notify MackKay-Lyons Sweetapple Architects Ltd. and to seek prior written approval for materials and workmanship which deviates from instructions provided by the Engineer.

AUTHORITIES' REQUIREMENTS AND APPROVALS:
All materials and workmanship must comply with the requirements of all authorities having jurisdiction over the work. It is the Builder's responsibility to gain necessary approval from all relevant Authorities.

DIMENSIONS:
All dimensions must be verified on site. Do not scale off drawings. Plans take precedent over elevations. In the absence of dimensions, or if discrepancies exist, consult Architect. All minimum dimensions are to comply with the International Residential Code.

SHOP DRAWINGS:
Submit shop drawings to the Architect and Engineer for approval prior to manufacture of prefabricated elements of the building.

Exterior
Elevations

scale: 1/4" = 1'-0"
date: 17-11-23
drawn: WPIRD
chk'd: BML

A301

Mackay-Lyons
Sweetapple
Architects
Limited

2188 Göttingen St.
Halifax, Nova Scotia
Canada B3K 3B4

ph: (902) 429.1867
fax: (902) 429.6276



No.	Description	Date
5	IFC Rev 02	2019.02.08
4	IFC Rev 01	2018.06.29
3	Issued for Construction	2018.03.13
2	Issued for Tender	2017.12.22
1	for coordination	2017.12.1

NOTES:

COPYRIGHT RELATED TO THE USE OF THIS DRAWING:
The use of this drawing shall be governed by standard copyright law as generally accepted in architectural practice.

ARCHITECT'S REQUIREMENTS AND APPROVALS:
It is the Builder's responsibility to notify Mackay-Lyons Sweetapple Architects Ltd. and to seek prior written approval for materials and workmanship which deviates from instructions provided by the Architect.

ENGINEER'S REQUIREMENTS AND APPROVALS:
It is the Builder's responsibility to notify Mackay-Lyons Sweetapple Architects Ltd. and to seek prior written approval for materials and workmanship which deviates from instructions provided by the Engineer.

AUTHORITIES' REQUIREMENTS AND APPROVALS:
All materials and workmanship must comply with the requirements of all authorities having jurisdiction over the work. It is the Builder's responsibility to gain necessary approval from all relevant Authorities.


DIMENSIONS:
All dimensions must be verified on site. Do not scale off drawings. Plans take precedent over elevations. In the absence of dimensions, or if discrepancies exist, consult Architect. All minimum dimensions are to comply with the International Residential Code.

SHOP DRAWINGS:
Submit shop drawings to the Architect and Engineer for approval prior to manufacture of precast elements of the building.


Building Sections

scale: 1/4" = 1'-0"
date: 17-11-23
drawn: WPIRD
chk'd: BML



A400

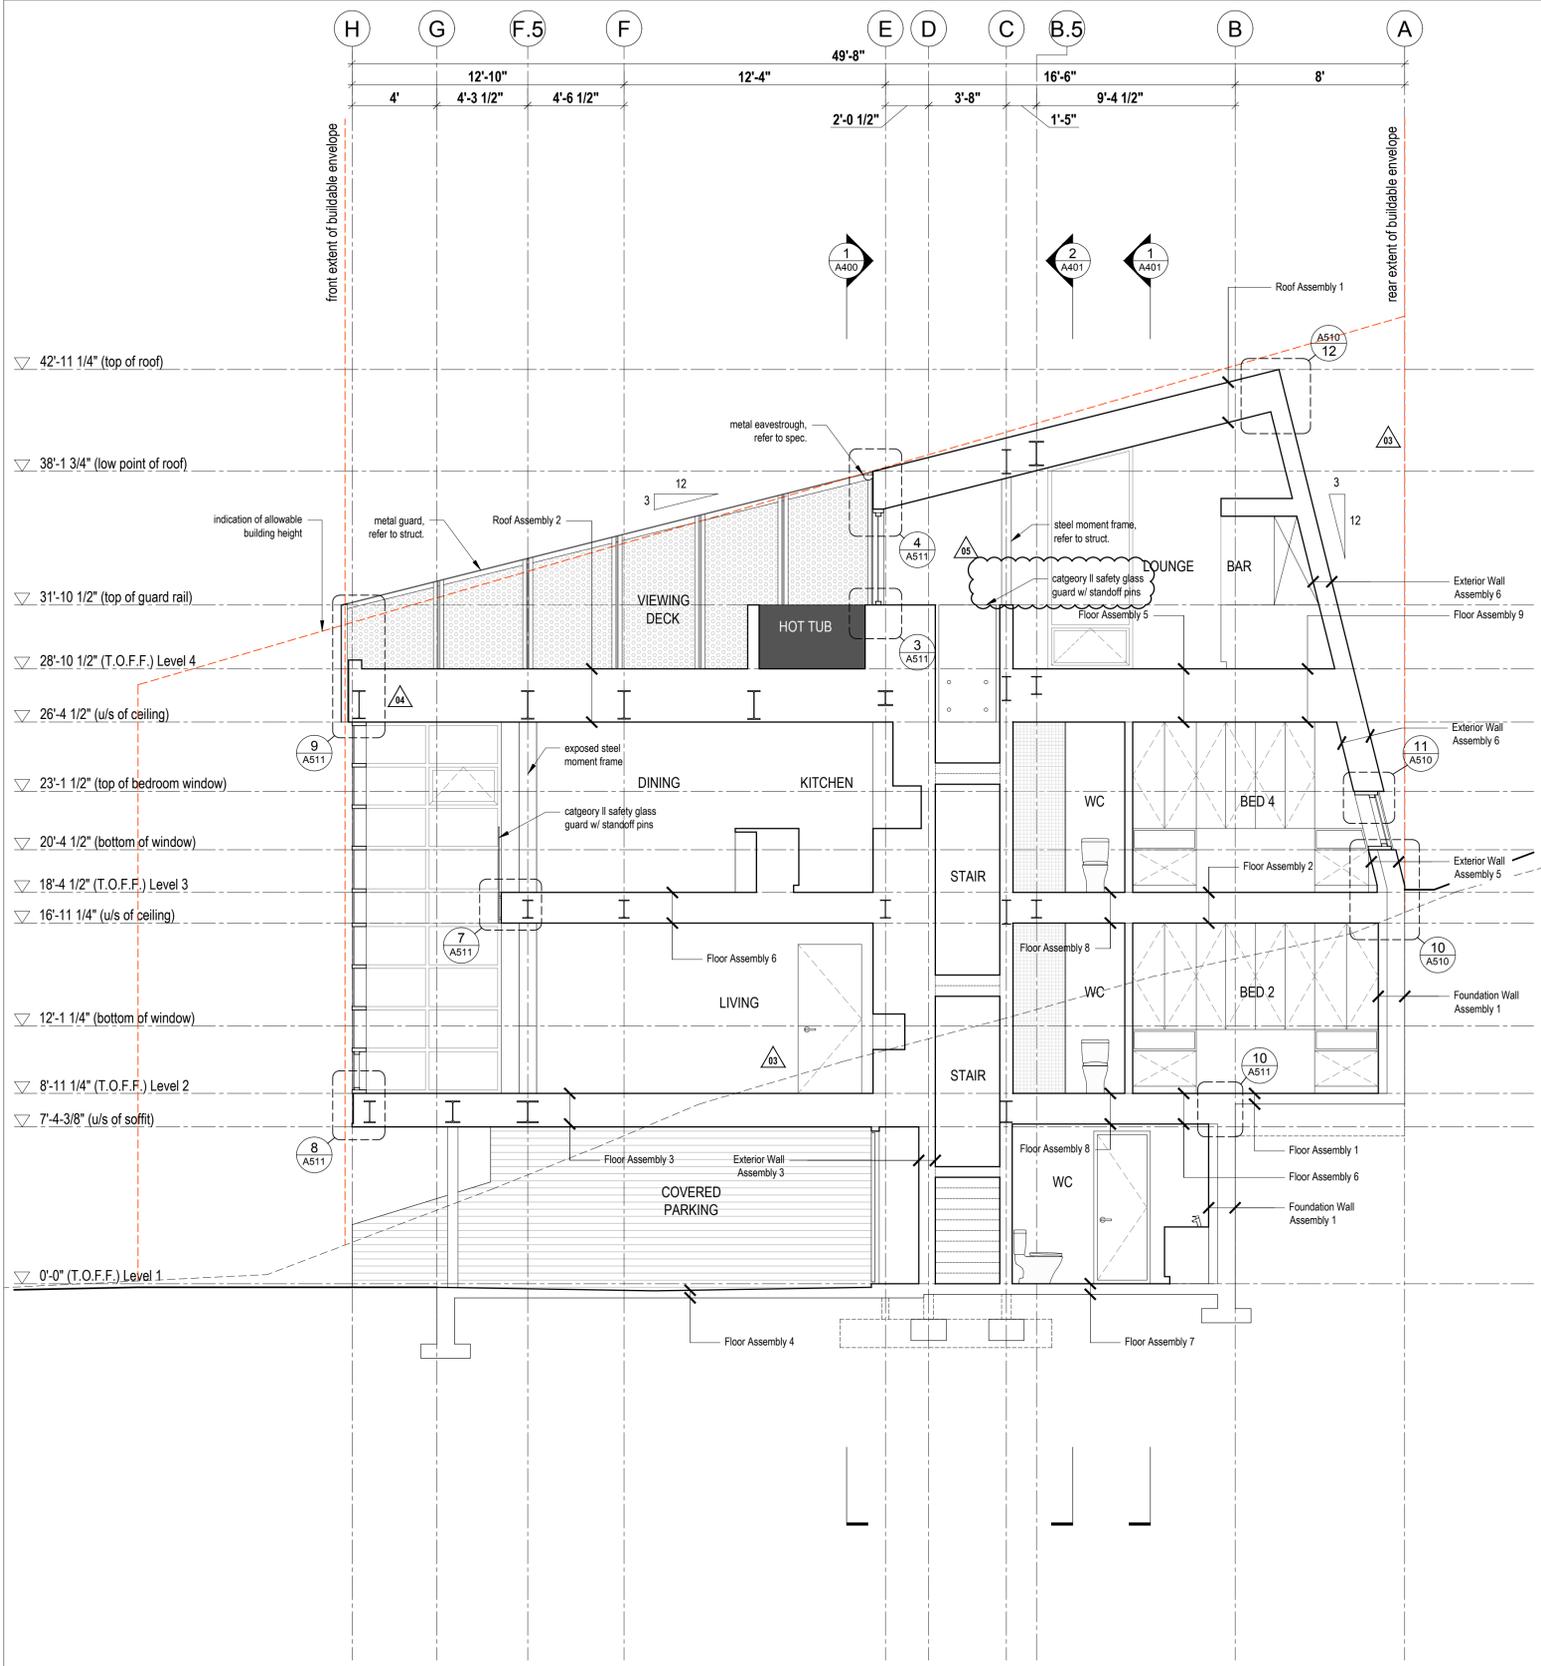

2 Longitudinal Section
Scale 1/4" = 1'-0"

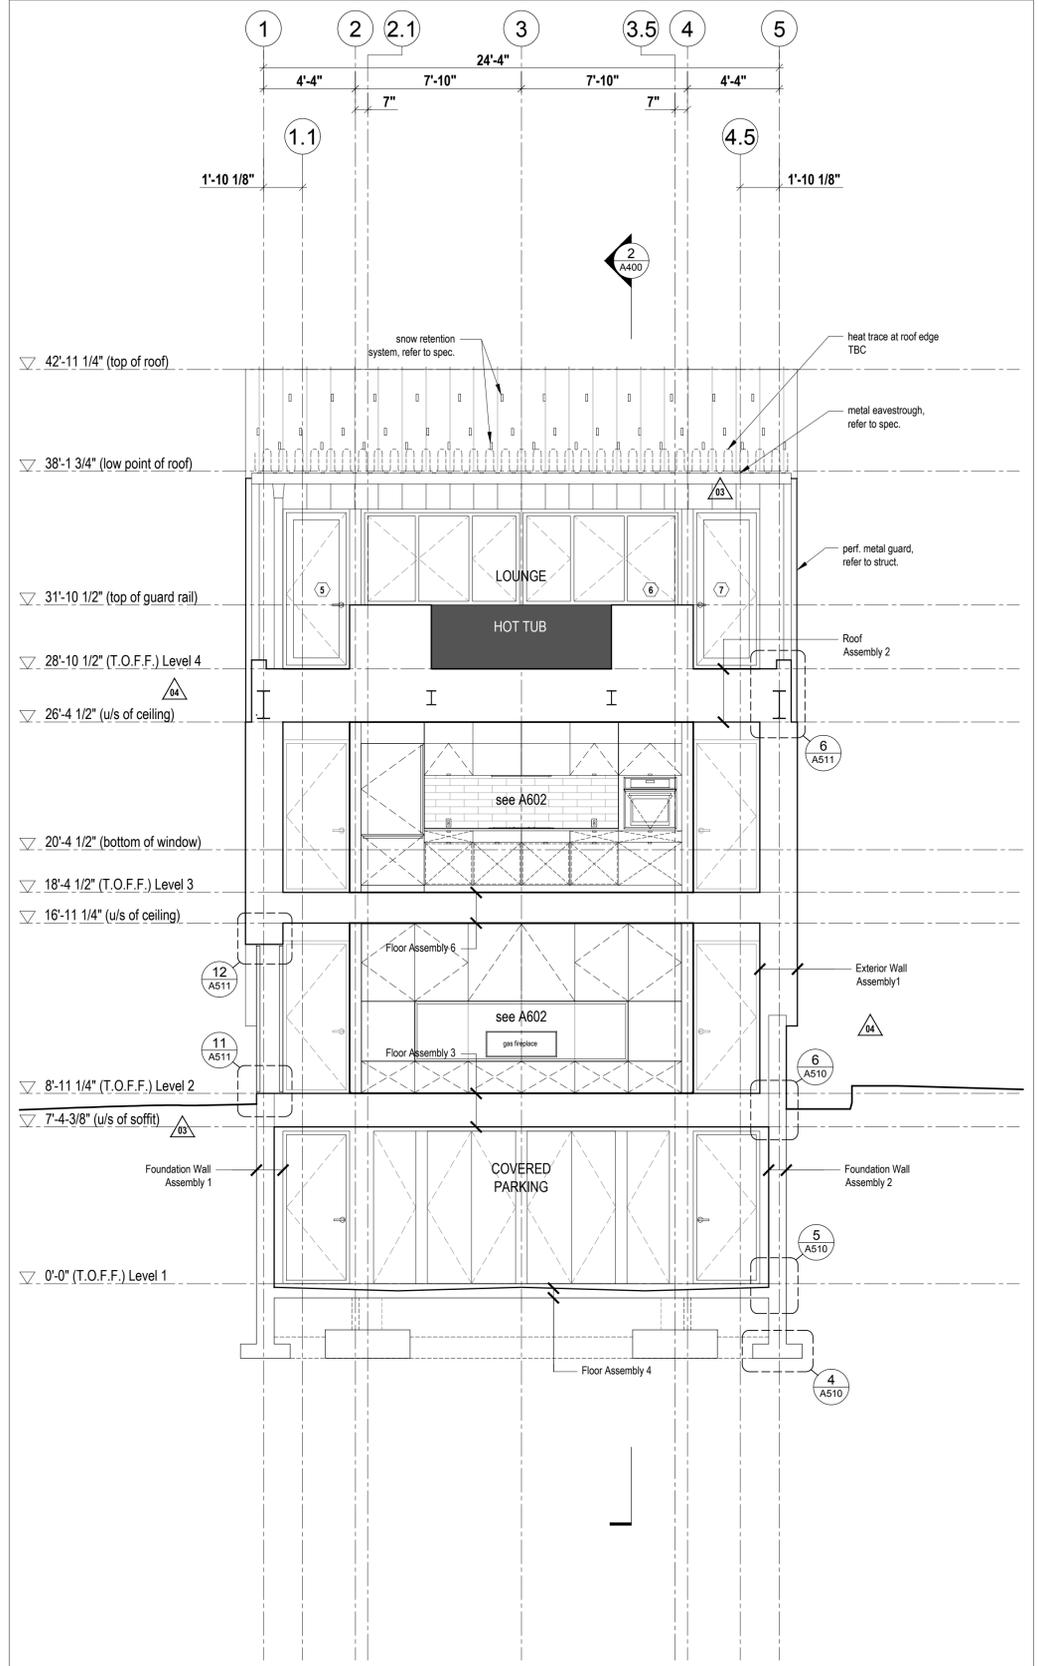

1 Cross Section
Scale 1/4" = 1'-0"

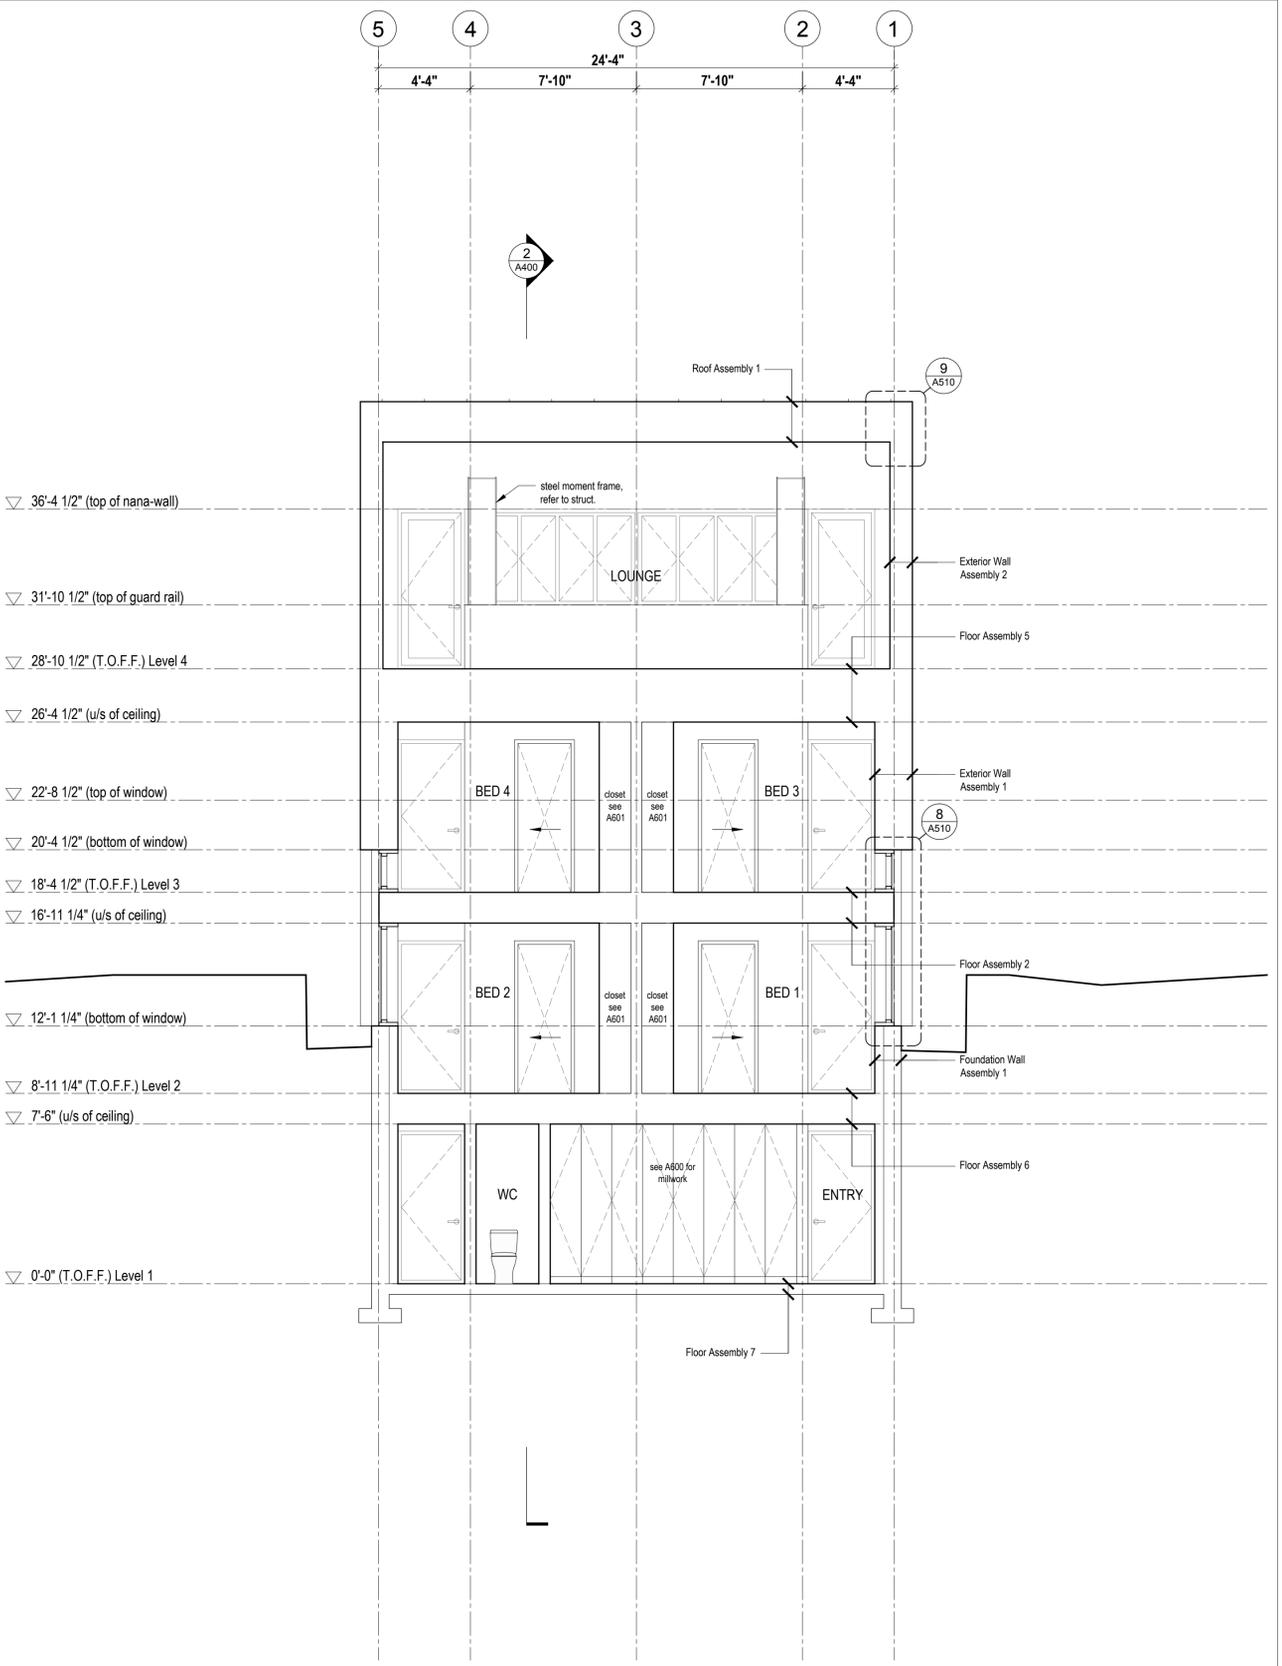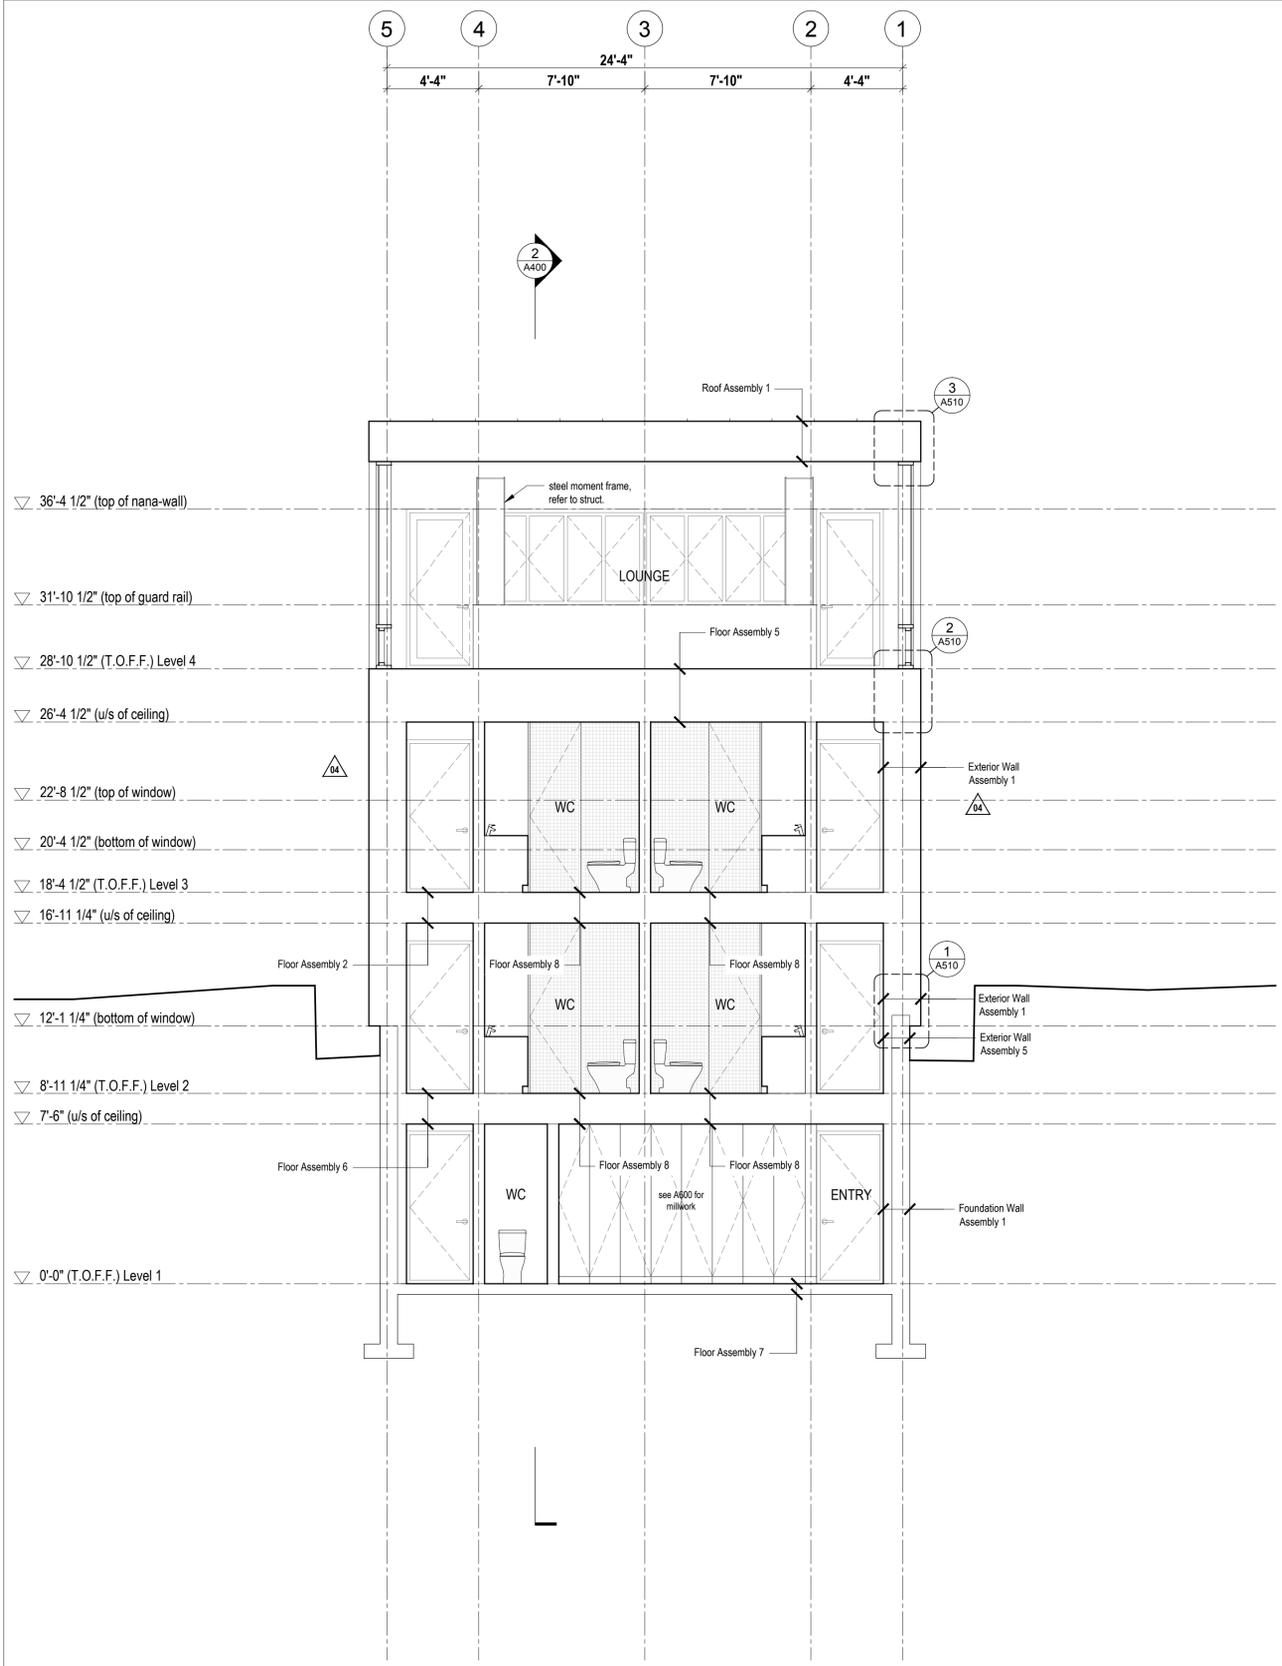

2 Cross Section
Scale 1/4" = 1'-0"

1 Cross Section
Scale 1/4" = 1'-0"

No.	Description	Date
5	IFC Rev 02	2019.02.08
4	IFC Rev 01	2018.06.29
3	Issued for Construction	2018.03.13
2	Issued for Tender	2017.12.22
1	for coordination	2017.12.1

NOTES:

COPYRIGHT RELATED TO THE USE OF THIS DRAWING:
The use of this drawing shall be governed by standard copyright law as generally accepted in architectural practice.

ARCHITECT'S REQUIREMENTS AND APPROVALS:
It is the Builder's responsibility to notify Mackay-Lyons Sweetapple Architects Ltd. and to seek prior written approval for materials and workmanship which deviates from instructions provided by the Architect.

ENGINEER'S REQUIREMENTS AND APPROVALS:
It is the Builder's responsibility to notify Mackay-Lyons Sweetapple Architects Ltd. and to seek prior written approval for materials and workmanship which deviates from instructions provided by the Engineer.

AUTHORITIES' REQUIREMENTS AND APPROVALS:
All materials and workmanship must comply with the requirements of all authorities having jurisdiction over the work. It is the Builder's responsibility to gain necessary approval from all relevant Authorities.

DIMENSIONS:
All dimensions must be verified on site. Do not scale off drawings. Plans take precedent over elevations. In the absence of dimensions, or if discrepancies exist, consult Architect. All minimum dimensions are to comply with the International Residential Code.

SHOP DRAWINGS:
Submit shop drawings to the Architect and Engineer for approval prior to manufacture of prefabricated elements of the building.

Building Sections


scale: 1/4" = 1'-0"
date: 17-11-23
drawn: WPIRD
chk'd: BML

A401

MackKay-Lyons
Sweetapple
Architects
Limited

2188 Göttingen St.
Halifax, Nova Scotia
Canada B3K 3B4

ph: (902) 429.1867
fax: (902) 429.6276

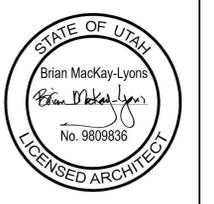

No.	Description	Date
5	IFC Rev 02	2019.02.08
4	IFC Rev 01	2018.06.29
3	Issued for Construction	2018.03.13
2	Issued for Tender	2017.12.22
1	for coordination	2017.12.1

Revision:

NOTES:

COPYRIGHT RELATED TO THE USE OF THIS DRAWING:
The use of this drawing shall be governed by standard copyright law as generally accepted in architectural practice.

ARCHITECT'S REQUIREMENTS AND APPROVALS:
It is the Builder's responsibility to notify MackKay-Lyons Sweetapple Architects Ltd. and to seek prior written approval for materials and workmanship which deviates from instructions provided by the Architect.

ENGINEER'S REQUIREMENTS AND APPROVALS:
It is the Builder's responsibility to notify MackKay-Lyons Sweetapple Architects Ltd. and to seek prior written approval for materials and workmanship which deviates from instructions provided by the Engineer.

AUTHORITIES' REQUIREMENTS AND APPROVALS:
All materials and workmanship must comply with the requirements of all authorities having jurisdiction over the work. It is the Builder's responsibility to gain necessary approval from all relevant Authorities.


DIMENSIONS:
All dimensions must be verified on site. Do not scale off drawings. Plans take precedent over elevations. In the absence of dimensions, or if discrepancies exist, consult Architect. All minimum dimensions are to comply with the International Residential Code.

SHOP DRAWINGS:
Submit shop drawings to the Architect and Engineer for approval prior to manufacture of prefabricated elements of the building.


Plan Details

scale: 1 1/2" = 1'-0"
date: 17-11-23
drawn: RDWP
chk'd: BML


A500

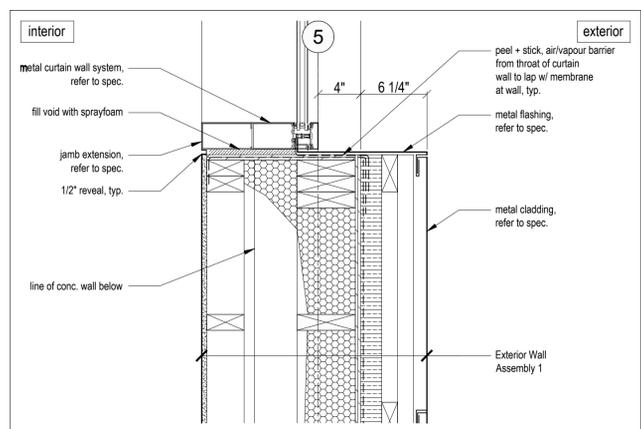


7
Window Jamb at Bedroom Window
Scale 1 1/2" = 1'-0"

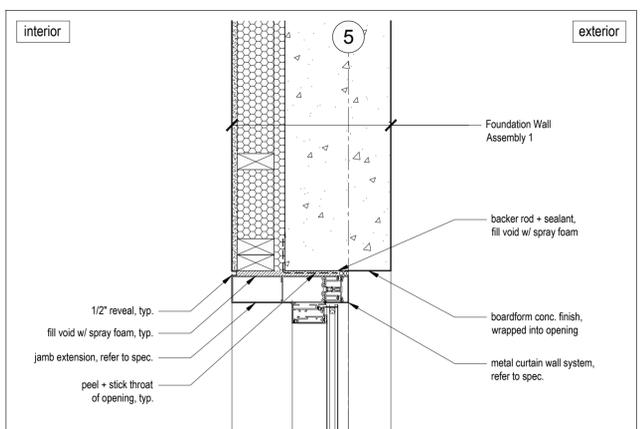


3
Typical Window Jamb at Concrete Wall
Scale 1 1/2" = 1'-0"

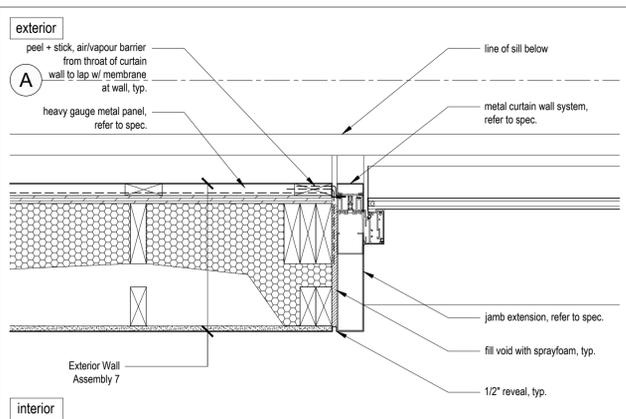

 
10
Typical Upper Bedroom Window Jamb at Sloped Wall
Scale 1 1/2" = 1'-0"




6
NOT USED

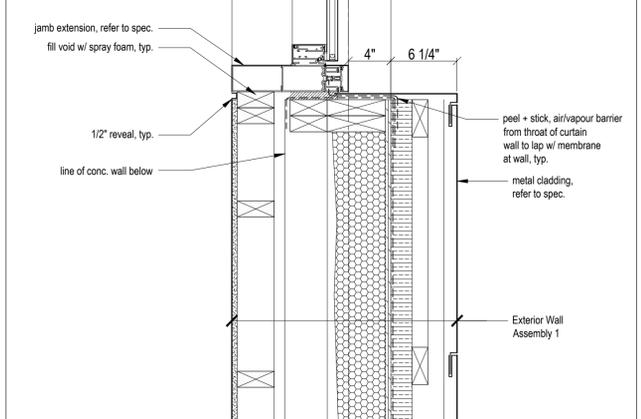


3
Typical Window Jamb at Concrete Wall
Scale 1 1/2" = 1'-0"

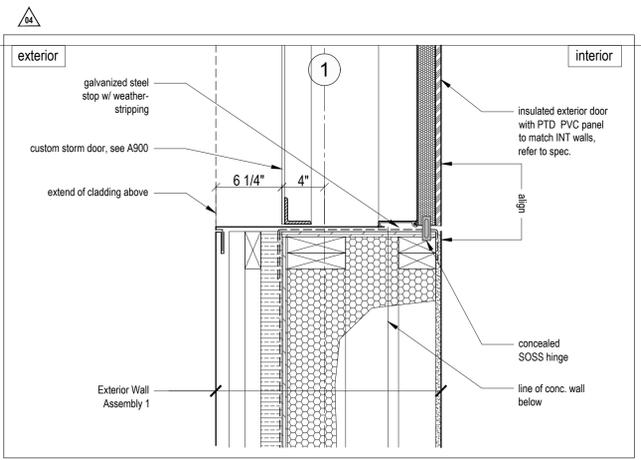


12
Level 2 Egress Door Jamb
Scale 1 1/2" = 1'-0"

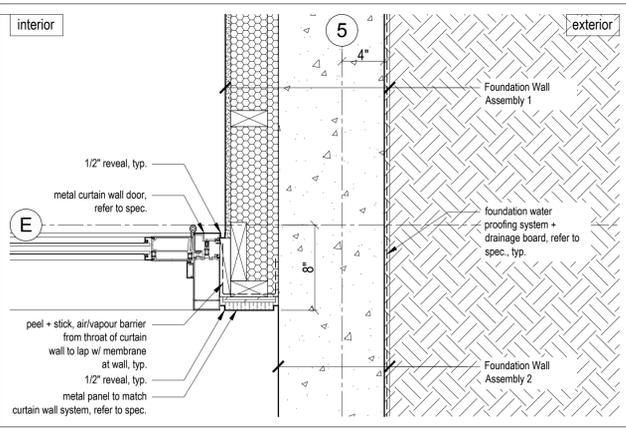


9
Typical Covered Parking Door Jamb
Scale 1 1/2" = 1'-0"

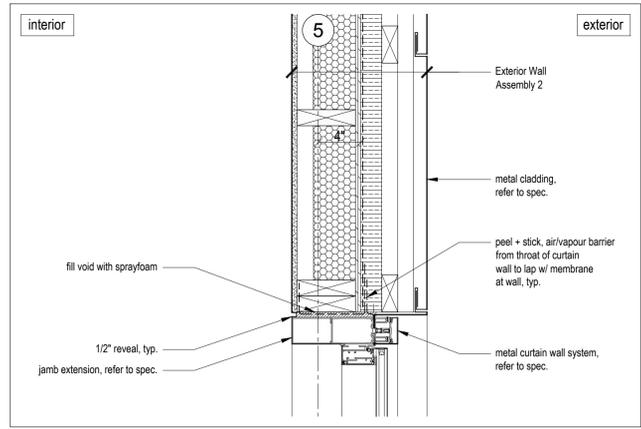


5
Typical Window/Metal Cladding Jamb Detail
Scale 1 1/2" = 1'-0"

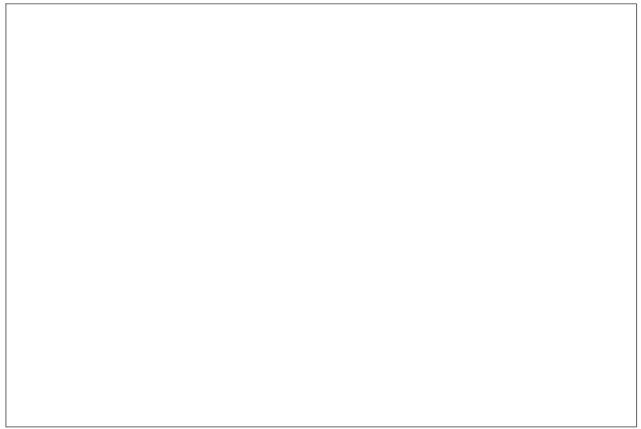


2
NOT USED

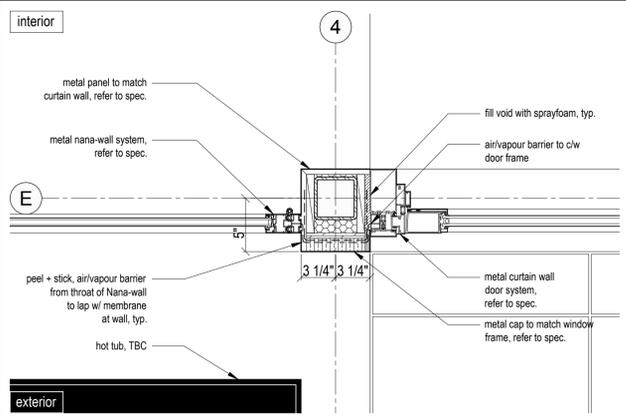


8
HSS Detail at Nana-wall / Door Jamb
Scale 1 1/2" = 1'-0"

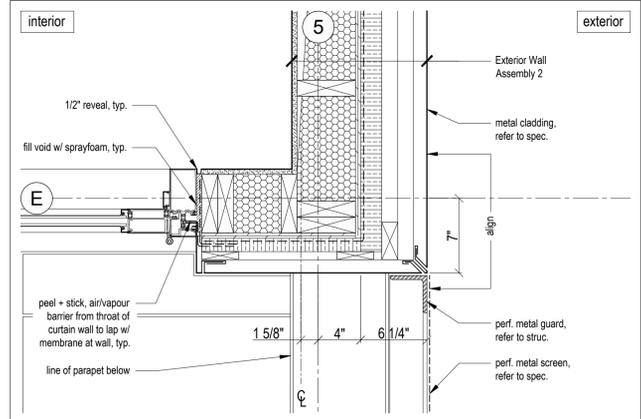


4
Roof Deck Door Jamb and Perforated Guard
Scale 1 1/2" = 1'-0"

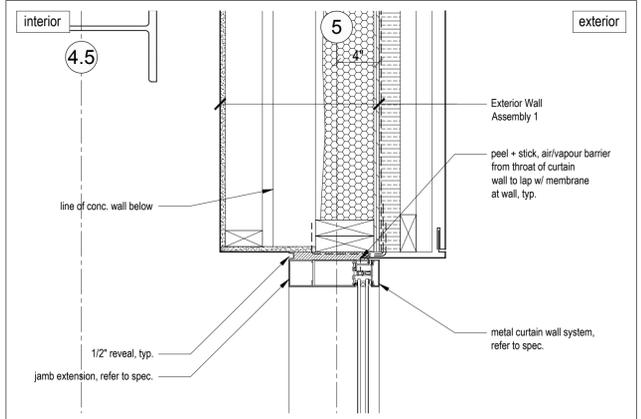


1
Typical Curtain Wall to Concrete Wall
Scale 1 1/2" = 1'-0"

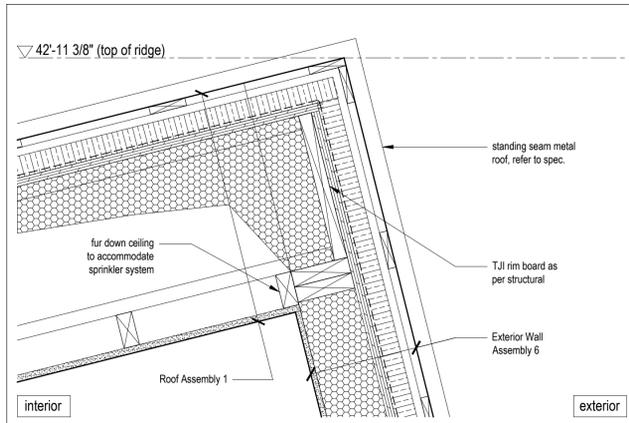


12 Typical Ridge Detail
Scale 1 1/2" = 1'-0"

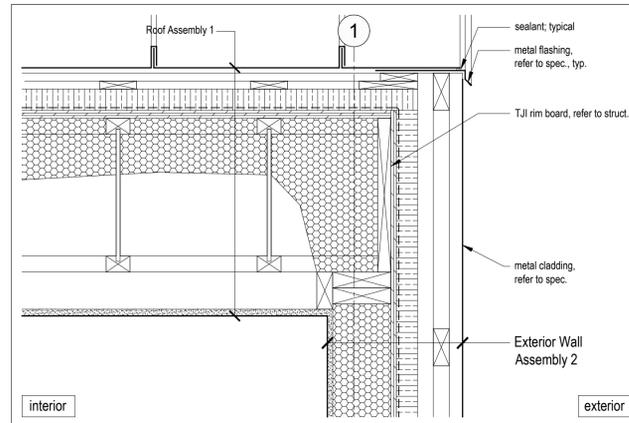


9 Typical Rake Wall/Roof Detail
Scale 1 1/2" = 1'-0"

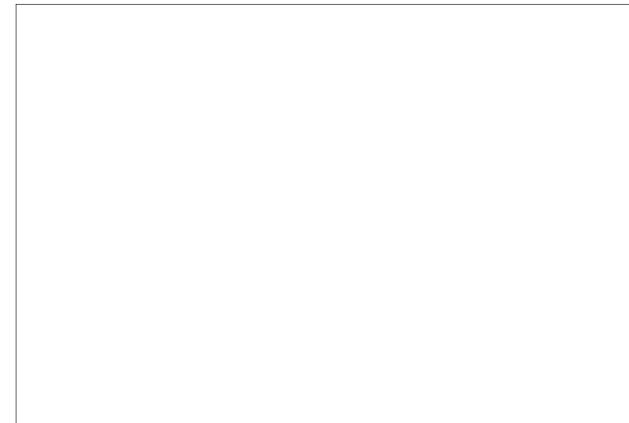


7 NOT USED

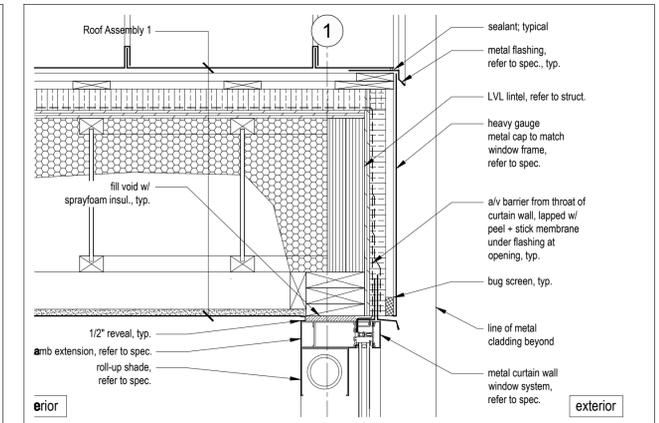


3 Typical Upper Rake Window/Roof Detail
Scale 1 1/2" = 1'-0"

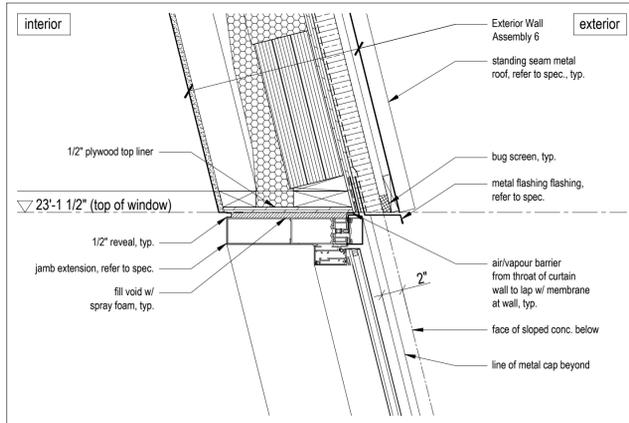


11 Typical Lower Raked Head Detail
Scale 1 1/2" = 1'-0"

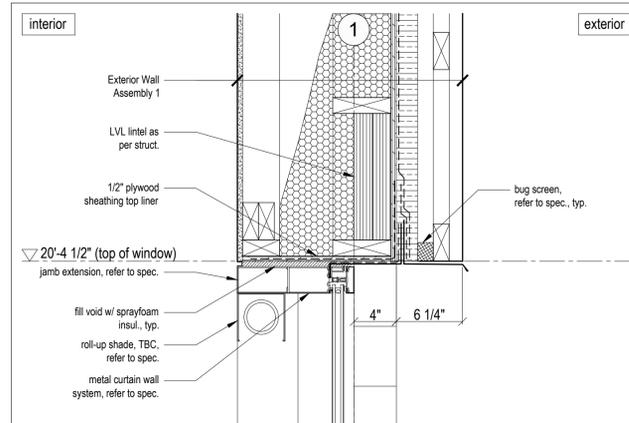


6 Typical Floor/Concrete Wall Detail

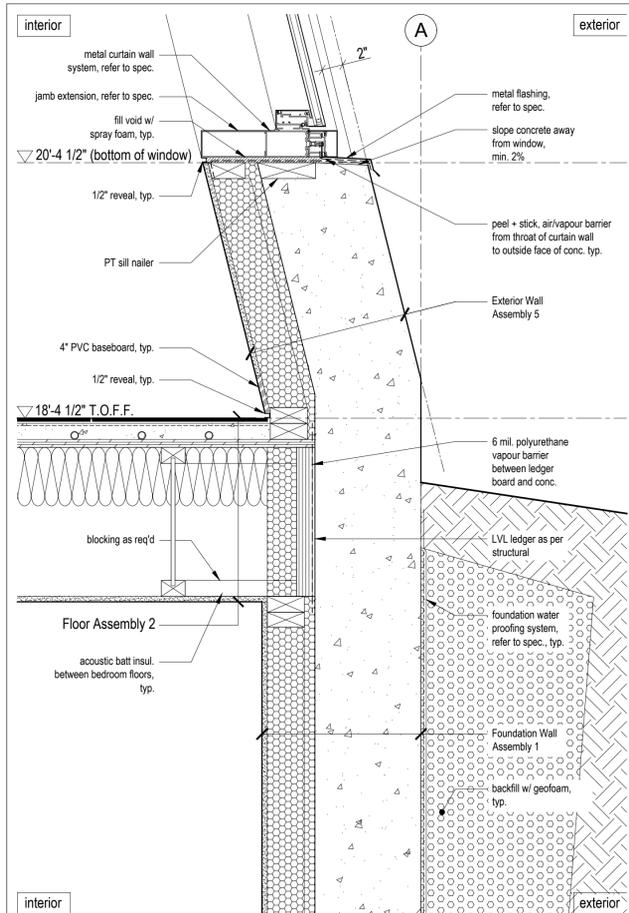


10 Typical Lower Raked Concrete Sill/Floor Detail
Scale 1 1/2" = 1'-0"

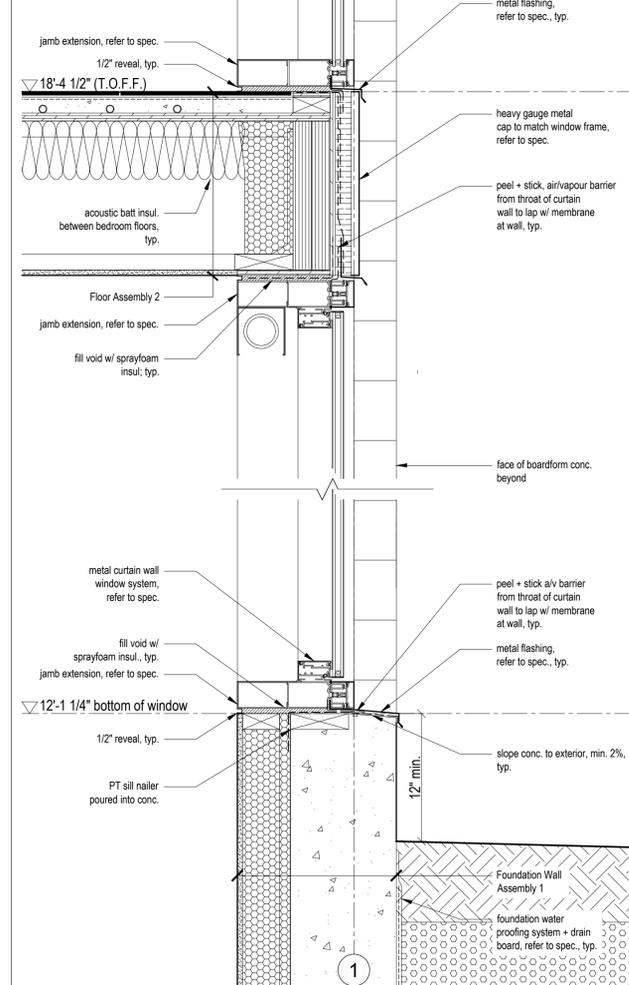


8 Typical Lower Level Bedroom Window Sill Detail
Scale 1 1/2" = 1'-0"

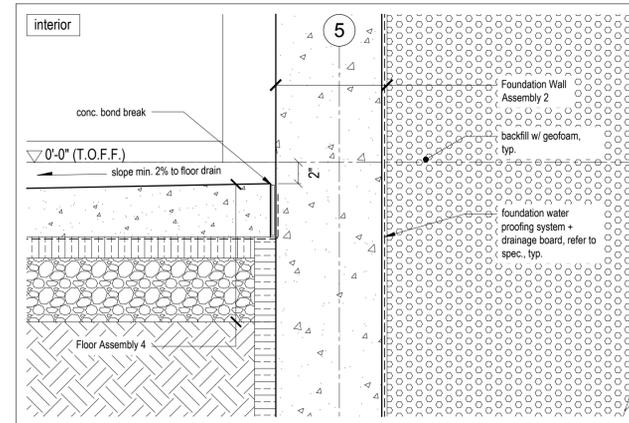


5 Typical Foundation Wall/Slab Detail

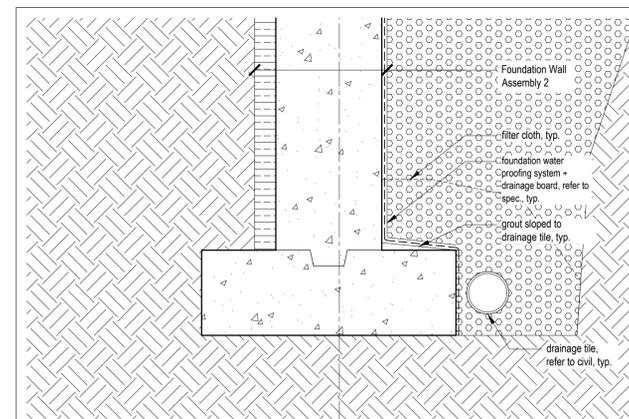

4 Typical Footing Detail

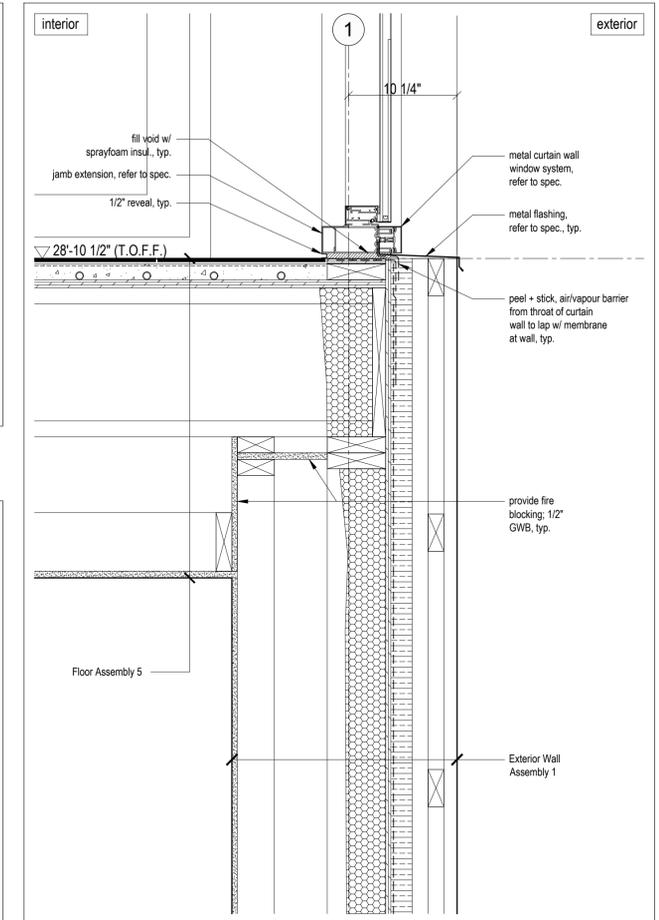

2 Typical Lounge Window Sill/Floor Detail
Scale 1 1/2" = 1'-0"

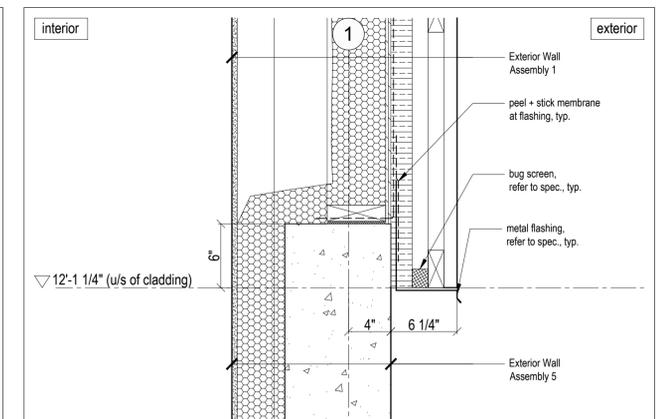

1 Typical Concrete/Cladding Wall Detail
Scale 1 1/2" = 1'-0"

Lot 71R
Village House

Summit Power Mountain
Econ. Unit

MackKay-Lyons
Sweetapple
Architects
Limited

2188 Göttingen St.
Halifax, Nova Scotia
Canada B3K 3B4

ph: (902) 429-1867
fax: (902) 429-6276



No.	Description	Date
5	IFC Rev 02	2019.02.08
4	IFC Rev 01	2018.06.29
3	Issued for Construction	2018.03.13
2	Issued for Tender	2017.12.22
1	for coordination	2017.12.1

NOTES:

COPYRIGHT RELATED TO THE USE OF THIS DRAWING:
The use of this drawing shall be governed by standard copyright law as generally accepted in architectural practice.

ARCHITECT'S REQUIREMENTS AND APPROVALS:
It is the Builder's responsibility to notify MackKay-Lyons Sweetapple Architects Ltd. and to seek prior written approval for materials and workmanship which deviates from instructions provided by the Architect.

ENGINEER'S REQUIREMENTS AND APPROVALS:
It is the Builder's responsibility to notify MackKay-Lyons Sweetapple Architects Ltd. and to seek prior written approval for materials and workmanship which deviates from instructions provided by the Engineer.

AUTHORITIES' REQUIREMENTS AND APPROVALS:
All materials and workmanship must comply with the requirements of all authorities having jurisdiction over the work. It is the Builder's responsibility to gain necessary approval from all relevant Authorities.


DIMENSIONS:
All dimensions must be verified on site. Do not scale off drawings. Plans take precedent over elevations. In the absence of dimensions, or if discrepancies exist, consult Architect. All minimum dimensions are to comply with the International Residential Code.

SHOP DRAWINGS:
Submit shop drawings to the Architect and Engineer for approval prior to manufacture of prefabricated elements of the building.


Section Details

scale: 1 1/2" = 1'-0"
date: 17-11-23
drawn: RD
chk'd: BML


A510

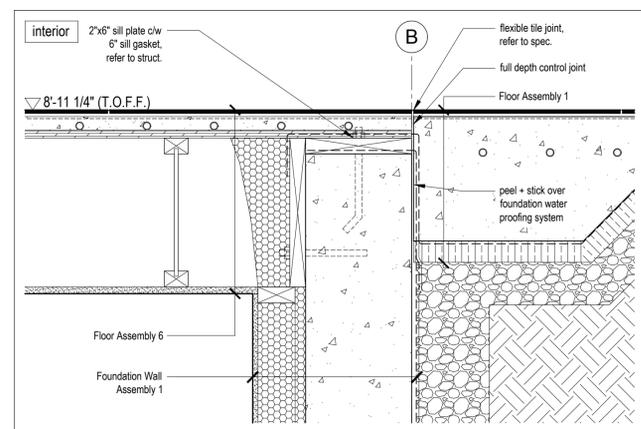


10 Foundation Wall/Slab/Floor Detail
Scale 1 1/2" = 1'-0"

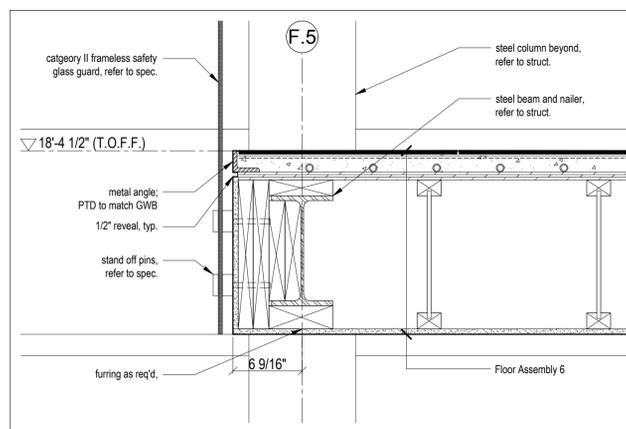


7 Typical Interior Glass Guard Detail
Scale 1 1/2" = 1'-0"

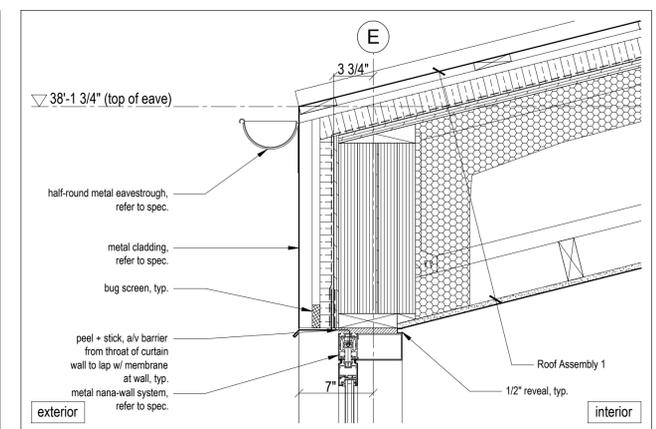


4 Typical Eave/Nana-wall Detail
Scale 1 1/2" = 1'-0"

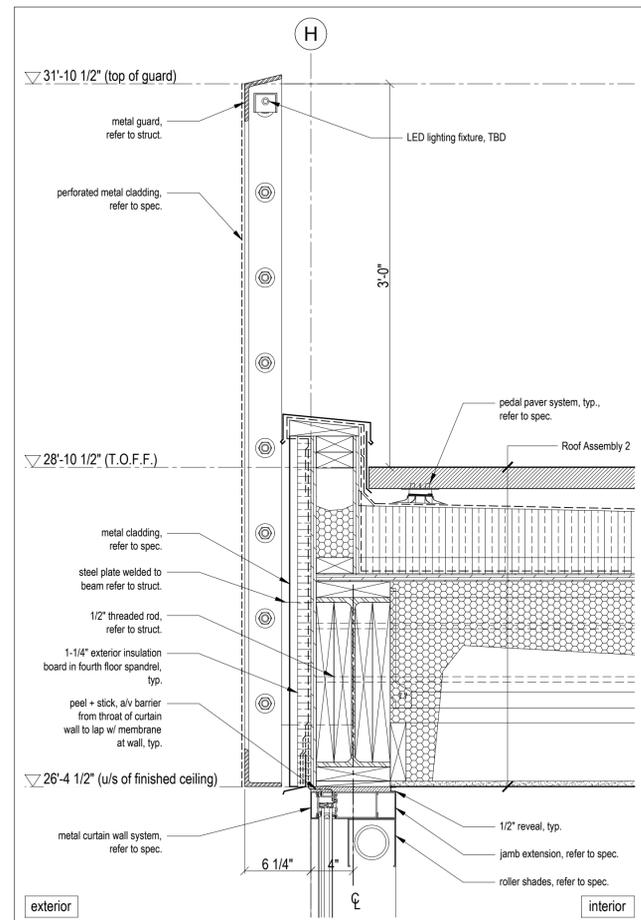


9 Guard/Roof Deck Detail @ Grid H
Scale 1 1/2" = 1'-0"

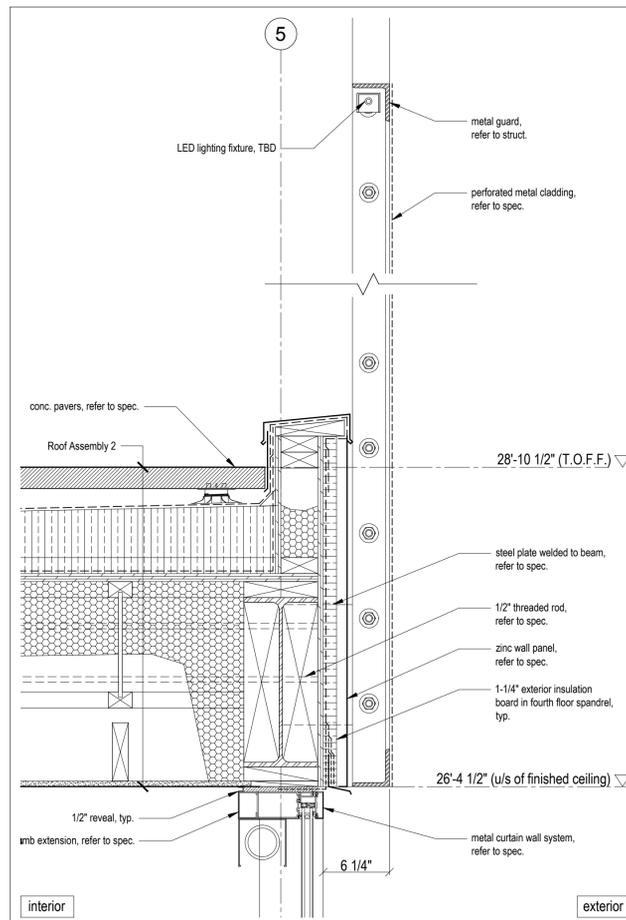


6 Typical Guard/Roof Deck Detail @ Grid 1 & 5
Scale 1 1/2" = 1'-0"

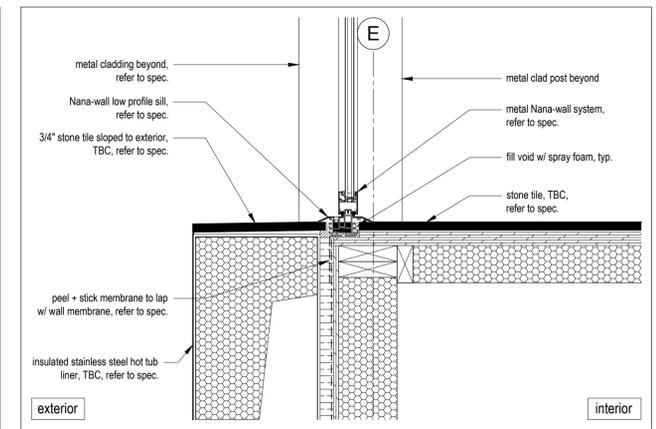


3 Nana-wall Sill Detail
Scale 1 1/2" = 1'-0"

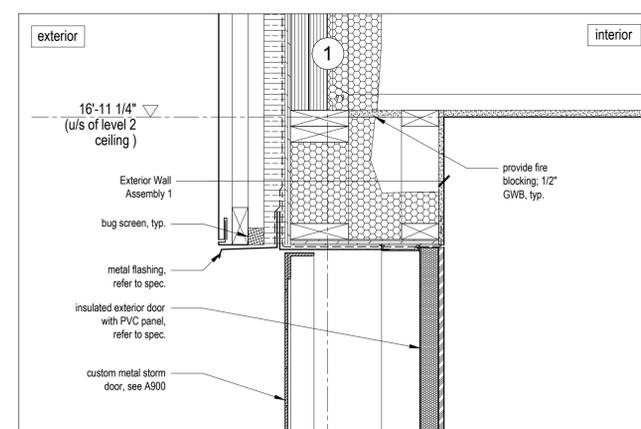


12 Egress Door Head
Scale 1 1/2" = 1'-0"

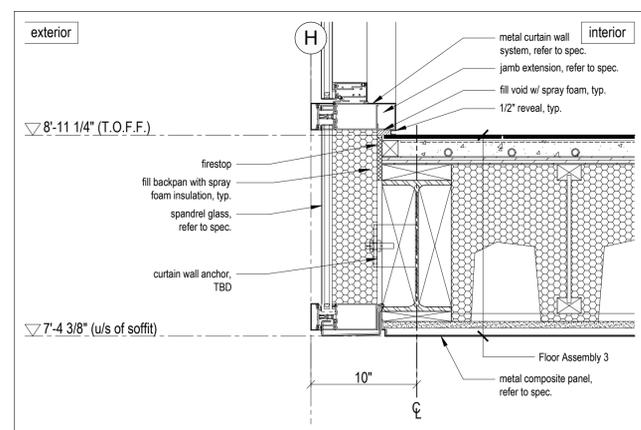


8 Living Room Bottom of Curtain Wall/Cantilever Detail
Scale 1 1/2" = 1'-0"

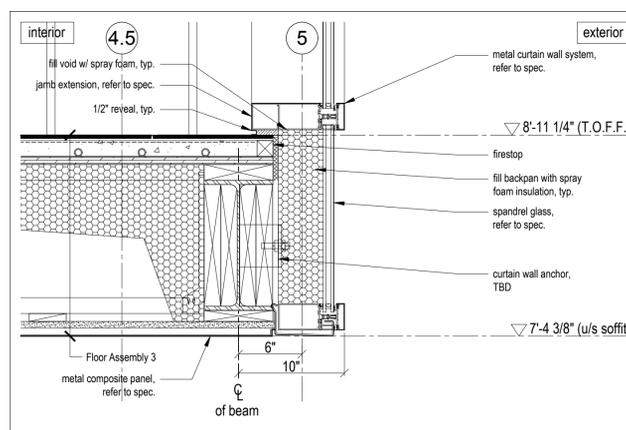


5 Living Room Bottom of Curtain Wall Detail
Scale 1 1/2" = 1'-0"

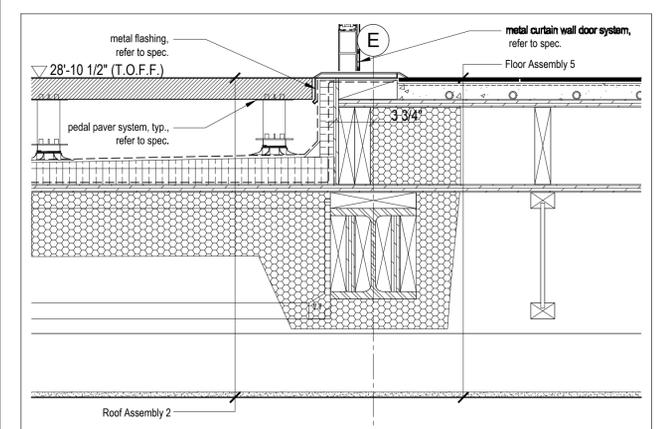

2 Typical Deck/Door Threshold Detail
Scale 1 1/2" = 1'-0"

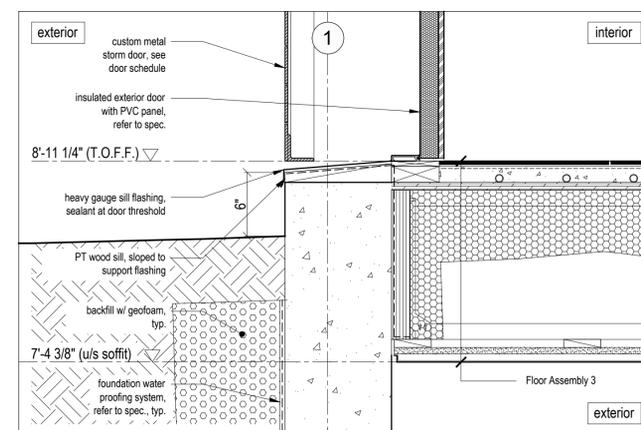

11 Egress Door Sill
Scale 1 1/2" = 1'-0"

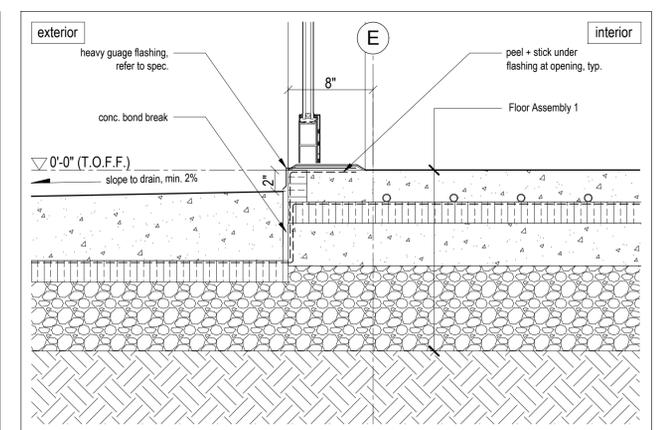

1 Typical Garage Slab/Door Threshold Detail
Scale 1 1/2" = 1'-0"

No.	Description	Date
5	IFC Rev 02	2019.02.08
4	IFC Rev 01	2018.06.29
3	Issued for Construction	2018.03.13
2	Issued for Tender	2017.12.22
1	for coordination	2017.12.1

NOTES:

COPYRIGHT RELATED TO THE USE OF THIS DRAWING:
The use of this drawing shall be governed by standard copyright law as generally accepted in architectural practice.

ARCHITECT'S REQUIREMENTS AND APPROVALS:
It is the Builder's responsibility to notify MacKay-Lyons Sweetapple Architects Ltd. and to seek prior written approval for materials and workmanship which deviates from instructions provided by the Architect.

ENGINEER'S REQUIREMENTS AND APPROVALS:
It is the Builder's responsibility to notify MacKay-Lyons Sweetapple Architects Ltd. and to seek prior written approval for materials and workmanship which deviates from instructions provided by the Engineer.

AUTHORITIES' REQUIREMENTS AND APPROVALS:
All materials and workmanship must comply with the requirements of all authorities having jurisdiction over the work. It is the Builder's responsibility to gain necessary approval from all relevant Authorities.


DIMENSIONS:
All dimensions must be verified on site. Do not scale off drawings. Plans take precedent over elevations. In the absence of dimensions, or if discrepancies exist, consult Architect. All minimum dimensions are to comply with the International Residential Code.

SHOP DRAWINGS:
Submit shop drawings to the Architect and Engineer for approval prior to manufacture of prefabricated elements of the building.


Section
Details

scale: 1 1/2" = 1'-0"
date: 17-11-23
drawn: RDWP
chk'd: BML


A511

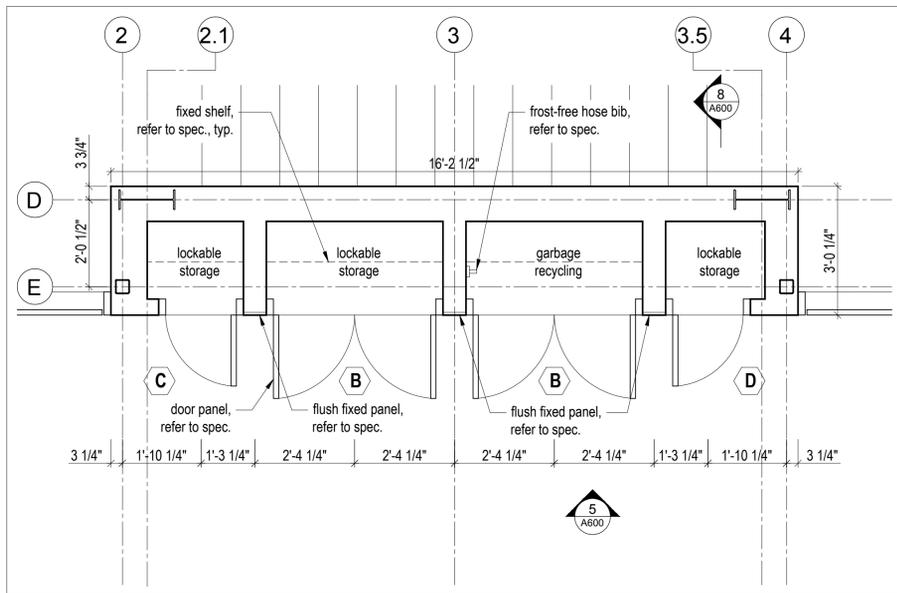


9 Garage Closet - Enlarged Plan
Scale 1/2" = 1'-0"

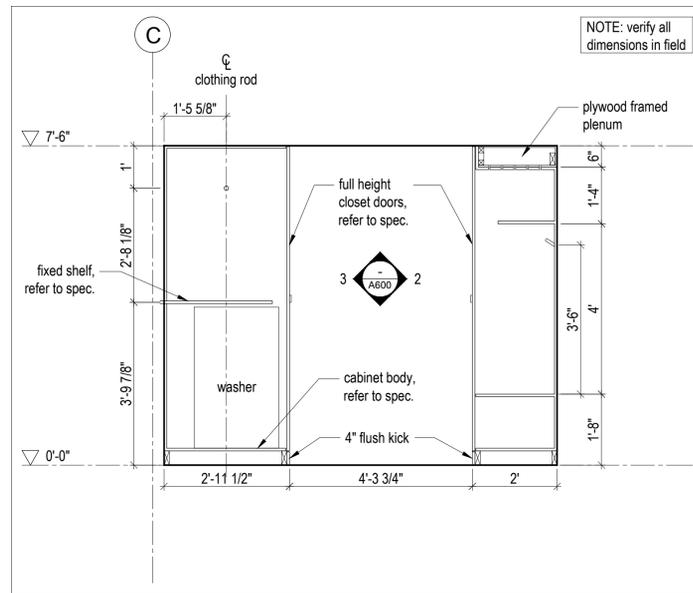


6 Laundry/Ski Equipment Closet- Section Detail
Scale 1/2" = 1'-0"

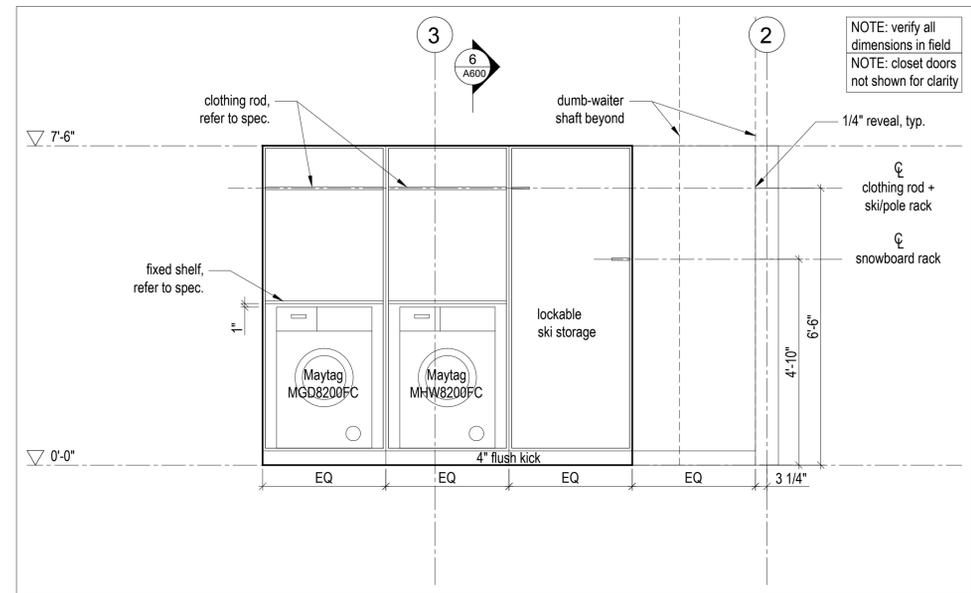

 
3 Laundry/Ski Equipment Closet - Elevation
Scale 1/2" = 1'-0"




8 NOT USED

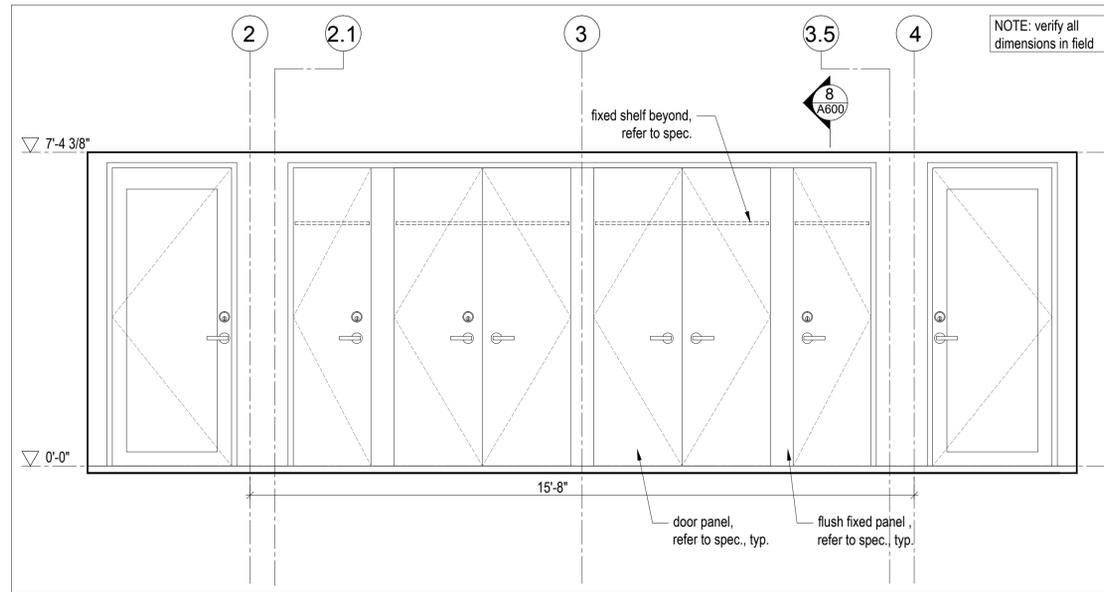


5 Garage Closet - Section Detail
Scale 1/2" = 1'-0"

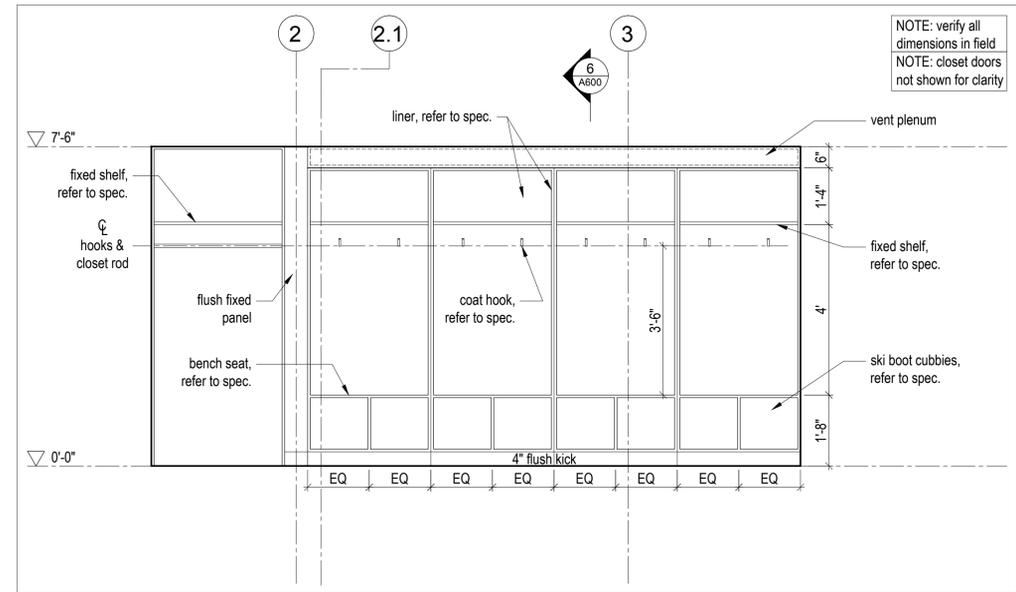


2 Ski Equipment Closet - Elevation
Scale 1/2" = 1'-0"

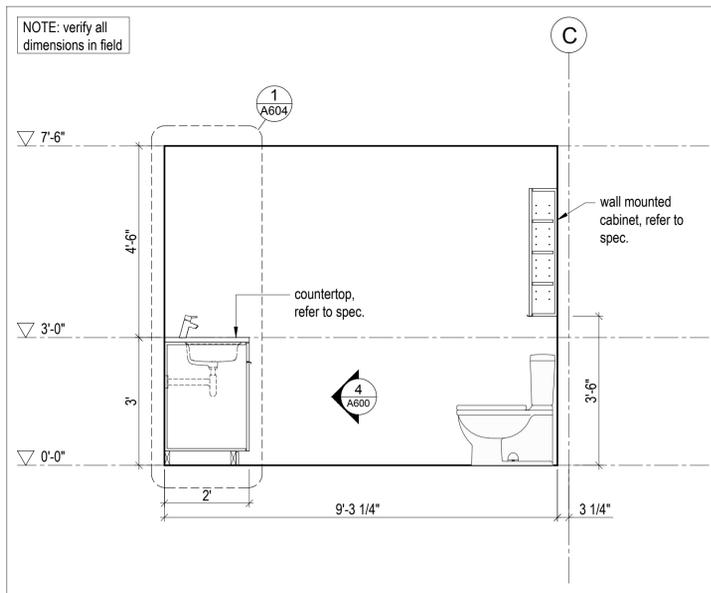


7 Bathroom - Section Detail
Scale 1/2" = 1'-0"

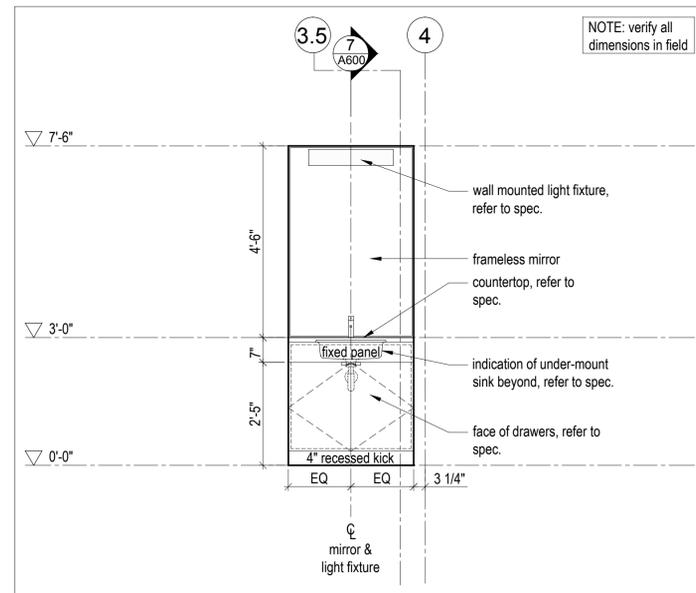


4 Bathroom - Elevation
Scale 1/2" = 1'-0"

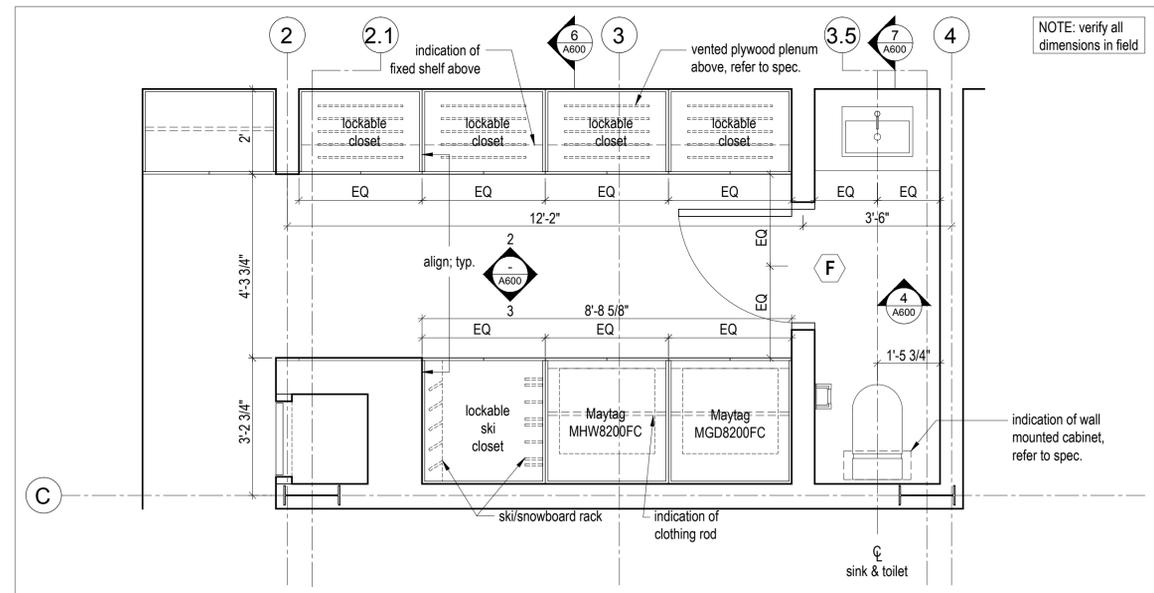

1 Bathroom - Enlarged Plan
Scale 1/2" = 1'-0"

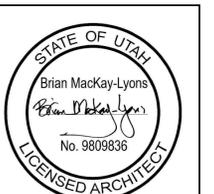

NOTE: all dimensions to be verified in field

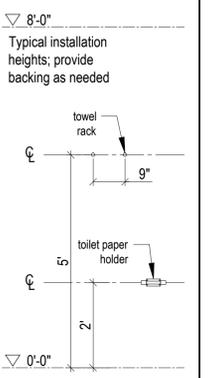

No.	Description	Date
5	IFC Rev 02	2019.02.08
4	IFC Rev 01	2018.06.29
3	Issued for Construction	2018.03.13
2	Issued for Tender	2017.12.22
1	for coordination	2017.12.1

NOTES:

COPYRIGHT RELATED TO THE USE OF THIS DRAWING:
The use of this drawing shall be governed by standard copyright law as generally accepted in architectural practice.

ARCHITECT'S REQUIREMENTS AND APPROVALS:
It is the Builder's responsibility to notify MacKay-Lyons Sweetapple Architects Ltd. and to seek prior written approval for materials and workmanship which deviates from instructions provided by the Architect.

ENGINEER'S REQUIREMENTS AND APPROVALS:
It is the Builder's responsibility to notify MacKay-Lyons Sweetapple Architects Ltd. and to seek prior written approval for materials and workmanship which deviates from instructions provided by the Engineer.


AUTHORITIES' REQUIREMENTS AND APPROVALS:
All materials and workmanship must comply with the requirements of all authorities having jurisdiction over the work. It is the Builder's responsibility to gain necessary approval from all relevant Authorities.

DIMENSIONS:
All dimensions must be verified on site. Do not scale off drawings. Plans take precedent over elevations. In the absence of dimensions, or if discrepancies exist, consult Architect. All minimum dimensions are to comply with the International Residential Code.

SHOP DRAWINGS:
Submit shop drawings to the Architect and Engineer for approval prior to manufacture of prefabricated elements of the building.



NOTE: all dimensions to be verified in field

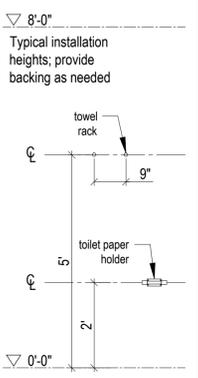

No.	Description	Date
5	IFC Rev 02	2019.02.08
4	IFC Rev 01	2018.06.29
3	Issued for Construction	2018.03.13
2	Issued for Tender	2017.12.22
1	for coordination	2017.12.1

Revision:

NOTES:
COPYRIGHT RELATED TO THE USE OF THIS DRAWING:
The use of this drawing shall be governed by standard copyright law as generally accepted in architectural practice.

ARCHITECT'S REQUIREMENTS AND APPROVALS:
It is the Builder's responsibility to notify Mackay-Lyons Sweetapple Architects Ltd. and to seek prior written approval for materials and workmanship which deviates from instructions provided by the Architect.


ENGINEER'S REQUIREMENTS AND APPROVALS:
It is the Builder's responsibility to notify Mackay-Lyons Sweetapple Architects Ltd. and to seek prior written approval for materials and workmanship which deviates from instructions provided by the Engineer.

AUTHORITIES' REQUIREMENTS AND APPROVALS:
All materials and workmanship must comply with the requirements of all authorities having jurisdiction over the work. It is the Builder's responsibility to gain necessary approval from all relevant Authorities.


DIMENSIONS:
All dimensions must be verified on site. Do not scale off drawings. Plans take precedent over elevations. In the absence of dimensions, or if discrepancies exist, consult Architect. All minimum dimensions are to comply with the International Residential Code.

SHOP DRAWINGS:
Submit shop drawings to the Architect and Engineer for approval prior to manufacture of prefabricated elements of the building.


Millwork -
Second Floor

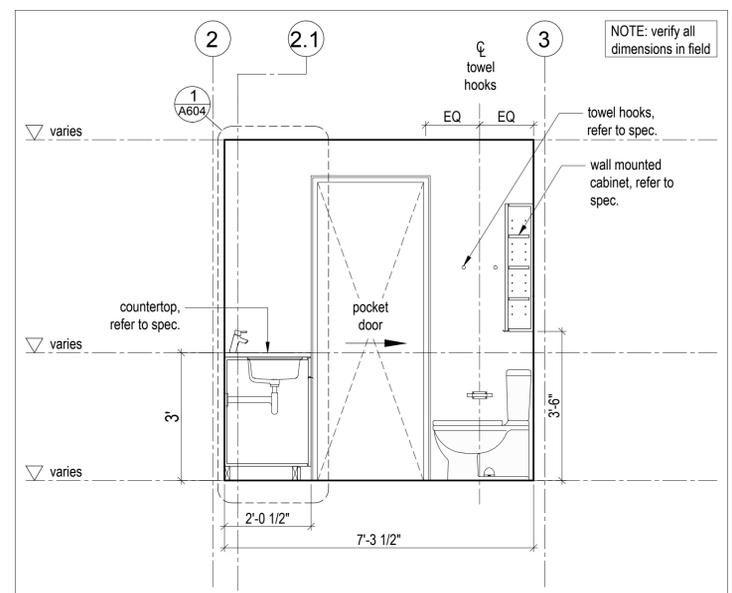


3 A601 Ensuite - Section Detail, Typ.
Scale 1/2" = 1'-0"

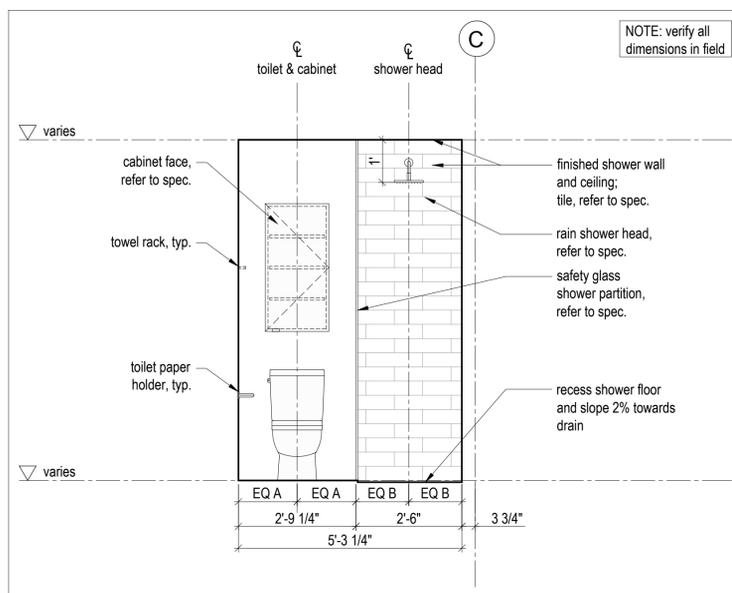


6 A601 Ensuite - Elevation, Typ.
Scale 1/2" = 1'-0"

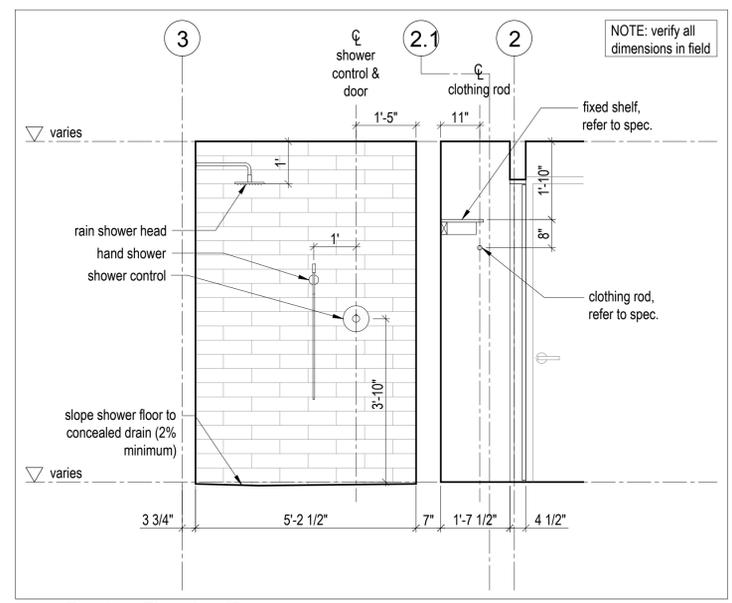


2 A601 Ensuite - Elevation, Typ.
Scale 1/2" = 1'-0"

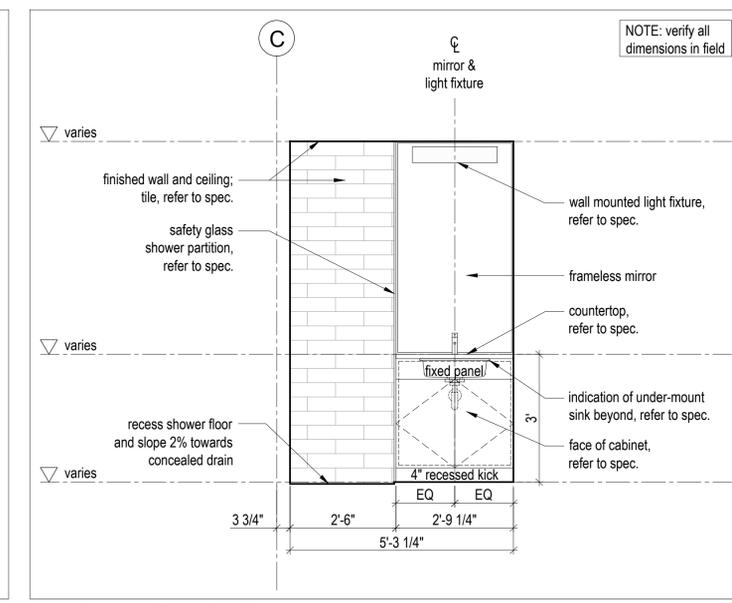


5 A601 Ensuite - Elevation, Typ.
Scale 1/2" = 1'-0"

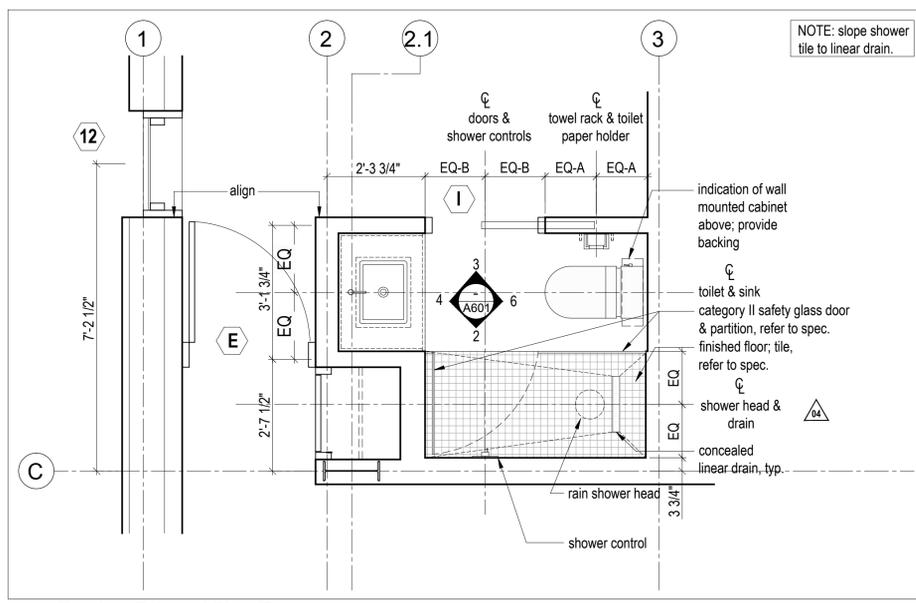


8 A601 Ensuite - Enlarged Plan, Typ.
Scale 1/2" = 1'-0"

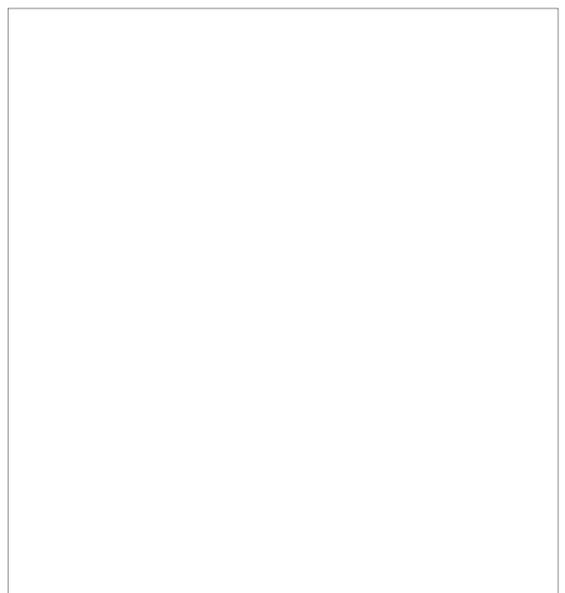


7 A601 Not Used
Scale 1/2" = 1'-0"

 


4 A601 Not Used
Scale 1/2" = 1'-0"

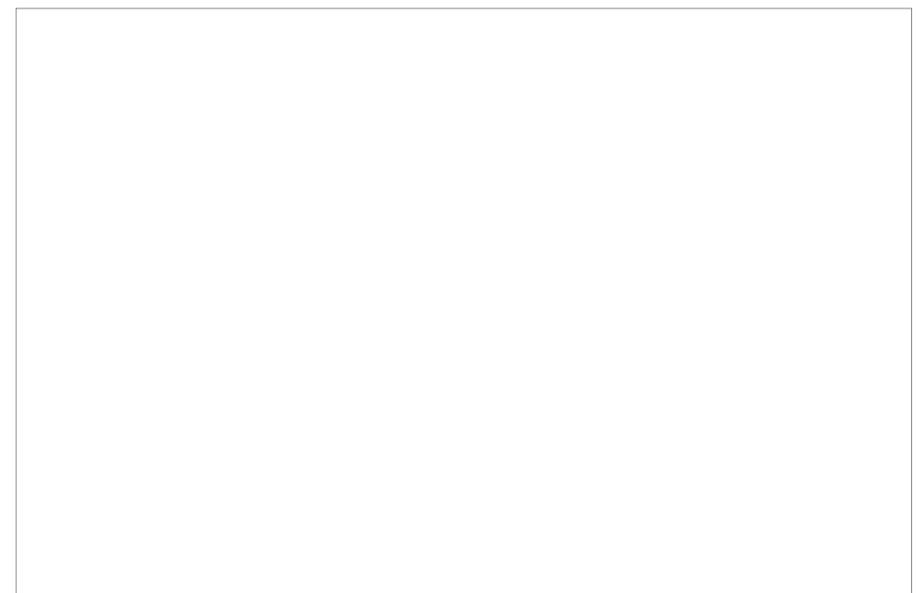


1 A601 Not Used
Scale 1/2" = 1'-0"

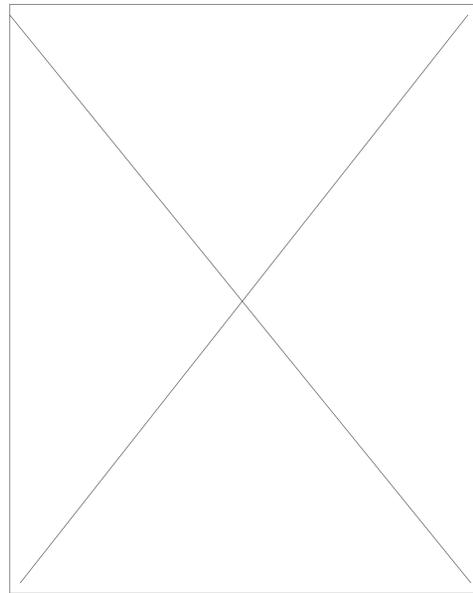


9 Not Used
Scale 1/2" = 1'-0"

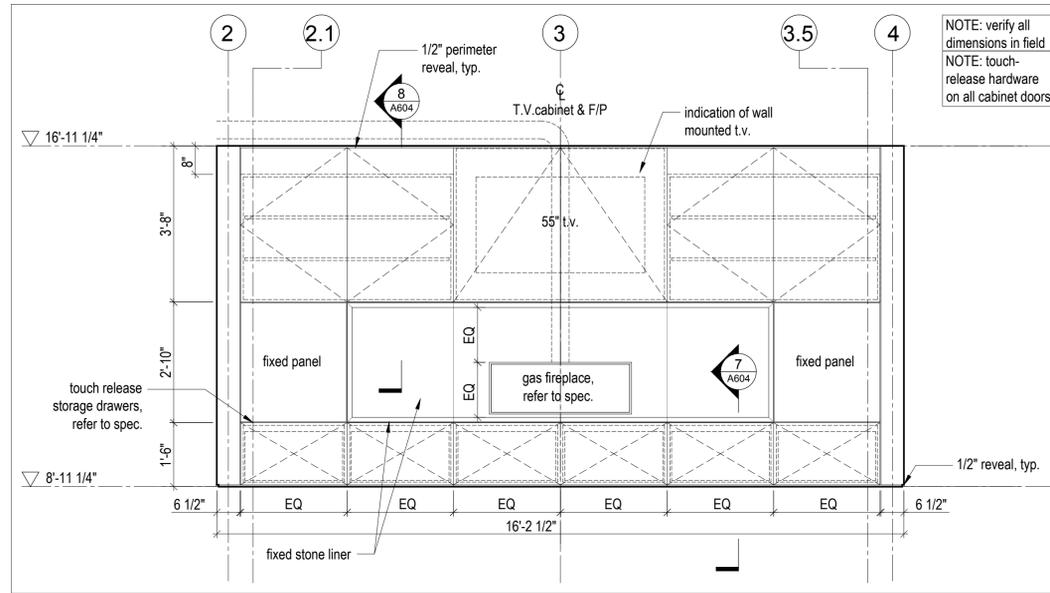


8 Hearth - Elevation
Scale 1/2" = 1'-0"

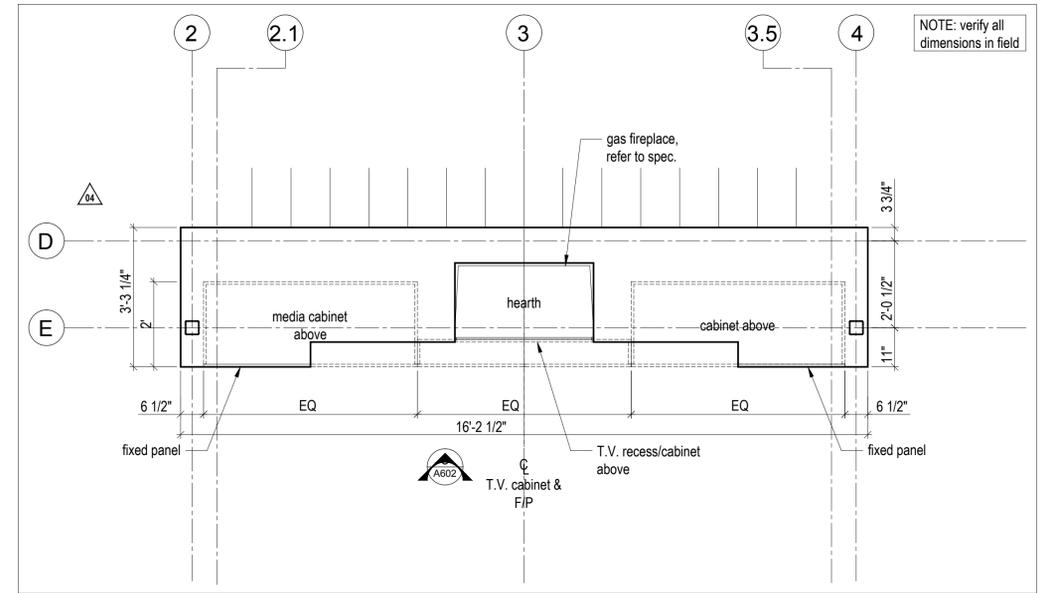

3 Hearth - Enlarged Plan
Scale 1/2" = 1'-0"

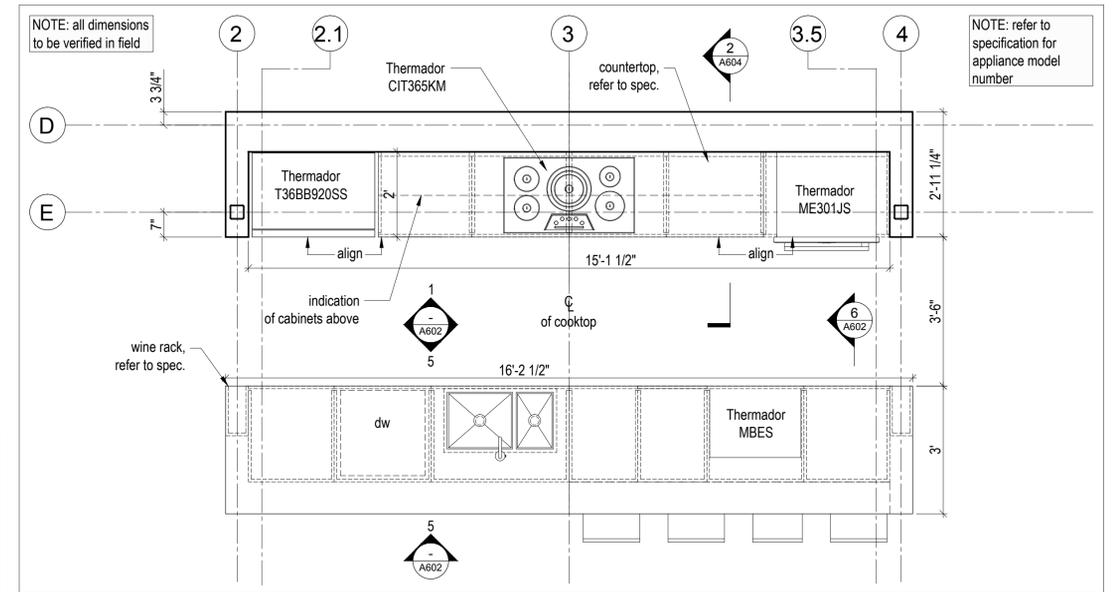


2 Kitchen - Enlarged Plan
Scale 1/2" = 1'-0"

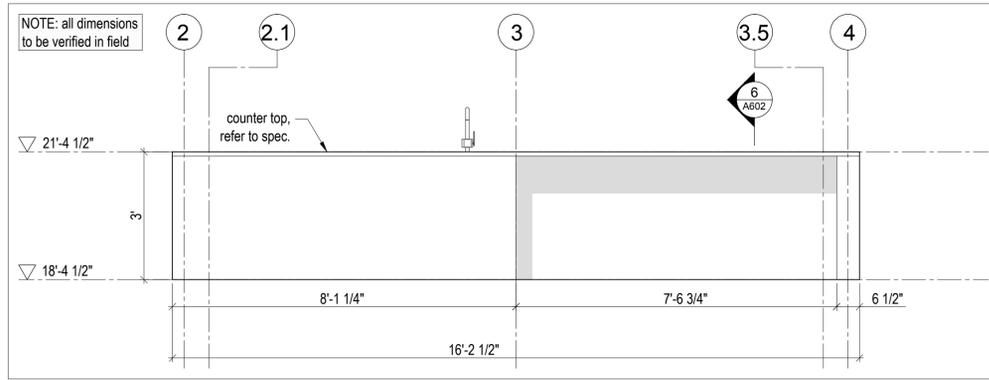


5 Kitchen Island - Elevation
Scale 1/2" = 1'-0"


7 Not Used
Scale 1/2" = 1'-0"

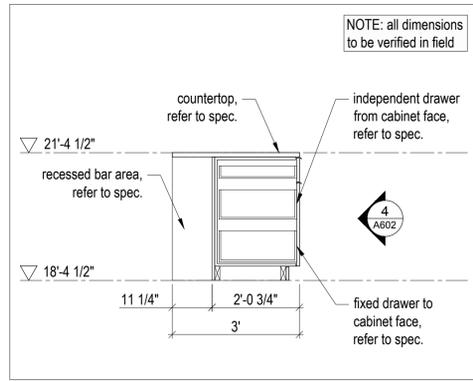

6 Kitchen Island - Section Detail
Scale 1/2" = 1'-0"

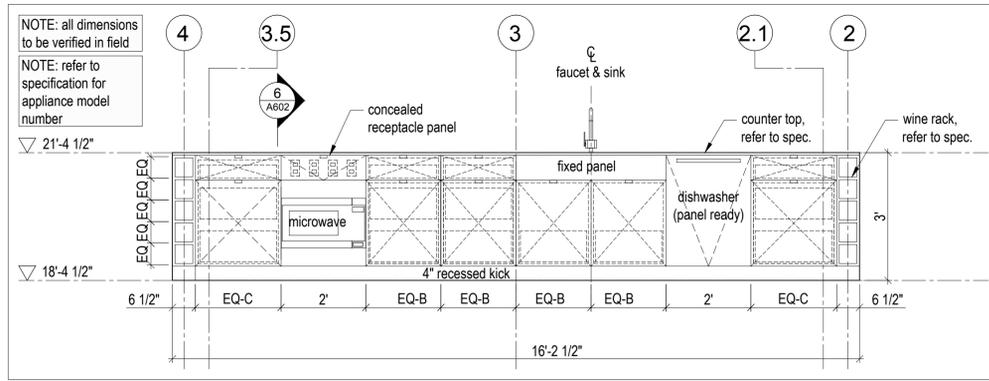

4 Kitchen Island - Elevation
Scale 1/2" = 1'-0"

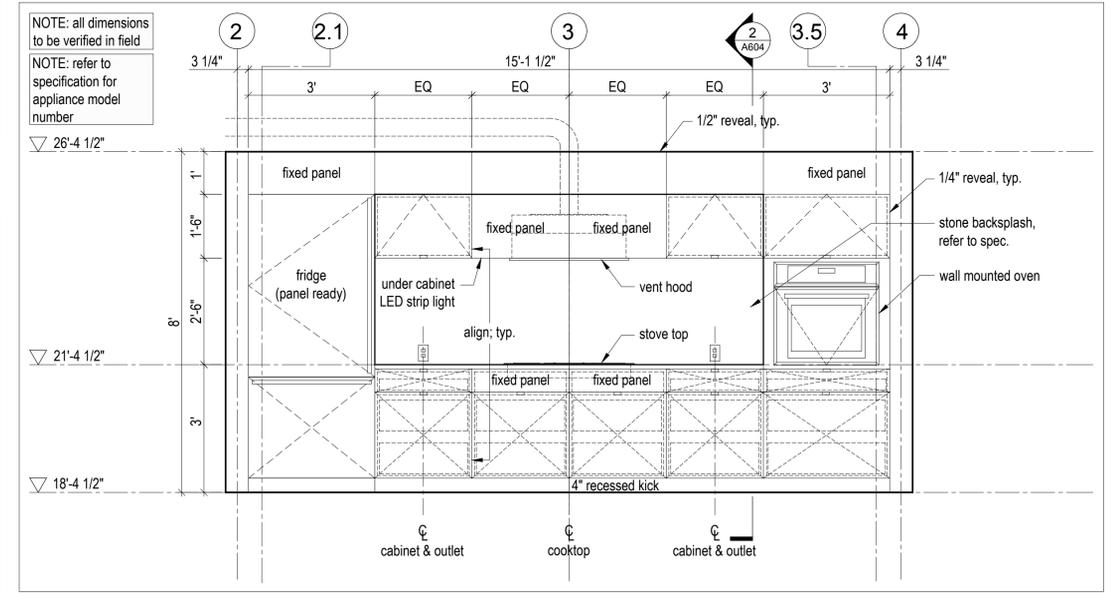


1 Kitchen - Elevation
Scale 1/2" = 1'-0"



NOTE: all dimensions to be verified in field

8'-0"
Typical installation heights; provide backing as needed

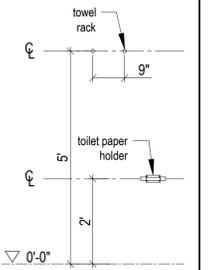

No.	Description	Date
5	IFC Rev 02	2019.02.08
4	IFC Rev 01	2018.06.29
3	Issued for Construction	2018.03.13
2	Issued for Tender	2017.12.22
1	for coordination	2017.12.1

NOTES:

COPYRIGHT RELATED TO THE USE OF THIS DRAWING:
The use of this drawing shall be governed by standard copyright law as generally accepted in architectural practice.

ARCHITECT'S REQUIREMENTS AND APPROVALS:
It is the Builder's responsibility to notify Mackay-Lyons Sweetapple Architects Ltd. and to seek prior written approval for materials and workmanship which deviates from instructions provided by the Architect.


ENGINEER'S REQUIREMENTS AND APPROVALS:
It is the Builder's responsibility to notify Mackay-Lyons Sweetapple Architects Ltd. and to seek prior written approval for materials and workmanship which deviates from instructions provided by the Engineer.

AUTHORITIES' REQUIREMENTS AND APPROVALS:
All materials and workmanship must comply with the requirements of all authorities having jurisdiction over the work. It is the Builder's responsibility to gain necessary approval from all relevant Authorities.


DIMENSIONS:
All dimensions must be verified on site. Do not scale off drawings. Plans take precedent over elevations. In the absence of dimensions, or if discrepancies exist, consult Architect. All minimum dimensions are to comply with the International Residential Code.

SHOP DRAWINGS:
Submit shop drawings to the Architect and Engineer for approval prior to manufacture of prefabricated elements of the building.


Millwork - Third & Fourth Floor

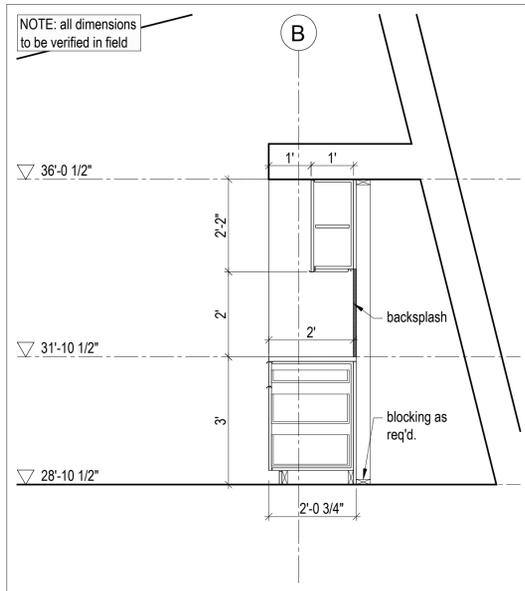


9 Lounge Bar - Section
Scale 1/2" = 1'-0"

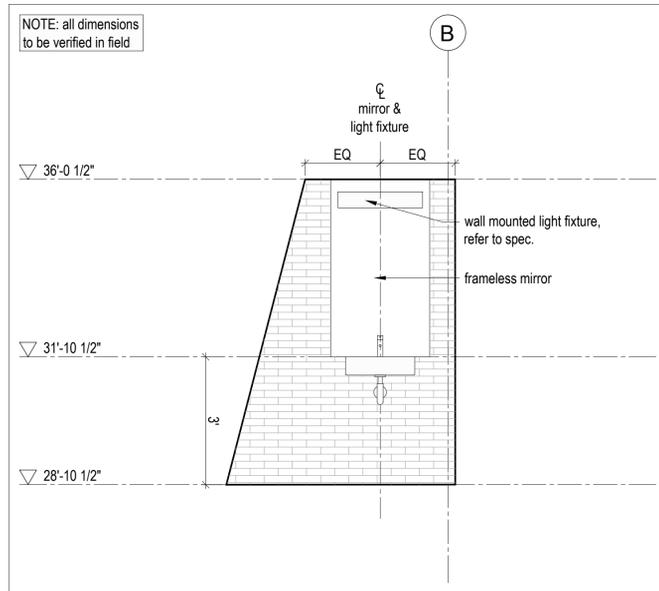


8 Lounge Bathroom - Elevation
Scale 1/2" = 1'-0"

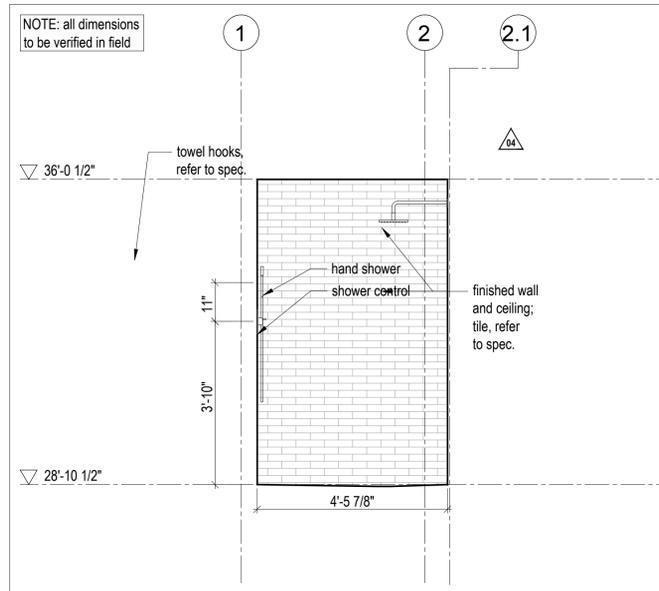


7 Lounge Shower - Section Detail
Scale 1/2" = 1'-0"

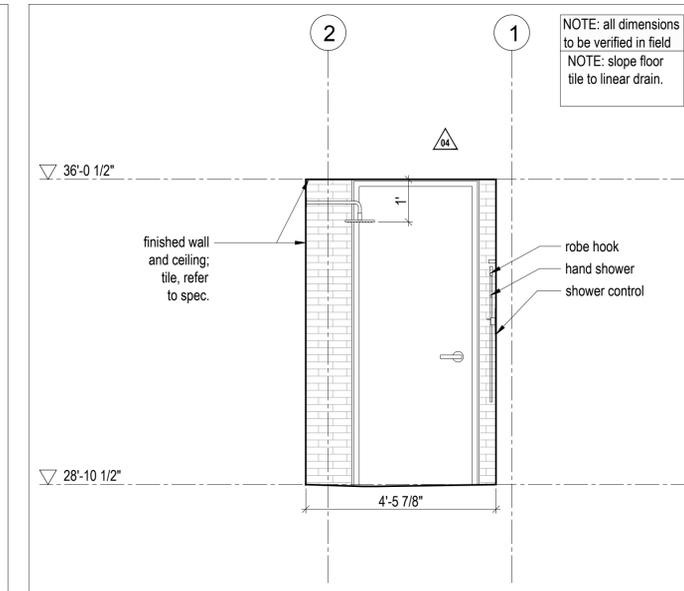


6 Lounge Shower - Section Detail
Scale 1/2" = 1'-0"

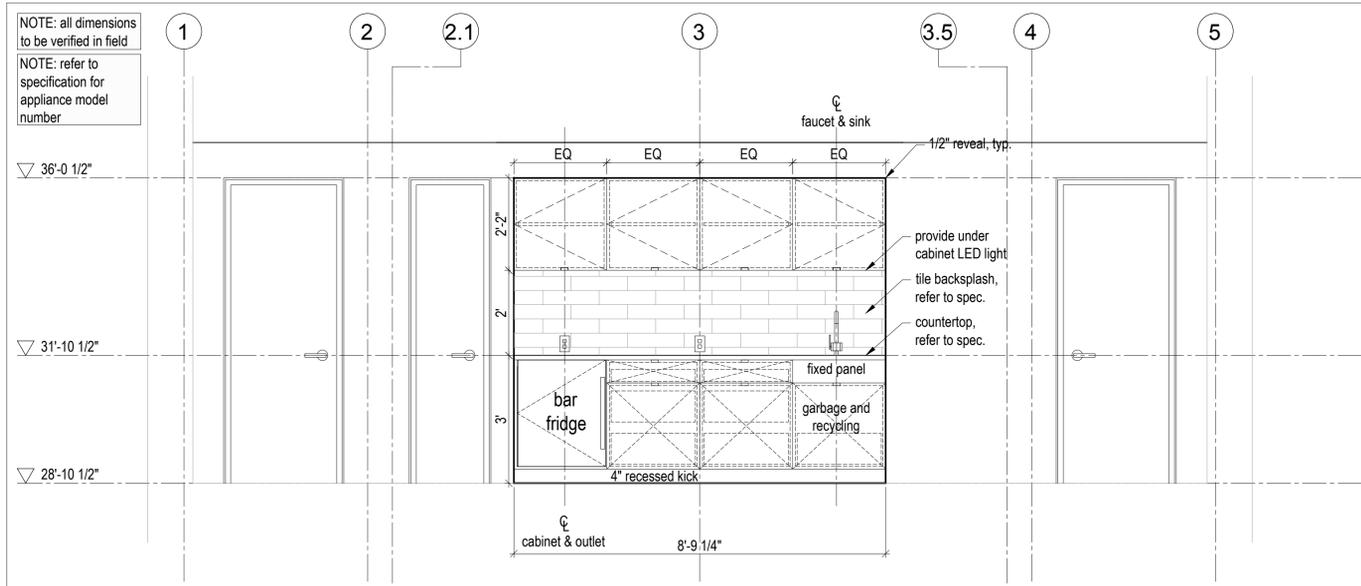


5 Lounge Bar - Elevation
Scale 1/2" = 1'-0"

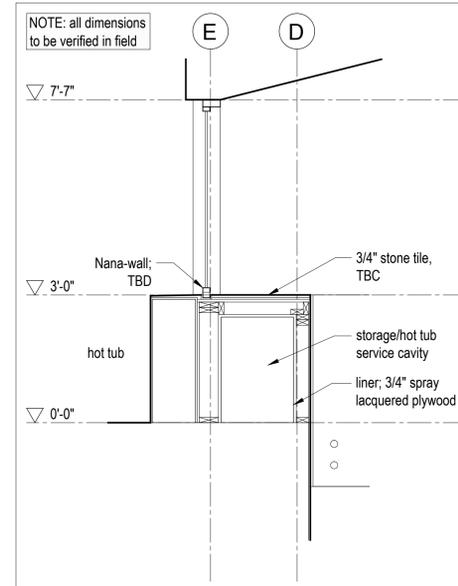


4 Sculpture Plinth - Section Detail
Scale 1/2" = 1'-0"

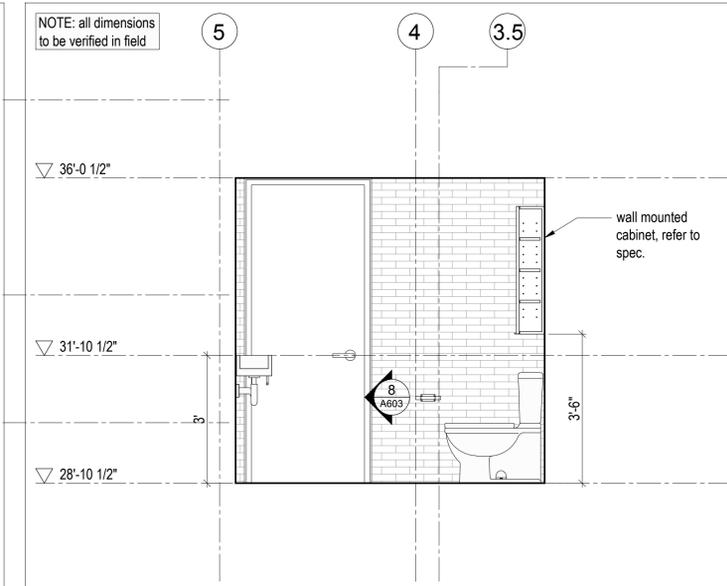

3 Lounge Bathroom - Section Detail
Scale 1/2" = 1'-0"

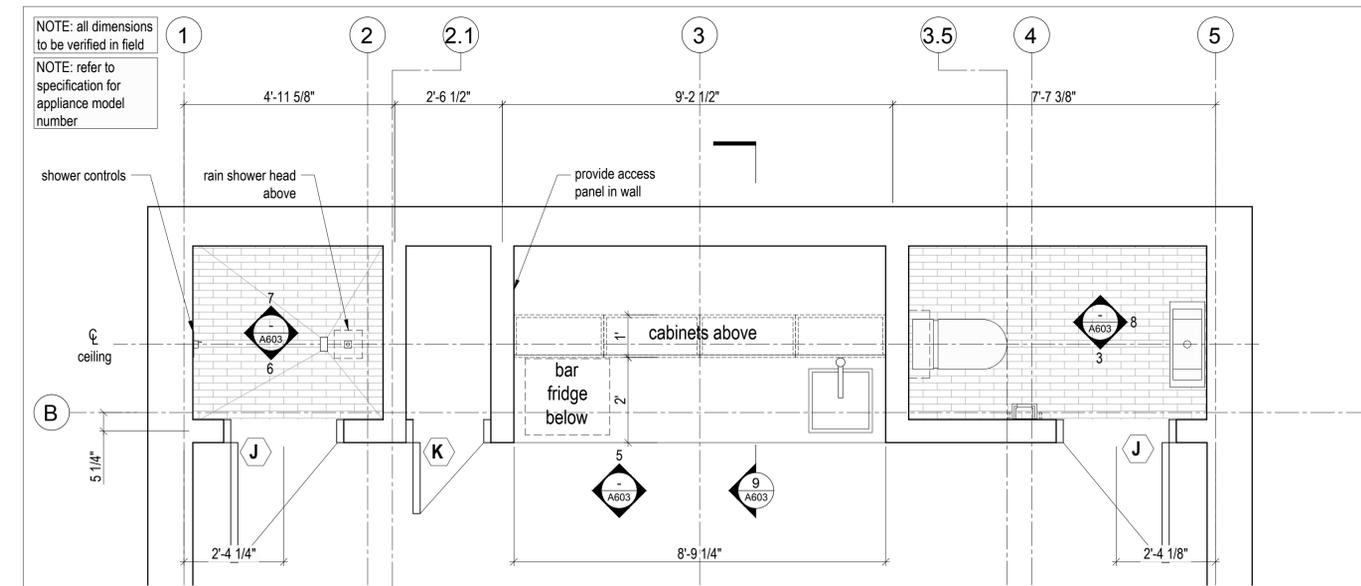

2 Lounge Shower/Bar/Powder Room - Enlarged Plan
Scale 1/2" = 1'-0"

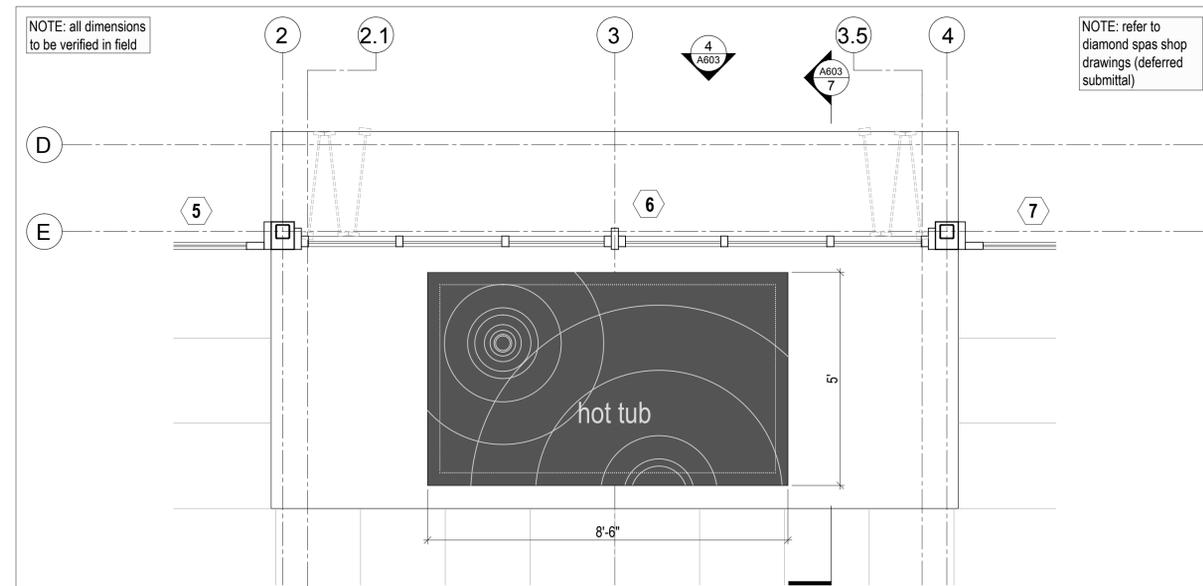

1 Sculpture Plinth - Enlarged Plan
Scale 1/2" = 1'-0"

Lot 71R
Village Houses

Summit Power, Mountain, Eden, Utah


MackKay-Lyons
Sweetapple
Architects
Limited

2188 Göttingen St.
Halifax, Nova Scotia
Canada B3K 3B4

ph: (902) 429-1867
fax: (902) 429-6276



NOTE: all dimensions to be verified in field

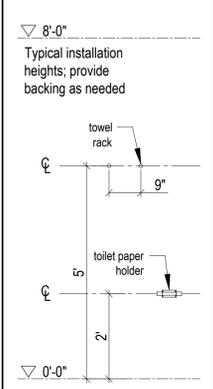

No.	Description	Date
5	IFC Rev 02	2019.02.08
4	IFC Rev 01	2018.06.29
3	Issued for Construction	2018.03.13
2	Issued for Tender	2017.12.22
1	for coordination	2017.12.1

NOTES:

COPYRIGHT RELATED TO THE USE OF THIS DRAWING:
The use of this drawing shall be governed by standard copyright law as generally accepted in architectural practice.

ARCHITECT'S REQUIREMENTS AND APPROVALS:
It is the Builder's responsibility to notify MackKay-Lyons Sweetapple Architects Ltd. and to seek prior written approval for materials and workmanship which deviates from instructions provided by the Architect.

ENGINEER'S REQUIREMENTS AND APPROVALS:
It is the Builder's responsibility to notify MackKay-Lyons Sweetapple Architects Ltd. and to seek prior written approval for materials and workmanship which deviates from instructions provided by the Engineer.

AUTHORITIES' REQUIREMENTS AND APPROVALS:
All materials and workmanship must comply with the requirements of all authorities having jurisdiction over the work. It is the Builder's responsibility to gain necessary approval from all relevant Authorities.


DIMENSIONS:
All dimensions must be verified on site. Do not scale off drawings. Plans take precedent over elevations. In the absence of dimensions, or if discrepancies exist, consult Architect. All minimum dimensions are to comply with the International Residential Code.

SHOP DRAWINGS:
Submit shop drawings to the Architect and Engineer for approval prior to manufacture of prefabricated elements of the building.


Millwork -
Fourth Floor

scale: 1/2" = 1'-0"
date: 17-11-23
drawn: RD
chk'd: BML


A603

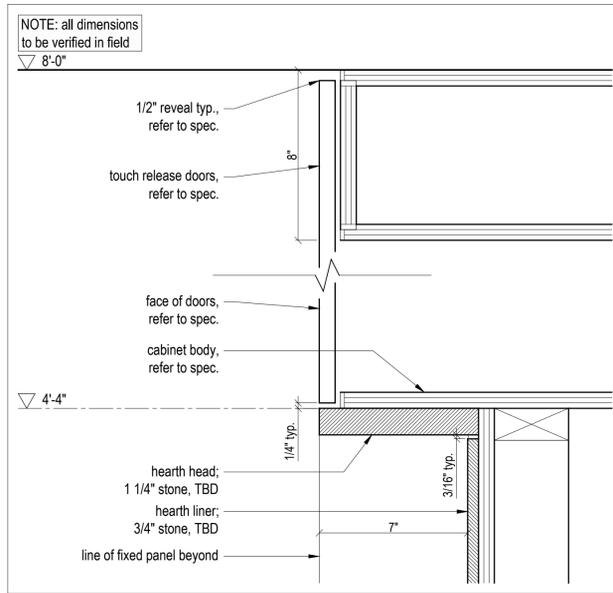


8 A604 **Hearth Head - Section Detail, Typ.**
 Scale 3" = 1'-0"

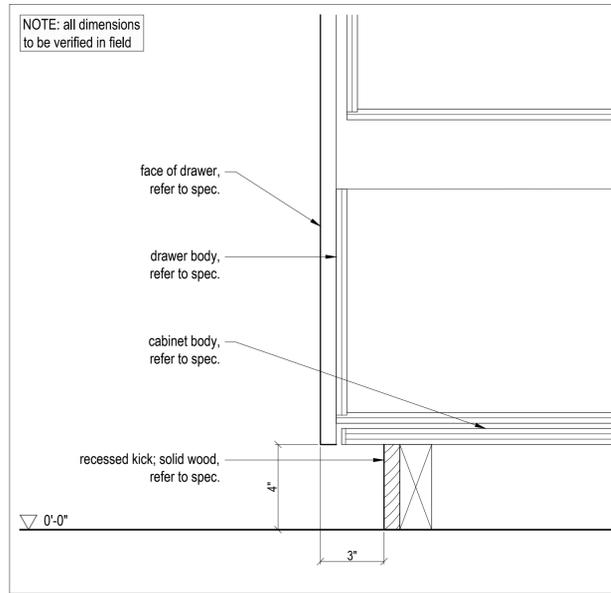


5 A604 **Kitchen Counter - Section Detail, Typ.**
 Scale 3" = 1'-0"

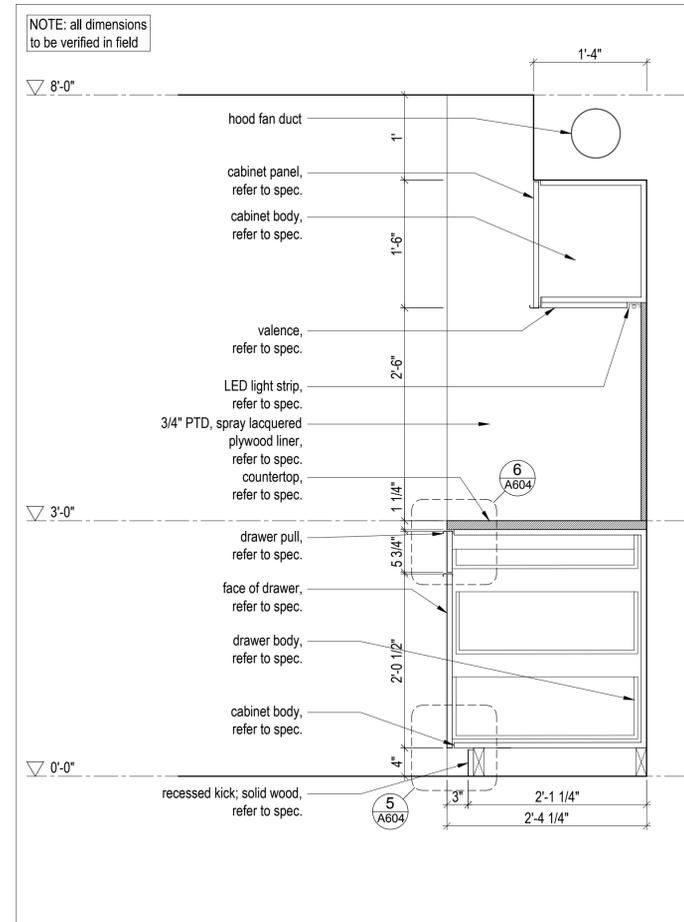


2 A604 **Kitchen Counter - Enlarged Section**
 Scale 1" = 1'-0"

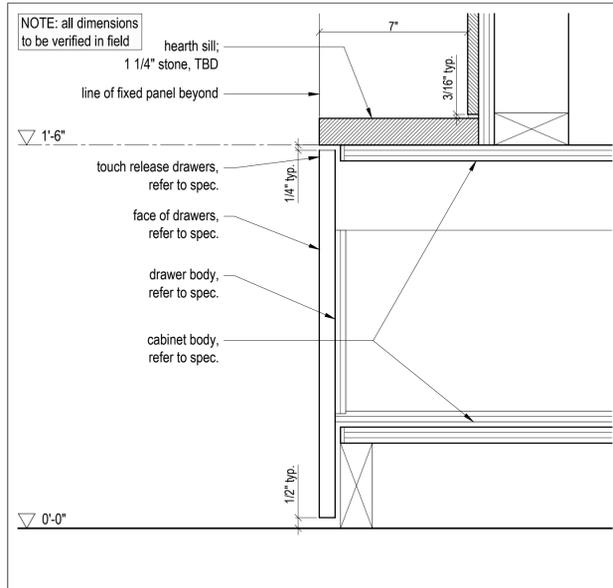


7 A604 **Hearth Sill - Section Detail, Typ.**
 Scale 3" = 1'-0"

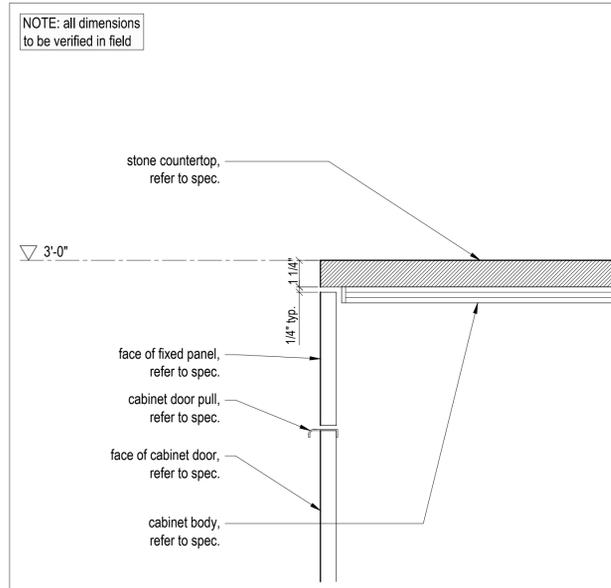


4 A604 **Bathroom Vanity - Section Detail, Typ.**
 Scale 3" = 1'-0"

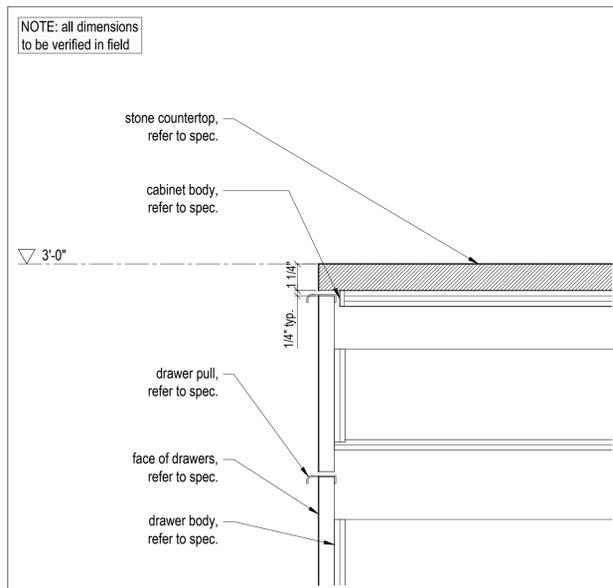


6 A604 **Kitchen Counter - Section Detail, Typ.**
 Scale 3" = 1'-0"

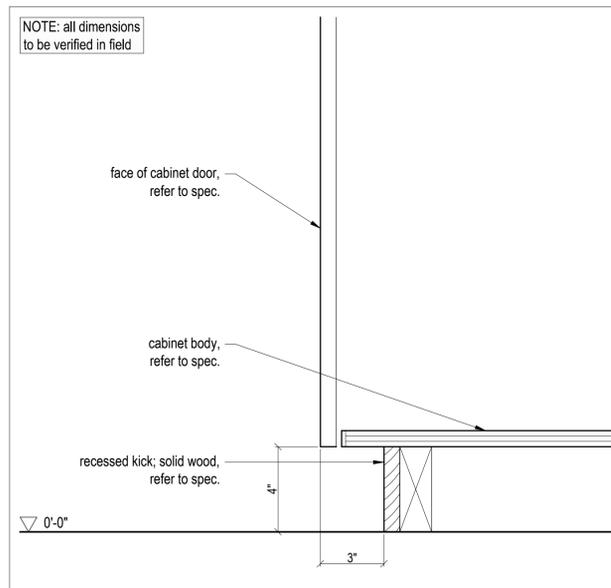

3 A604 **Bathroom Vanity - Section Detail, Typ.**
 Scale 3" = 1'-0"

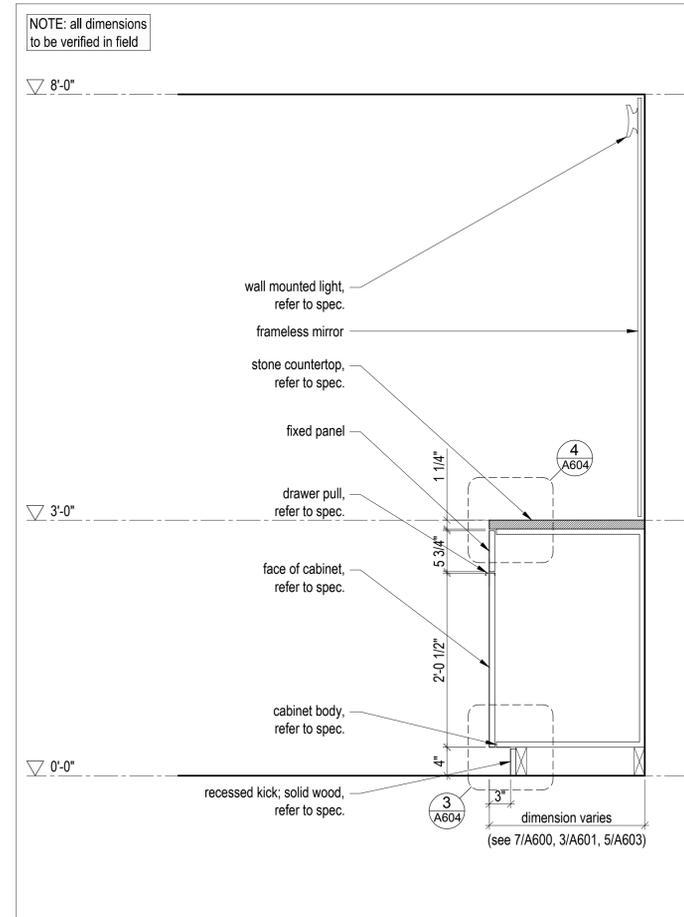


1 A604 **Bathroom Counter - Enlarged Section**
 Scale 1" = 1'-0"

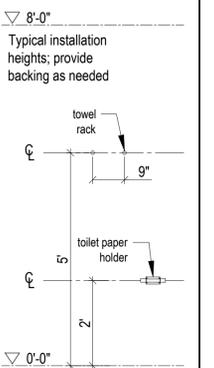


No.	Description	Date
5	IFC Rev 02	2019.02.08
4	IFC Rev 01	2018.06.29
3	Issued for Construction	2018.03.13
2	Issued for Tender	2017.12.22

Revision:


NOTES:
COPYRIGHT RELATED TO THE USE OF THIS DRAWING:
 The use of this drawing shall be governed by standard copyright law as generally accepted in architectural practice.
ARCHITECT'S REQUIREMENTS AND APPROVALS:
 It is the Builder's responsibility to notify Mackay-Lyons Sweetapple Architects Ltd. and to seek prior written approval for materials and workmanship which deviates from instructions provided by the Architect.
ENGINEER'S REQUIREMENTS AND APPROVALS:
 It is the Builder's responsibility to notify Mackay-Lyons Sweetapple Architects Ltd. and to seek prior written approval for materials and workmanship which deviates from instructions provided by the Engineer.
AUTHORITIES' REQUIREMENTS AND APPROVALS:
 All materials and workmanship must comply with the requirements of all authorities having jurisdiction over the work. It is the Builder's responsibility to gain necessary approval from all relevant Authorities.
DIMENSIONS:
 All dimensions must be verified on site. Do not scale off drawings. Plans take precedent over elevations. In the absence of dimensions, or if discrepancies exist, consult Architect. All minimum dimensions are to comply with the International Residential Code.
SHOP DRAWINGS:
 Submit shop drawings to the Architect and Engineer for approval prior to manufacture of prefabricated elements of the building.

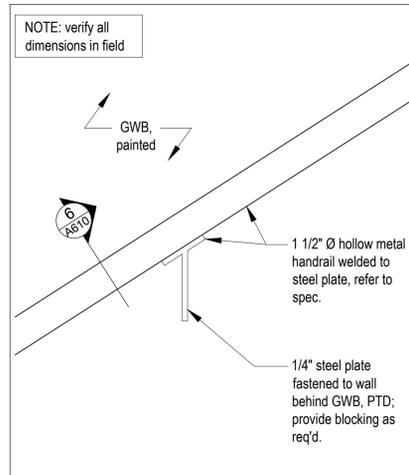


7 Handrail Connection - Detail
Scale 3" = 1'-0"

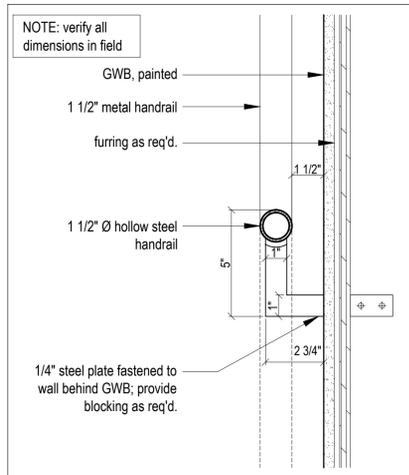


6 Handrail - Section Detail
Scale 3" = 1'-0"

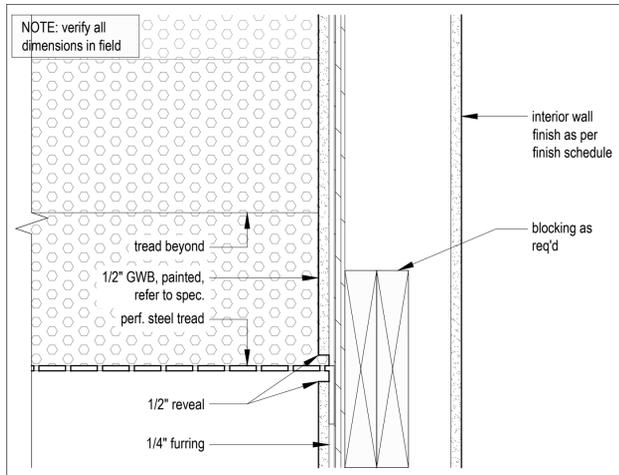


5 Stair Detail
Scale 3" = 1'-0"

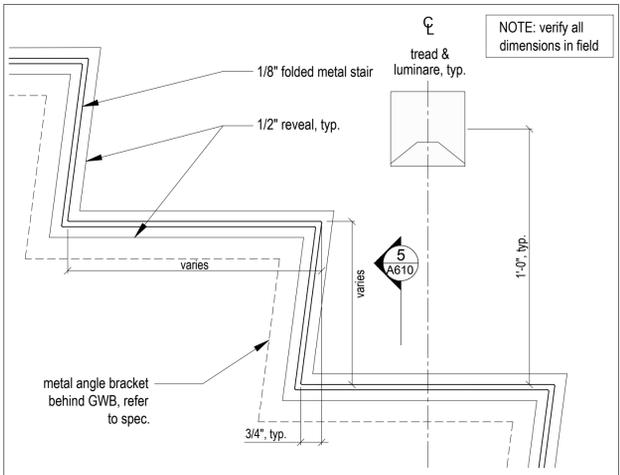


4 Stair Detail
Scale 3" = 1'-0"

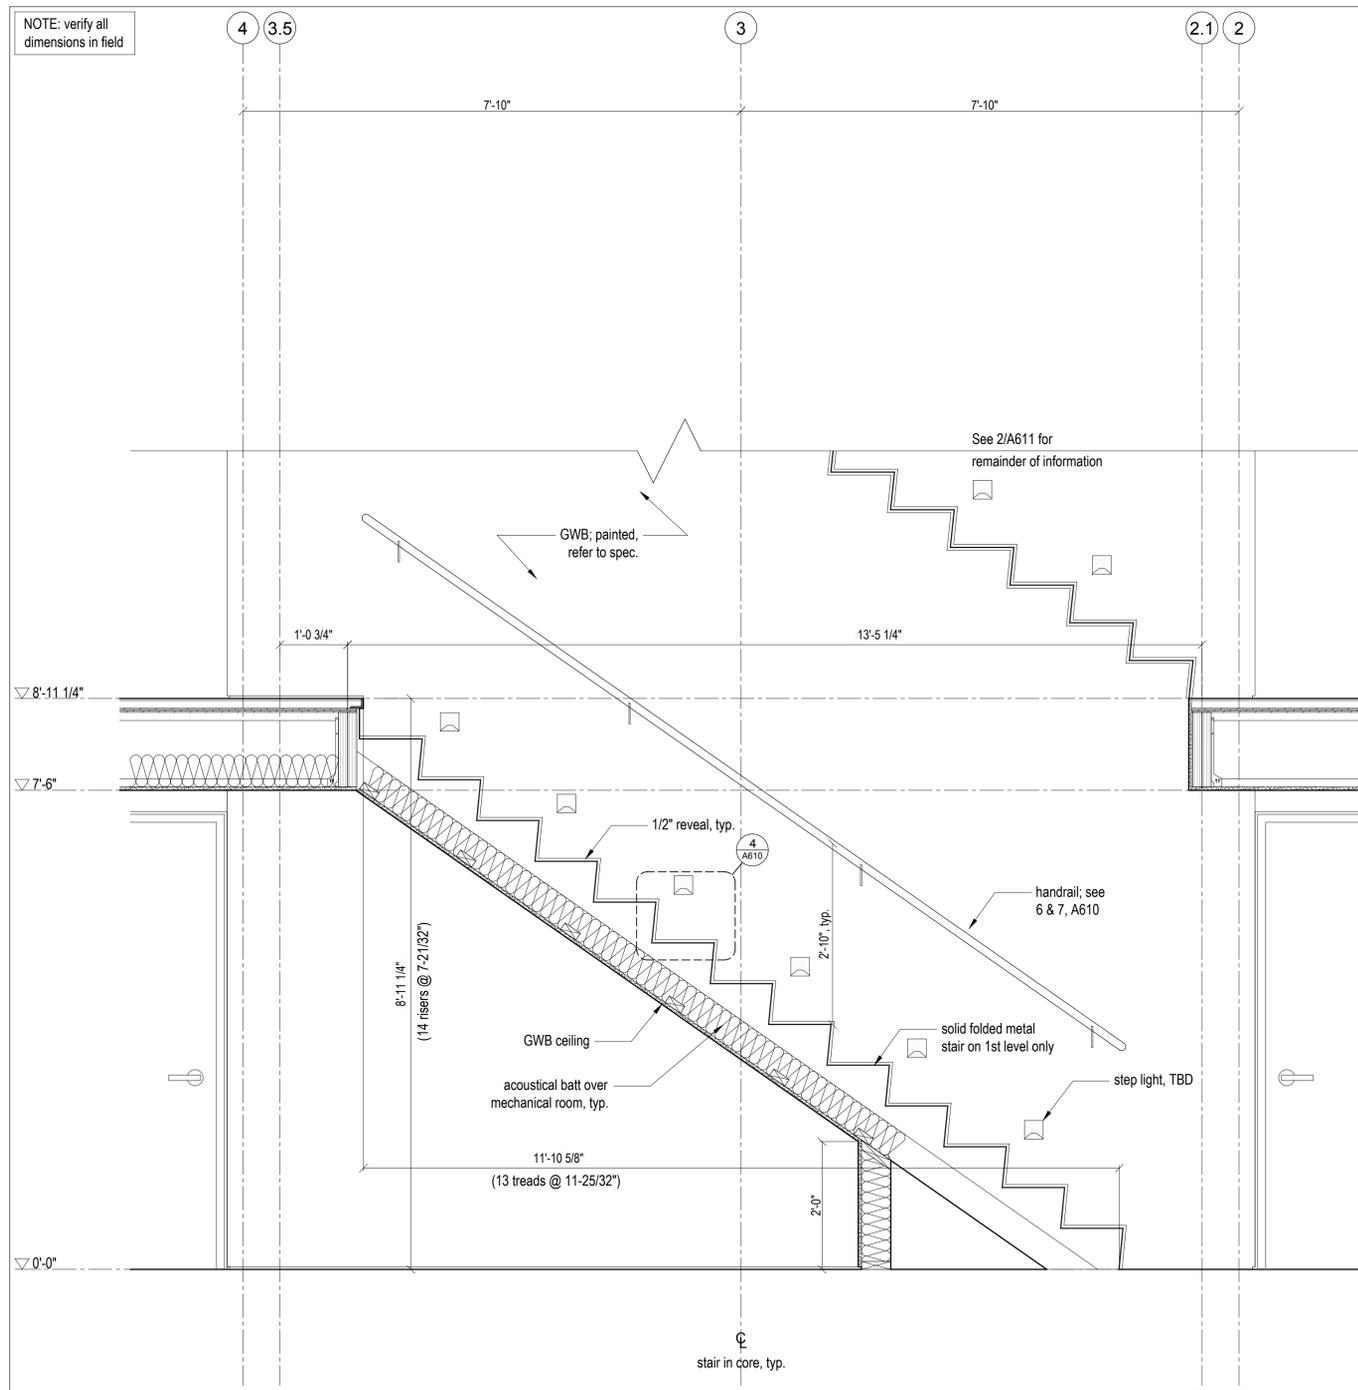

3 Lower Stair Section
Scale 3/4" = 1'-0"

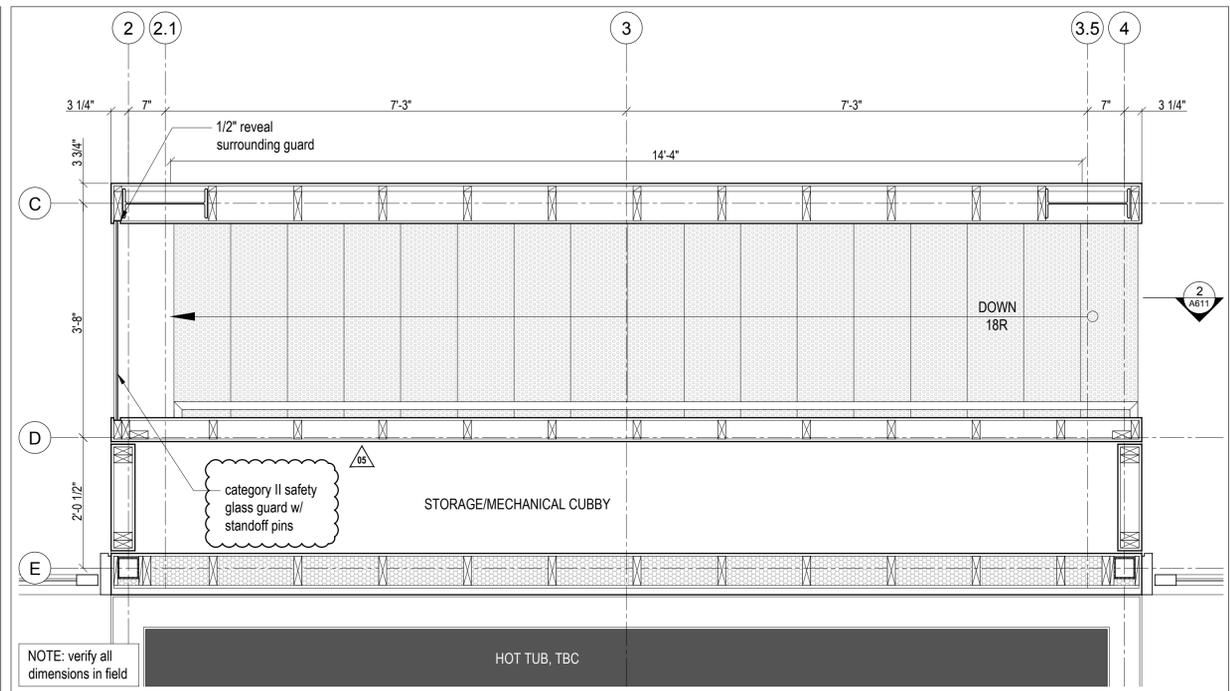

2 Enlarged 4th Floor Plan
Scale 3/4" = 1'-0"

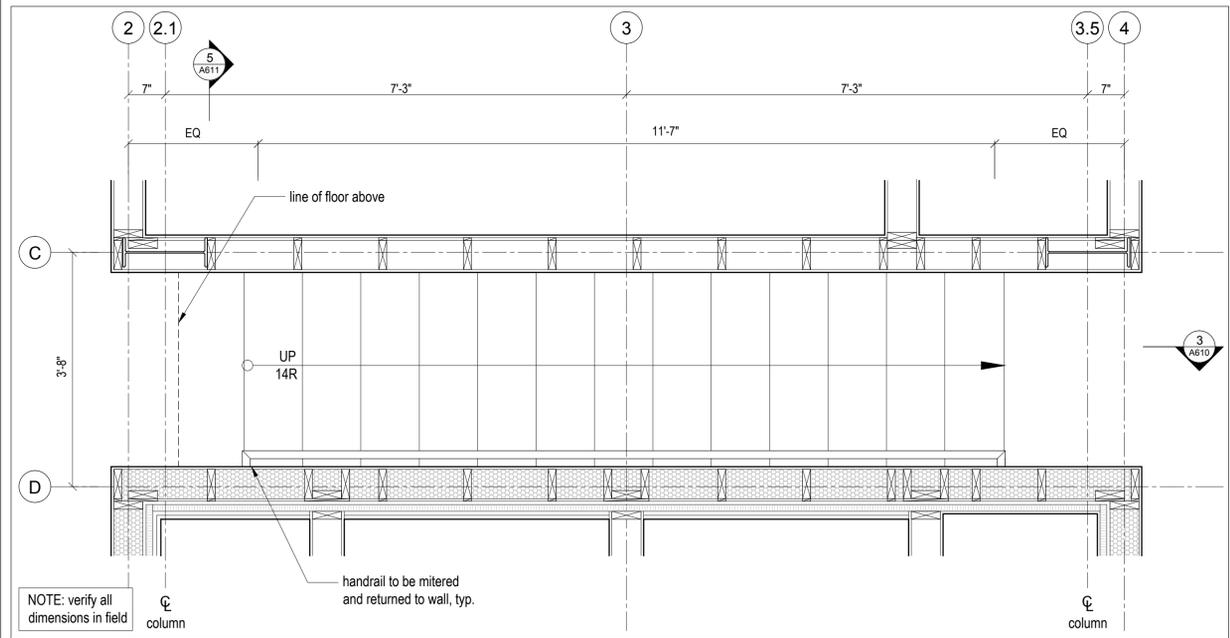

1 Enlarged 1st Floor Plan
Scale 3/4" = 1'-0"



No.	Description	Date
5	IFC Rev 02	2019.02.08
4	IFC Rev 01	2018.06.29
3	Issued for Construction	2018.03.13
2	Issued for Tender	2017.12.22
1	for coordination	2017.12.1

NOTES:

COPYRIGHT RELATED TO THE USE OF THIS DRAWING:
The use of this drawing shall be governed by standard copyright law as generally accepted in architectural practice.

ARCHITECT'S REQUIREMENTS AND APPROVALS:
It is the Builder's responsibility to notify Mackay-Lyons Sweetapple Architects Ltd. and to seek prior written approval for materials and workmanship which deviates from instructions provided by the Architect.

ENGINEER'S REQUIREMENTS AND APPROVALS:
It is the Builder's responsibility to notify Mackay-Lyons Sweetapple Architects Ltd. and to seek prior written approval for materials and workmanship which deviates from instructions provided by the Engineer.


AUTHORITIES' REQUIREMENTS AND APPROVALS:
All materials and workmanship must comply with the requirements of all authorities having jurisdiction over the work. It is the Builder's responsibility to gain necessary approval from all relevant Authorities.

DIMENSIONS:
All dimensions must be verified on site. Do not scale off drawings. Plans take precedent over elevations. In the absence of dimensions, or if discrepancies exist, consult Architect. All minimum dimensions are to comply with the National Building Code of Canada.


SHOP DRAWINGS:
Submit shop drawings to the Architect and Engineer for approval prior to manufacture of prefabricated elements of the building.



NOTE: verify all dimensions in field

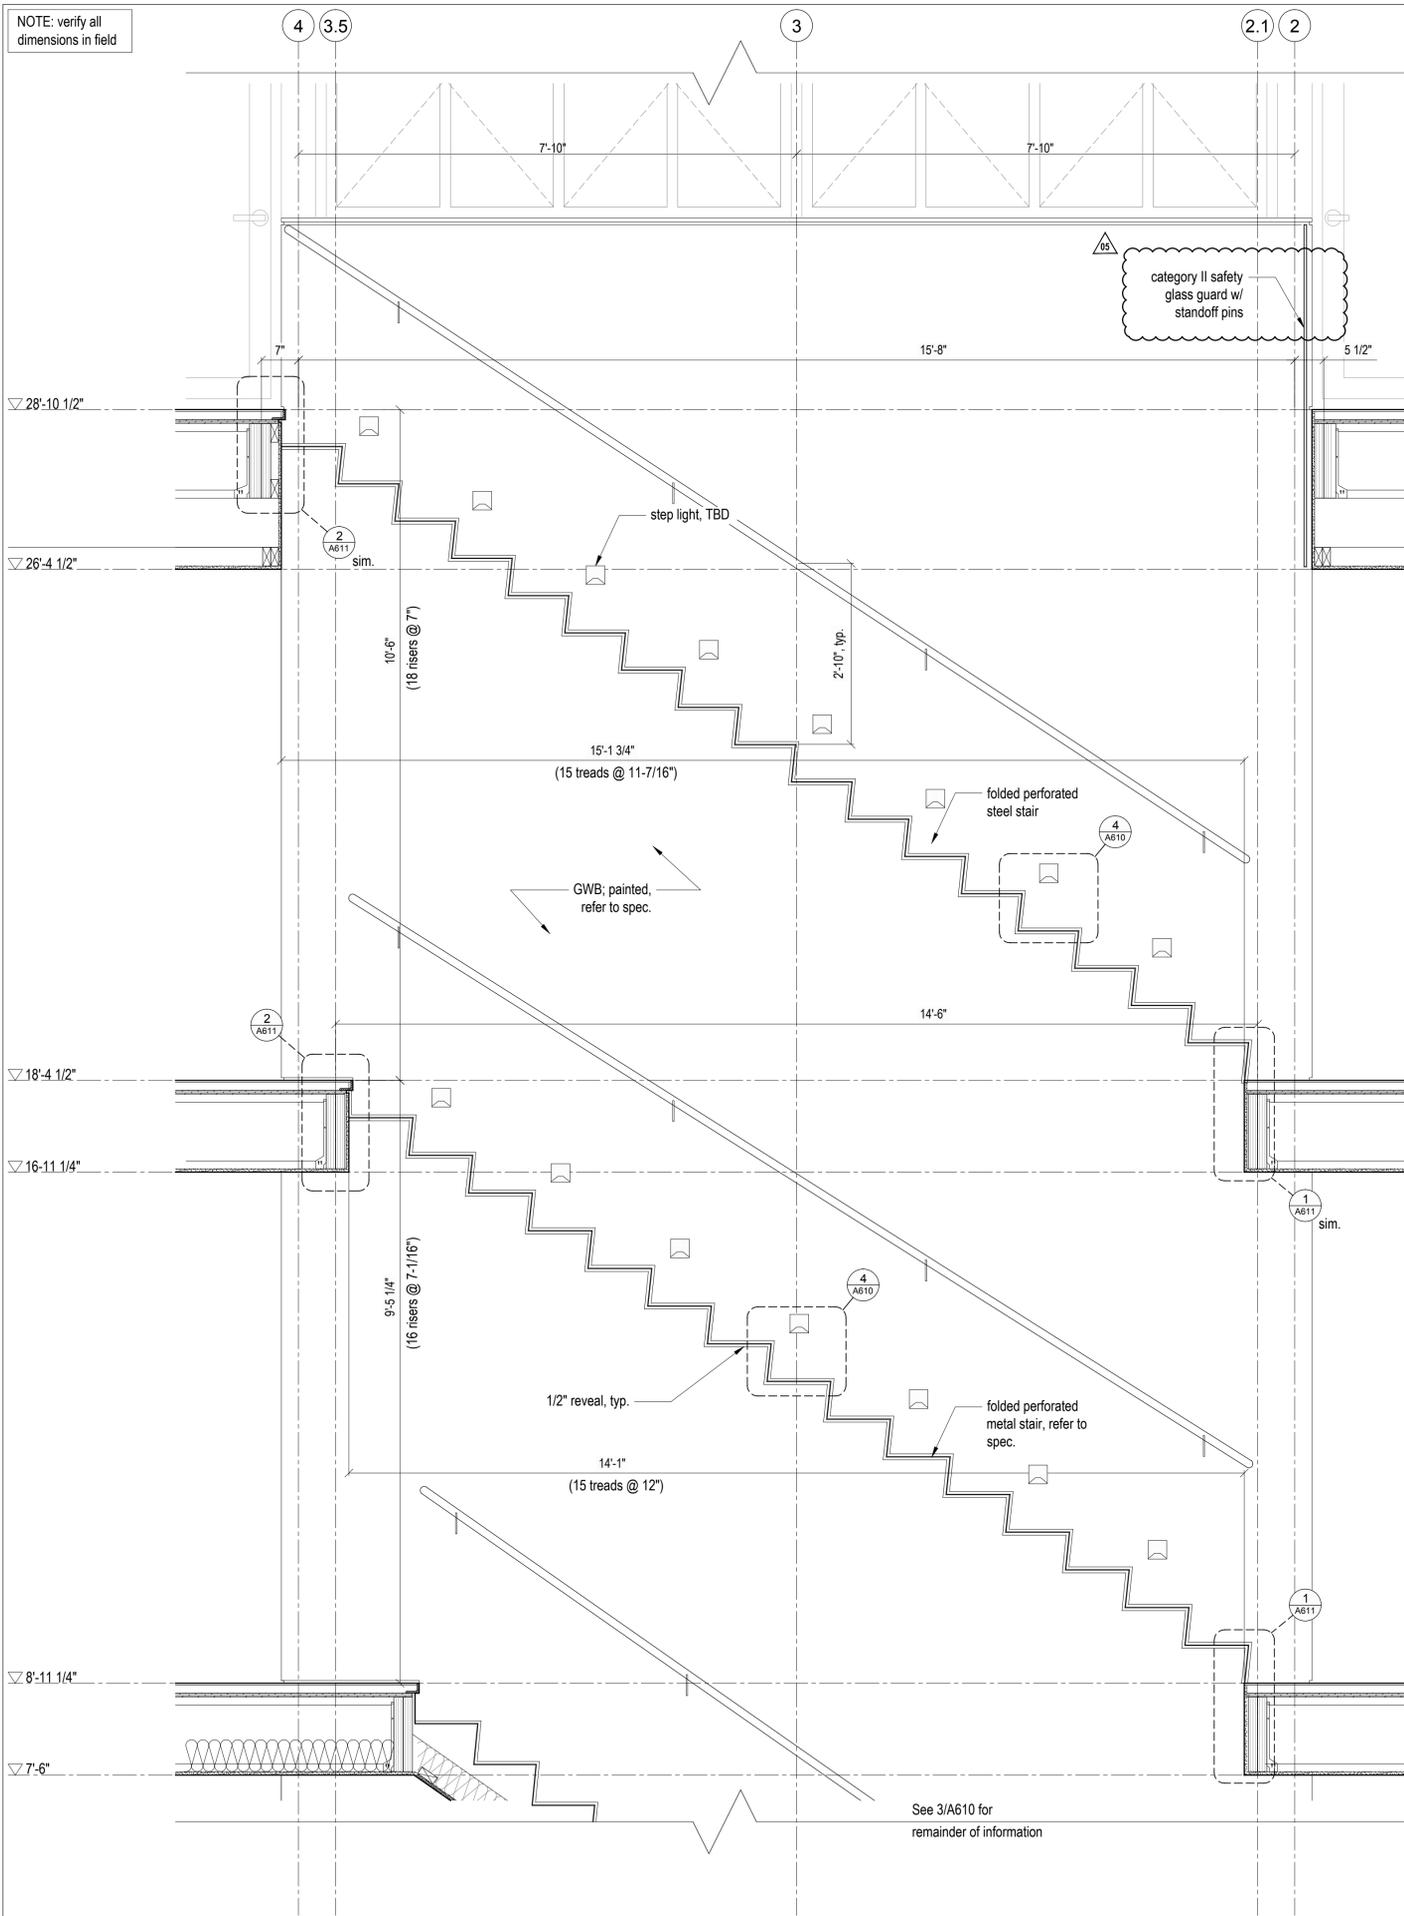


4 Upper Stair Section
Scale 3/4" = 1'-0"

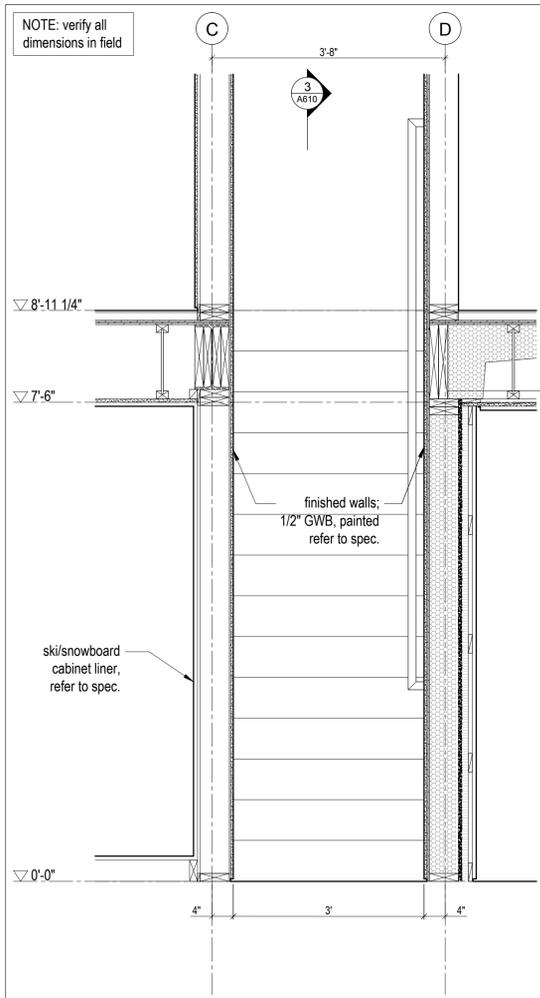


5 Level 1 Stair Section
Scale 3/4" = 1'-0"


3 NOT USED
A611 NTS

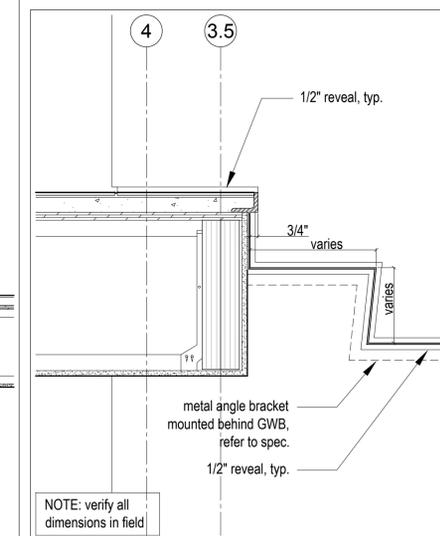

2 Top Threshold Detail
Scale 1 1/2" = 1'-0"

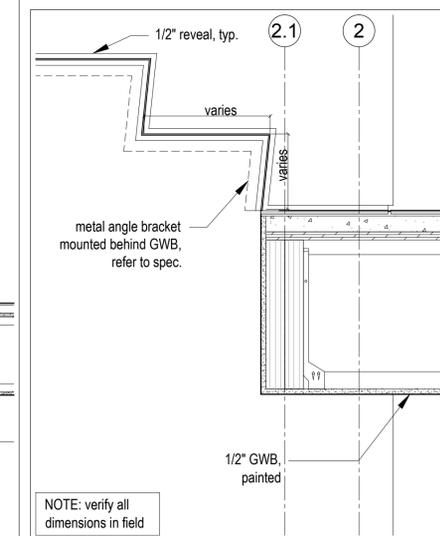

1 Bottom Threshold Detail, Typ.
Scale 1 1/2" = 1'-0"

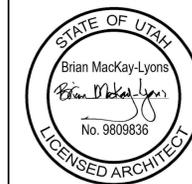

No.	Description	Date
5	IFC Rev 02	2019.02.08
4	IFC Rev 01	2018.06.29
3	Issued for Construction	2018.03.13
2	Issued for Tender	2017.12.22
1	for coordination	2017.12.1

NOTES:

COPYRIGHT RELATED TO THE USE OF THIS DRAWING:
The use of this drawing shall be governed by standard copyright law as generally accepted in architectural practice.

ARCHITECT'S REQUIREMENTS AND APPROVALS:
It is the Builder's responsibility to notify Mackay-Lyons Sweetapple Architects Ltd. and to seek prior written approval for materials and workmanship which deviates from instructions provided by the Architect.

ENGINEER'S REQUIREMENTS AND APPROVALS:
It is the Builder's responsibility to notify Mackay-Lyons Sweetapple Architects Ltd. and to seek prior written approval for materials and workmanship which deviates from instructions provided by the Engineer.

AUTHORITIES REQUIREMENTS AND APPROVALS:
All materials and workmanship must comply with the requirements of all authorities having jurisdiction over the work. It is the Builder's responsibility to gain necessary approval from all relevant Authorities.

DIMENSIONS:
All dimensions must be verified on site. Do not scale off drawings. Plans take precedent over elevations. In the absence of dimensions, or if discrepancies exist, consult Architect. All minimum dimensions are to comply with the National Building Code of Canada.

SHOP DRAWINGS:
Submit shop drawings to the Architect and Engineer for approval prior to manufacture of prefabricated elements of the building.


Stair

scale: as noted
date: 17-11-23
drawn: RD
chk'd: BML

A611

ELECTRIC LEGEND:

- ⊕ 125v duplex
- ⊕ GFCI duplex
- ⊕ 240v duplex
- ⊕ floor duplex
- ⊕ usb duplex
- shower luminaire
- ⊗ wall mounted stair luminaire
- square trim LED potlight
- ceiling mounted utility luminaire
- ⊗ single head spotlight
- puck light
- ⊕ ceiling mounted pendant
- LED pot light
- ⊕ wall switch
- ⊕ ceiling mounted pendant
- ⊕ wall mounted vanity luminaire
- ⊕ three-way switch
- ⊕ switch with timer
- ⊕ exhaust fan
- ⊕ cable jack
- ⊕ internet jack
- ⊕ telephone jack
- ⊕ smoke alarm (wall mounted)
- ⊕ thermostat
- ⊕ alarm control pad
- ⊕ carbon monoxide detector
- interior LED strip light
- exterior LED strip light
- electrical panel

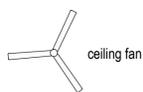



ceiling fan

APPLIANCE LEGEND
(refer to appliance specs for electrical requirements)

- ① refrigerator / freezer
- ② dishwasher
- ③ microwave
- ④ oven
- ⑤ washer
- ⑥ dryer
- ⑦ cooktop
- ⑧ dumb-waiter
- ⑨ hot tub
- ⑩ vent hood

NOTE:

All exterior lighting to conform to Lighting Level LZ1: Low Ambient Lighting, Joint IOA-IES Lighting Ordinance, 2011

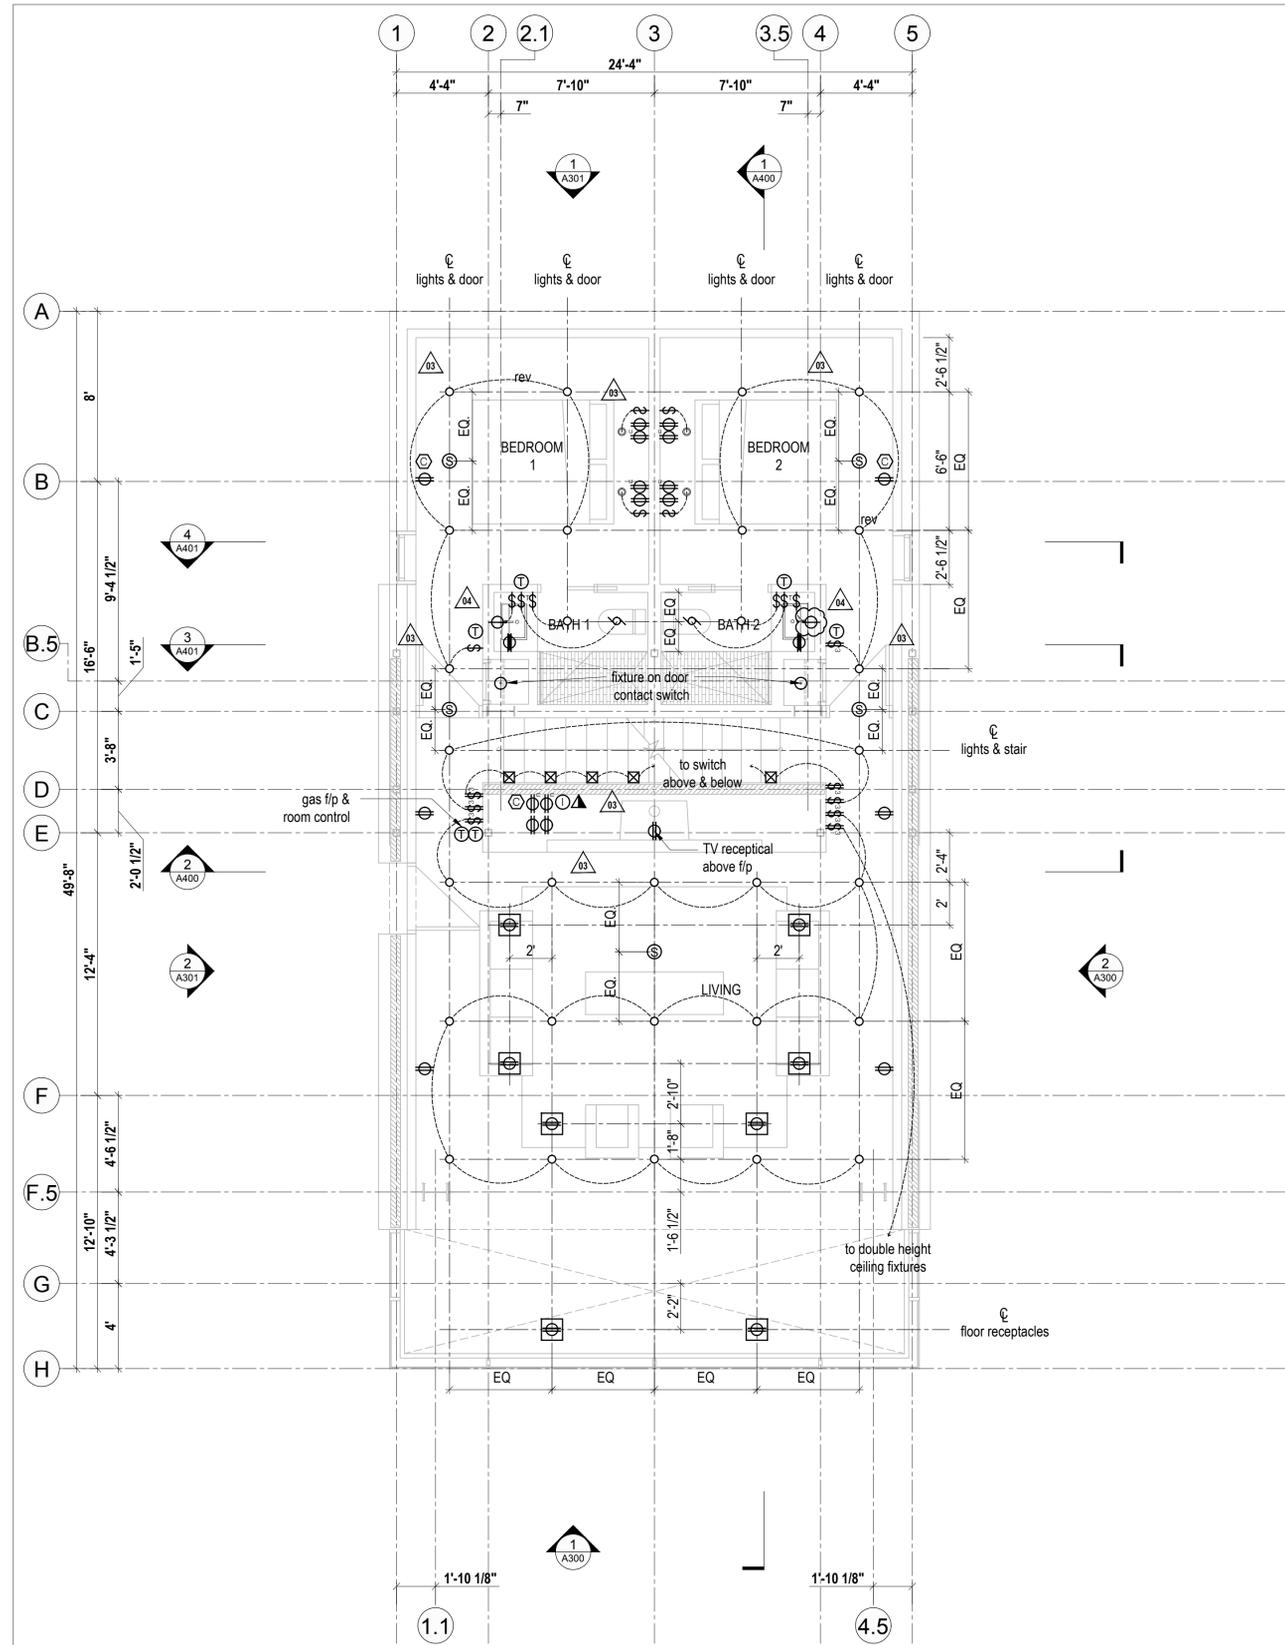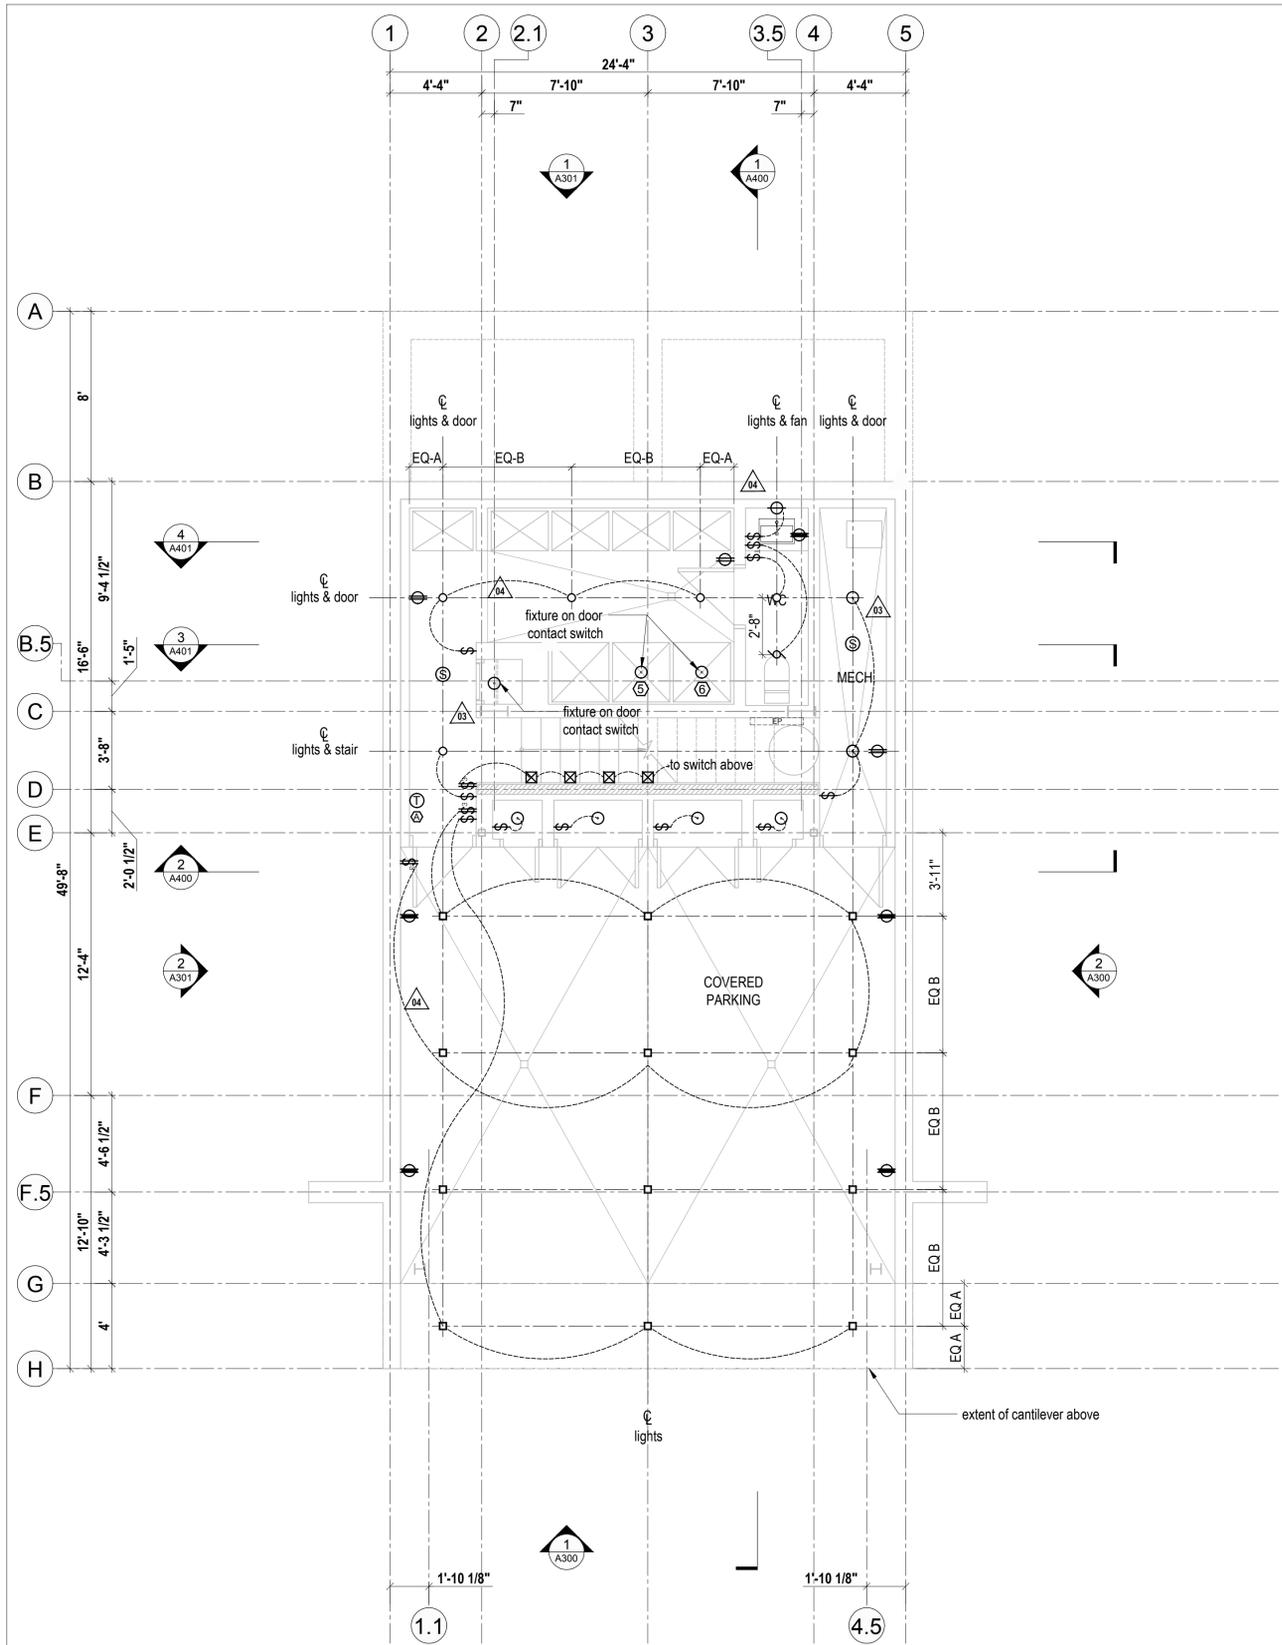

2
A800 Ground Floor Plan
Scale 1/4" = 1'-0"

1
A800 Second Floor Plan
Scale 1/4" = 1'-0"

Lot 71R
Village House

Summit Power Mechanical
Electrical


Mackay-Lyons
Sweetapple
Architects
Limited

2188 Göttingen St.
Halifax, Nova Scotia
Canada B3K 3B4

ph: (902) 429.1867
fax: (902) 429.6276

STATE OF UTAH
Brian Mackay-Lyons
No. 9809836
LICENSED ARCHITECT

NOTE: all dimensions
to be verified in field

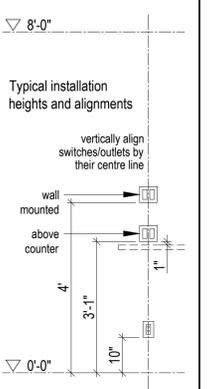

No.	Description	Date
5	IFC Rev 02	2019.02.08
4	IFC Rev 01	2018.06.29
3	Issued for Construction	2018.03.13
2	Issued for Tender	2017.12.22
1	for coordination	2017.12.1

NOTES:

COPYRIGHT RELATED TO THE USE OF THIS DRAWING:
The use of this drawing shall be governed by standard copyright law as generally accepted in architectural practice.

ARCHITECT'S REQUIREMENTS AND APPROVALS:
It is the Builder's responsibility to notify Mackay-Lyons Sweetapple Architects Ltd. and to seek prior written approval for materials and workmanship which deviates from instructions provided by the Architect.

ENGINEER'S REQUIREMENTS AND APPROVALS:
It is the Builder's responsibility to notify Mackay-Lyons Sweetapple Architects Ltd. and to seek prior written approval for materials and workmanship which deviates from instructions provided by the Engineer.

AUTHORITIES' REQUIREMENTS AND APPROVALS:
All materials and workmanship must comply with the requirements of all authorities having jurisdiction over the work. It is the Builder's responsibility to gain necessary approval from all relevant Authorities.

DIMENSIONS:
All dimensions must be verified on site. Do not scale off drawings. Plans take precedent over elevations. In the absence of dimensions, or if discrepancies exist, consult Architect. All minimum dimensions are to comply with the International Residential Code.

SHOP DRAWINGS:
Submit shop drawings to the Architect and Engineer for approval prior to manufacture of prefabricated elements of the building.


Ground &
Second Floor
Electrical Plans

scale: 1/4" = 1'-0"
date: 17-11-23
drawn: RD
chk'd: BML

A800

ELECTRIC LEGEND:

- ⊕ 125v duplex
- ⊕ GFCI duplex
- ⊕ 240v duplex
- ⊕ floor duplex
- ⊕ usb duplex
- shower luminaire
- ⊗ wall mounted stair luminaire
- square trim LED potlight
- ceiling mounted utility luminaire
- ⊗ single head spotlight
- puck light
- ⊕ ceiling mounted pendant
- LED pot light
- ⊕ wall switch
- ⊕ ceiling mounted pendant
- ⊕ wall mounted vanity luminaire
- ⊕ three-way switch
- ⊕ switch with timer
- ⊕ exhaust fan
- ⊕ cable jack
- ⊕ internet jack
- ⊕ telephone jack
- ⊕ smoke alarm (wall mounted)
- ⊕ thermostat
- ⊕ alarm control pad
- ⊕ carbon monoxide detector
- interior LED strip light
- exterior LED strip light
- electrical panel

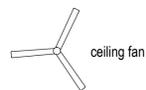



APPLIANCE LEGEND

(refer to appliance specs for electrical requirements)

- ① refrigerator / freezer
- ② dishwasher
- ③ microwave
- ④ oven
- ⑤ washer
- ⑥ dryer
- ⑦ cooktop
- ⑧ dumb-waiter
- ⑨ hot tub
- ⑩ vent hood

NOTE:

All exterior lighting to conform to Lighting Level LZ1: Low Ambient Lighting, Joint IOA-IES Lighting Ordinance, 2011

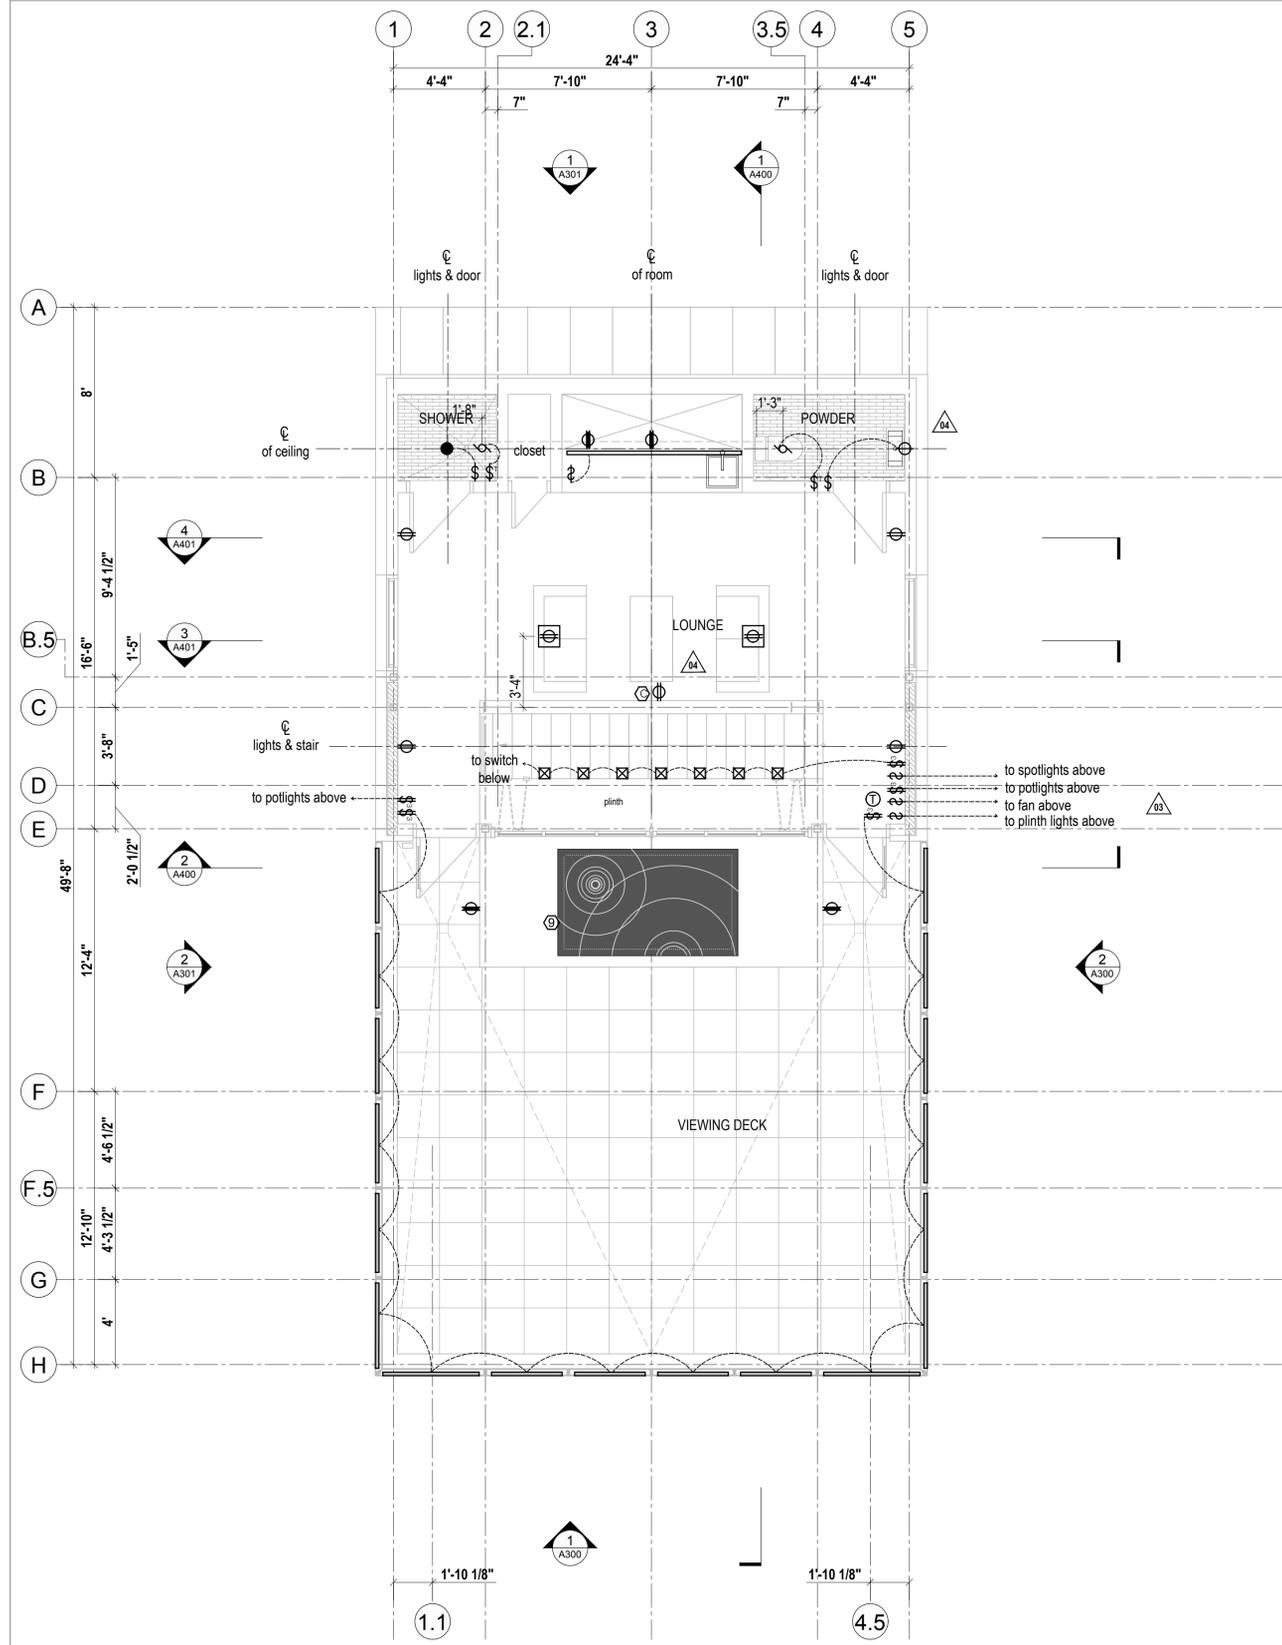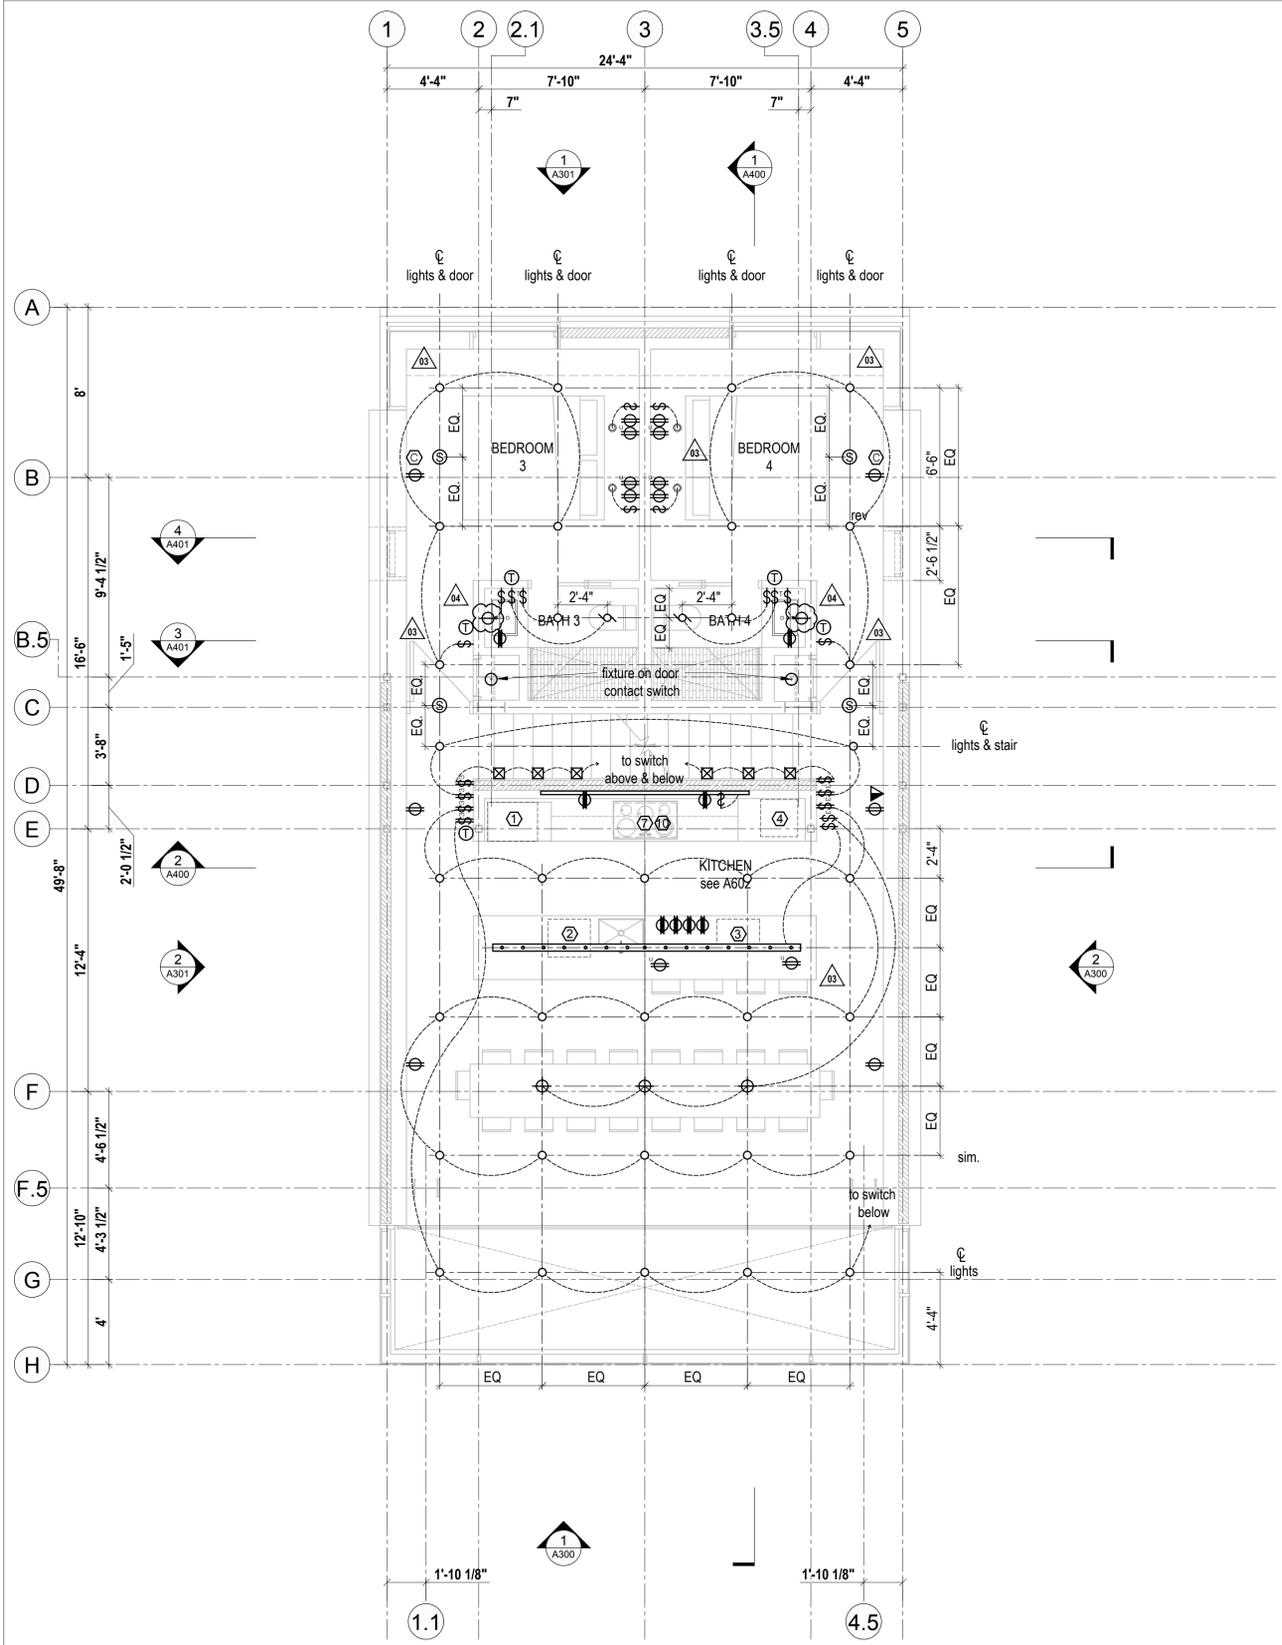

2 Third Floor Plan
Scale 1/4" = 1'-0"

1 Fourth Floor Plan
Scale 1/4" = 1'-0"

Lot 71R
Village House

Summit Power Mountain
Evan Utah


Mackay-Lyons
Sweetapple
Architects
Limited

2188 Göttingen St.
Halifax, Nova Scotia
Canada B3K 3B4

ph: (902) 429.1867
fax: (902) 429.6276

STATE OF UTAH
Brian Mackay-Lyons
No. 9809836
LICENSED ARCHITECT

NOTE: all dimensions to be verified in field

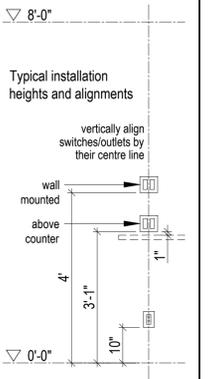

No.	Description	Date
5	IFC Rev 02	2019.02.08
4	IFC Rev 01	2018.06.29
3	Issued for Construction	2018.03.13
2	Issued for Tender	2017.12.22
1	for coordination	2017.12.1

NOTES:

COPYRIGHT RELATED TO THE USE OF THIS DRAWING:
The use of this drawing shall be governed by standard copyright law as generally accepted in architectural practice.

ARCHITECT'S REQUIREMENTS AND APPROVALS:
It is the Builder's responsibility to notify Mackay-Lyons Sweetapple Architects Ltd. and to seek prior written approval for materials and workmanship which deviates from instructions provided by the Architect.

ENGINEER'S REQUIREMENTS AND APPROVALS:
It is the Builder's responsibility to notify Mackay-Lyons Sweetapple Architects Ltd. and to seek prior written approval for materials and workmanship which deviates from instructions provided by the Engineer.

AUTHORITIES' REQUIREMENTS AND APPROVALS:
All materials and workmanship must comply with the requirements of all authorities having jurisdiction over the work. It is the Builder's responsibility to gain necessary approval from all relevant Authorities.

DIMENSIONS:
All dimensions must be verified on site. Do not scale off drawings. Plans take precedent over elevations. In the absence of dimensions, or if discrepancies exist, consult Architect. All minimum dimensions are to comply with the International Residential Code.

SHOP DRAWINGS:
Submit shop drawings to the Architect and Engineer for approval prior to manufacture of prefabricated elements of the building.

Third & Fourth
Electrical Plans


scale: 1/4" = 1'-0"
date: 17-11-23
drawn: RD
chk'd: BML

A801

ELECTRIC LEGEND:

- ⊕ 125v duplex
- ⊕ GFCI duplex
- ⊕ 240v duplex
- ⊕ floor duplex
- ⊕ usb duplex
- shower luminaire
- ⊗ wall mounted stair luminaire
- square trim LED potlight
- ceiling mounted utility luminaire
- ⊗ single head spotlight
- puck light
- ⊕ ceiling mounted pendant
- LED pot light
- ⊕ wall switch
- ⊕ ceiling mounted pendant
- ⊕ wall mounted vanity luminaire


- ⊕ three-way switch
- ⊕ switch with timer
- ⊕ exhaust fan
- ⊕ cable jack
- ⊕ internet jack
- ⊕ telephone jack
- ⊕ smoke alarm (wall mounted)
- ⊕ thermostat
- ⊕ alarm control pad
- ⊕ carbon monoxide detector
- interior LED strip light
- exterior LED strip light
- electrical panel

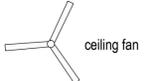

APPLIANCE LEGEND
(refer to appliance specs for electrical requirements)

- ① refrigerator / freezer
- ② dishwasher
- ③ microwave
- ④ oven
- ⑤ washer
- ⑥ dryer
- ⑦ cooktop
- ⑧ dumb-waiter
- ⑨ hot tub
- ⑩ vent hood

NOTE:
All exterior lighting to conform to Lighting Level LZ1: Low Ambient Lighting, Joint IOA-IES Lighting Ordinance, 2011

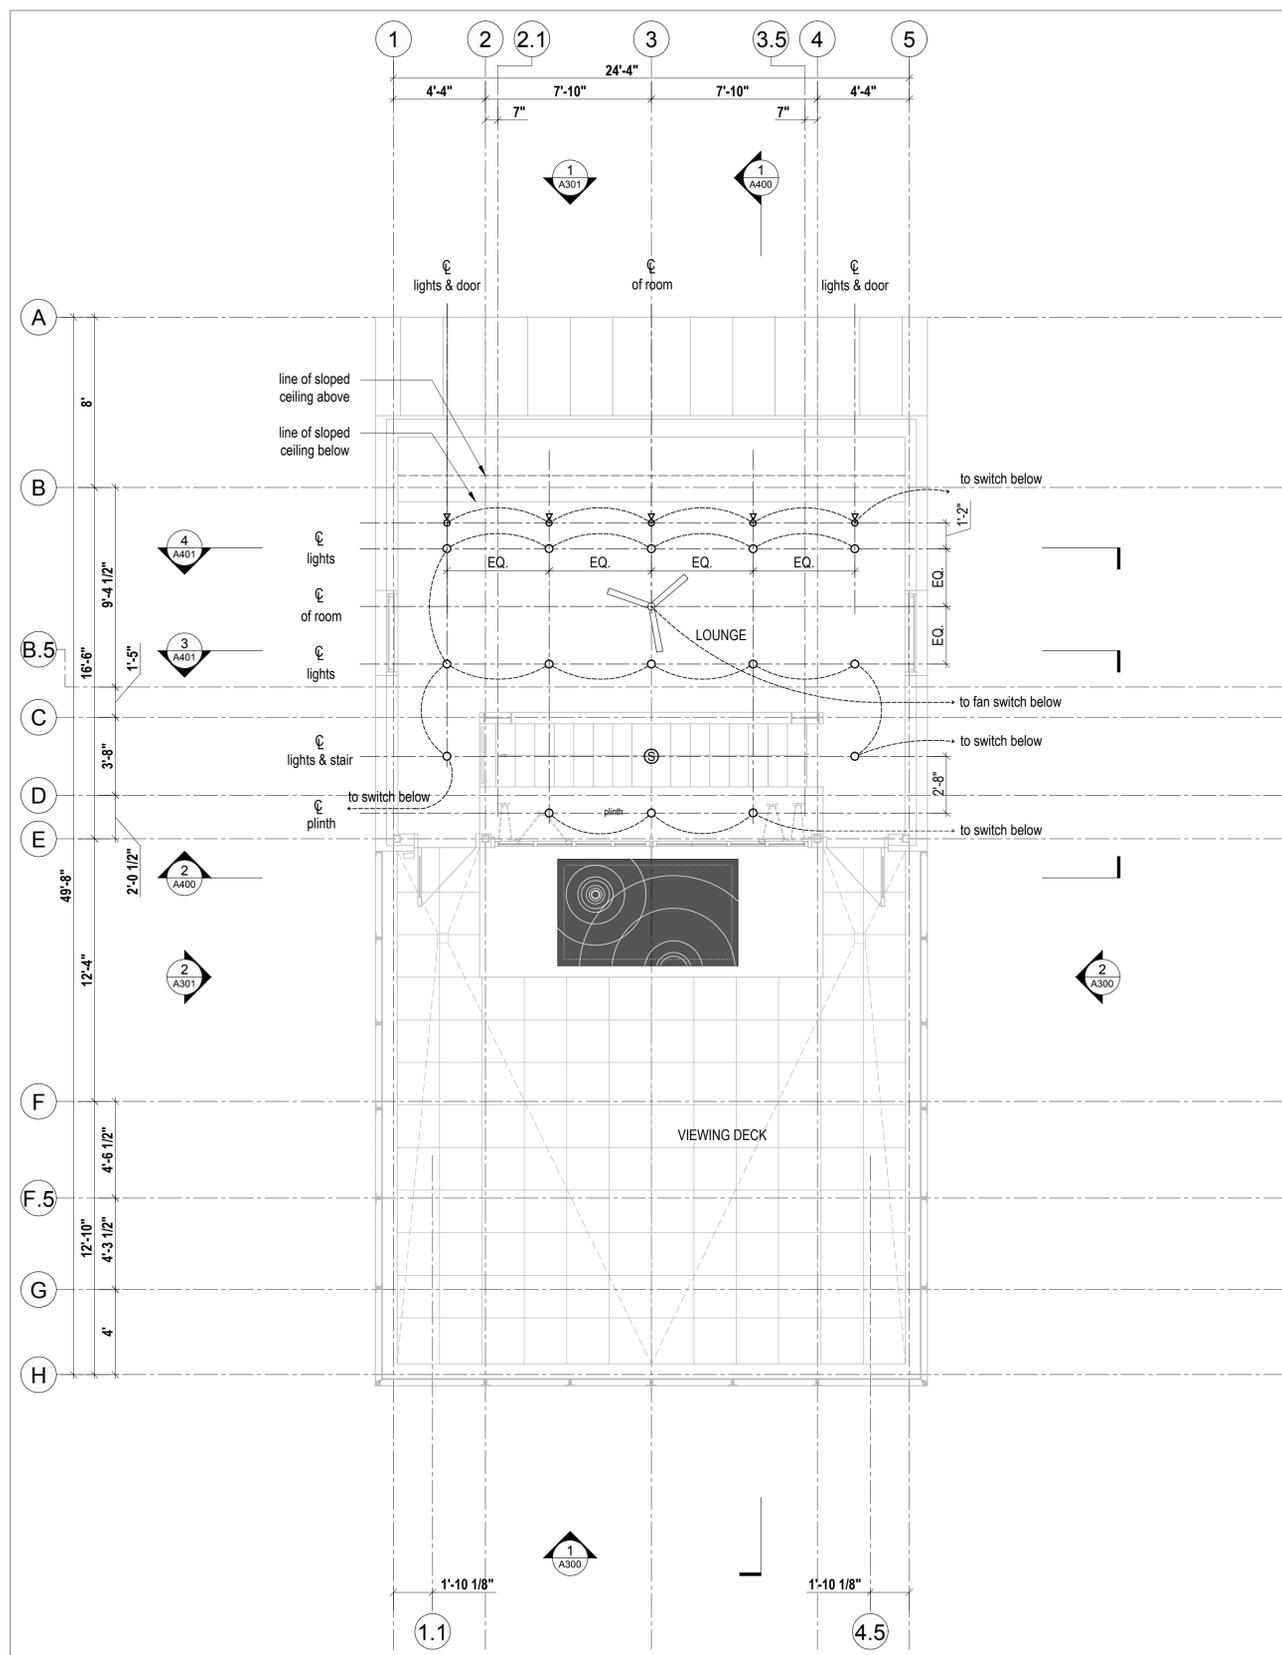

1 Loft Plan
Scale 1/4" = 1'-0"

Lot 71R
Village House

Summit Powder Mountain
Evan, Utah


Mackay-Lyons
Sweetapple
Architects
Limited

2188 Göttingen St.
Halifax, Nova Scotia
Canada B3K 3B4

ph: (902) 429.1867
fax: (902) 429.6276

STATE OF UTAH
Brian Mackay-Lyons
No. 9809836
LICENSED ARCHITECT

NOTE: all dimensions to be verified in field

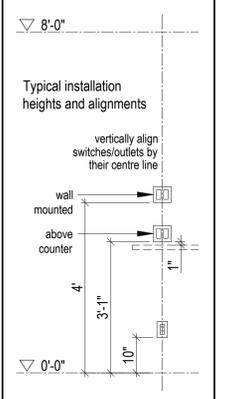

No.	Description	Date
5	IFC Rev 02	2019.02.08
4	IFC Rev 01	2018.06.29
3	Issued for Construction	2018.03.13
2	Issued for Tender	2017.12.22
1	for coordination	2017.12.1

NOTES:

COPYRIGHT RELATED TO THE USE OF THIS DRAWING:
The use of this drawing shall be governed by standard copyright law as generally accepted in architectural practice.

ARCHITECT'S REQUIREMENTS AND APPROVALS:
It is the Builder's responsibility to notify Mackay-Lyons Sweetapple Architects Ltd. and to seek prior written approval for materials and workmanship which deviates from instructions provided by the Architect.

ENGINEER'S REQUIREMENTS AND APPROVALS:
It is the Builder's responsibility to notify Mackay-Lyons Sweetapple Architects Ltd. and to seek prior written approval for materials and workmanship which deviates from instructions provided by the Engineer.

AUTHORITIES' REQUIREMENTS AND APPROVALS:
All materials and workmanship must comply with the requirements of all authorities having jurisdiction over the work. It is the Builder's responsibility to gain necessary approval from all relevant Authorities.


DIMENSIONS:
All dimensions must be verified on site. Do not scale off drawings. Plans take precedent over elevations. In the absence of dimensions, or if discrepancies exist, consult Architect. All minimum dimensions are to comply with the International Residential Code.

SHOP DRAWINGS:
Submit shop drawings to the Architect and Engineer for approval prior to manufacture of prefabricated elements of the building.

Level 4
Electrical Plan

scale: 1/4" = 1'-0"
date: 17-11-23
drawn: RD
chk'd: BML

A802

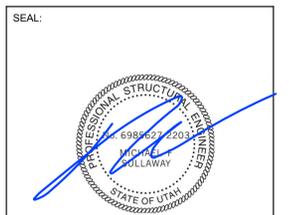

010000 GENERAL

- CONFORM TO THE REQUIREMENTS OF THE BUILDING CODE OF IBC 2015, LATEST EDITION, AND ALL OTHER APPLICABLE LOCAL CODES AND REGULATIONS OF AGENCIES HAVING JURISDICTION.
- READ STRUCTURAL DRAWINGS IN CONJUNCTION WITH THE SPECIFICATIONS AND ALL OTHER CONTRACT DOCUMENTS.
- BEFORE PROCEEDING WITH WORK, CHECK ALL THE DIMENSIONS SHOWN ON THE STRUCTURAL DRAWINGS WITH THE ARCHITECTURAL, MECHANICAL AND ELECTRICAL DRAWINGS AND REPORT DISCREPANCIES TO THE CONSULTANT.
- REFER TO THE ARCHITECTURAL AND OTHER DRAWINGS FOR LOCATIONS AND DIMENSIONING OF OPENINGS AND SLEEVES NOT SHOWN ON THE STRUCTURAL DRAWINGS. HOWEVER, OBTAIN THE CONSULTANT'S PRIOR APPROVAL BEFORE INSTALLING OPENINGS, SLEEVES, ETC. WHICH ARE NOT SHOWN ON STRUCTURAL DRAWINGS.
- SEE ARCHITECTURAL, MECHANICAL AND ELECTRICAL DRAWINGS FOR LOCATIONS OF PITS, BASES, Sumps, TRENCHES, DEPRESSIONS, GROOVES, CURBS, CHAMFERS AND SLOPES NOT SHOWN ON STRUCTURAL DRAWINGS.
- HORIZONTAL AND VERTICAL DESIGN LOADS ARE NOTED. THEY SHALL NOT BE EXCEEDED DURING CONSTRUCTION.
- TYPICAL STRUCTURAL DETAILS SHALL GOVERN THE WORK. IF DETAILS DIFFER ON THE DRAWINGS, THE MOST STRINGENT SHALL GOVERN.
- ALL TEMPORARY WORKS INCLUDING SHORING ARE TO BE PROVIDED BY THE CONTRACTOR.

010001 DESIGN NOTES

- ALL WORK SHALL CONFORM TO THE MINIMUM STANDARDS AND REQUIREMENTS OF THE FOLLOWING CODES:
- THE IBC 2015, AND ALL OTHER APPLICABLE LOCAL CODES AND REGULATIONS HAVING JURISDICTION.
- AMERICAN SOCIETY OF CIVIL ENGINEERS, ASCE 7-10 MINIMUM DESIGN LOADS FOR BUILDINGS AND OTHER STRUCTURES.
- AMERICAN CONCRETE INSTITUTE (ACI): ACI-318-14 BUILDING CODE REQUIREMENTS FOR STRUCTURAL CONCRETE.
- AMERICAN INSTITUTE OF STEEL CONSTRUCTION (AISC): AISC-325 AMERICAN INSTITUTE OF STEEL CONSTRUCTION MANUAL 14TH EDITION.
- AMERICAN INSTITUTE OF STEEL CONSTRUCTION (AISC): AISC 360-10 SPECIFICATIONS FOR STRUCTURAL STEEL BUILDINGS.
- AMERICAN INSTITUTE OF STEEL CONSTRUCTION (AISC): AISC-341-10 SEISMIC PROVISIONS FOR STRUCTURAL STEEL BUILDINGS.
- AMERICAN INSTITUTE OF STEEL CONSTRUCTION (AISC): AISC-358-11 PREQUALIFIED CONNECTIONS FOR SPECIAL AND INTERMEDIATE STEEL MOMENT FRAMES FOR SEISMIC APPLICATIONS - INCLUDING SUPPLEMENT NO.1.
- AMERICAN WOOD COUNCIL (AWC): NDS-2015 NATIONAL DESIGN SPECIFICATION FOR WOOD CONSTRUCTION COMMENTARY - WITH SUPPLEMENT 2015 EDITION.
- AMERICAN WOOD COUNCIL (AWC): SDPWS-2015 SPECIAL DESIGN PROVISIONS FOR WIND AND SEISMIC.
- FORCES ON STRUCTURAL FRAME:

A. LIVE:	VARIABLE REFER TO NOTES UNDER PLANS	
B. DEAD:	VARIABLE REFER TO NOTES UNDER PLANS	
C. SNOW:	EXPOSURE FACTOR (CE)	= 1.0
	THERMAL FACTOR (CT)	= 1.0
	IMPORTANCE FACTOR (I)	= 1
	ROOF SLOPE FACTOR (CS)	= 1
	GROUND SNOW LOAD (PG)	= 270psf
	FLAT ROOF SNOW LOAD (PF)	= 189psf
	SLOPED ROOF SNOW LOAD (PS)	= 189psf
	FROST DEPTH:	= 40in
D. WIND:	BASIC WIND SPEED (V)	= 115mph
	WIND IMPORTANCE FACTOR (I)	= 1
	EXPOSURE FACTOR:	= C

- SEISMIC ANALYSIS:

A. SEISMIC IMPORTANCE FACTOR (I):	= 1
B. RISK CATEGORY:	= II
C. SPECTRAL RESPONSE ACCEL (S _s):	= 0.813g
D. SPECTRAL RESPONSE ACCEL (S ₁):	= 0.269g
E. SITE CLASSIFICATION:	= C
F. DESIGN SPECTRAL RESPONSE (SDS):	= 0.582g
G. DESIGN SPECTRAL RESPONSE (SD1):	= 0.274g
H. SEISMIC DESIGN CATEGORY:	= D

17. LATERAL LOAD RESISTING SYSTEMS	
A. THE LATERAL FORCES ARE RESISTED BY:	
I) LATERAL SYSTEM:	BEARING WALL SYSTEM PLYWOOD SHEARWALLS
RESPONSE MOD. COEFFICIENT(R):	6.5
OVERSTRENGTH FACTOR(O):	3
DEFLECTION MODIFICATION FACTOR(C _d):	4
II) LATERAL SYSTEM:	MOMENT RESISTING FRAMES (SMF)
RESPONSE MOD. COEFFICIENT(R):	8
OVERSTRENGTH FACTOR(O):	3
DEFLECTION MODIFICATION FACTOR(C _d):	5.5

**DECREASE DEFLECTION LIMITS IN ACCORDANCE WITH ASCE-7 12.12.1.1, MOMENT FRAMES IN SEISMIC REGIONS D THROUGH F

- SEISMIC ANALYSIS PROCEDURE: EQUIVALENT LATERAL FORCE
- ANALYSIS SOFTWARE: RISA FLOOR/3D
- LATERAL LOAD ON FOUNDATIONS
 - A GEOTECHNICAL REPORT "GEOTECHNICAL AND GEOLOGIC HAZARD INVESTIGATION: LOT 71R OF SUMMIT EDEN PHASE 1C 8488 E. SPRING PARK ROAD SUMMIT POWDER MOUNTAIN RESORT WEBER COUNTY, UTAH" PROJECT NUMBER 02565-001, DATED AUGUST 30TH, 2017 HAS BEEN PREPARED BY IGES INC.
 - THE CONTRACTOR IS TO READ THE REPORT AND BE FAMILIAR WITH ITS CONTENTS.
 - BASEMENT WALLS ARE DESIGNED TO RETAIN AN EQUIVALENT FLUID DENSITY OF 55pcf AS PER THE REPORT.
 - FOUNDATION WALLS ARE DESIGNED ASSUMING THERE IS FREE-DRAINING BACKFILL OR THAT OTHER PROVISIONS HAVE BEEN MADE, SUCH THAT THE WALLS ARE NOT SUBJECT TO HYDROSTATIC PRESSURE.

030000 CONCRETE

- NOMINAL MAXIMUM SIZE OF AGGREGATE SHALL BE 3/4". USE SMALLER AGGREGATES AS APPROPRIATE IN AREAS OF CONGESTED REINFORCING STEEL OR TO IMPROVE WORKABILITY. MODIFY MIX DESIGNS TO SUIT.

CATEGORY	DESCRIPTION	EXPOSURE CLASS PER AC3.1	CONCRETE STRENGTH Fc (psi)	MAX W/C RATIO	AIR CONTENT ¹	SCOPE
CM1	FOUNDATION MIX		3500			FOOTING AND CAPS
CM2	SLAB ON GRADE MIX		3000			SLABS ON GRADE
CM3	SLAB AND BEAM MIX		4500			FRAMED SLABS AND BEAMS
CM4	COLUMN AND WALL MIX		4500			CONC. COLUMNS AND WALLS NOT EXPOSED TO FREEZE THAW OR DE-ICING CHEMICALS
CM5	TOPPING MIX		3000			TOPPING ON CONCRETE
CM6	COMPOSITE DECK MIX		3000			SLABS ON METAL DECKS
CM7	PARKING SLAB AND BEAM MIX	C-1 ²	5000	0.40		FOUNDATION WALLS ADJACENT TO PAVING FRAMED SLABS AND BEAMS EXPOSED TO DE-ICING CHEMICALS
CM8	PAVING MIX	C-2	4700	0.45		EXTERIOR PAVING AND SIDEWALKS
CM9	PARKING MIX	C-4	3500	0.55		SLAB ON GRADE IN PARKING GARAGE EXPOSED TO DE-ICING CHEMICALS BUT NOT TO FREEZE THAW
CM10	INTENTIONALLY LEFT BLANK					
CM11	EXTERIOR WALL MIX	F-2	3500	0.55		FOUNDATION WALLS AND OTHER WALLS AND OTHER WALLS EXPOSED TO FREEZE THAW BUT NOT EXPOSED TO DE-ICING CHEMICALS

- WHERE AGGREGATES SMALLER THAN 14 mm ARE USED, INCREASE AIR CONTENT BY 1%
- REINFORCED CONCRETE EXPOSED TO DE-ICING CHEMICALS TO HAVE DCI CORROSION INHIBITOR @ 11L/cu.m. DOSAGE OR APPROVED EQUIVALENT

- REINFORCEMENT: CONFORM TO THE REQUIREMENTS OF ASTM A615 AND ASTM A706 IF WELDABLE REINFORCEMENT IS USED.

- REINFORCING BARS SHALL BE MINIMUM ASTM A615 GRADE 60 AND WELDED WIRE FABRIC SHALL BE MINIMUM ASTM A185, SUPPLY IN FLAT SHEETS.

- SLAB ON GRADE:
 - PLACE SLABS ON GRADE ON MATERIAL CAPABLE OF OS SUSTAINING 500psf WITHOUT SETTLEMENT RELATIVE TO BUILDING FOOTING.
 - BEFORE PLACING SLAB, PLACE MINIMUM 6" OF 3/4" MAXIMUM SIZE CLEAR CRUSHED STONE OVER THE SUB GRADE, THOROUGHLY ROLL AND CONSOLIDATE TO THE LINES AND LEVELS REQUIRED.
- CONCRETE AND REINFORCEMENT:
 - PROVIDE DOWELS TO WALLS AND COLUMNS SIMILAR IN NUMBER, SIZE, AND SPACING TO VERTICAL STEEL IN THE WALL OR COLUMN EXCEPT WHEN NOTED OTHERWISE.
 - PROVIDE 1.5"x2.5" KEYS AT ALL CONSTRUCTION JOINTS UNLESS NOTED OTHERWISE.
 - CONCRETE COVER TO REINFORCEMENT TO CONFORM TO THE REQUIREMENTS OF THE INTERNATIONAL BUILDING CODE AND ACI 318 AND THE FOLLOWING COVER REQUIREMENTS:

REINFORCING TYPE:	
SLABS NOT EXPOSED TO WEATHER AND INTERIOR WALL SURFACES	3/4in
EXTERIOR WALL SURFACES, SLABS EXPOSED TO WEATHER #5 AND SMALLER	1 1/2in
EXTERIOR WALL SURFACES, SLABS EXPOSED TO WEATHER LARGER THAN #5	2in
COLUMN AND BEAM TIES	1 1/2in
CLEAR DISTANCE BETWEEN BARS	2in
FORMED DIRECTLY AGAINST EARTH	3in
SECURELY TIE IN PLACE AND ADEQUATELY SUPPORT ALL REINFORCEMENT. LAP ALL BARS MARKED 'CONTINUOUS JOINTS' (CONT.) MINIMUM 40db.	
WHERE CHEMICAL ANCHORS ARE REQUIRED, USE HILTI HIT HY 200 EPOXY OR APPROVED EQUAL.	

310000 FOUNDATIONS

- A GEOTECHNICAL REPORT "GEOTECHNICAL AND GEOLOGIC HAZARD INVESTIGATION: LOT 71R OF SUMMIT EDEN PHASE 1C 8488 E. SPRING PARK ROAD SUMMIT POWDER MOUNTAIN RESORT WEBER COUNTY, UTAH" PROJECT NUMBER 02565-001, DATED AUGUST 30TH, 2017 HAS BEEN PREPARED BY IGES INC.. READ THIS REPORT, AND BE THOROUGHLY FAMILIARIZED WITH THEIR FINDINGS.
- FOUND ALL FOOTINGS ON NATURALLY CONSOLIDATED UNDISTURBED SOIL, CAPABLE OF SAFELY SUSTAINING AN ALLOWABLE BEARING VALUE OF 2900 PSF.
- FOUND FOOTINGS EXPOSED TO FREEZING BELOW THE LEVEL AT WHICH POTENTIAL DAMAGE RESULTING FROM FROST ACTION CAN OCCUR, BUT A MINIMUM OF 42in BELOW FINISHED GRADE IF NOT NOTED TO BE FOUNDED LOWER.
- THE LINE OF SLOPE BETWEEN ADJACENT FOOTINGS OR EXCAVATIONS OR ALONG STEPPED FOOTINGS SHALL NOT EXCEED A RISE OF 7 IN A RUN OF 10.
- DO NOT PLACE BACKFILL AGAINST WALLS RETAINING EARTH (OTHER THAN CANTILEVER WALLS) UNTIL THE FLOOR CONSTRUCTION AT TOP AND BOTTOM OF THE WALLS IS POURED AND HAS ATTAINED 70% OF ITS SPECIFIED STRENGTH.
- CARRY OUT BACKFILLING AGAINST FOUNDATION WALLS WHERE THERE IS GRADE ON BOTH SIDES IN SUCH A MANNER THAT THE LEVEL OF BACKFILLING ON ONE SIDE OF THE WALL IS NEVER MORE THAN 1'-8" DIFFERENT FROM THE LEVEL ON THE OTHER SIDE OF THE WALL.

050000 STRUCTURAL STEEL

- ALL STRUCTURAL STEEL AND MISCELLANEOUS METAL SHALL BE DETAILED, FABRICATED AND ERECTED IN CONFORMANCE WITH AISC 325.
- MATERIALS: ALL STRUCTURAL STEEL SHALL CONFORM TO THE NOTED ASTM STANDARDS UNO.

A. W-SHAPES	A992
B. HSS (RECTANGULAR AND SQUARE)	A500 (Fy = 45ksi)
C. HSS (CIRCULAR)	A500 (Fy = 42ksi)
D. ANGLE/S-C CHANNELS/MC-CHANNELS	A36
E. ALL OTHER STEEL PLATES	A36

- WHERE SPECIFIED, GALVANIZED STEEL IS TO BE COMPLETED IN ACCORDANCE WITH ASTM A123 HOT DIP PROCESS.
- ALL TEMPORARY BRACING, SHORING, AND ERECTION CLIPS REQUIRED BY THE CONTRACTOR ARE NOT SHOWN. WORK IS TO CONFORM TO OSHA REQUIREMENTS.
- SHOP DRAWINGS ARE TO BE SUBMITTED TO CONSULTANTS FOR REVIEW PRIOR TO FABRICATION.
- TESTING AND INSPECTION AGENCIES SHALL SEND STRUCTURAL TESTING AND INSPECTION REPORTS DIRECTLY TO THE CONSULTANT.
- CONNECTIONS
 - ALL STEEL-TO-STEEL BOLTED CONNECTIONS TO BE MADE WITH HIGH STRENGTH BOLTS AS PER "SPECIFICATION FOR STRUCTURAL JOINTS USING ASTM A325 OR A490 BOLTS"
 - UNLESS NOTED BOLTS IN CONNECTIONS SHALL BE BEARING TYPE WITH THREADS EXCLUDED FROM THE SHEAR PLANE. USE ASTM A325 BOLTS UNLESS NOTED.
 - STEEL WASHERS CONFORM TO A436. NUTS TO CONFORM TO A563
 - ANCHOR BOLTS AND ANCHOR RODS TO CONFORM TO ASTM F1554 GRADE 36.
 - ALL WELDED CONNECTIONS TO BE COMPLETED IN ACCORDANCE WITH THE "STRUCTURAL WELDING CODE - STEEL (AWS-D1.1) AND HAVE A MINIMUM TENSILE STRENGTH OF 70ksi FOR ALL ELECTRODES.
 - ALL WELDERS ARE TO BE QUALIFIED IN ACCORDANCE WITH AWS.D1.1 FOR ALL WELDS THEY WILL BE COMPLETING.
 - WELD LENGTHS CALLED FOR ON STRUCTURAL DRAWINGS ARE NET EFFECTIVE LENGTH. IF NO LENGTH IS SPECIFIED USE THE MINIMUM SIZE AS SPECIFIED IN AISC 360, SECTION J2.2B.
 - ALL WELDING TO BE PERFORMED IN ACCORDANCE WITH A WRITTEN WELDING PROCEDURE (WPS). SUBMIT ALL WPS TO CONSULTANT WHICH OUTLINES ALL PROCEDURES, ELECTRODE SPECIFICATIONS, DATA SHEETS AND LIMITATIONS.
 - RUN-OFF TABS PER AWS D1.1 ARE REQUIRED FOR ALL COMPLETE JOINT PENETRATION WELDS. START AND COMPLETE ALL WELDS ON RUN-OFF TABS. WELDS ARE NOT TO BE COMPLETED AT COPE HOLE LOCATIONS.
 - COMPLETE PENETRATION AND PARTIAL PENETRATION WELDS SHALL BE INSPECTED AND EXAMINED BY ULTRASONIC TESTING. ALL TESTING AND INSPECTION SHALL CONFORM TO IBC REQUIREMENTS.
 - ALL HEADED STUDS WELDED TO BEAMS OR CONCRETE CONNECTIONS SHALL BE NELSON STUDS OR APPROVED EQUAL.
 - HEADED STUDS SHALL BE AUTOMATICALLY WELDED IN SHOP OR FIELD WELDED WITH EQUIPMENT APPROVED BY THE MANUFACTURER OF THE STUDS.

060000 WOOD:

- FRAMING LUMBER SHALL BE DOUGLAS FIR-LARCH AND MEET THE FOLLOWING MINIMUM REQUIREMENTS UNLESS NOTED OTHERWISE.

2x6 STUDS, SILL AND PLATES	No2
2x JOISTS & BLOCKING	No2
6x6 AND LARGER	No1

- ENGINEERED FRAMING BEAMS AND MATERIAL SHALL MEET THE FOLLOWING MINIMUM REQUIREMENTS UNLESS NOTED OTHERWISE.

"PSL"	PARALLEL STRAND LUMBER BENDING STRESS (EDGE LOADED) SHEAR STRESS (EDGE LOADED) COMPRESSIVE STRESS (PERP TO GRAIN) COMPRESSIVE STRESS (PARA TO GRAIN) MODULUS OF ELASTICITY	Fb = 2,900psi Fv = 290psi Fc = 750psi Fc = 2,900psi E = 2,000ksi
"LVL"	LAMINATED VENEER LUMBER BENDING STRESS (EDGE LOADED) SHEAR STRESS (EDGE LOADED) COMPRESSIVE STRESS (PERP TO GRAIN) COMPRESSIVE STRESS (PARA TO GRAIN) MODULUS OF ELASTICITY	Fb = 2,600psi Fv = 285psi Fc = 750psi Fc = 2,510psi E = 1,800ksi
"LSL"	LAMINATED STRAND LUMBER BENDING STRESS (EDGE LOADED) SHEAR STRESS (EDGE LOADED) COMPRESSIVE STRESS (PERP TO GRAIN) COMPRESSIVE STRESS (PARA TO GRAIN) MODULUS OF ELASTICITY	Fb = 2,325psi Fv = 310psi Fc = 900psi Fc = 2,170psi E = 1,550ksi

- ALL ROOF SHEATHING TO BE 3/4" C-D GRADE PLYWOOD WITH EXTERIOR GRADE GLUE OR OSB PANELS. TYPICAL NAILING TO BE 10d @ 6" o/c AT ALL SUPPORTED EDGES AND 10d @ 12" o/c AT INTERMEDIATE SUPPORTS, UNLESS NOTED OTHERWISE.
- ALL FLOOR SHEATHING TO BE 3/4" C-D GRADE T&G SHEATHING WITH EXTERIOR GRADE GLUE OR OSB PANELS. BLOCK ALL PANEL EDGES. TYPICAL NAILING TO BE 10d @ 6" o/c AT ALL SUPPORTED EDGES AND 10d @ 12" o/c AT INTERMEDIATE SUPPORTS, UNLESS NOTED OTHERWISE.
- ALL LOAD BEARING STUD WALLS NOT INDICATED AS SHEARWALLS ON PLANS TO BE SHEATHED WITH PLYWOOD OR OSB PANELS. BLOCK ALL PANEL EDGES. TYPICAL NAILING TO BE 10d @ 6" o/c AT ALL SUPPORTED EDGES AND 10d @ 12" o/c AT INTERMEDIATE SUPPORTS UNLESS NOTED OTHERWISE.
- ENGINEERED FLOOR JOISTS TO BE MANUFACTURED FLOOR JOIST SYSTEM BY REDBUILT ENGINEERED WOOD PRODUCTS. PROVIDE SEALED ENGINEERED FLOOR LAYOUTS FROM MANUFACTURER PRIOR TO FABRICATION OF ELEMENTS.
- ALL BLOCKING IN ENGINEERED FLOOR SYSTEM TO BE FULL DEPTH LVL MATERIAL.
- SUBSTITUTION OF FLOOR SYSTEM CAN BE MADE WITH THE SUBMISSION OF EQUIVALENCY REPORT FROM ALTERNATE SUPPLIER.
- ALL WOOD-TO-WOOD CONNECTIONS ARE TO BE BY SIMPSON STRONG TIE OR APPROVED EQUIVALENT, ALL HANGERS TO BE RATED FOR MINIMUM CONNECTION FORCES NOTED ON PLANS.
- EXECUTION:
 - ALL SILL PLATES TO BE STAMPED "KD" WHICH INDICATES KILN DRIED WITH A MOISTURE CONTENT NOT EXCEEDING 13%.
 - ALL WOOD SILL PLATES UNDER BEARING, EXTERIOR WALLS OR SHEARWALLS IN CONTACT WITH CONCRETE OR MASONRY SHALL BE BOLTED TO THE CONCRETE OR MASONRY BELOW WITH #8" Ø ANCHORS @ 4'-0" o/c BEGINNING AT 9" MAXIMUM FROM EACH END OF THE PLATES, EXTENDING MINIMUM 6" INTO THE CONCRETE OR MASONRY BELOW.
 - PROVIDE SOLID BLOCKING, INCLUDING SQUASH BLOCKS, BELOW ALL POINT LOADS, EXTENDING DOWN TO THE TOP OF FOUNDATIONS.
 - PROVIDE BRIDGING IN FLOOR AND ROOF ASSEMBLIES AT 8'-0" o/c MAXIMUM UNLESS SPECIFICALLY DETAILED OTHERWISE BY THE ENGINEERED FLOOR SUPPLIER.
 - REFER TO TYPICAL DETAILS FOR STANDARD FRAMING REQUIREMENTS AT WOOD TO STEEL, WOOD TO FOUNDATION AND WOOD TO WOOD FLOOR ASSEMBLIES.
 - PROTECT ALL WOOD PRODUCTS FROM DAMAGE AND STAINING DUE TO WETTING AND MOISTURE.
 - RE-TIGHTEN ALL ANCHORS JUST PRIOR TO COVERING THE WALL FRAMING.

010003 NOTABLE SUBMITTALS


- GENERAL REVIEW BY COMPONENT ENGINEERS
 - COMPONENT ENGINEERS ARE RESPONSIBLE FOR GENERAL REVIEW OF THE CONSTRUCTION FOR THE PORTION OF THE WORK PREPARED UNDER THEIR PROFESSIONAL SEALS. THEY SHALL PROVIDE:
 - REPORTS FOR EACH SITE VISIT
 - A PROJECT COMPLETION NOTICE
 - ENGINEERED COMPONENTS INCLUDE: PRECAST CONCRETE, OPEN WEB STEEL JOISTS, METAL DECK, PRE-ENGINEERED WOOD TRUSSES, DEEP FOUNDATIONS, MISCELLANEOUS METALS, STRUCTURAL GLASS, GLASS CONNECTIONS, CURTAINWALL, HELICAL PEIRS, GEOPIERS, MICROPILES.

010004 SUBMITTALS

- GEOMETRY
- SUBMIT SURVEY RECORDS CONFIRMING THAT THE BUILT GEOMETRY MATCHES THE DESIGN GEOMETRY.
- CONCRETE REINFORCEMENT
 - SUBMIT REINFORCING PLACING DRAWINGS AND BAR LISTS FOR REVIEW BY THE CONSULTANT.
 - PROVIDE TEST CYLINDERS IN ACCORDANCE WITH ASTM STANDARDS.
 - STRUCTURAL STEEL
 - SUBMIT DETAILED SHOP DRAWINGS AND DETAILED CONNECTIONS FOR ALL STEEL COMPONENTS, BASED ON SECTION DETAILS AND CONNECTION DETAILS PROVIDED, FOR THE REVIEW OF THE CONSULTANT PRIOR TO ANY FABRICATION.
 - ERECTION AND SETTING DRAWINGS FOR THE REVIEW OF THE CONSULTANT.

010005 DEFERRED SUBMITTALS

- ITEMS NOTED BELOW ARE INDICATED AS DEFERRED SUBMITTALS. THE ITEMS HAVE BEEN SHOWN OR INDICATED ON STRUCTURAL & ARCHITECTURAL DRAWINGS TO CONVEY DESIGN INTENT ONLY. FINAL SIZES, DETAILS, SHOP DRAWINGS AND CALCULATIONS SHALL BE SEALED BY A STRUCTURAL ENGINEER LICENSED IN THE STATE OF UTAH. ALL SUBMITTALS SHALL BE SUPPLIED TO THE BUILDING DEPARTMENT FOR REVIEW AND APPROVAL.
 - CUSTOM STEEL GUARD AT WALKOUT TERRACE
 - HELICAL PIER DESIGN

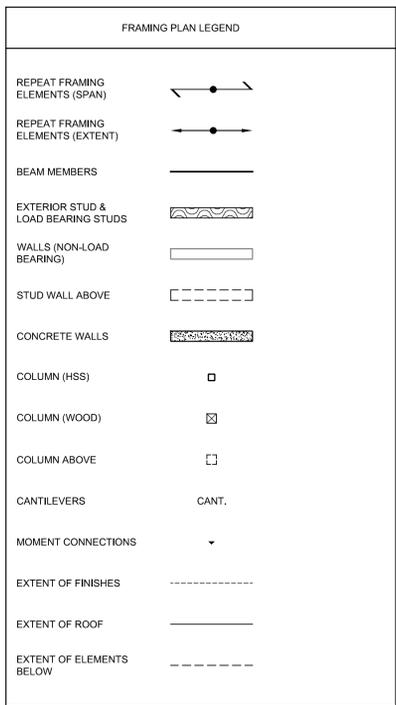

010005 DEFERRED SUBMITTALS

- ITEMS NOTED BELOW ARE INDICATED AS DEFERRED SUBMITTALS. THE ITEMS HAVE BEEN SHOWN OR INDICATED ON STRUCTURAL & ARCHITECTURAL DRAWINGS TO CONVEY DESIGN INTENT ONLY. FINAL SIZES, DETAILS, SHOP DRAWINGS AND CALCULATIONS SHALL BE SEALED BY A STRUCTURAL ENGINEER LICENSED IN THE STATE OF UTAH. ALL SUBMITTALS SHALL BE SUPPLIED TO THE BUILDING DEPARTMENT FOR REVIEW AND APPROVAL.

- CUSTOM STEEL GUARD AT WALKOUT TERRACE
- HELICAL PIER DESIGN

MARK	DATE	DESCRIPTION
△	2018.08.24	REVISED PERMIT SET
△	2018.06.26	ISSUED FOR PERMIT
△	2018.06.20	ISSUED FOR COORDINATION
△	2018.02.01	ISSUED FOR PERMIT
△	2017.12.13	ISSUED FOR INTERNAL COORD.
△	2017.12.02	ISSUED FOR COORDINATION
△	2017.11.22	ISSUED C GRADE COSTING
△	2017.11.07	INTERNAL COORDINATION

PROJECT NAME:
VILLAGE HOUSE AT LOT 71

PROJECT ADDRESS:
VILLAGE HOUSE LOT 71, SUMMIT POWDER MOUNTAIN

DRAWN: AVB	CHECKED: --
SCALE: AS NOTED	PROJECT NUMBER: 170450
SHEET TITLE: GENERAL NOTES	

SCHEDULE OF SPECIAL INSPECTIONS

VERIFICATION AND INSPECTION	CONTINUOUS	PERIODIC	DETAILED INSTRUCTIONS AND FREQUENCIES
REINFORCED CONCRETE (IBC 1705.3 & 1705.12.1)			
REINFORCING STEEL		X	VERIFY PRIOR TO PLACING CONCRETE THAT REINFORCING IS OF SPECIFIED TYPE, GRADE AND SIZE; THAT IT IS FREE OF OIL, DIRT AND RUST; THAT IT IS LOCATED AND SPACED PROPERLY; THAT HOOKS, BENDS, TIES, STIRRUPS, AND SUPPLEMENTAL REINFORCEMENT ARE PLACED CORRECTLY; THAT TAP LENGTHS, STAGGER AND OFFSETS ARE PROVIDED; AND THAT ALL MECHANICAL CONNECTIONS ARE INSTALLED PER THE MANUFACTURER'S INSTRUCTIONS AND/OR EVALUATION REPORT.
ANCHORAGE		X	INSPECTION OF ANCHORS CAST IN CONCRETE.
USE OF REQUIRED MIX DESIGN		X	VERIFY THAT ALL MIXTURES USED COMPLY WITH THE APPROVED CONSTRUCTION DOCUMENTS; ACI 318: Ch. 4, 5.2-5.4; AND IBC 1904.3, 1913.2, 1913.3.
CONCRETE SAMPLING FOR STRENGTH TESTS, SLUMP, AIR CONTENT, AND TEMPERATURE	X		
CONCRETE PLACEMENT	X		
CURING TEMPERATURE AND TECHNIQUES		X	VERIFY THAT AMBIENT TEMPERATURE FOR CONCRETE IS KEPT > 50°F FOR AT LEAST 7 DAYS AFTER PLACEMENT; HIGH-EARLY-STRENGTH CONCRETE SHALL BE KEPT > 50°F FOR AT LEAST 3 DAYS. ACCELERATED CURING METHODS MAY BE USED (SEE ACI 318.5.11.3). ALL CONCRETE MATERIALS, REINFORCEMENT, FORMS, FILLERS, AND GROUND SHALL BE FREE FROM FROST. IN HOT WEATHER CONDITIONS ENSURE THAT APPROPRIATE MEASURES ARE TAKEN TO AVOID PLASTIC SHRINKAGE CRACKING AND THAT THE SPECIFIED WATER/CEMENT RATIO IS NOT EXCEEDED.
STRENGTH VERIFICATION		X	VERIFY THAT ADEQUATE STRENGTH HAS BEEN ACHIEVED PRIOR TO THE REMOVAL OF FORMS.
FORMWORK		X	VERIFY THAT FORMS ARE PLACED PLUMB AND CONFORM TO THE SHAPES, LINES, AND DIMENSIONS OF THE MEMBERS AS REQUIRED BY THE APPROVED CONSTRUCTION DOCUMENTS.
STRUCTURAL STEEL - PRIOR TO WELDING (TABLE N5.4-1, AISC 360-10)			
VERIFY WELDING PROCEDURES (WPS) AND CONSUMABLE CERTIFICATES	X		
MATERIAL IDENTIFICATION		X	VERIFY TYPE AND GRADE OF MATERIAL.
WELDER IDENTIFICATION		X	A SYSTEM SHALL BE MAINTAINED BY WHICH A WELDER WHO HAS WELDED A JOINT OR MEMBER CAN BE IDENTIFIED.
FIT-UP GROOVE WELDS		X	VERIFY JOINT PENETRATION, DIMENSIONS, CLEANLINESS, TACKING, AND BACKING.
ACCESS HOLES		X	VERIFY CONFIGURATION AND FINISH.
FIT-UP FILLET WELDS		X	VERIFY ALIGNMENT, GAPS AT ROOT, CLEANLINESS OF STEEL SURFACES, AND TACK WELD QUALITY AND LOCATION.
STRUCTURAL STEEL - DURING WELDING (TABLE N5.4-2, AISC 360-10)			
USE OF QUALIFIED WELDERS		X	VERIFY THAT WELDERS ARE APPROPRIATELY QUALIFIED.
CONTROL AND HANDLING OF WELDING CONSUMABLES		X	VERIFY PACKAGING AND EXPOSURE CONTROL.
CRACKED TACK WELDS		X	VERIFY THAT WELDING DOES NOT OCCUR OVER CRACKED TACK WELDING.
ENVIRONMENTAL CONDITIONS		X	VERIFY THAT WIND SPEED, PRECIPITATION, AND TEMPERATURE ARE WITHIN LIMITS.
WPS FOLLOWED		X	VERIFY ITEMS SUCH AS SETTINGS ON WELDING EQUIPMENT, TRAVEL SPEED, WELDING MATERIALS, SHIELDING GAS TYPE/FLOW RATE, PREHEAT APPLIED, INTERPASS TEMPERATURE MAINTAINED, AND PROPER POSITION.
WPS FOLLOWED		X	VERIFY ITEMS SUCH AS SETTINGS ON WELDING EQUIPMENT, TRAVEL SPEED, WELDING MATERIALS, SHIELDING GAS TYPE/FLOW RATE, PREHEAT APPLIED, INTERPASS TEMPERATURE MAINTAINED, AND PROPER POSITION.
WELDING TECHNIQUES		X	VERIFY INTERPASS AND FINAL CLEANING, EACH PASS IS WITHIN PROFILE LIMITATIONS, AND QUALITY OF EACH PASS.
STRUCTURAL STEEL - AFTER WELDING (TABLE N5.4-3, AISC 360-10)			
WELDS CLEANED		X	VERIFY THAT WELDS HAVE BEEN PROPERLY CLEANED.
SIZE, LENGTH, AND LOCATION OF WELDS	X		
WELDS MEET VISUAL ACCEPTANCE CRITERIA	X		
ARC STRIKES	X		
K-AREA	X		
BACKING AND WELD TABS REMOVED	X		
REPAIR ACTIVITIES	X		
DOCUMENT ACCEPTANCE OR REJECTION OF WELDED JOINT/MEMBER	X		

VERIFICATION AND INSPECTION	CONTINUOUS	PERIODIC	DETAILED INSTRUCTIONS AND FREQUENCIES
NON-DSTRUCTIVE TESTING (SECTION N5.5, AISC 360-10)			
CJP WELDS		X	ULTRASONIC TESTING SHALL BE PERFORMED ON 10% OF CJP GROOVE WELDS IN BUTT, T- AND CORNER JOINTS SUBJECTED TO TRANSVERSELY APPLIED TENSION LOADING IN MATERIALS 5/16" THICK OR GREATER. TESTING RATE MUST BE INCREASED IF >5% OF WELDS TESTED HAVE UNACCEPTABLE DEFECTS.
ACCESS HOLES (FLANGE > 2")	X		
WELD JOINTS SUBJECT TO FATIGUE	X		
OTHER STEEL INSPECTIONS (SECTION N5.7, AISC 360-10; TABLES J8-1 & J10-1, AISC 341-10)			
STRUCTURAL STEEL DETAILS		X	ALL FABRICATED STEEL OR STEEL FRAMES SHALL BE INSPECTED TO VERIFY COMPLIANCE WITH THE DETAILS SHOWN IN THE CONSTRUCTION DOCUMENTS, SUCH AS BRACES, STIFFENERS, MEMBER LOCATIONS, AND PROPER APPLICATION OF JOINT DETAILS AT EACH CONNECTION.
ANCHOR RODS AND OTHER EMBEDMENTS SUPPORTING STRUCTURAL STEEL		X	SHALL BE ON THE PREMISES DURING THE PLACEMENT OF ANCHOR RODS AND OTHER EMBEDMENTS SUPPORTING STRUCTURAL STEEL FOR COMPLIANCE WITH CONSTRUCTION DOCUMENTS. VERIFY THE DIAMETER, GRADE, TYPE, AND LENGTH OF THE ANCHOR ROD OR EMBEDMENT ITEM, AND THE EXTENT OR DEPTH OF EMBEDMENT PRIOR TO PLACEMENT OF CONCRETE.
WOOD CONSTRUCTION (IBC 1705.10.1 & 1705.11.2)			
HIGH-LOAD DIAPHRAGMS		X	VERIFY THICKNESS AND GRADE OF SHEATHING, SIZE OF FRAMING MEMBERS AT PANEL EDGES, NAIL/STAPLE DIAMETERS AND LENGTH, AND THE NUMBER OF FASTENER LINES AND FASTENER SPACING PER APPROVED PLANS. <i>PERFORMED BY CODE INSPECTION FIRM.</i>
STRUCTURAL WOOD		X	WHERE FASTENER SPACING IS < 4" o.c.: VERIFY PROPER NAILING, BOLTING, ANCHORING, AND OTHER FASTENING OF SHEAR WALLS, DIAPHRAGMS, BRACES, AND HOLD-DOWNS. <i>PERFORMED BY CODE INSPECTION FIRM.</i>
SOILS (IBC 1705.6)			
VERIFY SUBGRADE IS ADEQUATE TO ACHIEVE DESIGN BEARING CAPACITY		X	PRIOR TO PLACEMENT OF CONCRETE.
VERIFY EXCAVATIONS EXTEND TO PROPER DEPTH AND MATERIAL		X	PRIOR TO PLACEMENT OF COMPACTED FILL OR CONCRETE.
VERIFY THAT SUBGRADE HAS BEEN APPROPRIATELY PREPARED PRIOR TO PLACING COMPACTED FILL		X	PRIOR TO PLACEMENT OF COMPACTED FILL.
PERFORM CLASSIFICATION AND TESTING OF COMPACTED FILL MATERIALS		X	ALL MATERIALS SHALL BE CHECKED AT EACH LIFT FOR PROPER CLASSIFICATIONS AND GRADATIONS NOT LESS THAN ONCE FOR EACH 10,000 SQ.FT. OF SURFACE AREA.
VERIFY PROPER MATERIALS, DENSITIES, AND LIFT THICKNESSES DURING PLACEMENT AND COMPACTION.	X		ALL MATERIALS SHALL BE CHECKED AT EACH LIFT FOR PROPER CLASSIFICATIONS AND GRADATIONS NOT LESS THAN ONCE FOR EACH 10,000 SQ.FT. OF SURFACE AREA.

- SPECIAL INSPECTORS SHALL BE APPROVED BY THE BUILDING OFFICIAL PRIOR TO PERFORMING ANY DUTIES.
- SPECIAL INSPECTORS SHALL PROVIDE PROOF OF LICENSURE BY THE STATE OF UTAH FOR EACH TYPE OF INSPECTION.
- SPECIAL INSPECTIONS AND TESTING SHALL BE PERFORMED IN ACCORDANCE WITH THE APPROVED PLANS AND SPECIFICATIONS, THIS STATEMENT, AND THE IBC SECTIONS 1704 AND 1705.
- INSPECTION REPORTS WILL BE SUBMITTED TO THE CODE CONSULTANT, THE ARCHITECT, AND THE STATE OF UTAH BUILDING OFFICIAL WITHIN 48 HOURS OF PERFORMING INSPECTIONS.
- A FINAL REPORT DOCUMENTING REQUIRED SPECIAL INSPECTIONS, TESTING AND CORRECTION OF ANY DISCREPANCIES NOTED IN THE INSPECTIONS AND A STATEMENT INDICATING THAT THE STRUCTURE IS IN COMPLIANCE WITH THE APPROVED CONSTRUCTION DOCUMENTS AND APPLICABLE CODES SHALL BE SUBMITTED.

SEAL:



MARK	DATE	DESCRIPTION
△	2018.08.24	REVISED PERMIT SET
△	2018.06.26	ISSUED FOR PERMIT
	2018.06.20	ISSUED FOR COORDINATION
	2018.02.01	ISSUED FOR PERMIT
	2017.12.13	ISSUED FOR INTERNAL COORD.
	2017.12.02	ISSUED FOR COORDINATION
	2017.11.22	ISSUED C GRADE COSTING
	2017.11.07	INTERNAL COORDINATION

PROJECT NAME:
VILLAGE HOUSE AT LOT 71





PROJECT ADDRESS:
VILLAGE HOUSE LOT 71, SUMMIT POWDER MOUNTAIN

DRAWN: AVB	CHECKED: --
SCALE: AS NOTED	PROJECT NUMBER: 170450

SHEET TITLE:
GENERAL NOTES CONT.'D

ABBREVIATIONS			0001
A.BOLT	= ANCHOR BOLT	kN	= KILONEWTON
ADJ.	= ADJUSTABLE	kg	= KILOGRAM
ALT.	= ALTERNATE	kN/m	= KILONEWTON METRES
ARCH.	= ARCHITECTURAL	kN/sq.m	= KILONEWTON PER SQUARE METRE
		kN/m	= KILONEWTON PER METRE
B	= BOTTOM	L.L.	= LIVE LOAD
BL	= BOTTOM LOWER LAYER	L.G.	= LONG
BUL	= BOTTOM UPPER LAYER	LLV	= LONG LEG VERTICAL
BUDC	= BUILDING	LLH	= LONG LEG HORIZONTAL
BM	= BEAM		
BR	= BASE OR BEARING PLATE	MAX	= MAXIMUM
BSMT.	= BASEMENT	MECH.	= MECHANICAL
		MEZZ.	= MEZZANINE
CA	= COLUMN ABOVE	MIN	= MINIMUM
C/C	= CENTRE TO CENTRE	MISC.	= MISCELLANEOUS
C	= CENTRE LINE	ML	= MIDDLE LAYER
CANT.	= CANTILEVER	mm	= MILLIMETRE
COL.	= COLUMN	MOM.	= MOMENT
CONC.	= CONCRETE	m	= METRIC METRE
CONSTR.	= CONSTRUCTION	MPa	= MEGAPASCAL
CONT.	= CONTINUOUS	MF	= FACTORED MOMENT
c/w	= COMPLETE WITH	N	= NEWTONS
		N.F.	= NEAR FACE
DET.	= DETAIL	NS	= NORTH-SOUTH
DIAG.	= DIAGONAL	NTS.	= NOT TO SCALE
DIA.	= DIAMETER		
Ø	= DIAMETER, BAR DIAMETER	OWSJ	= OPEN WEB STEEL JOISTS
DIM.	= DIMENSION	OPEN	= OPENING
D.J.	= DOUBLE JOIST		
DO.	= DITTO	PL	= PLATE
D.L.	= DEAD LOAD	PROJ.	= PROJECTION
DWG.	= DRAWING		
DWL.	= DOWEL	R	= REACTION
EA	= EACH	RAD	= RADIUS
EAF.	= EACH FACE	REF.	= REFERENCE
EA.W.	= EACH WAY	REINF.	= REINFORCING REINFORCEMENT
EL	= ELEVATION	REQ'D	= REQUIRED
ELECT.	= ELECTRICAL	REV.	= REVISION/REVISED
ELEV.	= ELEVATOR	rw	= REINFORCED WITH
E.W.	= EAST WEST	SECT.	= SECTION
EQ	= EQUAL	SDF	= STEP DOWN FOOTING
EXIST.	= EXISTING	SL	= SLAB
EXP.J.	= EXPANSION JOINT	SPEC'S.	= SPECIFICATIONS
EXT.	= EXTERIOR	STD.	= STANDARD
		SQ.	= SQUARE
		STRUCT.	= STRUCTURAL
F.F.	= FAR FACE	T	= TOP
FDN.	= FOUNDATION	T.J.	= TIE JOIST
FIN.	= FINISHED	TLL	= TOP LOWER LAYER
FL	= FLOOR	TUL	= TOP UPPER LAYER
FTG.	= FOOTING	TEMP.	= TEMPERATURE
		TYP.	= TYPICAL
GA	= GAUGE	UN	= UNLESS OTHERWISE NOTED
GALV.	= GALVANIZED	US	= UNDERSIDE
GEN.	= GENERAL	Vf	= FACTORED SHEAR FORCE
		V. VERT.	= VERTICAL
H HOR.	= HORIZONTAL	WWF	= WELDED WIRE FABRIC
HH	= HOOKED EACH END	w	= WITH
		w/d, wL	= UNIFORMLY DISTRIBUTED LOADS
INT.	= INTERIOR		
JT.	= JOINT		

REINFORCEMENT DEVELOPMENT LENGTHS			0301
TABLE 1 - TENSION DEVELOPMENT LENGTH (in)			
BAR SIZE	f _c		
	2900psi	3626psi	5077psi
4	12.6	11.8	11.8
5	18.9	16.8	14.6
6	25.2	22.8	19.3
8	39.8	35.4	29.9
9	47.6	42.5	35.9
11	55.5	49.6	41.7
14	71.7	63.8	53.9
18	87.4	78.0	66.1
TABLE 2 - TENSION LAP SPLICE (CLASS B) LENGTH (in)			
BAR SIZE	f _c		
	2900psi	3626psi	5077psi
4	16.5	15.0	12.4
5	24.8	22.0	19.1
6	33.1	29.7	25.2
8	51.8	46.1	39.0
9	61.1	55.3	46.5
11	72.4	64.6	55.3
14			
18	LAP SPLICES NOT PERMITTED		
TABLE 3 - DEVELOPMENT LENGTH FOR STD HOOKS (in)			
BAR SIZE	f _c		
	2900psi	3626psi	5077psi
4	6.1	5.9	5.9
5	9.4	8.3	7.5
6	12.4	11.0	10.2
8	15.4	13.8	12.6
9	18.5	16.5	14.2
11	21.7	19.9	17.7
14	28.5	24.4	23.1
18	49.6	44.4	40.6
TABLE 4 - COMPRESSION DEVELOPMENT LENGTH (in)			
BAR SIZE	f _c		
	2900psi	3626psi	5077psi
4	8.3	7.9	7.9
5	12.6	11.4	10.2
6	16.9	15.0	13.5
8	21.3	18.9	17.3
9	25.2	22.8	20.9
11	29.5	26.4	24.4
14	38.2	33.9	31.1
18	46.5	41.7	38.2
TABLE 5 - COMPRESSION LAP SPLICE LENGTH (in)			
BAR SIZE	USUAL CONFINEMENT		
4	11.8		
5	17.3		
6	22.8		
8	28.7		
9	34.6		
11	40.2		
TABLE 6 - STANDARD HOOK DIMENSION FOR BACK REINFORCING (in)			
BAR SIZE	400R OR 500R		400W OR 500W
	90° HOOK	180° HOOK	90° HOOK
4	7.1	5.5	7.1
5	10.2	7.1	9.8
6	12.2	8.7	11.8
8	15.7	11.0	15.7
9	20.1	15.7	19.3
11	24.0	18.9	23.2
14	31.1	26.8	30.3
18	40.6	35.4	39.8
NOTE: #14 AND #18 BARS SHALL BE SPLICED WITH MECHANICAL CONNECTORS			
REFER TO THE CRS MANUAL OF STANDARD PRACTICE FOR MORE INFORMATION			

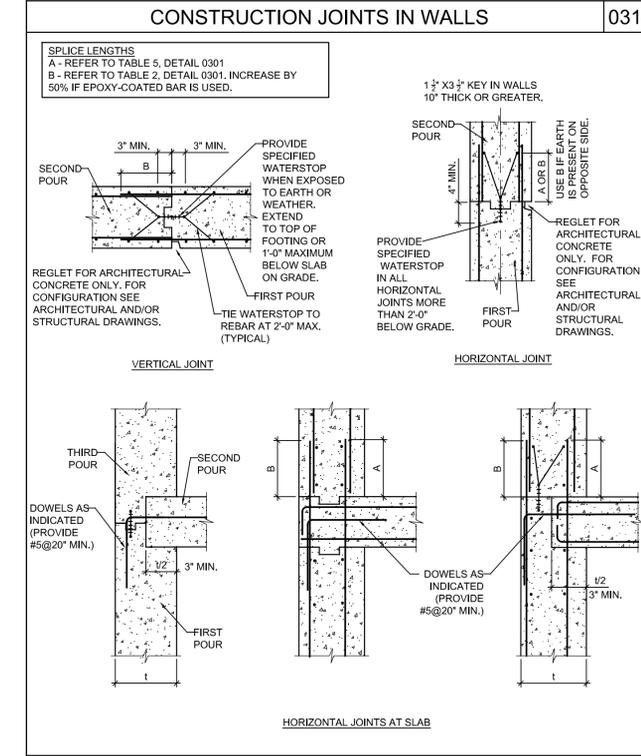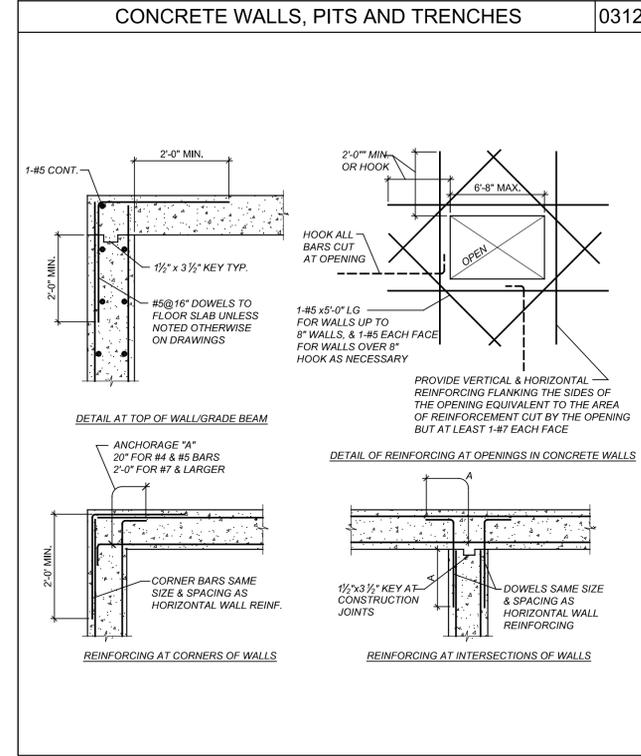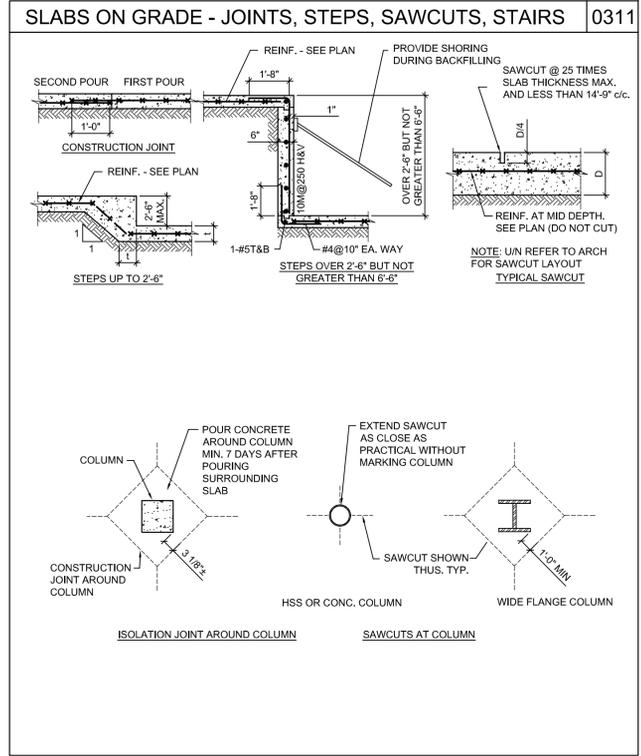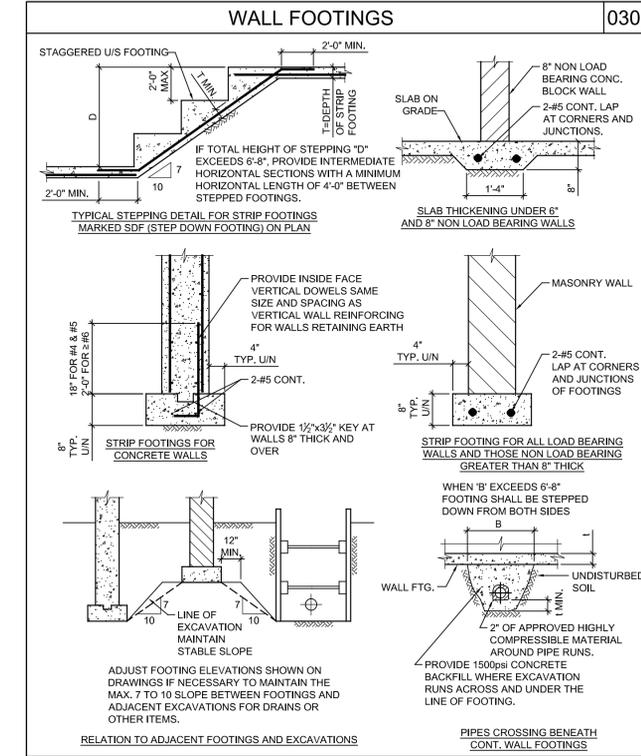

SEAL:

PROJECT NAME:
VILLAGE HOUSE AT LOT 71

PROJECT ADDRESS:
VILLAGE HOUSE LOT 71, SUMMIT POWDER MOUNTAIN

MARK DATE DESCRIPTION

△	2018.08.24	REVISED PERMIT SET
△	2018.06.26	ISSUED FOR PERMIT
△	2018.06.20	ISSUED FOR COORDINATION
△	2018.02.01	ISSUED FOR PERMIT
△	2017.12.13	ISSUED FOR INTERNAL COORD.
△	2017.12.02	ISSUED FOR COORDINATION
△	2017.11.22	ISSUED C GRADE COSTING
△	2017.11.07	INTERNAL COORDINATION

PROJECT NAME:
VILLAGE HOUSE AT LOT 71








PROJECT ADDRESS:
VILLAGE HOUSE LOT 71, SUMMIT POWDER MOUNTAIN

DRAWN: AVB CHECKED: --

SCALE: AS NOTED PROJECT NUMBER: 170450

SHEET TITLE:
TYPICAL DETAILS

S-003

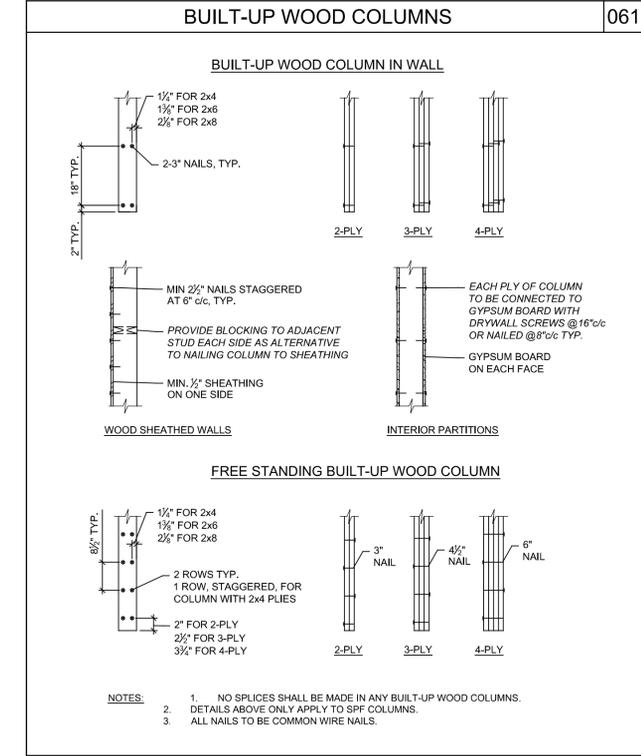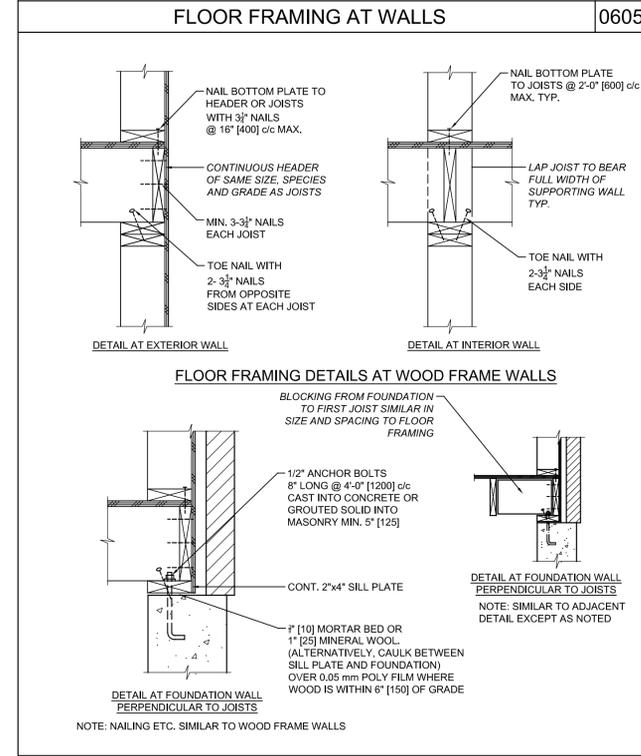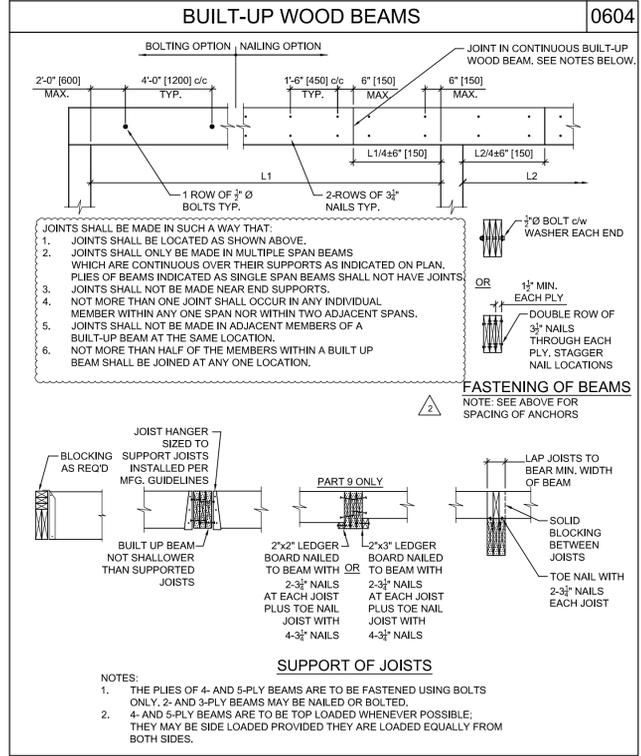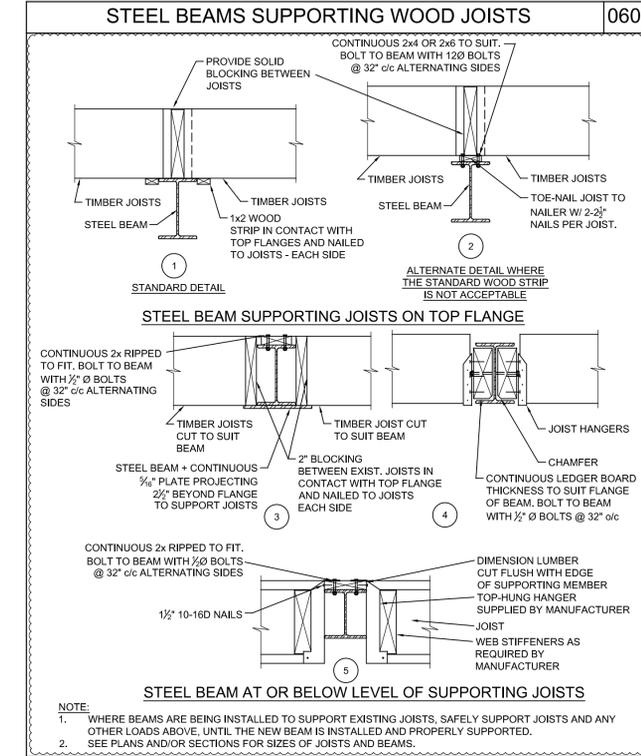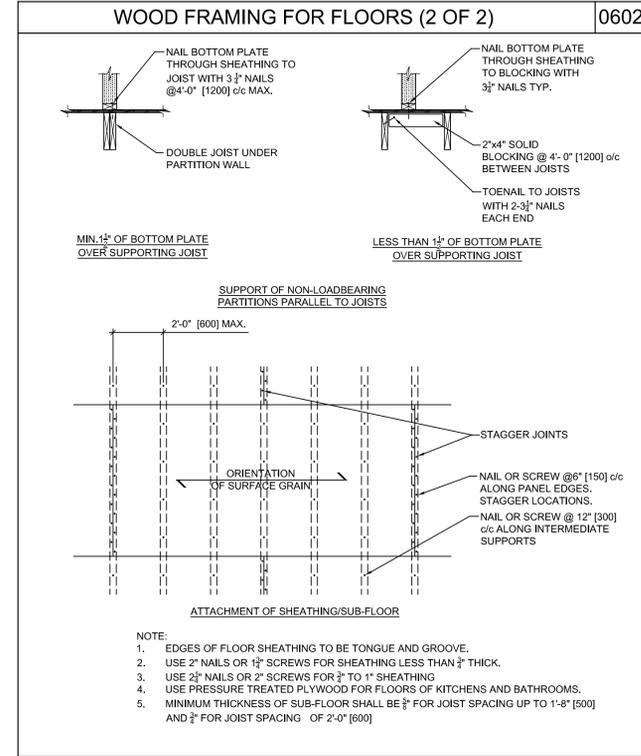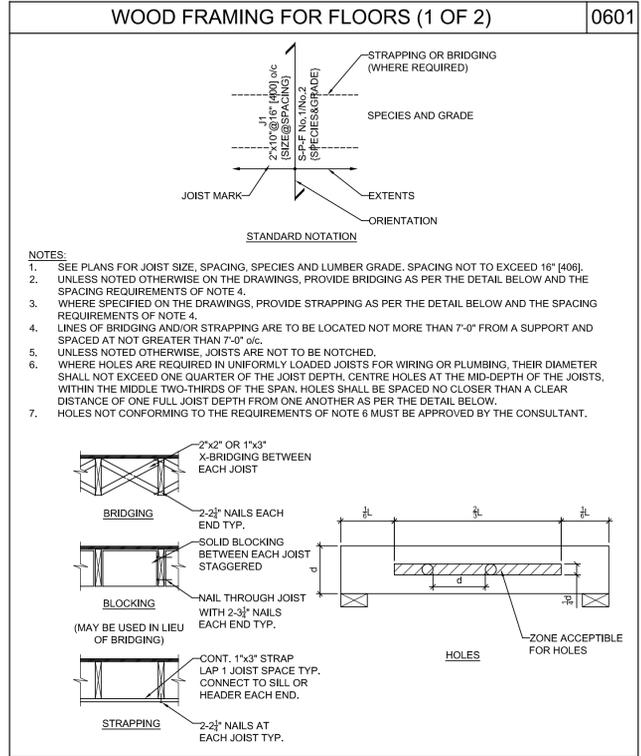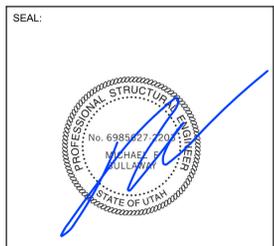

2018.08.24	REVISED PERMIT SET
2018.06.26	ISSUED FOR PERMIT
2018.06.20	ISSUED FOR COORDINATION
2018.02.01	ISSUED FOR PERMIT
2017.12.13	ISSUED FOR INTERNAL COORD.
2017.12.02	ISSUED FOR COORDINATION
2017.11.22	ISSUED C GRADE COSTING
2017.11.07	INTERNAL COORDINATION

PROJECT NAME:
VILLAGE HOUSE AT LOT 71

PROJECT ADDRESS:
VILLAGE HOUSE LOT 71, SUMMIT POWDER MOUNTAIN

DRAWN: AVB	CHECKED: ---
SCALE: AS NOTED	PROJECT NUMBER: 170450

SHEET TITLE:
TYPICAL DETAILS CONT.'D


SEAL:



FOUNDATION MEMBER SCHEDULE		
MEMBER MARK	MEMBER DESCRIPTION	REMARKS
FW10A	10" CONCRETE FOUNDATION WALL	V.I.F #5 @ 18" c/c H.I.F #5 @ 18" c/c ON 10"x26" CONTINUOUS STRIP FOOTING r/w 2 #5 CONTINUOUS BARS. WALL TO BE COMPLETELY BACKFILLED EACH SIDE.
FW10B	10" CONCRETE FOUNDATION WALL	V.I.F #5 @ 18" c/c H.I.F #5 @ 18" c/c ON 10"x26" CONTINUOUS STRIP FOOTING r/w 2 #5 CONTINUOUS BARS.
FW10C	10" CONCRETE FOUNDATION WALL	V.I.F #5 @ 18" c/c H.I.F #5 @ 18" c/c ON 10"x18" CONTINUOUS STRIP FOOTING r/w 2 #5 CONTINUOUS BARS.
FW12A	12" CONCRETE BUTTRESS WALL	V.E.F #5 @ 12" c/c H.I.F #5 @ 18" c/c V.E.F #5 @ 12" c/c HORIZONTAL: #4 TIES REFER TO SECTION.
GB-1	2'-2"Dx2'-2"Wx7'-6" CONCRETE GRADE BEAM	r/w 7 #6 TOP AND BOTTOM BARS #4 TIES @ 4" c/c 4-HP1 AT EACH END, REFER TO SECTION.
GB-2	1'-6"Dx1'-4"W CONCRETE GRADE BEAM	r/w 5 #6 TOP AND BOTTOM BARS #3 TIES @ 8" c/c HP1 SPACING PER PLAN
FTG1	4'-0"x10'-0"x1'-4" CONCRETE PAD FOOTING	r/w 5 #6 BARS LONG DIRECTION EACH FACE 8 #6 BARS SHORT DIRECTION EACH FACE
FTG2	3'-0"x3'-0"x0'-10" CONCRETE PAD FOOTING	r/w 5 #5 BARS LONG DIRECTION BOTTOM 5 #5 BARS SHORT DIRECTION BOTTOM
SF1	20"x10" CONT. STRIP FOOTING	r/w 2 #5 CONTINUOUS
P1	16"x16" CONCRETE PIER (MIN. DIMENSIONS)	r/w 8 #5 VERTICALS AND #4 TIES @ 10" c/c. PROVIDE #3 HOOKED DOWELS TO FOOTING
P2	16"x16" CONCRETE PIER (MIN. DIMENSIONS)	r/w 12 #5 VERTICALS AND #4 TIES @ 10" c/c. PROVIDE #3 HOOKED DOWELS TO FOOTING
HP1	HELICAL PILE	EACH PIER RATED FOR 20 KIPS C/T (LFRD)

NOTES:

- AT A MINIMUM PROVIDE DOWELS FROM STRIP FOOTING TO WALLS ABOVE MATCHING VERTICAL BARS FROM WALL ABOVE.

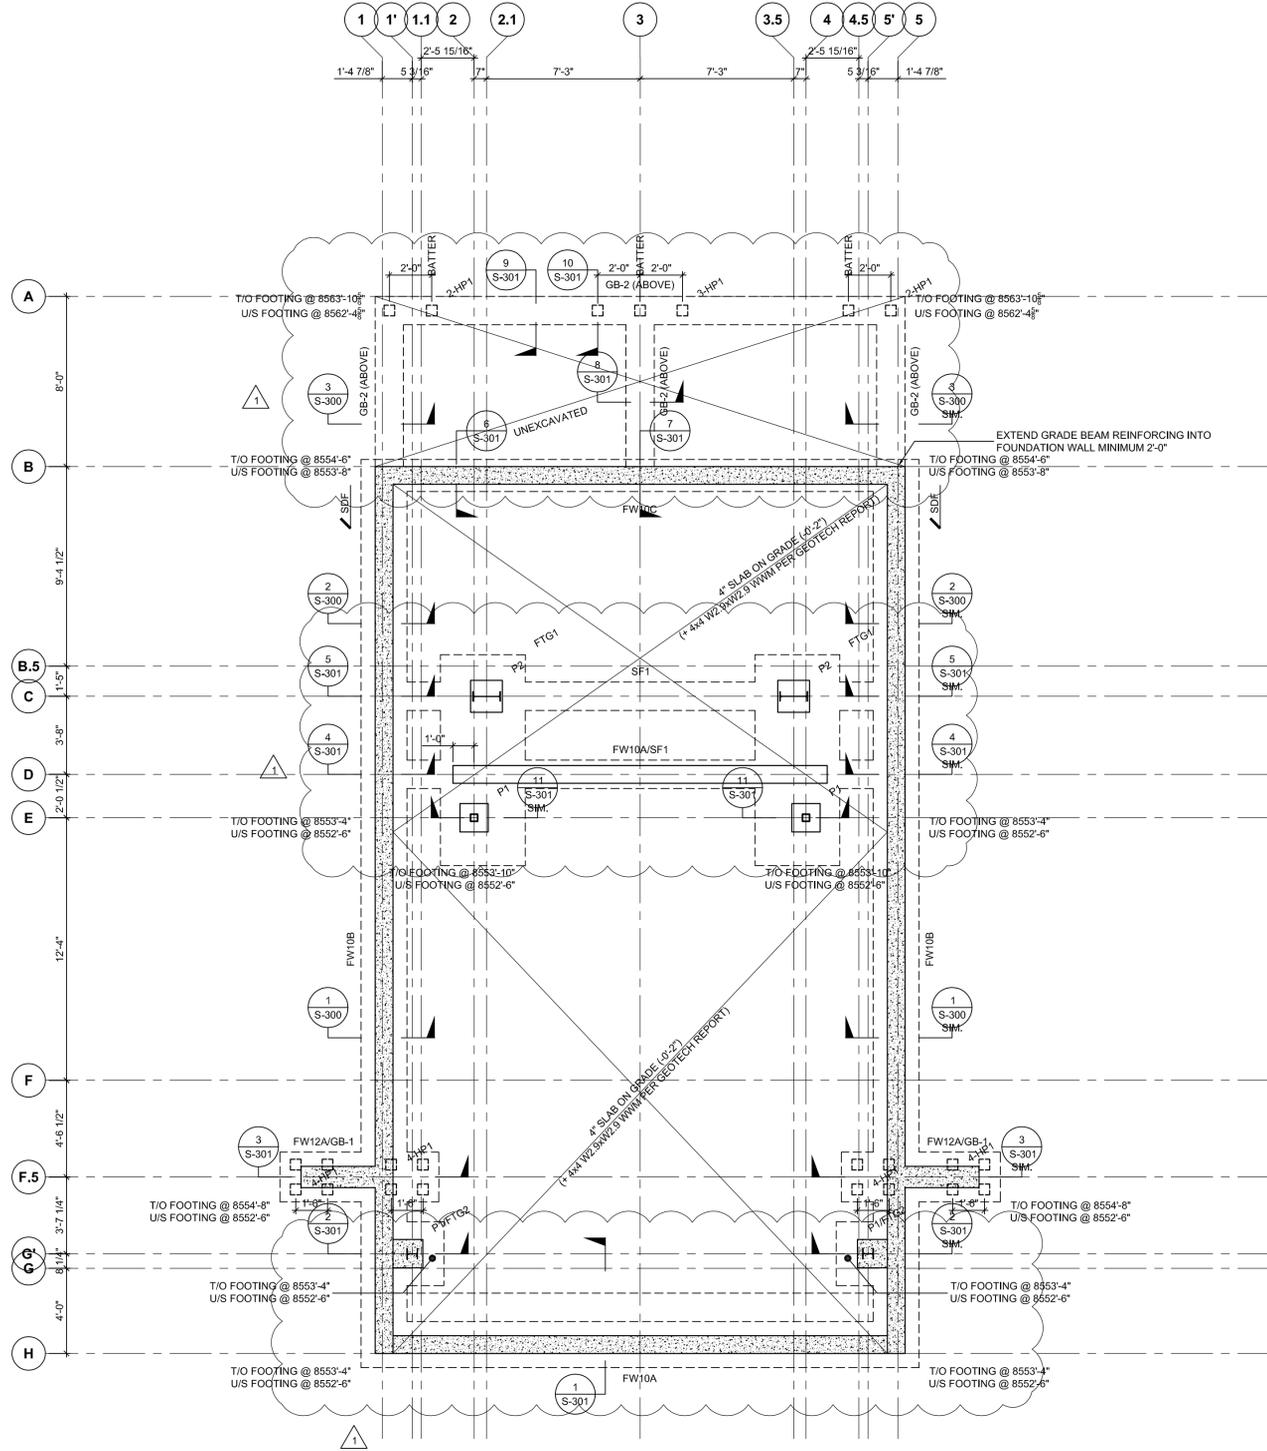

1 FOUNDATION PLAN
S-100 1/4" = 1'-0"

NOTES:

- A GEOTECHNICAL REPORT HAS BEEN PREPARED BY IGES INC. "GEOTECHNICAL AND GEOLOGIC HAZARD INVESTIGATION LOT 71R OF SUMMIT EDEN PHASE 1C 8488 E. SPRING PARK ROAD SUMMIT POWDER MOUNTAIN." CONTRACTOR IS TO READ THE REPORT AND BECOME FAMILIAR WITH ITS CONTENTS.
- SHALLOW FOUNDATIONS HAVE BEEN DESIGNED WITH AN ALLOWABLE BEARING CAPACITY OF 2,900psf FOR DEAD AND LIVE LOADS. 1/2 INCREASE FOR SEISMIC AND WIND.
- NO FOOTINGS ARE TO BE CAST WITHOUT PRIOR APPROVAL FROM THE GEOTECHNICAL CONSULTANT.
- ASSUMED SPOT ELEVATIONS OF FOOTINGS ARE GIVEN AS UNDERSIDE OF FOOTING AND ARE RELATIVE FINISHED FLOOR OF (0'-0" & GEODETIC EL. 8555'-6"). US OF FOOTINGS MAY BE REQUIRED TO VARY BASED ON COMMENTS FROM IGES FOLLOWING EXCAVATION.
- REFER TO GENERAL NOTES AND TYPICAL DETAILS FOR ADDITIONAL INFORMATION.

MARK	DATE	DESCRIPTION
△	2018.08.24	REVISED PERMIT SET
△	2018.06.26	ISSUED FOR PERMIT
	2018.06.20	ISSUED FOR COORDINATION
	2018.02.01	ISSUED FOR PERMIT
	2017.12.13	ISSUED FOR INTERNAL COORD.
	2017.12.02	ISSUED FOR COORDINATION
	2017.11.22	ISSUED C GRADE COSTING
	2017.11.07	INTERNAL COORDINATION

PROJECT NAME:
VILLAGE HOUSE AT LOT 71


PROJECT ADDRESS:
VILLAGE HOUSE LOT 71, SUMMIT POWDER MOUNTAIN

DRAWN:
AVB
SCALE:
AS NOTED

CHECKED:
—
PROJECT NUMBER:
170450

SHEET TITLE:
FOUNDATION PLAN

SEAL:

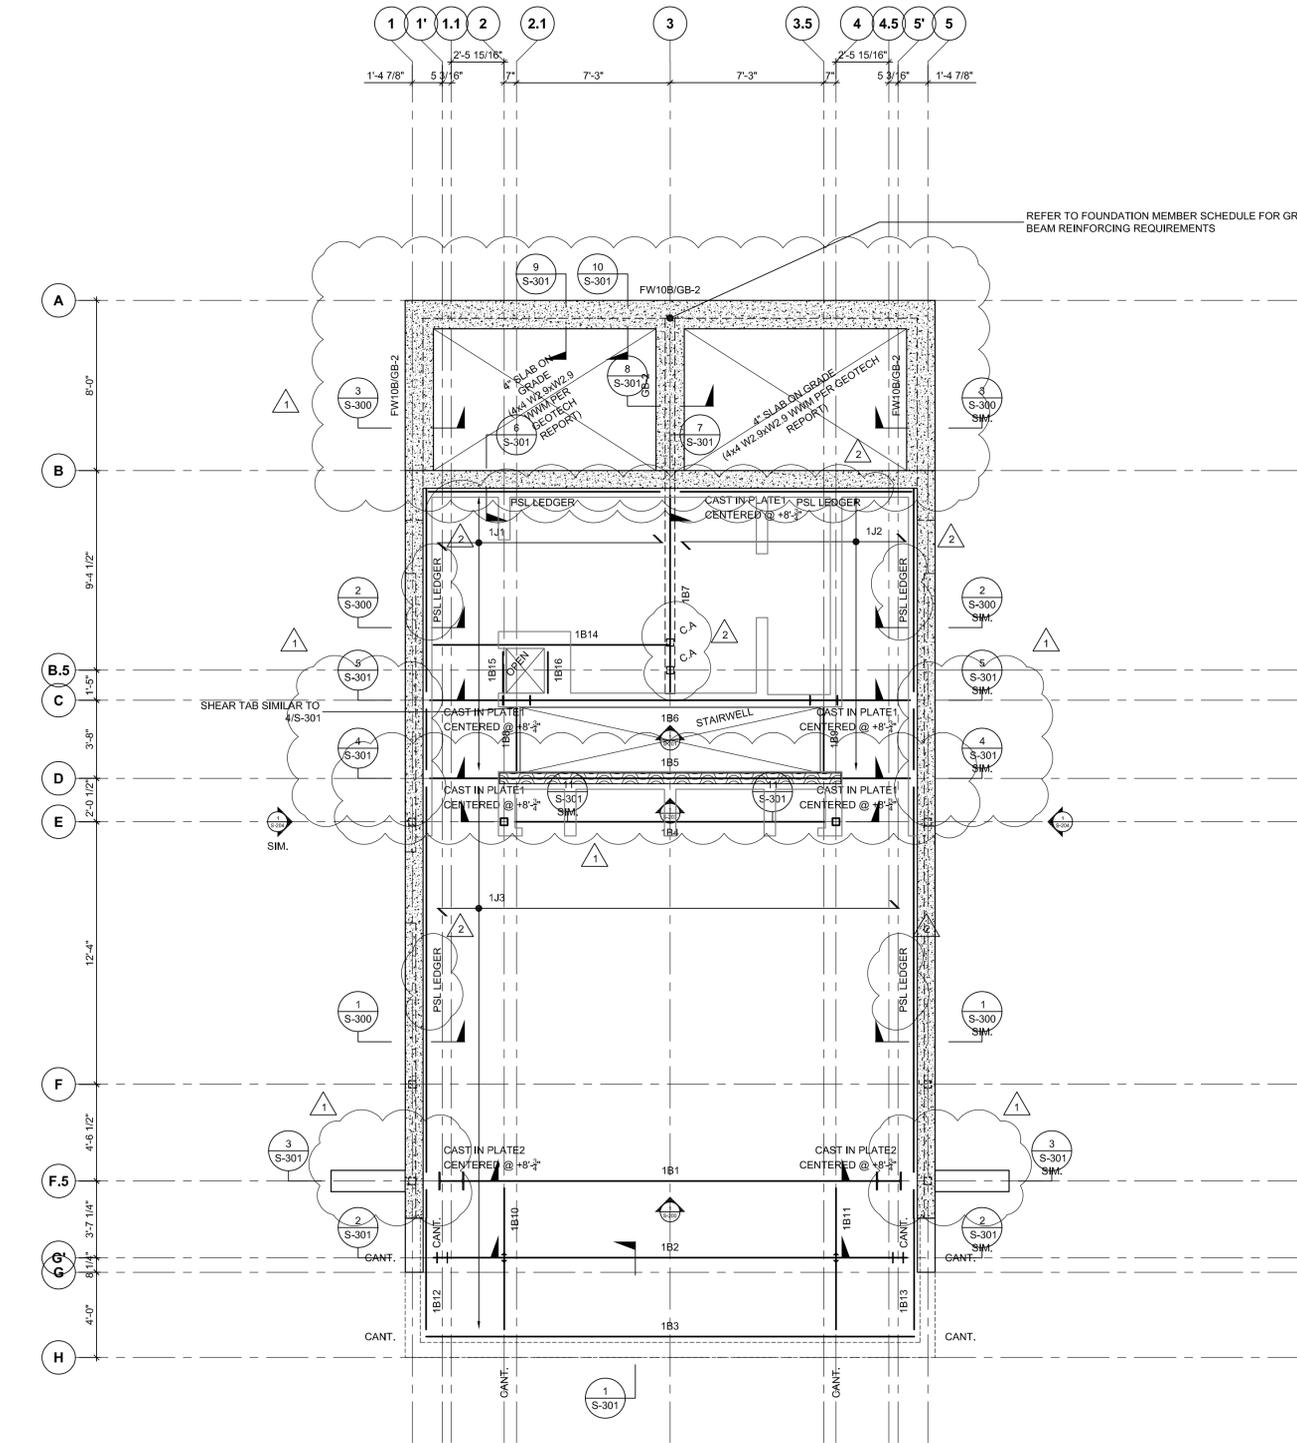

1 GARAGE LEVEL SHOWING LEVEL 2 FRAMING
S-101 1/4" = 1'-0"

1. MAIN FLOOR DATUM IS LOCATED (8'-11 1/4") ABOVE PROJECT 0'-0"
2. TOP OF SHEATHING IS AT (-0'-2") BELOW FINISH
3. WHERE CROSSEED AND NOTED SHEATHING ELEVATION IS GIVEN RELATIVE TO THE DATUM
4. LOADS USED IN DESIGN: DEAD: 40psf (INTERIOR SPACE + 1 1/2" LIGHTWEIGHT GYPCRETE)
SNOW: N/A
LIVE: 40psf
5. ALL SHEATHING TO BE 3/4" T&G APPLIED DIRECTLY TO THE JOISTS
6. TYPICAL SUBFLOOR NAILING SHALL BE 10d NAILS @ 6" c/c @ ALL SUPPORTED EDGES
7. OVER SFRS BEAMS NAILING SPACING TO BE 2" ROWS OF 10d BOX NAILS @ 2" c/c TO NAILER PLATE.
8. REFER TO GENERAL NOTES AND TYPICAL DETAILS FOR ADDITIONAL INFORMATION.

LEVEL 2 MEMBER SCHEDULE				
MEMBER MARK	MEMBER DESCRIPTION	REACTIONS		REMARKS
		LEFT	RIGHT	
1J1	14" REDBUILT RED I-45 @16" c/c	1.0	1.0	SOLID BLOCKING @ 8'-0" c/c MAX
1J2	14" REDBUILT RED I-45 @16" c/c	1.0	1.0	SOLID BLOCKING @ 8'-0" c/c MAX
1J3	14" REDBUILT RED I-65 @12" c/c	1.0	1.0	SOLID BLOCKING @ 8'-0" c/c MAX
1B1 (SFRS)	W12x72	Vf = 23.0 (8)	Vf = 23.0 (8)	TOP PLATE NAILER. CHORD MEMBER. CONNECTION TO CAST IN PLATE
1B2	W12x30	Vf = 29.0 (13)	Vf = 29.0 (13)	WEB PACK OUT + TOP PLATE NAILER. BLOCKING @ 4'-0" c/c EACH SIDE.
1B3	W12x26	Vf = 9.0 (1)	Vf = 9.0 (1)	WEB PACK OUT + TOP PLATE NAILER
1B4	W8x18	Vf = 1.5 (8)	Vf = 1.5 (8)	TOP PLATE NAILER
1B5 (SFRS)	2 - 1 1/2" x 14" LVL	1.5	1.5	CHORD
1B6 (SFRS)	W12x35	Vf = 12.5 (8)	Vf = 12.5 (8)	TOP PLATE NAILER. CONNECTION TO CAST IN PLATE. CHORD
1B7	W12x26	Vf = 20.0 (1)	Vf = 20.0 (8)	TOP PLATE NAILER. CONNECTION TO CAST IN PLATE AT NORTH END.
1B8	2 - 1 1/2" x 14" LVL	1.5	1.5	
1B9	2 - 1 1/2" x 14" LVL	1.5	1.5	
1B10	W12x30	Vf = 28.0 (7) Mf = 49.5 (7)	Vf = 13.0 (1)	TOP PLATE NAILER.
1B11	W12x30	Vf = 28.0 (7) Mf = 49.5 (7)	Vf = 13.0 (1)	TOP PLATE NAILER.
1B12	W12x26	Vf = 2.0 (1)	Vf = 2.0 (1)	WEB PACK OUT + TOP PLATE NAILER
1B13	W12x26	Vf = 2.0 (1)	Vf = 2.0 (1)	WEB PACK OUT + TOP PLATE NAILER
1B14	2 - 1 1/2" x 14" LVL	1.0	1.0	
1B15	2 - 1 1/2" x 14" LVL	1.0	1.0	
1B16	2 - 1 1/2" x 14" LVL	1.0	1.0	
PSL LEDGER (SFRS)	1 3/4" x 14" PARALLAM PSL PLUS	BENT PLATE WITH 3/4" THREADED ROD @ 24" c/c FROM BENT PLATE TO FOUNDATION WALL. INSTALL SILLGASKET BETWEEN FDN WALL AND PLATE. FASTEN LEDGER TO PLATE WITH TBS WOOD-TO-STEEL SCREWS @ 8" c/c. REFER TO 3/S-300		

- NOTES:
1. ALL WOOD CONNECTORS ARE TO BE BY SIMPSON STRONG TIE. PROVIDE CONSULTANT WITH FULL SPEC. OF ALL ALTERNATE HANGERS FOR APPROVAL PRIOR TO USE.
 2. ALL LOADS HAVE BEEN FACTORED IN ACCORDANCE WITH IBC 2015 LOAD CASES (LRFD)
 3. LEFT AND RIGHT BEAM REACTIONS ORIENTATED WITH THE MEMBER LABEL ON PLAN.
 4. ALL FASTENERS (i.e. NAILS, SCREWS, ANCHOR BOLTS, ETC.) WHICH ARE TO BE INSTALLED IN PRESERVATIVE TREATED WOOD (i.e. SILL PLATES) SHALL MEET THE REQUIREMENTS OF IBC 2304.10.5.1
 5. FOR STEEL BEAMS, REFER TO S-203 FOR CONNECTION DETAILING


2018.08.24	REVISED PERMIT SET
2018.06.26	ISSUED FOR PERMIT
2018.06.20	ISSUED FOR COORDINATION
2018.02.01	ISSUED FOR PERMIT
2017.12.13	ISSUED FOR INTERNAL COORD.
2017.12.02	ISSUED FOR COORDINATION
2017.11.22	ISSUED C GRADE COSTING
2017.11.07	INTERNAL COORDINATION

PROJECT NAME:
VILLAGE HOUSE AT LOT 71

PROJECT ADDRESS:
VILLAGE HOUSE LOT 71, SUMMIT POWDER MOUNTAIN

DRAWN: AVB	CHECKED: —
SCALE: AS NOTED	PROJECT NUMBER: 170450

SHEET TITLE:
LEVEL 2 FRAMING PLAN

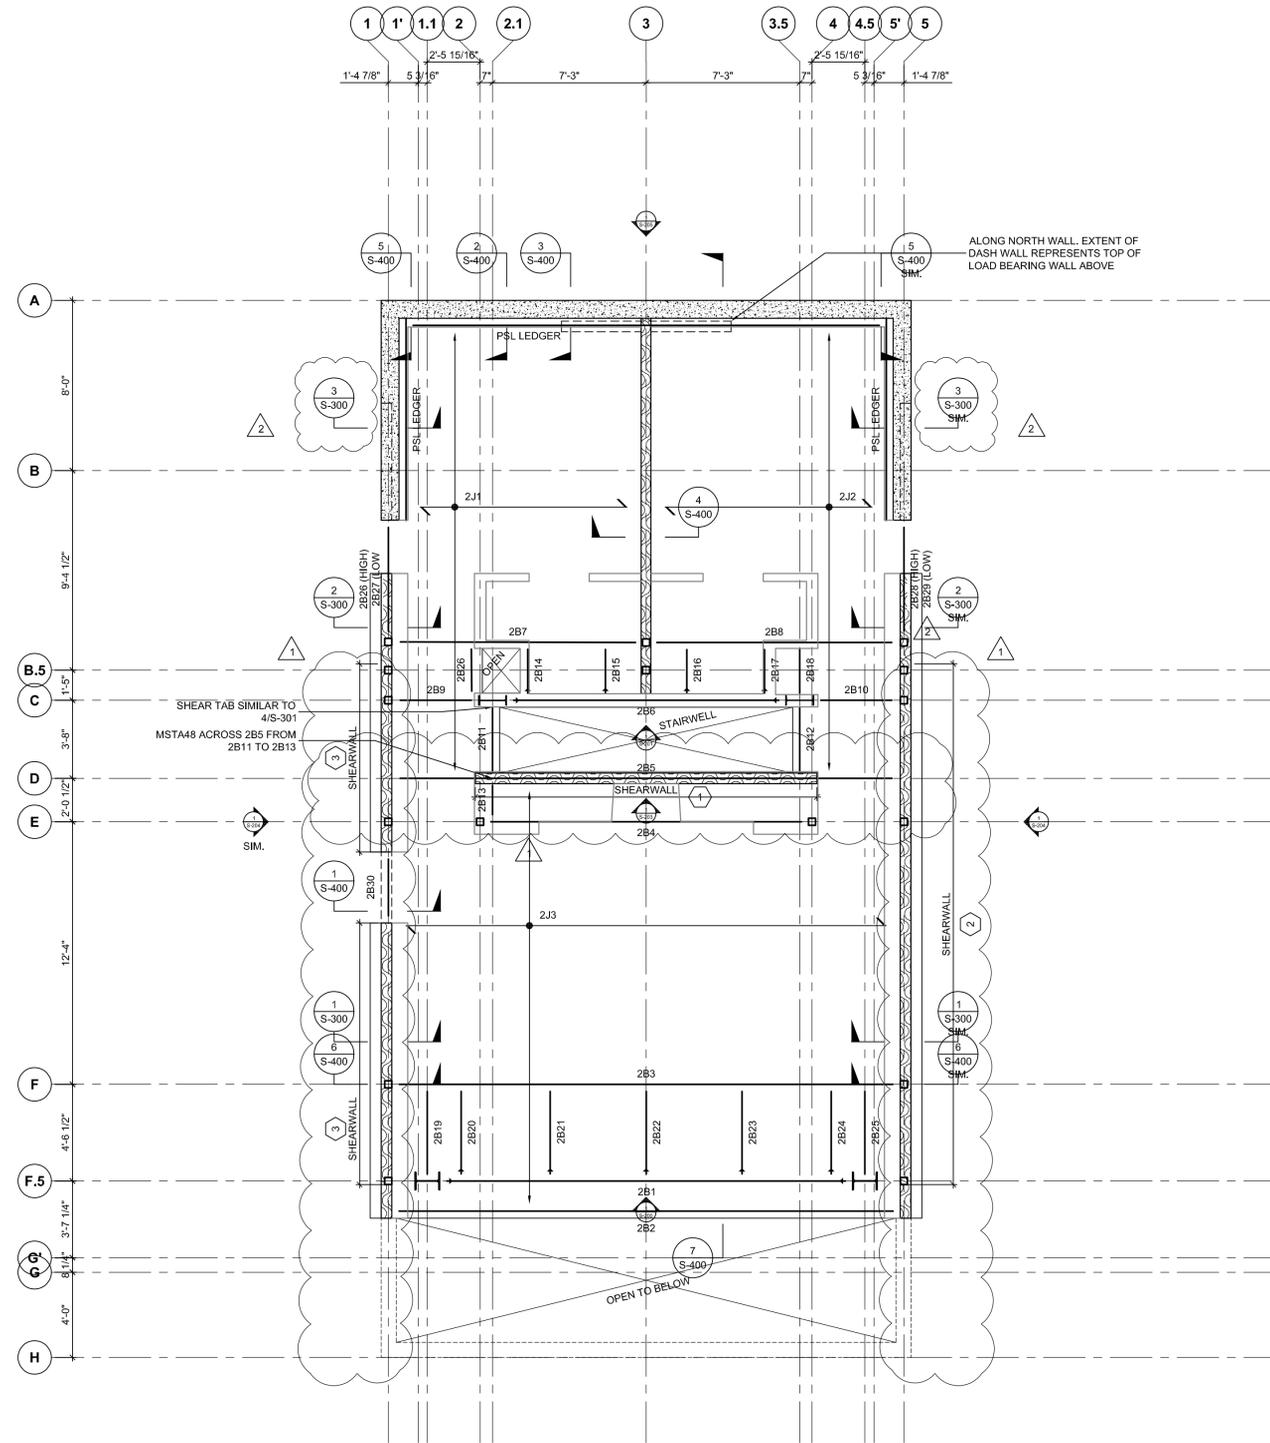

1 LEVEL 2 SHOWING LEVEL 3 FLOOR FRAMING
S-102 1/4" = 1'-0"

1. SECOND FLOOR DATUM IS LOCATED (+18'-4 1/2") ABOVE PROJECT 0'-0"
2. TOP OF SHEATHING IS AT (-0'-2") BELOW FINISH
3. WHERE CROSSEED AND NOTED SHEATHING ELEVATION IS GIVEN RELATIVE TO THE DATUM
4. LOADS USED IN DESIGN: DEAD: 40psf (INTERIOR SPACE + 1 1/2" LIGHTWEIGHT GYPCRETE)
SNOW: N/A
LIVE: 40psf
5. ALL SHEATHING TO BE 3/4" T&G APPLIED DIRECTLY TO THE JOISTS.
6. TYPICAL NAILING SHALL BE 10d NAILS @ 8" c/c @ ALL SUPPORTED EDGES. 12" c/c @ ALL INTERMEDIATE SUPPORT UNLESS OTHERWISE NOTED.
7. OVER SMF NAILING SPACING TO BE 2" c/c TO NAILER PLATE.
8. REFER TO GENERAL NOTES AND TYPICAL DETAILS FOR ADDITIONAL INFORMATION.

LEVEL 3 MEMBER SCHEDULE

MEMBER MARK	MEMBER DESCRIPTION	REACTIONS		REMARKS
		LEFT	RIGHT	
2J1	14" REDBUILT RED I-45 @16" c/c	1.0	1.0	SOLID BLOCKING @ 8'-0" c/c MAX
2J2	14" REDBUILT RED I-45 @16" c/c	1.0	1.0	SOLID BLOCKING @ 8'-0" c/c MAX
2J3	14" REDBUILT RED I-65 @12" c/c	1.0	1.0	SOLID BLOCKING @ 8'-0" c/c MAX
2B1 (SFRS)	W10x26	Vf = 27.5 Mf = 81.5	Vf = 27.5 Mf = 81.5	RBS-SMF REFER TO STEEL ELEVATIONS TOP PLATE NAILER
2B2	2 - 1 1/2" x 14" LVL	4.0	4.0	
2B3	W10x26	Vf = 4.0	Vf = 4.0	TOP PLATE NAILER
2B4	W8x18	Vf = 1.5	Vf = 1.5	TOP PLATE NAILER
2B5 (SFRS)	2 - 1 1/2" x 14" LVL	1.5	1.5	CHORD
2B6 (SFRS)	W14x22	Vf = 5.0 Mf = 33.0	Vf = 5.0 Mf = 33.0	RBS-SMF REFER TO STEEL ELEVATIONS TOP PLATE NAILER
2B7	W10x22	Vf = 1.5	Vf = 1.5	TOP PLATE NAILER
2B8	W10x22	Vf = 1.5	Vf = 1.5	TOP PLATE NAILER
2B9 (SFRS)	W8x18	Vf = 1.5	Vf = 1.5	TOP PLATE NAILER (CHORD)
2B10 (SFRS)	W8x18	Vf = 1.5	Vf = 1.5	TOP PLATE NAILER (CHORD)
2B11	2 - 1 1/2" x 14" LVL	1.5	1.5	
2B12	2 - 1 1/2" x 14" LVL	1.5	1.5	
2B13	2 - 1 1/2" x 14" LVL	1.5	1.5	
2B14	W10x22	Vf = 1.5 Mf = 9.5	Vf = 1.5	TORSION BRACE TOP PLATE NAILER
2B15	W10x22	Vf = 1.5 Mf = 9.5	Vf = 1.5	TORSION BRACE TOP PLATE NAILER
2B16	W10x22	Vf = 1.5 Mf = 9.5	Vf = 1.5	TORSION BRACE TOP PLATE NAILER
2B17	W10x22	Vf = 1.5 Mf = 9.5	Vf = 1.5	TORSION BRACE TOP PLATE NAILER
2B18	W10x22	Vf = 1.5	Vf = 1.5	TOP PLATE NAILER
2B19	W10x22	Vf = 1.5	Vf = 1.5	TOP PLATE NAILER
2B20	W10x22	Vf = 1.5 Mf = 14.5	Vf = 1.5	TORSION BRACE TOP PLATE NAILER
2B21	W10x22	Vf = 1.5 Mf = 14.5	Vf = 1.5	TORSION BRACE TOP PLATE NAILER
2B22	W10x22	Vf = 1.5 Mf = 14.5	Vf = 1.5	TORSION BRACE TOP PLATE NAILER
2B23	W10x22	Vf = 1.5 Mf = 14.5	Vf = 1.5	TORSION BRACE TOP PLATE NAILER
2B24	W10x22	Vf = 1.5 Mf = 14.5	Vf = 1.5	TORSION BRACE TOP PLATE NAILER
2B25	W10x22	Vf = 1.5	Vf = 1.5	TOP PLATE NAILER
2B26	2 - 1 1/2" x 14" LVL	0.5	0.5	
2B27	1 - 1 1/2" x 14" LVL + RIM	0.5	1.0	
2B28	2 - 1 1/2" x 14" LVL	0.5	0.5	
2B29	1 - 1 1/2" x 14" LVL + RIM	0.5	1.0	
2B30	2 - 1 1/2" x 14" LVL	1.0	1.0	
PSL LEDGER (SFRS)	1 3/4" x 14" PARALLAM PSL PLUS	BENT PLATE WITH 3/4" THREADED ROD @ 24" c/c FROM BENT PLATE TO FOUNDATION WALL. INSTALL SILLGASKET BETWEEN FDN WALL AND PLATE. FASTEN LEDGER TO PLATE WITH TBS WOOD-TO-STEEL SCREWS @ 8" c/c. REFER TO 3/S-300		

- NOTES:
1. ALL WOOD CONNECTORS ARE TO BE BY SIMPSON STRONG TIE. PROVIDE CONSULTANT WITH FULL SPEC. OF ALL ALTERNATE HANGERS FOR APPROVAL PRIOR TO USE.
 2. ALL LOADS HAVE BEEN FACTORED IN ACCORDANCE WITH IBC 2015 LOAD CASES (LRFD)
 3. LEFT AND RIGHT BEAM REACTIONS ORIENTATED WITH THE MEMBER LABEL ON PLAN.
 4. ALL FASTENERS (i.e. NAILS, SCREWS, ANCHOR BOLTS, ETC.) WHICH ARE TO BE INSTALLED IN PRESERVATIVE TREATED WOOD (i.e. SILL PLATES) SHALL MEET THE REQUIREMENTS OF IBC 2304.10.5.1.
 5. FOR STEEL BEAMS, REFER TO S-203 FOR CONNECTION DETAILING

MARK	DATE	DESCRIPTION
△	2018.08.24	REVISED PERMIT SET
△	2018.06.26	ISSUED FOR PERMIT
△	2018.06.20	ISSUED FOR COORDINATION
△	2018.02.01	ISSUED FOR PERMIT
△	2017.12.13	ISSUED FOR INTERNAL COORD.
△	2017.12.02	ISSUED FOR COORDINATION
△	2017.11.22	ISSUED C GRADE COSTING
△	2017.11.07	INTERNAL COORDINATION


PROJECT NAME:
VILLAGE HOUSE AT LOT 71

PROJECT ADDRESS:
VILLAGE HOUSE LOT 71, SUMMIT POWDER MOUNTAIN

DRAWN: AVB	CHECKED: —
SCALE: AS NOTED	PROJECT NUMBER: 170450

SHEET TITLE:
LEVEL 3 FRAMING PLAN

SEAL:

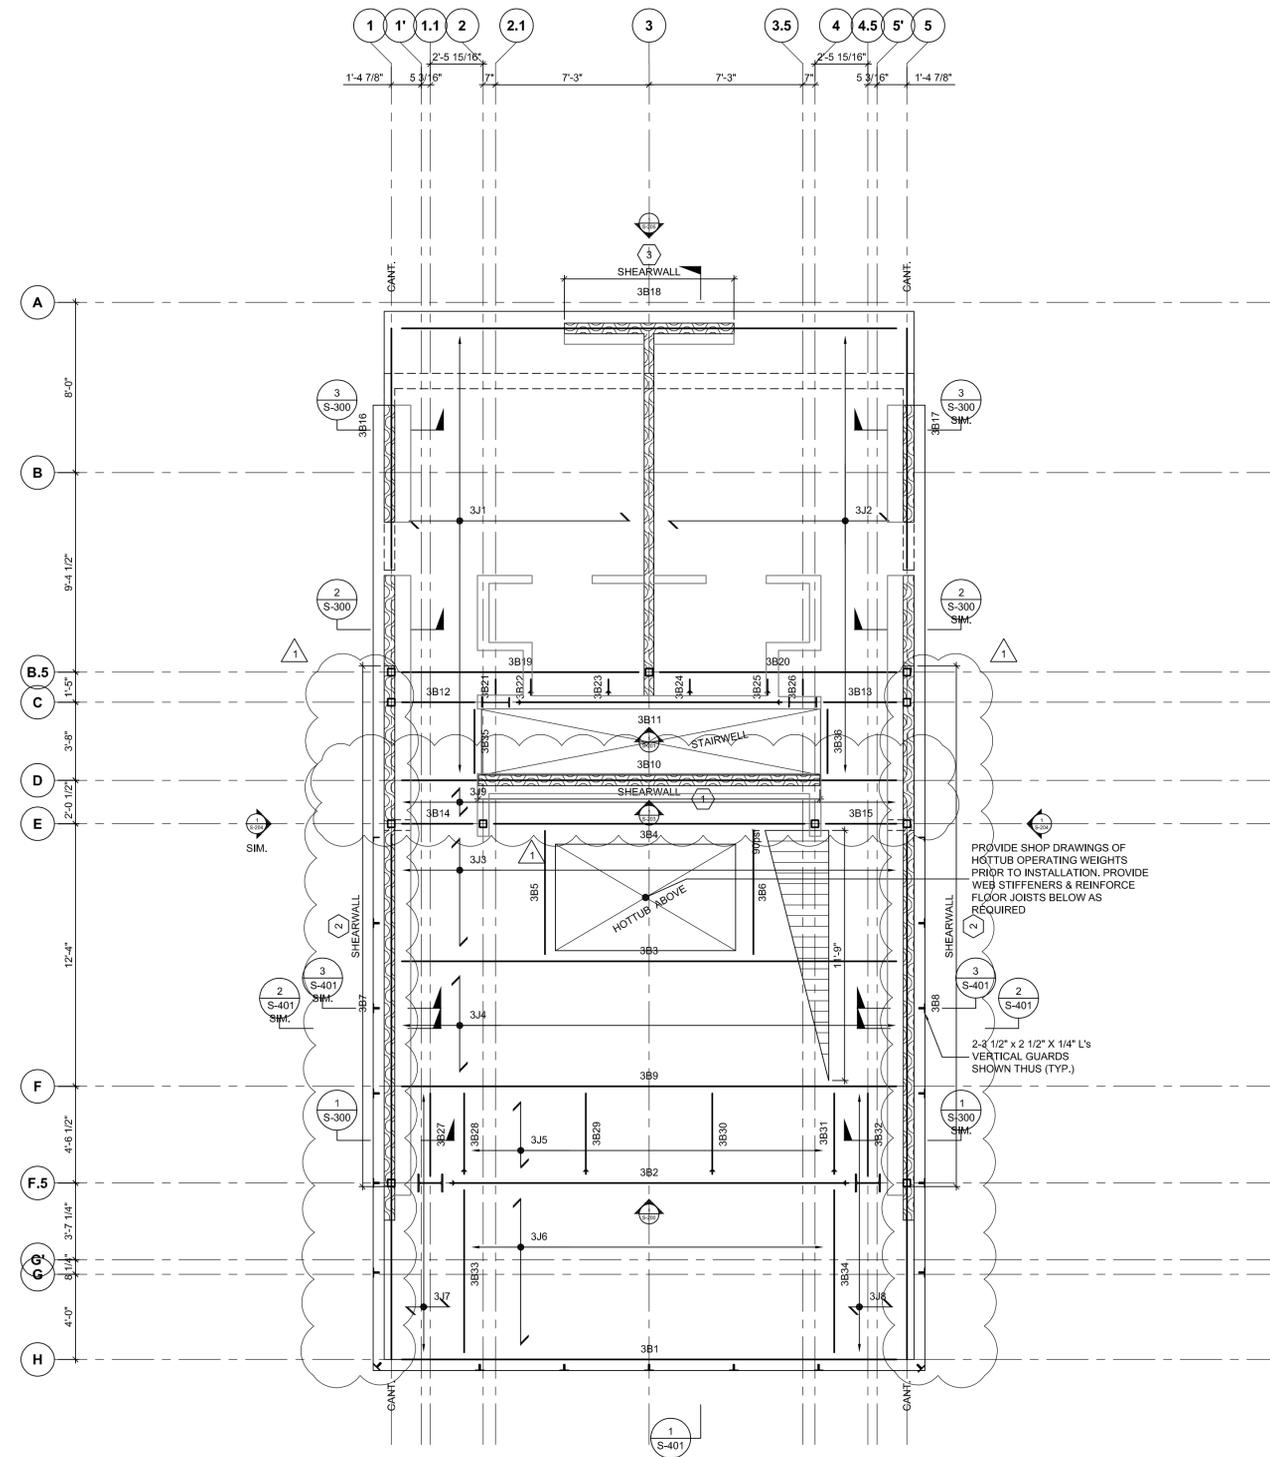

1 LEVEL 3 SHOWING LEVEL 4 FRAMING
S-103 1/4" = 1'-0"

- TERRACE DATUM IS LOCATED (28'-10 1/2") ABOVE PROJECT 0'-0"
- TOP OF SHEATHING IS AT (-0'-2") BELOW THE DATUM.
- WHERE CROSSEED AND NOTED SHEATHING ELEVATION IS GIVEN RELATIVE TO THE DATUM
- LOADS USED IN DESIGN: DEAD: 40psf (INTERIOR SPACE + 1 1/2" LIGHTWEIGHT GYPCRETE)
45psf (EXTERIOR TERRACE - SLOPED INSULATION)
SNOW: 192psf
LIVE: 40psf
- ALL SHEATHING TO BE 3/4" T&G APPLIED DIRECTLY TO THE JOISTS.
- TYPICAL NAILING SHALL BE 10d NAILS @ 6" c/c @ ALL SUPPORTED EDGES AND OVER SHEARWALLS. 12" c/c @ ALL INTERMEDIATE SUPPORT UNLESS OTHERWISE NOTED.
- OVER SMF NAILING SPACING TO BE 2" c/c TO NAILER PLATE.
- REFER TO GENERAL NOTES AND TYPICAL DETAILS FOR ADDITIONAL INFORMATION.

LEVEL 4 MEMBER SCHEDULE				
MEMBER MARK	MEMBER DESCRIPTION	REACTIONS		REMARKS
		LEFT	RIGHT	
3J1	11 7/8" REDBUILT RED I-45 @ 16" c/c	1.0	1.0	SOLID BLOCKING @ 8'-0" c/c MAX
3J2	11 7/8" REDBUILT RED I-45 @ 16" c/c	1.0	1.0	SOLID BLOCKING @ 8'-0" c/c MAX
3J3	11 7/8" REDBUILT RED I-45 @ 16" c/c	1.5	1.5	SOLID BLOCKING @ 8'-0" c/c MAX
3J4	11 7/8" REDBUILT RED I-45 @ 16" c/c	1.0	1.0	SOLID BLOCKING @ 8'-0" c/c MAX
3J5	11 7/8" REDBUILT RED I-45 @ 16" c/c	1.0	1.0	SOLID BLOCKING @ 8'-0" c/c MAX
3J6	11 7/8" REDBUILT RED I-45 @ 16" c/c	2.0	2.0	SOLID BLOCKING @ 8'-0" c/c MAX
3J7	11 7/8" REDBUILT RED I-45 @ 16" c/c	1.0	1.0	SOLID BLOCKING @ 8'-0" c/c MAX
3J8	11 7/8" REDBUILT RED I-45 @ 16" c/c	1.0	1.0	SOLID BLOCKING @ 8'-0" c/c MAX
3J9	11 7/8" REDBUILT RED I-45 @ 16" c/c	1.0	1.0	SOLID BLOCKING @ 8'-0" c/c MAX
3B1	W16x36	Vf = 18.0 (1)	Vf = 18.0 (1)	WEB PACK OUT + TOP PLATE NAILER
3B2 (SFRS)	W12x35	Vf = 27.5 (11) Mf = 81.5	Vf = 27.5 (11) Mf = 81.5	RBS-SMF REFER TO STEEL ELEVATIONS WEB PACK OUT + TOP PLATE NAILER
3B3	W16x45	Vf = 33.0 (1)	Vf = 33.0 (1)	WEB PACK OUT + TOP PLATE NAILER. FULL HEIGHT STIFFENER AT GIRDER.
3B4	W8x48	Vf = 18.0 (8)	Vf = 18.0 (8)	WEB PACK OUT + TOP PLATE NAILER
3B5	W8x18	Vf = 2.0 (1)	Vf = 2.0 (1)	WEB PACK OUT + TOP PLATE NAILER
3B6	W8x18	Vf = 2.0 (1)	Vf = 2.0 (1)	WEB PACK OUT + TOP PLATE NAILER
3B7 (SFRS)	W16x36	Vf = 64.5 (13)	Vf = 20 (13)	WEB PACK OUT + TOP PLATE NAILER. CHORD MEMBER
3B8 (SFRS)	W16x36	Vf = 64.5 (13)	Vf = 20 (13)	WEB PACK OUT + TOP PLATE NAILER. CHORD MEMBER
3B9	W16x45	Vf = 24.0 (1)	Vf = 24.0 (1)	WEB PACK OUT + TOP PLATE NAILER. FULL HEIGHT STIFFENER AT GIRDER.
3B10 (SFRS)	2 - 1 1/2" x 14" LVL	1.5	1.5	CHORD
3B11 (SFRS)	W14x22	Vf = 5.5 (11) Mf = 35.0	Vf = 5.5 (11) Mf = 35.0	RBS-SMF REFER TO STEEL ELEVATIONS TOP PLATE NAILER
3B12 (SFRS)	W18x18	Vf = 1.5 (8)	Vf = 1.5 (8)	TOP PLATE NAILER. CHORD
3B13 (SFRS)	W8x18	Vf = 1.5 (8)	Vf = 1.5 (8)	TOP PLATE NAILER. CHORD
3B14	W8x18	Vf = 1.5 (8)	Vf = 1.5 (8)	WEB PACK OUT + TOP PLATE NAILER
3B15	W8x18	Vf = 1.5 (8)	Vf = 1.5 (8)	WEB PACK OUT + TOP PLATE NAILER
3B16	3 - 1 1/2" x 14" LVL	4.0	16.0	
3B17	3 - 1 1/2" x 14" LVL	4.0	16.0	
3B18	3 - 1 1/2" x 11 1/2" LVL	12.0	12.0	
3B19	W10x22	Vf = 1.5 (8)	Vf = 1.5 (8)	TOP PLATE NAILER
3B20	W10x22	Vf = 1.5 (8)	Vf = 1.5 (8)	TOP PLATE NAILER
3B21	W10x22	Vf = 1.5 (8)	Vf = 1.5 (1)	TOP PLATE NAILER
3B22	W10x22	Vf = 1.5 (17) Mf = 9.5	Vf = 1.5 (1)	TORSION BRACE TOP PLATE NAILER
3B23	W10x22	Vf = 1.5 (17) Mf = 9.5	Vf = 1.5 (1)	TORSION BRACE TOP PLATE NAILER
3B24	W10x22	Vf = 1.5 (17) Mf = 9.5	Vf = 1.5 (1)	TORSION BRACE TOP PLATE NAILER
3B25	W10x22	Vf = 1.5 (17) Mf = 9.5	Vf = 1.5 (1)	TORSION BRACE TOP PLATE NAILER
3B26	W10x22	Vf = 1.5 (8)	Vf = 1.5 (1)	TOP PLATE NAILER
3B27	W12x26	Vf = 2.5 (8)	Vf = 2.5 (1)	TOP PLATE NAILER
3B28	W12x26	Vf = 1.5 (17) Mf = 14.5	Vf = 1.5 (1)	TORSION BRACE TOP PLATE NAILER
3B29	W12x26	Vf = 1.5 (17) Mf = 14.5	Vf = 1.5 (1)	TORSION BRACE TOP PLATE NAILER
3B30	W12x26	Vf = 1.5 (17) Mf = 14.5	Vf = 1.5 (1)	TORSION BRACE TOP PLATE NAILER
3B31	W12x26	Vf = 1.5 (17) Mf = 14.5	Vf = 1.5 (1)	TORSION BRACE TOP PLATE NAILER
3B32	W12x26	Vf = 2.5 (8)	Vf = 2.5 (1)	TOP PLATE NAILER
3B33	3 - 1 1/2" x 11 1/2" LVL	2.0	2.0	
3B34	3 - 1 1/2" x 11 1/2" LVL	2.0	2.0	
3B35	2 - 1 1/2" x 11 1/2" LVL	1.5	1.5	
3B36	2 - 1 1/2" x 11 1/2" LVL	1.5	1.5	

NOTES:

- ALL WOOD CONNECTORS ARE TO BE BY SIMPSON STRONG TIE. PROVIDE CONSULTANT WITH FULL SPEC. OF ALL ALTERNATE HANGERS FOR APPROVAL PRIOR TO USE.
- ALL LOADS HAVE BEEN FACTORED IN ACCORDANCE WITH IBC 2015 LOAD CASES (LRFD)
- LEFT AND RIGHT BEAM REACTIONS ORIENTATED WITH THE MEMBER LABEL ON PLAN.
- ALL FASTENERS (i.e. NAILS, SCREWS, ANCHOR BOLTS, ETC.) WHICH ARE TO BE INSTALLED IN PRESERVATIVE TREATED WOOD (i.e. SILL PLATES) SHALL MEET THE REQUIREMENTS OF IBC 2304.10.5.1.
- FOR STEEL BEAMS, REFER TO S-203 FOR CONNECTION DETAILING

MARK	DATE	DESCRIPTION
△	2018.08.24	REVISED PERMIT SET
△	2018.06.26	ISSUED FOR PERMIT
△	2018.06.20	ISSUED FOR COORDINATION
△	2018.02.01	ISSUED FOR PERMIT
△	2017.12.13	ISSUED FOR INTERNAL COORD.
△	2017.12.02	ISSUED FOR COORDINATION
△	2017.11.22	ISSUED C GRADE COSTING
△	2017.11.07	INTERNAL COORDINATION



PROJECT NAME:
VILLAGE HOUSE AT LOT 71

PROJECT ADDRESS:
VILLAGE HOUSE LOT 71, SUMMIT POWDER MOUNTAIN

DRAWN: AVB
SCALE: AS NOTED

CHECKED: —
PROJECT NUMBER: 170450

SHEET TITLE:
LEVEL 4 FRAMING PLAN

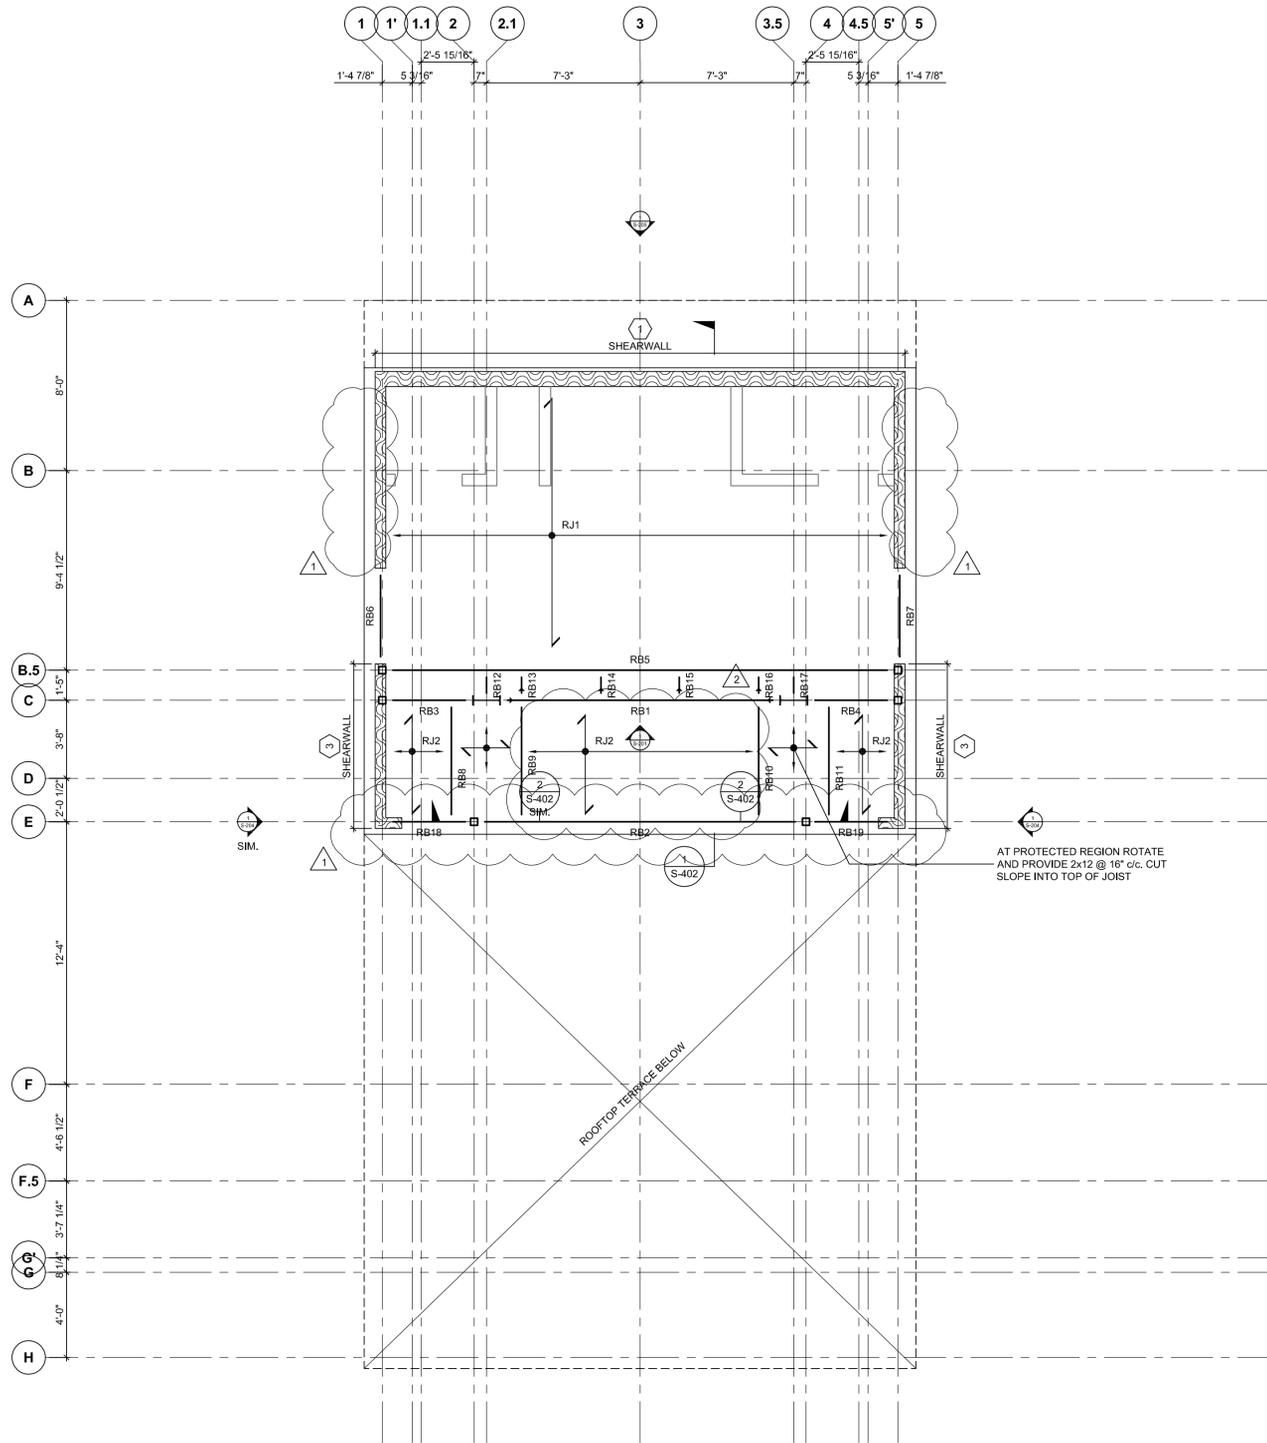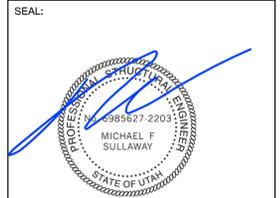

1 LEVEL 4 SHOWING UPPER ROOF FRAMING
S-104 1/4" = 1'-0"

- ROOF DATUM VARIES BASED ON ROOF SLOPE. REFER TO ARCHITECTURAL DRAWINGS.
- TOP OF SHEATHING IS AT (-0'-3 1/2") BELOW FINISH
- LOADS USED IN DESIGN: DEAD: 25psf
SNOW: 152psf
LIVE: N/A
- ALL SHEATHING TO BE 3/4" T&G APPLIED DIRECTLY TO THE JOISTS.
- TYPICAL NAILING SHALL BE 10d NAILS @ 6" c/c @ ALL SUPPORTED EDGES AND OVER SHEARWALLS. 12" c/c @ ALL INTERMEDIATE SUPPORT UNLESS OTHERWISE NOTED.
- OVER SMF NAILING SPACING TO BE 2" c/c TO NAILER PLATE.
- REFER TO GENERAL NOTES AND TYPICAL DETAILS FOR ADDITIONAL INFORMATION.

ROOF MEMBER SCHEDULE				
MEMBER MARK	MEMBER DESCRIPTION	REACTIONS		REMARKS
		LEFT	RIGHT	
RJ1	14" REDBUILT RED I-90 @ 12" c/c	2.0	2.0	SOLID BLOCKING @ 8'-0" c/c MAX
RJ2	14" REDBUILT RED I-45 @ 16" c/c	1.0	1.0	SOLID BLOCKING @ 8'-0" c/c MAX
RB1 (SFRS)	W14x22	Vf = 8.0 Mf = 26.5	Vf = 8.0 Mf = 26.5	RBS-SMF REFER TO STEEL ELEVATIONS WEB PACK OUT + TOP PLATE NAILER
RB2	4 - 1 1/2" x 16" LVL	4.5	4.5	
RB3 (SFRS)	W14x22	Vf = 2.5	Vf = 2.5	WEB PACK OUT + TOP PLATE NAILER. CHORD
RB4 (SFRS)	W14x22	Vf = 2.5	Vf = 2.5	WEB PACK OUT + TOP PLATE NAILER CHORD.
RB5	W14x53	Vf = 31.0	Vf = 31.0	WEB PACK OUT + TOP PLATE NAILER
RB6	2 - 1 1/2" x 14" LVL	0.5	0.5	
RB7	2 - 1 1/2" x 14" LVL	0.5	0.5	
RB8	2 - 1 1/2" x 14" LVL	1.5	1.5	
RB9	2 - 1 1/2" x 14" LVL	1.5	1.5	
RB10	2 - 1 1/2" x 14" LVL	1.5	1.5	
RB11	2 - 1 1/2" x 14" LVL	1.5	1.5	
RB12	W10x22	Vf = 1.5	Vf = 1.5	TOP PLATE NAILER
RB13	W10x22	Vf = 1.5 Mf = 9.5	Vf = 1.5	TORSION BRACE TOP PLATE NAILER
RB14	W10x22	Vf = 1.5 Mf = 9.5	Vf = 1.5	TORSION BRACE TOP PLATE NAILER
RB15	W10x22	Vf = 1.5 Mf = 9.5	Vf = 1.5	TORSION BRACE TOP PLATE NAILER
RB16	W10x22	Vf = 1.5 Mf = 9.5	Vf = 1.5	TORSION BRACE TOP PLATE NAILER
RB17	W10x22	Vf = 1.5	Vf = 1.5	TOP PLATE NAILER
RB18	2 - 1 1/2" x 16" LVL	1.5	1.5	
RB19	2 - 1 1/2" x 16" LVL	1.5	1.5	

NOTES:

- ALL WOOD CONNECTORS ARE TO BE BY SIMPSON STRONG TIE. PROVIDE CONSULTANT WITH FULL SPEC. OF ALL ALTERNATE HANGERS FOR APPROVAL PRIOR TO USE.
- ALL LOADS HAVE BEEN FACTORED IN ACCORDANCE WITH IBC 2015 LOAD CASES (LRFD)
- LEFT AND RIGHT BEAM REACTIONS ORIENTATED WITH THE MEMBER LABEL ON PLAN.
- ALL FASTENERS (i.e. NAILS, SCREWS, ANCHOR BOLTS, ETC.) WHICH ARE TO BE INSTALLED IN PRESERVATIVE TREATED WOOD (i.e. SILL PLATES) SHALL MEET THE REQUIREMENTS OF IBC 2304.10.5.1.
- FOR STEEL BEAMS, REFER TO S-205 FOR CONNECTION DETAILING

SHEARWALL SCHEDULE							
MEMBER MARK	PLYWOOD SHEATHING	EDGE NAILING	BOTTOM PLATE TO RIM	SILL BOLTING	ASD SHEAR (PLF)	END STUDS	FOUNDATION ANCHORAGE
SW1	15/32" STRUCT I	8d @ 6" c/c	16d @ 6" c/c COMMON	5/8" @ 32" c/c	280	2-2x6	SIMPSON HDU-8 c/w 1" CAST IN HEADED STUD. 8" EMBEDMENT. PROVIDE ADDITIONAL 2 #3 INVERTED U-BARS, 1 EACH SIDE OF ANCHOR.
SW2	15/32" STRUCT I	8d @ 4" c/c	16d @ 6" c/c COMMON	5/8" @ 32" c/c	430	2-2x6	SIMPSON HDU-8 c/w 1" CAST IN HEADED STUD. 10" EMBEDMENT. PROVIDE ADDITIONAL 2 #3 INVERTED U-BARS, 1 EACH SIDE OF ANCHOR.
SW3	15/32" STRUCT I	8d @ 3" c/c	16d @ 6" c/c COMMON	5/8" @ 16" c/c	550	2-2x6	SIMPSON HDU-11 c/w 1" CAST IN HEADED STUD. 12" EMBEDMENT. PROVIDE ADDITIONAL 2 #3 INVERTED U-BARS, 1 EACH SIDE OF ANCHOR.
SW4	15/32" STRUCT I	8d @ 2" c/c	16d @ 6" c/c COMMON	5/8" @ 16" c/c	730	2-2x6	SHEARWALL NAILING PATTERN CURRENTLY NOT IN USE.

NOTES:

- ALL PANEL EDGES SHALL BE BACKED WITH 2" NOMINAL FRAMING MINIMUM.
- ALL PANEL EDGES RECEIVING EDGE NAILING FROM ABUTTING PANELS SHALL BE 3" NOMINAL MINIMUM OR STAGGER ROWS TO PROVIDE MINIMUM 1/2" EDGE DISTANCE.
- MINIMUM 1/2" EDGE DISTANCE.
- PROVIDE 3"x3"x0.229 WASHERS FOR ALL ANCHOR BOLTS TO STILL PLATES (TYP.). LOCATE ANCHORS, SUCH THAT EDGE OF WASHER IS WITHIN 1/2" OF INSIDE FACE OF SHEATHING.
- AT INTERMEDIATE FRAMING MEMBERS NAIL WALLS @ 12" c/c.
- EDGE NAILS NOTED IN SCHEDULE TO BE STAGGERED AND PROVIDE 1/2" EDGE DISTANCE MINIMUM.
- ALL FASTENERS IN CONTACT WITH PRESSURE TREATED SILL SHALL BE GALVANIZED.
- 4x4x1/2" HSS COLUMNS ARE ACCEPTABLE ALTERNATES TO END STUD CONDITIONS.
- SEE SHEARWALL ELEVATIONS FOR ADDITIONAL INFORMATION.

MARK	DATE	DESCRIPTION
△	2018.08.24	REVISED PERMIT SET
△	2018.06.26	ISSUED FOR PERMIT
△	2018.06.20	ISSUED FOR COORDINATION
△	2018.02.01	ISSUED FOR PERMIT
△	2017.12.13	ISSUED FOR INTERNAL COORD.
△	2017.12.02	ISSUED FOR COORDINATION
△	2017.11.22	ISSUED C GRADE COSTING
△	2017.11.07	INTERNAL COORDINATION

PROJECT NAME:
VILLAGE HOUSE AT LOT 71

PROJECT ADDRESS:
VILLAGE HOUSE LOT 71, SUMMIT POWDER MOUNTAIN

DRAWN: AVB
CHECKED: —
SCALE: AS NOTED
PROJECT NUMBER: 170450

SHEET TITLE:
ROOF FRAMING PLAN

COLUMN SCHEDULE																							
COLUMN	B.5 - 1	B.5(-1'-3 $\frac{3}{8}$ " - 1	B.5(-1'-3 $\frac{3}{8}$ " - 3	B.5(-1'-3 $\frac{3}{8}$ " - 5	B.5 - 3	B.5 - 5	C - 1	C - 2.1	C - 3.5	C - 5	E - 1	E - 2	E - 4	E - 5	F - 1	F - 5	F.5 - 1	F.5 - 1.1	F.5 - 4.5	F.5 - 5	G' - 1'	G' - 5'	
ROOF PEAK (42'-11 $\frac{1}{2}$ "																							
LEVEL 4 (28'-10 $\frac{1}{2}$ "																							
TOP OF CONCRETE WALL (20'-4 $\frac{1}{2}$ "																							
LEVEL 3 (18'-4 $\frac{1}{2}$ "																							
TOP OF CONCRETE WALL (12'-1 $\frac{1}{4}$ "																							
LEVEL 2 (8'-11 $\frac{1}{4}$ "																							
LEVEL 1 (0'-0"																							
BASEPLATE	D	A	A	A	D	D	A	B	B	A	A	A	A	A	A	A	D	D	D	D	C	C	
ADDITIONAL																							

NOTES:

- ALL FORCES ARE GIVEN IN KIP AND KIP-FT.
- ALL COLUMNS LOCATED WITHIN STUD CAVITIES TO HAVE FIRST STUD FASTENED DIRECTLY TO FACE OF COLUMN WITH SIMPSON TB WOOD-TO-STEEL SCREW @ 10" c/c.

BASEPLATE SCHEDULE			
BASEPLATE A - $\frac{5}{8}$ " THICK	BASEPLATE B - $\frac{5}{8}$ " THICK	BASEPLATE C - $\frac{5}{8}$ " THICK	BASEPLATE D - $\frac{5}{8}$ " THICK
2- $\frac{5}{8}$ " \varnothing HILTI HIT-Z BARS DRILLED AND EPOXIED 6" USING HILTI HIT-HY 200	4- $\frac{5}{8}$ " \varnothing HILTI HIT-Z BARS DRILLED AND EPOXIED 6" USING HILTI HIT-HY 200	4- $\frac{5}{8}$ " \varnothing HILTI HIT-Z BARS DRILLED AND EPOXIED 6" USING HILTI HIT-HY 200	4- $\frac{3}{4}$ " \varnothing HILTI HEX HEAD HEADED STUD ANCHORS CAST-IN WITH 16" EMBEDMENT

CAST IN PLATE SCHEDULE	
CAST IN PLATE 1 - $\frac{3}{4}$ " THICK	CAST IN PLATE 2 - $\frac{3}{4}$ " THICK
4- $\frac{3}{4}$ " \varnothing HILTI HEX HEAD HEADED STUD ANCHORS CAST-IN WITH 6" EMBEDMENT	4- $\frac{7}{8}$ " \varnothing HILTI HEX HEAD HEADED STUD ANCHORS CAST-IN WITH 6" EMBEDMENT

SEAL:



MARK	DATE	DESCRIPTION
△	2018.08.24	REVISED PERMIT SET
△	2018.06.26	ISSUED FOR PERMIT
△	2018.06.20	ISSUED FOR COORDINATION
△	2018.02.01	ISSUED FOR PERMIT
△	2017.12.13	ISSUED FOR INTERNAL COORD.
△	2017.12.02	ISSUED FOR COORDINATION
△	2017.11.22	ISSUED C GRADE COSTING
△	2017.11.07	INTERNAL COORDINATION


PROJECT NAME:
VILLAGE HOUSE AT LOT 71

PROJECT ADDRESS:
VILLAGE HOUSE LOT 71, SUMMIT POWDER MOUNTAIN

DRAWN: AVB	CHECKED: —
SCALE: AS NOTED	PROJECT NUMBER: 170450

SHEET TITLE:
COLUMN SCHEDULE

S-105

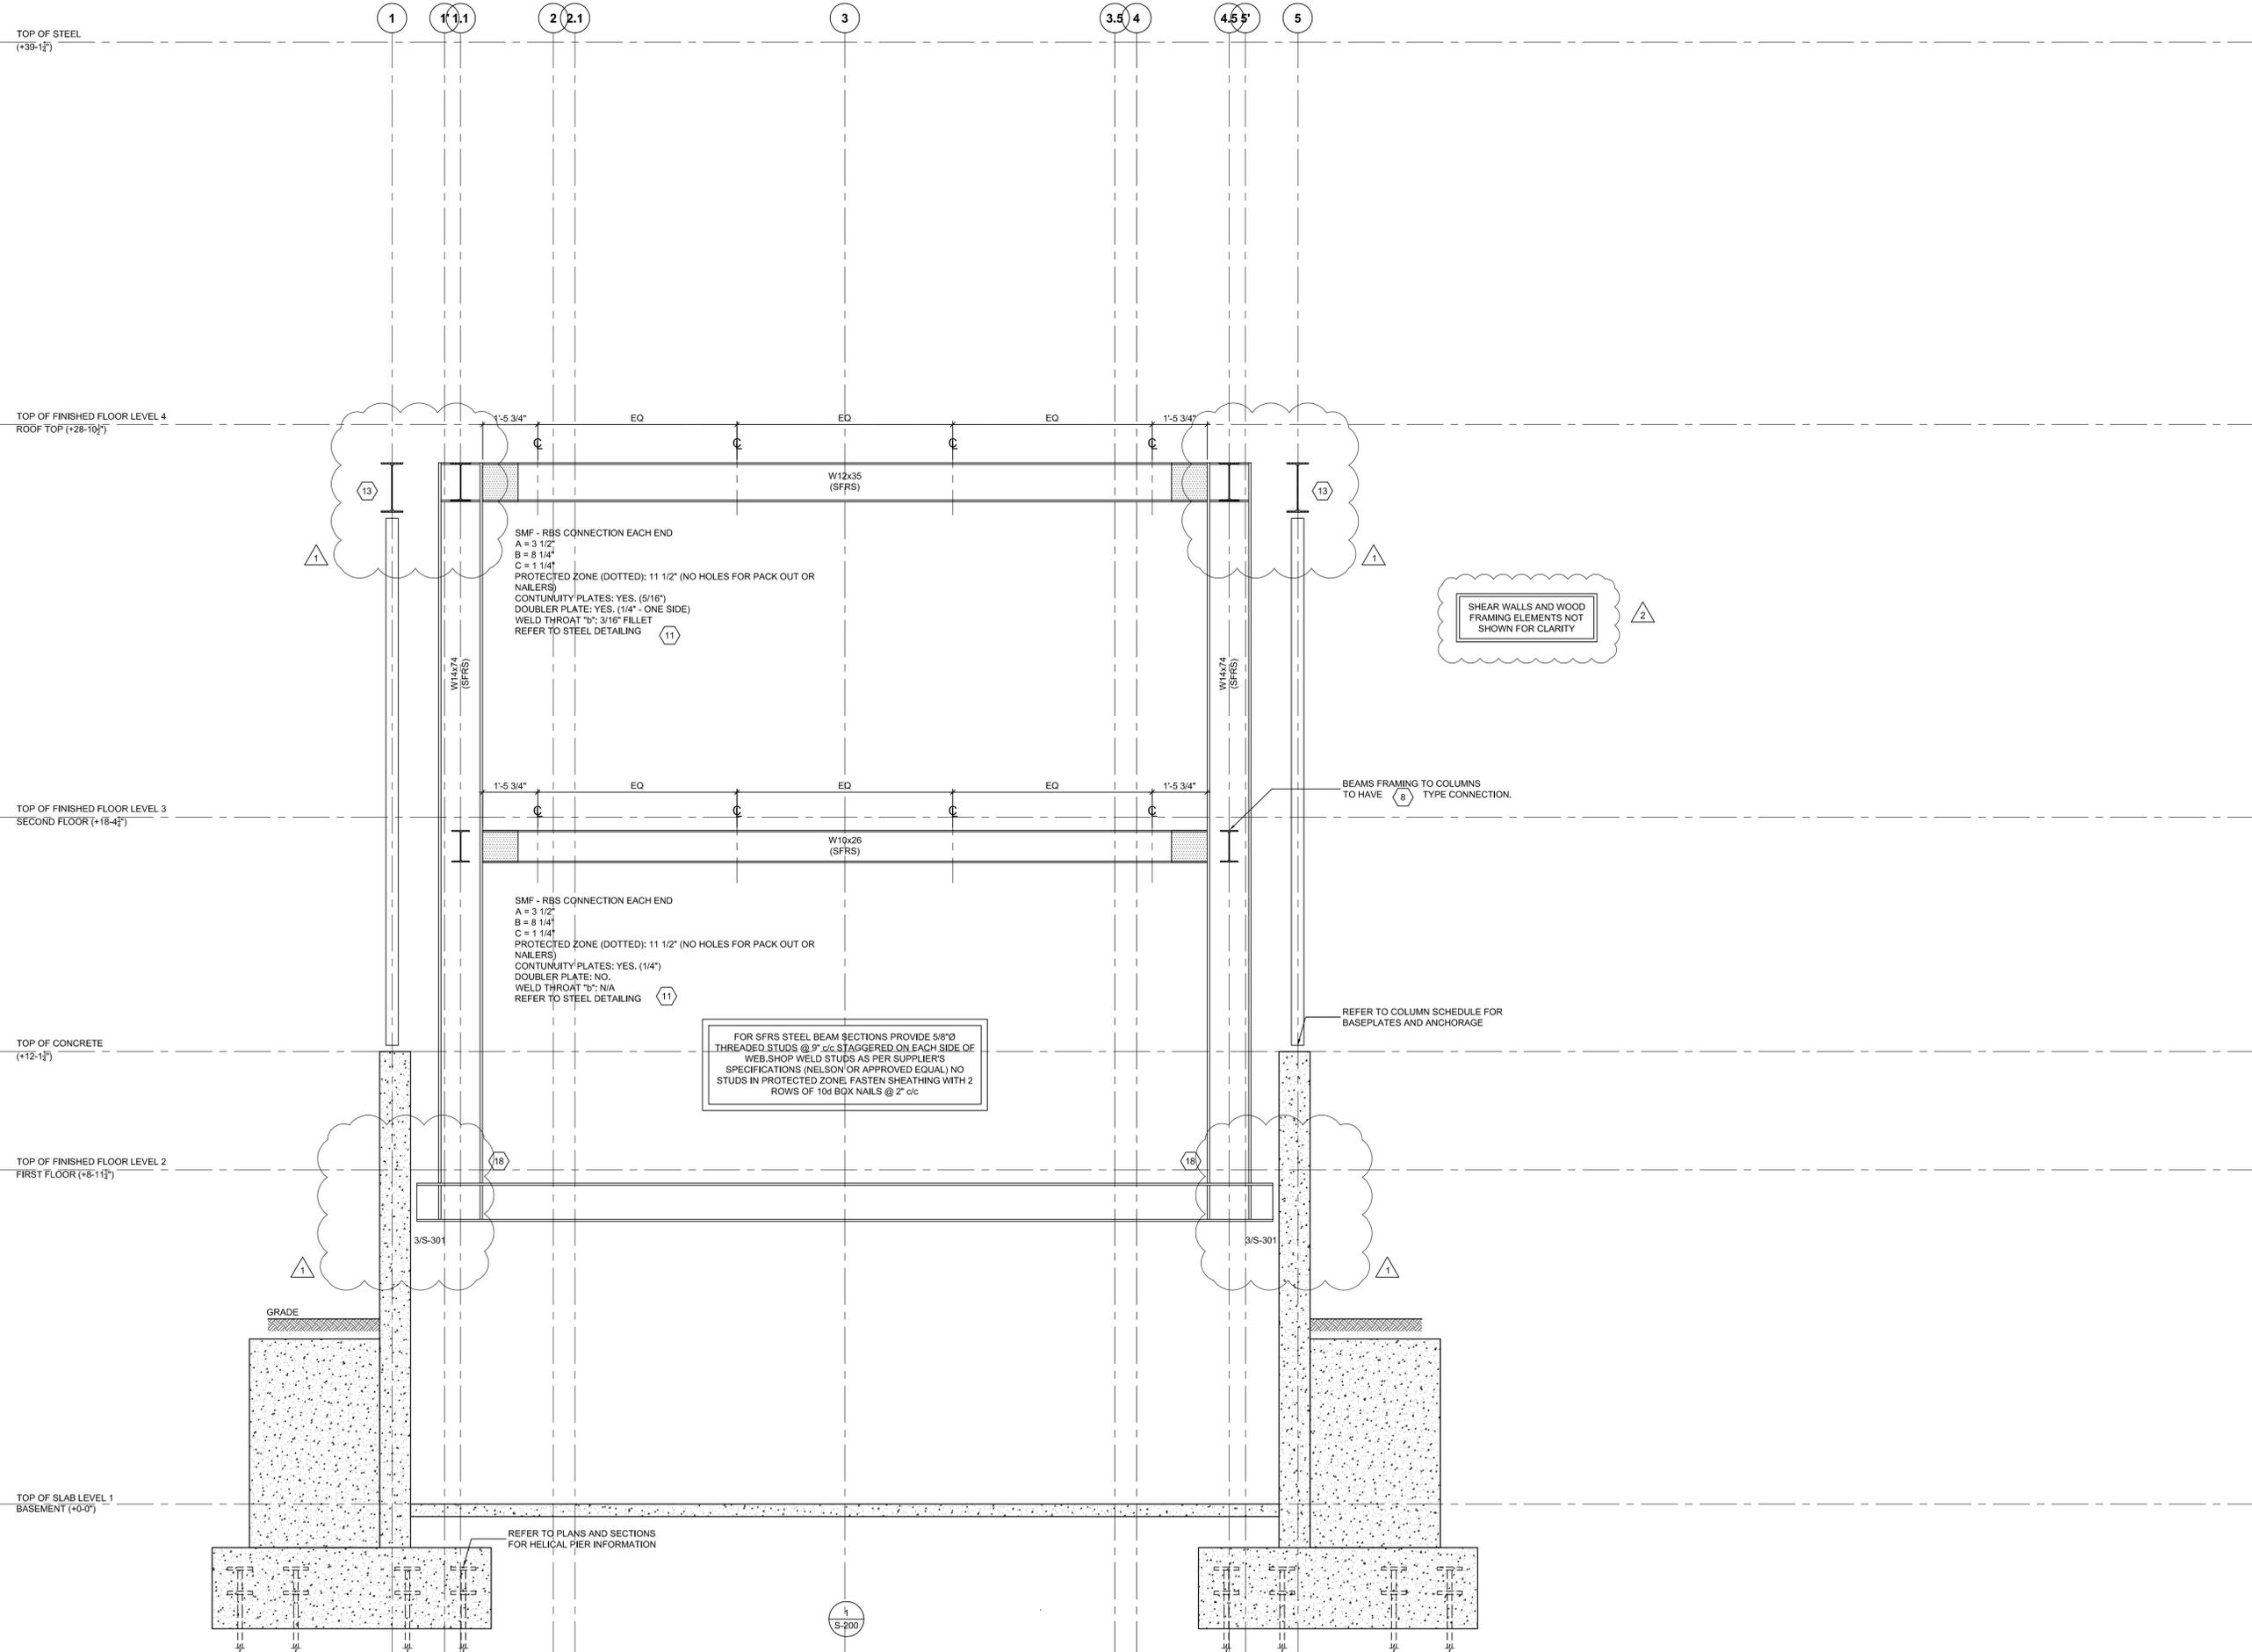

SEAL:



MARK	DATE	DESCRIPTION
△	2018.08.24	REVISED PERMIT SET
△	2018.06.26	ISSUED FOR PERMIT
△	2018.06.20	ISSUED FOR COORDINATION
△	2018.02.01	ISSUED FOR PERMIT
△	2017.12.13	ISSUED FOR INTERNAL COORD.
△	2017.12.02	ISSUED FOR COORDINATION
△	2017.11.22	ISSUED C GRADE COSTING
△	2017.11.07	INTERNAL COORDINATION


PROJECT NAME:
VILLAGE HOUSE AT LOT 71

PROJECT ADDRESS:
VILLAGE HOUSE LOT 71, SUMMIT POWDER MOUNTAIN

DRAWN: AVB	CHECKED: —
SCALE: AS NOTED	PROJECT NUMBER: 170450

SHEET TITLE:
STEEL ELEVATIONS

S-200

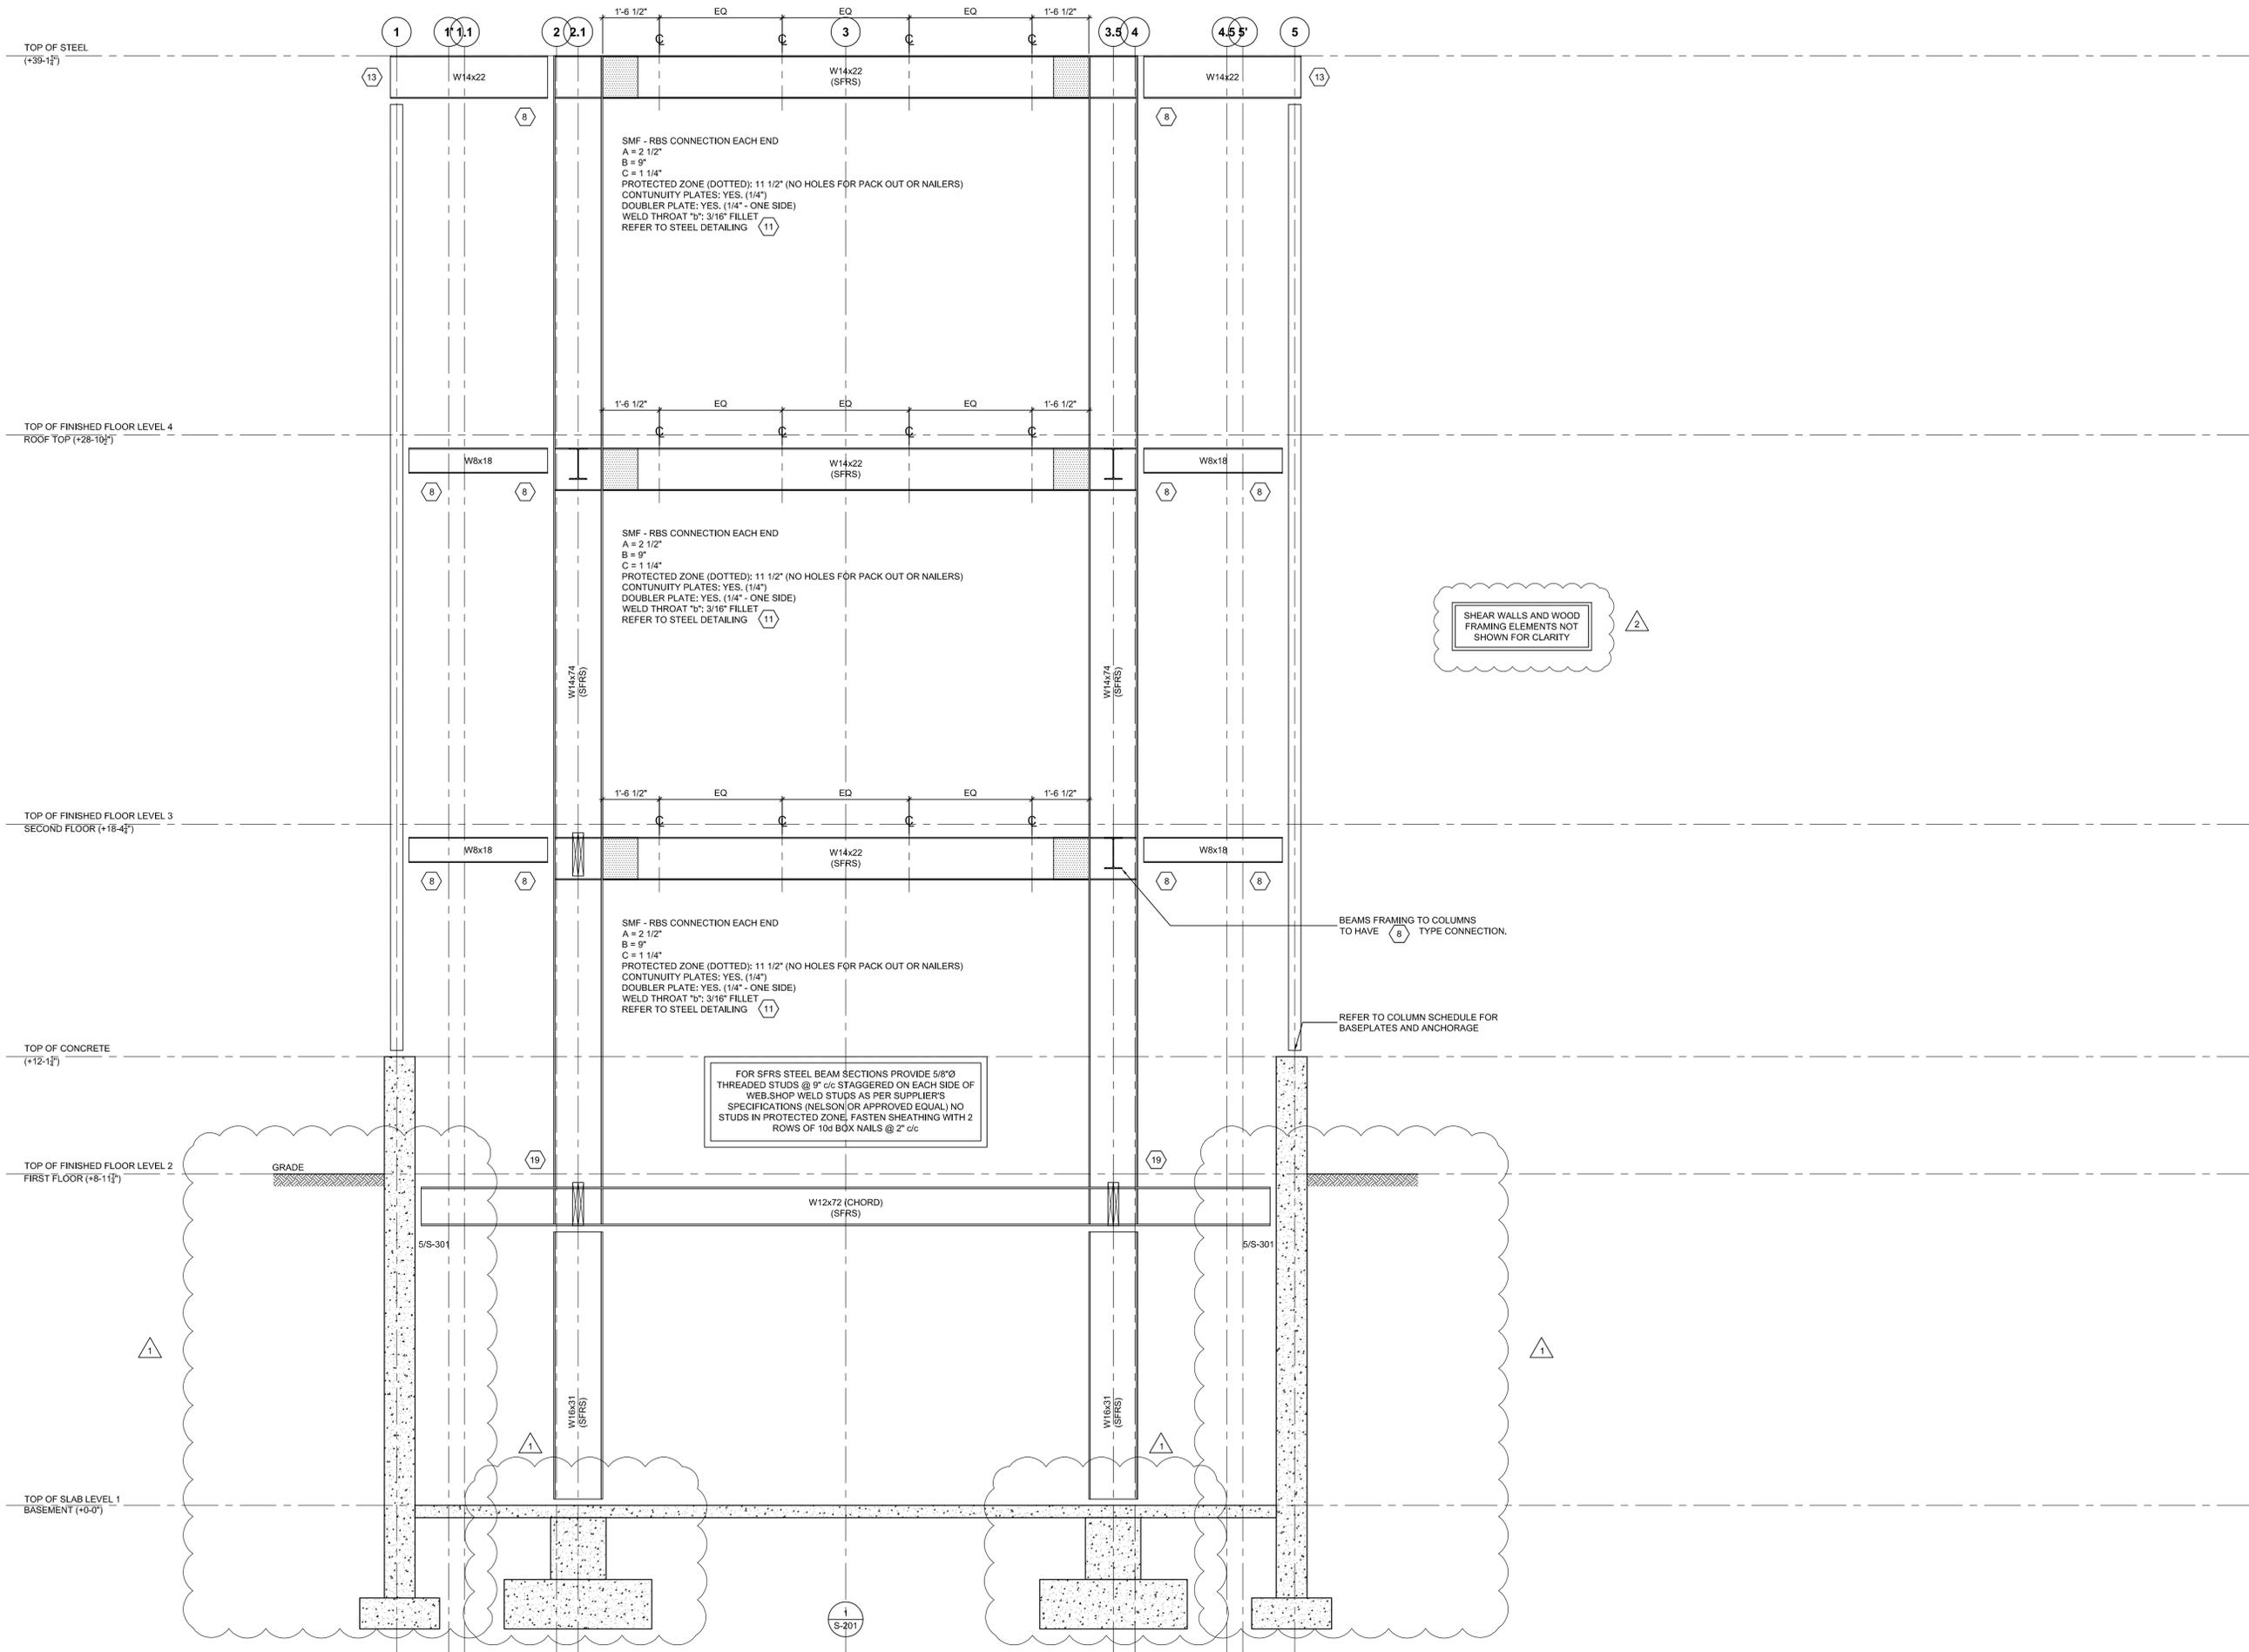

SEAL:



MARK	DATE	DESCRIPTION
△	2018.08.24	REVISED PERMIT SET
△	2018.06.26	ISSUED FOR PERMIT
△	2018.06.20	ISSUED FOR COORDINATION
△	2018.02.01	ISSUED FOR PERMIT
△	2017.12.13	ISSUED FOR INTERNAL COORD.
△	2017.12.02	ISSUED FOR COORDINATION
△	2017.11.22	ISSUED C GRADE COSTING
△	2017.11.07	INTERNAL COORDINATION

PROJECT NAME:
VILLAGE HOUSE AT LOT 71

PROJECT ADDRESS:
VILLAGE HOUSE LOT 71, SUMMIT POWDER MOUNTAIN

DRAWN: AVB	CHECKED: —
SCALE: AS NOTED	PROJECT NUMBER: 170450

SHEET TITLE:
STEEL ELEVATIONS CONT'D

S-201



MARK	DATE	DESCRIPTION
△	2018.08.24	REVISED PERMIT SET
△	2018.06.26	ISSUED FOR PERMIT
△	2018.06.20	ISSUED FOR COORDINATION
△	2018.02.01	ISSUED FOR PERMIT
△	2017.12.13	ISSUED FOR INTERNAL COORD.
△	2017.12.02	ISSUED FOR COORDINATION
△	2017.11.22	ISSUED C GRADE COSTING
△	2017.11.07	INTERNAL COORDINATION

MARK	DATE	DESCRIPTION
△	2018.08.24	REVISED PERMIT SET
△	2018.06.26	ISSUED FOR PERMIT
△	2018.06.20	ISSUED FOR COORDINATION
△	2018.02.01	ISSUED FOR PERMIT
△	2017.12.13	ISSUED FOR INTERNAL COORD.
△	2017.12.02	ISSUED FOR COORDINATION
△	2017.11.22	ISSUED C GRADE COSTING
△	2017.11.07	INTERNAL COORDINATION

PROJECT NAME:
VILLAGE HOUSE AT LOT 71

PROJECT ADDRESS:
VILLAGE HOUSE LOT 71, SUMMIT POWDER MOUNTAIN

DRAWN: AVB
SCALE: AS NOTED
SHEET TITLE: STEEL CONNECTIONS

CHECKED: —
PROJECT NUMBER: 170450

REFER TO DETAIL 5 FOR SHEAR PL AND BOLTS

ONE-SIDED CONNECTION

REFER TO DETAIL 5 FOR SHEAR PL AND BOLTS

TWO-SIDED CONNECTION

REFER TO DETAIL 5 FOR SHEAR PL AND BOLTS

TWO-SIDED CONNECTION

REFER TO DETAIL 5 FOR SHEAR PL AND BOLTS

TWO-SIDED CONNECTION

CONNECTION SCHEDULE						
BEAM SIZE	PLATE THICKNESS	BOLTS DIA.	QTY.	DIM 'B'	W (MAX)	
W8	5/16	3/4	2	2 1/2	24	
W10	5/16	3/4	2	2 1/2	41	
W12	5/16	3/4	3	2 1/2	41	
W14	5/16	3/4	3	2 1/2	43	
W16	5/16	3/4	4	2 1/2	62	
W18	5/16	3/4	5	2 1/2	81	

CONNECTION SCHEDULE NOTES

- ALL HOLE SIZES ARE 1/8" UNLESS NOTED
- BOLTS TO BE ASTM A325N OR A325X
- ALL WELDS TO BE E70XX
- SHEAR PLATES SHALL BE MINIMUM GRADE A36
- REFER TO BEAM SCHEDULE FOR FACTORED DESIGN REACTIONS. THE REACTION FORCES NOTED IN THE RESPECTIVE BEAM SCHEDULES SHALL NOT EXCEED THE CONNECTION CAPACITY NOTED IN THIS TABLE.

REFER TO DETAIL 5 FOR SHEAR PL AND BOLTS

UNEQUAL BEAM AND GIRDER DEPTH

REFER TO DETAIL 5 FOR SHEAR PL AND BOLTS

EQUAL BEAM AND GIRDER DEPTH

REFER TO DETAIL 5 FOR SHEAR PL AND BOLTS

GIRDER TO COLUMN

REFER TO DETAIL 5 FOR SHEAR PL AND BOLTS

GIRDER TO COLUMN

REFER TO DETAIL 5 FOR SHEAR PL AND BOLTS

TOP OF HSS COLUMN

REFER TO DETAIL 5 FOR SHEAR PL AND BOLTS

TOP OF HSS COLUMN

REFER TO STEEL ELEVATION FOR DIMENSIONS A,B,C

WELD THROAT "a" TO BE THICKNESS OF CONTINUITY PLATE, LESS 1/16"

REFER TO STEEL ELEVATIONS FOR WELD THROAT THICKNESS "b" AND DOUBLER PLATE QUANTITY AND THICKNESS

REFER TO STEEL ELEVATIONS FOR DOUBLER PLATE THICKNESS

3/8" SHEAR TAB 5/8" BOLTS @ 3" c/c (2 MIN) FOR REECTION ONLY

STEEL BACKING MUST BE REMOVED AND THE ROOT PASS MUST BE BACKGROUGED AND BACK-WELDED WITH A 3/8" REINFORCING FIBER

REFER TO STEEL ELEVATION FOR DIMENSIONS A,B,C

CJP DEMAND CRITICAL WELD TOP & BOT. BACK UP BAR TO REMAIN REMOVE WELD TABS

REFER TO DETAIL 16 FOR WELD SIZE "c" FOR STIFFENERS, TYP.

REFER TO DETAIL 16 FOR WELD SIZE "c" FOR STIFFENERS, TYP.



REFER TO DETAIL 16 FOR WELD SIZE "c" FOR STIFFENERS, TYP.

REFER TO DETAIL 16 FOR WELD SIZE "c" FOR STIFFENERS, TYP.

REFER TO DETAIL 16 FOR WELD SIZE "c" FOR STIFFENERS, TYP.

REFER TO DETAIL 16 FOR WELD SIZE "c" FOR STIFFENERS, TYP.

SEAL:

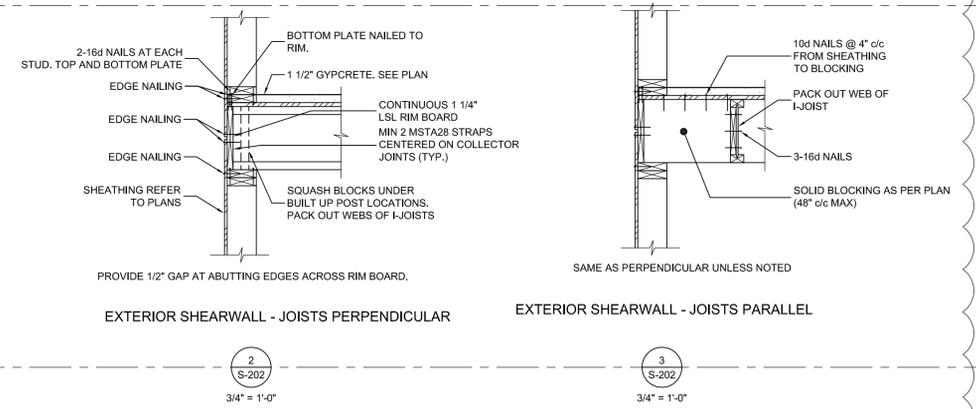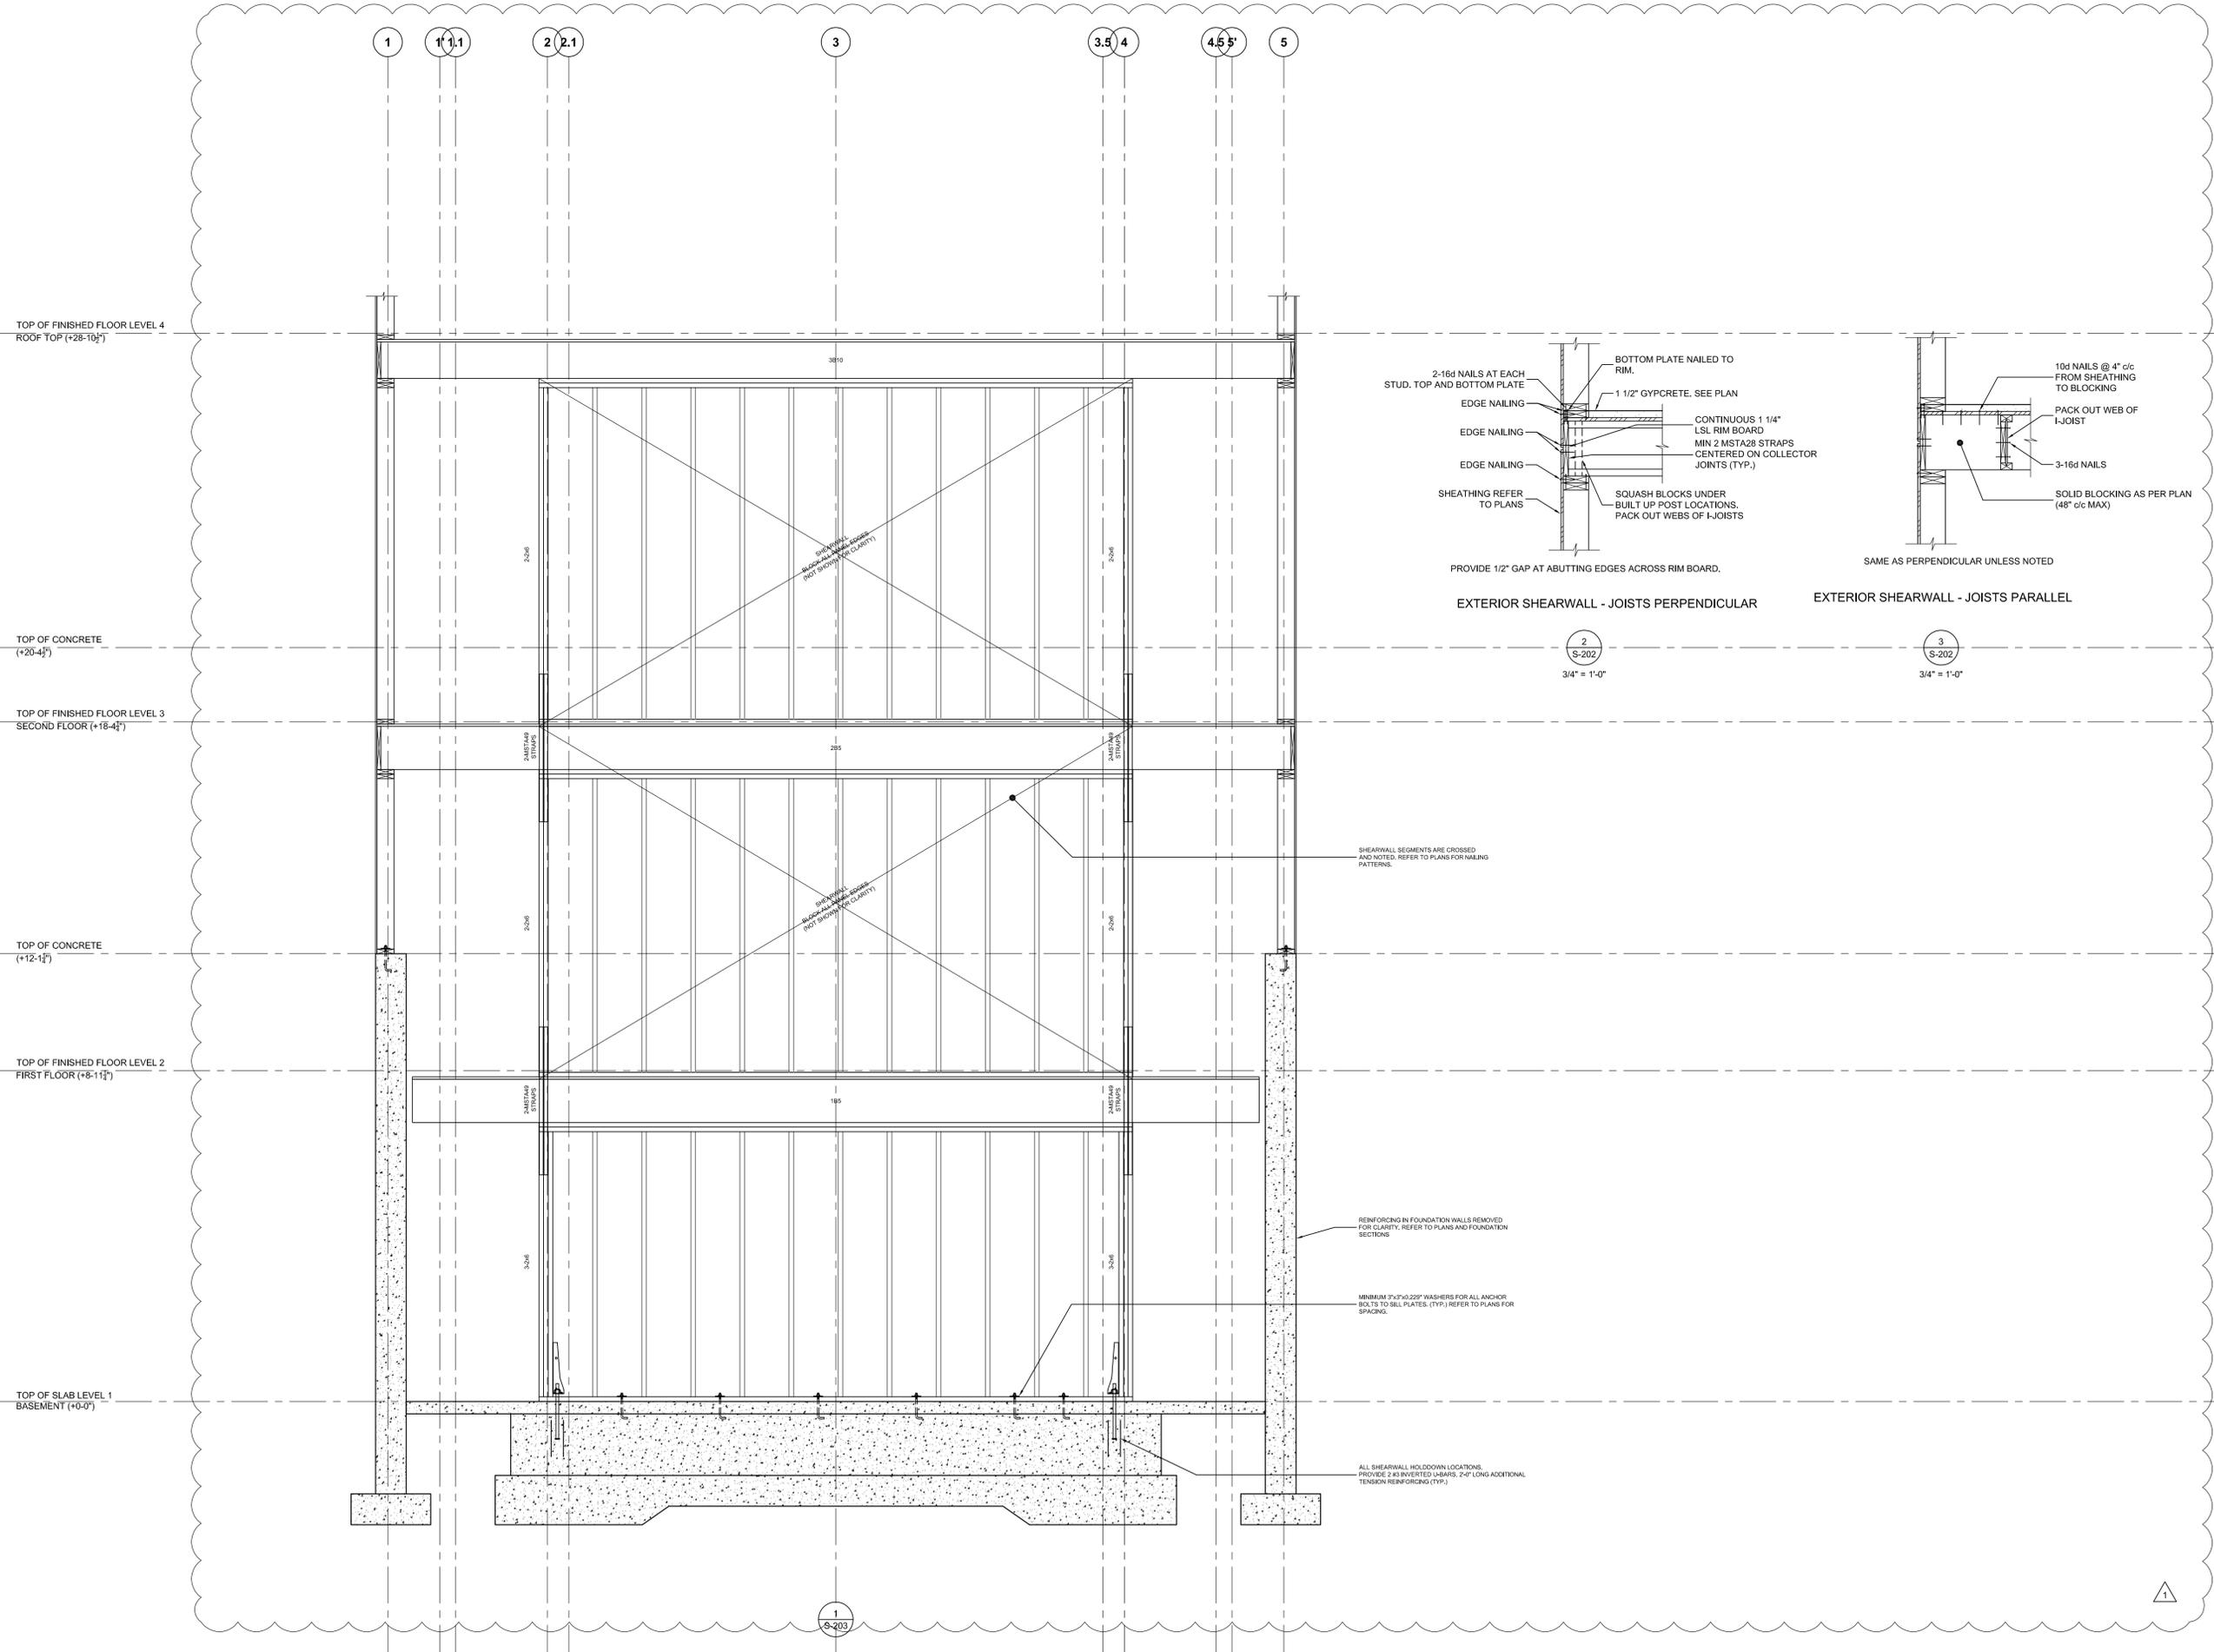

△	2018.08.24	REVISED PERMIT SET
△	2018.06.26	ISSUED FOR PERMIT
△	2018.06.20	ISSUED FOR COORDINATION
△	2018.02.01	ISSUED FOR PERMIT
△	2017.12.13	ISSUED FOR INTERNAL COORD.
△	2017.12.02	ISSUED FOR COORDINATION
△	2017.11.22	ISSUED C GRADE COSTING
△	2017.11.07	INTERNAL COORDINATION

PROJECT NAME:
VILLAGE HOUSE AT LOT 71

PROJECT ADDRESS:
VILLAGE HOUSE LOT 71, SUMMIT POWDER MOUNTAIN


DRAWN: AVB
SCALE: AS NOTED

CHECKED: —
PROJECT NUMBER: 170450

SHEET TITLE:
WOOD SHEARWALL ELEVATIONS

S-203

SEAL:

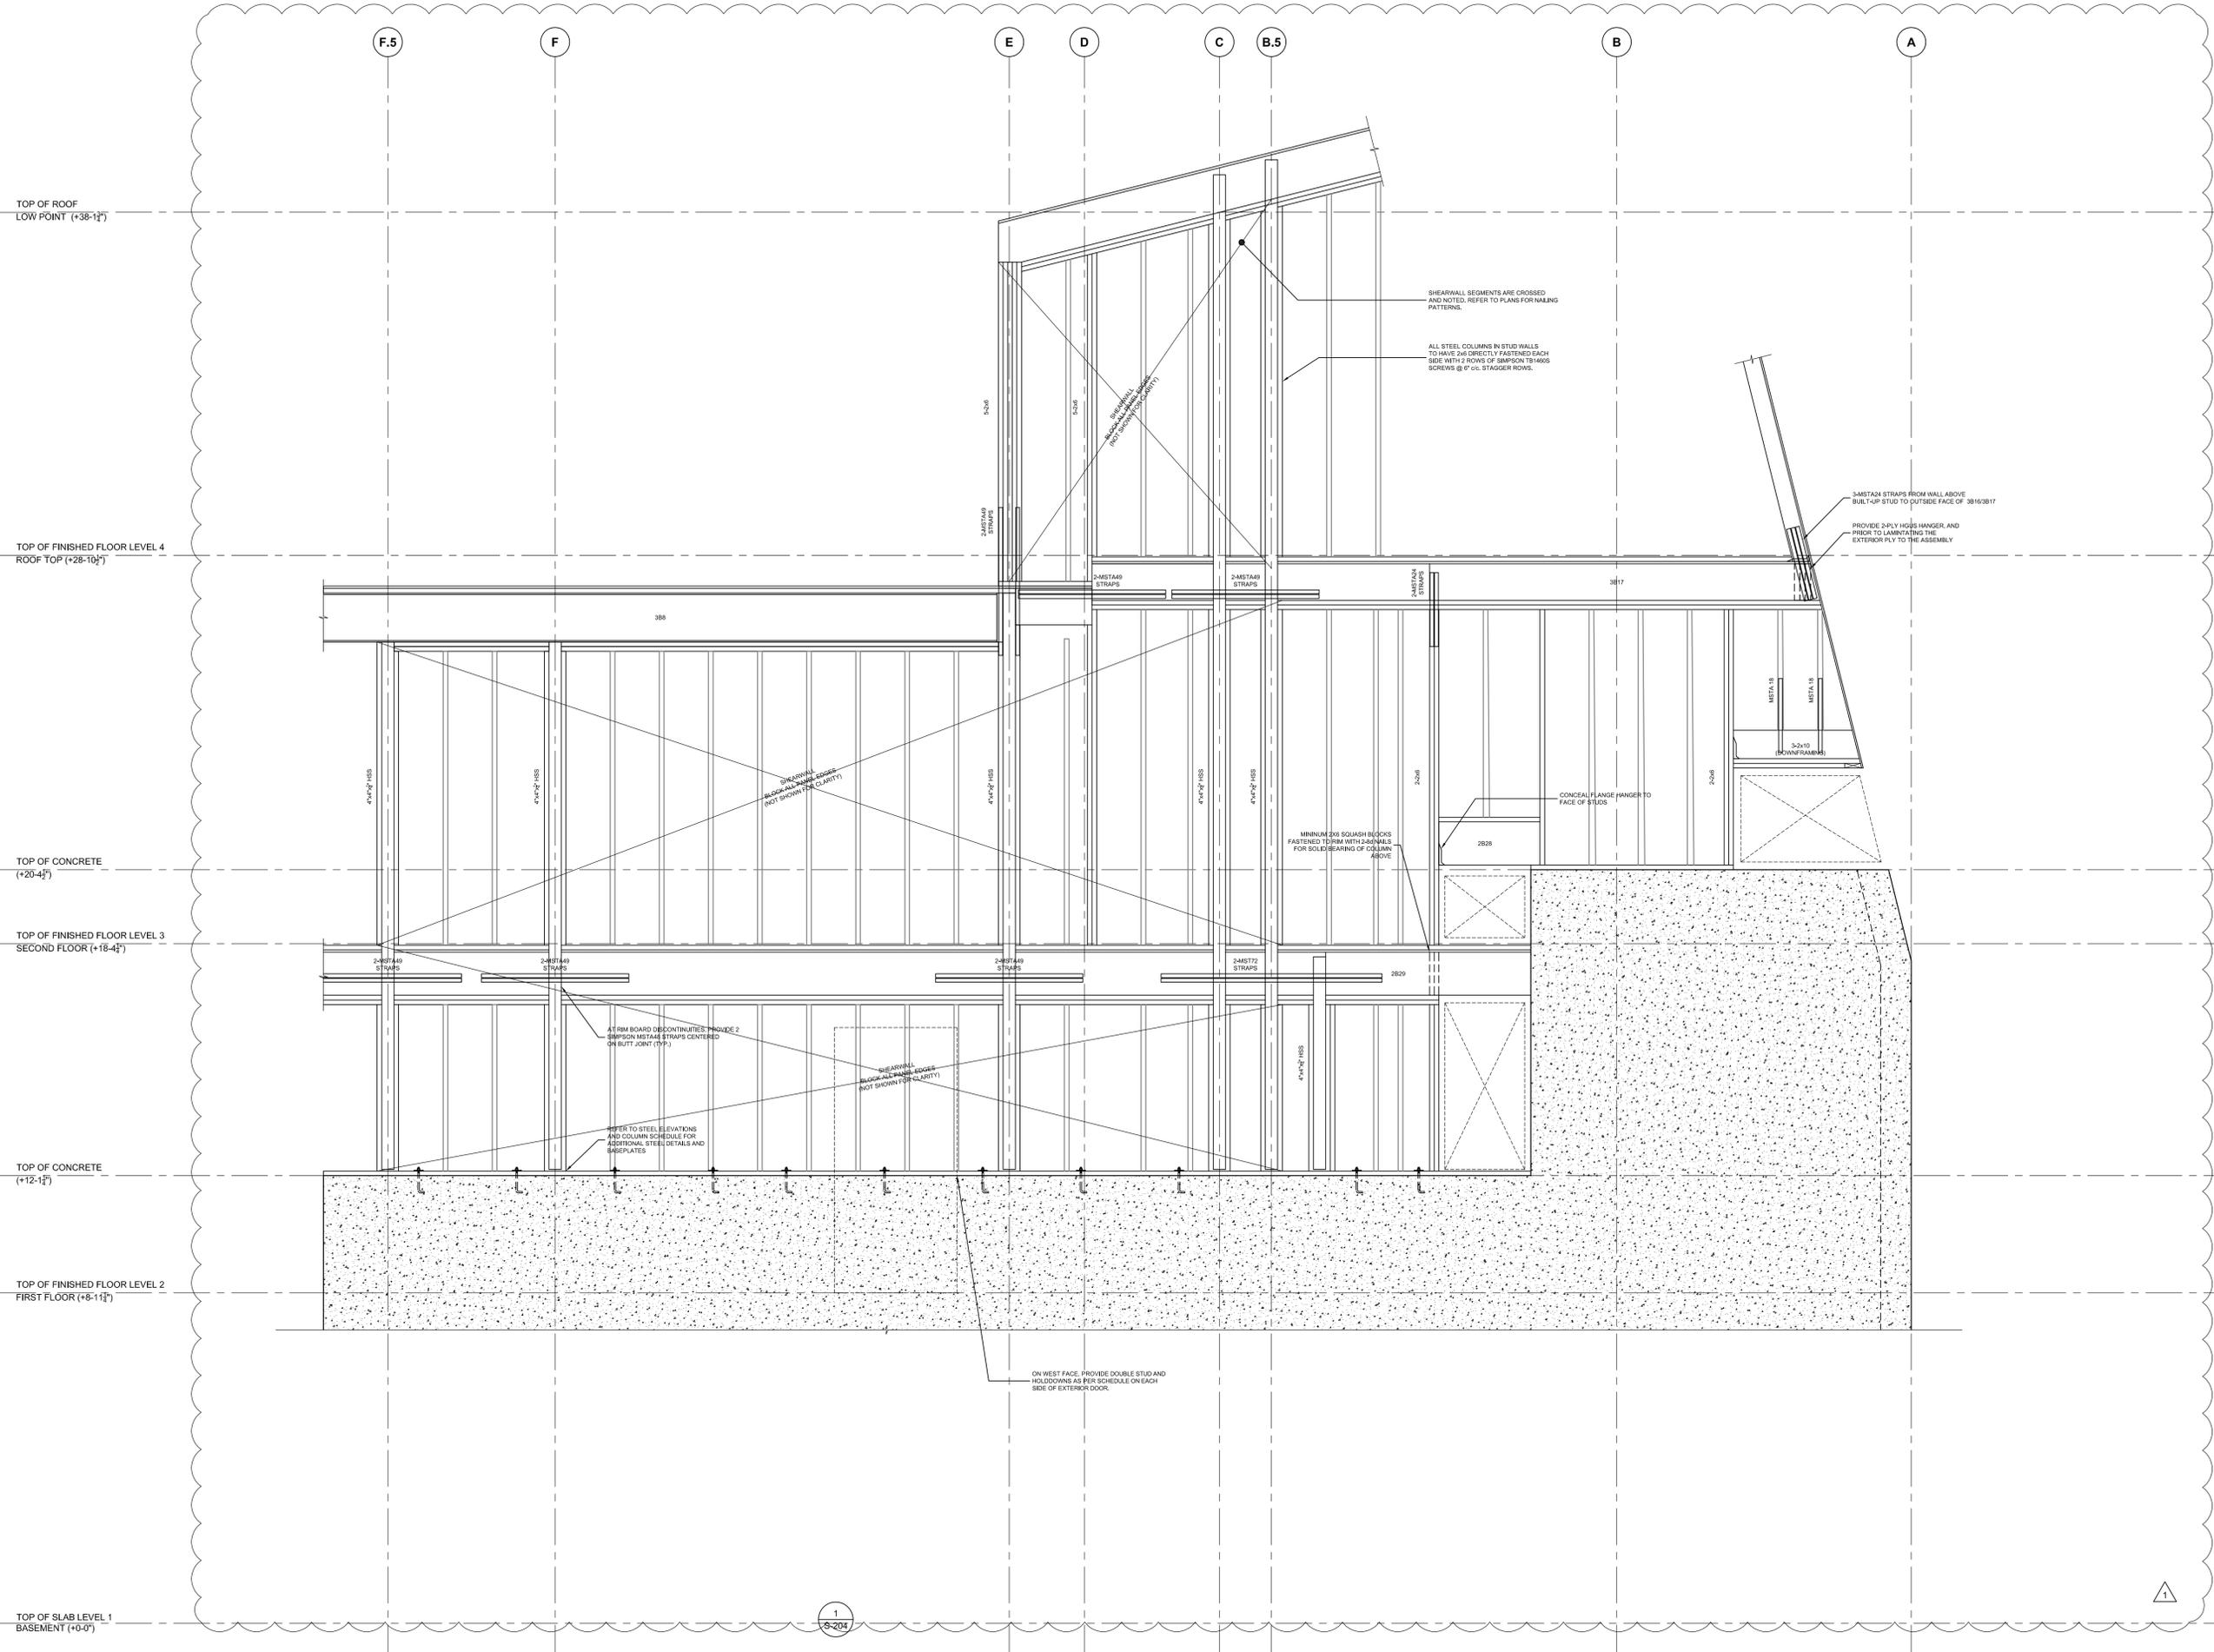

MARK	DATE	DESCRIPTION
△	2018.08.24	REVISED PERMIT SET
△	2018.06.26	ISSUED FOR PERMIT
△	2018.06.20	ISSUED FOR COORDINATION
△	2018.02.01	ISSUED FOR PERMIT
△	2017.12.13	ISSUED FOR INTERNAL COORD.
△	2017.12.02	ISSUED FOR COORDINATION
△	2017.11.22	ISSUED C GRADE COSTING
△	2017.11.07	INTERNAL COORDINATION

PROJECT NAME:
VILLAGE HOUSE AT LOT 71



PROJECT ADDRESS:
VILLAGE HOUSE LOT 71, SUMMIT POWDER MOUNTAIN

DRAWN: AVB
SCALE: AS NOTED

CHECKED: —
PROJECT NUMBER: 170450

SHEET TITLE:
WOOD SHEARWALL ELEVATIONS CONT'D

SEAL:

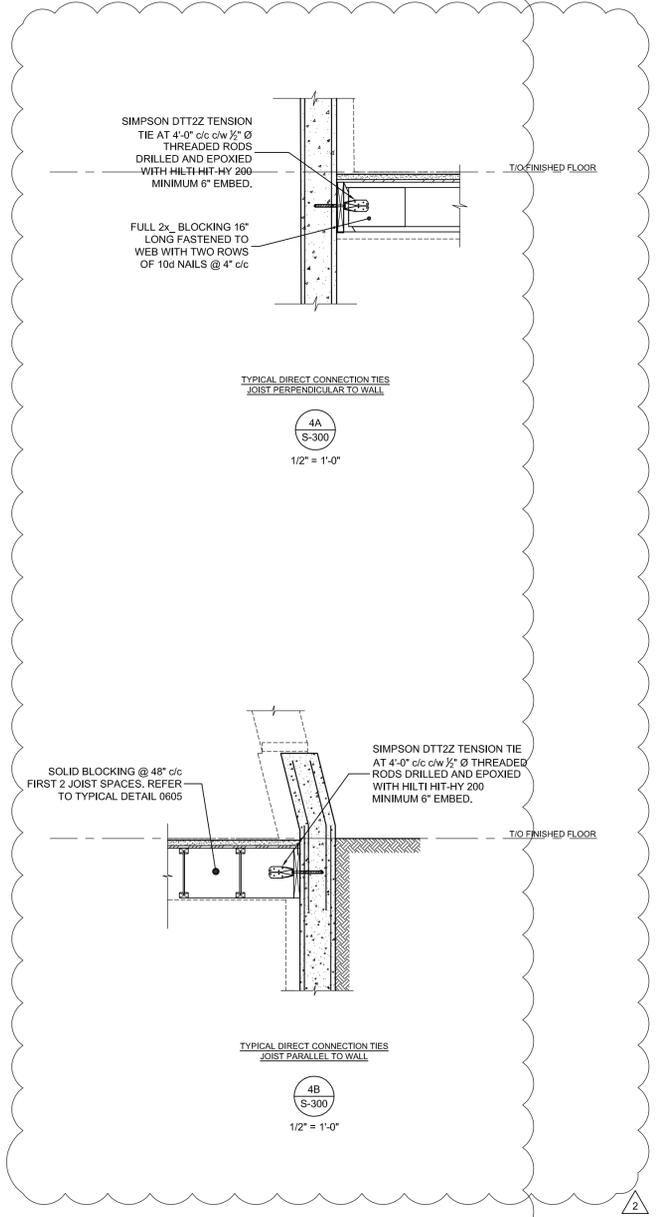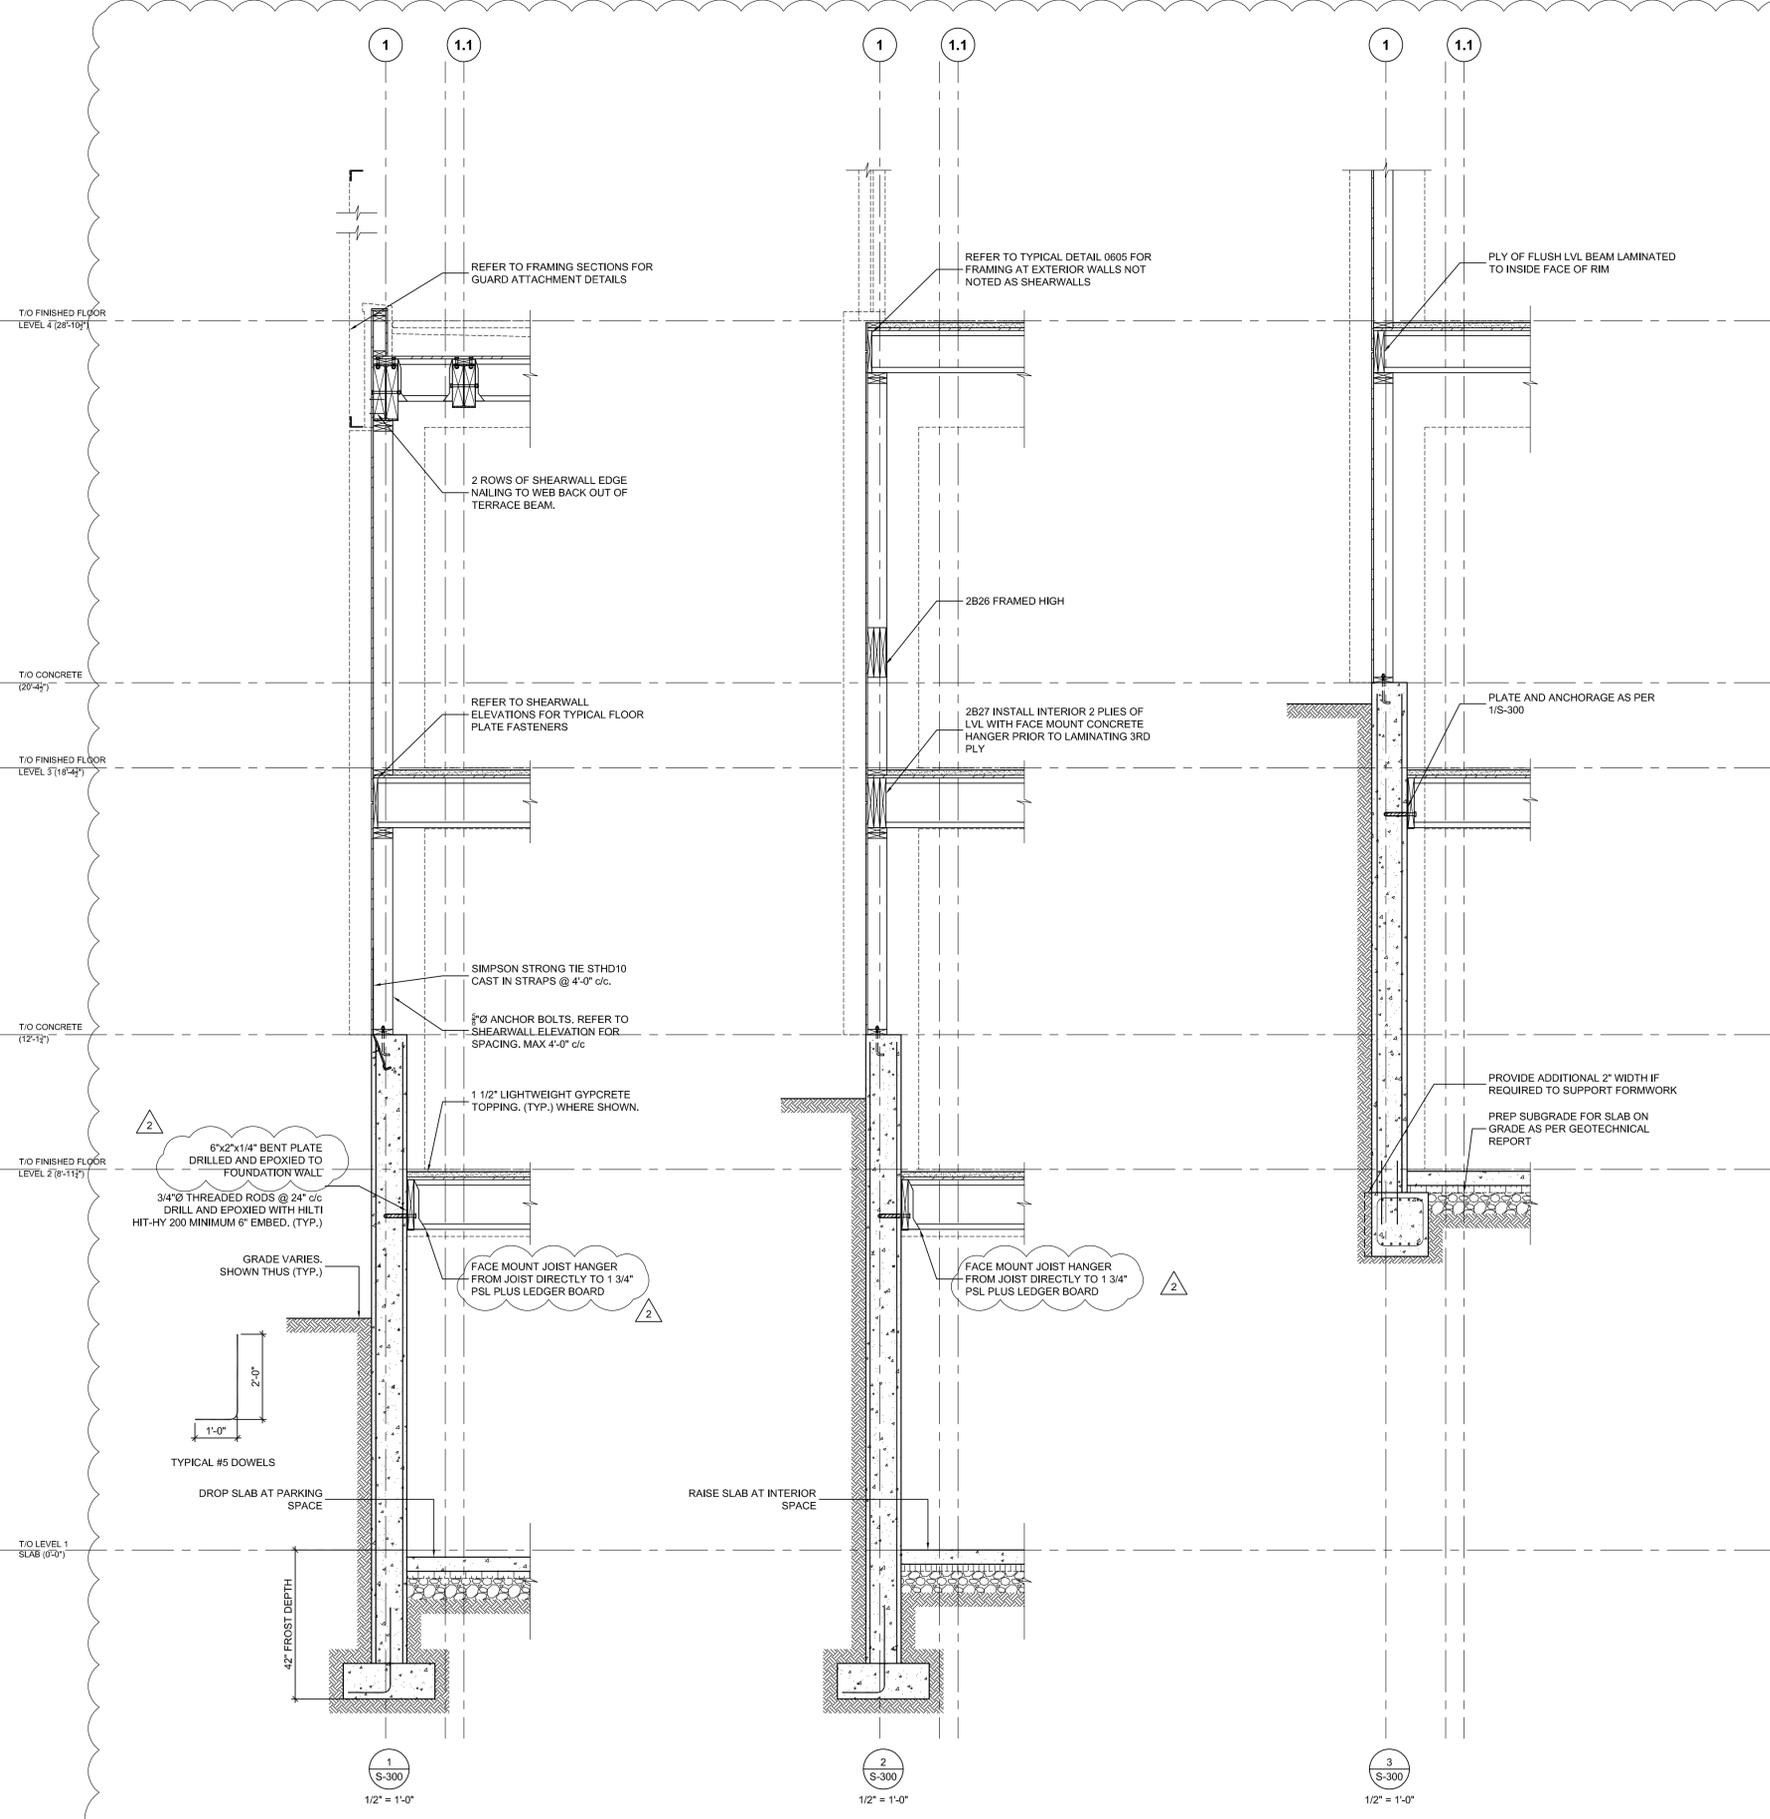

MARK	DATE	DESCRIPTION
△	2018.08.24	REVISED PERMIT SET
△	2018.06.26	ISSUED FOR PERMIT
△	2018.06.20	ISSUED FOR COORDINATION
△	2018.02.01	ISSUED FOR PERMIT
△	2017.12.13	ISSUED FOR INTERNAL COORD.
△	2017.12.02	ISSUED FOR COORDINATION
△	2017.11.22	ISSUED C GRADE COSTING
△	2017.11.07	INTERNAL COORDINATION

PROJECT NAME:
VILLAGE HOUSE AT LOT 71



PROJECT ADDRESS:
VILLAGE HOUSE LOT 71, SUMMIT POWDER MOUNTAIN

DRAWN: AVB
SCALE: AS NOTED

CHECKED: —
PROJECT NUMBER: 170450

SHEET TITLE:
WALL SECTIONS

S-300

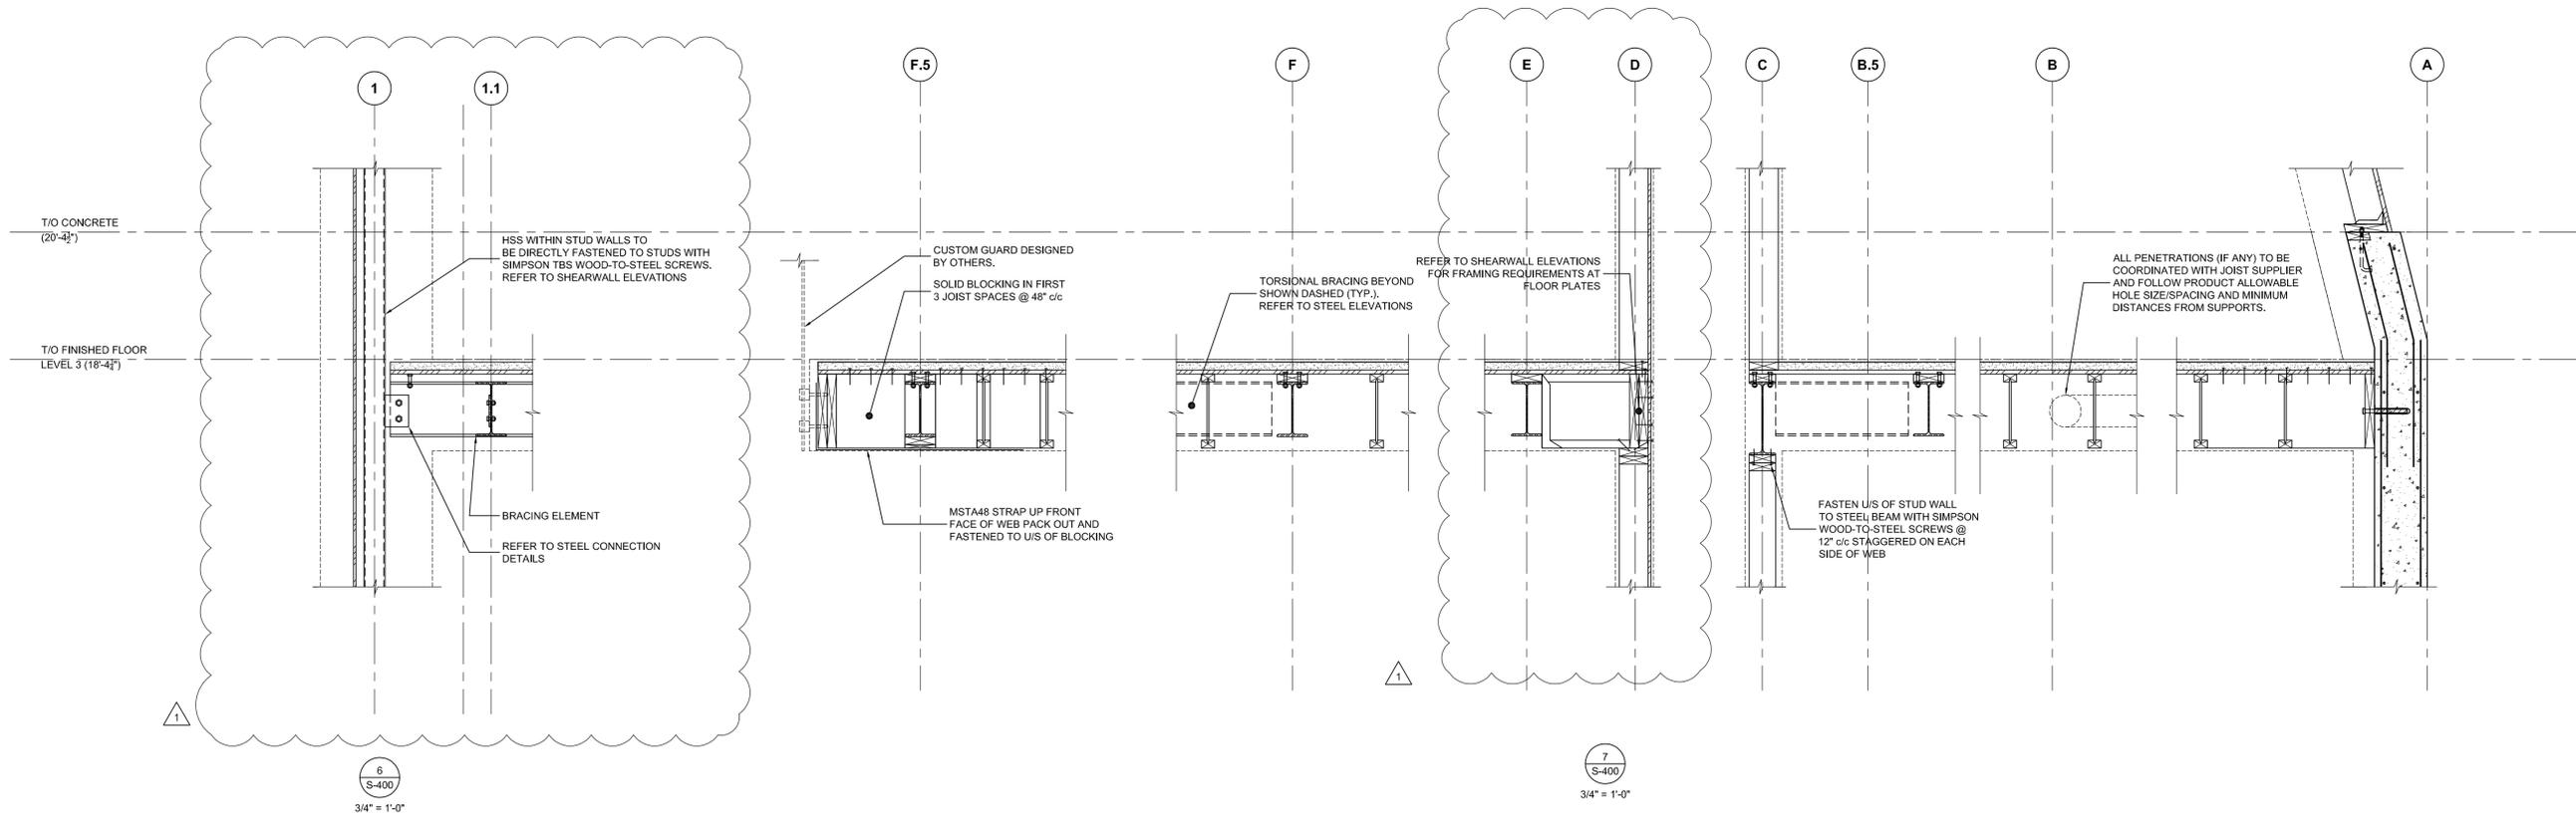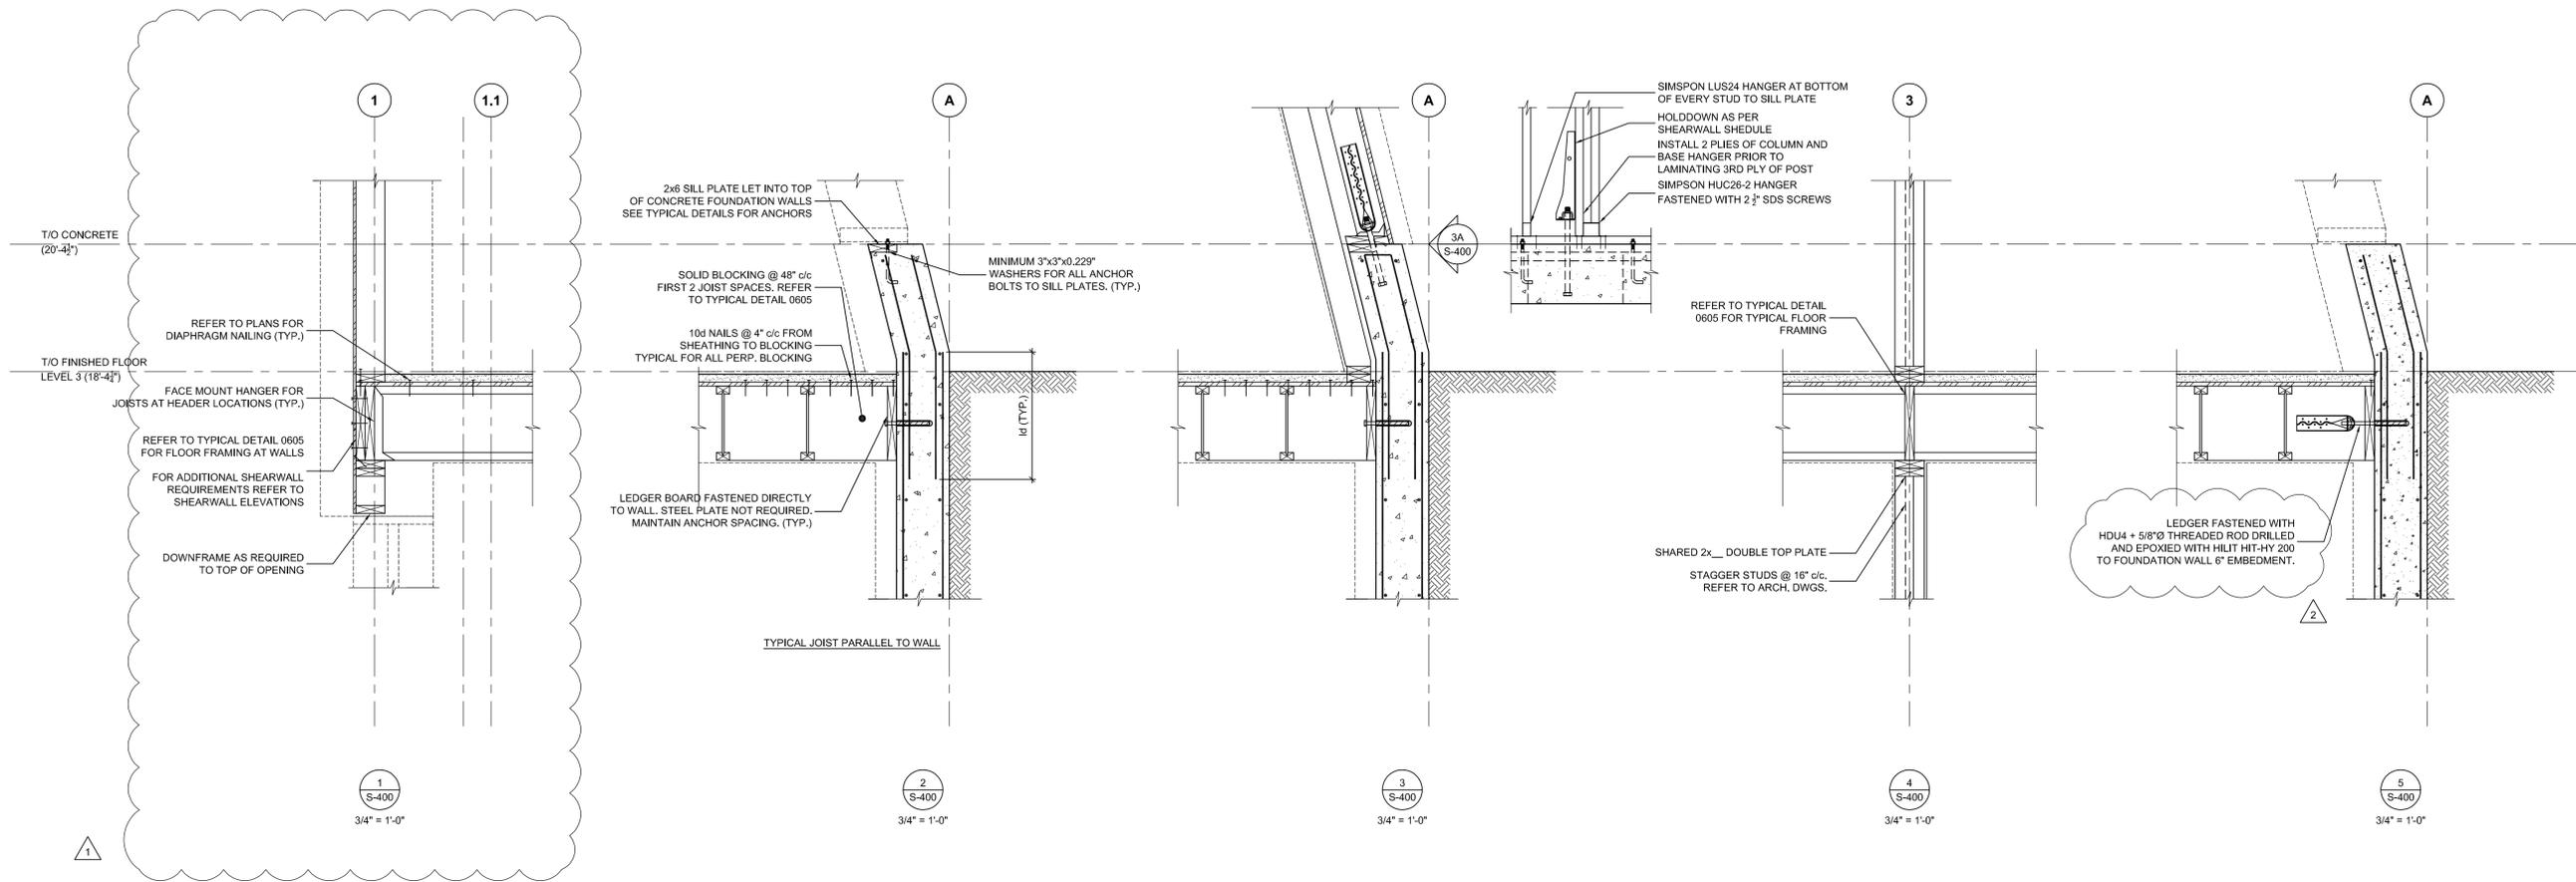

2018.08.24	REVISED PERMIT SET
2018.06.26	ISSUED FOR PERMIT
2018.06.20	ISSUED FOR COORDINATION
2018.02.01	ISSUED FOR PERMIT
2017.12.13	ISSUED FOR INTERNAL COORD.
2017.12.02	ISSUED FOR COORDINATION
2017.11.22	ISSUED C GRADE COSTING
2017.11.07	INTERNAL COORDINATION




PROJECT NAME:
VILLAGE HOUSE AT LOT 71

PROJECT ADDRESS:
VILLAGE HOUSE LOT 71, SUMMIT POWDER MOUNTAIN

DRAWN: AVB	CHECKED: —
SCALE: AS NOTED	PROJECT NUMBER: 170450

SHEET TITLE:
FRAMING SECTIONS

S-400

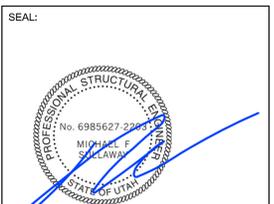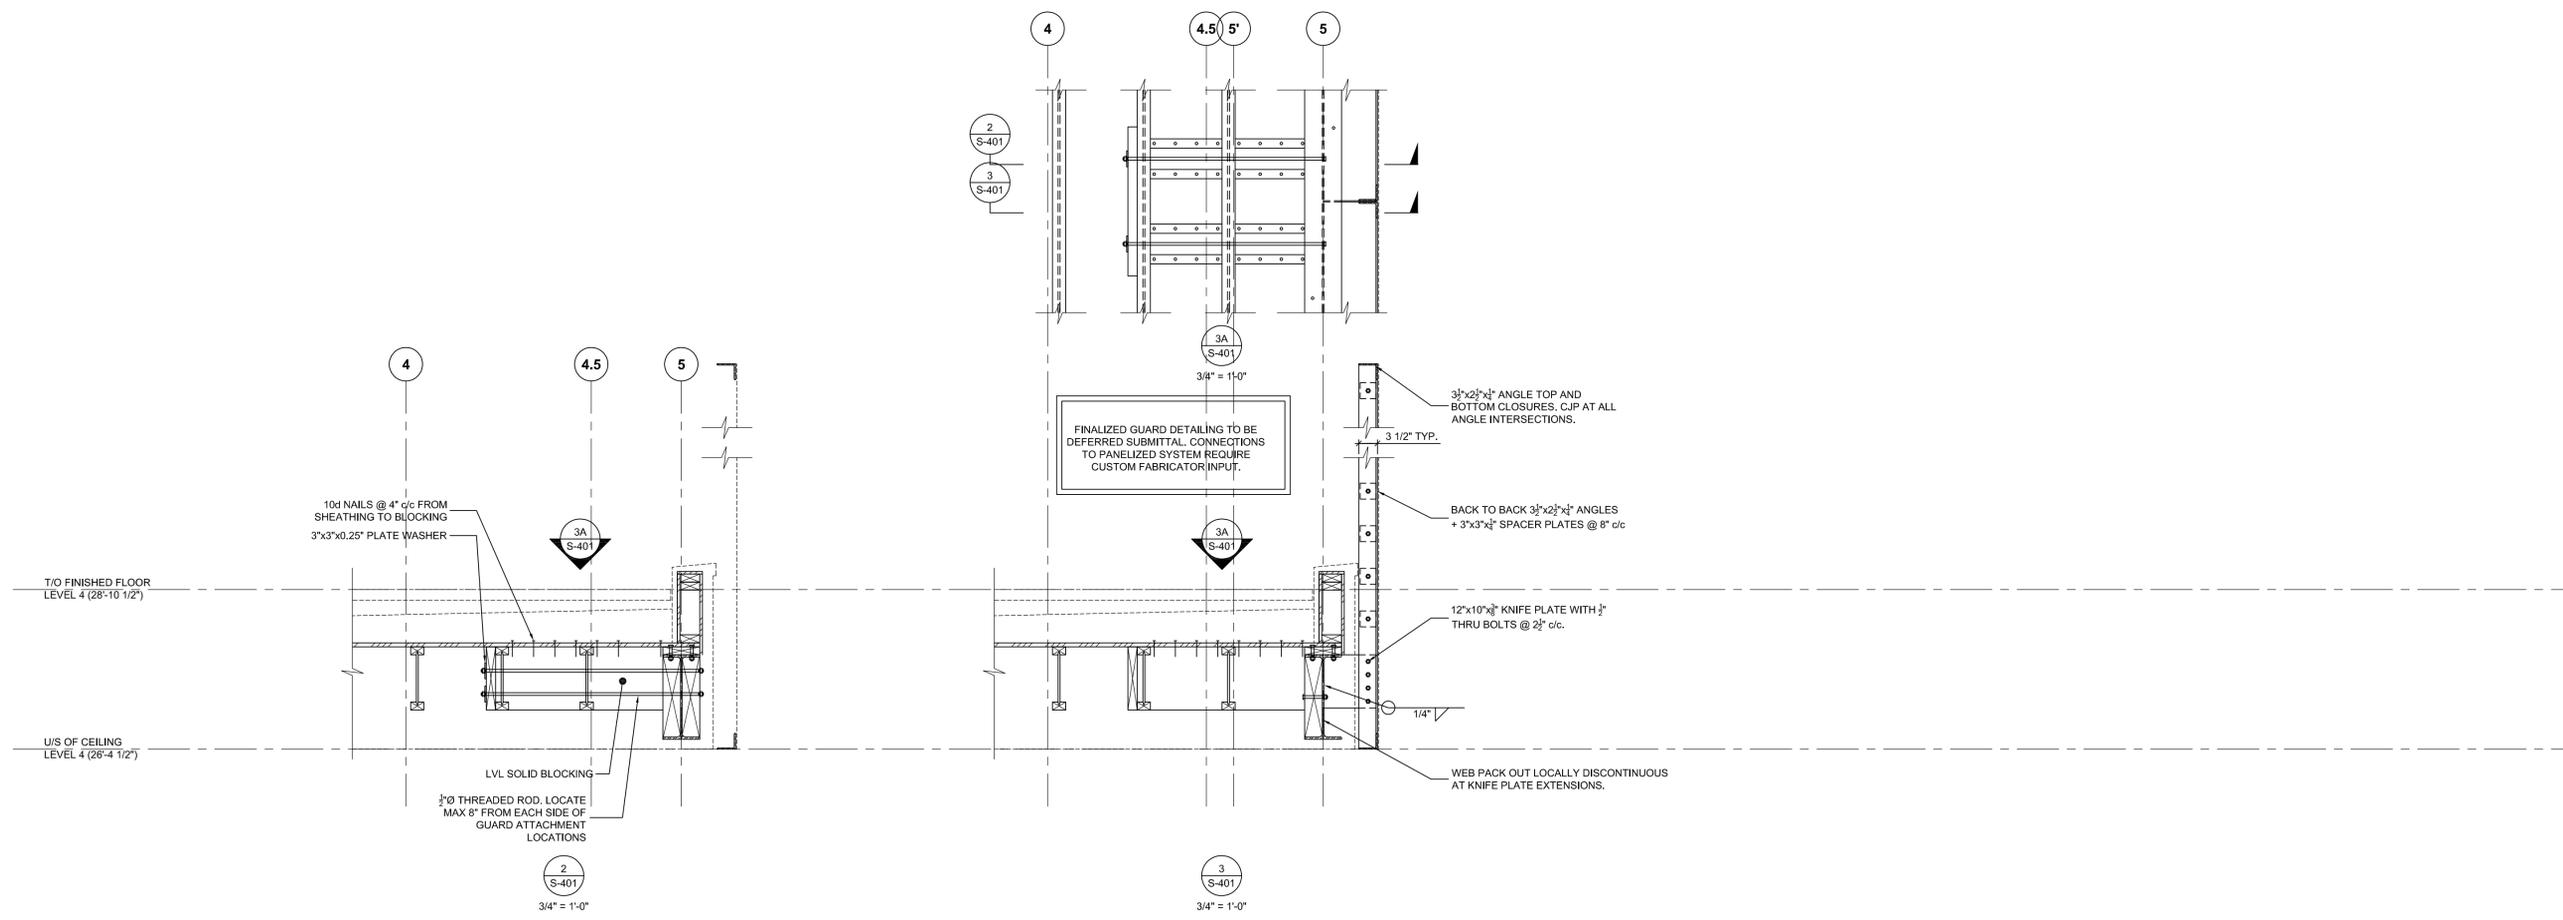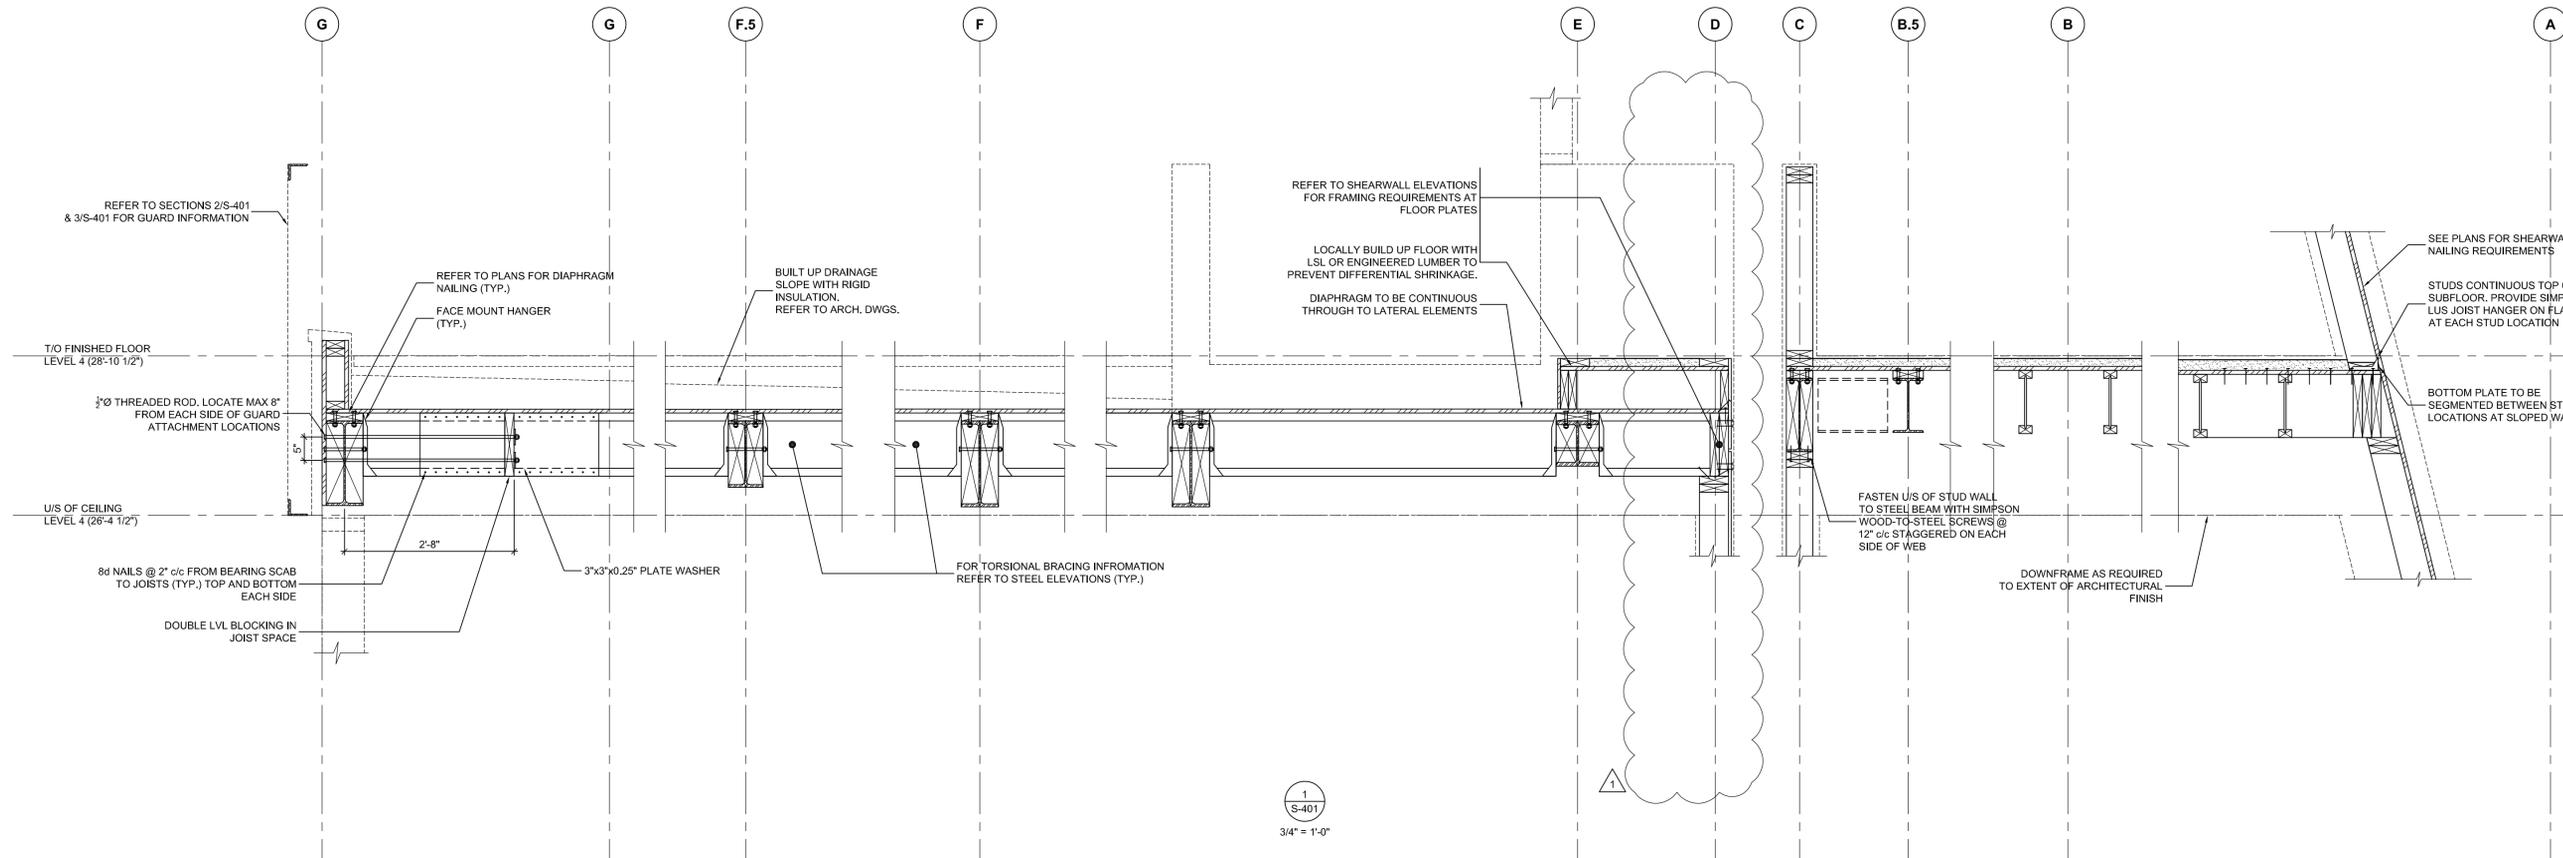

MARK	DATE	DESCRIPTION
△	2018.08.24	REVISED PERMIT SET
△	2018.06.26	ISSUED FOR PERMIT
	2018.06.20	ISSUED FOR COORDINATION
	2018.02.01	ISSUED FOR PERMIT
	2017.12.13	ISSUED FOR INTERNAL COORD.
	2017.12.02	ISSUED FOR COORDINATION
	2017.11.22	ISSUED C GRADE COSTING
	2017.11.07	INTERNAL COORDINATION

PROJECT NAME:
VILLAGE HOUSE AT LOT 71



PROJECT ADDRESS:
VILLAGE HOUSE LOT 71, SUMMIT POWDER MOUNTAIN

DRAWN: AVB
SCALE: AS NOTED

CHECKED: —
PROJECT NUMBER: 170450

SHEET TITLE:
FRAMING SECTIONS CONT'D

S-401

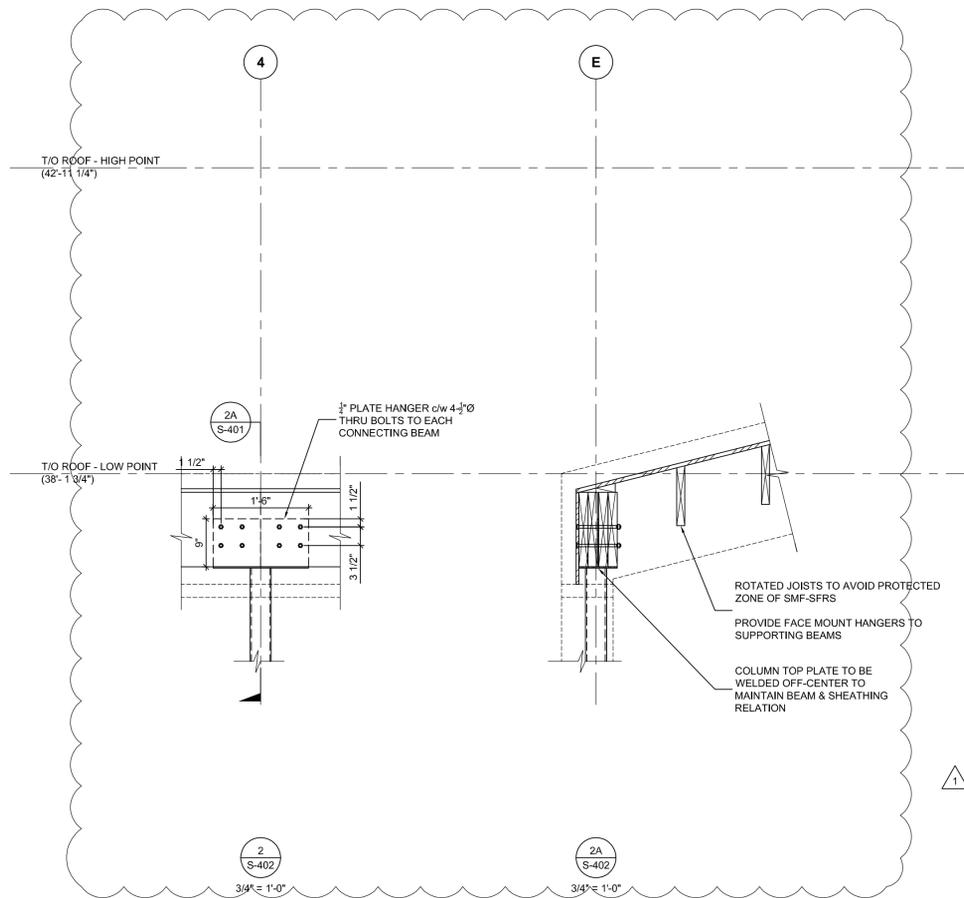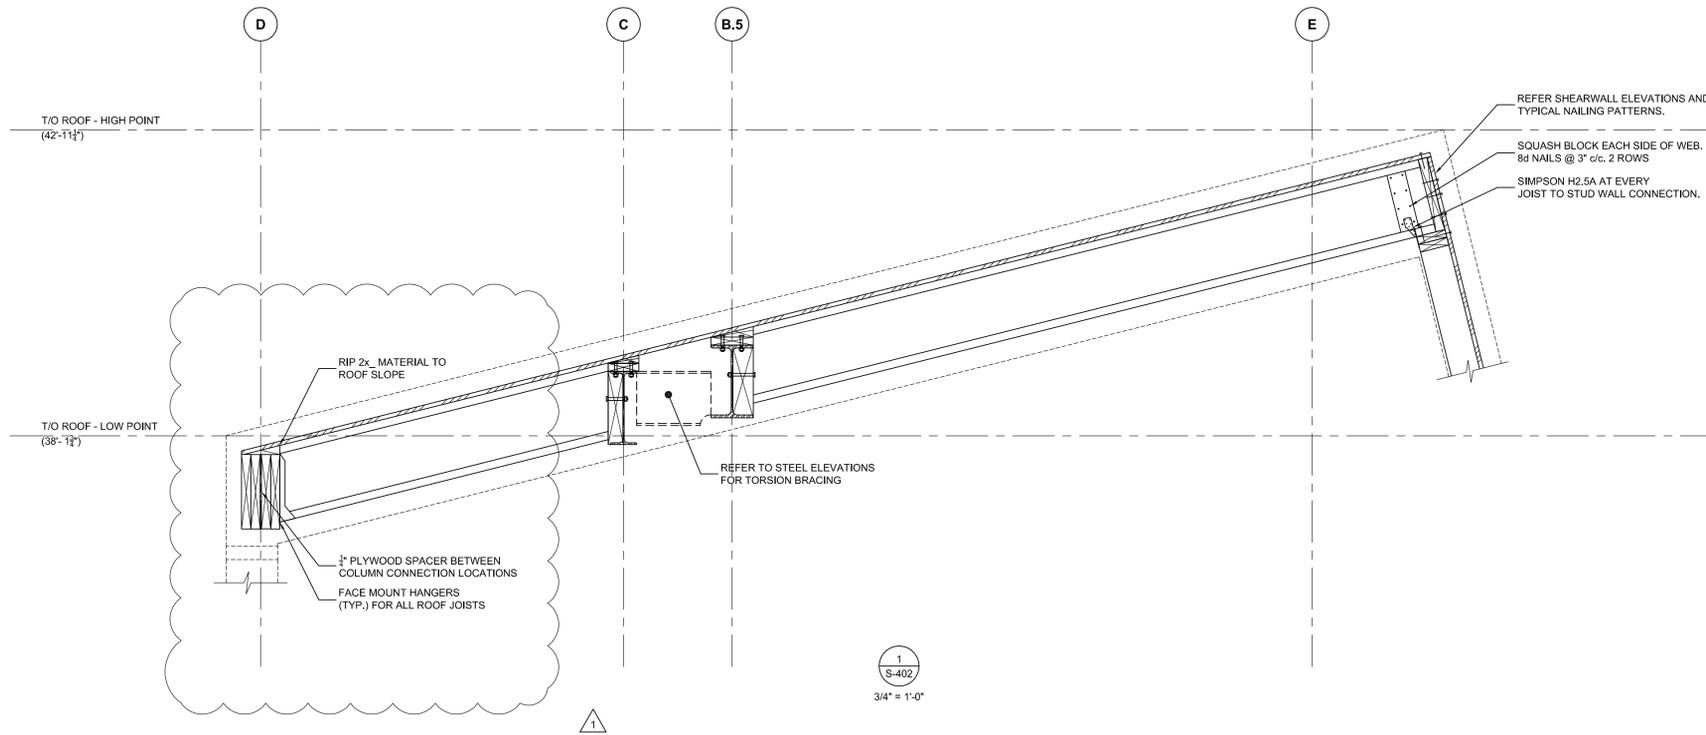

SEAL:



MARK	DATE	DESCRIPTION
△	2018.08.24	REVISED PERMIT SET
△	2018.06.26	ISSUED FOR PERMIT
	2018.06.20	ISSUED FOR COORDINATION
	2018.02.01	ISSUED FOR PERMIT
	2017.12.13	ISSUED FOR INTERNAL COORD.
	2017.12.02	ISSUED FOR COORDINATION
	2017.11.22	ISSUED C GRADE COSTING
	2017.11.07	INTERNAL COORDINATION

PROJECT NAME:
VILLAGE HOUSE AT LOT 71

PROJECT ADDRESS:
VILLAGE HOUSE LOT 71, SUMMIT POWDER MOUNTAIN

DRAWN: AVB	CHECKED: —
SCALE: AS NOTED	PROJECT NUMBER: 170450

SHEET TITLE:
FRAMING SECTIONS CONT'D

S-402