

STATE OF UTAH, DEPARTMENT OF ENVIRONMENTAL QUALITY, DIVISION OF WATER QUALITY  
195 North 1950 West, P.O. Box 144870, Salt Lake City, Utah 84114-4870 (801) 536-4300

**NOI** Notice of Intent (NOI) for Storm Water Discharges Associated with Construction Activity Under the UPDES General Permit UTRH92109 SEE REVERSE FOR INSTRUCTIONS

Submission of this Notice of Intent constitutes notice that the party(s) identified in Section I of this form intends to be authorized by UPDES General Permit No. UTRH92109 issued for storm water discharges associated with construction activity in the State of Utah. Becoming a permittee obligates such discharger to comply with the terms and conditions of the permit. ALL NECESSARY INFORMATION MUST BE PROVIDED ON THIS FORM.

**PERMIT PERIOD** Permit Start Date: 03/22/2019 Permit Expiration Date: 06/30/2019

**PERMIT TYPE** Construction General Permit (CGP, this permit covers any construction project): .....   
Common Plan Permit (this only covers single lot residential construction disturbing less than an acre): .....

Is this NOI seeking continuation for previously expired permit coverage at the same site? Y  N  If yes, what is the number of the previous permit coverage? Permit No. UTR

**I. OWNER INFORMATION**  
Owner Name: Lync Construction Phone: 801-710-2234  
Address: 1407 N Mountain Road Status of Owner: PRIVATE  
City: OGDEN State: UT Zip: 84404  
Contact Person: Pat Burns Phone: 801-710-2234

**GENERAL CONTRACTOR:** Lync Construction Phone: 801-710-2234  
Address: 407 N Mountain road Status of General Contractor: PRIVATE  
City: OGDEN State: UT Zip: 84404  
Contact Person: Pat Burns Phone: 801-710-2234


**II. FACILITY SITE / LOCATION INFORMATION**  
Name: Vaquero LOT 10  
Project No. (if any):  
Address: 707 S 7100 W County: WEBER  
City: WEBER COUNTY (UNINCORPORATED AREA) State: UT Zip: 84404  
Latitude: 0.00 Longitude: 0.00  
Method (check one):  USGS Topo Map, Scale  EPA Web site  GPS  Other  
Is the facility located in Indian Country? Y  N

**III. SITE INFORMATION**  
Municipal Separate Storm Sewer System (MS4) Operator Name: Weber County  
Receiving Water Body: Salt Lake guess this is known  this is a guess  (see <http://wq.deq.utah.gov/>)  
Estimate of distance to the nearest water body? 6 miles ft.  miles.   
Is the receiving water an impaired or high quality water body (see <http://wq.deq.utah.gov/>)? Yes  No   
List the Number of any other UPDES permits at the site:

**IV. THIS SECTION IS ONLY FOR PROJECTS INVOLVED IN DEVELOPMENT OF A SUBDIVISION.**  
List the lots proposed for the development (please add another sheet of paper if there is not enough room to list all lots).  
.5 Acres



# PLOT PLAN FOR LYNC CONST.

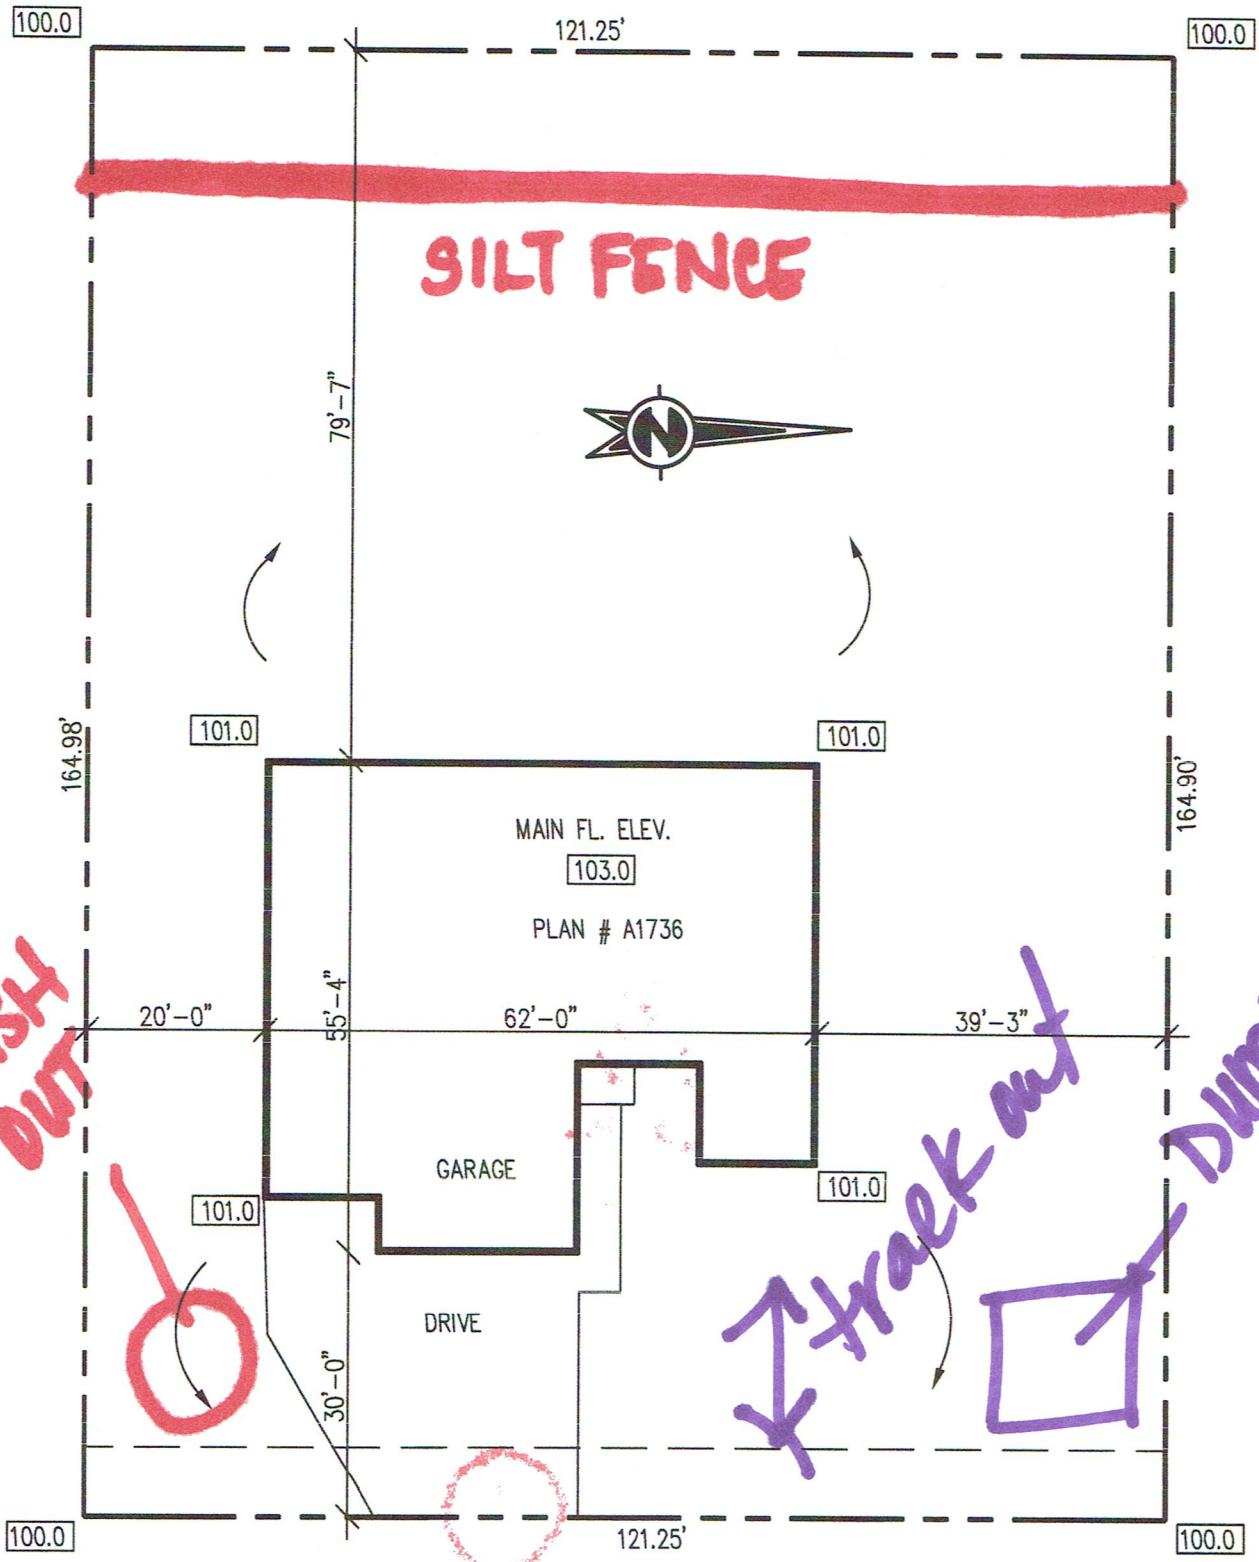

LOT # 10 VAQUERO VILLAGE

WEBER CO., UTAH

TYPE 'B' GRADING, 2% GRADE 10' AWAY FROM HOUSE

SCALE 1" = 20' - 0"

MAR. 2019