
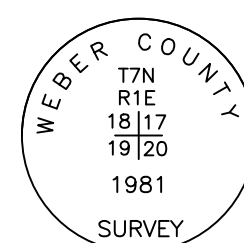


THIRTY-THREE HUNDRED EAST CHURCH SUBDIVISION 1ST AMENDMENT

AMENDING LOT 1 OF THIRTY-THREE HUNDRED EAST CHURCH SUBDIVISION AND PARCEL A OF MONTGOMERY'S PLACE


PART OF THE SOUTHWEST QUARTER OF SECTION 17, TOWNSHIP 7 NORTH, RANGE 1 EAST, SALT LAKE BASE & MERIDIAN, U.S. SURVEY, WEBER COUNTY, UTAH
JUNE, 2019

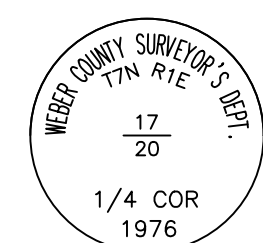

MONUMENT DETAIL 1
(NOT TO SCALE)

MONUMENT DETAIL 2
(NOT TO SCALE)

LOT 1, MONTGOMERY'S PLACE

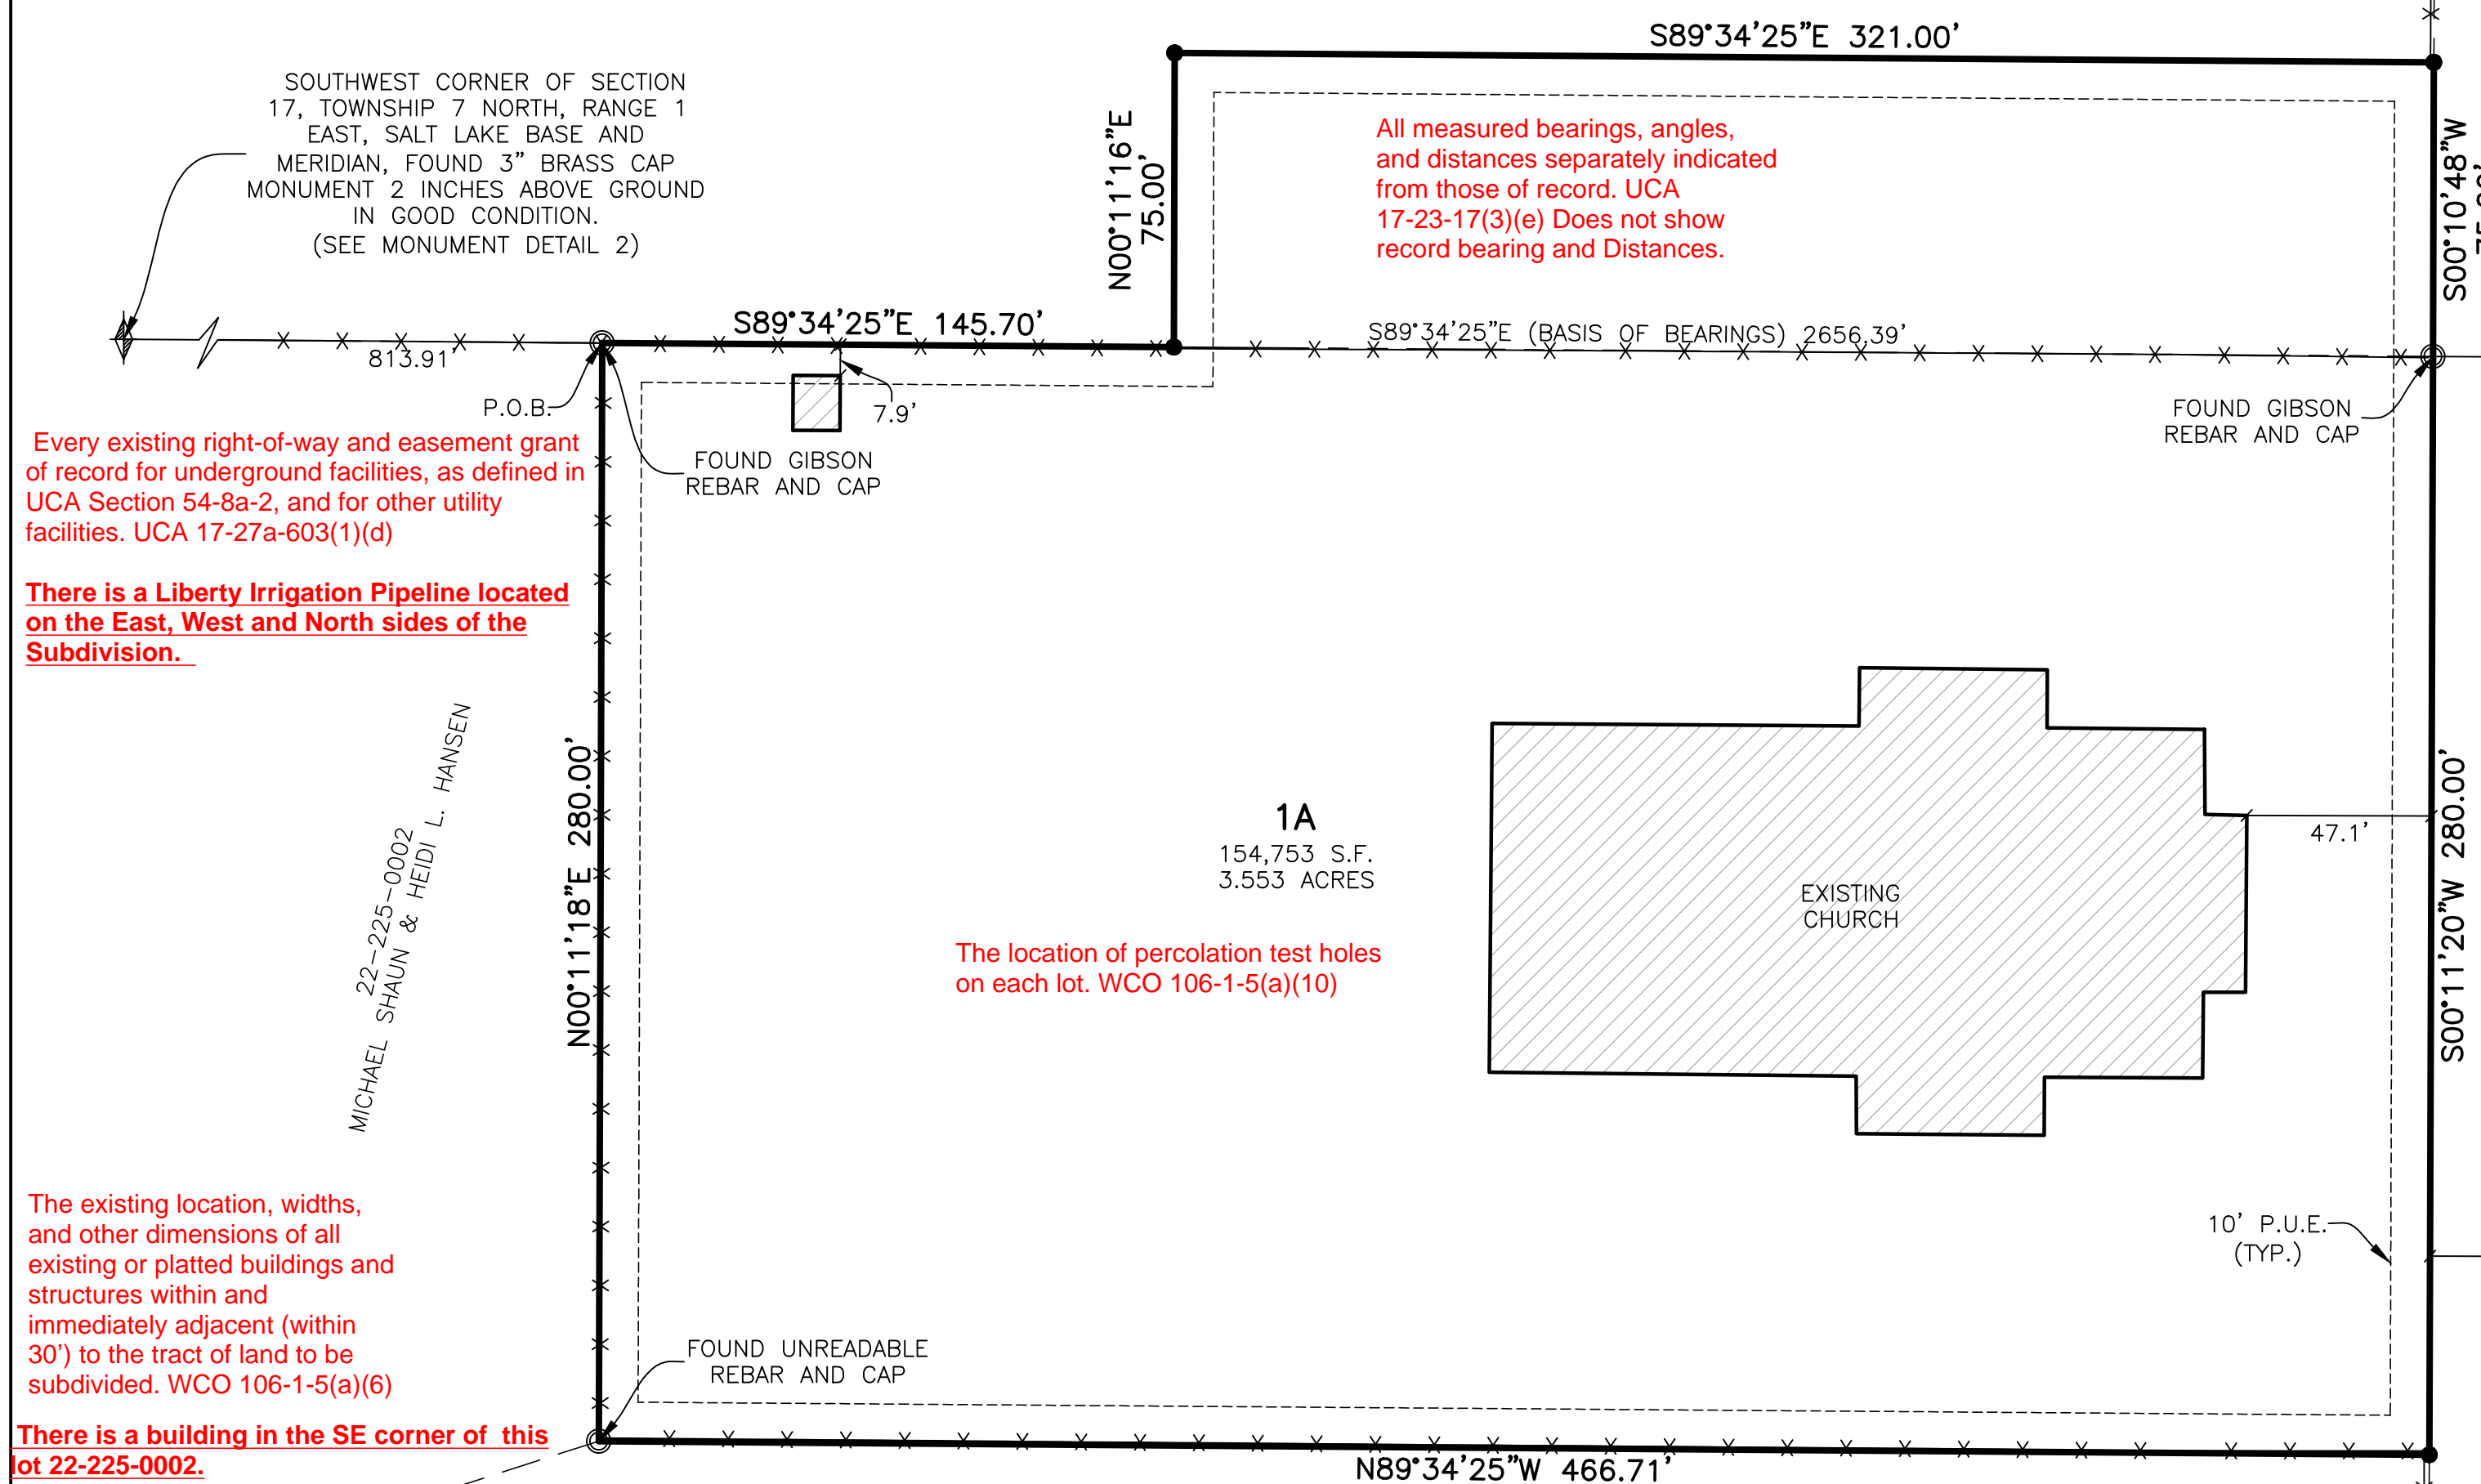

Every existing right-of-way and easement grant of record for underground facilities, as defined in UCA Section 54-8a-2, and for other utility facilities. UCA 17-27a-603(1)(d)

There is a Liberty Irrigation Pipeline located on the East, West and North sides of the Subdivision.

The existing location, widths, and other dimensions of all existing or platted buildings and structures within and immediately adjacent (within 30') to the tract of land to be subdivided. WCO 106-1-5(a)(6)

There is a building in the SE corner of this lot 22-225-0002.

Check preliminary title report to ensure all easements, boundary line agreements, or rights of way (subject to or together with) that are listed in the report are shown and/or identified on the plat. WCO 106-1-5(a)(13); WCO 106-1-8(c)(1)n


Need Preliminary Title report

All easements observed, recorded in the Recorder's Office, or included in a preliminary title report unless legally vacated by all easement holders. WCO 106-1-8(c)(1)m

Need Preliminary Title report

DEVELOPER.

CORPORATION OF THE PRESIDING BISHOP OF THE CHURCH OF JESUS CHRIST OF LATTER-DAY SAINTS
UTAH NORTH-PM OFFICE
435 NORTH WALL AVENUE
OGDEN, UT 84404
(801) 680-2006

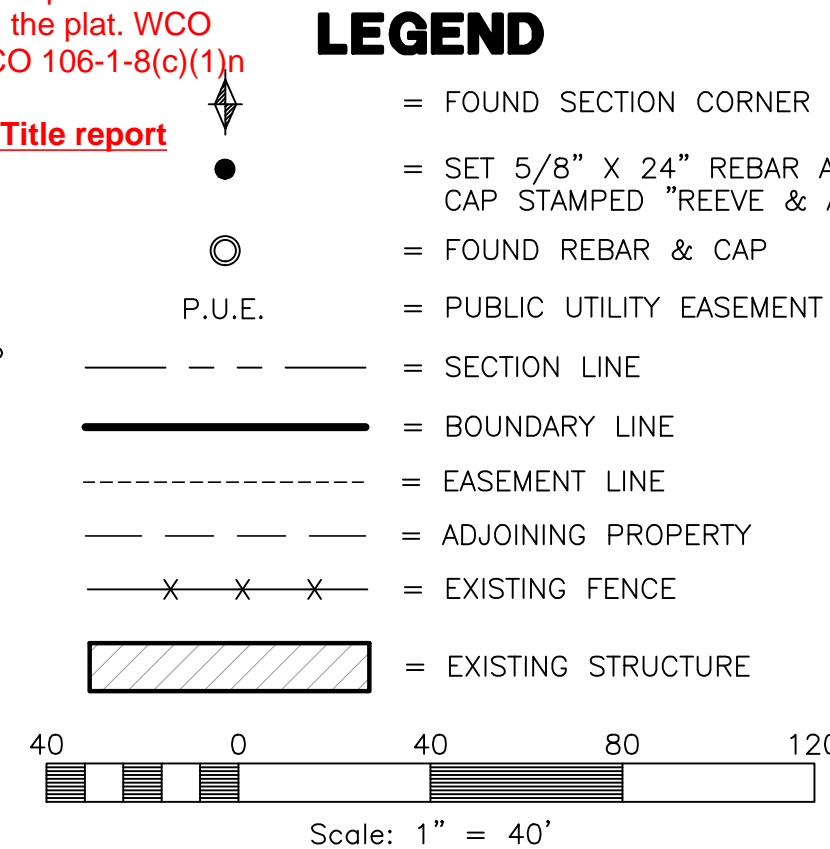


LEGEND

- FOUND SECTION CORNER
- SET 5/8" X 24" REBAR AND PLASTIC CAP STAMPED "REEVE & ASSOCIATES"
- FOUND REBAR & CAP
- P.U.E. = PUBLIC UTILITY EASEMENT
- SECTION LINE
- BOUNDARY LINE
- EASEMENT LINE
- ADJOINING PROPERTY
- EXISTING FENCE
- EXISTING STRUCTURE

Scale: 1" = 40'

NOTES

- DUE TO THE TOPOGRAPHY AND THE LOCATION OF THIS SUBDIVISION ALL OWNERS WILL ACCEPT RESPONSIBILITY FOR ANY STORM WATER RUNOFF FROM THE ROAD ADJACENT TO THIS PROPERTY UNTIL CURB AND GUTTER IS INSTALLED.
- AGRICULTURE IS THE PREFERRED USE IN THE AGRICULTURE ZONES. AGRICULTURAL OPERATIONS AS SPECIFIED IN THE LAND USE CODE FOR A PARTICULAR ZONE ARE PERMITTED AT ANY TIME INCLUDING THE OPERATION OF FARM MACHINERY AND NO ALLOWED AGRICULTURAL USE SHALL BE SUBJECT TO RESTRICTIONS ON THE BASIS THAT IT INTERFERES WITH ACTIVITIES OF FUTURE RESIDENTS OF THIS SUBDIVISION

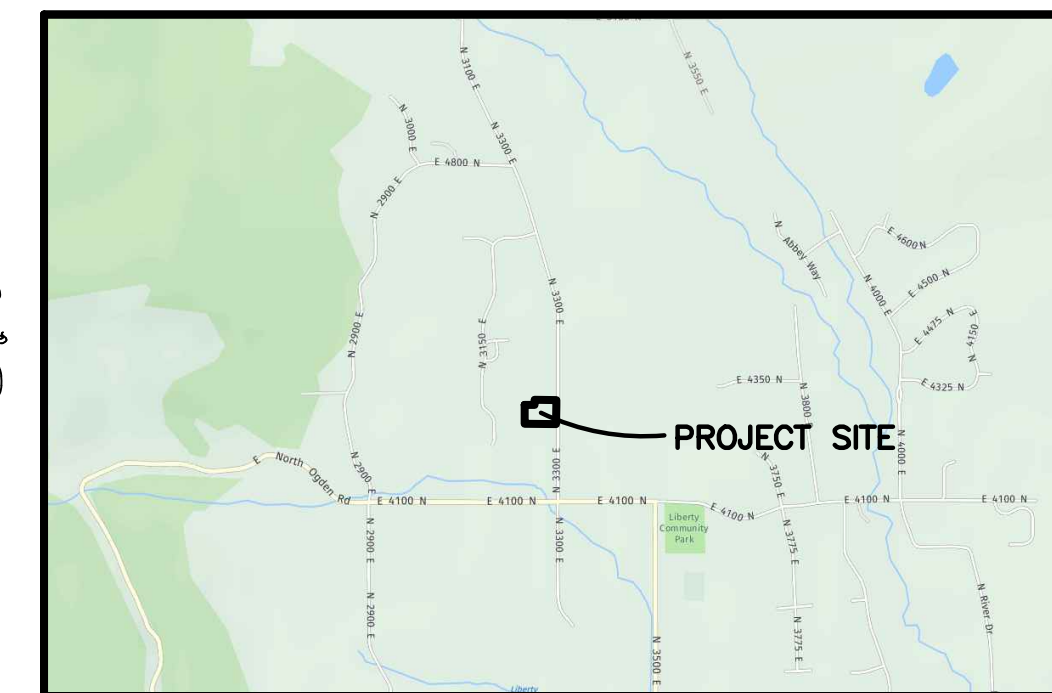

VICINITY MAP
(NOT TO SCALE)

SOUTH QUARTER CORNER OF SECTION 17, TOWNSHIP 7 NORTH, RANGE 1 EAST, SALT LAKE BASE AND MERIDIAN, FOUND 3" BRASS CAP MONUMENT 1 INCH ABOVE GROUND IN GOOD CONDITION. (SEE MONUMENT DETAIL 1)

The names, widths, lengths, bearings and curve data on centerlines of proposed streets and alleys. WCO 106-1-8(c)(1); UCA 17-27a-603(1)(b)

Please provide centerline for road, or show that street is parallel to property line adjoining the street.

BASIS OF BEARINGS

THE BASIS OF BEARINGS FOR THIS PLAT IS BETWEEN FOUND BRASS CAP MONUMENTS MARKING THE SOUTHWEST CORNER AND SOUTH QUARTER CORNER OF SECTION 17, TOWNSHIP 7 NORTH, RANGE 1 EAST, SALT LAKE BASE AND MERIDIAN, SHOWN HEREON AS: S89°34'25"E

NARRATIVE

THE PURPOSE OF THIS PLAT IS TO CREATE AN AMENDED PLAT BY AMENDING LOT 1 OF THIRTY-THREE HUNDRED EAST CHURCH SUBDIVISION AND PARCEL A OF MONTGOMERY'S PLACE. THE BOUNDARY WAS DETERMINED BY RETRACING THE TWO EXISTING SUBDIVISION MONUMENTS AND FROM FOUND REBAR AND CAPS AS SHOWN ON PLAT. ALL CORNERS NOT FOUND WERE SET WITH A 5/8" REBAR AND PLASTIC CAP STAMPED "REEVE & ASSOCIATES".

BOUNDARY DESCRIPTION

ALL OF LOT 1 OF THIRTY-THREE HUNDRED EAST CHURCH SUBDIVISION AND PARCEL A OF MONTGOMERY'S PLACE BEING MORE PARTICULARLY DESCRIBED AS FOLLOWS:

PART OF THE SOUTHWEST QUARTER OF SECTION 17, TOWNSHIP 7 NORTH, RANGE 1 EAST, SALT LAKE BASE & MERIDIAN, MORE PARTICULARLY DESCRIBED AS FOLLOWS:

BEGINNING AT THE NORTHWEST CORNER OF THIRTY-THREE HUNDRED EAST CHURCH SUBDIVISION, SAID POINT BEING S89°34'25"E 813.91 FEET FROM THE SOUTHWEST CORNER OF SAID SECTION 17; THENCE S89°34'25"E ALONG THE NORTH LINE OF LOT 1 OF THIRTY-THREE HUNDRED EAST CHURCH SUBDIVISION, 145.70 FEET TO THE SOUTHWEST CORNER OF PARCEL A OF MONTGOMERY'S PLACE; THENCE N00°11'16"E ALONG THE WEST LINE OF SAID MONTGOMERY'S PLACE, 75.00 FEET TO THE NORTHWEST CORNER OF SAID MONTGOMERY'S PLACE; THENCE S89°34'25"E ALONG THE NORTH LINE OF SAID MONTGOMERY'S PLACE, 321.00 FEET TO THE NORTHEAST CORNER OF SAID MONTGOMERY'S PLACE AND THE WESTERLY RIGHT OF WAY LINE OF 3300 EAST STREET; THENCE ALONG SAID WESTERLY RIGHT OF WAY LINE THE FOLLOWING TWO COURSES: (1) S00°10'48"W 75.00 FEET; AND (2) S00°11'20"W 280.00 FEET TO THE SOUTHWEST CORNER OF LOT 1 OF THIRTY-THREE HUNDRED EAST CHURCH SUBDIVISION; THENCE N89°34'25"W ALONG THE SOUTH LINE OF SAID THIRTY-THREE HUNDRED EAST CHURCH SUBDIVISION, 466.71 FEET TO THE SOUTHWEST CORNER OF SAID THIRTY-THREE HUNDRED EAST CHURCH SUBDIVISION; THENCE N00°11'18"E ALONG THE WEST LINE OF SAID THIRTY-THREE HUNDRED EAST CHURCH SUBDIVISION, 280.00 FEET TO THE POINT OF BEGINNING.

CONTAINING 154,753 SQUARE FEET OR 3.553 ACRES MORE OR LESS

SURVEYOR'S CERTIFICATE

I, **TREVOR J. HATCH**, DO HEREBY CERTIFY THAT I AM A PROFESSIONAL LAND SURVEYOR IN THE STATE OF UTAH IN ACCORDANCE WITH TITLE 58, CHAPTER 22, PROFESSIONAL ENGINEERS AND LAND SURVEYORS ACT; AND THAT I HAVE COMPLETED A SURVEY OF THE PROPERTY DESCRIBED ON THIS PLAT IN ACCORDANCE WITH SECTION 17-23-17 AND HAVE VERIFIED ALL MEASUREMENTS, AND HAVE PLACED MONUMENTS AS REPRESENTED ON THIS PLAT, AND THAT THIS PLAT OF **THIRTY-THREE HUNDRED EAST CHURCH SUBDIVISION 1ST AMENDMENT** IN **WEBER COUNTY**, UTAH, HAS BEEN DRAWN CORRECTLY TO THE DESIGNATED SCALE AND IS A TRUE AND CORRECT REPRESENTATION OF THE HEREIN DESCRIBED LANDS INCLUDED IN SAID SUBDIVISION, BASED UPON DATA COMPILED FROM RECORDS IN THE **WEBER COUNTY** RECORDER'S OFFICE AND FROM SAID SURVEY MADE BY ME ON THE GROUND. I FURTHER CERTIFY THAT THE REQUIREMENTS OF ALL APPLICABLE STATUTES AND ORDINANCES OF **WEBER COUNTY** CONCERNING ZONING REQUIREMENTS REGARDING LOT MEASUREMENTS HAVE BEEN COMPLIED WITH.

SIGNED THIS _____ DAY OF _____, 20____.

9031945

UTAH LICENSE NUMBER

OWNERS DEDICATION AND CERTIFICATION

WE THE UNDERSIGNED OWNERS OF THE HEREIN DESCRIBED TRACT OF LAND, DO HEREBY SET APART AND SUBDIVIDE THE SAME INTO LOTS AS SHOWN ON THE PLAT AND NAME SAID TRACT **THIRTY-THREE HUNDRED EAST CHURCH SUBDIVISION 1ST AMENDMENT**, AND GRANT AND DEDICATE A PERPETUAL RIGHT AND EASEMENT OVER, UPON AND UNDER THE LANDS DESIGNATED HEREON AS PUBLIC UTILITY, STORM WATER DETENTION PONDS DRAINAGE EASEMENTS AND CANAL MAINTENANCE EASEMENT, THE SAME TO BE USED FOR THE INSTALLATION MAINTENANCE AND OPERATION OF PUBLIC UTILITY SERVICE LINE, STORM DRAINAGE FACILITIES, IRRIGATION CANALS OR FOR THE PERPETUAL PRESERVATION OF WATER CHANNELS IN THEIR NATURAL STATE WHICHEVER IS APPLICABLE AS MAY BE AUTHORIZED BY THE GOVERNING AUTHORITY, WITH NO BUILDINGS OR STRUCTURES BEING ERRECTED WITHIN SUCH EASEMENTS.

SIGNED THIS _____ DAY OF _____, 20____.

FOR: MONTGOMERY ACRES LLC

JARED MONTGOMERY

FOR: CORPORATION OF THE PRESIDING BISHOP OF THE CHURCH OF JESUS CHRIST OF LATTER-DAY SAINTS

ACKNOWLEDGMENT

STATE OF UTAH)
COUNTY OF _____)

ON THE _____ DAY OF _____, 20____, PERSONALLY APPEARED BEFORE ME, THE UNDERSIGNED NOTARY PUBLIC, _____ (AND) _____ BEING BY ME DULY SWORN, ACKNOWLEDGED TO ME THEY ARE _____ AND _____ OF SAID LIMITED LIABILITY COMPANY AND THAT THEY SIGNED THE ABOVE OWNER'S DEDICATION AND CERTIFICATION FREELY, VOLUNTARILY, AND IN BEHALF OF SAID LIMITED LIABILITY COMPANY FOR THE PURPOSES THEREIN MENTIONED.

COMMISSION EXPIRES _____

NOTARY PUBLIC

ACKNOWLEDGMENT

STATE OF UTAH)
COUNTY OF _____)

ON THE _____ DAY OF _____, 20____, PERSONALLY APPEARED BEFORE ME, THE UNDERSIGNED NOTARY PUBLIC, _____ (AND) _____ BEING BY ME DULY SWORN, ACKNOWLEDGED TO ME THEY ARE _____ AND _____ OF SAID CORPORATION AND THAT THEY SIGNED THE ABOVE OWNER'S DEDICATION AND CERTIFICATION FREELY, VOLUNTARILY, AND IN BEHALF OF SAID CORPORATION FOR THE PURPOSES THEREIN MENTIONED.

COMMISSION EXPIRES _____

NOTARY PUBLIC

Project Info.

Surveyor: **T. HATCH**
Designer: **N. ANDERSON**
Begin Date: **06-26-19**
Name: **MONTGOMERY'S PLACE**
Number: **7207-01**
Revision: _____
Scale: **1"=40'**
Checked: _____



Reeve & Associates, Inc.
5160 S 1500 W, RIVERDALE, UTAH 84405
TEL: (801) 621-3100 FAX: (801) 621-2666 www.reeve-associ.com

WEBER COUNTY PLANNING COMMISSION APPROVAL

THIS IS TO CERTIFY THAT THIS SUBDIVISION PLAT WAS DULY APPROVED BY THE WEBER COUNTY PLANNING COMMISSION. SIGNED THIS _____ DAY OF _____, 20____.

CHAIRMAN, WEBER COUNTY PLANNING COMMISSION

WEBER COUNTY ENGINEER

I HEREBY CERTIFY THAT THE REQUIRED PUBLIC IMPROVEMENT STANDARDS AND DRAWINGS FOR THIS SUBDIVISION CONFORM WITH THE COUNTY STANDARDS AND THE AMOUNT OF THE FINANCIAL GUARANTEE IS SUFFICIENT FOR THE INSTALLATION OF THESE IMPROVEMENTS.

WEBER COUNTY ENGINEER

WEBER COUNTY COMMISSION ACCEPTANCE

THIS IS TO CERTIFY THAT THIS SUBDIVISION PLAT, THE DEDICATION OF STREETS AND OTHER PUBLIC WAYS AND FINANCIAL GUARANTEE OF PUBLIC IMPROVEMENTS ASSOCIATED WITH THIS SUBDIVISION, THEREON ARE HEREBY APPROVED AND ACCEPTED BY THE COMMISSIONERS OF WEBER COUNTY, UTAH. SIGNED THIS _____ DAY OF _____, 20____.

CHAIRMAN, WEBER COUNTY COMMISSION

ATTEST TITLE

WEBER COUNTY SURVEYOR

I HEREBY CERTIFY THAT THE WEBER COUNTY SURVEYOR'S OFFICE HAS REVIEWED THIS PLAT AND ALL CONDITIONS FOR APPROVAL BY THIS OFFICE HAVE BEEN SATISFIED. THE APPROVAL OF THIS PLAT BY THE WEBER COUNTY SURVEYOR DOES NOT RELIEVE THE LICENSED LAND SURVEYOR WHO EXECUTED THIS PLAT FROM THE RESPONSIBILITIES AND/OR LIABILITIES ASSOCIATED THEREWITH. SIGNED THIS _____ DAY OF _____, 20____.

WEBER COUNTY SURVEYOR

WEBER COUNTY ATTORNEY

I HAVE EXAMINED THE FINANCIAL GUARANTEE AND OTHER DOCUMENTS ASSOCIATED WITH THIS SUBDIVISION PLAT, AND IN MY OPINION THEY CONFORM WITH THE COUNTY ORDINANCE APPLICABLE THERETO AND NOW IN FORCE AND AFFECT. SIGNED THIS _____ DAY OF _____, 20____.

WEBER COUNTY ATTORNEY

WEBER-MORGAN HEALTH DEPARTMENT

I HEREBY CERTIFY THAT THE SOILS, PERCOLATION RATES, AND SITE CONDITIONS FOR THIS SUBDIVISION HAVE BEEN INVESTIGATED BY THIS OFFICE AND ARE APPROVED FOR ON-SITE WASTEWATER DISPOSAL SYSTEMS. SIGNED THIS _____ DAY OF _____, 20____.

DIRECTOR, WEBER-MORGAN HEALTH DEPARTMENT

Weber County Recorder

Entry No. _____ Fee Paid _____
And Recorded, _____
At _____ In Book _____
Of The Official Records, Page _____
Recorded For: _____

Weber County Recorder

Deputy.