
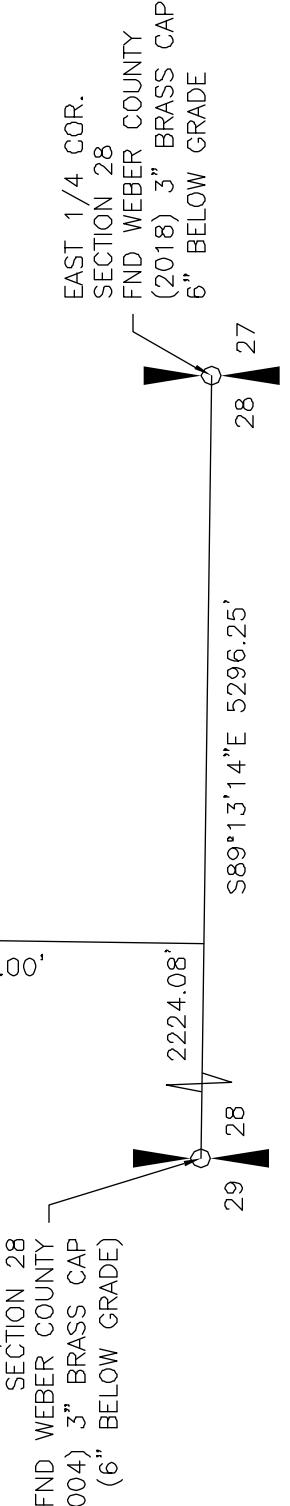
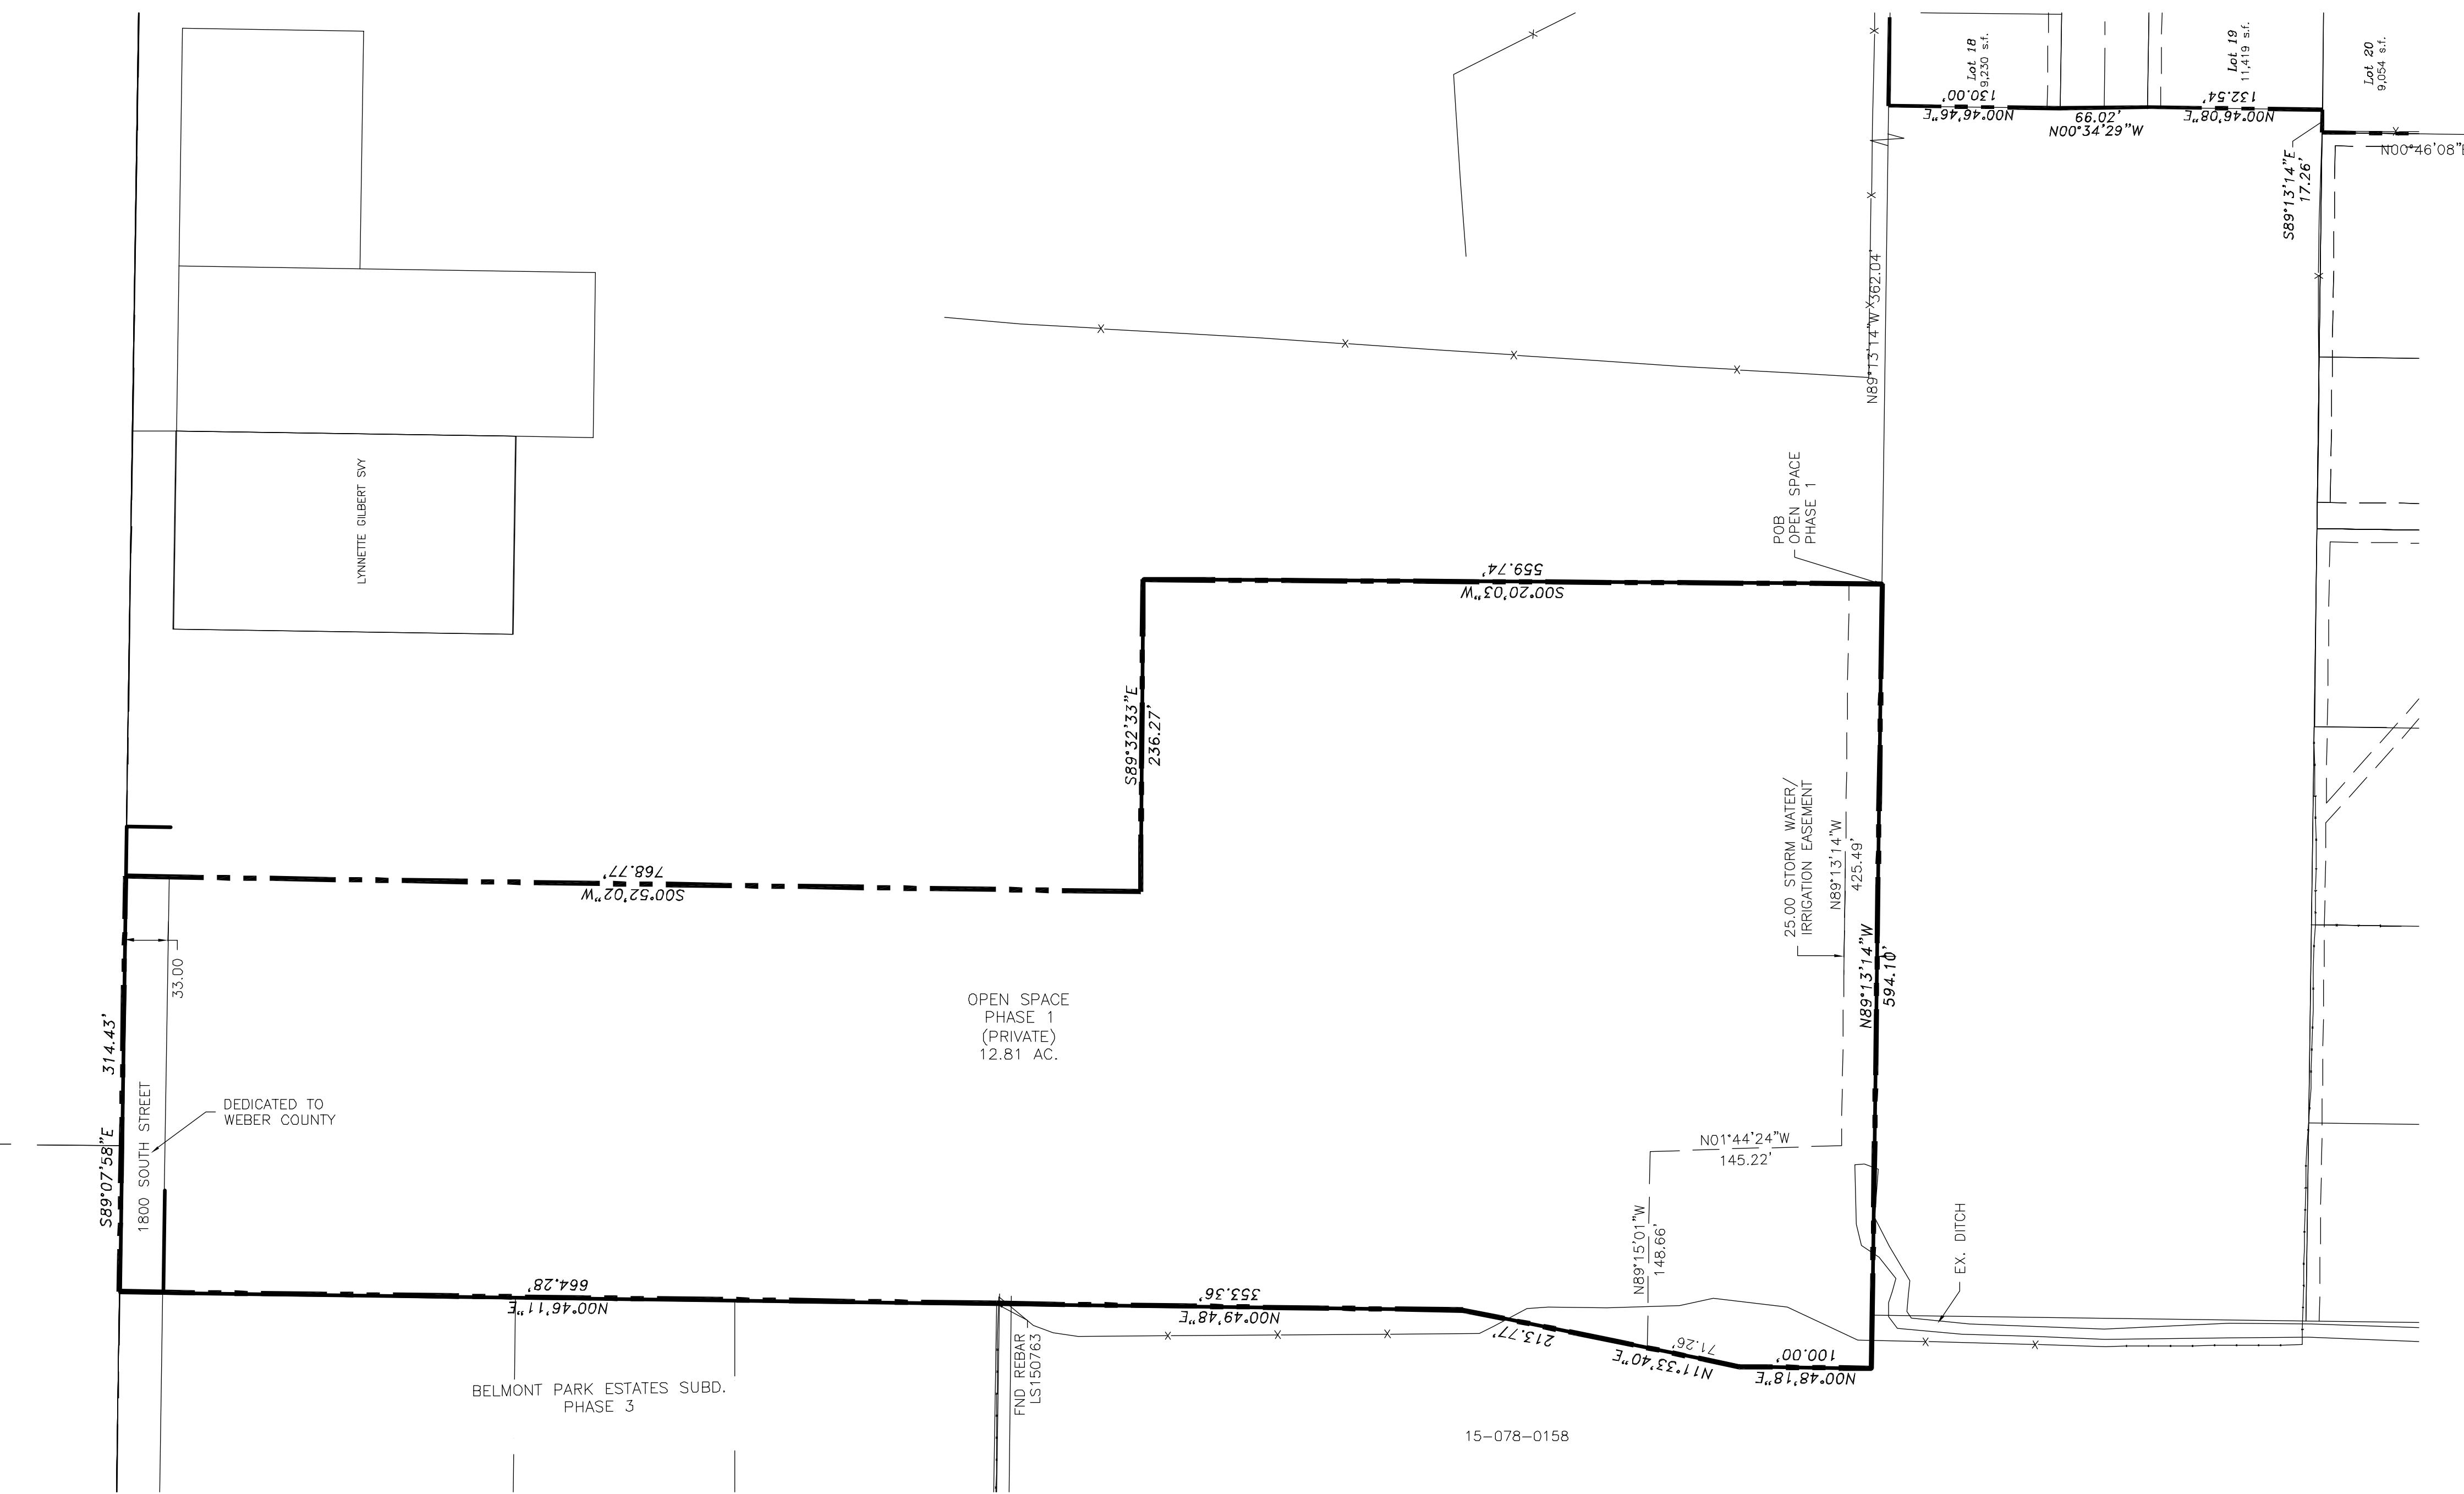


TAYLOR LANDING PHASE 1A  
A CLUSTER SUBDIVISION

PART OF THE NORTHWEST QUARTER OF SECTION 28,  
TOWNSHIP 6 NORTH, RANGE 2 WEST,  
SALT LAKE BASELINE AND MERIDIAN  
WEBER COUNTY, UTAH

FINAL PLAT

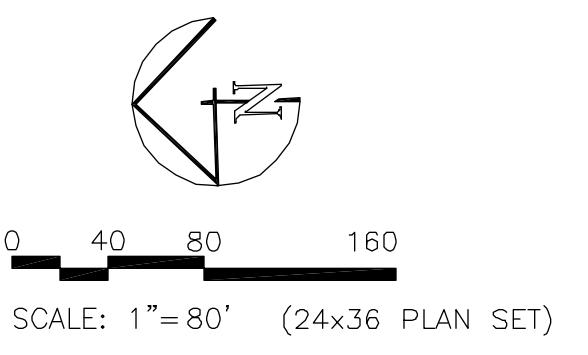


**OPEN SPACE PHASE I BOUNDARY DESCRIPTION**  
Part of the East Half of the Northwest Quarter of Section 28, Township 6 North, Range 2 West of the Salt Lake Base and Meridian described as follows:  
Commencing at the West Quarter Corner of Section 28, Township 6 North, Range 2 West of the Salt Lake Base and Meridian monumented with a Brass Cap; thence S 89°13'14" E 2224.08 feet along the south line of the Northwest Quarter of said Section 28; thence N 00°46'08"E 1001.00 feet; thence S 89°13'14" E 17.26 feet; thence N 00°46'08" E 132.54 feet; thence N 00°34'29" W 66.02 feet; thence N 00°46'46" E 130.00 feet; N 89°13'14" W 362.04 feet to the POINT OF BEGINNING and running thence N 89°13'14" W 594.10 feet; thence N 00°48'18" E 100.00 feet; thence N 11°33'40" E 213.77 feet; thence N 00°49'48" E 353.36 feet to the Southeast Corner of Belmont Park Estates Subdivision, Phase 3; thence S 89°07'58" E 314.43 feet along the north line of the Northwest Quarter of said Section 28; thence S 00°52'02" W 768.77 feet; thence S 89°32'33" E 236.27 feet; thence S 00°20'03" W 559.74 feet to the point of beginning, containing 12.81 acres, more or less.

**NOTES:**

Taylor Landing Overall Subdivision  
TOTAL AREA: 109.63 ACRES  
PUBLIC R-O-W: 13.55 ACRES  
NET DEVELOPABLE GROUND: 96.08 ACRES  
NET OPEN SPACE: 55.97 ACRES (58.25%)

PHASE 1 (INCLUDES PH1A AND FUTURE PH1B)  
TOTAL AREA: 12.81 ACRES  
PUBLIC R-O-W: 3.62 ACRES  
NET DEVELOPABLE GROUND: 9.18 ACRES  
NET OPEN SPACE: 12.81 ACRES (58.25%)

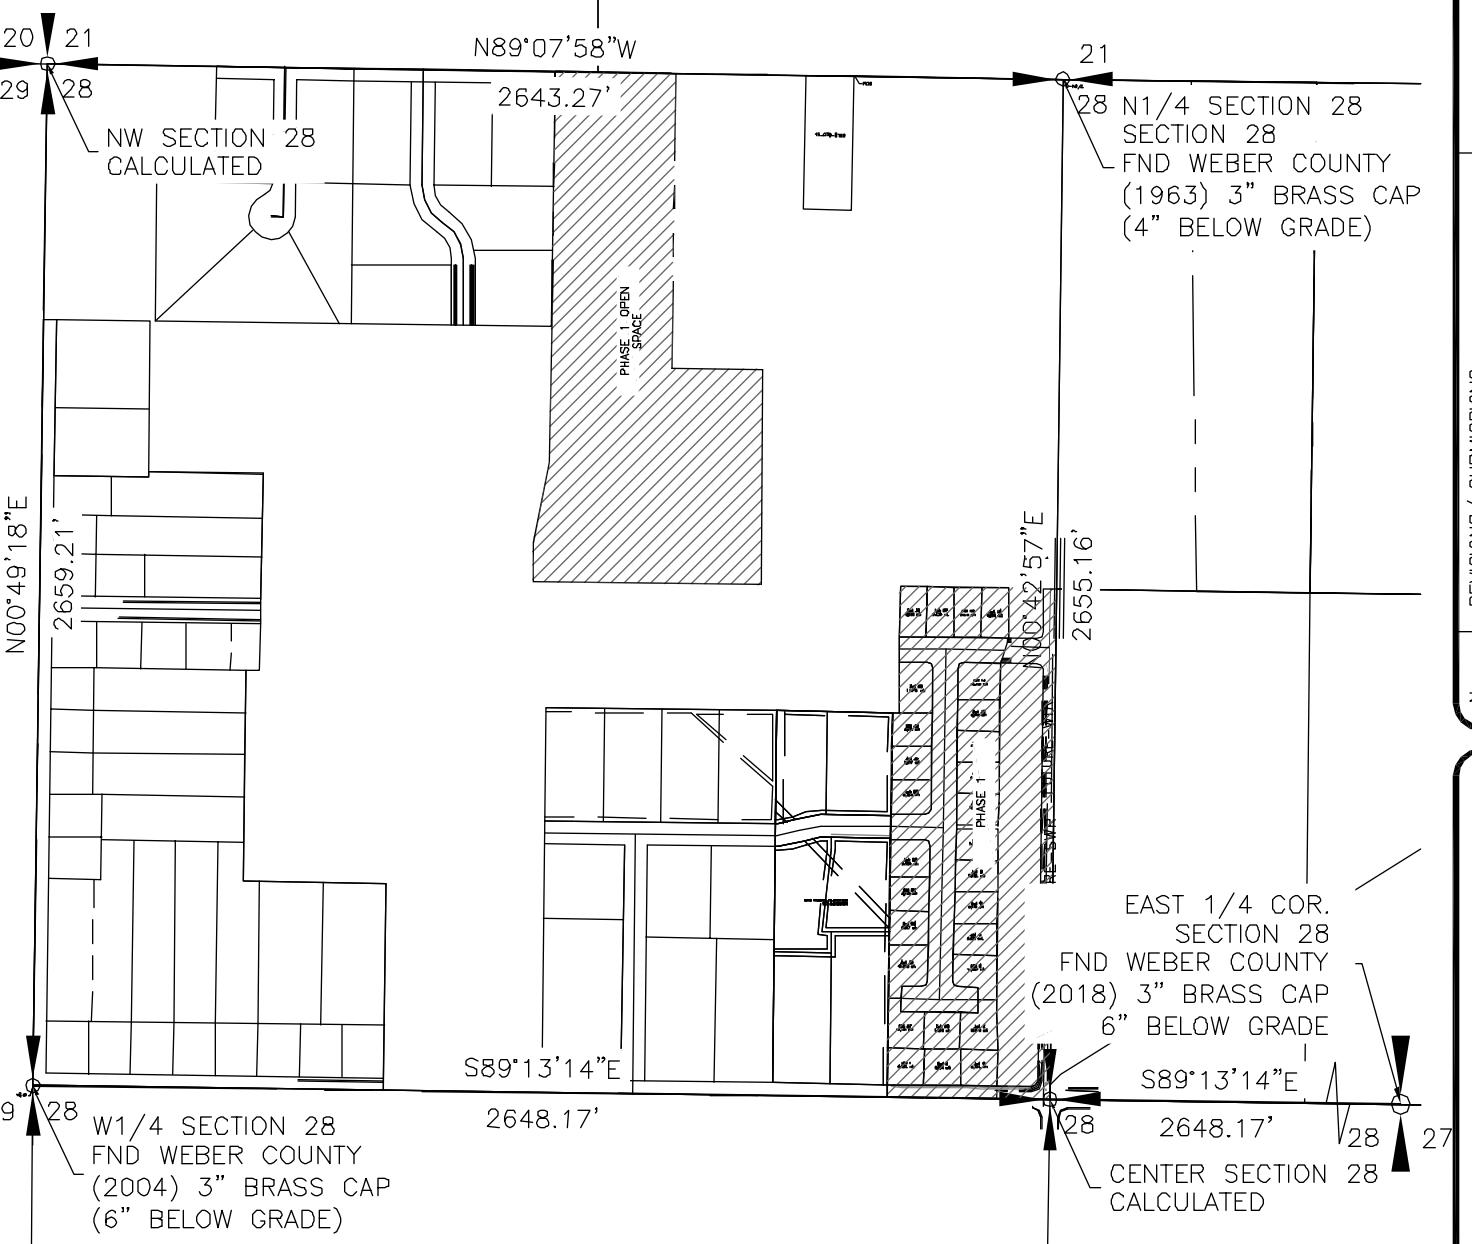

**SECTION CONTROL MAP**  
SCALE: 1"=500'

State of Utah, County of Weber, recorded and filed at the request of \_\_\_\_\_  
Date \_\_\_\_\_ Time \_\_\_\_\_ Fee \_\_\_\_\_  
Entry \_\_\_\_\_

Index Filed in: File of plats  
County Recorder \_\_\_\_\_

**TAYLOR LANDING PHASE 1A**  
A CLUSTER SUBDIVISION  
PART OF THE NORTH HALF OF SECTION 28, TOWNSHIP 6  
RANGE 2 WEST, SALT LAKE BASELINE AND MERIDIAN  
WEBER COUNTY, UTAH, TAYLOR, UTAH

PROJECT TITLE: TAYLOR LANDING PHASE 1A  
DRAWING TITLE: FINAL PLAT  
DRAWING DATE: OCT.26,2020  
DRAWING NO.: 2  
2 of 2

**ALLIANCE CONSULTING ENGINEERS**  
150 EAST 200 NORTH SUITE P  
LOGAN, UTAH 84321  
(435)755-5121  
alliance Logan@yahoo.com

|               |                         |
|---------------|-------------------------|
| DATE          | REVISIONS / SUBMISSIONS |
| DRAWN:        | REVIEWED:               |
| PROJECT NO. : | FILED:                  |

|  |
|--|
| PROJECT TITLE: TAYLOR LANDING PHASE 1A |
| DRAWING TITLE: FINAL PLAT              |
| DATE: OCT.26,2020                      |
| DRAWING NO.: 2                         |
| 2 of 2                                 |

**TAYLOR LANDING PHASE 2**  
A CLUSTER SUBDIVISION

PART OF THE NORTHWEST QUARTER OF SECTION 28,  
TOWNSHIP 6 NORTH, RANGE 2 WEST,  
SALT LAKE BASELINE AND MERIDIAN  
WEBER COUNTY, UTAH

**FINAL PLAT**  
DECEMBER 2020

**LEGEND**

- SECTION CORNER
- SET CL MONUMENT
- LOT LINE
- BOUNDARY LINE
- PUBLIC UTILITY EASEMENT  
(UNLESS NOTED OTHERWISE)
- CENTERLINE
- FOUND REBAR
- FENCE LINE

SCALE: 1" = 60' (24x36 PLAN SET)

**TAYLOR LANDING PHASE 1 OPEN SPACE**

**TAYLOR LANDING PHASE 2 OPEN SPACE**

**TEMPORARY TURNAROUND EASEMENT**

**2025 SOUTH STREET (PUBLIC)**  
N89°13'14"E 730.74'

**Where is the easement for the sewer to come through at? 20ft.**

**2025 WEST STREET (PUBLIC)**

**HAZY ACRES SUBDIVISION**  
ENTRY #1984231 OCT. 20, 2003

**BOYD RUSSELL SUBDIVISION, 1ST AMENDMENT**  
ENTRY #2841599 FEB. 8, 2017

**WELL 1/4 COR. SECTION 28  
(2004) 3" BRASS CAP  
(6" BELOW GRADE)**

**EAST 1/4 COR. SECTION 28  
FND WEBER COUNTY  
(2018) 3" BRASS CAP  
6" BELOW GRADE**

**WEST 1/4 COR. SECTION 28  
(2004) 3" BRASS CAP  
(6" BELOW GRADE)**

**SURVEYOR'S NOTES NARRATIVE**

- The purpose of this survey was to subdivide part of parcel 15-078-0110 into 27 lots. The survey was requested by Jay Stocking of Sierra Homes.
- The basis of bearing is S 89°13'14"E between the West Quarter Corner and East Quarter Corner of Section 28, Township 6 North, Range 2 West, Salt Lake Base and Meridian.
- The south line was established along the north line of the Boyd Russell Subdivision, 1st Amendment recorded in the Weber County Recorder's office under Entry 2841599 on February 8, 2017 and the south line of Hazy Acres Subdivision recorded in the Weber County Recorder's Office under Entry 1984231 on October 20, 2003. The east line was established along the west line of Taylor Landing Subdivision, Phase 1A.

**GENERAL NOTES**

- All Public Utility Easements shown as dashed lines shall be 10.00 foot wide unless otherwise indicated.
- 8" rebar to be set at all rear property corners. Curb pins to be set at lot line projections along streets.
- All development within this subdivision is subject to the requirements of Section 108-16 "Outdoor Lighting" of the Weber County Land Use Code.
- Street trees of a species determined by Weber County Policy are required every 50 feet on both sides of the street within the subdivision boundary. In the event infrastructure or a driveway approach makes a tree's placement impossible, that tree shall be located as close to 50-foot spacing as otherwise reasonably possible, provided compliance with the clear view triangle as defined in Section 108-7-7 of Weber County Land Use Code.

**SURVEYOR'S CERTIFICATE**

I, Brian G. Lyon, a Registered Land Surveyor, hold Certificate No. 275617, in the State of Utah in accordance with Title 58, Chapter 22, Professional Engineers and Land Surveyors Act; and I have completed a survey of the property described on this plat in accordance with Section 108-16 of the Land Use Code and have verified all measurements and have plotted the boundaries represented on this plat, and have hereby subdivided said tract into twenty (20) lots, known hereafter as TAYLOR LANDING PHASE 2, A CLUSTER SUBDIVISION, located in Weber County, Utah and has been correctly drawn to the designated scale and is true and correct representation of the herein described lands included in said subdivision, based upon data compiled from records in the Weber County Recorder's Office and from said survey made by me on the ground.

**PROFESSIONAL LAND SURVEYOR**  
275617  
BRIAN G. LYON  
STATE OF UTAH  
11/30/20

**BOUNDARY DESCRIPTION**

Part of the East Half of the Northwest Quarter of Section 28, Township 6 North, Range 2 West of the Salt Lake Base and Meridian described as follows:

Commencing at the West Quarter Corner of Section 28, Township 6 North, Range 2 West of the Salt Lake Base and Meridian monumented with a Brass Cap; thence S 89°13'14"E 2224.08 feet along the south line of the Northwest Quarter of said Section 28; thence N00°46'08"E 1001.00 feet to the POINT OF BEGINNING and running

hence N 89°13'14" W 698.71 feet along the north line of Boyd Russell Subdivision, 1st Amendment and Hazy Acres Subdivision; thence N 00°46'10" E 132.54 feet;

thence N 24°26'56" W 36.48 feet;

thence N 00°42'56" E 163.00 feet;

thence S 89°13'14" E 730.15 feet to the boundary line of Taylor Landing Phase 1A;

thence along said boundary the next four courses:

- thence S 00°46'46" W 130.00 feet;
- thence S 00°34'29" E 66.02 feet;
- thence S 00°46'08" W 132.54 feet;
- thence N 89°13'14" W 17.26 feet to the point of beginning, containing 5.46 acres, more or less.

**OWNER'S DEDICATION**

Know all by these presents that we the undersigned owners of the above-described tract of land, having caused the same to be subdivided into lots and streets to hereafter be known as TAYLOR LANDING, PHASE 1A.

Do hereby dedicate to the public use all those parts or portions of said tract of land designated as streets, the same to be used as public thoroughfares.

Grant and dedicate a perpetual right and easement over, upon and under the lands designated hereof as public utility, drainage easements and canal maintenance easement, the same to be used for the installation, maintenance and operation of public utility service lines, storm drainage facilities, irrigation canals for the perpetual preservation of water channels in their natural state whichever is applicable as may be authorized by the governing authority, with no buildings or structures being erected within such easements.

Do hereby dedicate to Weber County a perpetual open space easement on, under, and over all parcels and areas described as open space parcels or areas to guarantee to the public that those parcels and areas remain open and undeveloped in a manner consistent with the approved open space plan.

Dedicate and convey to Weber County a temporary turnaround easement as shown on the plat.

In witness whereof, we have hereunto set our hands this day of \_\_\_\_\_, 2020.

Doug Nosler Stocking, Manager  
3900 WEST/TAYLOR PARTNER, LLC

**LIMITED LIABILITY ACKNOWLEDGEMENT**

STATE OF UTAH  
COUNTY OF \_\_\_\_\_ ss

On this \_\_\_\_\_ day of \_\_\_\_\_ A.D. 2020, personally appeared before me, Jay Stocking who being duly sworn did say, for himself that he is the Manager of 3900 WEST/TAYLOR PARTNER, LLC, a Utah Limited Liability Company, and that the within and foregoing instrument was signed on behalf of said Limited Liability Companies.

MY COMMISSION EXPIRES \_\_\_\_\_ NOTARY PUBLIC  
RESIDING AT \_\_\_\_\_

**COUNTY RECORDER**

State of Utah, County of Weber, recorded and filed at the request of \_\_\_\_\_ Date \_\_\_\_\_ Time \_\_\_\_\_ Fee \_\_\_\_\_  
Entry \_\_\_\_\_

Index \_\_\_\_\_ Filed in: File of plats \_\_\_\_\_ County Recorder \_\_\_\_\_

**TAYLOR LANDING PHASE 2**  
A CLUSTER SUBDIVISION

PART OF THE NORTH HALF OF SECTION 28, TOWNSHIP 6  
NORTH, RANGE 2 WEST, SALT LAKE BASELINE AND MERIDIAN  
WEBER COUNTY, TAYLOR, UTAH

**FINAL PLAT**




PROJECT TITLE: TAYLOR LANDING PHASE 2  
DRAWING TITLE: FINAL PLAT  
DRAWING NO.: 1  
DATE: OCT. 29, 2020  
DRAWING DATE: 1  
1 of 2

# TAYLOR LANDING PHASE 2

## A CLUSTER SUBDIVISION

PART OF THE NORTHWEST QUARTER OF SECTION 28,  
TOWNSHIP 6 NORTH, RANGE 2 WEST,  
SALT LAKE BASELINE AND MERIDIAN  
WEBER COUNTY, UTAH

### FINAL PLAT

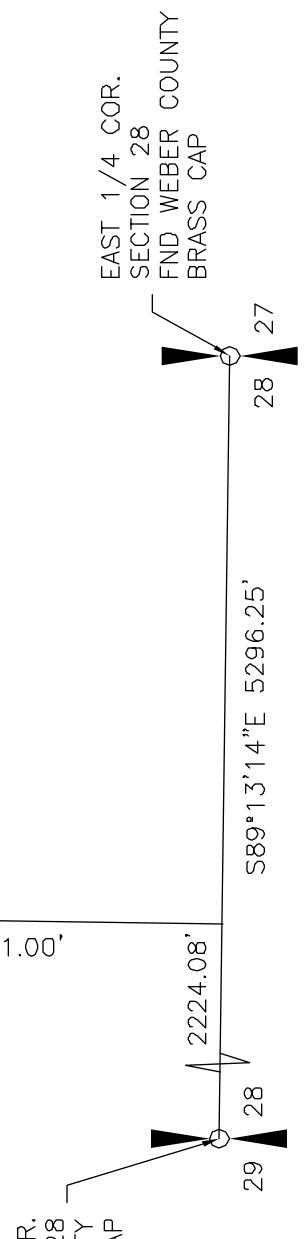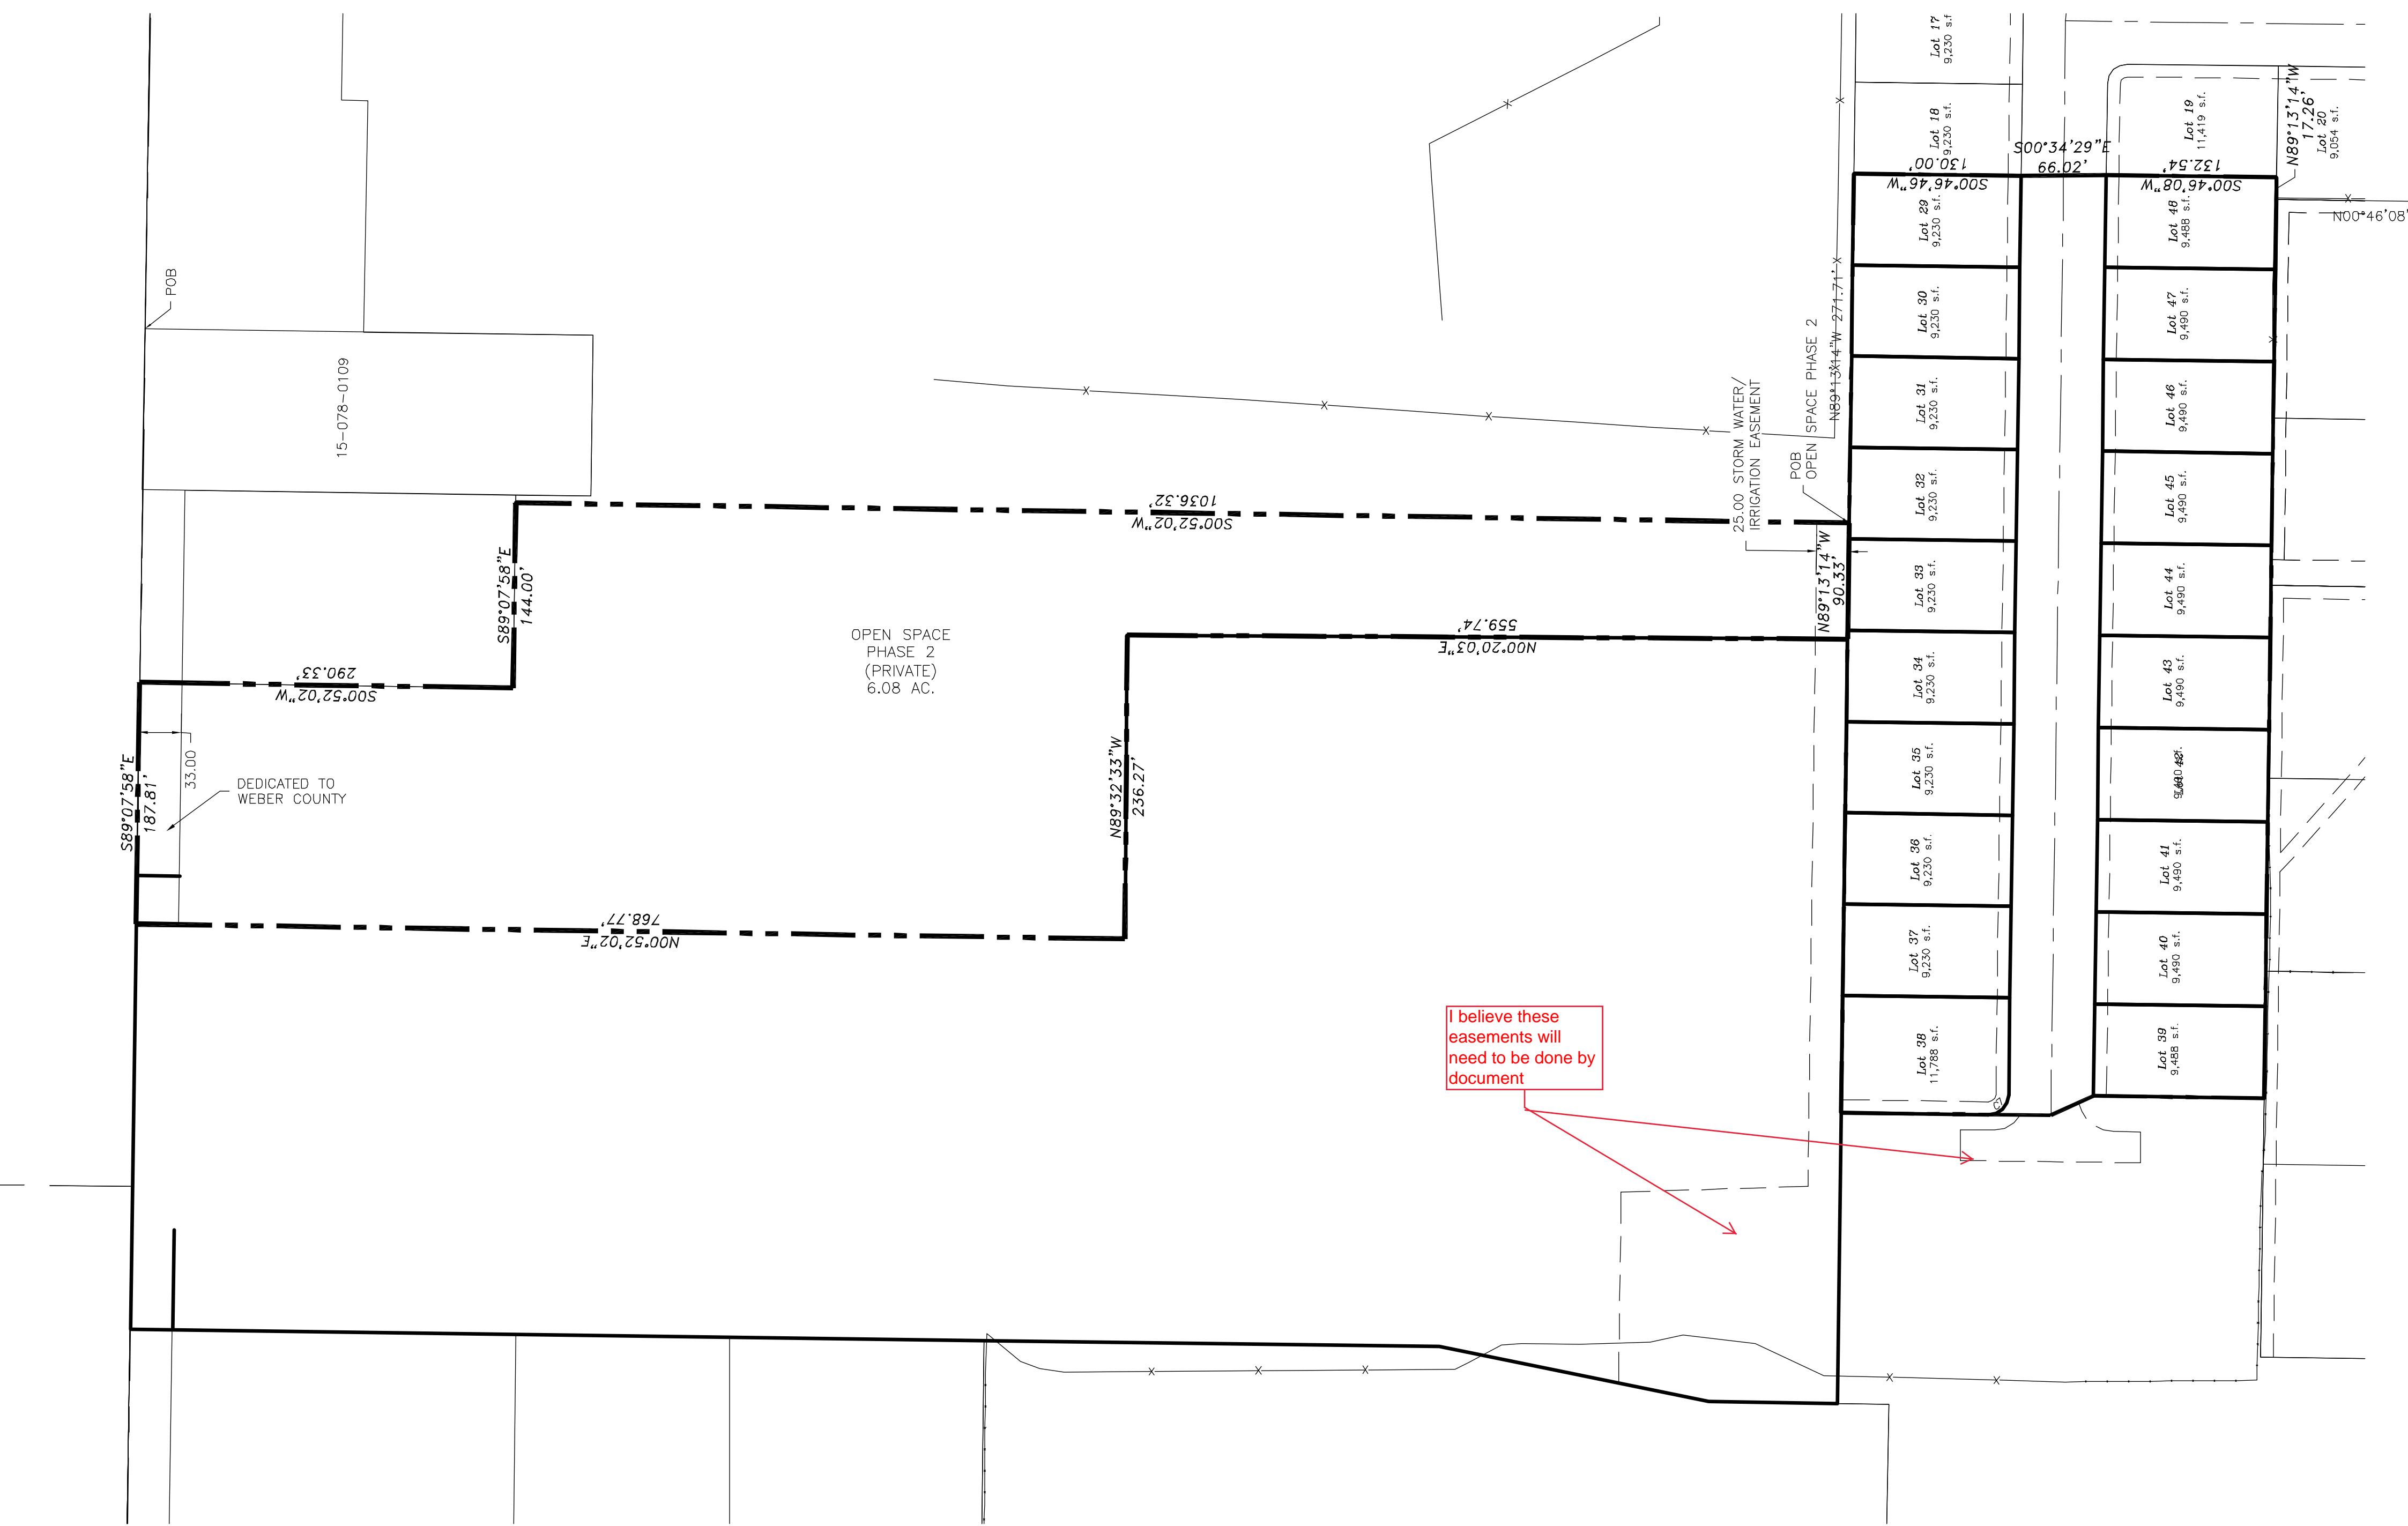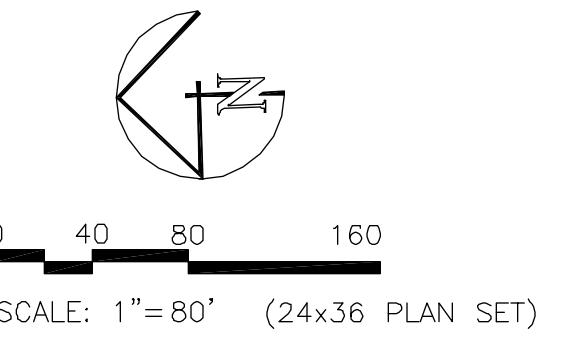

### OPEN SPACE PHASE 2 BOUNDARY DESCRIPTION

Part of the East Half of the Northwest Quarter of Section 28,  
Township 6 North, Range 2 West of the Salt Lake Base and  
Meridian described as follows:


Commencing at the West Quarter Corner of Section 28, Township 6  
North, Range 2 West of the Salt Lake Base and Meridian  
monumented with a Brass Cap; thence S 89°13'14" E 2224.08 feet  
along the south line of the Northwest Quarter of said Section 28;  
thence ND 4°46'08"E 1001.00 feet; thence S 89°13'14" E 17.26 feet;  
thence N 00°46'08" W 132.54 feet; thence N 00°34'29" W 66.02  
feet; thence N 00°46'46" E 130.00 feet; N 89°13'14" W 271.71 feet  
to the POINT OF BEGINNING and running

thence N 89°13'14" W 90.33 feet;  
thence N 00°20'03" E 559.74 feet;  
thence N 89°32'33" W 236.27 feet;  
thence N 00°52'02" E 768.77 feet to the north line of the  
Northwest Quarter of said Section 28;  
thence S 89°07'58" E 187.81 feet along said north line;  
thence S 00°52'02" W 290.33 feet;  
thence S 89°07'58" E 144.00 feet;  
thence S 00°52'02" W 1,036.32 feet to the point of beginning,  
containing 6.08 acres, more or less.

### NOTES:

TAYLOR LANDING OVERALL SUBDIVISION  
TOTAL AREA: 109.63 ACRES  
PUBLIC R-O-W: 13.55 ACRES  
NET DEVELOPABLE GROUND: 96.08 ACRES  
NET OPEN SPACE: 55.97 ACRES (58.25%)

PHASE 2  
TOTAL AREA: 5.46 ACRES  
PUBLIC R-O-W: 1.1 ACRES  
NET DEVELOPABLE GROUND: 4.36 ACRES  
NET OPEN SPACE: 6.08 ACRES (58.25%)

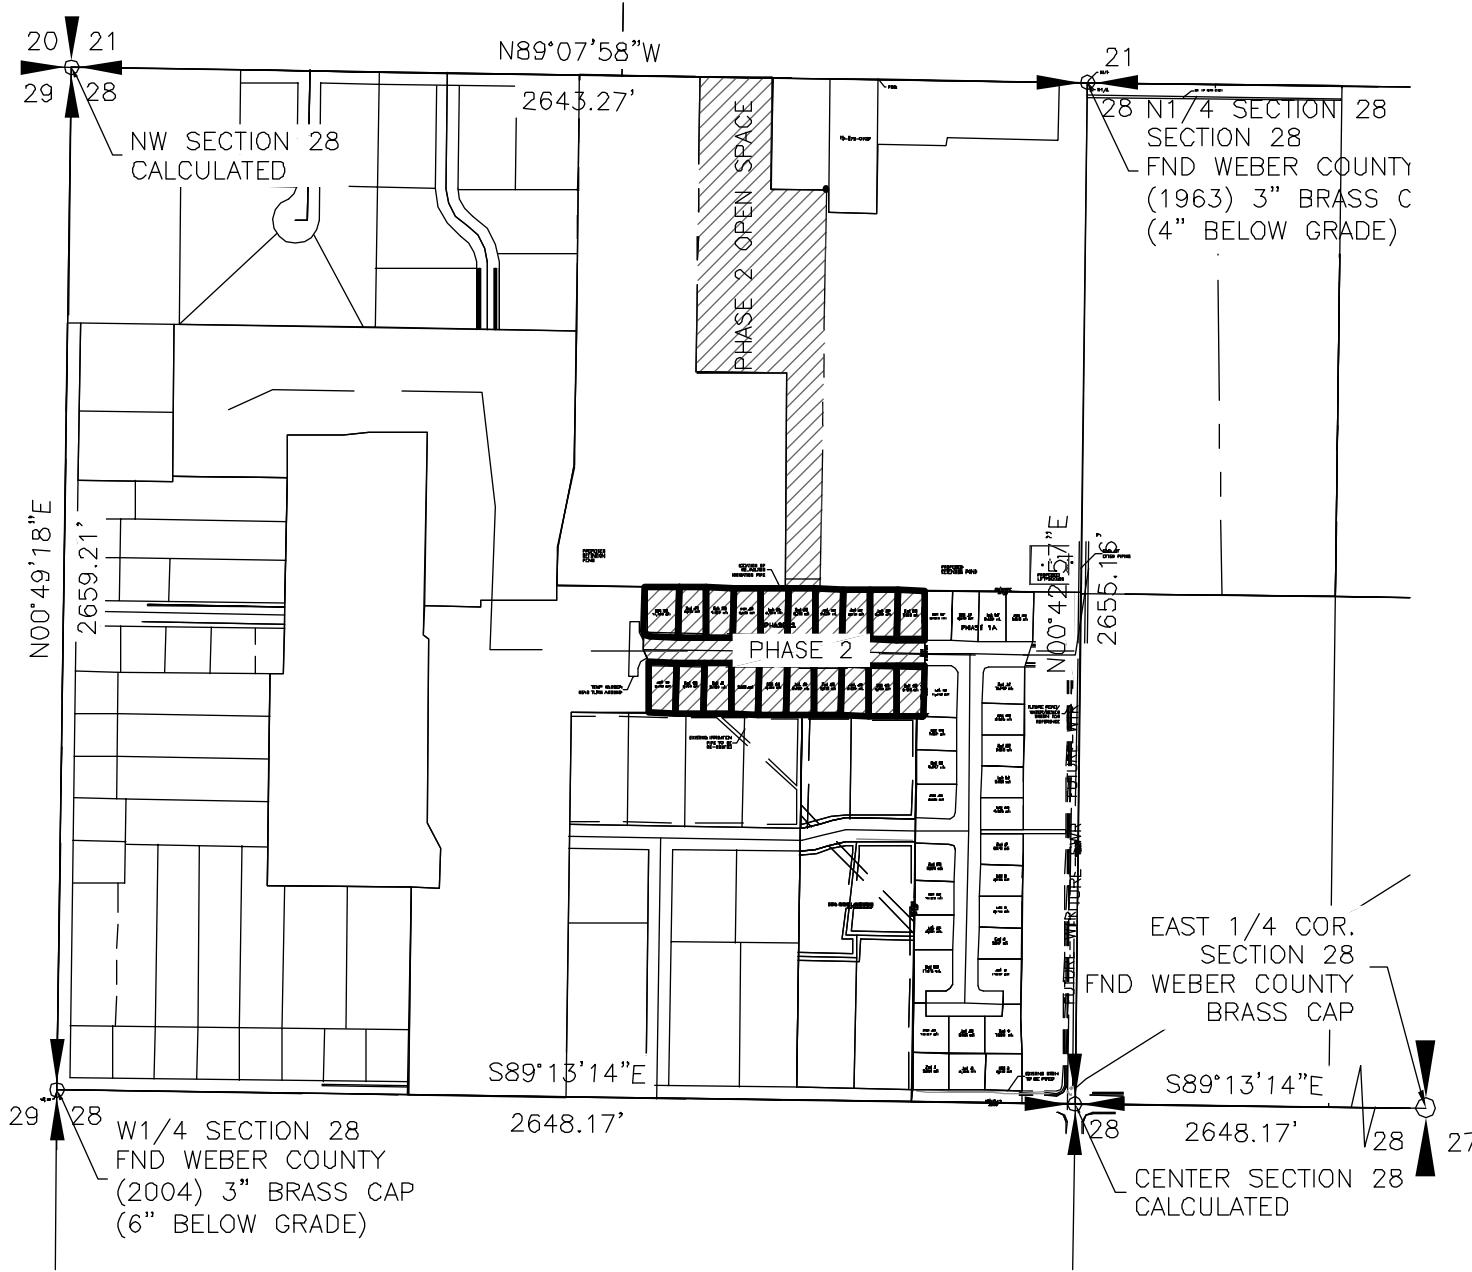

### COUNTY RECORDER

State of Utah, County of Weber, recorded and filed at the request  
of \_\_\_\_\_ Date \_\_\_\_\_ Time \_\_\_\_\_ Fee \_\_\_\_\_  
Entry \_\_\_\_\_

Index \_\_\_\_\_ Filed in: File of plats \_\_\_\_\_ County Recorder \_\_\_\_\_

**ALLIANCE CONSULTING  
ENGINEERS**  
150 EAST 200 NORTH SUITE P  
LOGAN, UTAH 84337  
(435)755-5121  
alliancecgm@yahoo.com

© 2020 ALLIANCE CONSULTING ENGINEERS


**TAYLOR LANDING PHASE 2  
A CLUSTER SUBDIVISION**  
PART OF THE NORTH HALF OF SECTION 28, TOWNSHIP 6  
NORTH, RANGE 2 WEST, SALT LAKE BASELINE AND MERIDIAN  
WEBER COUNTY, UTAH

DRAWING TITLE

DATE : SEPT, 2020

DRAWING NO.

2 of 2

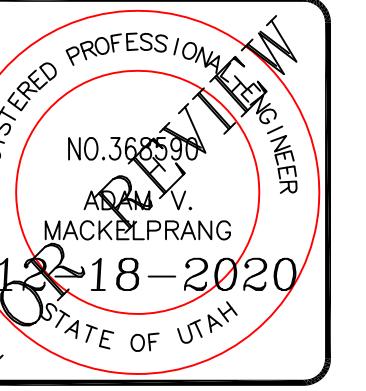

REGISTERED PROFESSIONAL ENGINEER  
NO. 36859  
MACKELPRANG  
STATE OF UTAH  
FOR 18-2020

ALLIANCE CONSULTING  
ENGINEERS  
150 EAST 200 NORTH SUITE P  
LOGAN, UTAH 84321  
(435)755-5121  
allianceengr@jawsoffice.net

CONFIDENTIALITY AND COPYRIGHT NOTICE  
UNAUTHORIZED USE, DISCLOSURE, OR COPYING OF THIS  
DRAWING IS PROHIBITED.  
CONSTRUCTION DOCUMENTS THAT ARE DISTRIBUTED FOR  
BIDDING PURPOSES SHALL NOT BE RETAINED AND SHALL  
BE DESTROYED WITHIN 30 DAYS AFTER THE BID OPENING  
BY THE PLAN HOLDER.

COPYRIGHT 2005

TAYLOR LANDING PHASE 1A/2  
A CLUSTER SUBDIVISION  
DRAWING TITLE : INDEX SHEET  
DATE : NOV,2020  
DRAWING No. :

**TAYLOR LANDING PHASE 1A/2**  
**A CLUSTER SUBDIVISION**  
PART OF THE NORTH HALF OF SECTION 28, TOWNSHIP 6 NORTH,  
RANGE 2 WEST,  
SALT LAKE BASELINE AND MERIDIAN  
WEBER COUNTY, TAYLOR, UTAH

INDEX SHEET

**PROJECT**

**Sunset EQ**  
Write a description for your map.

**Legend**

- Taylor
- Taylor
- The Church of Jesus Christ of Latter-day Saints
- Wasatch Archery Shop
- Wuenschel Concrete, Inc.

**OWNER/DEVELOPER**  
**SIERRA HOMES**

**CIVIL ENGINEER**  
**ALLIANCE CONSULTING  
ENGINEERS, INC.**  
**150 EAST 200 NORTH SUITE P  
LOGAN, UTAH 84321**  
**435-755-5121**

**SHEET INDEX**

| SHEET NO. | SHEET DESCRIPTION              |
|-----------|--------------------------------|
| 1         | INDEX SHEET                    |
| 2         | MASTERPLAN                     |
| 3         | 3940 WEST/2100 SOUTH ROAD PLAN |
| 4         | 2025 SOUTH/3900 WEST ROAD PLAN |
| 5         | IRRIGATION RE-ROUTE PLAN       |
| 6         | EAST GRADING/DRAINAGE PLAN     |
| 7         | WEST GRADING/DRAINAGE PLAN     |
| 8         | DETAILS                        |

**GENERAL NOTES (APPLICABLE TO ALL CIVIL SHEETS):**

- ALL CONSTRUCTION AND MATERIALS SHALL BE IN ACCORDANCE WITH THE PROJECT SPECIFICATIONS, WEBER COUNTY STANDARDS, STATE OF UTAH AND ANY OTHER APPLICABLE STANDARDS ISSUED BY THE CONTROLLING AGENCY.
- CONTRACTOR SHALL FIELD VERIFY ALL DIMENSIONS BEFORE CONSTRUCTION. ANY DISCREPANCIES BETWEEN CONSTRUCTION DOCUMENTS AND FIELD CONDITIONS SHALL IMMEDIATELY BE BROUGHT TO THE ATTENTION OF THE OWNER. ANY WORK COMPLETED WITHOUT DOING SUCH IS DONE SO AT THE CONTRACTOR'S EXPENSE.
- CONTRACTOR SHALL REPAIR AND/OR REPLACE ANY AREAS AND/OR MATERIALS DAMAGED DURING CONSTRUCTION.
- CONTRACTOR SHALL MAINTAIN ALL ADJACENT PROPERTY (PUBLIC & PRIVATE) FROM ALL CONSTRUCTION DEBRIS.
- CONTRACTOR SHALL PROVIDE SMOOTH TRANSITION FROM ALL NEW CONSTRUCTION TO EXISTING CONDITIONS.
- CONTRACTOR SHALL PROVIDE ALL NECESSARY AUTOMOBILE AND PEDESTRIAN TRAFFIC CONTROL DEVICES REQUIRED BY LOCAL, STATE, AND FEDERAL CODES AND ORDINANCES.
- CONTRACTOR SHALL REPLACE SURVEY MONUMENTS DAMAGED DURING CONSTRUCTION. SURVEY MONUMENTS TO BE REPLACED BY A REGISTERED, LICENSED LAND SURVEYOR.
- CONTRACTOR TO LOCATE ALL EXISTING UTILITIES, INCLUDING FIBER OPTIC. ANY DAMAGES TO EXISTING UTILITIES WILL BE REPAIRED AT CONTRACTOR'S EXPENSE.
- DIMENSIONS SHOWN ARE TO THE CENTER OF THE PIPELINE UNLESS OTHERWISE NOTED.
- DISTANCES SHOWN ALONG PIPELINES ARE HORIZONTAL DISTANCES AND NOT ACTUAL PIPE LENGTHS. MORE PIPE MAY BE REQUIRED TO COMPLETE CONSTRUCTION THAN IS DIMENSIONED IN THE PLANS.
- CONTRACTOR IS REQUIRED TO HAVE A SET OF PLANS ON THE SITE AT ALL TIMES. ANY WORK COMPLETED WITHOUT A SET PRESENT IS DONE SO AT THE CONTRACTOR'S RISK AND EXPENSE IF ERRORS OCCUR.
- CONTRACTOR IS RESPONSIBLE FOR PROVIDING WATER NECESSARY FOR DUST ABATEMENT, COMPACTION, ETC.
- THE CONTRACTOR SHALL BE RESPONSIBLE FOR SECURING SOURCES FOR GRANULAR MATERIALS, WATER, WASTE SITES, AND ANY OTHER MATERIALS SOURCES AS REQUIRED FOR PROJECT COMPLETION.
- ANY WORK DONE WITHIN A PUBLIC RIGHT-OF-WAY SHALL BE COORDINATED WITH THE APPROPRIATE TRANSPORTATION AGENCY AND SHALL MEET THE REQUIREMENTS OF THAT AGENCY AND THE REQUIREMENTS OF ANY RIGHT-OF-WAY OR SPECIAL USE PERMITS.
- THE CONTRACTOR SHALL COORDINATE ALL LIVE TAPS AND ANY OTHER WORK OR MANIPULATION OF THE EXISTING WATER SYSTEM WITH THE TAYLOR-WEST WEBER WATER IMPROVEMENT DISTRICT, 24 HOURS IN ADVANCE OF AN PRE-CONSTRUCTION MEETING AND CONSTRUCTION ACTIVITY. 801-731-1668.
- ON SLOPING AREAS THE CONTRACTOR SHALL TAKE PRECAUTIONS TO MITIGATE ANY POSSIBLE EROSION PROBLEMS DUE TO TRENCHES DUE TO STORM WATER THAT MIGHT OCCUR DURING OR AFTER CONSTRUCTION AS DIRECTED OR APPROVED BY ENGINEER.
- THE CONTRACTOR SHALL INSTALL AND MAINTAIN ALL EROSION CONTROL MEASURES AS DETAILED IN THE PROJECT PLANS UNTIL FINAL ACCEPTANCE OF THIS PROJECT.
- THE CONTRACTOR REQUIRED TO TAKE ALL PRECAUTIONS NECESSARY TO INSURE THAT NO STORM WATER/SEDIMENT AND/OR CONSTRUCTION DEBRIS ARE RELEASED FROM THE SITE. ANY RELEASES SHALL BE CLEANED AND MITIGATED AT THE CONTRACTOR'S EXPENSE.
- CONTRACTOR SHALL COORDINATE ALL CONSTRUCTION ACCESS AND RELATED TRAFFIC CONTROL WITH THE COUNTY, CITY, AND STATE ROADWAY DEPARTMENTS. THE ENGINEER SHALL REVIEW ALL TRAFFIC CONTROL PLANS.
- CONTRACTOR SHALL PROVIDE ALL NECESSARY FITTINGS, HARDWARE, LABOR, ETC. TO CONSTRUCT VERTICAL AND HORIZONTAL BENDS IN PIPE AS NEEDED TO MEET THE REQUIRED GRADES, ALIGNMENTS AND COVER REQUIREMENTS.
- ALL AIR RELEASE VALVES SHALL BE INSTALLED AT THE CREST OF THE VERTICAL CURVATURE OF THE WATER LINE. CONTRACTOR SHALL RECORD ACTUAL LOCATION OF VALVES ON FIELD RECORD DRAWINGS.
- THE CONTRACTOR SHALL COORDINATE WITH WEBER COUNTY FOR ALL UTILITY INSPECTIONS PRIOR TO BACKFILLING.
- ALL WATER SYSTEM COMPONENTS SHALL BE INSTALLED, PRESSURE TESTED, AND CHLORINATED PRIOR TO COMPLETING ANY ROADWAY CONSTRUCTION.
- ALL WORK ON THE SECONDARY WATER SYSTEM IS TO BE DONE IN ACCORDANCE WITH HOOPER IRRIGATION COMPANY STANDARDS.

**CITY ENGINEER'S CERTIFICATE OF APPROVAL**

I hereby approve the above plat having reviewed it for conformity with standard engineering practice and County's Subdivision Ordinance

Date \_\_\_\_\_ Weber County Engineer \_\_\_\_\_


# TAYLOR LANDING PHASE 1A/2

## A CLUSTER SUBDIVISION

PART OF THE NORTH HALF OF SECTION 28, TOWNSHIP 6  
NORTH, RANGE 2 WEST,  
SALT LAKE BASELINE AND MERIDIAN

WEBER COUNTY, TAYLOR, UTAH

### MASTERPLAN

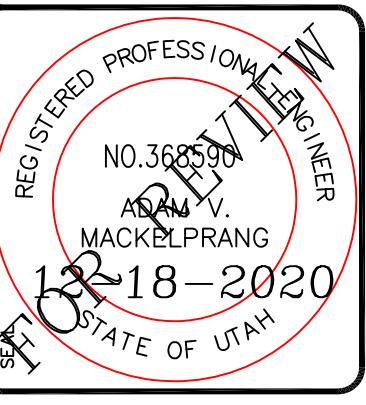

SCALE: 1"=80' (22x34 PLAN SET)

- BOUNDARY LINE
- LOT LINE
- CENTERLINE
- FUTURE ROAD SHOWN FOR REFERENCE
- EXISTING FENCE
- EXISTING DITCH
- E 8 C900 WTR
- EXISTING WATER AS NOTED
- PROPOSED 8" PVC C-900 DR 18 WATER
- PROPOSED 1" CTS 200 PSI POLY WATER SERVICE
- FUTURE-WTR
- FUTURE WATER SHOWN FOR REFERENCE
- E 30-CONC-SWER
- EXISTING SEWER AS NOTED
- PROPOSED 8" SDR 35 SEWER AS NOTED
- PROPOSED 10" SDR 35 SEWER AS NOTED
- S
- PROPOSED 4" SEWER LATERAL
- FUTURE-SWER
- FUTURE SEWER SHOWN FOR REFERENCE
- E 12 DI IRR
- EXISTING 12" DI IRRIGATION
- PROPOSED 8" PVC C-900 DR18 IRRIGATION MAIN
- PROPOSED 12" PVC C-909 DR18 IRRIGATION MAIN
- PROPOSED IRRIGATION SERVICE PER HOOPER
- IRRIGATION COMPANY (see Pl-10 hooper irrigation, double service unless otherwise noted)
- 15 E ADS SD
- EXISTING STORM SYSTEM
- 15 ADS SD
- PROPOSED STORM SYSTEM AS NOTED
- 12 IRR
- EXISTING MAJOR CONTOUR (5')
- EXISTING MINOR CONTOUR (1')
- X
- EXISTING ASPHALT
- PROPOSED ASPHALT
- PROPOSED CONCRETE

CONFIDENTIAL AND COPYRIGHT NOTICE  
UNAUTHORIZED USE, DISCLOSURE, OR COPYING OF THIS  
DRAWING IS PROHIBITED.  
CONSTRUCTION DOCUMENTS THAT ARE DISTRIBUTED FOR  
BIDDING PURPOSES SHALL NOT BE RETURNED AND SHALL  
BE DESTROYED WITHIN 30 DAYS AFTER THE BID OPENING  
BY THE PLAN HOLDER.

COPYRIGHT 2005

**ALLIANCE CONSULTING**  
**ENGINEERS**

150 EAST 200 NORTH SUITE P  
LOGAN, UTAH 84321  
(435)755-5121  
alliancebgm@yahoo.com

DATE : DRAWN : PROJECT NO. :

No. REVISIONS/ SUBMISSIONS  
REVIEWED : CAD FILE :

PROJECT TITLE : TAYLOR LANDING PHASE 1A/2  
DRAWING TITLE : A CLUSTER SUBDIVISION  
DATE : NOV,2020  
DRAWING NO. : 2

DRAWING NO. : 2  
DATE : NOV,2020

# TAYLOR LANDING PHASE 1A/2


## A CLUSTER SUBDIVISION

PART OF THE NORTH HALF OF SECTION 28, TOWNSHIP 6





NORTH, RANGE 2 WEST,

SALT LAKE BASELINE AND MERIDIAN

WEBER COUNTY, TAYLOR, UTAH

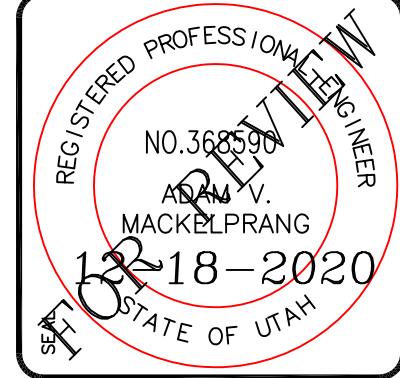

3940 WEST/2100 SOUTH ROAD PLAN

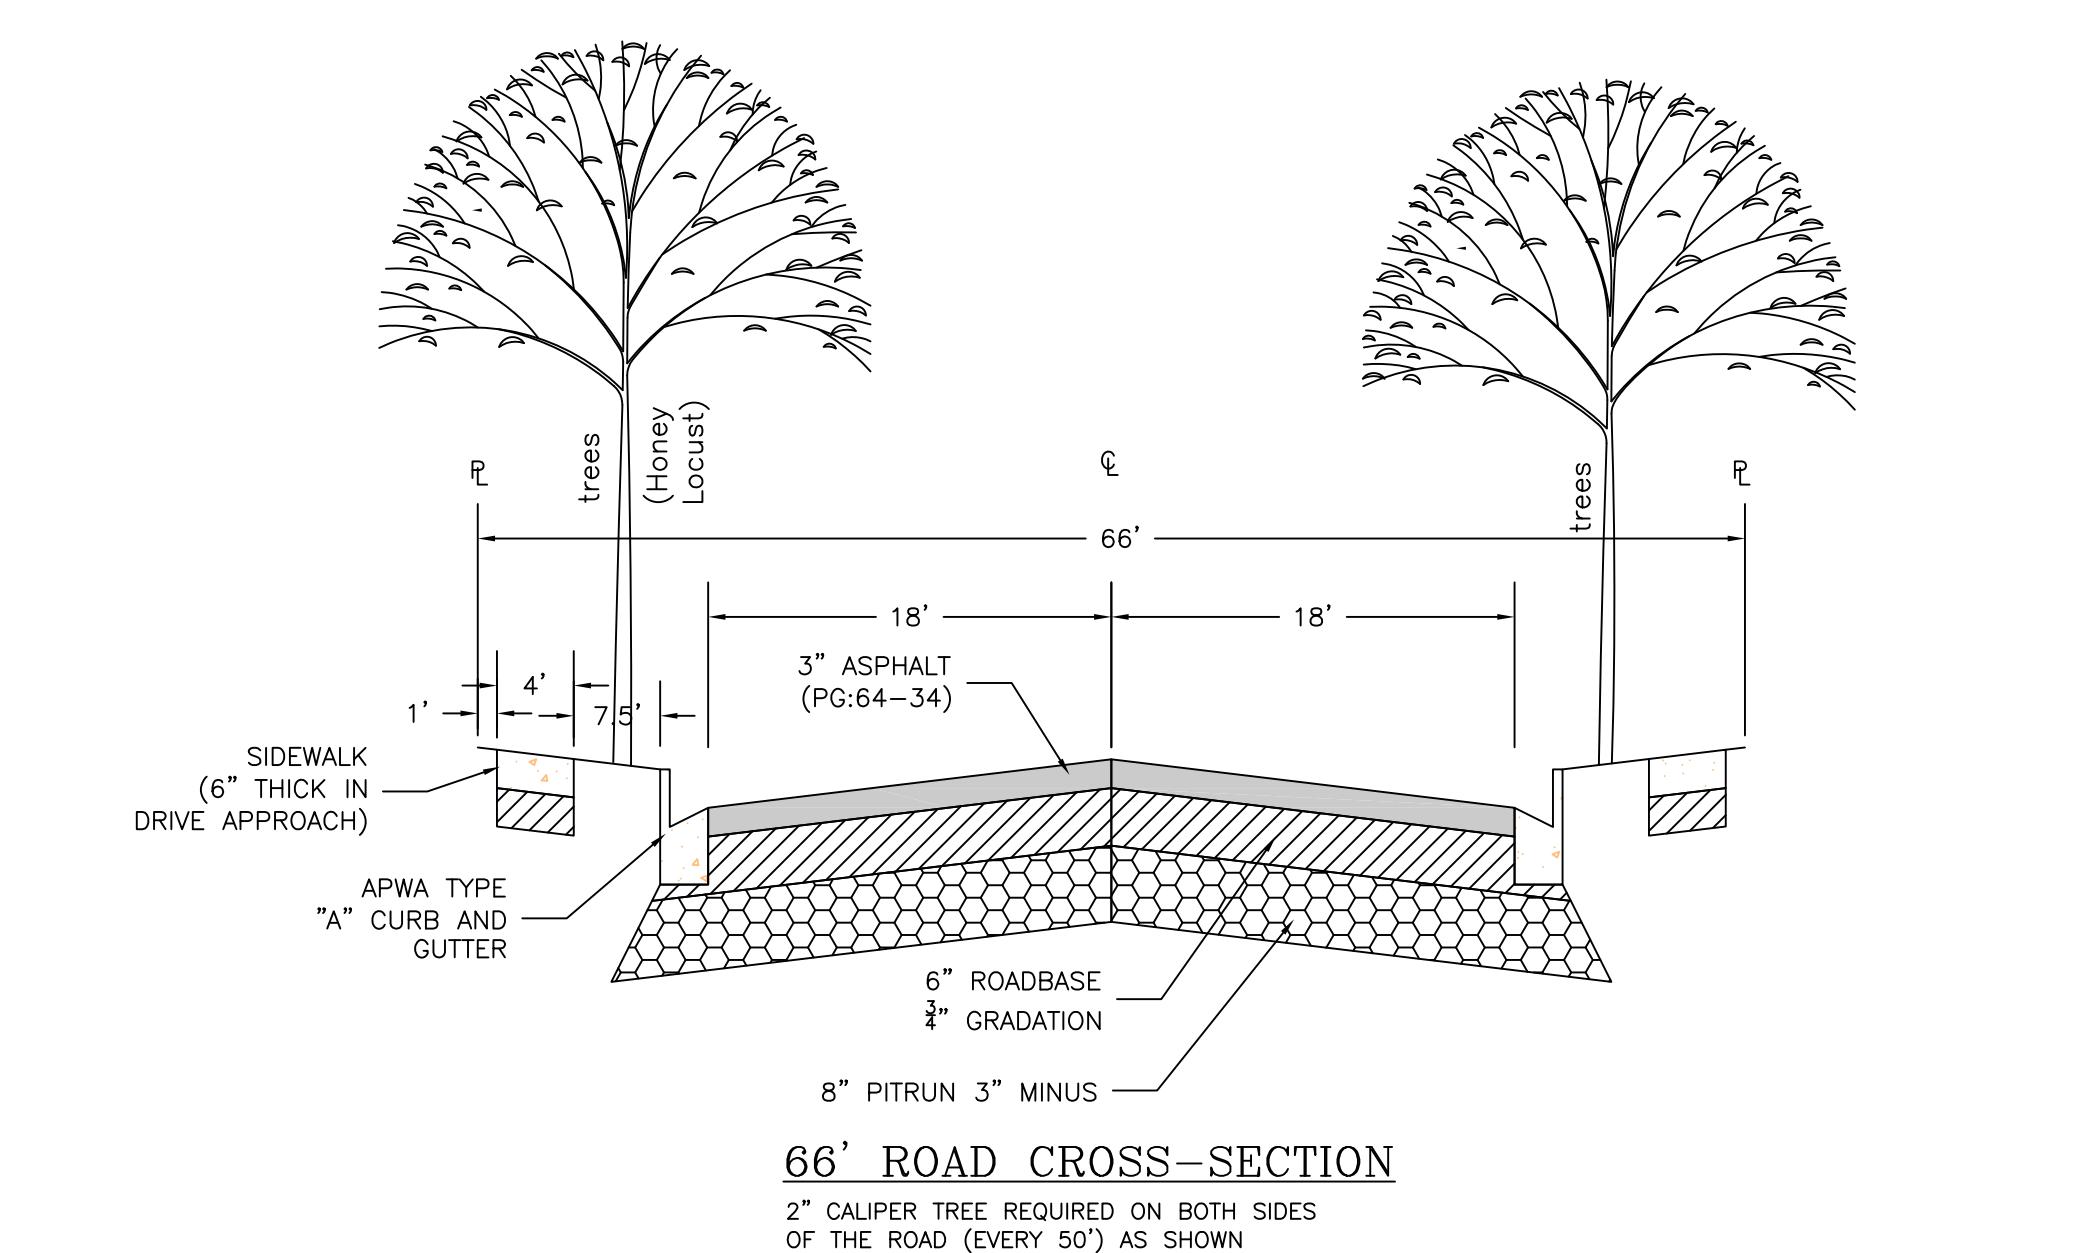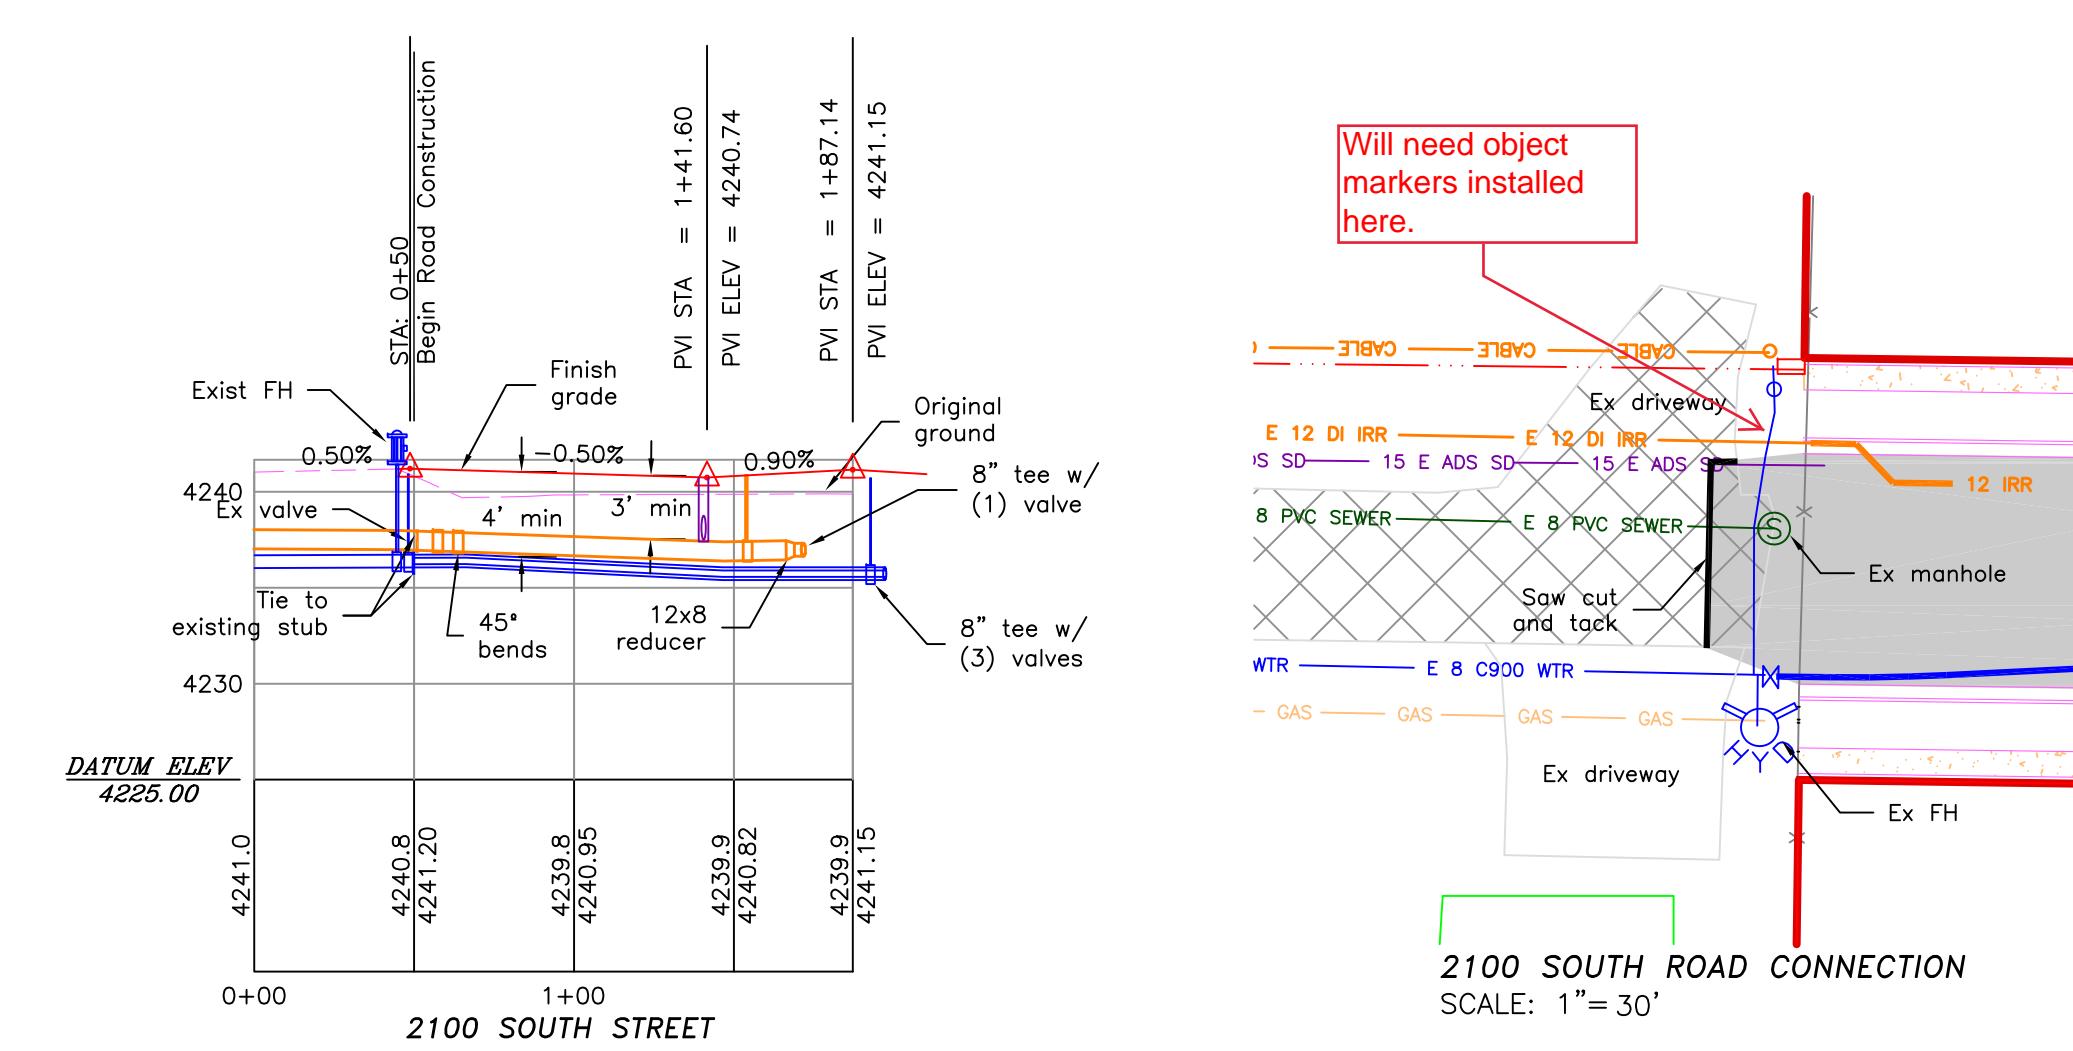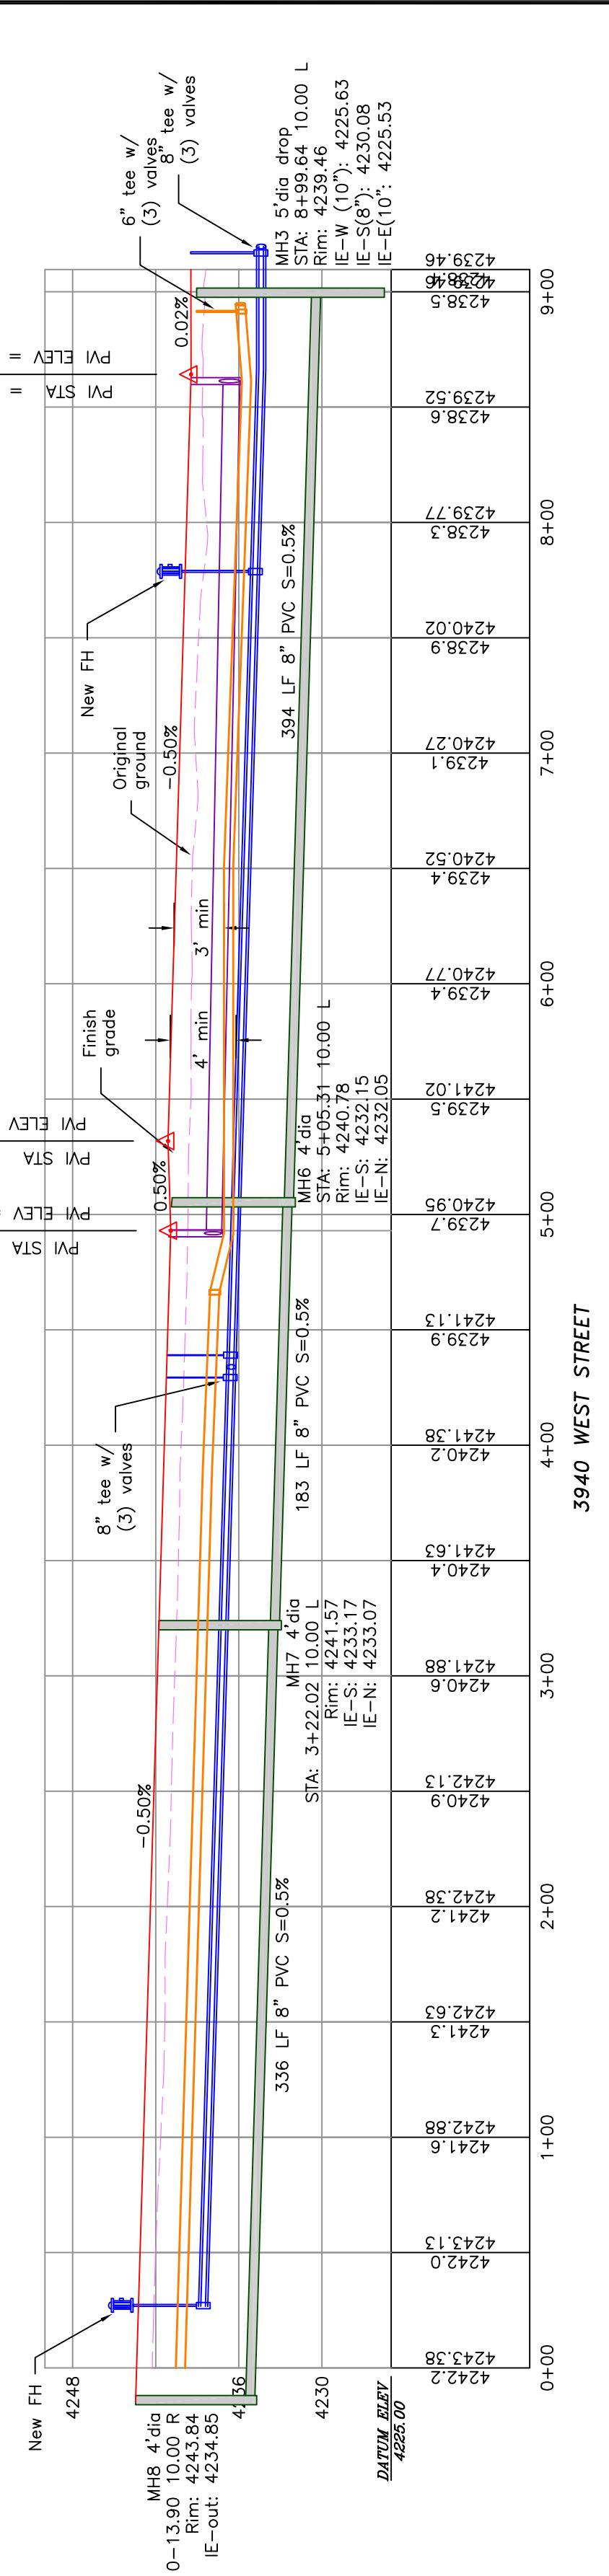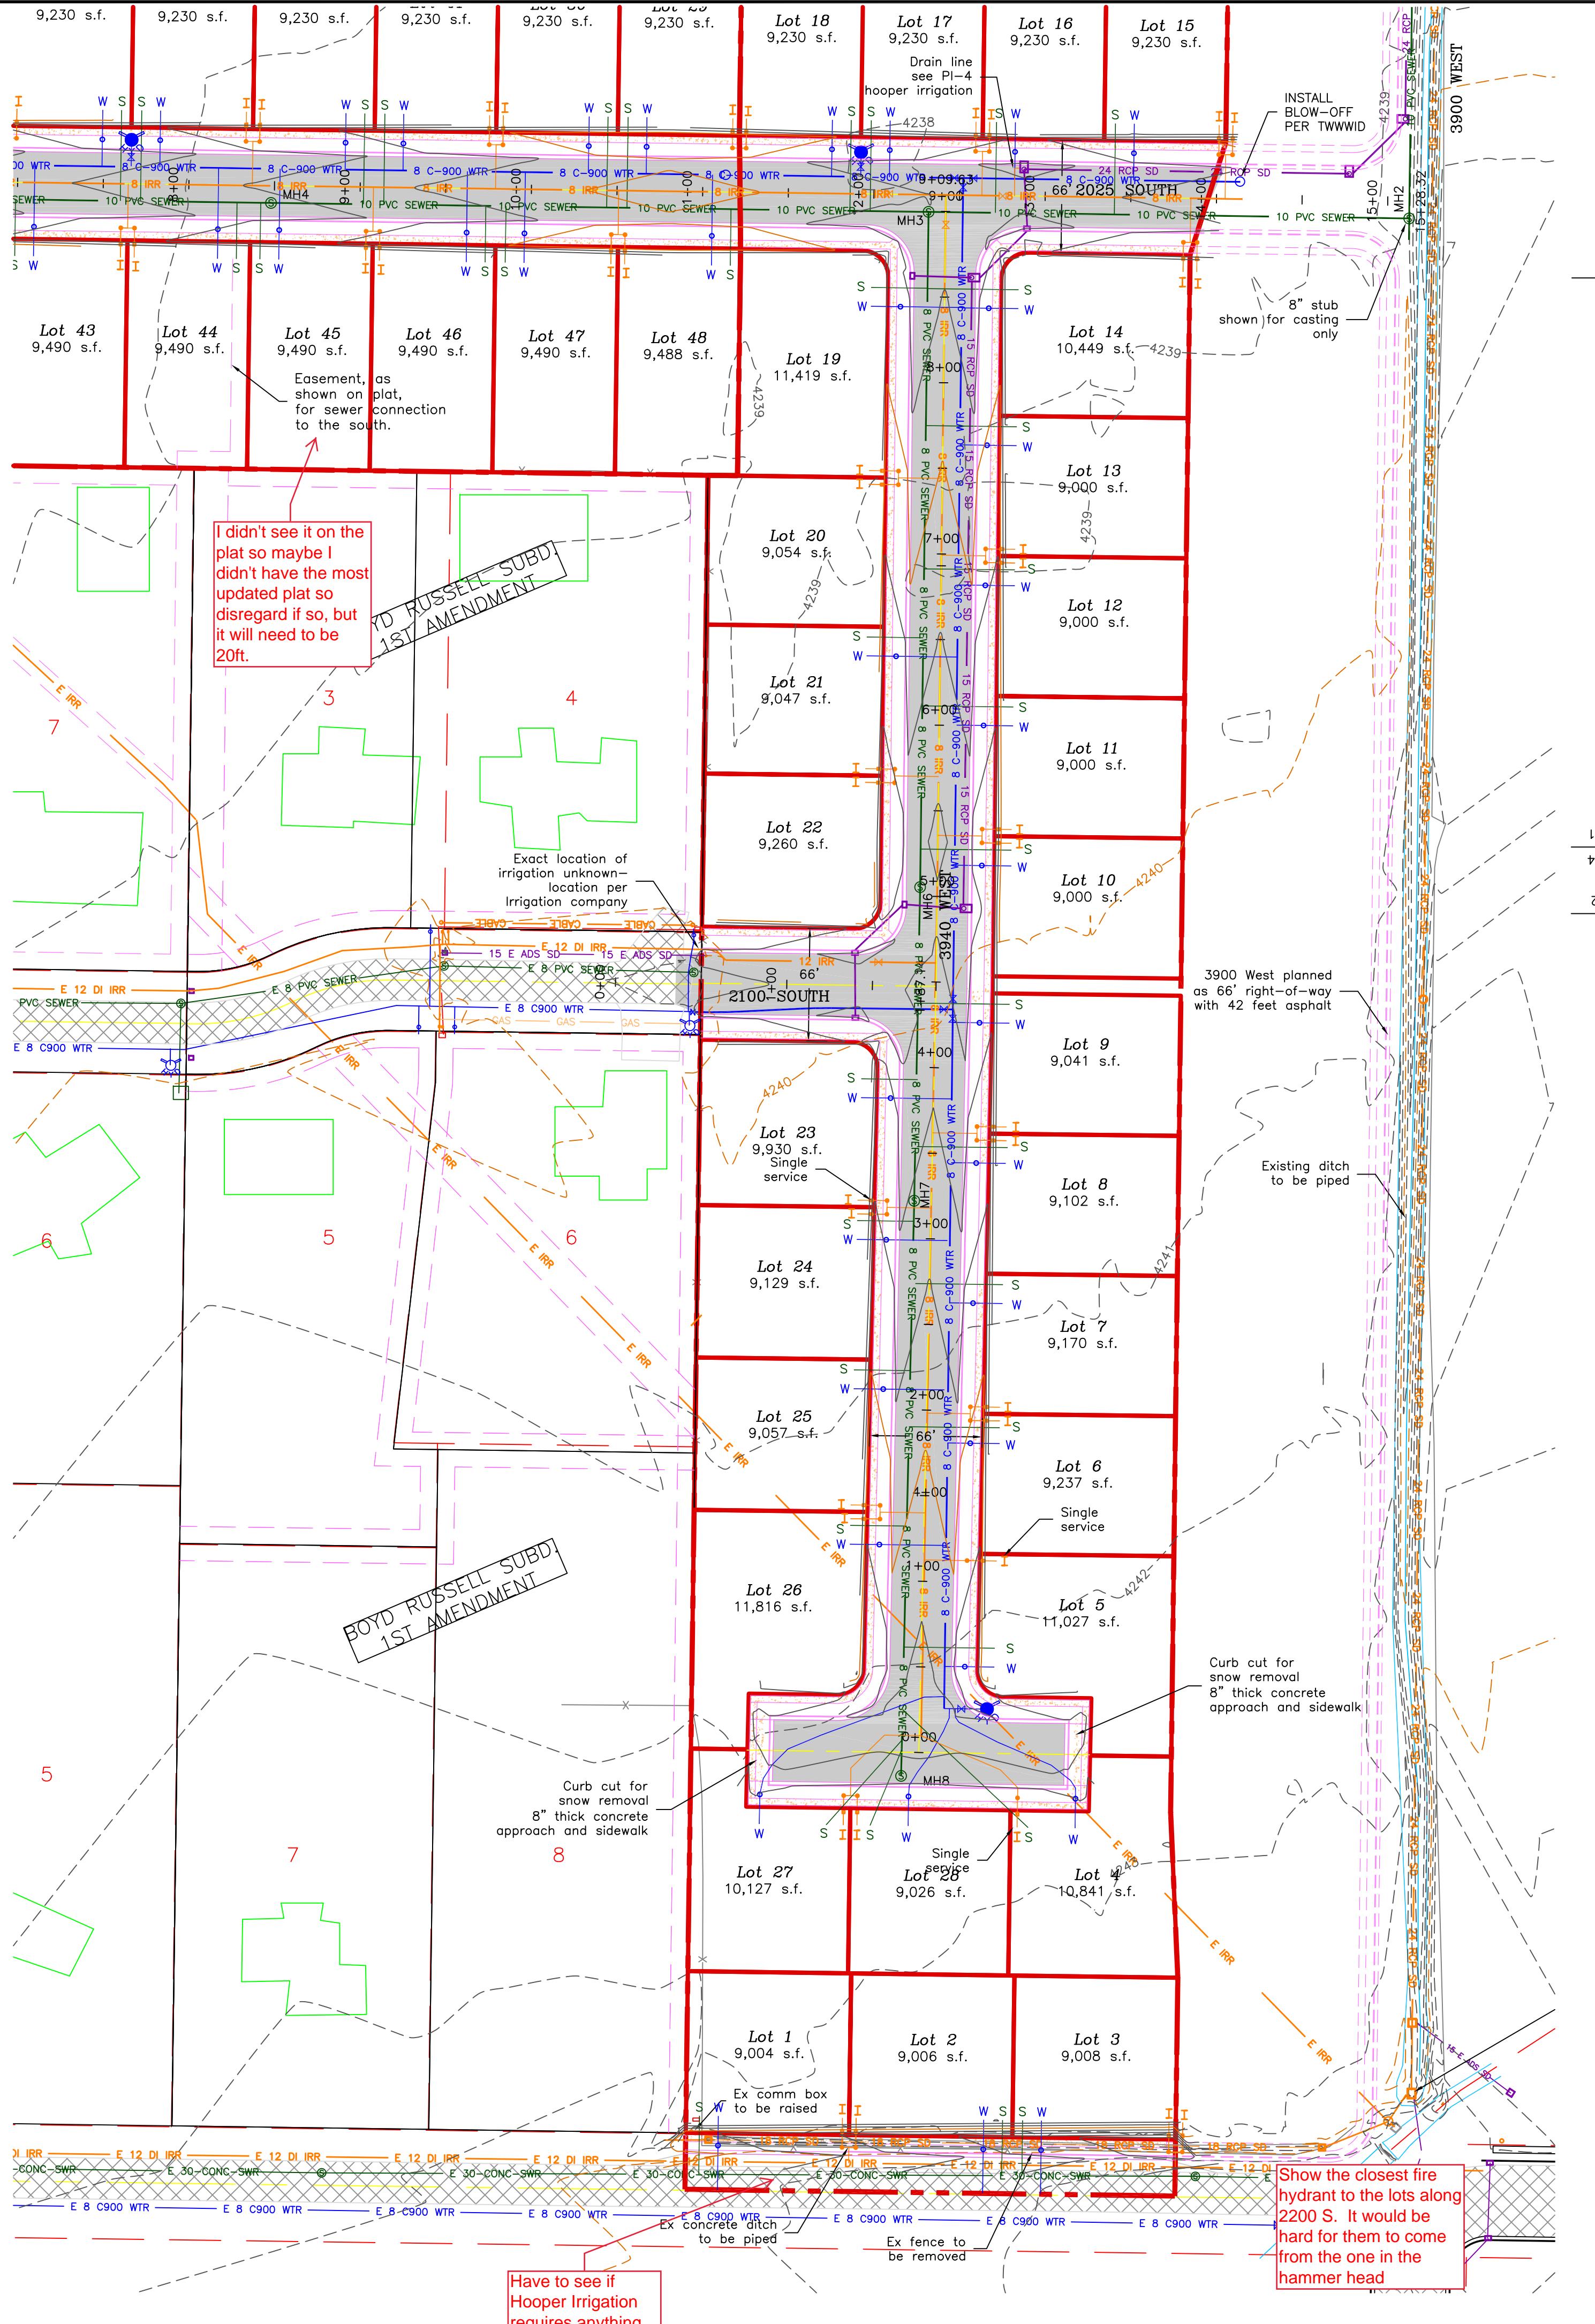

**ALLIANCE CONSULTING ENGINEERS**  
AJE

CONFIDENTIALITY AND COPYRIGHT NOTICE  
UNAUTHORIZED USE, DISCLOSURE, OR COPYING OF THIS  
DRAWING IS PROHIBITED.  
CONSTRUCTION DOCUMENTS THAT ARE DISTRIBUTED FOR  
BIDDING PURPOSES SHALL NOT BE RETURNED AND SHALL  
BE DESTROYED WITHIN 30 DAYS AFTER THE BID OPENING  
BY THE PLAN HOLDER.

COPYRIGHT 2005

|                           |               |
|---------------------------|---------------|
| DATE :                    | DRAWN :       |
| REVISIONS / SUBMISSIONS : | PROJECT NO. : |

|  |                                |
|--|--------------------------------|
| PROJECT TITLE : TAYLOR LANDING PHASE 1A/2      | A CLUSTER SUBDIVISION          |
| DRAWING TITLE : 3940 WEST/2100 SOUTH ROAD PLAN | 3940 WEST/2100 SOUTH ROAD PLAN |
| DATE : NOV,2020                                | DRAWING No. : 3                |

# TAYLOR LANDING PHASE 1A/2


## A CLUSTER SUBDIVISION

PART OF THE NORTH HALF OF SECTION 28, TOWNSHIP 6


NORTH, RANGE 2 WEST,

SALT LAKE BASELINE AND MERIDIAN

WEBER COUNTY, TAYLOR, UTAH

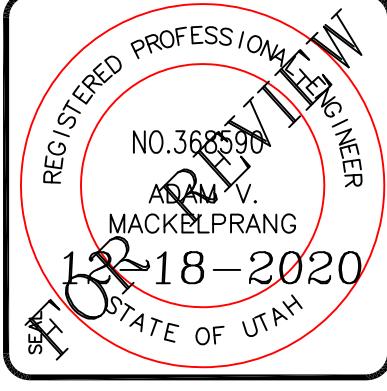


2025 SOUTH/3900 WEST ROAD PLAN


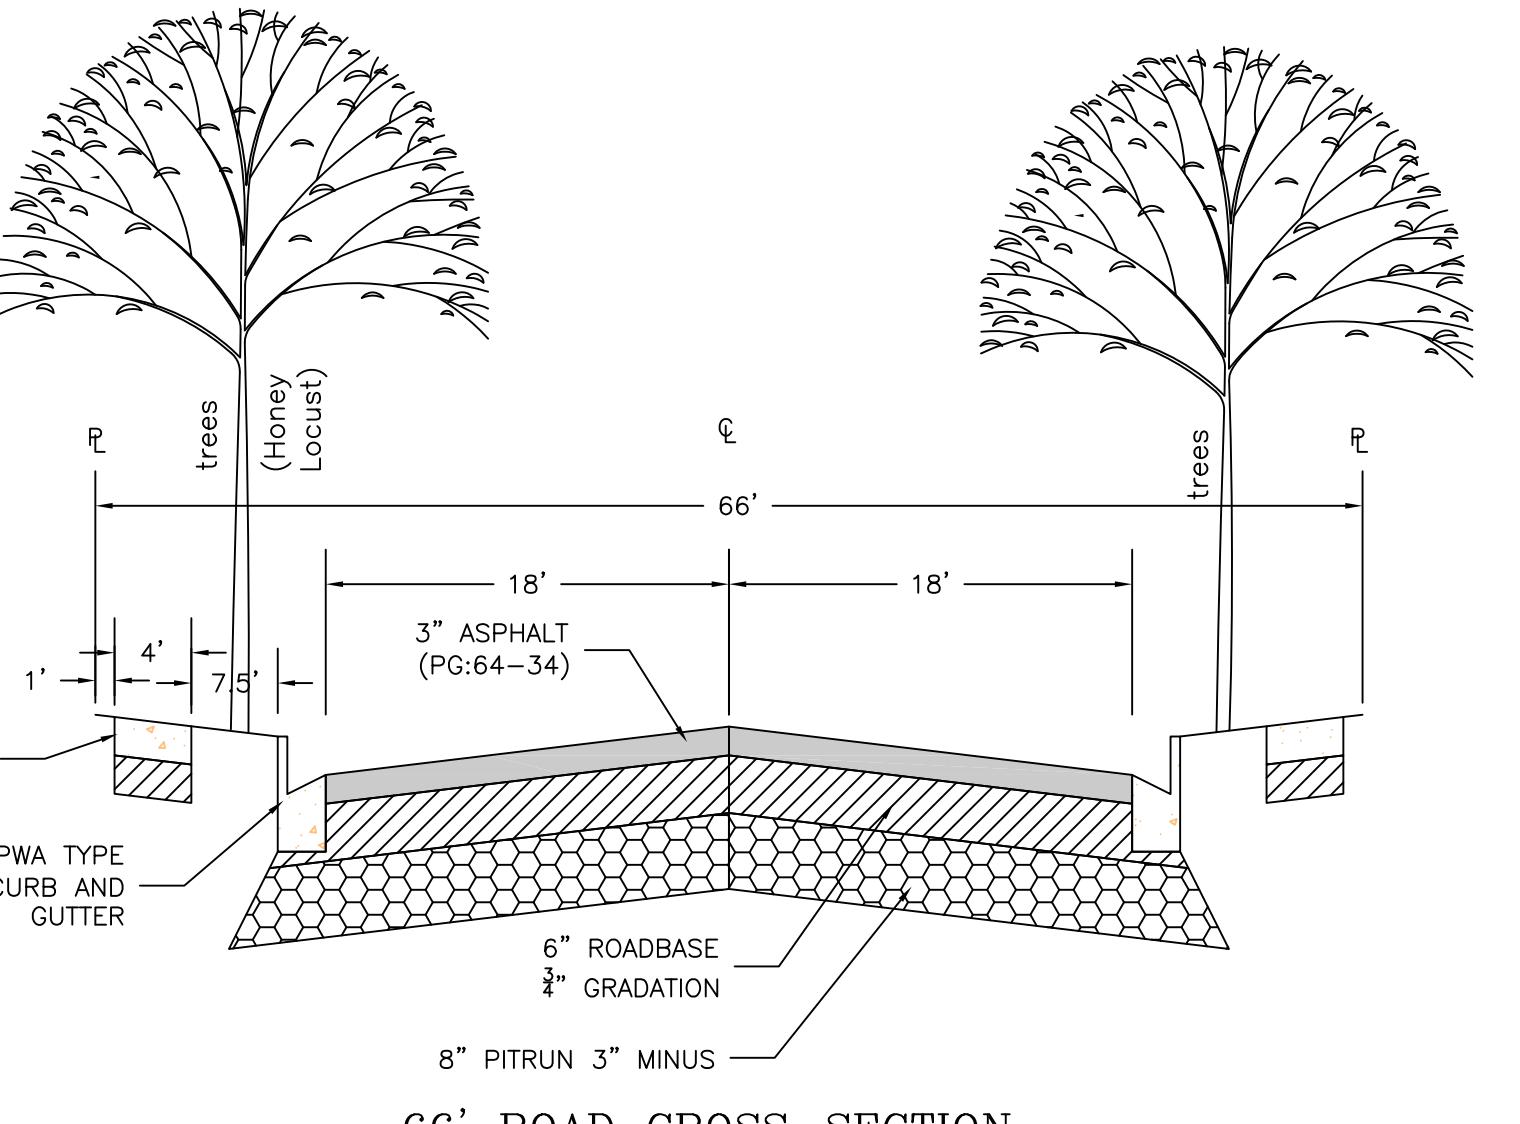


66' ROAD CROSS-SECTION

2" CALIPER TREE REQUIRED ON BOTH SIDES  
OF THE ROAD (EVERY 50') AS SHOWN

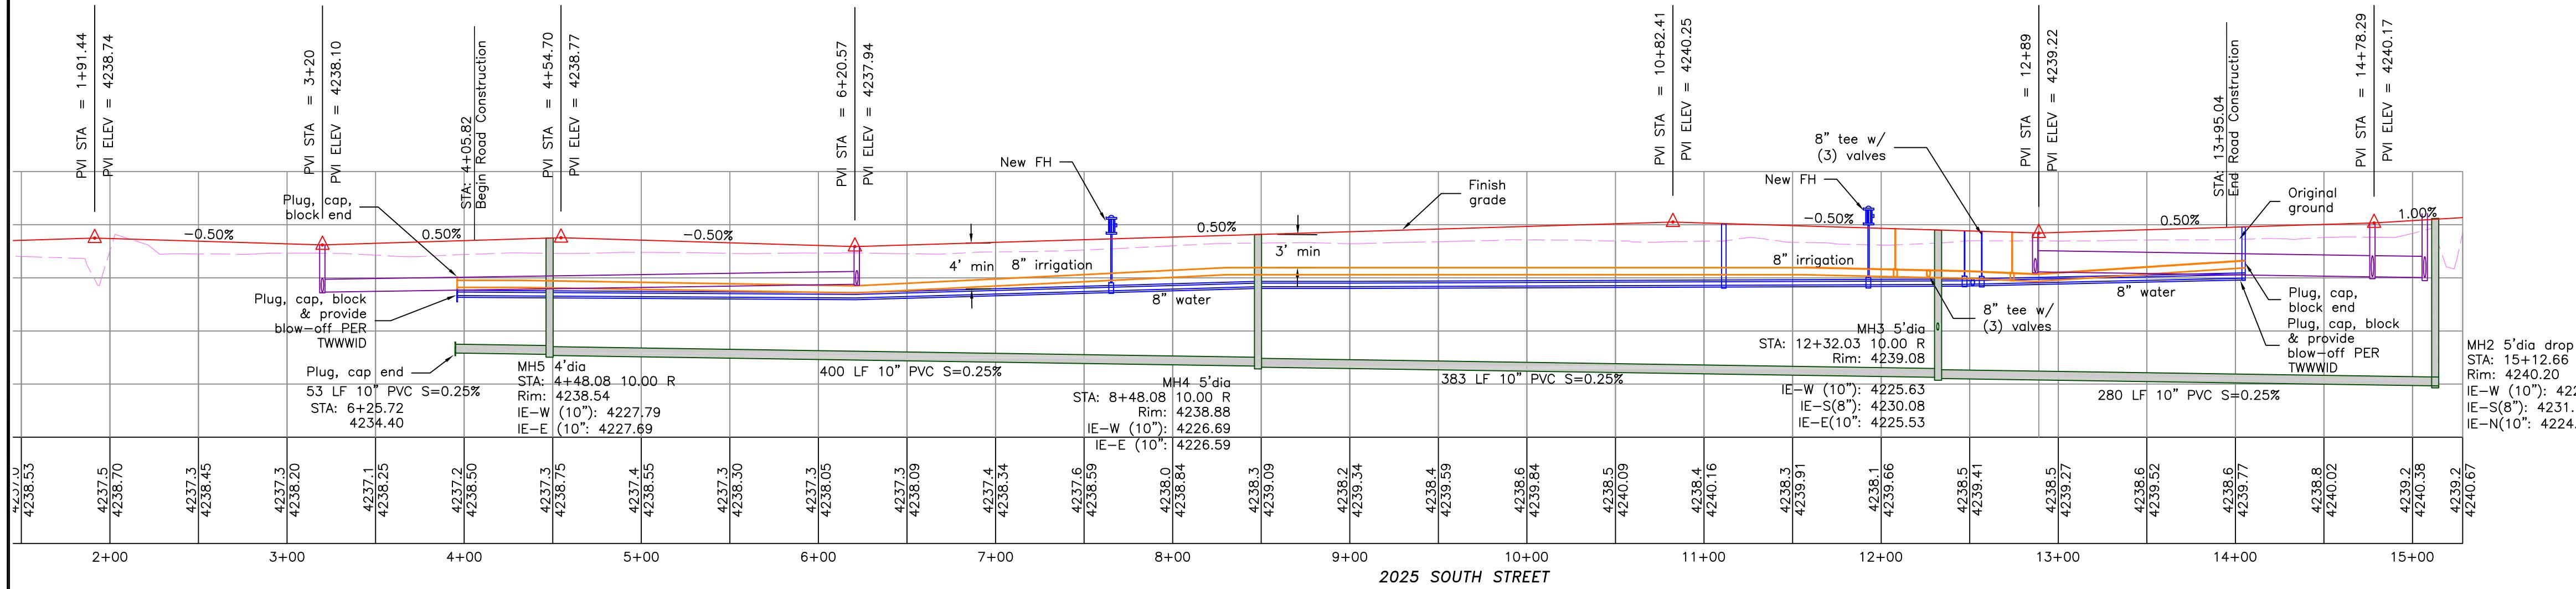

2025 SOUTH STREET

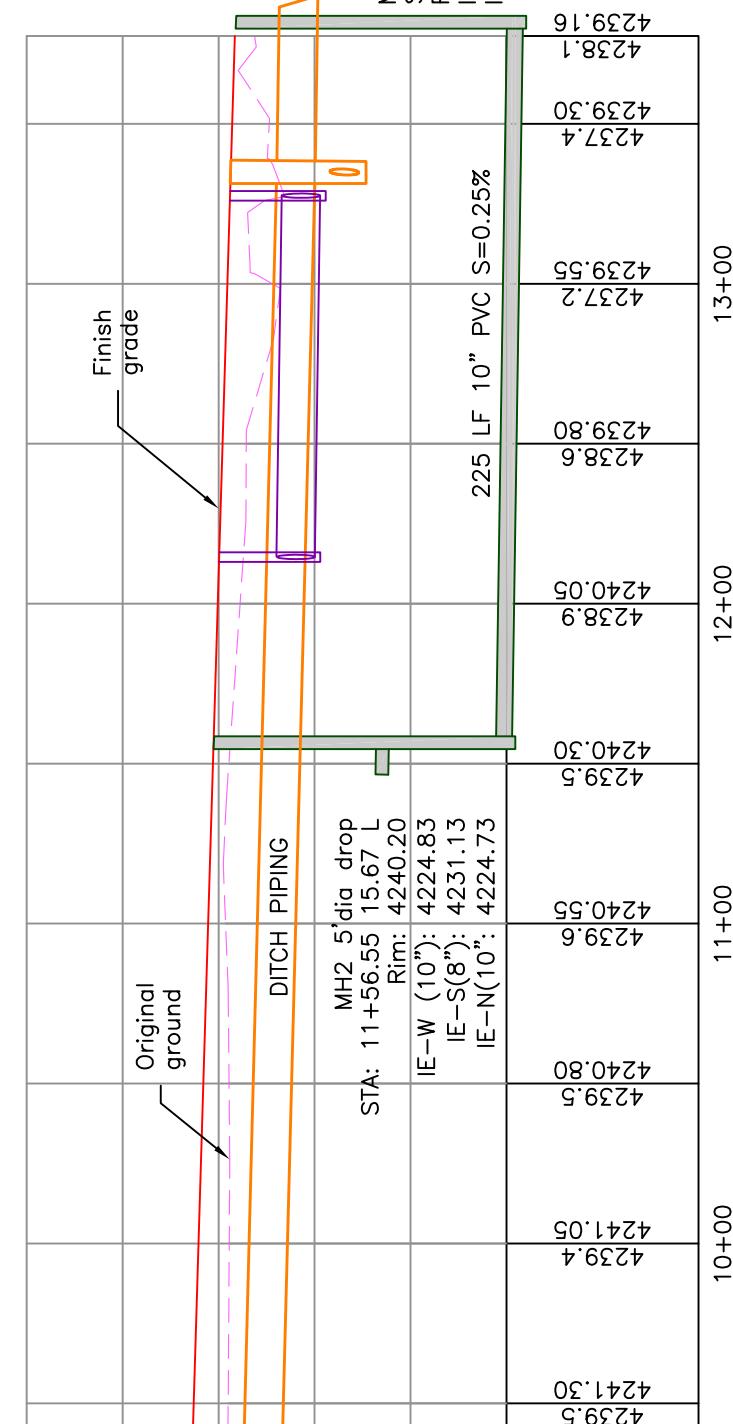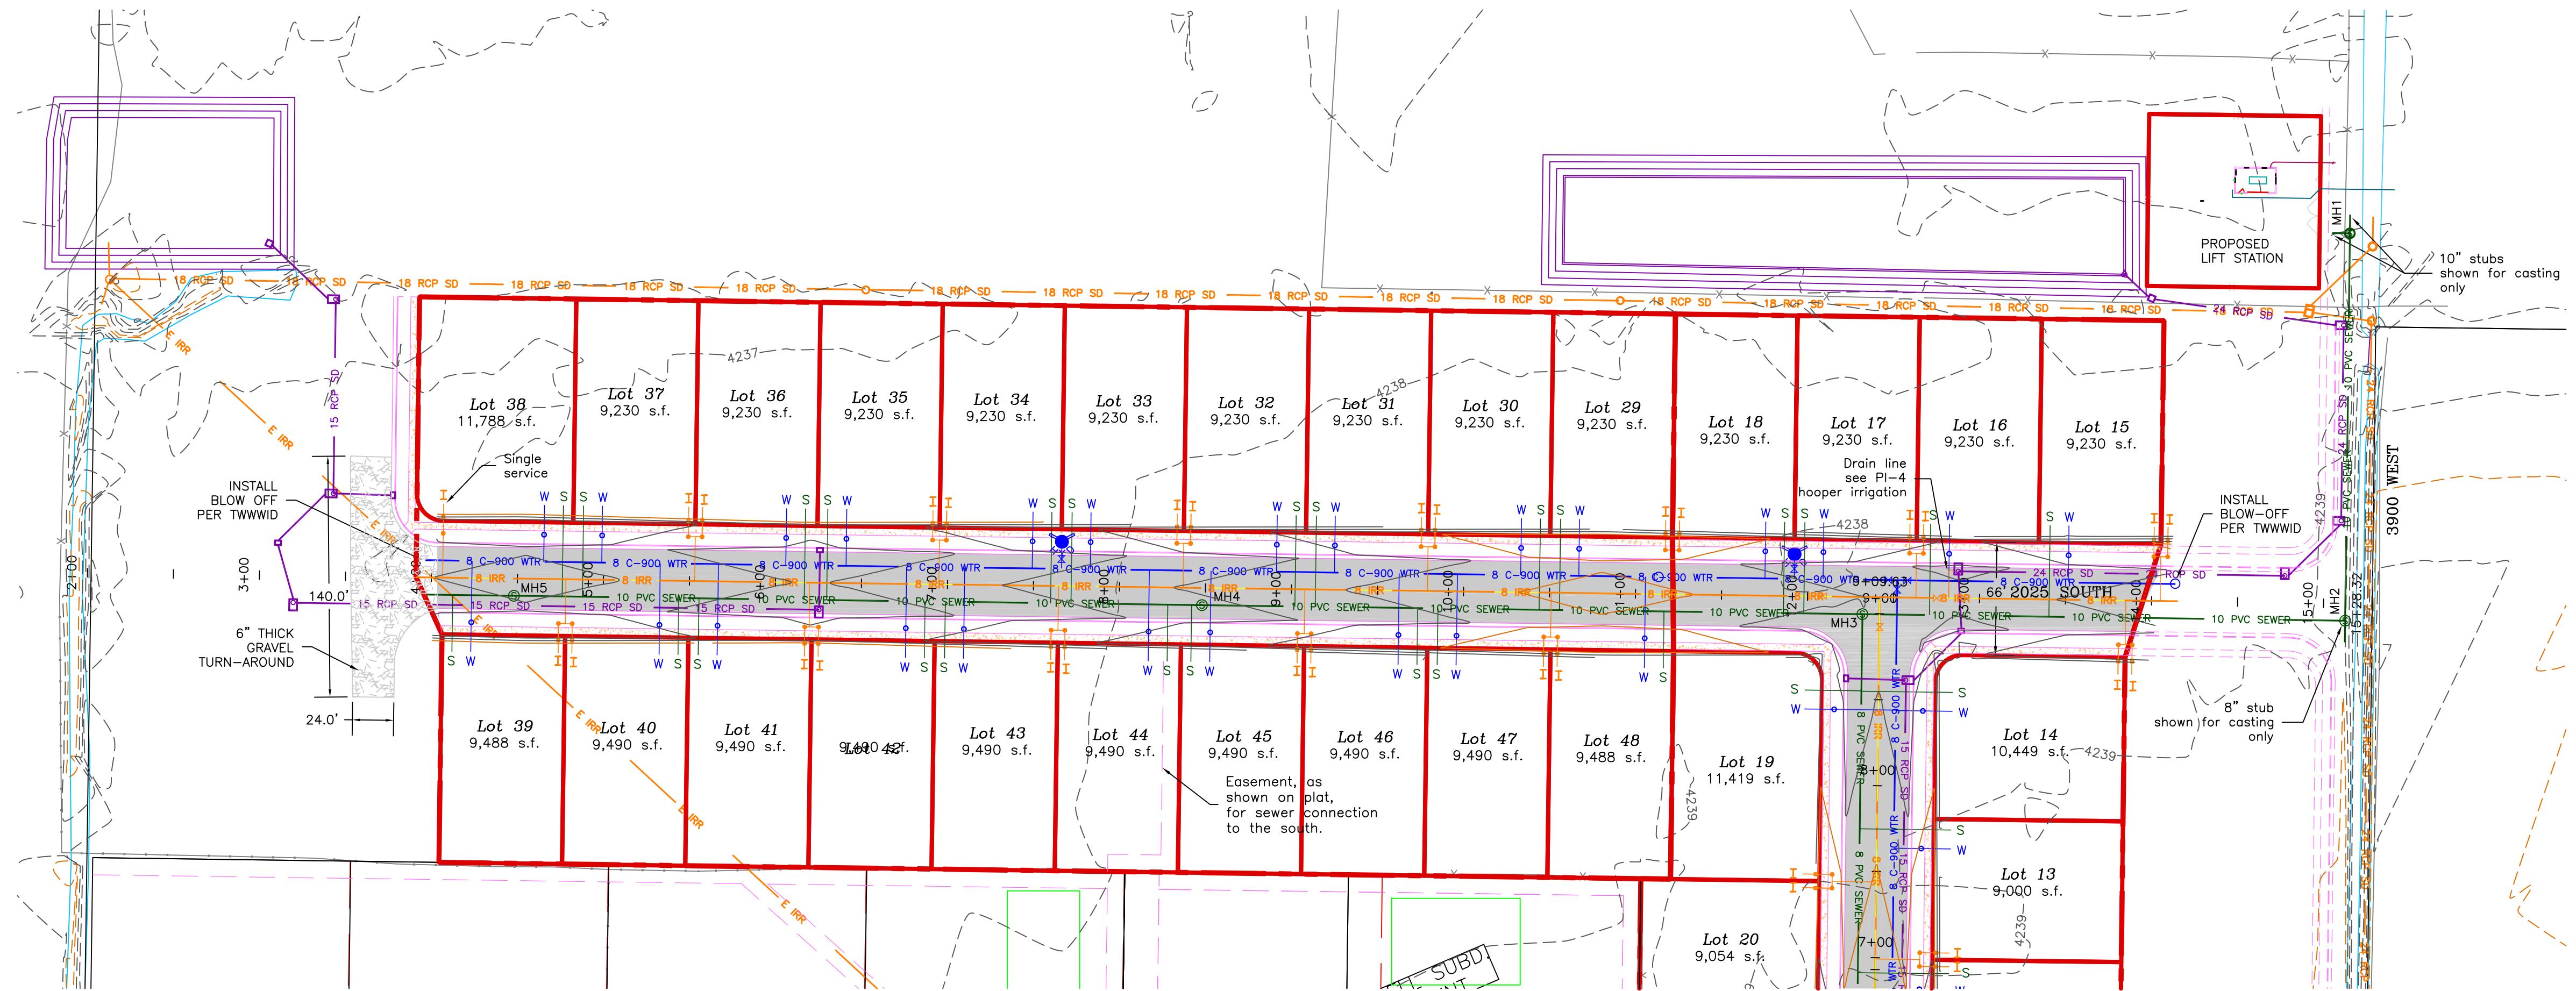

PROJECT TITLE : TAYLOR LANDING PHASE 1A/2  
A CLUSTER SUBDIVISION  
DRAWING TITLE : 2025 SOUTH/3900 WEST ROAD PLAN  
DRAWING NO. : 4  
DATE : NOV,2020

**ALLIANCE CONSULTING  
ENGINEERS**  
150 EAST 200 PSI POLY WATER SERVICE  
LOGAN, UTAH 84321  
(435)755-5121  
alliancebgm@yahoo.com

CONFIDENTIALITY AND COPYRIGHT NOTICE

UNAUTHORIZED USE, DISCLOSURE, OR COPYING OF THIS

DRAWING IS PROHIBITED.

CONSTRUCTION DOCUMENTS THAT ARE DISTRIBUTED FOR

BIDDING PURPOSES SHALL NOT BE RETURNED AND SHALL

BE DESTROYED WITHIN 30 DAYS AFTER THE BID OPENING

BY THE PLAN HOLDER.

COPYRIGHT 2005

0 30 60 120  
SCALE: 1"=60' (22x34 PLAN SET)  
SCALE: 1"=10'-VERTICAL

- Boundary Line
- Lot Line
- Centerline
- Utility Easement Line
- Future Road Shown for Reference
- Existing Fence
- Existing Ditch
- E 8 C900 WTR
- PROPOSED 8" PVC C-900 DR 18 WATER
- PROPOSED 1" CTS 200 PSI POLY WATER SERVICE
- E 30-CONC-SWR
- EXISTING SEWER AS NOTED
- PROPOSED 8" SDR 35 SEWER AS NOTED
- PROPOSED 10" SDR 35 SEWER AS NOTED
- S PROPOSED 4" SEWER LATERAL
- E 12 DI IRR
- PROPOSED 8" PVC C-900 DR18 IRRIGATION MAIN
- 8 IRR
- PROPOSED 12" PVC C-900 DR18 IRRIGATION MAIN
- 12 IRR
- PROPOSED IRRIGATION SERVICE PER HOOPER  
IRRIGATION COMPANY (see Pl-10 hooper irrigation,  
double service unless otherwise noted)
- 15 E ADS SD
- EXISTING STORM SYSTEM
- 15 RCP SD
- PROPOSED STORM SYSTEM AS NOTED
- 15 RCP SD
- EXISTING MAJOR CONTOUR (5')
- EXISTING MINOR CONTOUR (1')
- X Existing Asphalt
- PROPOSED ASPHALT
- PROPOSED CONCRETE



# TAYLOR LANDING PHASE 1A/2

## A CLUSTER SUBDIVISION

PART OF THE NORTH HALF OF SECTION 28, TOWNSHIP 6

NORTH, RANGE 2 WEST,  
SALT LAKE BASELINE AND MERIDIAN

WEBER COUNTY, TAYLOR, UTAH

### IRRIGATION RE-ROUTE



0 30 60 120

SCALE: 1"=60' (22x34 PLAN SET)


150 EAST 200 NORTH SUITE P

LOGAN, UTAH 84321

(435)755-5121

allianceengineering@yahoo.com

**ALLIANCE CONSULTING  
ENGINEERS**

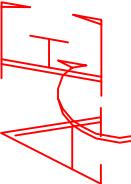

CONFIDENTIALITY AND COPYRIGHT NOTICE  
UNAUTHORIZED USE, DISCLOSURE, OR COPYING OF THIS  
CONSTRUCTION DOCUMENTS THAT ARE DISTRIBUTED FOR  
BIDDING PURPOSES SHALL NOT BE RETURNED AND SHALL  
BE DESTROYED WITHIN 30 DAYS AFTER THE BID OPENING  
BY THE PLAN HOLDER.

COPYRIGHT 2005


| REVISIONS/ SUBMISSIONS | DATE |
|------------------------|------|
|                        |      |
|                        |      |
| PROJECT TITLE             | DRAWING TITLE       |
|---------------------------|---------------------|
| TAYLOR LANDING PHASE 1A/2 | IRRIGATION RE-ROUTE |
| A CLUSTER SUBDIVISION     |                     |
|                           |                     |


DATE : NOV,2020  
DRAWING NO. 5

5

Will need something from the irrigation company/users on this design. This is not ideal but not sure how else to address it without separating them.

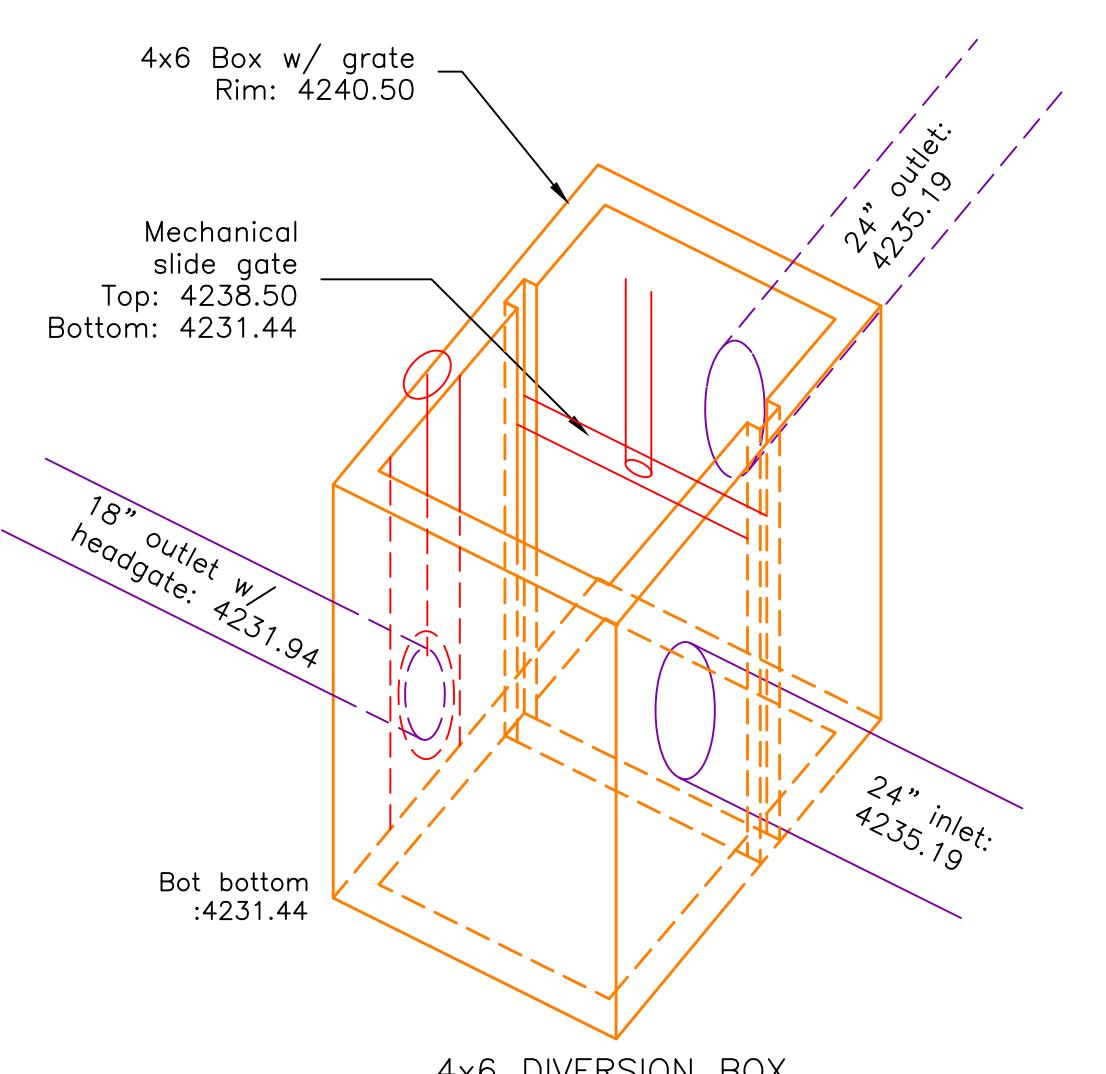


With mechanical slide gate open water freely flows through the box and out the 24" outlet. With the mechanical slide gate closed the 18" irrigation outlet can be opened and allow water to pass through for irrigation purposes to the west. If both gates are accidentally left closed water will pass over the mechanical slide gate and out the 24" outlet.

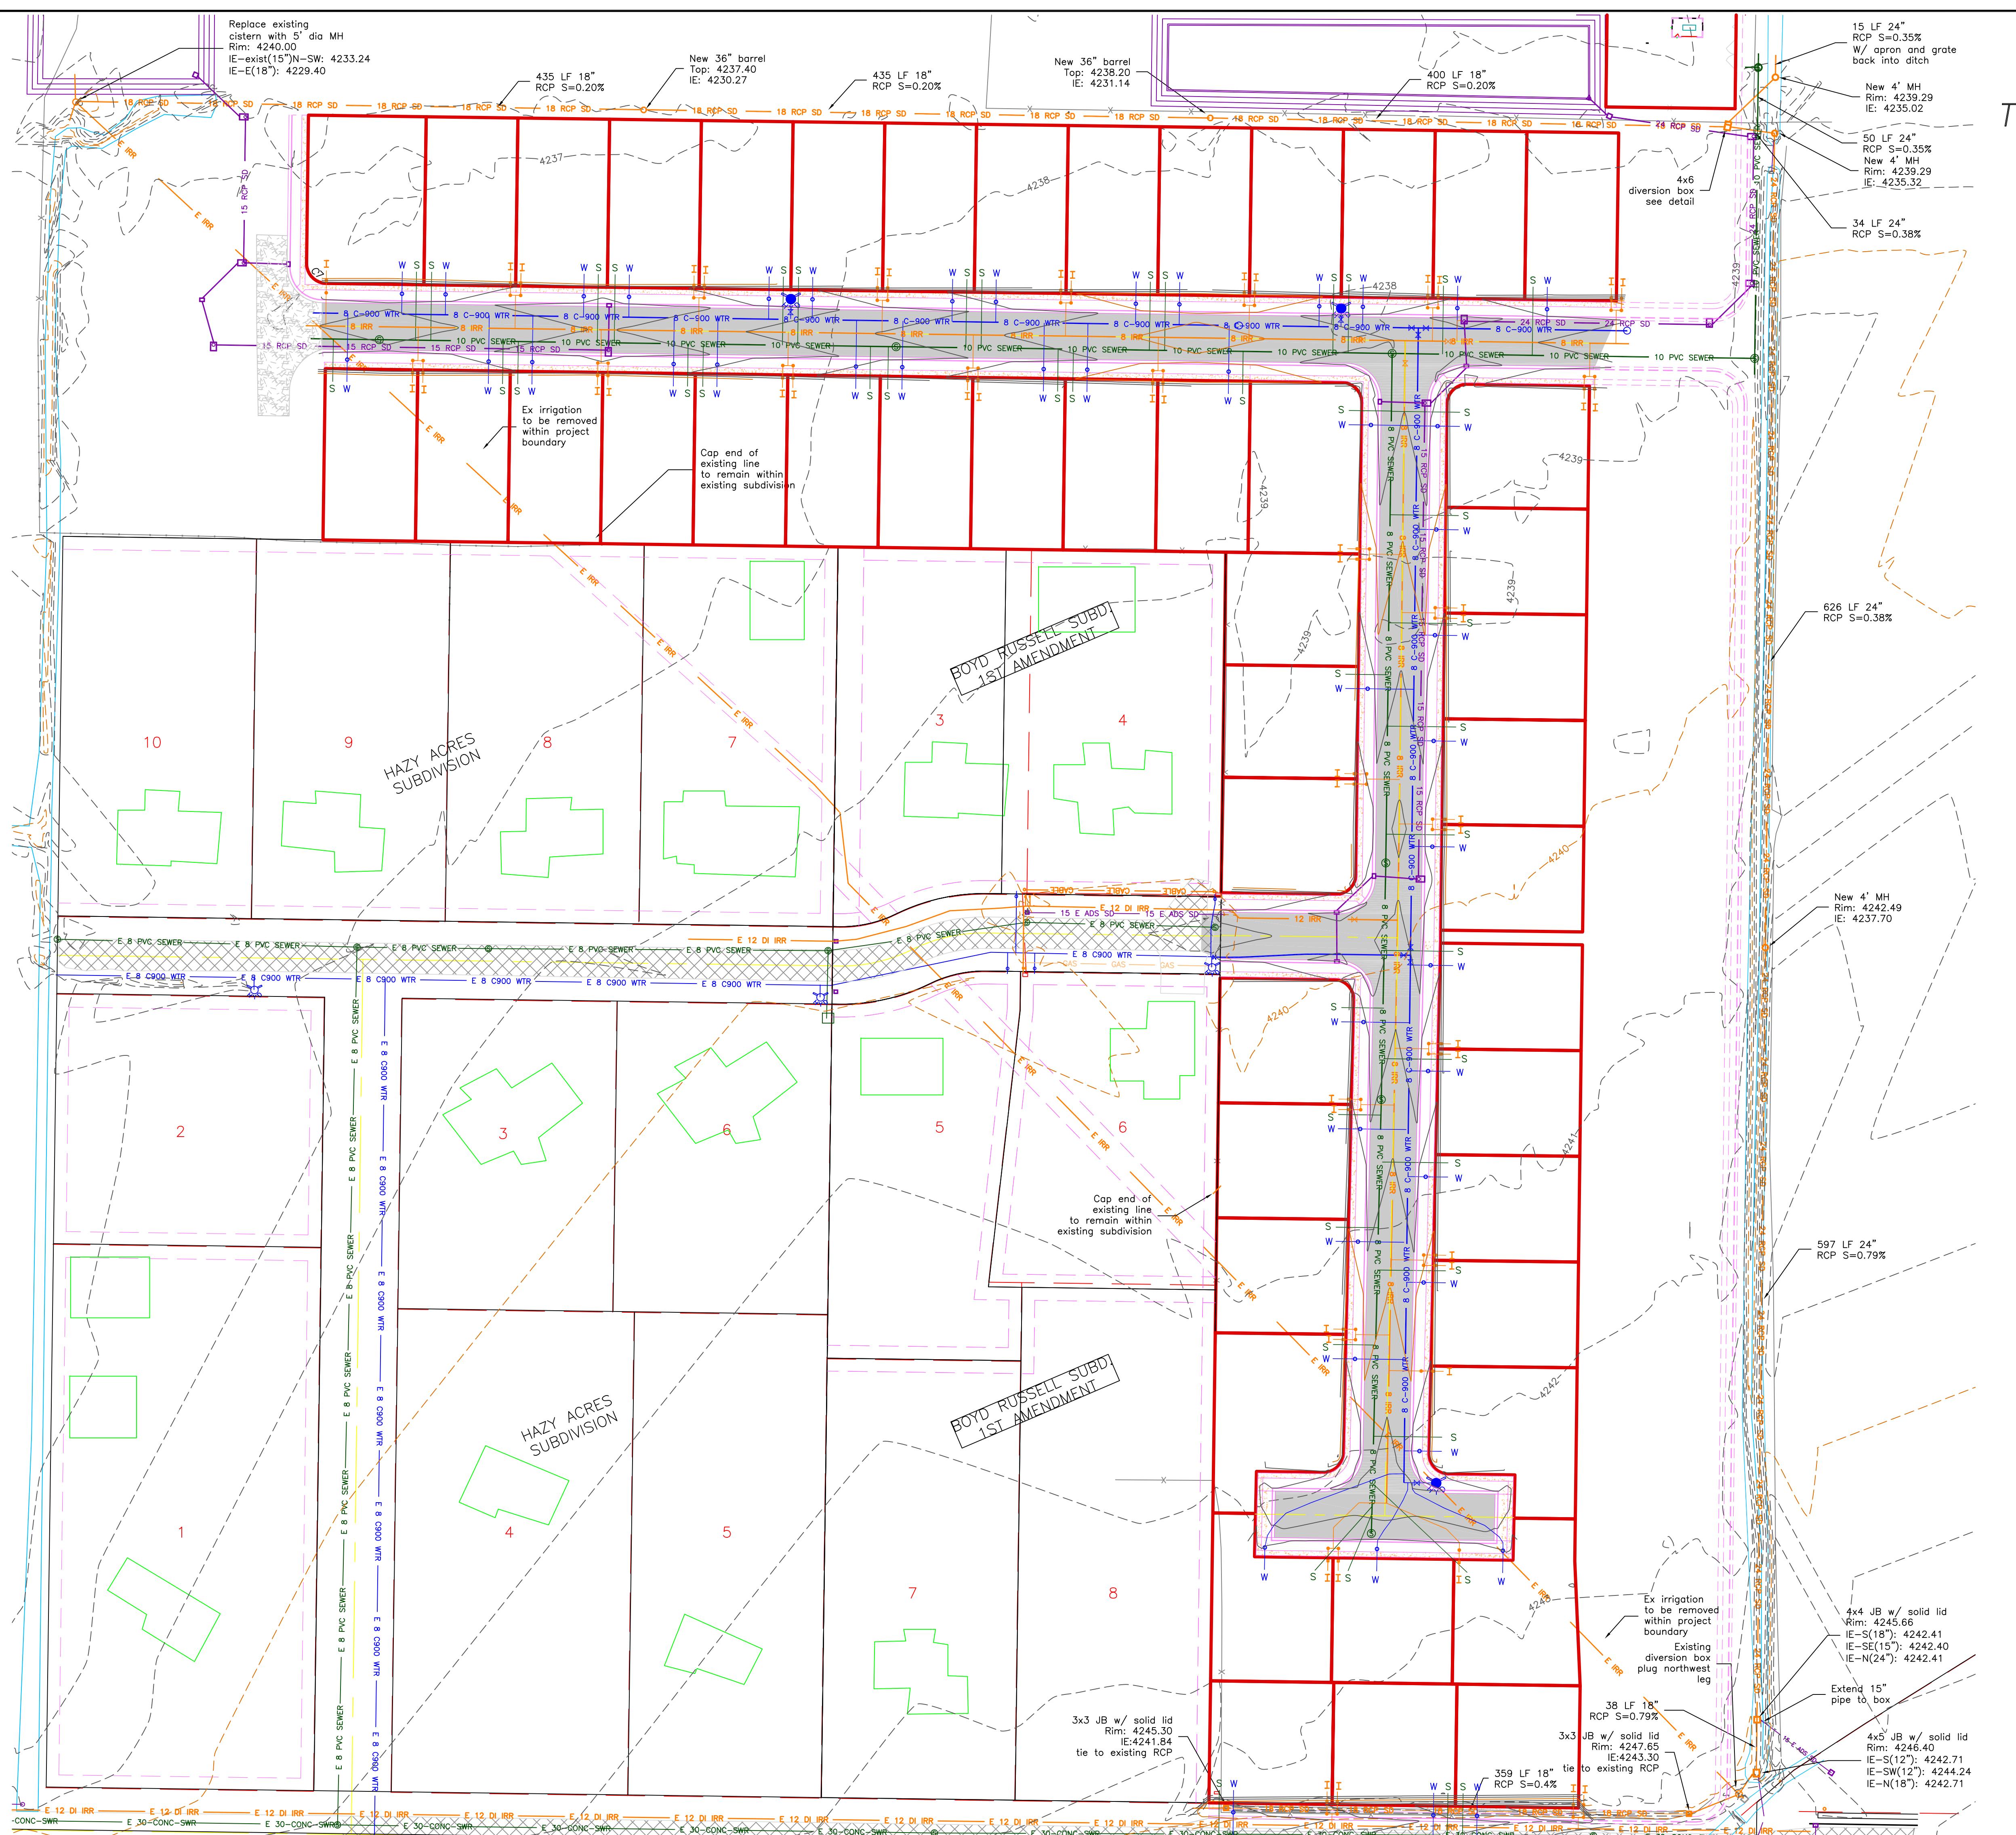

# TAYLOR LANDING PHASE 1A/2

## A CLUSTER SUBDIVISION

PART OF THE NORTH HALF OF SECTION 28, TOWNSHIP 6  
NORTH, RANGE 2 WEST,  
SALT LAKE BASELINE AND MERIDIAN  
WEBER COUNTY, TAYLOR, UTAH


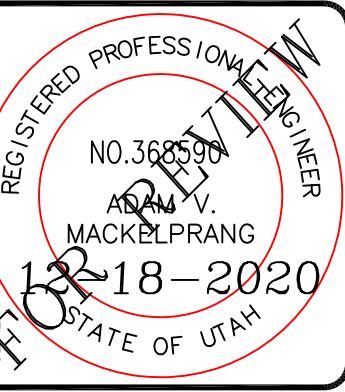


## EAST GRADING/ DRAINAGE PLAN



0 30 60 120  
SCALE: 1" = 60' (22x34 PLAN SET)

|   |
|---|
| <b>BOUNDARY LINE</b>  |
| <b>LOT LINE</b>   |
| <b>CENTERLINE</b>   |
| <b>UTILITY EASEMENT LINE</b>  |
| <b>EXISTING FENCE</b>   |
| <b>EXISTING WATER AS NOTED</b>  |
| <b>PROPOSED 8" PVC C-900 DR 18 WATER</b>  |
| <b>PROPOSED 1" CTS 200 PSI POLY WATER SERVICE</b>   |
| <b>EXISTING SEWER AS NOTED</b>  |
| <b>PROPOSED 8" SDR 35 SEWER AS NOTED</b>  |
| <b>PROPOSED 4" SEWER LATERAL</b>  |
| <b>EXISTING 12" DI IRRIGATION</b>   |
| <b>PROPOSED 8" PVC C-900 DR18 IRRIGATION MAIN</b>   |
| <b>PROPOSED 12" PVC C-909 DR18 IRRIGATION MAIN</b>  |
| <b>PROPOSED IRRIGATION SERVICE PER HOOVER IRRIGATION COMPANY (see PI-10 hooper irrigation, double service unless otherwise noted)</b> |
| <b>EXISTING STORM SYSTEM</b>  |
| <b>PROPOSED STORM SYSTEM AS NOTED</b>   |
| <b>EXISTING MAJOR CONTOUR (5')</b>  |
| <b>EXISTING MINOR CONTOUR (1')</b>  |
| <b>EXISTING ASPHALT</b>   |
| <b>PROPOSED ASPHALT</b>   |
| <b>PROPOSED CONCRETE</b>  |

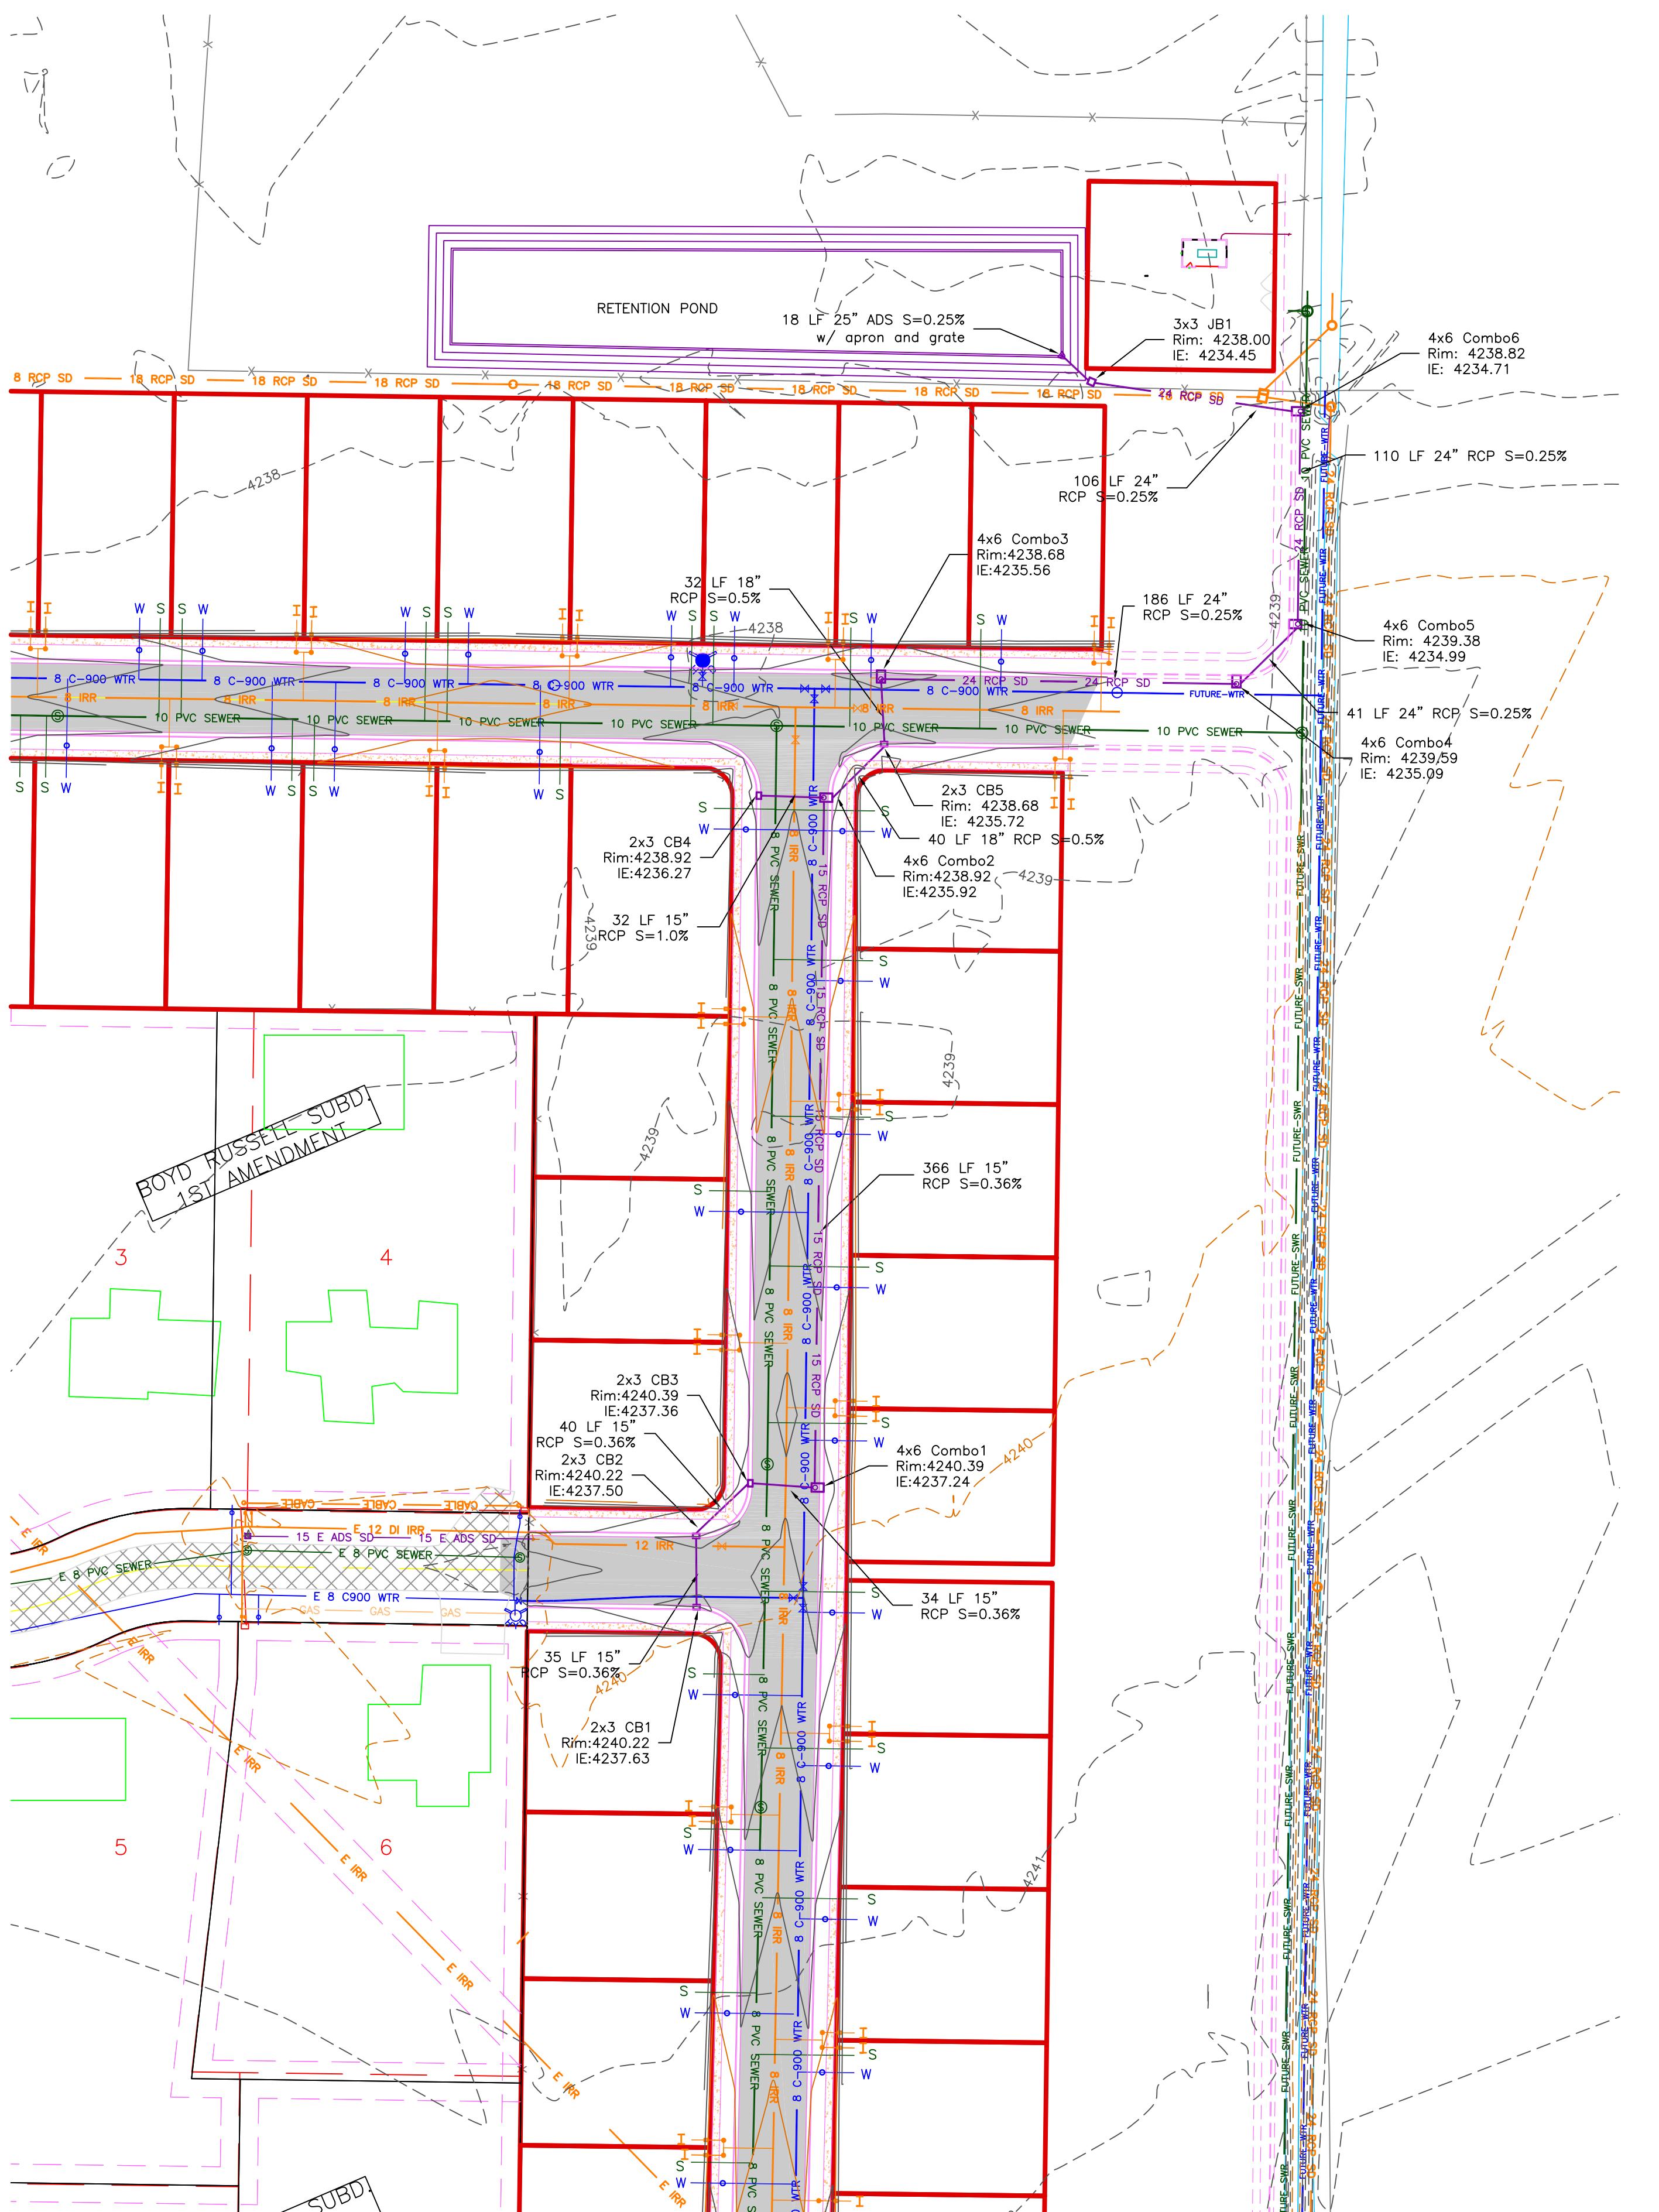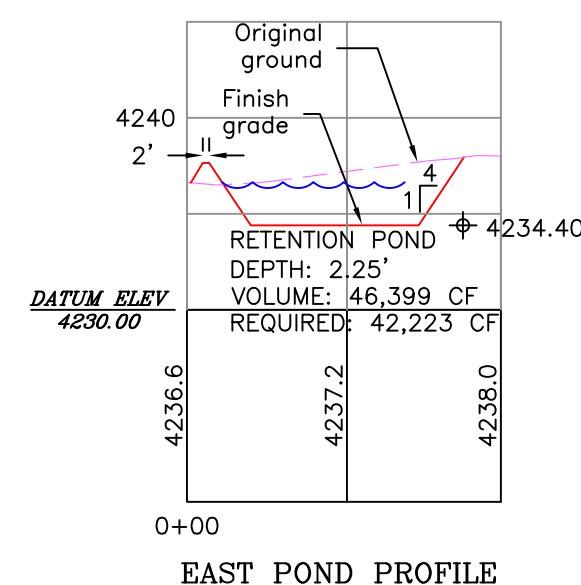

ALLIANCE CONSULTING  
ENGINEERS  
107  
150 EAST 200 NORTH SUITE P  
LOGAN, UTAH 84321  
(435)755-5121  
alliancebgm@yahoo.com

CONFIDENTIALITY AND COPYRIGHT NOTICE  
UNAUTHORIZED USE, DISCLOSURE, OR COPYING OF THIS  
CONSTRUCTION DOCUMENTS THAT ARE DISTRIBUTED FOR  
BUILDING PURPOSES SHALL NOT BE RETURNED AND SHALL  
BE DESTROYED WITHIN 30 DAYS AFTER THE BIO OPENING  
BY THE PLAN HOLDER.

COPYRIGHT 2005


| No. | REVISIONS/ SUBMISSIONS | DATE |
|-----|------------------------|------|
|     |                        |      |
|     |                        |      |
|     |                        |      |
|     |                        |      |

| PROJECT TITLE | TAYLOR LANDING PHASE 1A/2   |
|---------------|-----------------------------|
| DRAWING TITLE | A CLUSTER SUBDIVISION       |
| DRAWING No.   | EAST GRADING/ DRAINAGE PLAN |
| DATE :        | NOV,2020                    |
| DRAWING No.   | 6                           |



# TAYLOR LANDING PHASE 1A/2

## A CLUSTER SUBDIVISION

PART OF THE NORTH HALF OF SECTION 28, TOWNSHIP 6  
NORTH, RANGE 2 WEST,  
SALT LAKE BASELINE AND MERIDIAN  
WEBER COUNTY, TAYLOR, UTAH

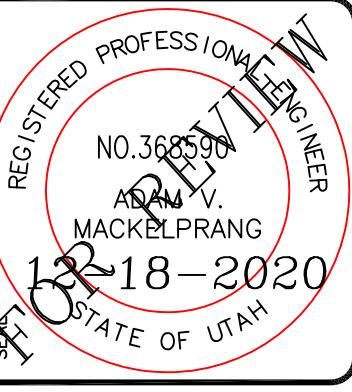

## WEST GRADING/ DRAINAGE PLAN

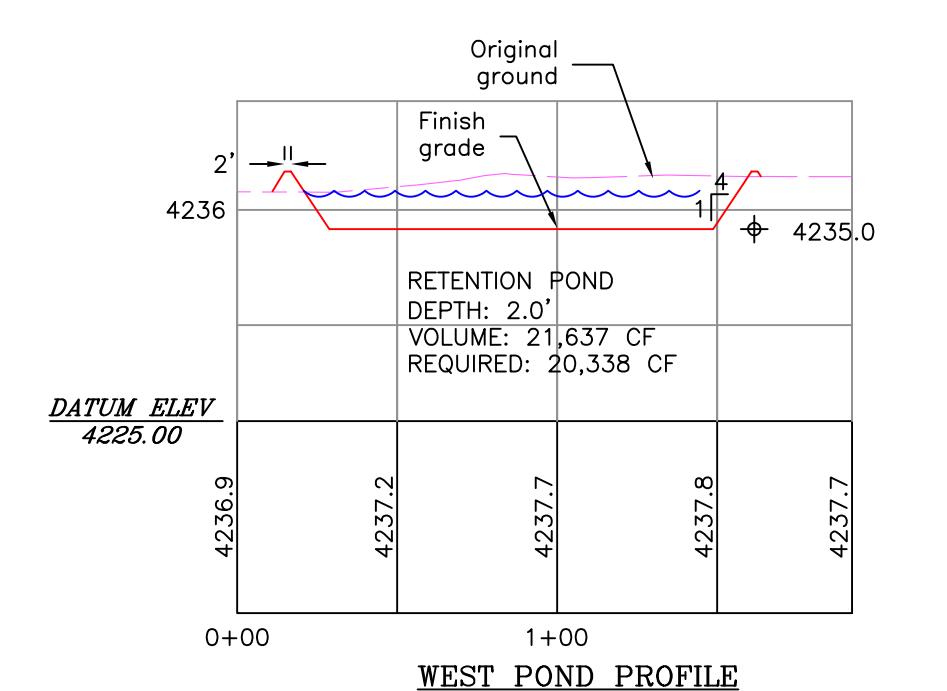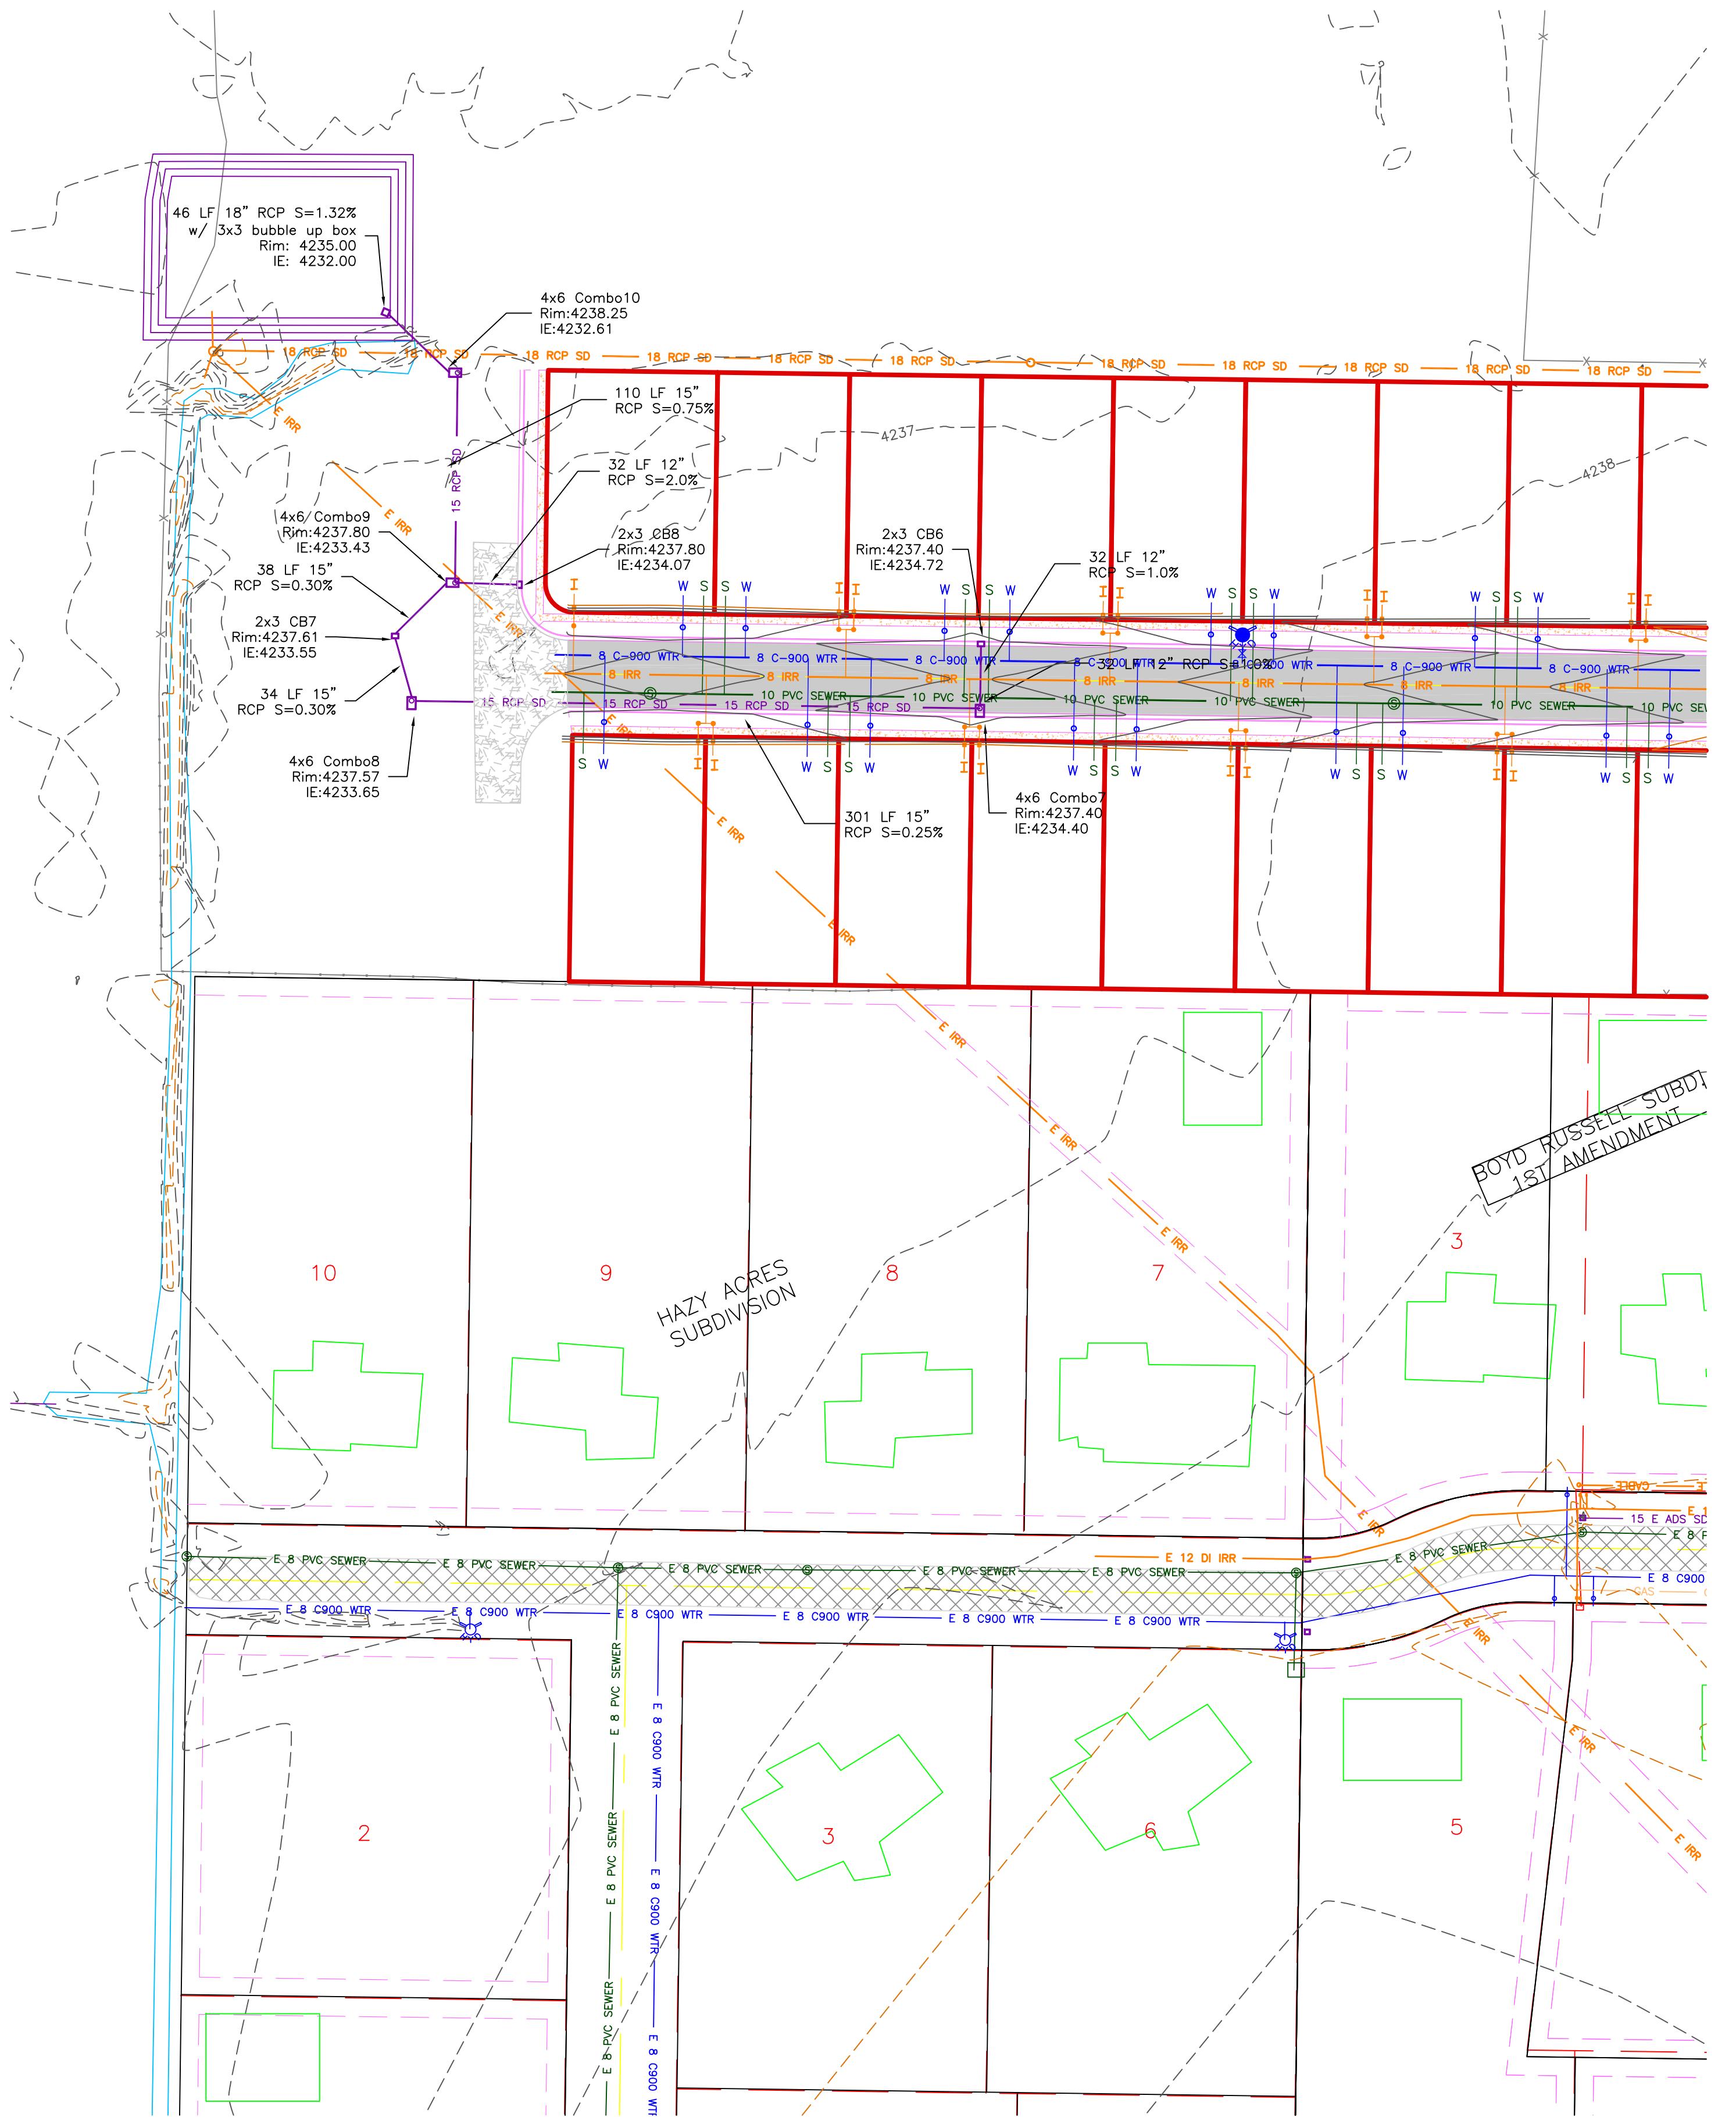

SCALE: 1" = 60' (22x34 PLAN SET)

- Boundary Line:** Red dashed line
- Lot Line:** Yellow dashed line
- Centerline:** Yellow solid line
- Utility Easement Line:** Pink dashed line
- Existing Fence:** Purple dashed line
- E 8 C 900 WTR:** Existing water as noted
- 8 C-900 WTR:** Proposed 8" PVC C-900 DR 18 WATER
- W:** Proposed 1" CTS 200 PSI POLY WATER SERVICE
- E 30-CONC-SWR:** Existing sewer as noted
- 8 PVC SEWER:** Proposed 8" SDR 35 SEWER AS NOTED
- S:** Proposed 4" SEWER LATERAL
- E 12 DI IRR:** Existing 12" DI IRRIGATION
- 8 IRR:** Proposed 8" PVC C-900 DR18 IRRIGATION MAIN
- 12 IRR:** Proposed 12" PVC C-900 DR18 IRRIGATION MAIN
- I:** Proposed irrigation service per Hooper Irrigation Company (see PI-10 hooper irrigation, double service unless otherwise noted)
- 15 E ADS SD:** Existing storm system
- 15 RCP SD:** Proposed storm system as noted
- Existing Major Contour (5'):** Orange dashed line
- Existing Minor Contour (1'):** Dashed line

**ALLIANCE CONSULTING ENGINEERS**  
150 EAST 200 NORTH SUITE P  
LOGAN, UTAH 84321  
(435) 5121  
alliancebegan@yahoo.com

CONFIDENTIAL AND COPYRIGHT NOTICE  
UNAUTHORIZED USE, DISCLOSURE, OR COPYING OF THIS  
DRAWING IS PROHIBITED.  
CONSTRUCTION DOCUMENTS THAT ARE DISTRIBUTED FOR  
BUILDING PURPOSES SHALL NOT BE RETURNED AND SHALL  
BE DESTROYED WITHIN 30 DAYS AFTER THE BID OPENING  
BY THE PLAN HOLDER.

COPYRIGHT 2005

|               |  |
|---------------|--|
| DATE          |  |
| REVIEWED      |  |
| CAD FILE      |  |
| PROJECT NO. : |  |
| DRAWN :       |  |

|                 |                           |
|-----------------|---------------------------|
| PROJECT TITLE   | TAYLOR LANDING PHASE 1A/2 |
| DRAWING TITLE   | A CLUSTER SUBDIVISION     |
| DATE : NOV,2020 |                           |
| DRAWING NO.     | 7                         |

**ALLIANCE CONSULTING**  
**ENGINEERS**  
150 EAST 200 NORTH SUITE P  
LOGAN, UTAH 84321  
(435)755-5121  
alliancebogm@yahoo.com

CONFIDENTIALITY AND COPYRIGHT NOTICE  
UNAUTHORIZED USE, DISCLOSURE, OR COPYING OF THIS  
DRAWING IS PROHIBITED.


CONSTRUCTION DOCUMENTS THAT ARE DISTRIBUTED FOR  
BIDDING PURPOSES SHALL NOT BE RETURNED AND SHALL  
BE DESTROYED WITHIN 30 DAYS AFTER THE BID OPENING  
BY THE FLAW OWNER.

COPYRIGHT 2005


|           |  |
|-----------|--|
| DATE:     |  |
| DRAWN:    |  |
| REVIEWED: |  |
| CD FILE:  |  |

|                |                        |
|----------------|------------------------|
| PROJECT TITLE: | TAYLOR LANDING PHASE 1 |
| DETAILS:       | A CLUSTER SUBDIVISION  |
| REVISION:      | 0                      |
| DRAWING NO.:   | NOV, 2020              |


DRAWING : NOV, 2020  
DRAWING NO. :

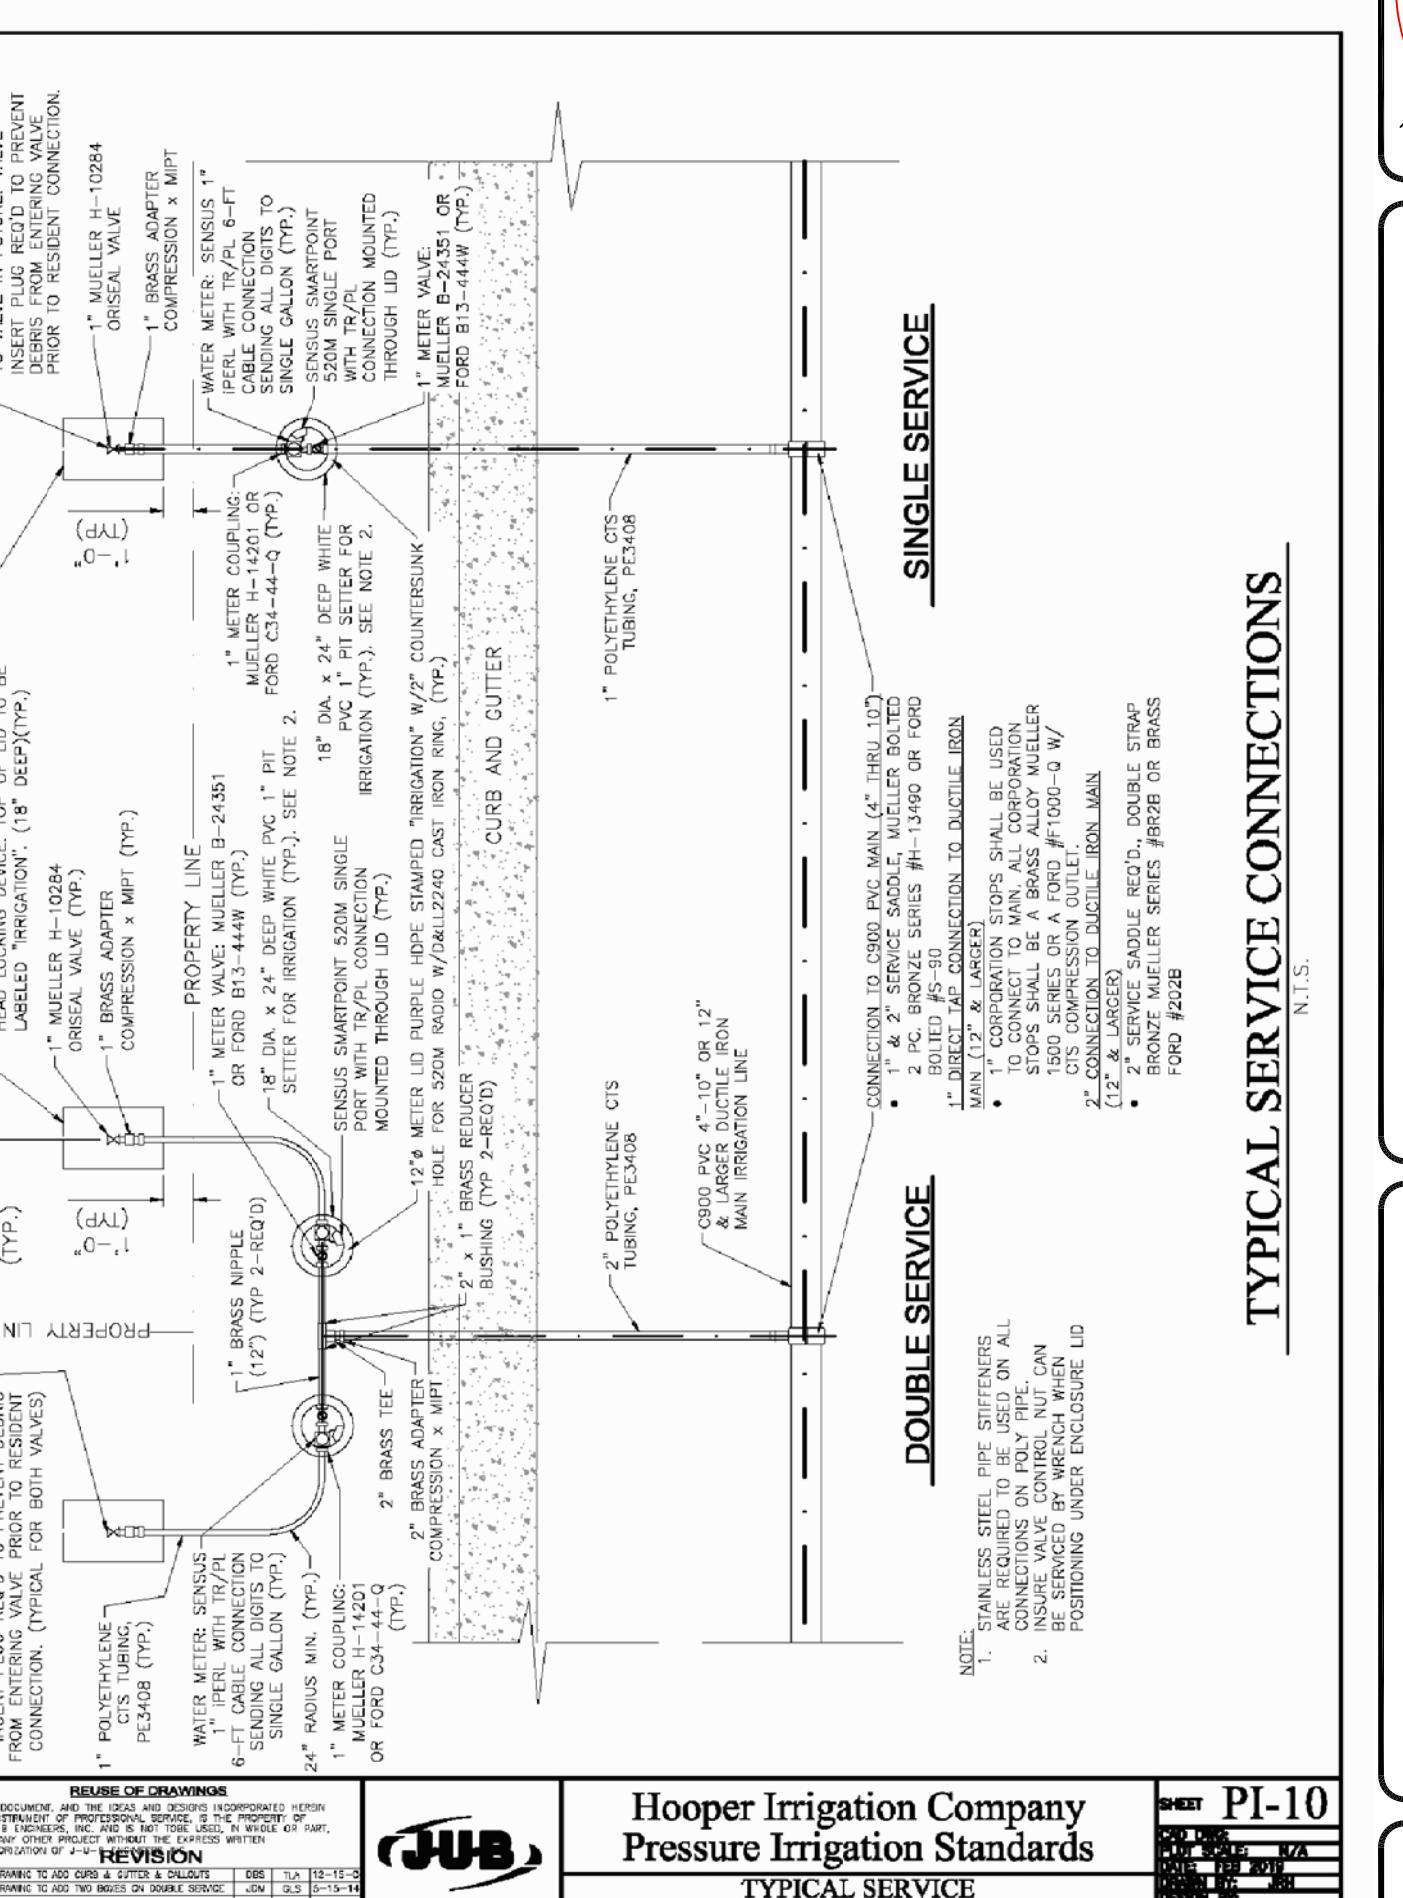


**Hooper Irrigation Company Pressure Irrigation Standards PI-10**

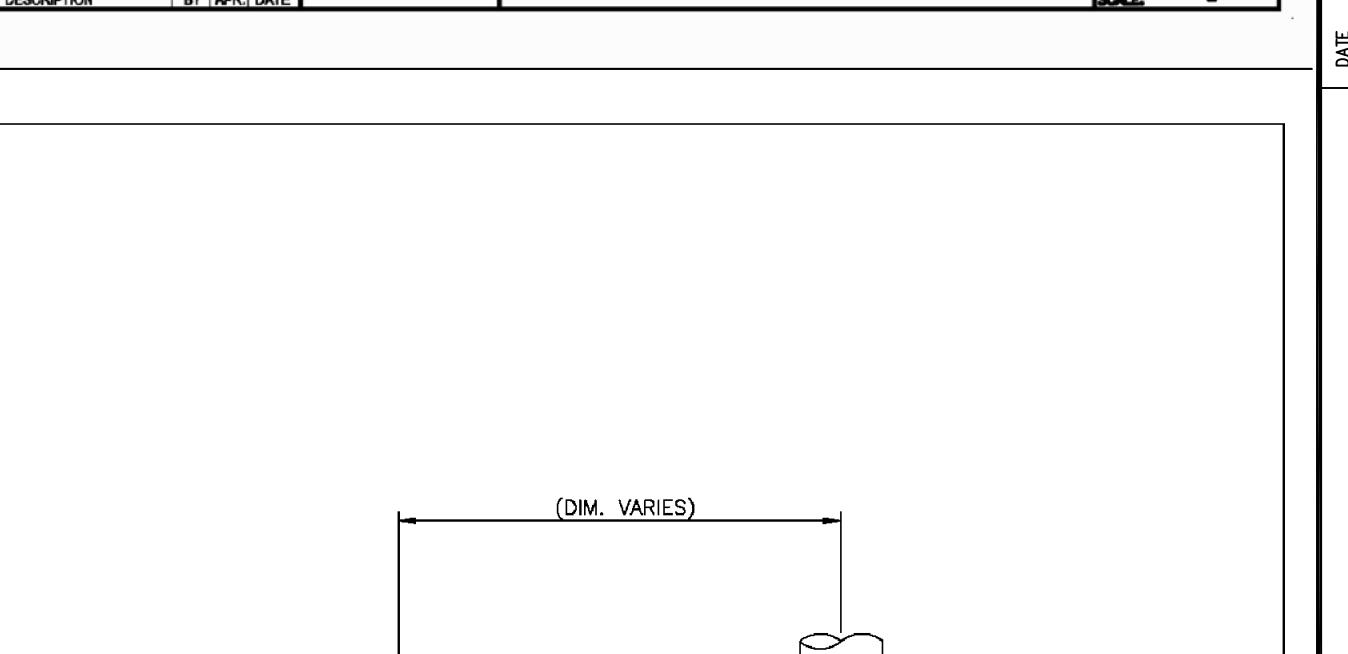


**Hooper Irrigation Company Pressure Irrigation Standards PI-4**

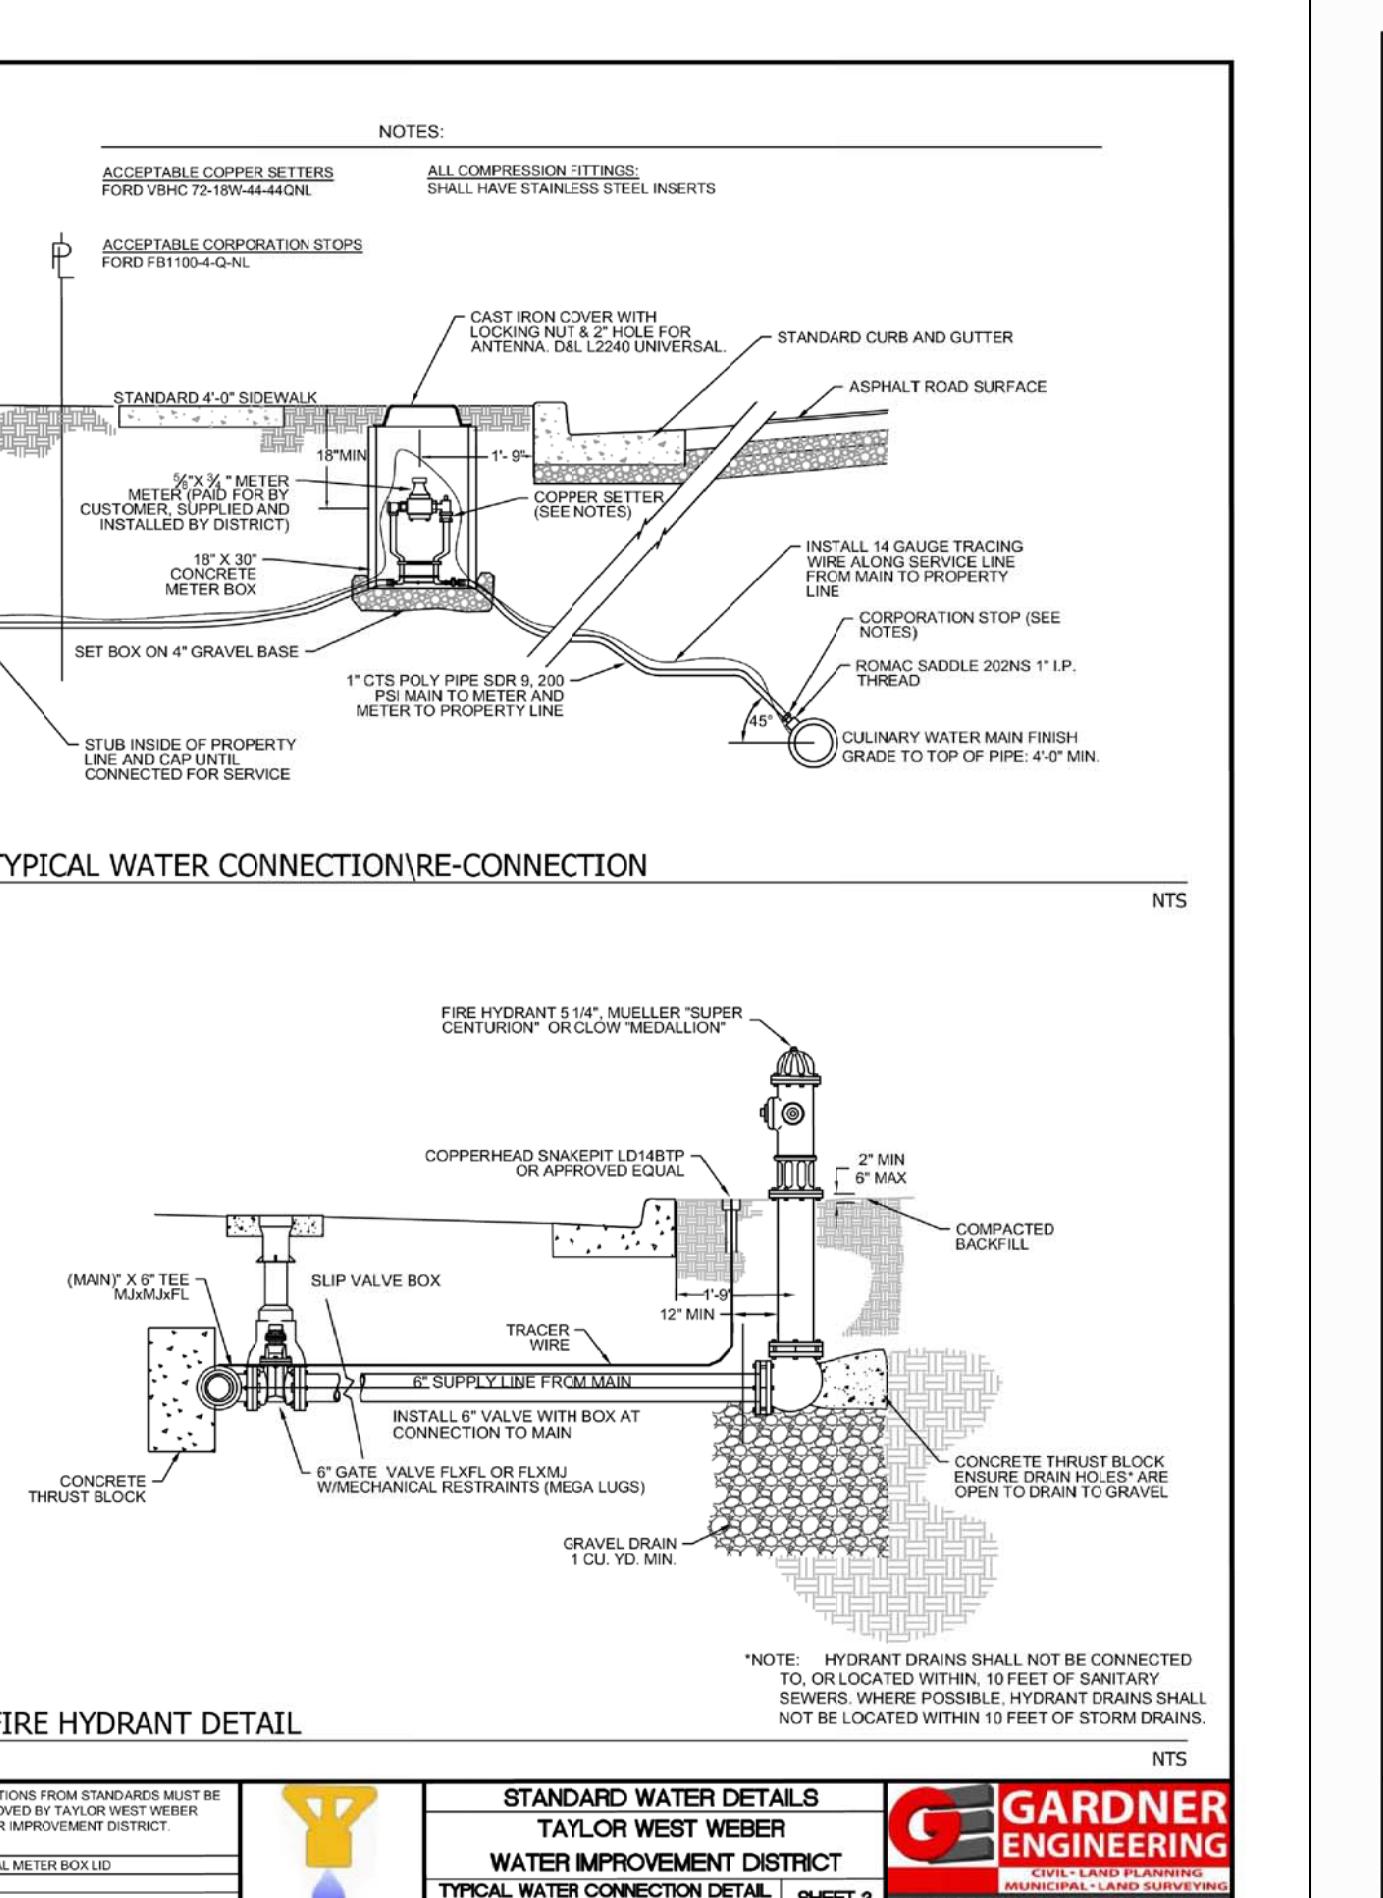


**FIRE HYDRANT DETAIL**

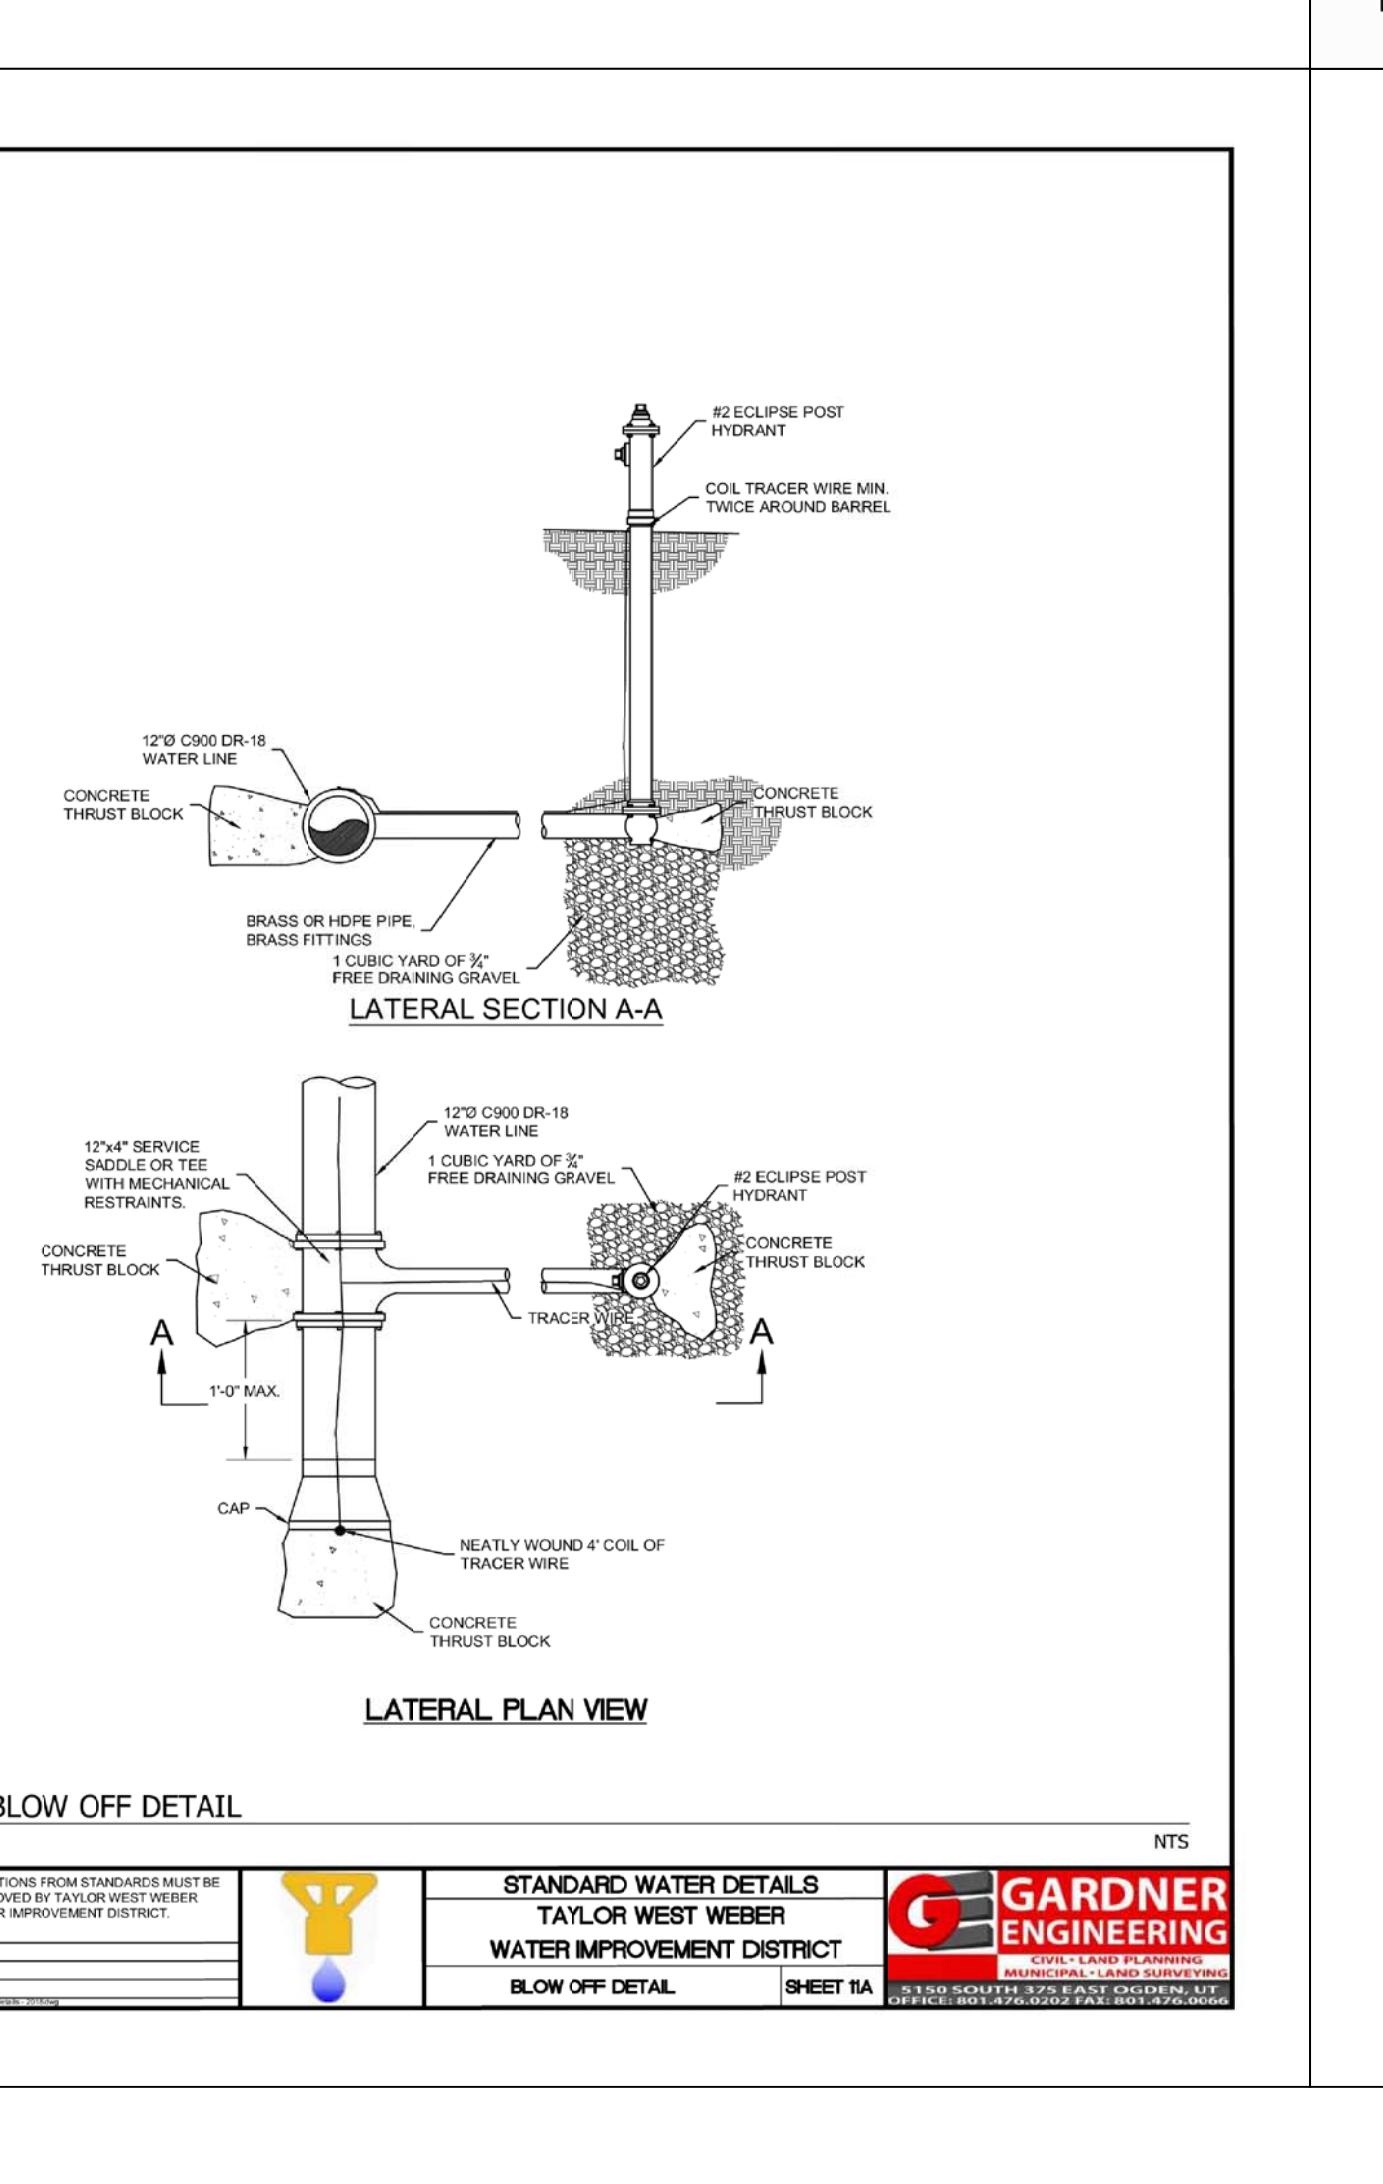








**LOCAL / SYSTEM DRAIN DETAIL**

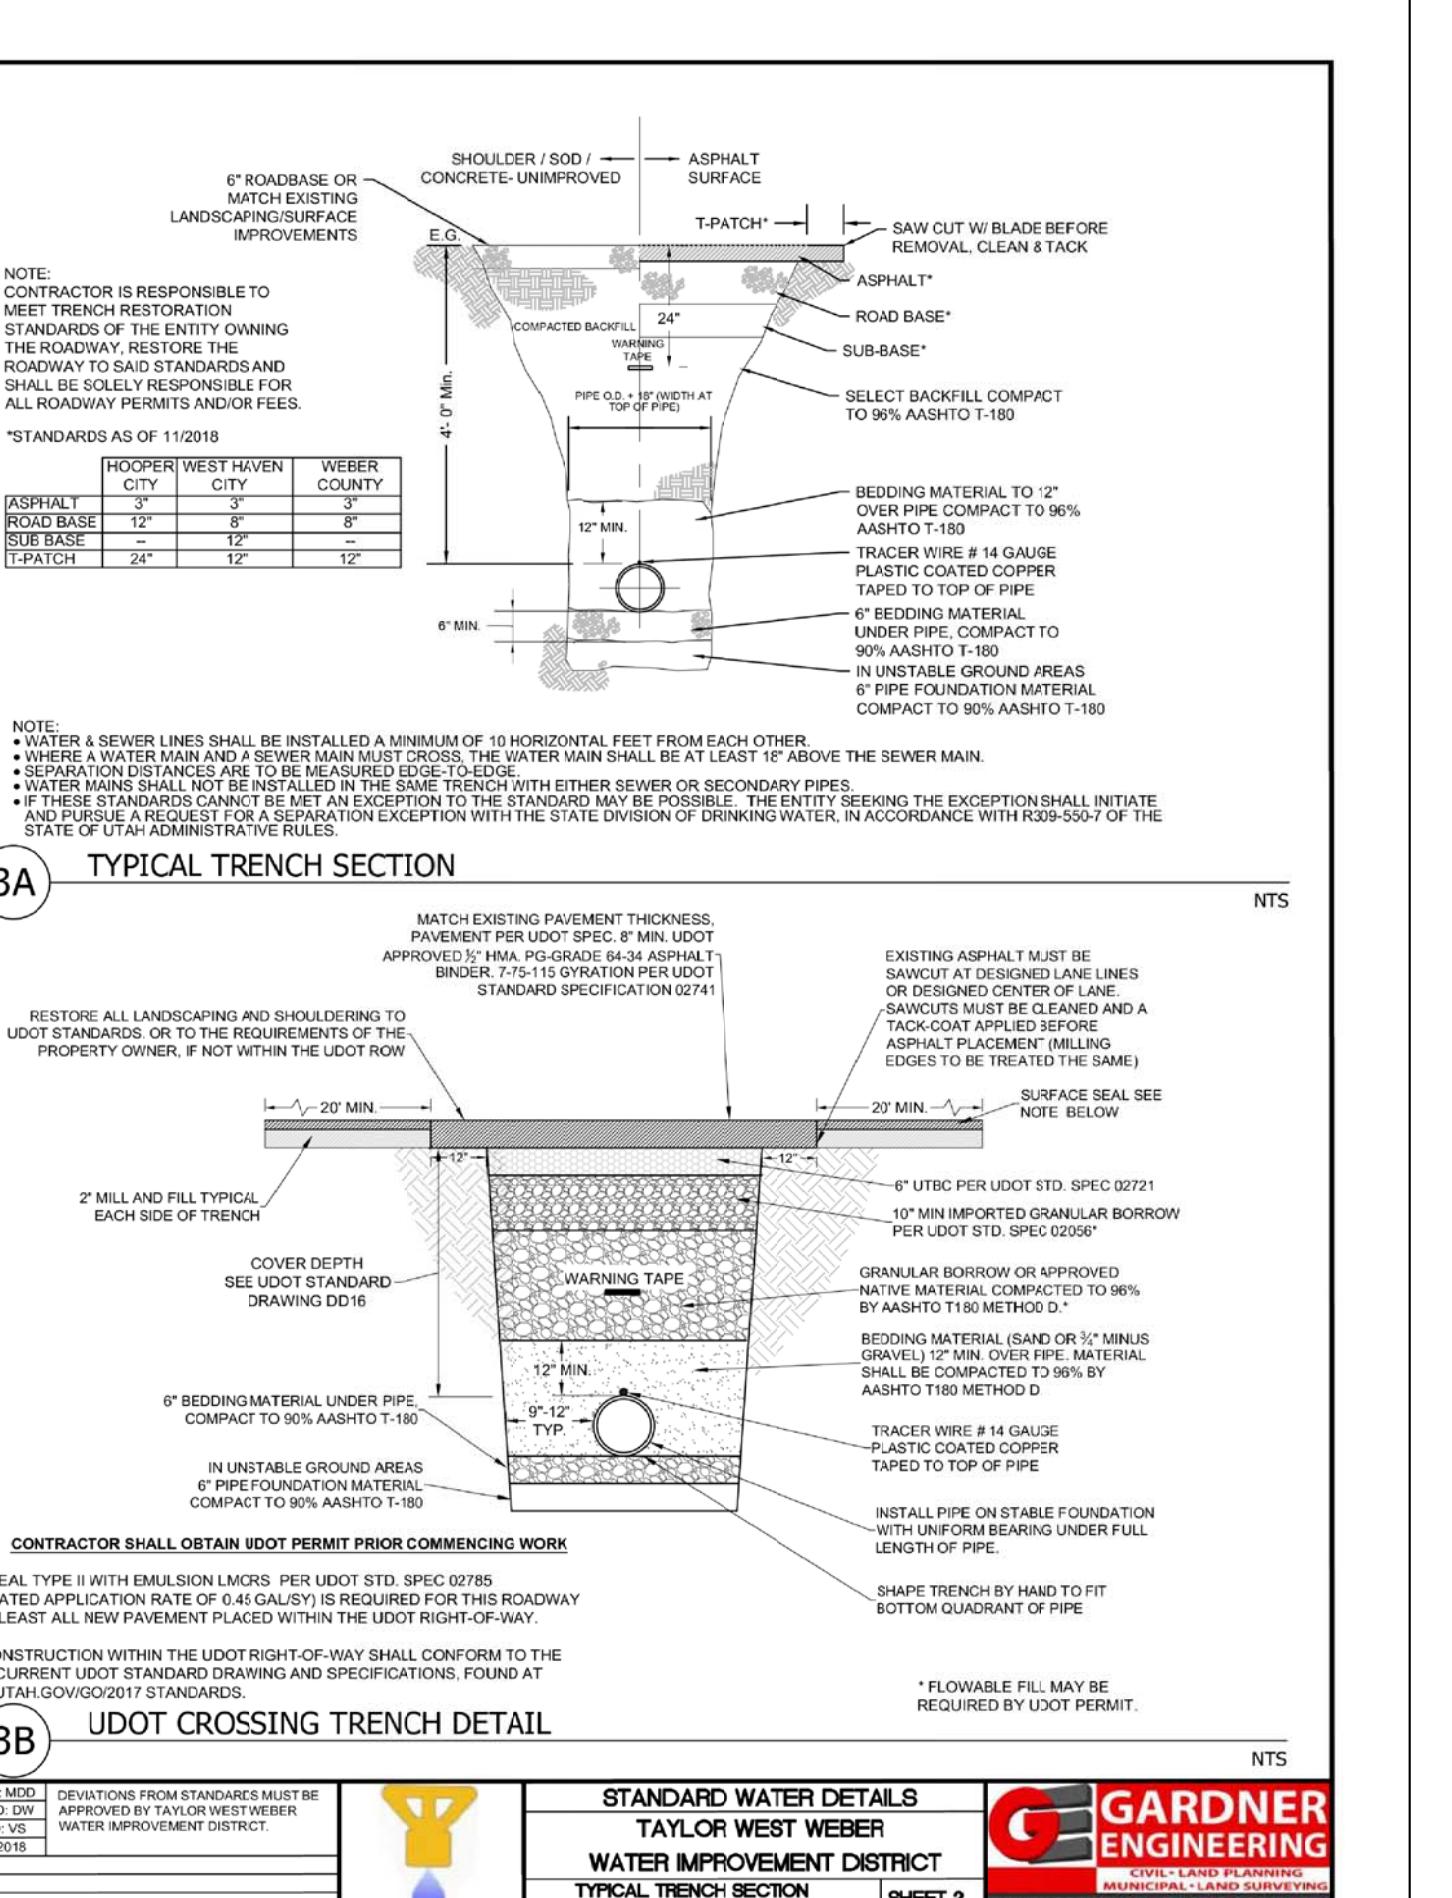



**3A TYPICAL TRENCH SECTION**

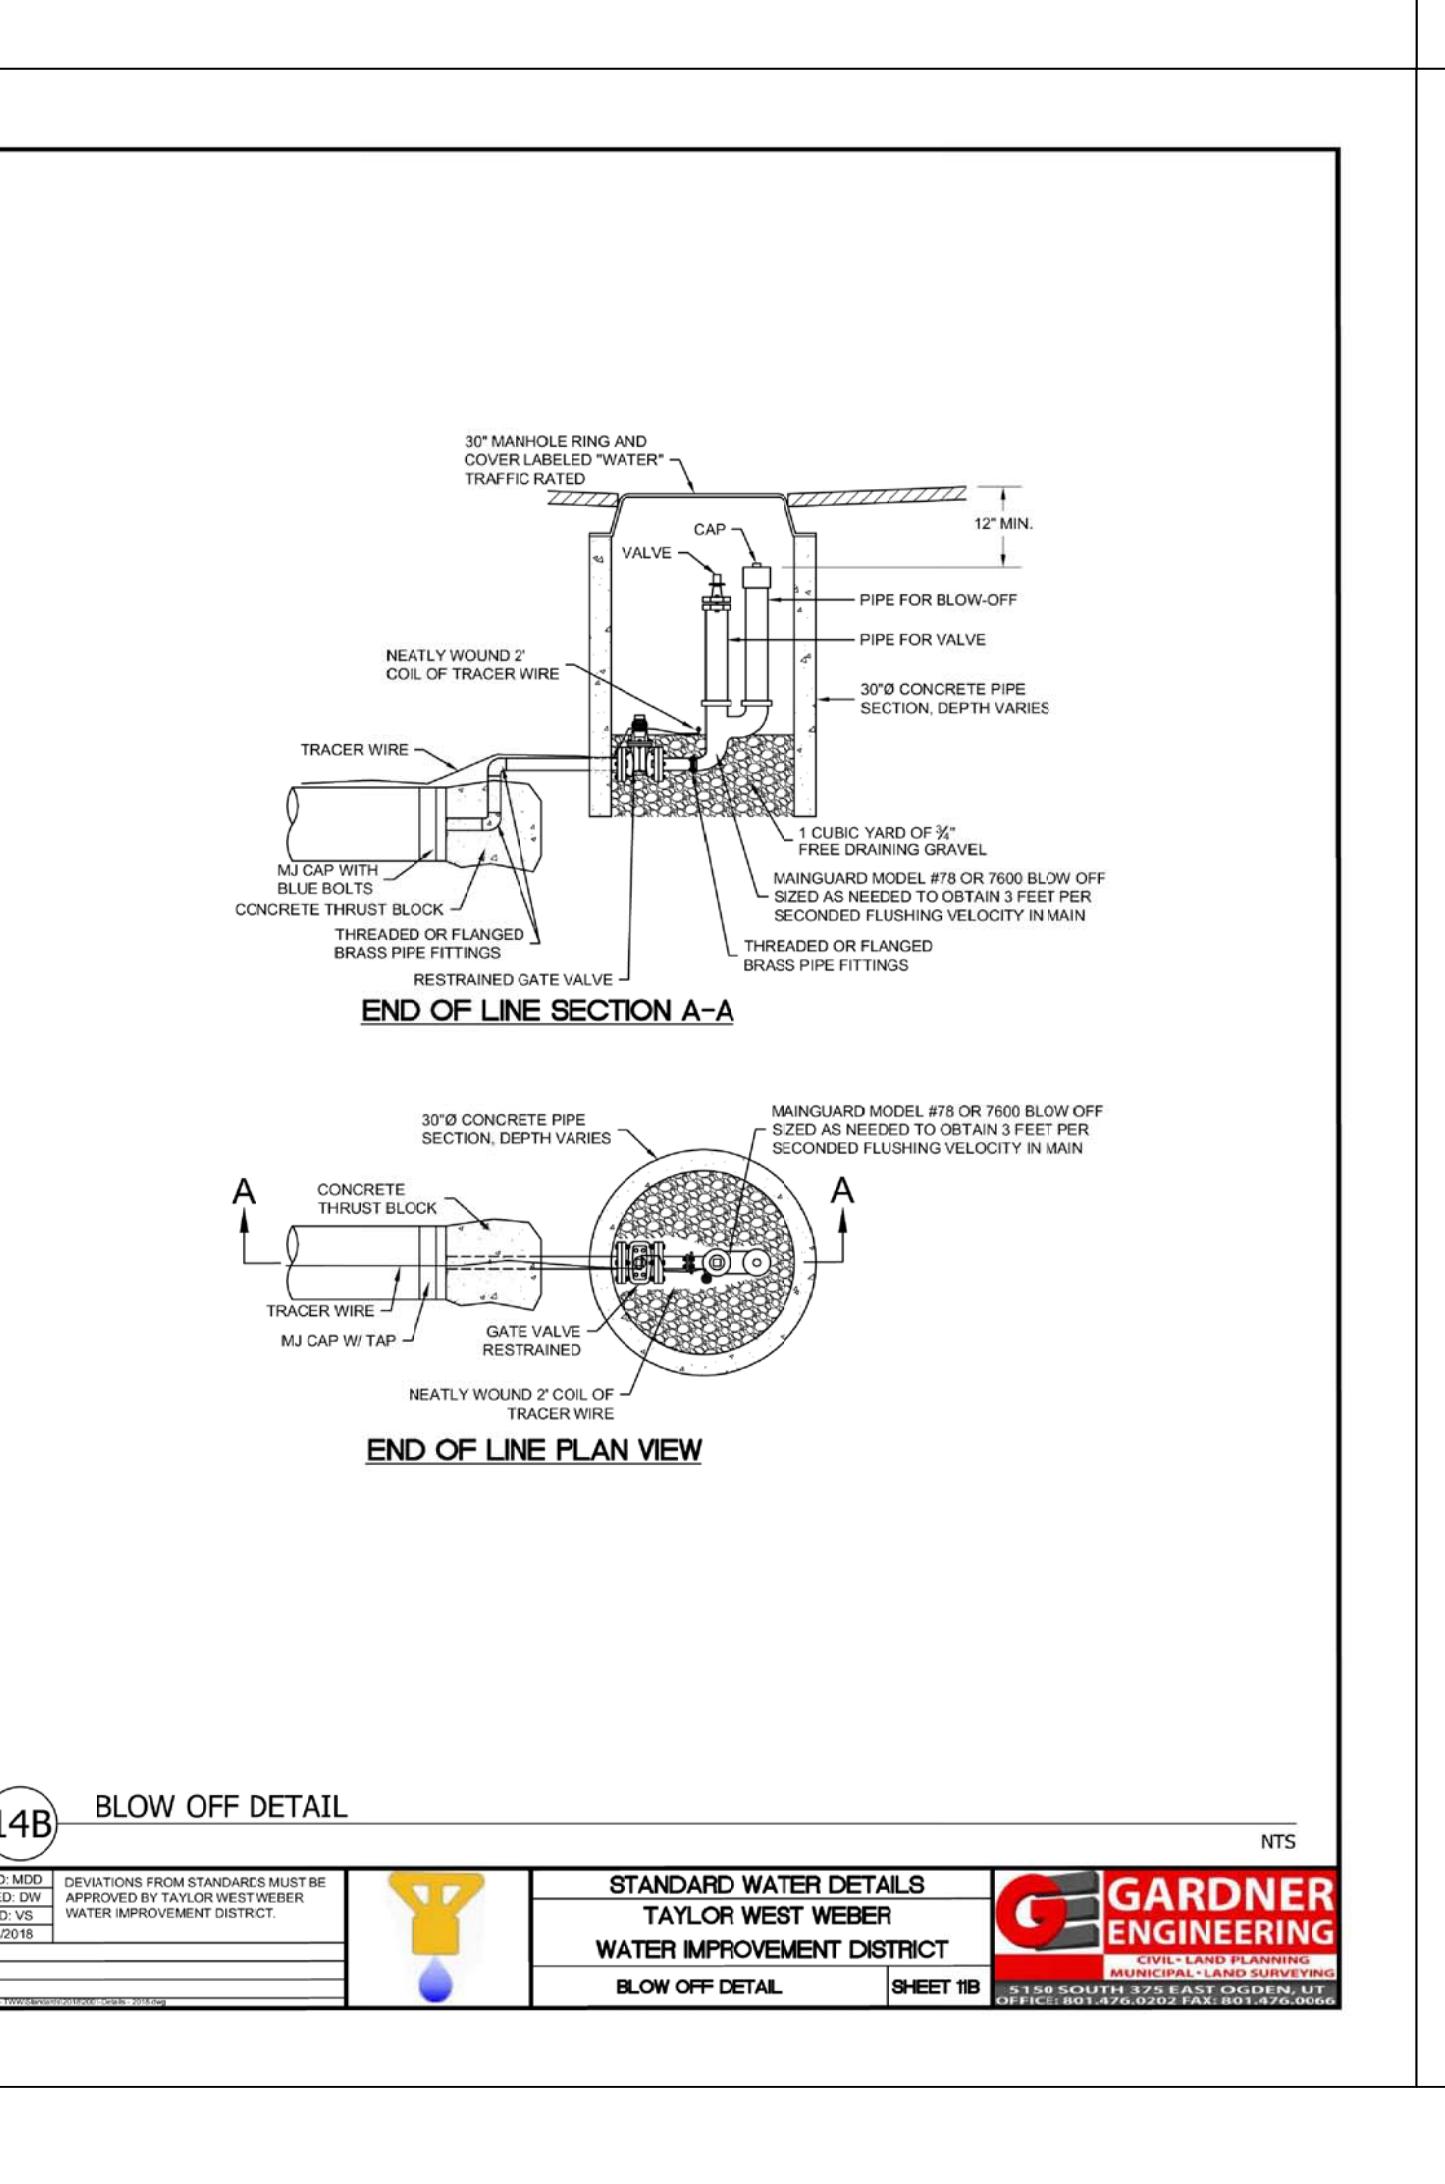


**3B UDOT CROSSING TRENCH DETAIL**

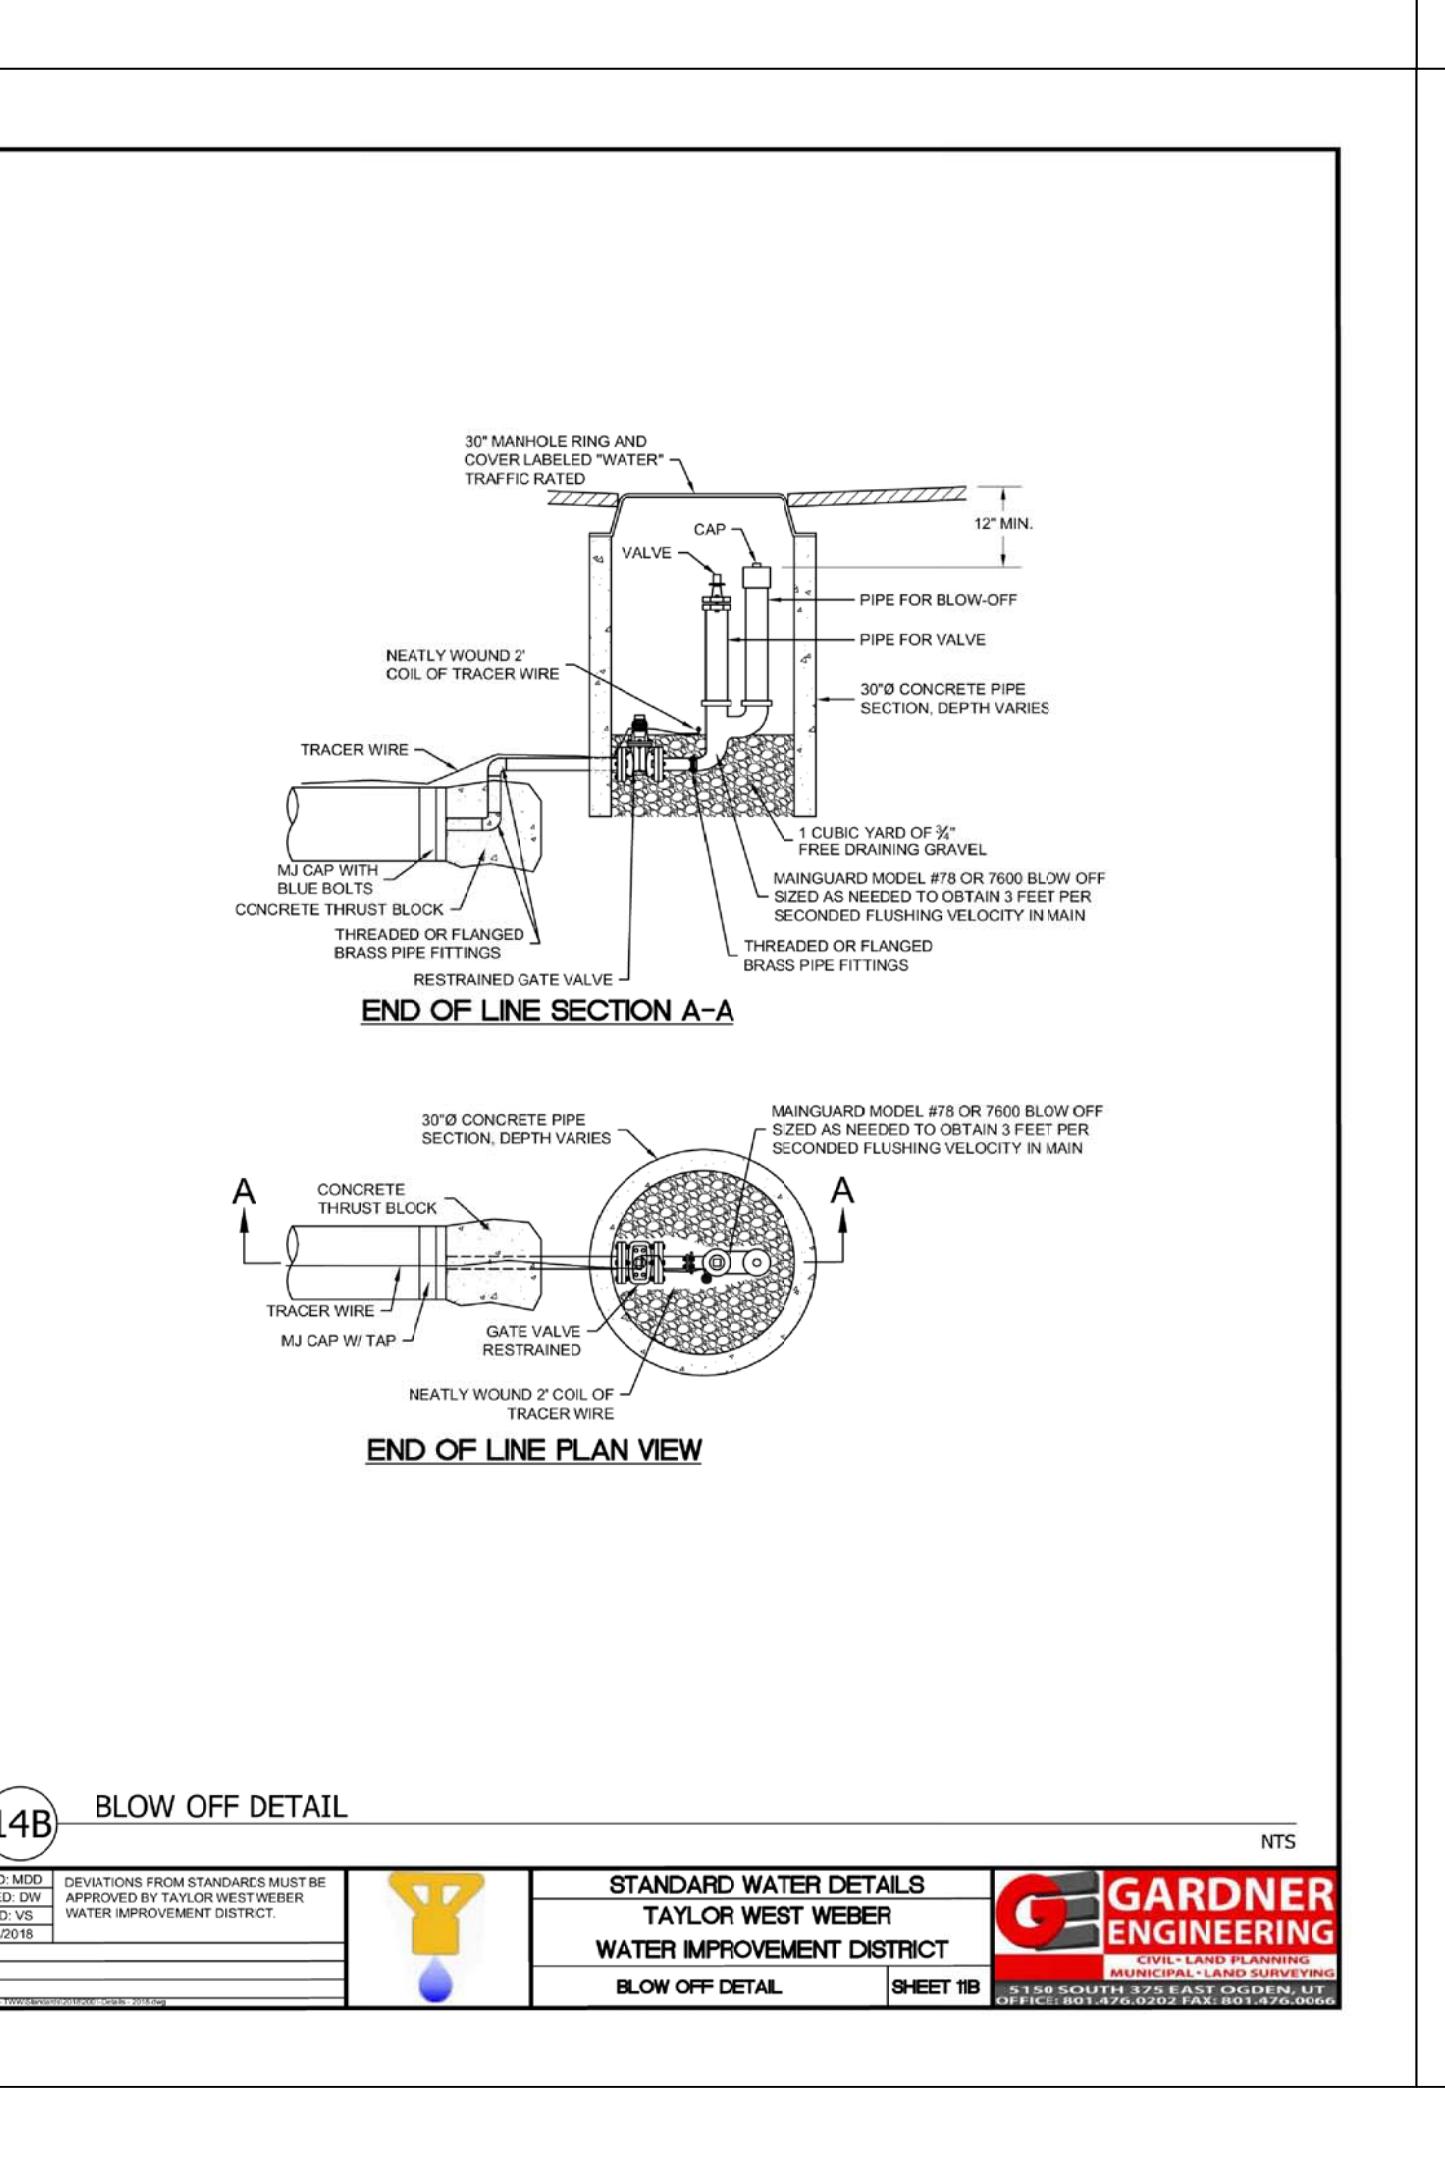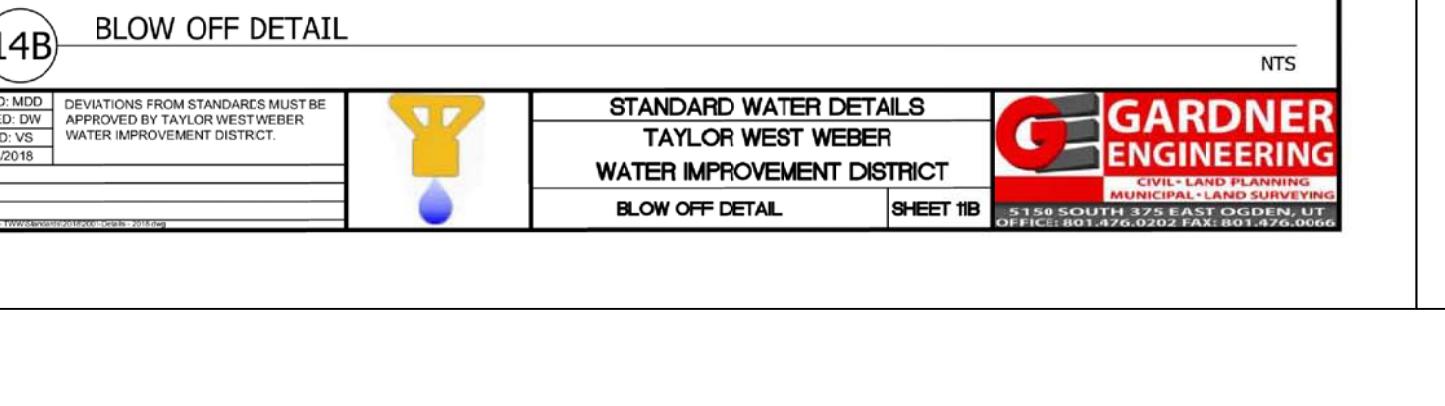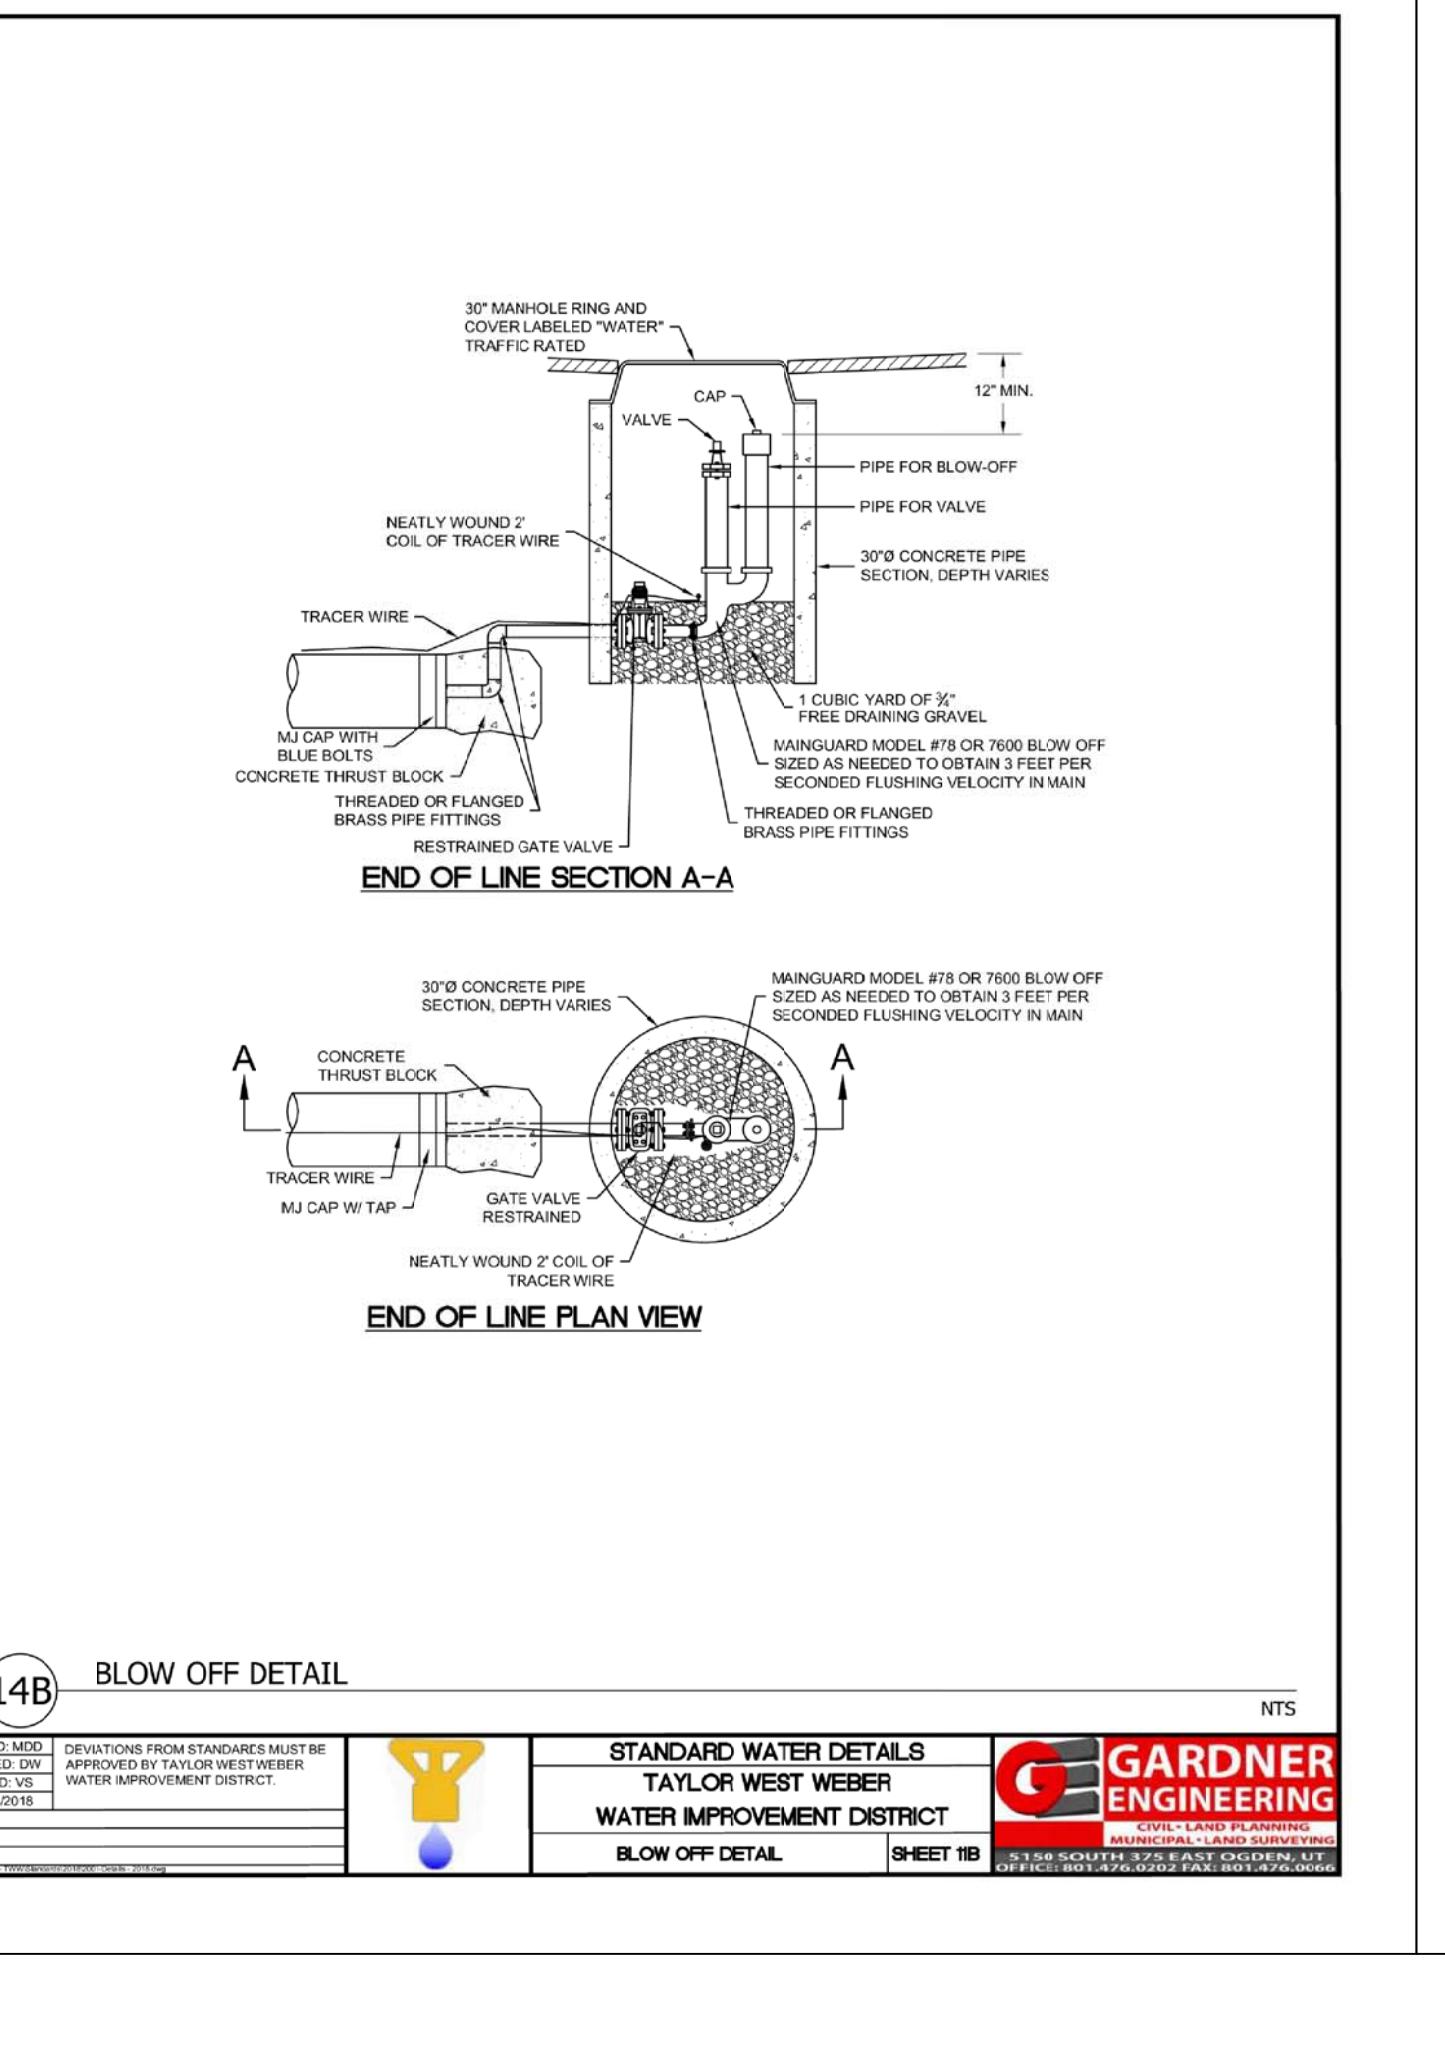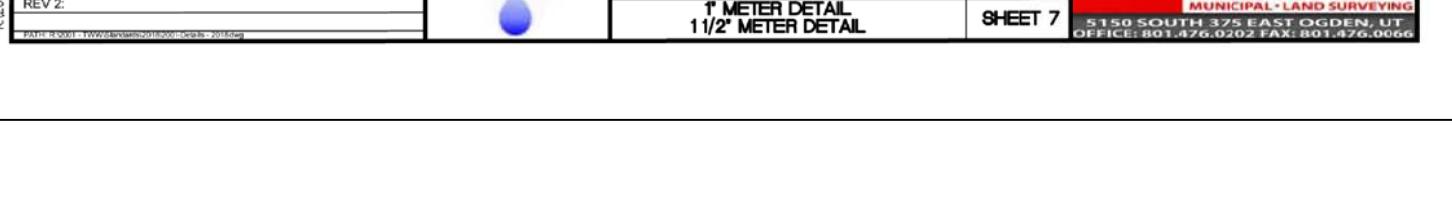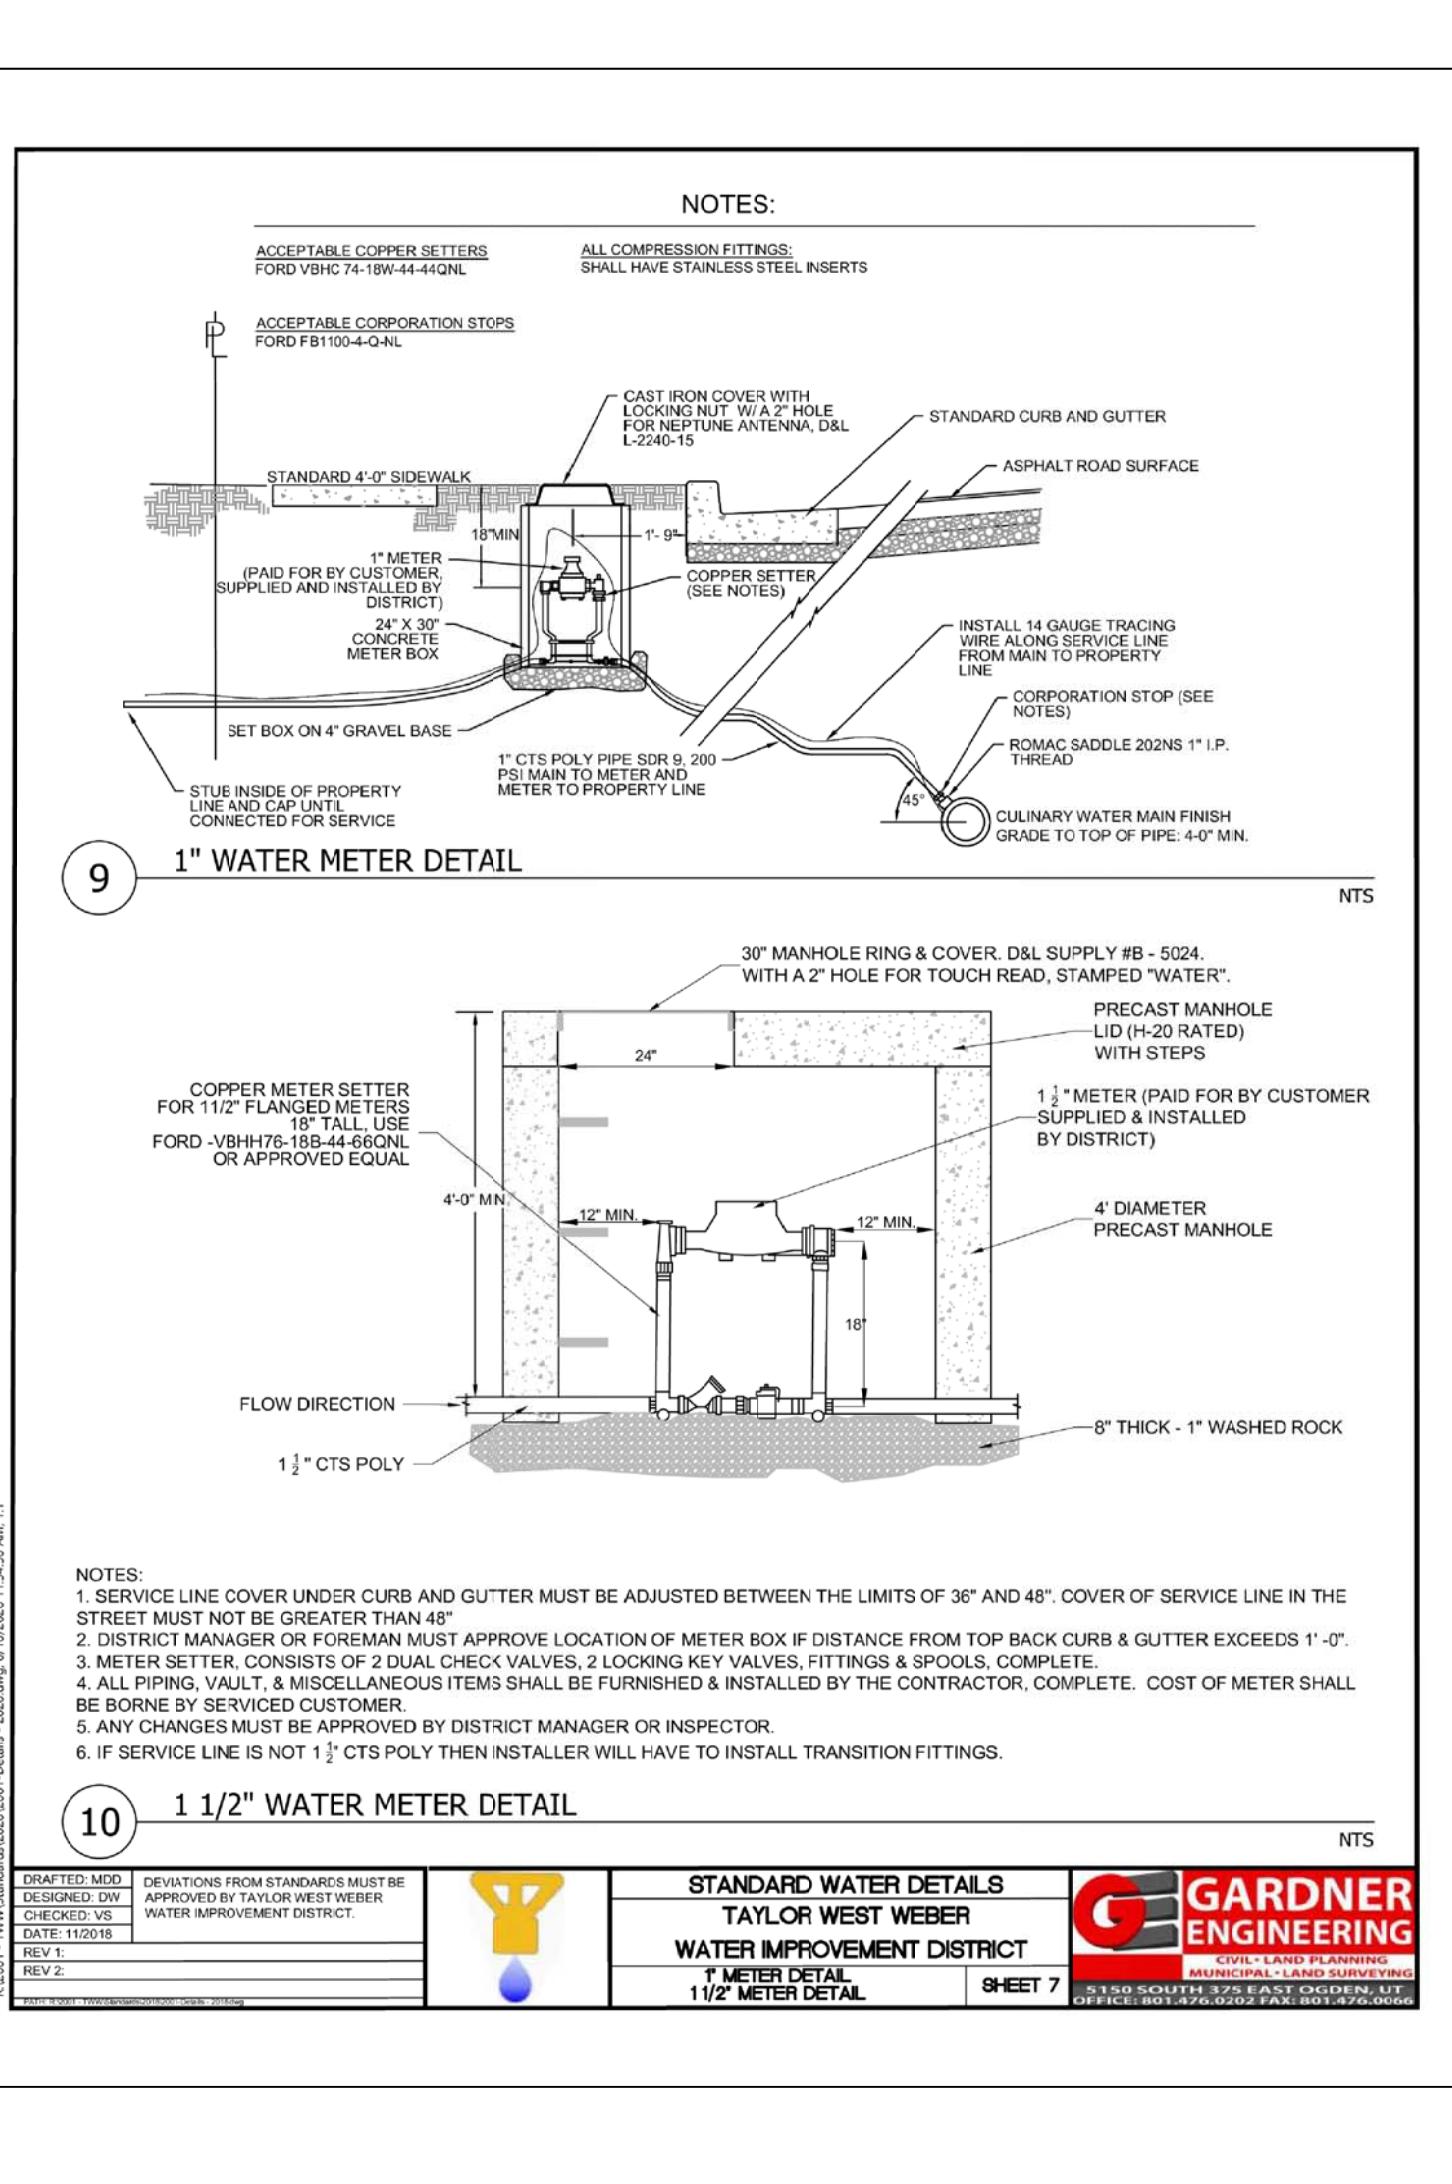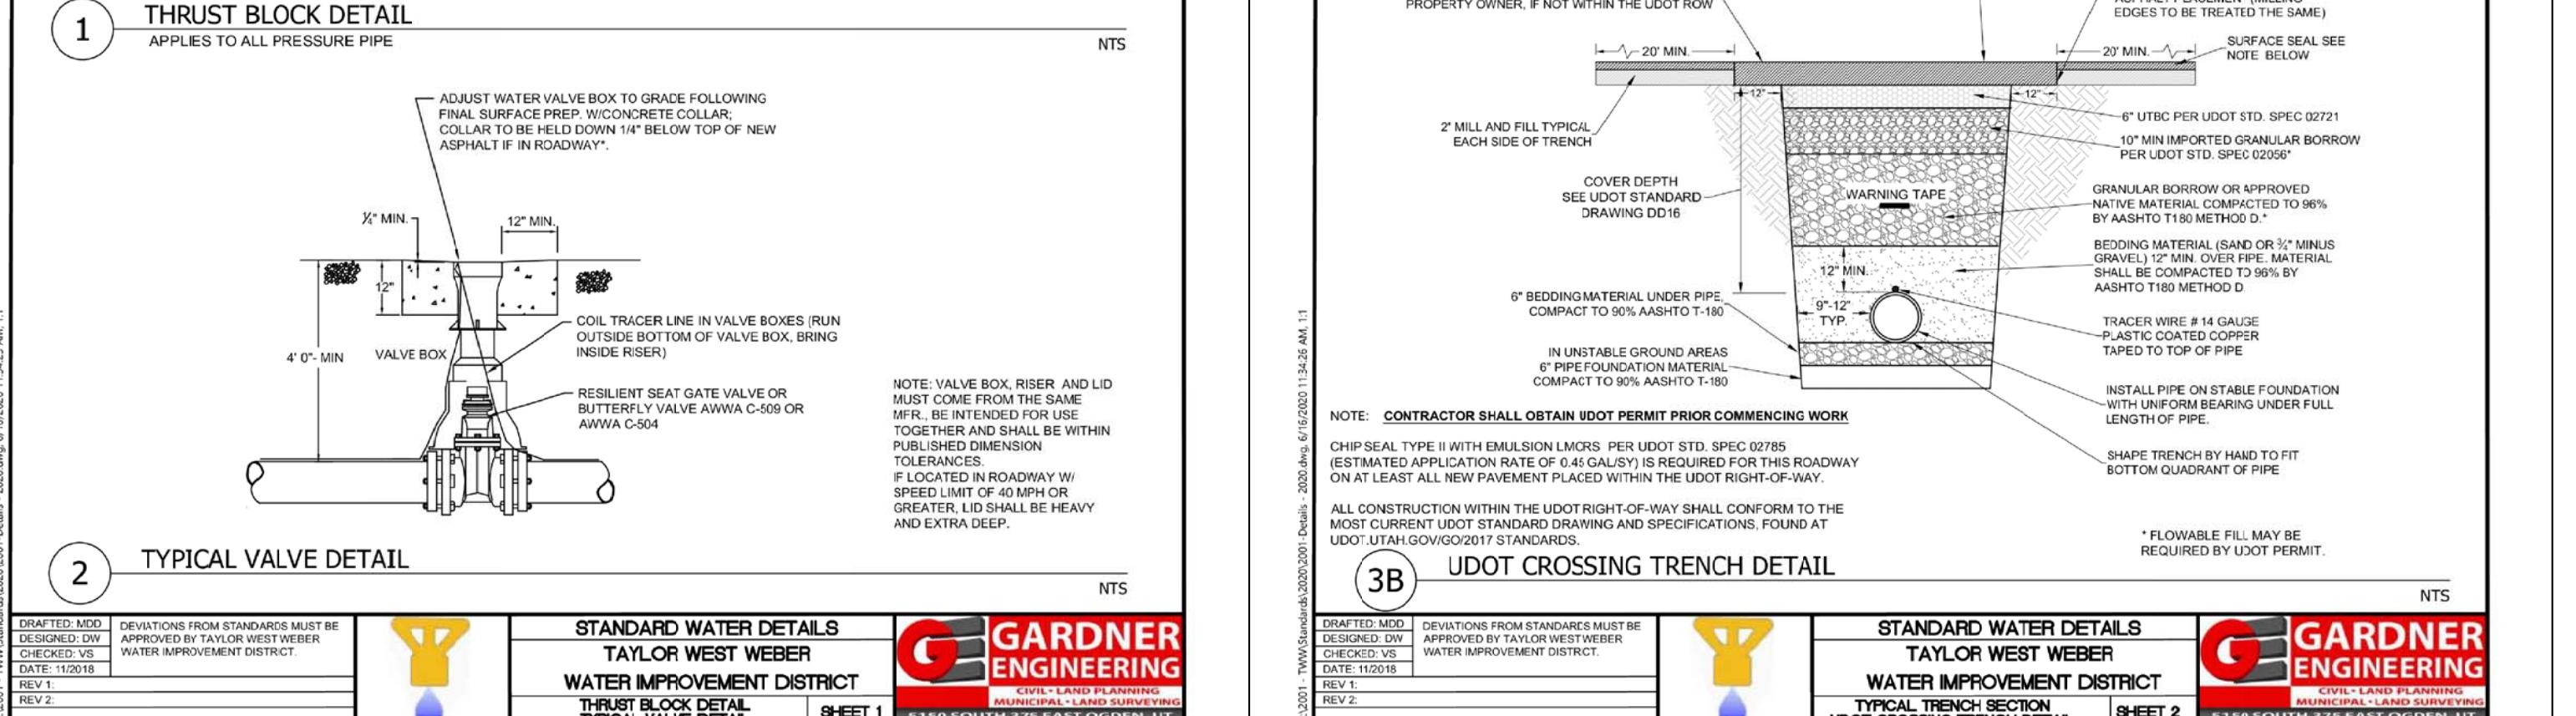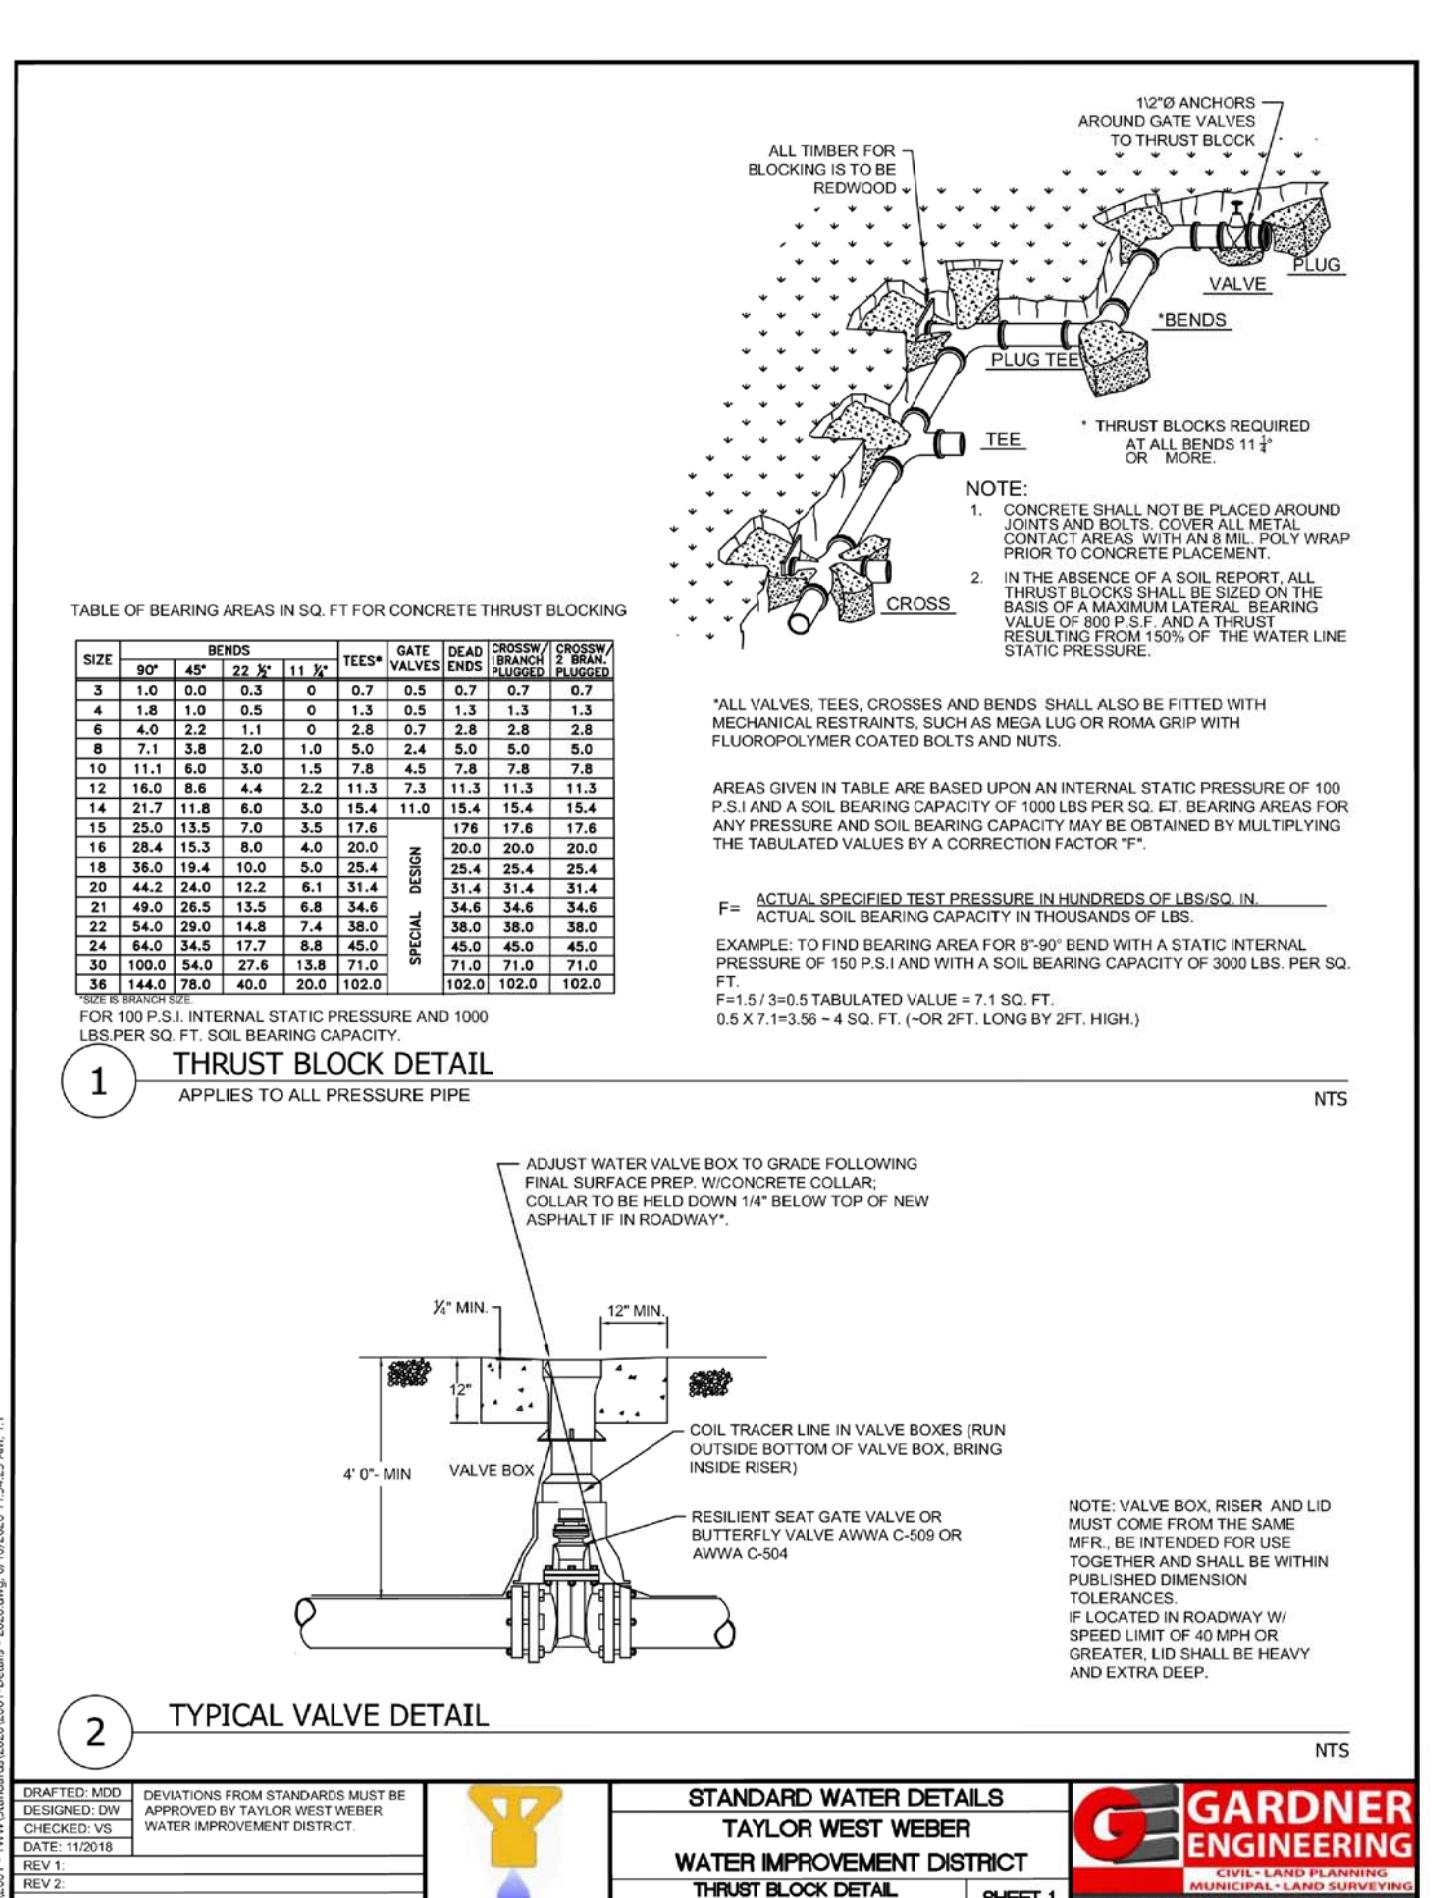

**9 1" WATER METER DETAIL**

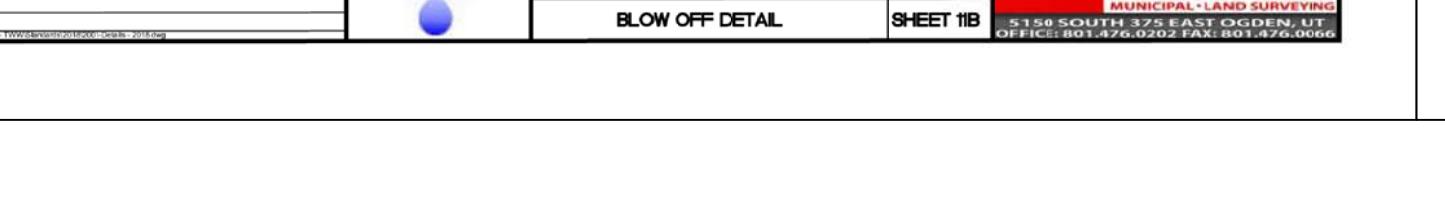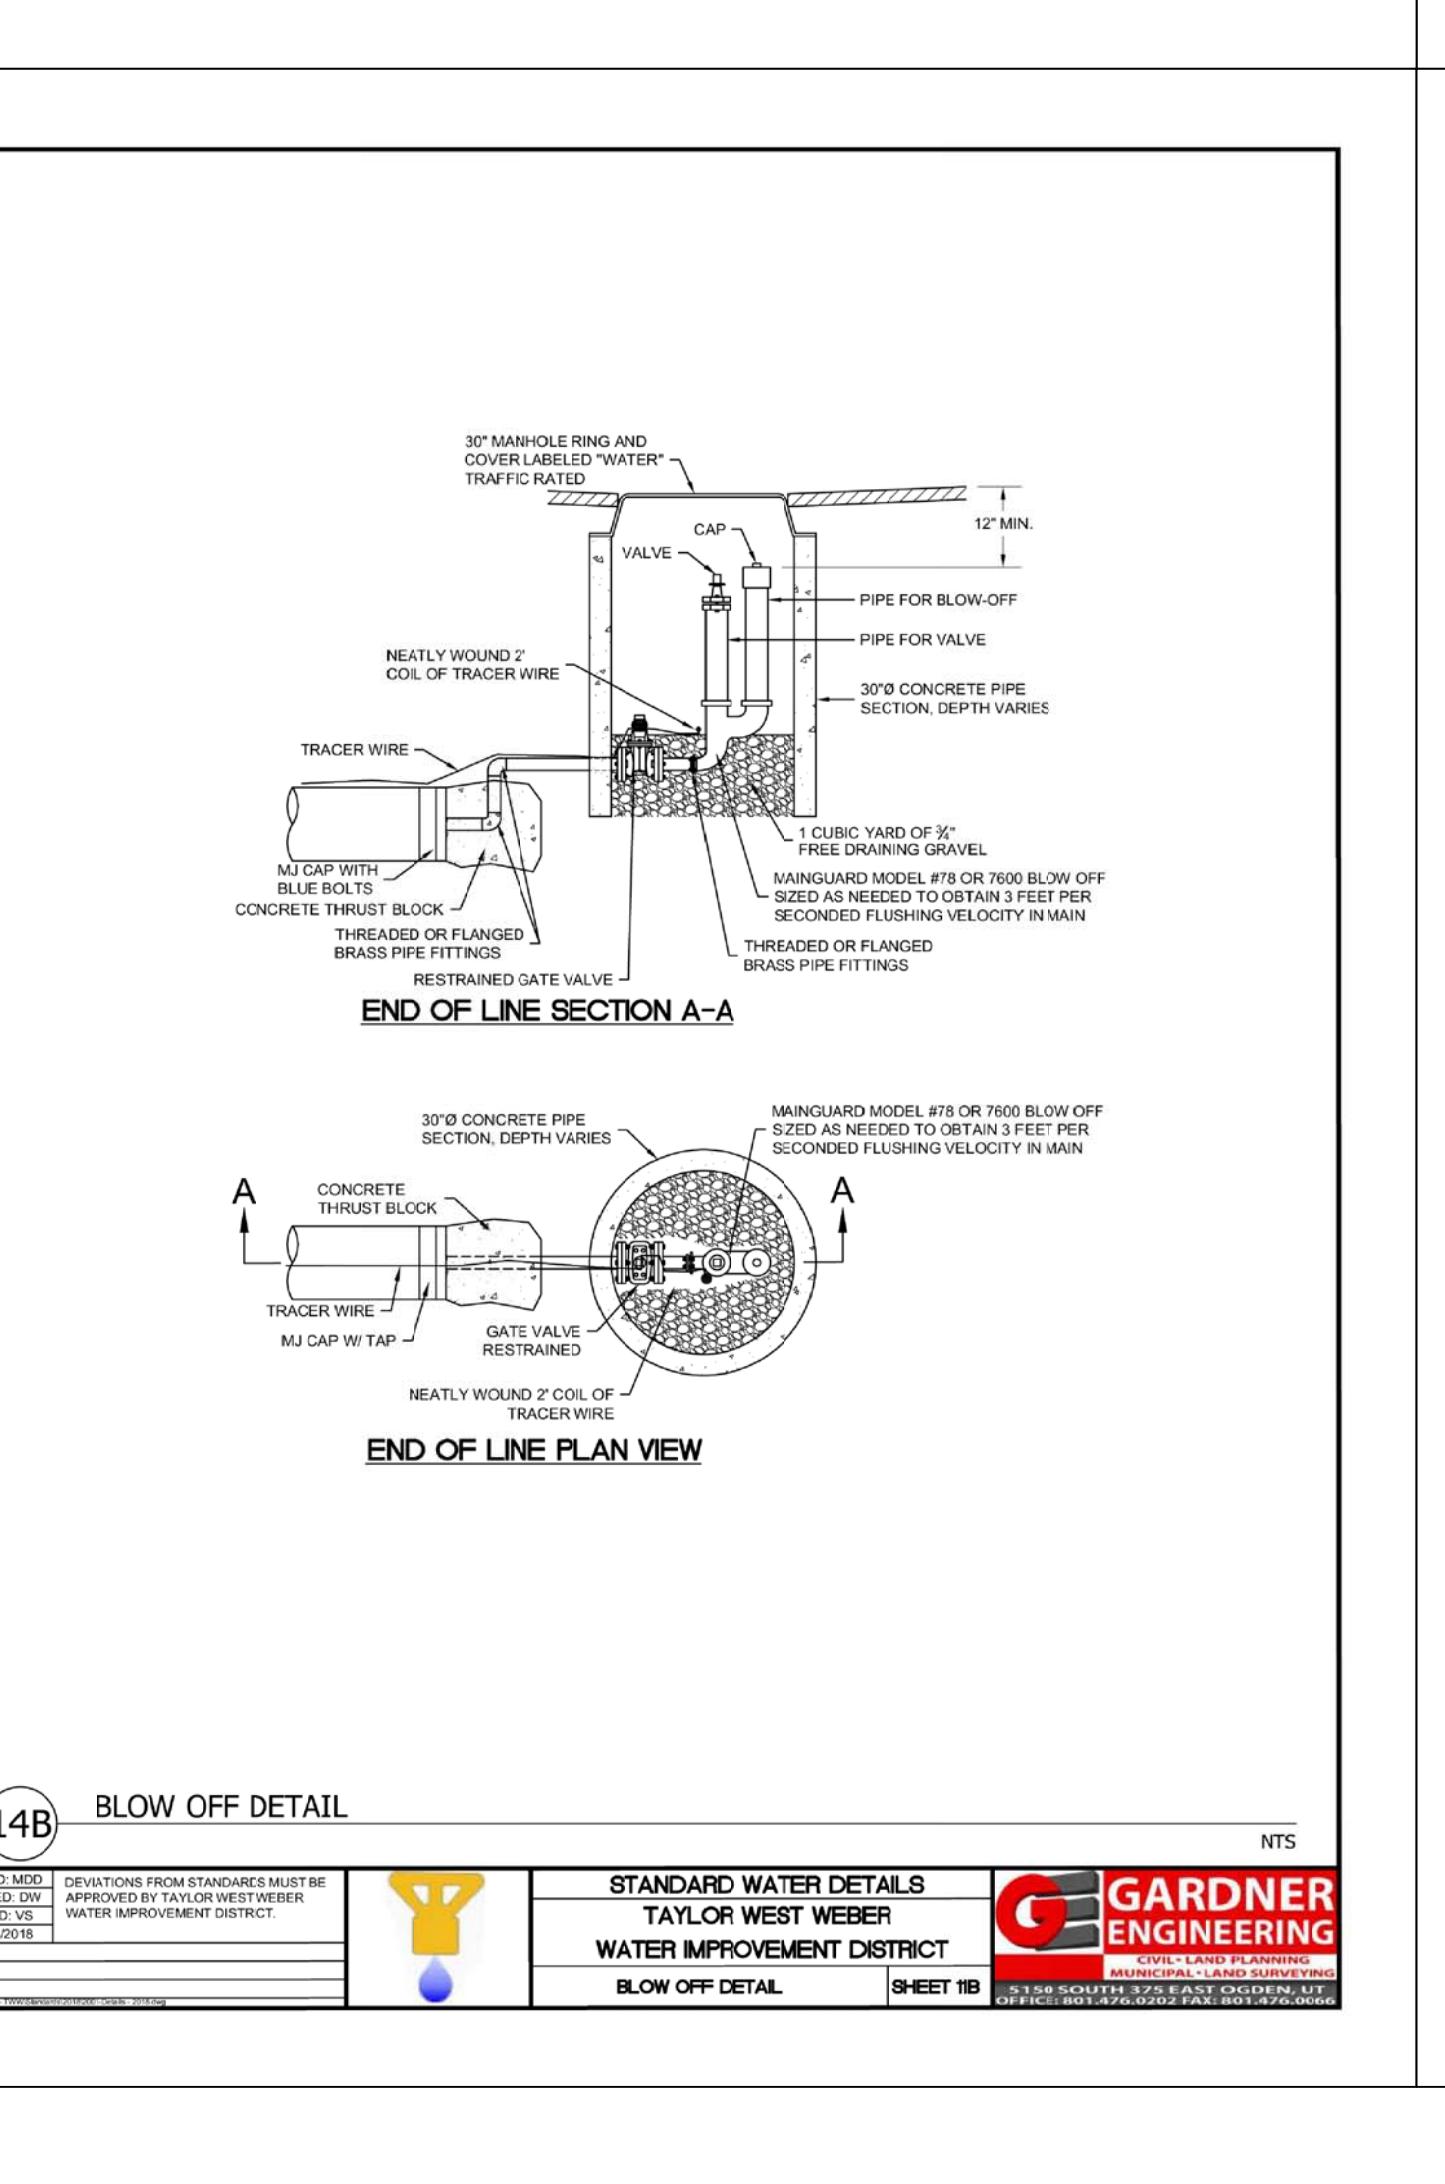

**HYDROLOGY STUDY  
FOR  
TAYLOR LANDING PHASE 1A/2  
TAYLOR, UTAH**

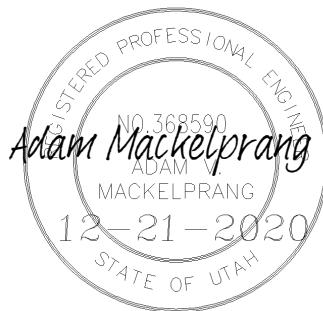

**PREPARED BY  
ALLIANCE CONSULTING ENGINEERS  
150 East 200 North  
Logan, Utah  
(435) 755-5121**

**December 2020**

## **TABLE OF CONTENTS**

**INTRODUCTION**

**DESIGN SUMMARY**

## **INTRODUCTION**

The Taylor Landing Subdivision is a multi-phase residential development located between 1800 South and 2200 South at 4000 West. The entire project will be comprised of 156 single family lots on 109.62 acres and will be constructed in five phases. The following report address the storm water for phase 1A and 2.

## **DESIGN SUMMARY**

For the hydrology study, the rational method was used to analyze the peak flows from this subdivision site..

The hydrology for the site area was evaluated using rainfall intensities for the 10 year (time of concentration for pipe sizing) and 100 year (full retention pond sizing) rainfall events. For the current phases all ponds will be retention.

Peak flows were determined for the 10 year event based on undisturbed and disturbed area C values. Standard engineering values were used based on the anticipated land conditions for the existing and proposed watershed characteristics. Additionally, the drainage basins and sub-areas of the basins were determined based on the topography of the site area and the placement of the necessary catch basins and water ways to ensure that the runoff was directed to the detention basins. Additionally, catch basins were placed to ensure that the capacity was not exceeded at any point within the development. The weighted C values are shown in Table 1 and the peak flow calculations are tabulated in Table 3.

The overall retention volumes for the ponds were evaluated using rainfall intensities for the 100 year events. A percolation rate of 0.6 inches per hour was included in the sizing of the pond based on the soil types found in the geotechnical study. Calculations for both ponds are shown in Table 2.



## **CALCULATION SUMMARY**

The calculations require the following pond size and orifice size.

East Pond: 42,223 cf retention

West Pond: 20,338 cf retention

TAYLOR LANDING PHASE 1A/2  
A CLUSTER SUBDIVISION  
HYDROLOGY MAP

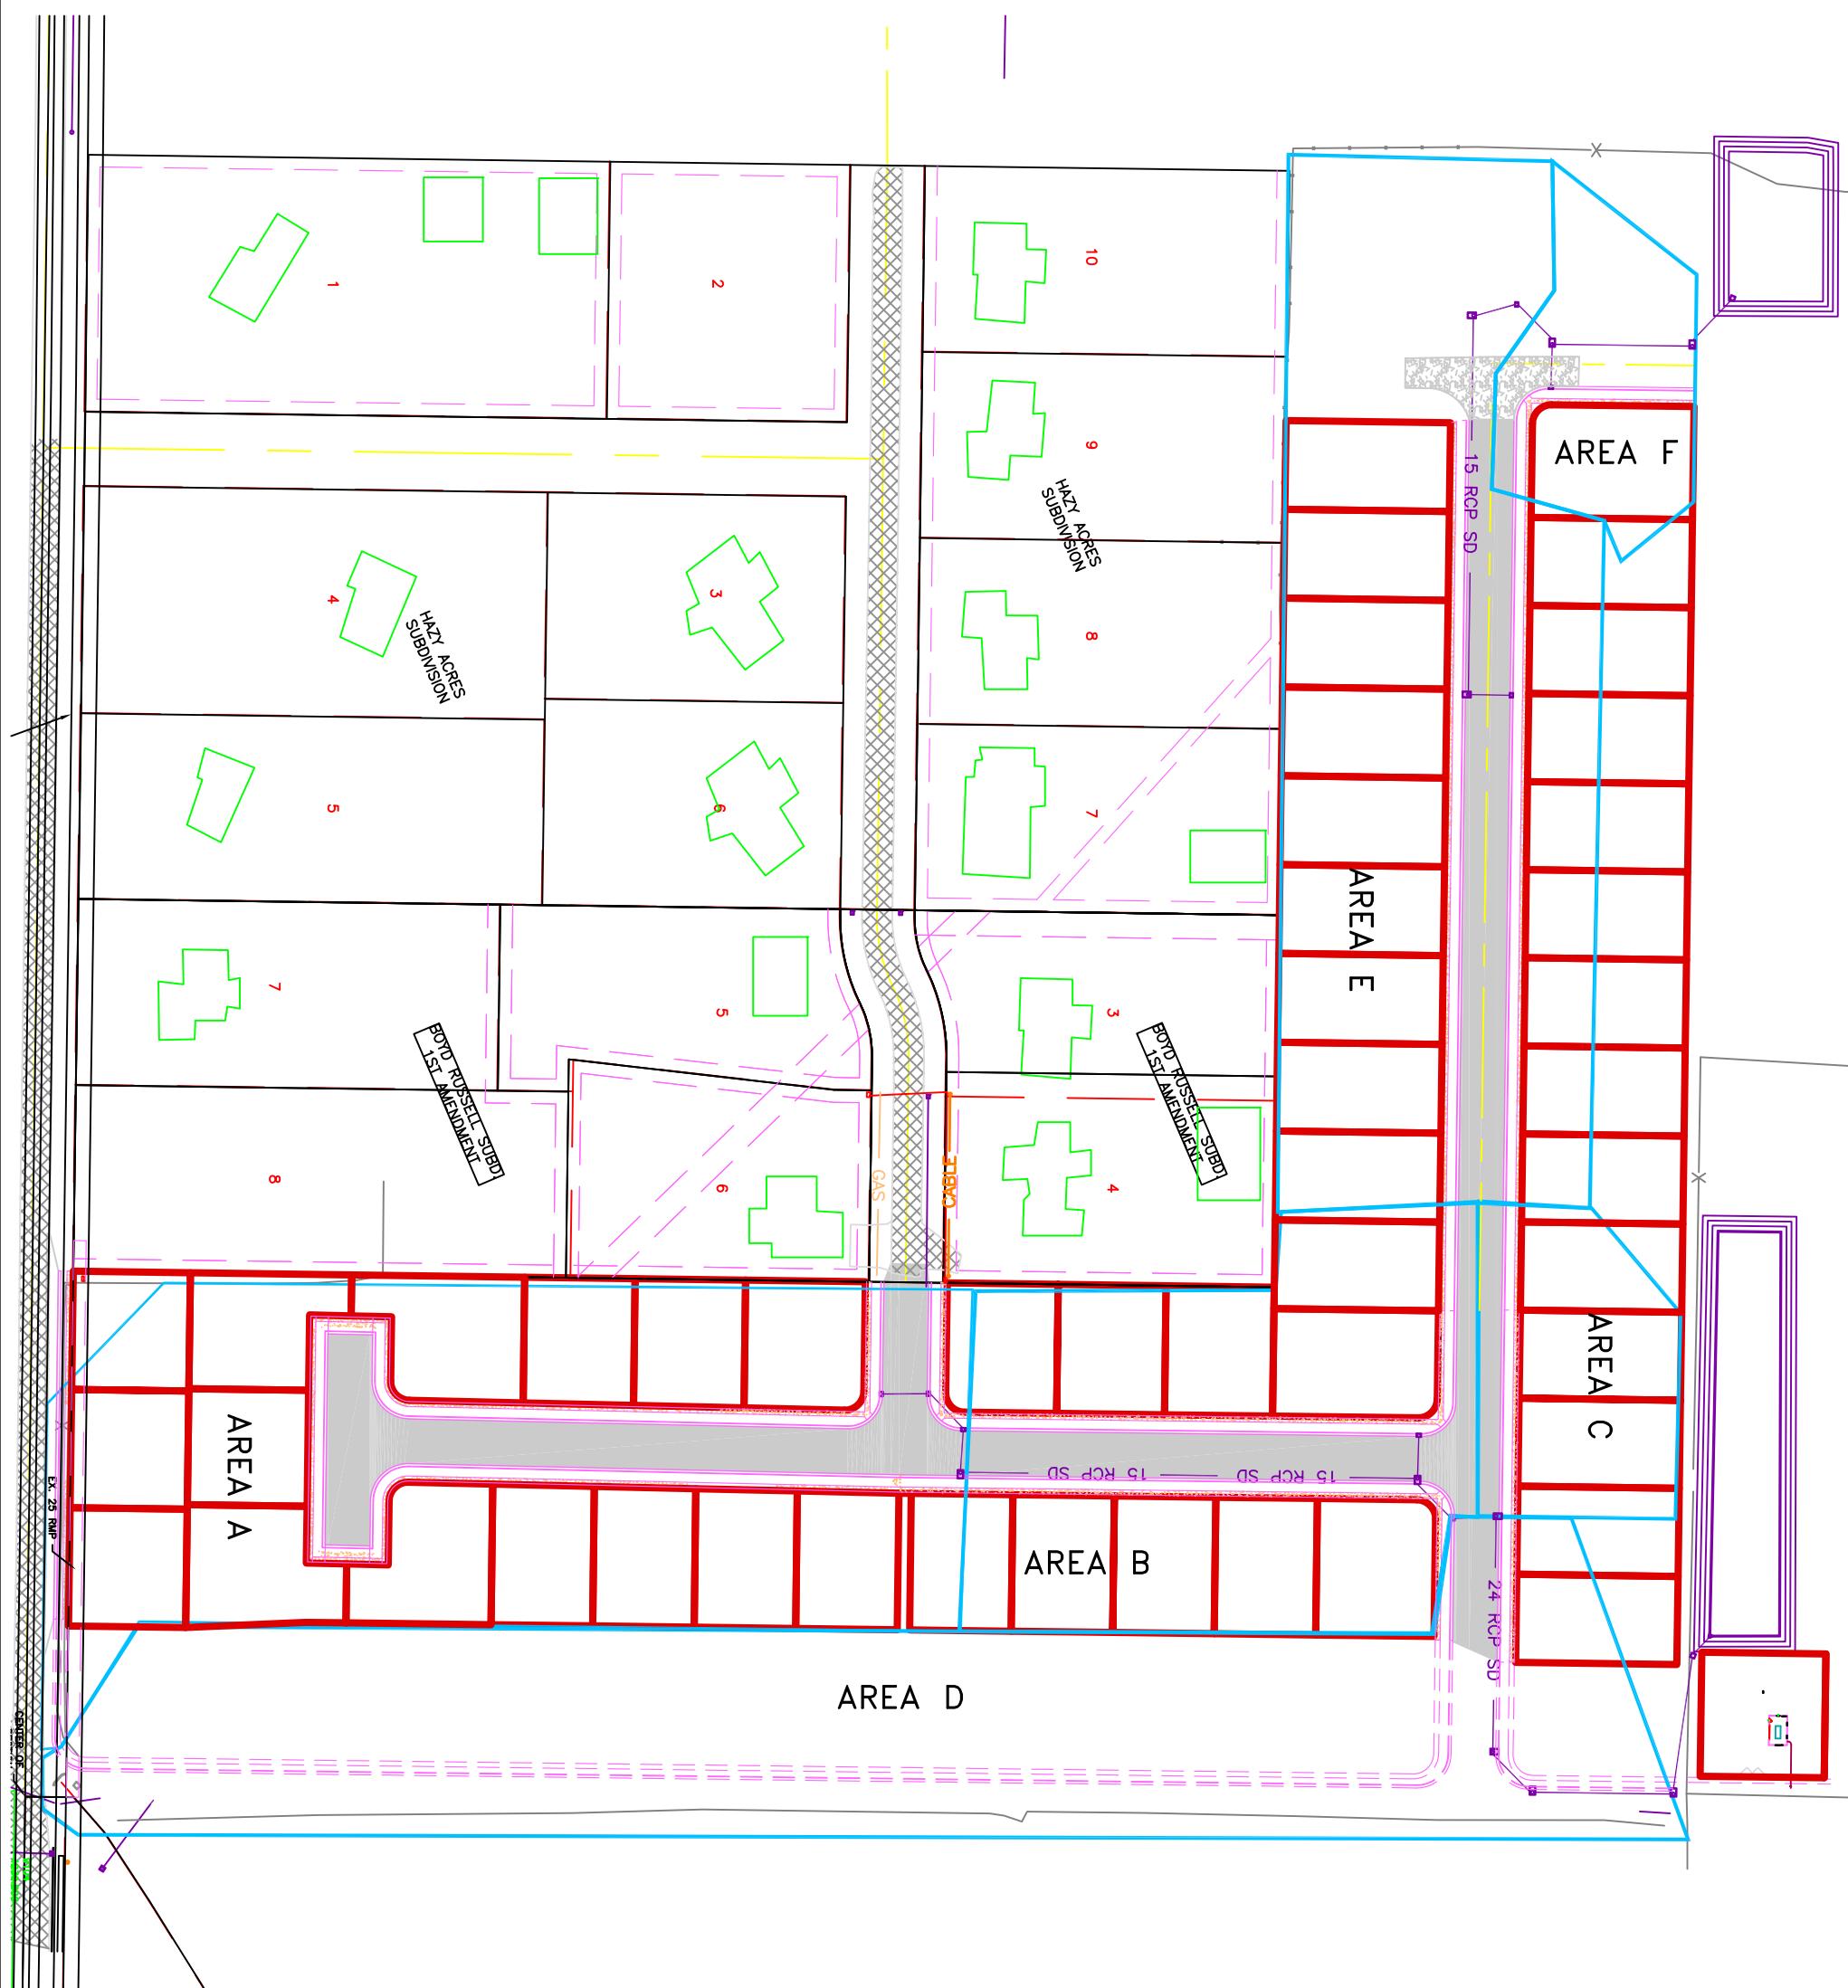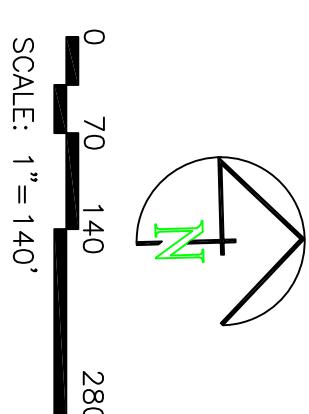

**TABLE 1****SUNSET EQUESTRIAN PHASE 1A/2**

Determination of Weighted 'C' Value and Peak Flow Estimate

| <b>Determination of Weighted 'C' Value:</b>    | Area - disturbed<br>(ft^2) | Subarea A<br>(ft^2) | Subarea B<br>(ft^2) | Subarea C<br>(ft^2) | Subarea D<br>(ft^2) | Subarea E<br>(ft^2) | Subarea F<br>(ft^2) | Area<br>(ft^2) | 'C'<br>Value | A*C      |
|--|----------------------------|---------------------|---------------------|---------------------|---------------------|---------------------|---------------------|----------------|--------------|----------|
| Road Area (roads, sidewalks, driveways, etc.): | 38262                      | 25578               | 6511                | 74263               | 37779               | 9277                | 191670              | 0.95           | 182086.50    |          |
| Roof Area:                                     | 36000                      | 21600               | 7200                | 15120               | 38400               | 3600                | 121920              | 0.9            | 109728.00    |          |
| Landscaped Area:                               | 129375                     | 74103               | 23778               | 132117              | 107493              | 36612               | 503478              | 0.15           | 75521.70     |          |
| Total Area:                                    | 203637                     | 121281              | 37489               | 221500              | 183672              | 49489               | 817068 ~            |                |              |          |
|  |                            |                     |                     |                     |                     |                     | 0.45                |                |              | 18.76 Ac |

**Peakflow Determination:**

|                     |        |        |       |        |        |            |   |
|---------------------|--------|--------|-------|--------|--------|------------|---|
| 'C' Value:          | 0.43   | 0.45   | 0.43  | 0.47   | 0.47   | 0.35       | 15 min event - 10 yr storm<br>per time of concentration |
| Rainfall Intensity: | 2.04   | 2.04   | 2.04  | 2.04   | 2.04   | 2.04 in/hr |   |
| Area:               | 203637 | 121281 | 37489 | 221500 | 183672 | 49489 sf   |   |
| Peakflow:           | 4.13   | 2.57   | 0.76  | 4.87   | 4.05   | 0.82 cfs ~ |   |
| area input          | 203637 | 121281 | 37489 | 221500 | 183672 | 49489      |   |

**TABLE 2**

**SUNSET EQUESTRIAN PHASE 1A2**  
**Determination of Pond Storage Requirements**

|  |             |                 |               |  |              |  |  |
|--|-------------|-----------------|---------------|--|--------------|--|--|
| Drainage Area to Pond:                     | 13.70 acres |                 |               |  |              |  |  |
| Weighted 'C' value for Pond Drainage Area: | 0.45        |                 |               |  |              |  |  |
| Allowable Infiltration Rate:               | Hyd D       | 0.6 inches/hr = | 0.0008 ft/min |  | 100 min/inch |  |  |
| Pond Bottom Area:                          | 76 ft x     | 350 ft =        | 26600 sq. ft. |  |              |  |  |
| Allowable Discharge Rate:                  |             | 0.0 cfs/acre    |               |  |              |  |  |

| 100-Year Return Period |                     |                          |              |            |                                   |  |  |
|------------------------|---------------------|--------------------------|--------------|------------|-----------------------------------|--|--|
| Interval<br>(min)      | Precip.*<br>(in/hr) | Precip.<br>Depth<br>(in) | Area<br>(ac) | C<br>Value | CxAx3630<br>(ft <sup>3</sup> /in) | Accum.<br>Inflow<br>(ft <sup>3</sup> /min) | Allowable<br>Discharge<br>(ft <sup>3</sup> /min) |
| 5                      | 6.52                | 0.54                     | 13.7         | 0.45       | 22378.95                          | 1215.77                                    | 22   |
| 10                     | 4.96                | 0.83                     | 13.7         | 0.45       | 22378.95                          | 18485.013                                  | 22   |
| 15                     | 4.08                | 1.02                     | 13.7         | 0.45       | 22378.95                          | 22826.529                                  | 22   |
| 30                     | 2.76                | 1.38                     | 13.7         | 0.45       | 22378.95                          | 30882.951                                  | 22   |
| 60                     | 1.71                | 1.71                     | 13.7         | 0.45       | 22378.95                          | 38268.005                                  | 22   |
| 120                    | 0.93                | 1.86                     | 13.7         | 0.45       | 22378.95                          | 41624.847                                  | 22   |
| 180                    | 0.63                | 1.90                     | 13.7         | 0.45       | 22378.95                          | 42517.767                                  | 22   |
| 360                    | 0.35                | 2.12                     | 13.7         | 0.45       | 22378.95                          | 47442.926                                  | 22   |
| 720                    | 0.22                | 2.60                     | 13.7         | 0.45       | 22378.95                          | 58183.48                                   | 22   |
| 1440                   | 0.12                | 2.88                     | 13.7         | 0.45       | 22378.95                          | 64451.376                                  | 22   |

\* Precip. intensity values derived from NOAA

**TABLE 2**

**SUNSET EQUESTRIAN PHASE 1A\2**  
**Determination of Pond Storage Requirements**

|  |                                |
|--|--------------------------------|
| Drainage Area to Pond:                     | 6.35 acres                     |
| Weighted 'C' value for Pond Drainage Area: | 0.45                           |
| Allowable Infiltration Rate:               | Hyd D                          |
| Pond Bottom Area:                          | 85 ft x 130 ft = 11050 sq. ft. |
| Allowable Discharge Rate:                  | 0.0 cfs/acre                   |

| 100-Year Return Period        |   |                          |              |               |  |  |   |                                |       |
|-------------------------------|---|--------------------------|--------------|---------------|--|--|---|--------------------------------|-------|
| Precip.*<br>Interval<br>(min) | Precip.<br>Intensity<br>(in/in <sup>2</sup> ) | Precip.<br>Depth<br>(in) | Area<br>(ac) | C<br>CxAx3630 | Accum.<br>Inflow<br>(ft <sup>3</sup> /min) | Allowable<br>Discharge<br>(ft <sup>3</sup> /min) | Accum.<br>Discharge<br>(ft <sup>3</sup> ) | Required<br>Storage<br>(ac-ft) |       |
| 5                             | 6.52  | 0.54                     | 6.35         | 0.45          | 10372.725                                  | 5632.3897  | 9   | 46                             | 5586  |
| 10                            | 4.96  | 0.83                     | 6.35         | 0.45          | 10372.725                                  | 8567.8709  | 9   | 92                             | 8476  |
| 15                            | 4.08  | 1.02                     | 6.35         | 0.45          | 10372.725                                  | 10580.18   | 9   | 138.125                        | 10442 |
| 30                            | 2.76  | 1.38                     | 6.35         | 0.45          | 10372.725                                  | 14314.361  | 9   | 276.25                         | 14038 |
| 60                            | 1.71  | 1.71                     | 6.35         | 0.45          | 10372.725                                  | 17737.36   | 9   | 552.5                          | 17185 |
| 120                           | 0.93  | 1.86                     | 6.35         | 0.45          | 10372.725                                  | 19293.269  | 9   | 1105                           | 18188 |
| 180                           | 0.63  | 1.90                     | 6.35         | 0.45          | 10372.725                                  | 19707.14   | 9   | 1657.5                         | 18050 |
| 360                           | 0.35  | 2.12                     | 6.35         | 0.45          | 10372.725                                  | 21989.97   | 9   | 3315                           | 18675 |
| 720                           | 0.22  | 2.60                     | 6.35         | 0.45          | 10372.725                                  | 26968.255  | 9   | 6630                           | 20338 |
| 1440                          | 0.12  | 2.88                     | 6.35         | 0.45          | 10372.725                                  | 29873.448  | 9   | 13260                          | 16613 |

\* Precip. intensity values derived from NOAA

TABLE 3

**SUNSET EQUESTRIAN PHASE 1A/2**  
**Determination of Storm Drain System Sizing**

| <b>Peak Flow Determination</b> |                |                      |                  | <b>Pipe Hydraulics</b>      |                               |                         |                         |                       |                         |                        |                    |                        |                        |              |
|--------------------------------|----------------|----------------------|------------------|-----------------------------|-------------------------------|-------------------------|-------------------------|-----------------------|-------------------------|------------------------|--------------------|------------------------|------------------------|--------------|
| <b>Watershed Designation</b>   | <b>Q (cfs)</b> | <b>Total Q (cfs)</b> | <b>Pipe I.D.</b> | <b>Upstream Invert (ft)</b> | <b>Downstream Invert (ft)</b> | <b>Pipe Length (ft)</b> | <b>Gradient (ft/ft)</b> | <b>Pipe Size (in)</b> | <b>Pipe Area (ft^2)</b> | <b>Pipe Circ. (ft)</b> | <b>Manning's n</b> | <b>Pipe Cap. (cfs)</b> | <b>Vel. Full (fps)</b> | <b>Check</b> |
| Area A                         | 4.13           | 2.07                 | CB1-CB2          | 4237.63                     | 4237.50                       | 35.00                   | 0.0037                  | 15                    | 1.23                    | 3.93                   | 0.011              | 4.65                   | 3.79                   | OK           |
|                                |                | 2.07                 | CB2-CB3          | 4237.50                     | 4237.36                       | 40.00                   | 0.0035                  | 15                    | 1.23                    | 3.93                   | 0.011              | 4.52                   | 3.68                   | OK           |
|                                |                | 2.07                 | CB3-Combo1       | 4237.36                     | 4237.24                       | 34.00                   | 0.0035                  | 15                    | 1.23                    | 3.93                   | 0.011              | 4.54                   | 3.70                   | OK           |
|                                |                | 4.13                 | Combo1-Combo2    | 4237.24                     | 4235.92                       | 366.00                  | 0.0036                  | 15                    | 1.23                    | 3.93                   | 0.011              | 4.58                   | 3.74                   | OK           |
| Area B                         | 2.57           | 1.29                 | CB4-Combo2       | 4236.27                     | 4235.92                       | 32.00                   | 0.0109                  | 15                    | 1.23                    | 3.93                   | 0.011              | 7.98                   | 6.51                   | OK           |
|                                |                | 6.70                 | Combo2-CB5       | 4235.92                     | 4235.72                       | 40.00                   | 0.0050                  | 18                    | 1.77                    | 4.71                   | 0.011              | 8.78                   | 4.97                   | OK           |
|                                |                | 6.70                 | CB5-Combo3       | 4235.72                     | 4235.56                       | 32.00                   | 0.0050                  | 18                    | 1.77                    | 4.71                   | 0.011              | 8.78                   | 4.97                   | OK           |
| Area C                         | 0.76           |                      |                  |                             |                               |                         |                         |                       |                         |                        |                    |                        |                        |              |
| Area D                         | 4.87 Future    | 12.33                | Combo3-Combo4    | 4235.56                     | 4235.09                       | 186.00                  | 0.0025                  | 24                    | 3.14                    | 6.28                   | 0.011              | 13.44                  | 4.28                   | OK           |
|                                |                | 12.33                | Combo4-Combo5    | 4235.09                     | 4234.99                       | 41.00                   | 0.0024                  | 24                    | 3.14                    | 6.28                   | 0.011              | 13.20                  | 4.20                   | OK           |
|                                |                | 12.33                | Combo5-Combo6    | 4234.99                     | 4234.71                       | 110.00                  | 0.0025                  | 24                    | 3.14                    | 6.28                   | 0.011              | 13.49                  | 4.29                   | OK           |
|                                |                | 12.33                | Combo6-JB1       | 4234.71                     | 4234.45                       | 106.00                  | 0.0025                  | 24                    | 3.14                    | 6.28                   | 0.011              | 13.24                  | 4.21                   | OK           |
| Area E                         | 4.05           | 1.05                 | CB6-Combo7       | 4234.72                     | 4234.40                       | 32.00                   | 0.0100                  | 12                    | 0.79                    | 3.14                   | 0.011              | 4.21                   | 5.36                   | OK           |
|                                |                | 3.00                 | Combo7-Combo8    | 4234.40                     | 4233.65                       | 301.00                  | 0.0025                  | 15                    | 1.23                    | 3.93                   | 0.011              | 3.81                   | 3.11                   | OK           |
|                                |                | 4.05                 | Combo8-CB7       | 4233.65                     | 4233.55                       | 34.00                   | 0.0029                  | 15                    | 1.23                    | 3.93                   | 0.011              | 4.14                   | 3.37                   | OK           |
|                                |                | 4.05                 | CB7-Combo9       | 4233.55                     | 4233.43                       | 38.00                   | 0.0032                  | 15                    | 1.23                    | 3.93                   | 0.011              | 4.29                   | 3.50                   | OK           |
|                                |                | 0.41                 | CB8-Combo9       | 4234.07                     | 4233.43                       | 32.00                   | 0.0200                  | 15                    | 1.23                    | 3.93                   | 0.011              | 10.80                  | 8.80                   | OK           |
|                                |                | 0.82                 | Combo9-Combo10   | 4233.43                     | 4232.60                       | 110.00                  | 0.0075                  | 15                    | 1.23                    | 3.93                   | 0.011              | 6.63                   | 5.40                   | OK           |
|                                |                | 4.87                 | Combo10-Pond     | 4232.60                     | 4232.00                       | 46.00                   | 0.0130                  | 15                    | 1.23                    | 3.93                   | 0.011              | 8.72                   | 7.10                   | OK           |