



THE RESERVE AT CRIMSON RIDGE PHASE 2C CLUSTER SUBDIVISION

LOCATED IN THE NORTH HALF OF SECTION 10, AND THE SOUTH HALF OF SECTION 3
TOWNSHIP 6 NORTH, RANGE 1 EAST, SALT LAKE BASE AND MERIDIAN,
WEBER COUNTY, UTAH, JANUARY 2021

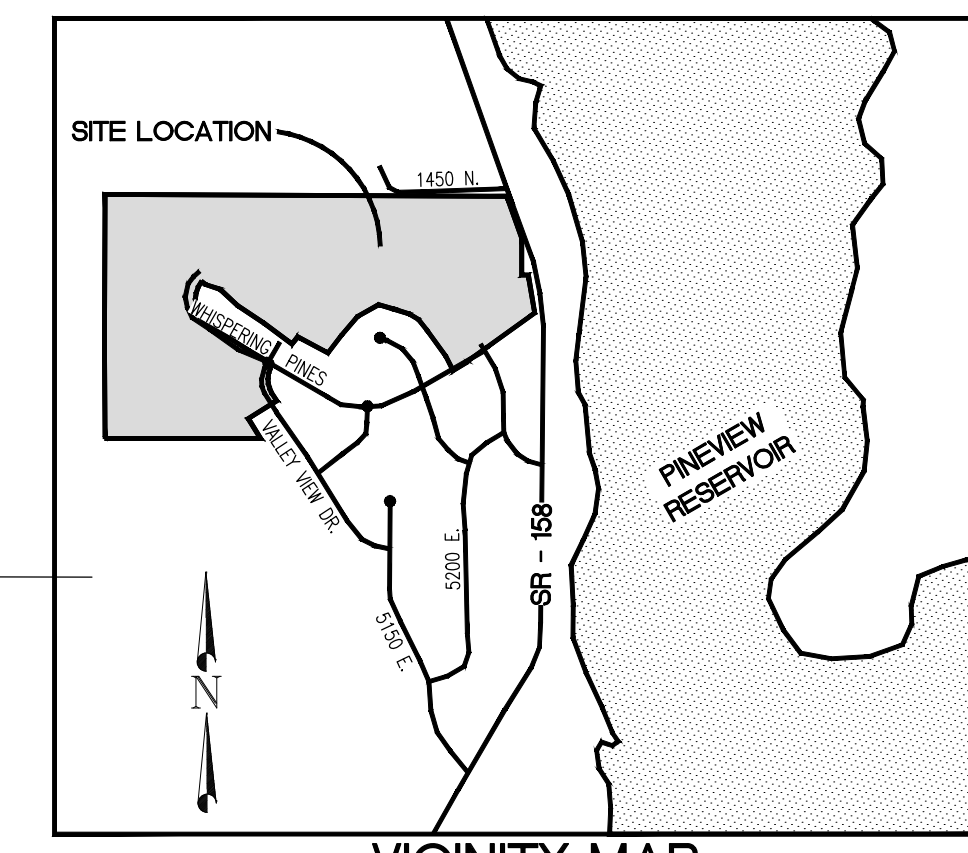

VICINITY MAP

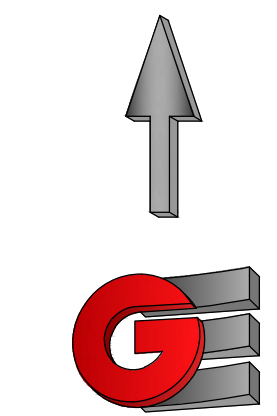

*Check that distances, bearings, and calls to adjoining the boundary description of property surveyed match what is shown on the map.



Scale of the map no smaller than 1" = 100' unless specified by the county surveyor. WCO 106-1-5(a); WCO 106-1-8(c)(1)

LEGEND

- ◆ WEBER COUNTY MONUMENT AS NOTED
- SET 24" REBAR AND CAP MARKED GARDNER ENGINEERING
- ◆ STREET CENTERLINE MONUMENT TO BE SET
- SUBDIVISION BOUNDARY
- - - LOT LINE
- - - CENTER LINE
- - - ADJACENT PARCEL
- - - SECTION LINE
- - - EASEMENT
- x EXISTING FENCE LINE

NOTES

1. SUBJECT PROPERTY FALLS WITHIN FEMA FLOOD ZONE "X" - AREAS DETERMINED TO BE OUTSIDE THE 0.2% ANNUAL CHANCE FLOODPLAIN AND ZONE "D" - AREAS IN WHICH FLOOD HAZARDS ARE UNDETERMINED BUT POSSIBLE. PER FEMA MAP NO.49057C0239E WITH AN EFFECTIVE DATE OF DECEMBER 16, 2015.
2. CLUSTER SUBDIVISION SETBACKS: FRONT: 20'; SIDE: 8'; REAR: 20'
3. N.A.P. STANDS FOR "NOT A PART OF THIS SUBDIVISION"
4. HOMEOWNERS ARE REFERRED TO THE GEOTECHNICAL STUDY "GEOTECHNICAL INVESTIGATION CRIMSON RIDGE SUBDIVISION PHASE 2 EDEN, UTAH" PREPARED BY CHRISTENSEN GEOTECHNICAL ON MAY 26, 2021 WITH A PROJECT NUMBER OF 227-001. HOUSE CONSTRUCTION SHALL CONFORM TO REPORT PARAMETERS. HOMEOWNERS ARE ENCOURAGED TO SEEK GEOTECHNICAL ON-SITE EVALUATION AS DEEMED DESIRABLE PER REPORT. FOR SOIL TEST PIT LOSS REFER TO THE ABOVE MENTIONED GEOTECHNICAL REPORT.

NARRATIVE

THE PURPOSE OF THIS SURVEY WAS TO CREATE AN EIGHT LOT SUBDIVISION ON THE PROPERTY AS SHOWN AND DESCRIBED HEREON. THE SURVEY WAS ORDERED BY B&H INVESTMENTS PROPERTIES. THE CONTROL USED TO ESTABLISH THE BOUNDARY WAS THE EXISTING WEBER COUNTY SURVEY MONUMENTATION AS SHOWN AND NOTED HEREON. THE BASIS OF BEARING IS THE NORTH LINE OF THE NORTHEAST QUARTER OF SECTION 3, TOWNSHIP 6 NORTH, RANGE 1 EAST, OF THE SALT LAKE BASE AND MERIDIAN WHICH BEARS NORTH 89°26'19" WEST WEBER COUNTY, UTAH NORTH, NAD 83 STATE PLANE GRID BEARING. THE DEDICATED PLAT OF THE RESERVE AT CRIMSON RIDGE CLUSTER SUBDIVISION PHASE 1 RECORDED AS ENTRY NUMBER 2199115 WAS ALSO USED TO ESTABLISH THE BOUNDARY.

The existing location, widths, and other dimensions of all existing or platted streets or railroad lines within and immediately adjacent (within 30') to the tract of land to be subdivided. WCO 106-1-5(a)(6)

All proposed streets shall be numbered under a definite system approved by the county surveyor and conform as far as practicable to the adopted street naming and numbering system of the county. Unless there are street alignment situations where a street name may be better utilized as a primary identifier. WCO 106-1-8(c)(1); UCA 17-27a-603(1)(c) see addressing review for street #

The names, widths, lengths, bearings and curve data on centerlines of proposed streets and alleys. WCO 106-1-8(c)(1); UCA 17-27a-603(1)(b)

A house number indicating the street address for each lot within the subdivision shall be assigned by the county surveyor. WCO 106-1-8(c)(1) f see addressing review for lot #

The house number marked on each lot so as to face the street frontage. WCO 106-1-8(c)(1) f

Where streets are given a number as the primary identifier a street name may be assigned as a secondary identifier. WCO 106-1-8(c)(1) Check street name

When street monuments are required, send "Subdivision Monumentation Letter" to developer of Subdivision to notify of the MIA and its associated costs. Letter and instructions will be sent with next review

The remaining parcel will show a note: "Remaining Agricultural Parcel, Not Approved for Development." WCO 106-1-8(c)(3).

per engineering review lots 60, 61 and 62 should have buildable area or restricted lots if lots need to be restricted or buildable areas then the following comments will need to be addressed

Restricted lots shall be designated on the final plat by placing the letter "R" immediately to the right of the number of the said lot. WCO 106-1-8(c)(3)a.

Plats including restricted lots shall include the following notification on the final plat: "Notice to Purchasers of restricted "R" lots. Lots designated by the letter "R" after the lot number are restricted lots and building development on such lots is subject to the provisions of title 108, chapter 14: Hillside Development Review Procedures and Standards. Approval of a restricted lot does not guarantee the lot is buildable. A Hillside Review as outlined in the Hillside Development Review Procedures and Standards chapter of the Land Use Code shall be done to determine if a lot is buildable." WCO 106-1-8(c)(4)a.

Lots approved with "buildable areas" shall have said buildable areas designated on the final plat by short dashed lines with dimensions and distances to at least two lot lines to accurately indicate the location of such building area. WCO 106-1-8(c)(4)b.

For lots approved with "buildable areas" such buildable area shall be designated on the plat by short dashed lines. WCO 106-1-8(c)(4)b.

The words "buildable area" shall be placed within the dashed lines. WCO 106-1-8(c)(4)b.

The buildable area shall provide sufficient survey detail to make it locatable within the lot boundaries. WCO 106-1-8(c)(4)b.

Plats with lots which include "buildable areas" shall include the following notification on the final plat: "Notice to Purchasers of Lots with Designated Building Areas. Lots with designated "building areas" have been approved subject to the condition that building development shall take place only within such designated areas." WCO 106-1-8(c)(4)a.

WEBER COUNTY SURVEYOR

I HEREBY CERTIFY THAT THE WEBER COUNTY SURVEYOR'S OFFICE HAS REVIEWED THIS PLAT AND ALL CONDITIONS FOR APPROVAL BY THIS OFFICE HAVE BEEN SATISFIED. THE APPROVAL OF THIS PLAT BY THE WEBER COUNTY SURVEYOR DOES NOT RELIEVE THE LICENSED LAND SURVEYOR WHO EXECUTED THIS PLAT FROM THE RESPONSIBILITIES AND/OR LIABILITIES ASSOCIATED THEREWITH.

SIGNED THIS ___ DAY OF ___, 2021.

COUNTY SURVEYOR

WEBER COUNTY ATTORNEY

I HAVE EXAMINED THE FINANCIAL GUARANTEE AND OTHER DOCUMENTS ASSOCIATED WITH THIS SUBDIVISION PLAT AND IN MY OPINION THEY CONFORM WITH THE COUNTY ORDINANCE APPLICABLE HERETO AND NOW IN FORCE AND EFFECT.

SIGNED THIS ___ DAY OF ___, 2021.

COUNTY ATTORNEY

WEBER COUNTY ENGINEER

I HEREBY CERTIFY THAT THE REQUIRED PUBLIC IMPROVEMENT STANDARDS AND DRAWINGS FOR THIS SUBDIVISION CONFORM WITH COUNTY STANDARDS AND THE AMOUNT OF THE FINANCIAL GUARANTEE IS SUFFICIENT FOR THE INSTALLATION OF THESE IMPROVEMENTS.

SIGNED THIS ___ DAY OF ___, 2021.

COUNTY ENGINEER

WEBER COUNTY COMMISSION ACCEPTANCE

THIS IS TO CERTIFY THAT THIS SUBDIVISION PLAT, THE DEDICATION OF STREETS AND OTHER PUBLIC WAYS AND FINANCIAL GUARANTEE OF PUBLIC IMPROVEMENTS ASSOCIATED WITH THIS SUBDIVISION THEREON ARE HEREBY APPROVED AND ACCEPTED BY THE COMMISSIONERS OF WEBER COUNTY, UTAH.

SIGNED THIS ___ DAY OF ___, 2021.

CHAIRMAN, WEBER COUNTY COMMISSION

ATTEST: _____ NAME/TITLE

WEBER COUNTY PLANNING COMMISSION APPROVAL

THIS IS TO CERTIFY THAT THIS SUBDIVISION WAS DULY APPROVED BY THE WEBER COUNTY PLANNING COMMISSION.

SIGNED THIS ___ DAY OF ___, 2021.

CHAIRMAN, WEBER COUNTY PLANNING COMMISSION

WEBER - MORGAN HEALTH DEPARTMENT

I DO HEREBY CERTIFY THAT THE SOILS, PERCOLATION RATES, AND SITE CONDITION FOR THIS SUBDIVISION HAVE BEEN INVESTIGATED BY THIS OFFICE AND ARE APPROVED FOR ON-SITE WASTEWATER DISPOSAL SYSTEMS.

SIGNED THIS ___ DAY OF ___, 2021.

DIRECTOR WEBER-MORGAN HEALTH DEPT.


BOUNDARY DESCRIPTION

A PART OF THE NORTH HALF OF SECTION 10 AND A PART OF THE SOUTH HALF OF SECTION 3, TOWNSHIP 6 NORTH, RANGE 1 EAST OF THE SALT LAKE BASE AND MERIDIAN, BEGINNING AT A POINT ON THE NORTHERLY BOUNDARY LINE OF THE RESERVE AT CRIMSON RIDGE PHASE 1 BEING LOCATED SOUTH 89°38'41" EAST 1049.21 FEET ALONG THE NORTH LINE OF SAID SECTION 10 AND NORTH 00°00'00" EAST 480.71 FEET FROM THE NORTHWEST QUARTER CORNER OF SAID SECTION 10, OF THE SALT LAKE BASE AND MERIDIAN (BASIS OF BEARING BEING THE NORTH LINE OF THE NORTHWEST QUARTER OF SECTION 10, TOWNSHIP 6 NORTH, RANGE 1 EAST, OF THE SALT LAKE BASE AND MERIDIAN SOUTH 89°38'41" EAST); RUNNING THENCE NORTH 71°47'20" WEST 135.28 FEET; THENCE NORTH 53°01'30" WEST 50.00 FEET; THENCE NORTH 32°04'03" EAST 182.91 FEET; THENCE NORTH 56°55'15" WEST 1160.48 FEET; THENCE SOUTH 89°37'01" EAST 2067.79 FEET; THENCE SOUTH 89°36'44" EAST 530.94 FEET TO THE WESTERLY BOUNDARY OF HARBOR VIEW ESTATES CLUSTER SUBDIVISION; THENCE ALONG SAID WESTERLY BOUNDARY FOLLOWING FOUR (4) COURSES: (1) SOUTH 23°18'36" WEST 250.13 FEET; (2) SOUTH 64°02'20" WEST 152.56 FEET; (3) ALONG THE ARC OF A 240.89 FOOT RADIUS CURVE TO THE RIGHT 41.41 FEET HAVING A CENTRAL ANGLE OF 9°29'23" WITH A CHORD BEARING SOUTH 49°04'51" EAST 41.36 FEET; (4) SOUTH 45°02'30" EAST 210.44 FEET TO THE WEST BOUNDARY LINE OF THE RESERVE AT CRIMSON RIDGE CLUSTER SUBDIVISION PHASE 2A; THENCE ALONG SAID WEST BOUNDARY SOUTH 30°15'03" WEST 51.25 FEET TO THE NORTHERN BOUNDARY OF THE RESERVE AT CRIMSON RIDGE CLUSTER SUBDIVISION PHASE 2B; THENCE ALONG SAID NORTHERN BOUNDARY FOLLOWING TEN (10) COURSES: (1) ALONG THE ARC OF A 345.00 FOOT RADIUS CURVE TO THE RIGHT 18.24 FEET, HAVING A CENTRAL ANGLE OF 3°01'47" WITH A CHORD BEARING NORTH 46°32'21" WEST 18.24 FEET; (2) NORTH 45°01'27" WEST 110.02 FEET; (3) SOUTH 65°30'50" WEST 175.30 FEET; (4) SOUTH 32°44'13" WEST 158.36 FEET; (5) SOUTH 57°38'44" WEST 193.46 FEET; (6) NORTH 85°54'18" WEST 16.21 FEET; (7) NORTH 59°06'47" WEST 36.34 FEET; (8) NORTH 87°28'10" WEST 163.09 FEET; (9) NORTH 89°07'03" WEST 451.18 FEET; (10) SOUTH 65°33'19" WEST 342.71 FEET TO THE POINT OF BEGINNING. CONTAINING 31.247 ACRES MORE OR LESS.

SURVEYOR'S CERTIFICATE

I, KLINT H. WHITNEY, DO HEREBY CERTIFY THAT I AM A LICENSED PROFESSIONAL LAND SURVEYOR IN THE STATE OF UTAH AND THAT I HOLD CERTIFICATE NO. 8227228 IN ACCORDANCE WITH TITLE 58, CHAPTER 22, OF THE PROFESSIONAL ENGINEERS AND LAND SURVEYORS ACT; I FURTHER CERTIFY THAT BY AUTHORITY OF THE OWNERS I HAVE COMPLETED A SURVEY OF THE PROPERTY AS SHOWN AND DESCRIBED ON THIS PLAT, AND HAVE SUBMITTED SAID PROPERTY INTO LOTS AND STREETS, TOGETHER WITH EASEMENTS, HEREAFTER TO BE KNOWN AS THE RESERVE AT CRIMSON RIDGE PHASE 2C CLUSTER SUBDIVISION IN ACCORDANCE WITH SECTION 17-23-17 AND HAVE VERIFIED ALL MEASUREMENTS; THAT THE REFERENCE MONUMENTS SHOWN HEREON ARE LOCATED AS INDICATED AND ARE SUFFICIENT TO RETRACE OR REESTABLISH THIS SURVEY; THAT ALL LOTS MEET THE REQUIREMENTS OF THE LAND USE CODE; AND THAT THE INFORMATION SHOWN HEREIN IS SUFFICIENT TO ACCURATELY ESTABLISH THE LATERAL BOUNDARIES OF THE HEREIN DESCRIBED TRACT OF REAL PROPERTY.

SIGNED THIS ___ DAY OF ___, 2021.

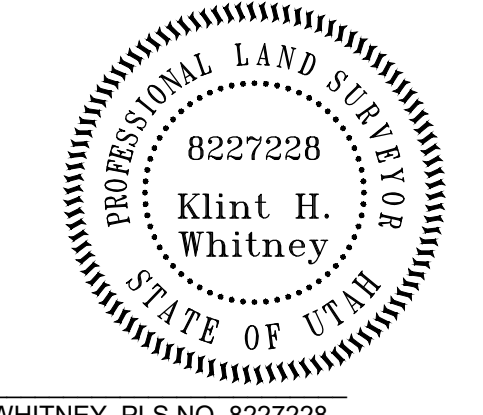

KLINT H. WHITNEY, PLS NO. 8227228

OWNER'S DEDICATION

WE THE UNDERSIGNED OWNERS OF THE HEREIN DESCRIBED TRACT OF LAND, DO HEREBY SET APART AND SUBDIVIDE THE SAME INTO LOTS AND STREETS (PRIVATE STREETS, PRIVATE RIGHT OF WAY) AS SHOWN ON THE PLAT AND NAME SAID TRACT THE RESERVE AT CRIMSON RIDGE PHASE 2C CLUSTER SUBDIVISION AND DO HEREBY DEDICATE TO PUBLIC USE ALL THOSE PARTS OR PORTIONS OF SAID TRACT OF LAND DESIGNATED AS STREETS, THE SAME TO BE USED AS PUBLIC THROUGHFARES, AND ALSO TO DEDICATE AND RESERVE UNTO THEMSELVES, THEIR HEIRS, THEIR GRANTEEES AND ASSIGNS, A RIGHT-OF-WAY TO BE USED IN COMMON WITH ALL OTHERS WITHIN SAID SUBDIVISION AND THOSE ADJOINING SUBDIVISIONS THAT MAY BE SUBDIVIDED BY THE UNDERSIGNED OWNERS, THEIR SUCCESSORS, OR ASSIGNS) ON, OVER AND ACROSS ALL THOSE PORTIONS OR PARTS OF SAID TRACT OF LAND DESIGNATED ON SAID PLAT AS PRIVATE STREETS (PRIVATE RIGHTS OF WAY) AS ACCESS TO THE INDIVIDUAL LOTS, TO BE MAINTAINED BY A LOT (UNIT) OWNERS ASSOCIATION WHOSE MEMBERSHIP CONSISTS OF SAID OWNERS, THEIR GRANTEEES, SUCCESSORS, OR ASSIGNS, AND ALSO TO GRANT AND CONVEY TO THE SUBDIVISION LOT (UNIT) OWNERS ASSOCIATION, ALL THOSE PART OR PORTIONS OF SAID TRACT OF LAND DESIGNATED AS COMMON AREAS TO BE USED FOR RECREATIONAL AND OPEN SPACE PURPOSES FOR THE BENEFIT OF EACH LOT (UNIT) OWNERS ASSOCIATION MEMBER IN COMMON WITH ALL OTHERS IN THE SUBDIVISION AND GRANT AND DEDICATE TO WEBER COUNTY A PERPETUAL OPEN SPACE RIGHT AND EASEMENT ON AND OVER THE COMMON AREAS TO GUARANTEE TO WEBER COUNTY THAT THE COMMON AREAS REMAIN OPEN AND UNDEVELOPED EXCEPT FOR APPROVED RECREATIONAL, PARKING AND OPEN SPACE PURPOSES, AND ALSO TO GRANT AND DEDICATE A PERPETUAL RIGHT AND EASEMENT OVER, UPON AND UNDER THE LANDS DESIGNATED HEREON AS PUBLIC UTILITY, THE SAME TO BE USED FOR THE INSTALLATION MAINTENANCE AND OPERATION OF PUBLIC UTILITY SERVICE LINES, STORM DRAINAGE FACILITIES, IRRIGATION CANALS OR THOSE THE PERPETUAL PRESERVATION OF WATER CHANNELS IN THEIR NATURAL STATE WHICH EVER IS APPLICABLE AS MAY BE AUTHORIZED BY THE GOVERNING AUTHORITY, WITH NO BUILDINGS OR STRUCTURES BEING ERECTED WITHIN SUCH EASEMENTS AND ALSO GRANT, DEDICATE AND CONVEY LANDS DESIGNATED ON THE PLAT AS SEPTIC TANK EASEMENT TO PINEVIEW WEST SEWER IMPROVEMENT DISTRICT, THE SAME TO BE USED FOR MAINTENANCE AND REGULAR INSPECTIONS.

SIGNED THIS ___ DAY OF ___, 2021.

B & H INVESTMENT PROPERTIES LLC

BY: _____ PRINTED NAME/TITLE:

ACKNOWLEDGEMENT

STATE OF UTAH)
COUNTY OF WEBER)

On this ___ day of ___, 2021, personally appeared before me _____ whose identity is personally known to me (or proven on the basis of satisfactory evidence) and who by me duly sworn/affirmed, did say that he/she is the _____ of B & H INVESTMENT PROPERTIES LLC, and that said document was signed by him/her in behalf of said Corporation by Authority of its Bylaws, or a Resolution of its Board of Directors, and said acknowledged to me that said Corporation executed the same.

STAMP

NOTARY PUBLIC

<p>DEVELOPER: B&H INVESTMENT PROPERTIES LLC 110 WEST 1700 NORTH CENTERTVILLE, UTAH 84014 801-295-4193</p>	<p>S1 3</p>	<p>COUNTY RECORDER</p> <p>ENTRY NO. _____ FEE PAID _____</p> <p>FILED FOR AND RECORDED _____</p> <p>AT _____ IN BOOK _____ OF OFFICIAL _____</p> <p>RECORDS, PAGE _____ RECORDED _____</p> <p>FOR _____</p> <p>COUNTY RECORDER</p> <p>BY: _____</p>
<p>GARDNER ENGINEERING CIVIL • LAND PLANNING MUNICIPAL • LAND SURVEYING 5150 SOUTH 875 EAST OPEN UT OFFICE: 801.476.0202 FAX: 801.476.0066</p>		

**THE RESERVE AT CRIMSON RIDGE PHASE 2C
CLUSTER SUBDIVISION**
LOCATED IN THE NORTH HALF OF SECTION 10, AND THE SOUTH HALF OF SECTION 3
TOWNSHIP 6 NORTH, RANGE 1 EAST, SALT LAKE BASE AND MERIDIAN,
WEBER COUNTY, UTAH, JANUARY 2021

The existing location, widths, and other dimensions of all existing or platted streets or railroad lines within and immediately adjacent (within 30') to the tract of land to be subdivided. WCO 106-1-5(a)(6)
Check all curve data and bearings for road there seems to be a lot of ambiguity of brgs and radius

The location, widths, and other dimensions of proposed public streets, private streets, private access rights of way, or alleys with proper labeling of spaces to be dedicated to public or designated as private. WCO 106-1-5(a)(7)

The location, widths, and other dimensions of proposed lots with proper labeling of spaces to be dedicated to public or designated as private. WCO 106-1-5(a)(7)

The location, widths, and other dimensions of proposed pathways, parks, or other open spaces with proper labeling of spaces to be dedicated to public or designated as private. WCO 106-1-5(a)(7)

missing or wrong curve data on lots and open spaces

check Sf and acreage on lots

Different radius?

The existing location, widths, and other dimensions of all existing or platted land drains, culverts, watercourses, wetlands, streams corridor setbacks, flood plain within and immediately adjacent (within 30') to the tract of land to be subdivided. WCO 106-1-5(a)(6)
ties to stream and adjacent location

All different radius?


Curve?

Bearings? Matching cl or boundary?


Curve?

Different radius?

CURVE TABLE					
CURVE #	LENGTH	RADIUS	DELTA	CHORD BEARING	CHORD LENGTH
C1	465.26	473.00	56.36	N60° 17' 08"E	446.73
C2	174.32	325.00	30.73	S76° 10' 08"E	172.24
C3	309.31	400.00	44.31	S82° 57' 19"E	301.66
C4	235.95	225.00	60.08	S75° 03' 58"E	225.28
C5	11.74	320.00	2.10	S46° 04' 30"E	11.74
C6	489.85	498.00	56.36	N60° 17' 08"E	470.34
C7	187.73	350.00	30.73	S76° 10' 08"E	185.49
C8	289.98	375.00	44.31	S82° 57' 19"E	282.81
C9	223.76	250.00	51.28	S79° 28' 00"E	216.37
C10	209.73	200.00	60.08	N75° 03' 58"W	200.25
C11	328.64	425.00	44.31	N82° 57' 19"W	320.51
C12	160.91	300.00	30.73	N76° 10' 08"W	158.99
C14	440.67	448.00	56.36	S60° 17' 08"W	423.12
C16	241.68	498.01	27.80	S60° 12' 43"W	239.31
C17	124.71	497.83	14.35	S81° 17' 27"W	124.38
C18	170.85	350.00	27.97	N77° 33' 02"W	169.16
C19	222.12	375.00	33.94	N77° 46' 17"W	218.89
C20	16.88	350.00	2.76	N62° 11' 03"W	16.88
C21	96.42	250.00	22.10	S85° 56' 29"W	95.83
C22	67.86	375.00	10.37	S80° 04' 33"W	67.76
C23	127.34	250.15	29.17	N68° 25' 03"W	125.97
C24	32.14	313.26	5.88	S63° 52' 19"E	32.13
C25	197.71	425.00	26.65	S74° 07' 48"E	195.94
C34	309.82	448.00	39.62	N68° 39' 10"E	303.69
C39	123.47	497.23	14.23	S39° 12' 51"W	123.15
C40	46.13	225.71	11.71	N77° 26' 07"E	46.05
C41	151.97	760.05	11.46	N77° 33' 42"E	151.72
C42	428.23	705.32	34.79	S85° 30' 39"E	421.68
C43	114.52	143.44	45.74	S84° 11' 24"E	111.50
C44	117.14	307.00	21.86	N62° 00' 30"E	116.43
C45	121.44	328.26	21.20	N40° 28' 47"E	120.75
C46	100.56	263.76	21.85	N23° 52' 38"E	99.96

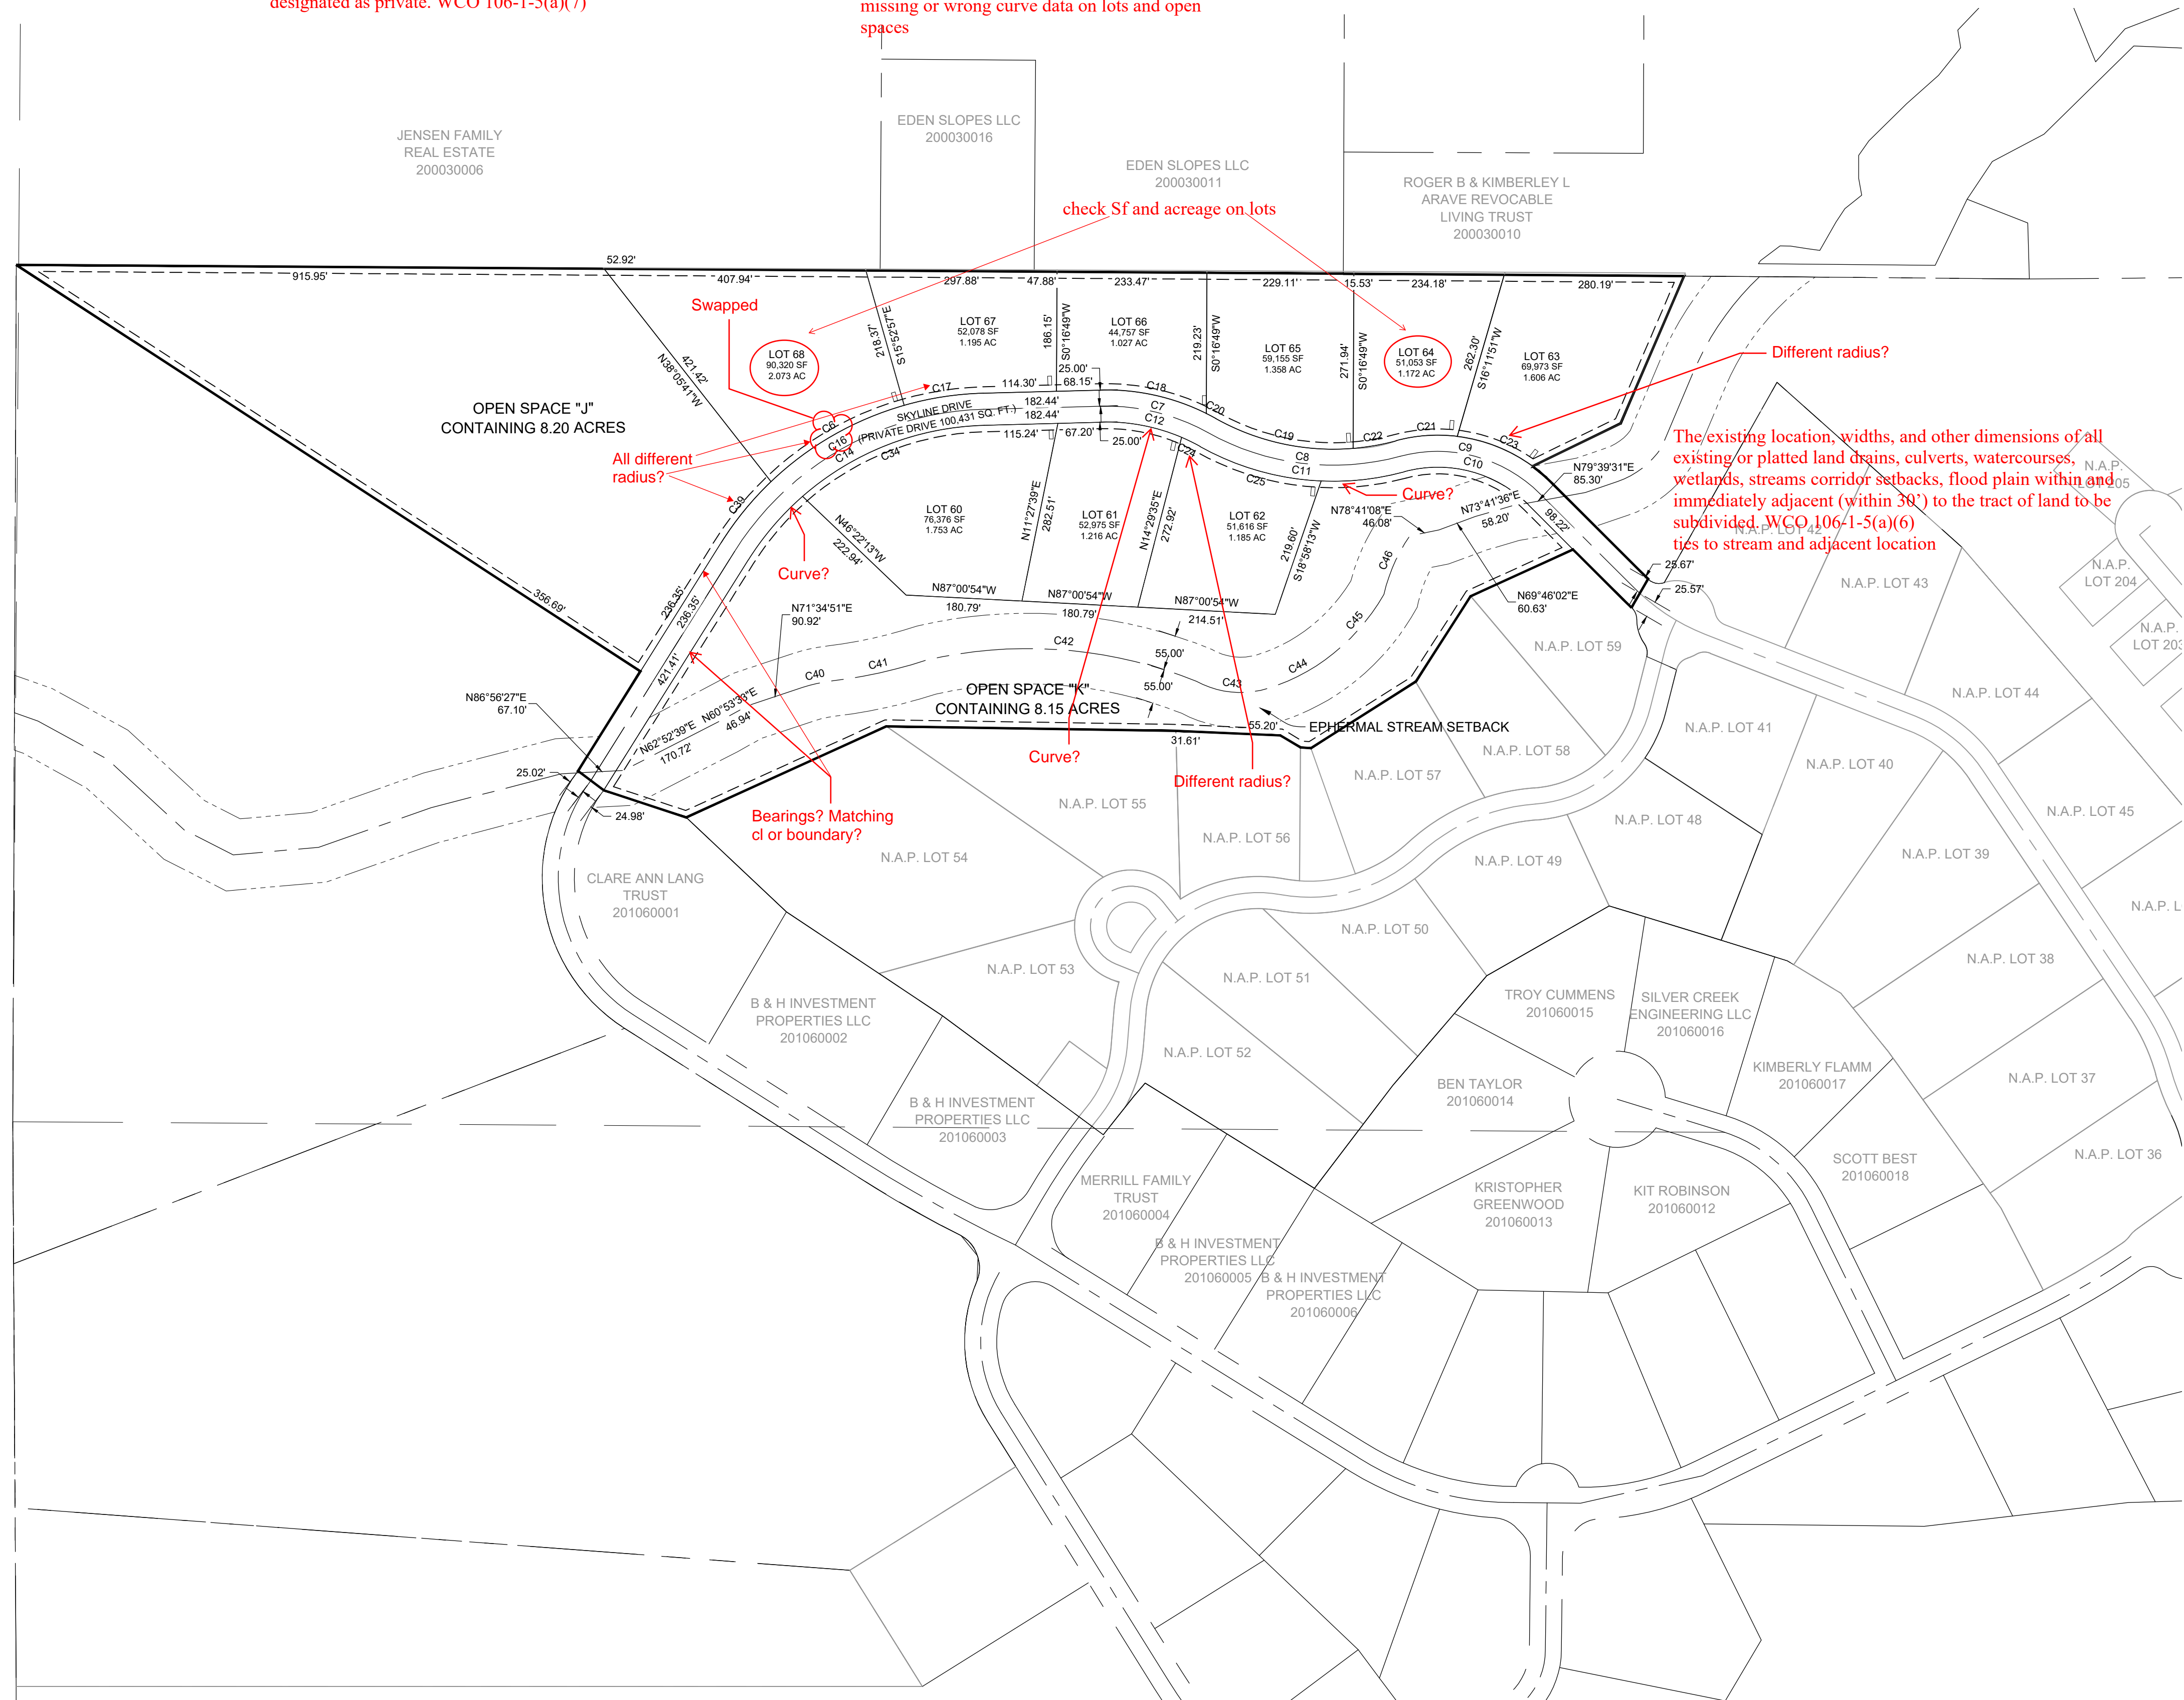

- LEGEND**
- ◆ WEBER COUNTY MONUMENT AS NOTED
 - SET 24" REBAR AND CAP MARKED GARDNER ENGINEERING
 - SUBDIVISION BOUNDARY
 - LOT LINE
 - - - CENTER LINE
 - - - ADJACENT PARCEL
 - - - SECTION LINE
 - - - EASEMENT
 - x EXISTING FENCE LINE

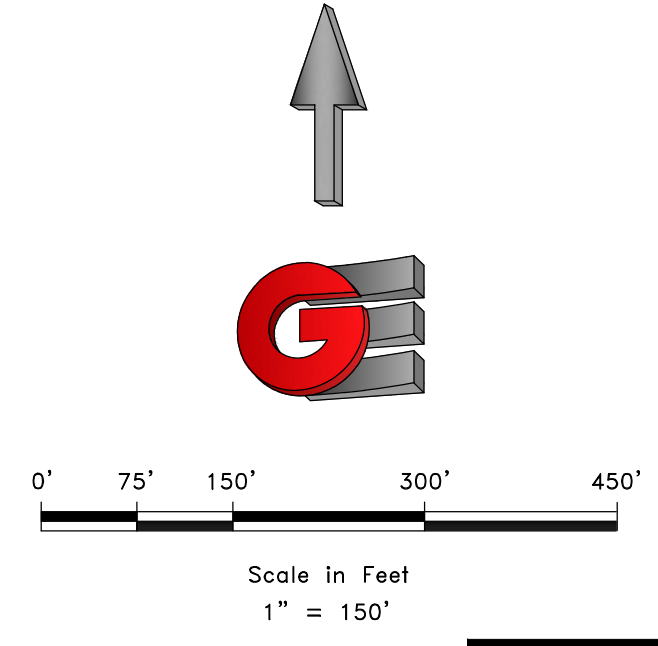

DEVELOPER: B&H INVESTMENT PROPERTIES LLC 110 WEST 1700 NORTH CENTERTVILLE, UTAH 84014 801-295-4193	S2 3	COUNTY RECORDER ENTRY NO. _____ FEE PAID _____ FILED FOR AND RECORDED _____ AT _____ IN BOOK _____ OF OFFICIAL _____ RECORDS, PAGE _____ RECORDED _____ FOR _____ COUNTY RECORDER _____ BY: _____
		<p>GARDNER ENGINEERING CIVIL • LAND PLANNING MUNICIPAL • LAND SURVEYING 5150 SOUTH 375 EAST OGDEN, UT OFFICE: 801-476-0202 FAX: 801-476-0066</p>

P:\0208 - B&H INVESTMENT\CRIMSON RIDGE\SURVEY\CRIMSON RIDGE PHASE 2C\DWG