

ASPEN DRIVE

EXISTING PRIVATE ROAD  
(GRAVEL SURFACE)

LOT 41R

TRAIL AS CONSTRUCTED

20' TRAIL  
EASEMENT  
LOCATION PER  
SUBDIVISION PLAT

20'

2'

8280

8270

LOT 40

LOT 39

ASPEN DRIVE


EXISTING PRIVATE ROAD  
(GRAVEL SURFACE)

EXIST TELE  
PEDESTAL


EXIST ELECTRICAL  
PEDESTAL

DEVELOPER:

Jim DePiano  
97 West Ridge Rd  
Stowe, VT 05672

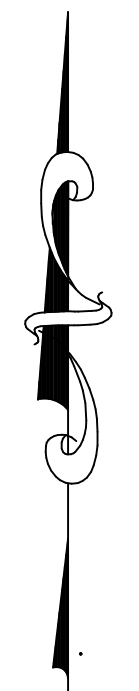

SCALES: 1" = 100'

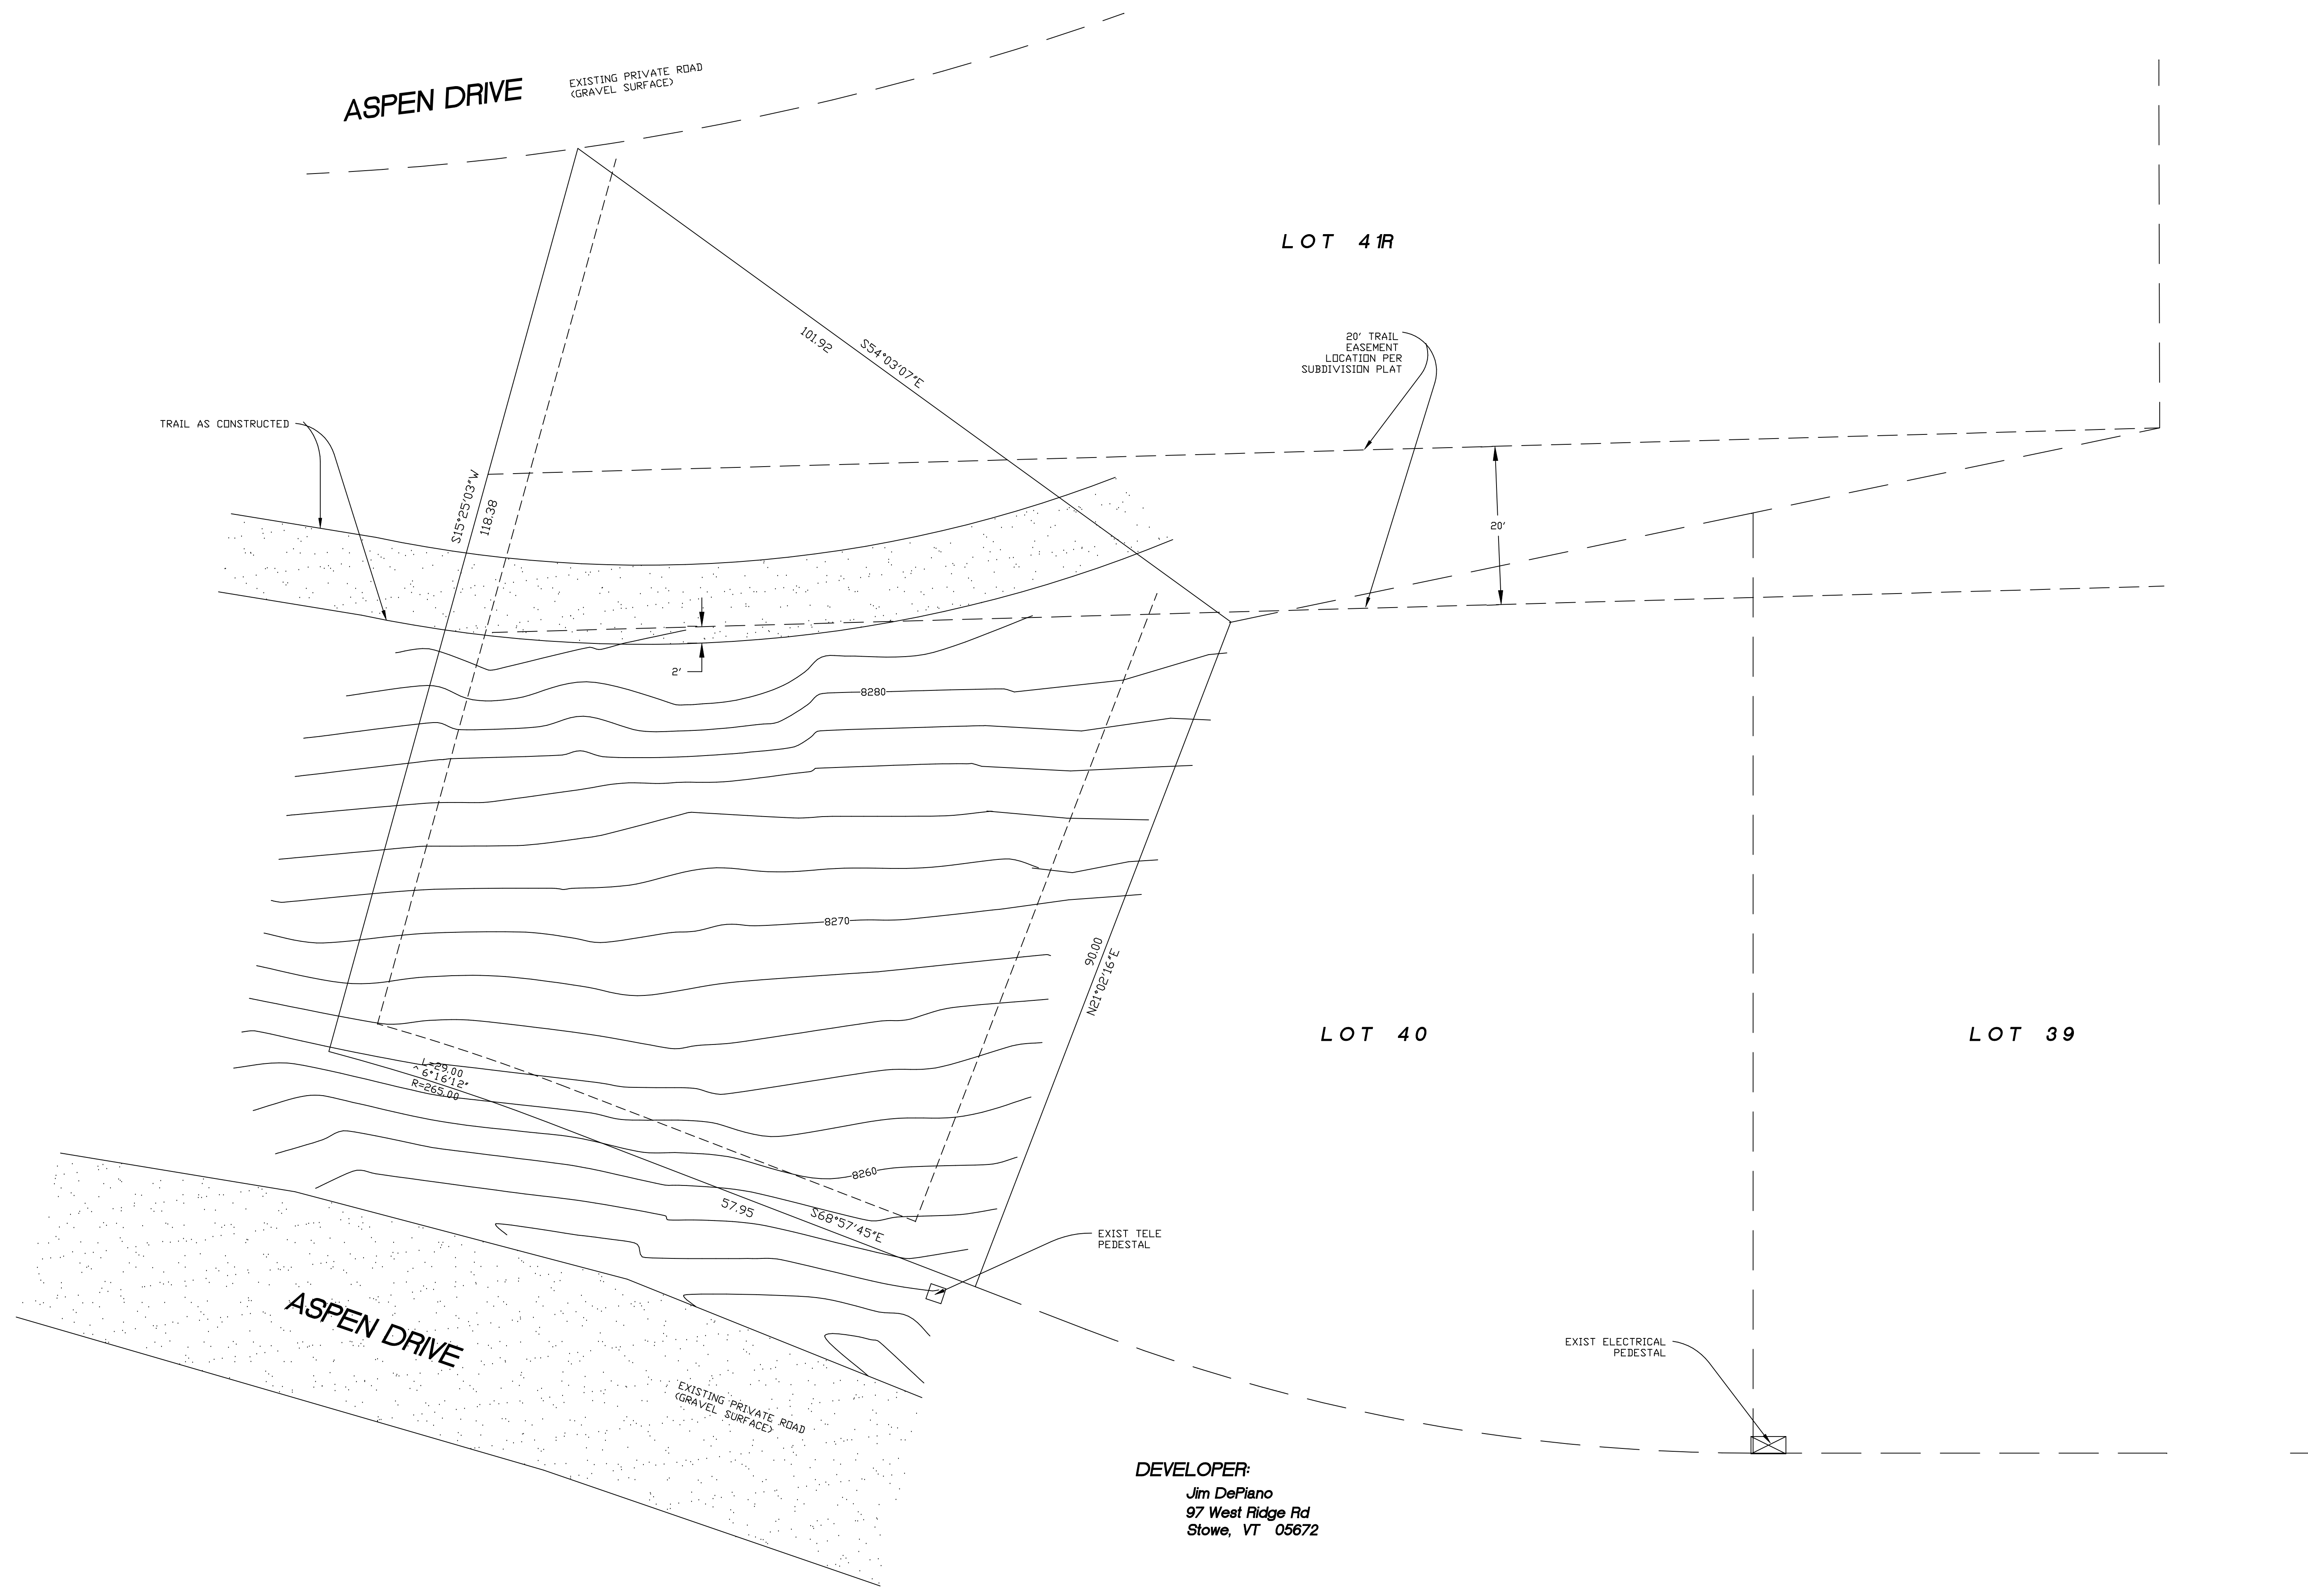

REVISIONS	
1.) _____	5.) _____
2.) _____	6.) _____
3.) _____	7.) _____
4.) _____	8.) _____

DRAWN BY:	DATE:
CHECKED BY:	SCALE: 1" = 100'
JOB NO.	



**LANDMARK SURVEYING**  
A COMPLETE SURVEYING SERVICE  
4646 S 3500 W STE3, WEST HAVEN, UT. 84401  
PHONE 801-731-4075

### TOPOGRAPHY PLAN

LOT 42R  
POWDER MOUNTAIN WEST PH-2  
WEBER CO., UTAH

SHEET	1
SHEETS	1