


THE POINTE AT WOLF CREEK
LOCATED IN THE SOUTHWEST QUARTER OF SECTION 22,
TOWNSHIP 7 NORTH, RANGE 1 EAST, SALT LAKE BASE AND MERIDIAN,
WEBER COUNTY, UTAH
JUNE 2021

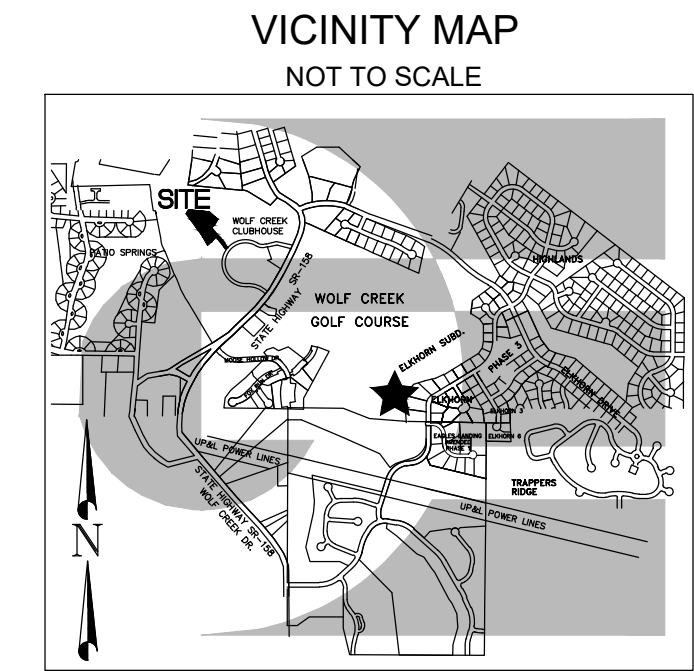


BOUNDARY DESCRIPTION

A PART OF THE SOUTHWEST QUARTER OF SECTION 22, TOWNSHIP 7 NORTH, RANGE 1 EAST OF THE SALT LAKE BASE AND MERIDIAN, MORE PARTICULARLY DESCRIBED AS FOLLOWS: BEGINNING AT A POINT BEING LOCATED NORTH 89°14'39" WEST 720.14 FEET ALONG THE NORTH LINE OF THE SOUTHWEST QUARTER OF SAID SECTION AND SOUTH 00°00'00" EAST 169.10 FEET FROM THE EAST QUARTER CORNER OF SAID SECTION...

SURVEYOR'S CERTIFICATE

I, KLINT H. WHITNEY, DO HEREBY CERTIFY THAT I AM A LICENSED PROFESSIONAL LAND SURVEYOR IN THE STATE OF UTAH AND THAT I HOLD CERTIFICATE NO. 8227228 IN ACCORDANCE WITH TITLE 68, CHAPTER 22, OF THE PROFESSIONAL ENGINEERS AND LAND SURVEYORS ACT...

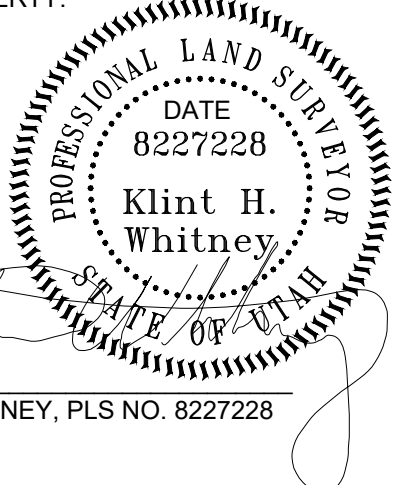

SIGNED THIS ____ DAY OF _____, 2021.

OWNER'S DEDICATION

THE POINTE AT WOLF CREEK, LLC, (THE POINTE) AS OWNER OF THE TRACT OF LAND DESCRIBED HEREON, AND AS DECLARANT OF THAT CERTAIN PROJECT KNOWN AS THE POINTE AT WOLF CREEK, HEREBY DEDICATES AND RESERVES UNTO ITSELF, INCLUDING ITS GRANTEEES, SUCCESSORS AND ASSIGNS, A RIGHT-OF-WAY TO BE USED IN COMMON WITH ALL OTHERS WITHIN SAID PROJECT...

THE POINTE AT WOLF CREEK, LLC, GRANTS AND DEDICATES TO WEBER COUNTY A PERPETUAL EASEMENT OVER UPON AND UNDER THE LANDS DESIGNATED ON THE PLAT AS COMMON AREA, THE SAME TO BE USED FOR THE INSTALLATION, MAINTENANCE AND OPERATION OF PUBLIC UTILITY SERVICE LINES...

A. PRIVATE OWNERSHIP WILL BE DEFINED AS ANYTHING WITHIN THE FOOTPRINT OF THE INDIVIDUAL LOTS/UNITS AS SHOWN ON SHEET 3.

B. LIMITED COMMON AREA TO BE EXCLUDED FROM PUBLIC UTILITY EASEMENT DEDICATION.

THE POINTE AT WOLF CREEK, LLC
SIGNED THIS ____ DAY OF _____, 2021
JOHN L. LEWIS, MANAGING MEMBER

ACKNOWLEDGEMENT

STATE OF UTAH)
COUNTY OF WEBER)

On this ____ day of _____, 2021, personally appeared before me JOHN L. LEWIS, whose identity is personally known to me (or proven on the basis of satisfactory evidence) and who by me duly sworn/affirmed, did say that he/she is the MANAGING MEMBER OF THE POINTE AT WOLF CREEK, LLC...

PRINTED NAME SIGNATURE COUNTY AND STATE
COMMISSION NUMBER MY COMMISSION EXPIRES

NOTES

- 1. ZONE: FOREST RESIDENTIAL
2. NIGHTLY RENTALS ARE ALLOWED.

NARRATIVE

THE PURPOSE OF THIS SURVEY WAS TO CREATE UNITS ON THE PROPERTY AS SHOWN AND DESCRIBED HEREON. THE SURVEY WAS ORDERED BY JOHN LEWIS. THE CONTROL USED TO ESTABLISH THE BOUNDARY WAS THE EXISTING WEBER COUNTY SURVEY MONUMENTATION AS SHOWN AND NOTED HEREON...

FOUND
W.C. 3" BRASS CAP IN PVC - 1981
AT GROUND LEVEL - GOOD COND.
WEST QUARTER CORNER
SEC. 22 T7N, R1E SLB&M

FOUND
W.C. 3" BRASS CAP IN CONC. - 1967
AT GROUND LEVEL - GOOD COND.
CENTER QUARTER CORNER
SEC. 22 T7N, R1E SLB&M

Please show dimension or where does this tie in at? or starting point?

Please see comment on second page. Address review will be submitted once I get clarification on how the unit numbering works.

The existing location, widths, and other dimensions of all existing or platted sanitary sewers, storm drains, water supply mains, fire hydrants, water wells within or immediately adjacent to the tract of land to be subdivided. WCO 106-1-5(a)(6)

Please show dimension or where does this tie in at? or starting point?

A signature block for County Surveyor conforming to state code and county ordinance. Weber County Surveyor: I hereby certify that the Weber County Surveyor's Office has reviewed this plat and all conditions for approval by this office have been satisfied...

Weber County Surveyor
Record Of Survey #
WCO 106-1-8(c)(1)h.10; WCO 45-4-2(c)

LINE TABLE with columns for LINE #, LENGTH, BEARING. Includes lines L1 through L150.

CURVE TABLE with columns for CURVE #, LENGTH, RADIUS, DELTA, CHORD BEARING, CHORD LENGTH. Includes curves C1 through C13.

WEBER COUNTY SURVEYOR
I HEREBY CERTIFY THAT THE WEBER COUNTY SURVEYOR'S OFFICE HAS REVIEWED THIS PLAT AND ALL CONDITIONS FOR APPROVAL BY THIS OFFICE HAVE BEEN SATISFIED...

WEBER COUNTY ATTORNEY
I HAVE EXAMINED THE FINANCIAL GUARANTEE AND OTHER DOCUMENTS ASSOCIATED WITH THIS SUBDIVISION PLAT...

WEBER COUNTY ENGINEER
I HEREBY CERTIFY THAT THE REQUIRED PUBLIC IMPROVEMENT STANDARDS AND DRAWINGS FOR THIS SUBDIVISION CONFORM WITH COUNTY STANDARDS...

WEBER COUNTY COMMISSION ACCEPTANCE
THIS IS TO CERTIFY THAT THIS SUBDIVISION PLAT, THE DEDICATION OF STREETS AND OTHER PUBLIC WAYS AND FINANCIAL GUARANTEE OF PUBLIC IMPROVEMENTS ASSOCIATED WITH THIS SUBDIVISION THEREON ARE HEREBY APPROVED AND ACCEPTED...

WEBER COUNTY PLANNING COMMISSION APPROVAL
THIS IS TO CERTIFY THAT THIS SUBDIVISION WAS DULY APPROVED BY THE WEBER COUNTY PLANNING COMMISSION.


WEBER - MORGAN HEALTH DEPARTMENT
I DO HEREBY CERTIFY THAT THE SOILS, PERCOLATION RATES, AND SITE CONDITION FOR THIS SUBDIVISION HAVE BEEN INVESTIGATED BY THIS OFFICE AND ARE APPROVED FOR ON-SITE WASTEWATER DISPOSAL SYSTEMS.

DEVELOPER: THE POINT AT WOLF CREEK, LLC
COUNTY RECORDER: ENTRY NO., FEE PAID, FILED FOR AND RECORDED, AT _____ IN BOOK _____ OF OFFICIAL RECORDS, PAGE _____ RECORDED FOR _____ COUNTY RECORDER BY: _____
GARDNER ENGINEERING CIVIL - LAND PLANNING MUNICIPAL - LAND SURVEYING


R:\2021 - LEWIS HOMES\1062 - THE POINTE\SURVEY\DWG\THE POINTE - SUB PLAT.DWG

THE POINTE AT WOLF CREEK
 LOCATED IN THE SOUTHWEST QUARTER OF SECTION 22,
 TOWNSHIP 7 NORTH, RANGE 1 EAST, SALT LAKE BASE AND MERIDIAN,
 WEBER COUNTY, UTAH
 JUNE 2021


How does the numbering work? Each unit should be the same number.

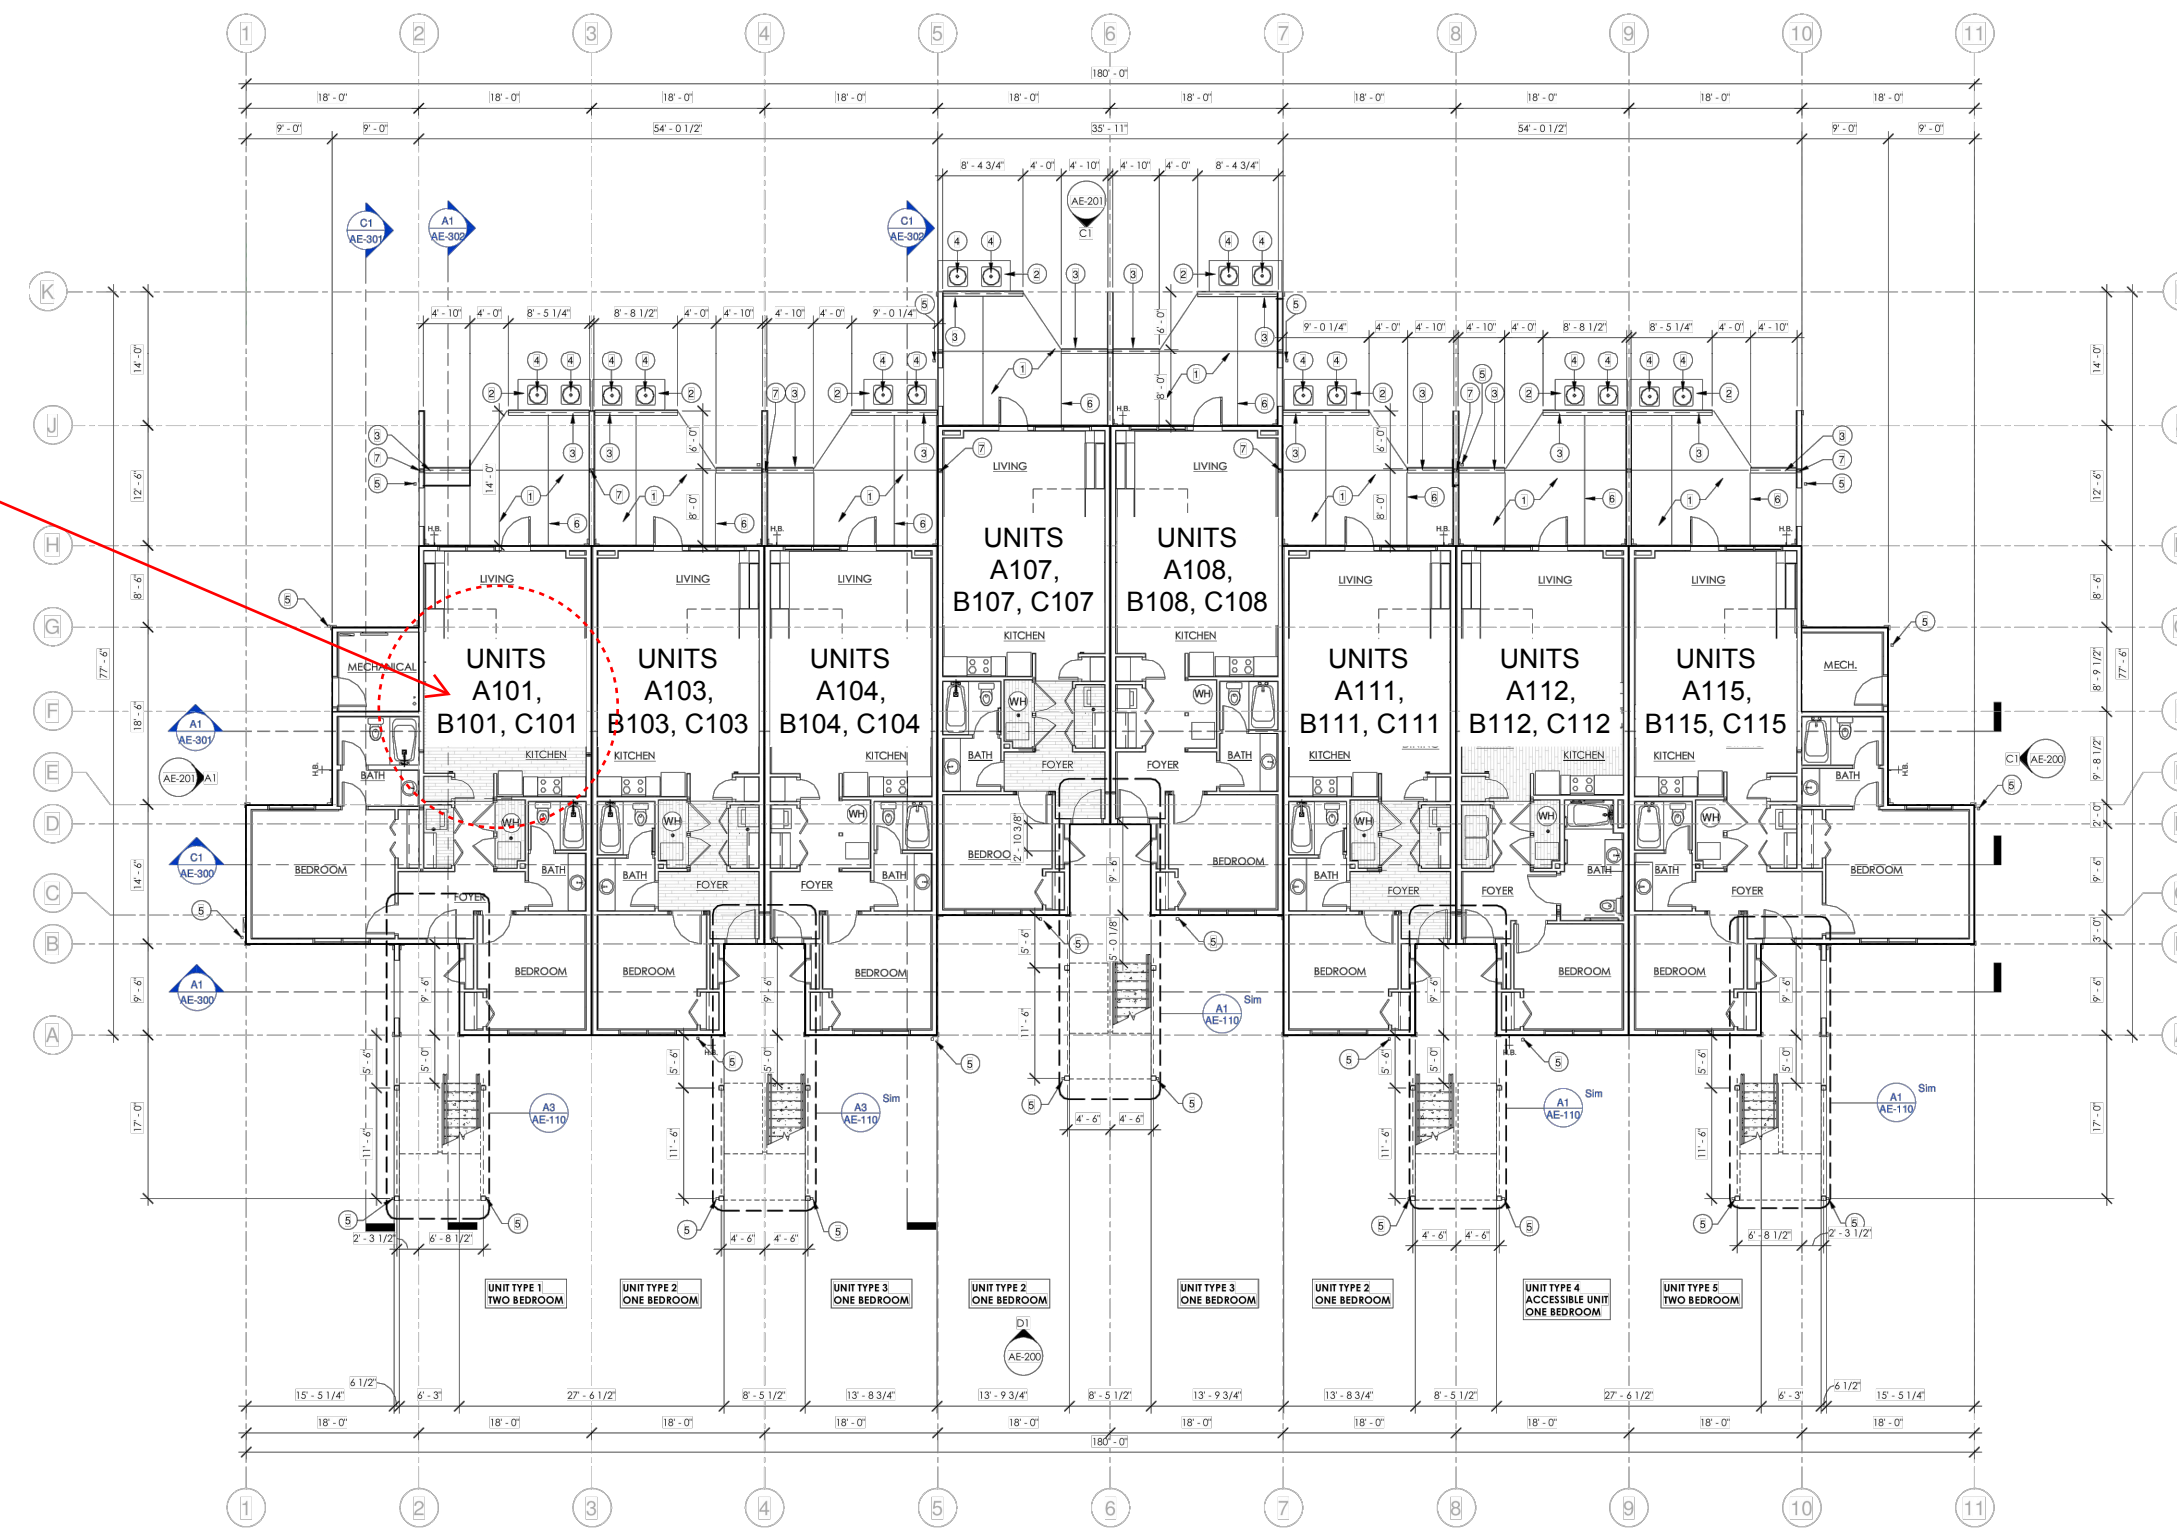

MAIN LEVEL FLOOR PLAN

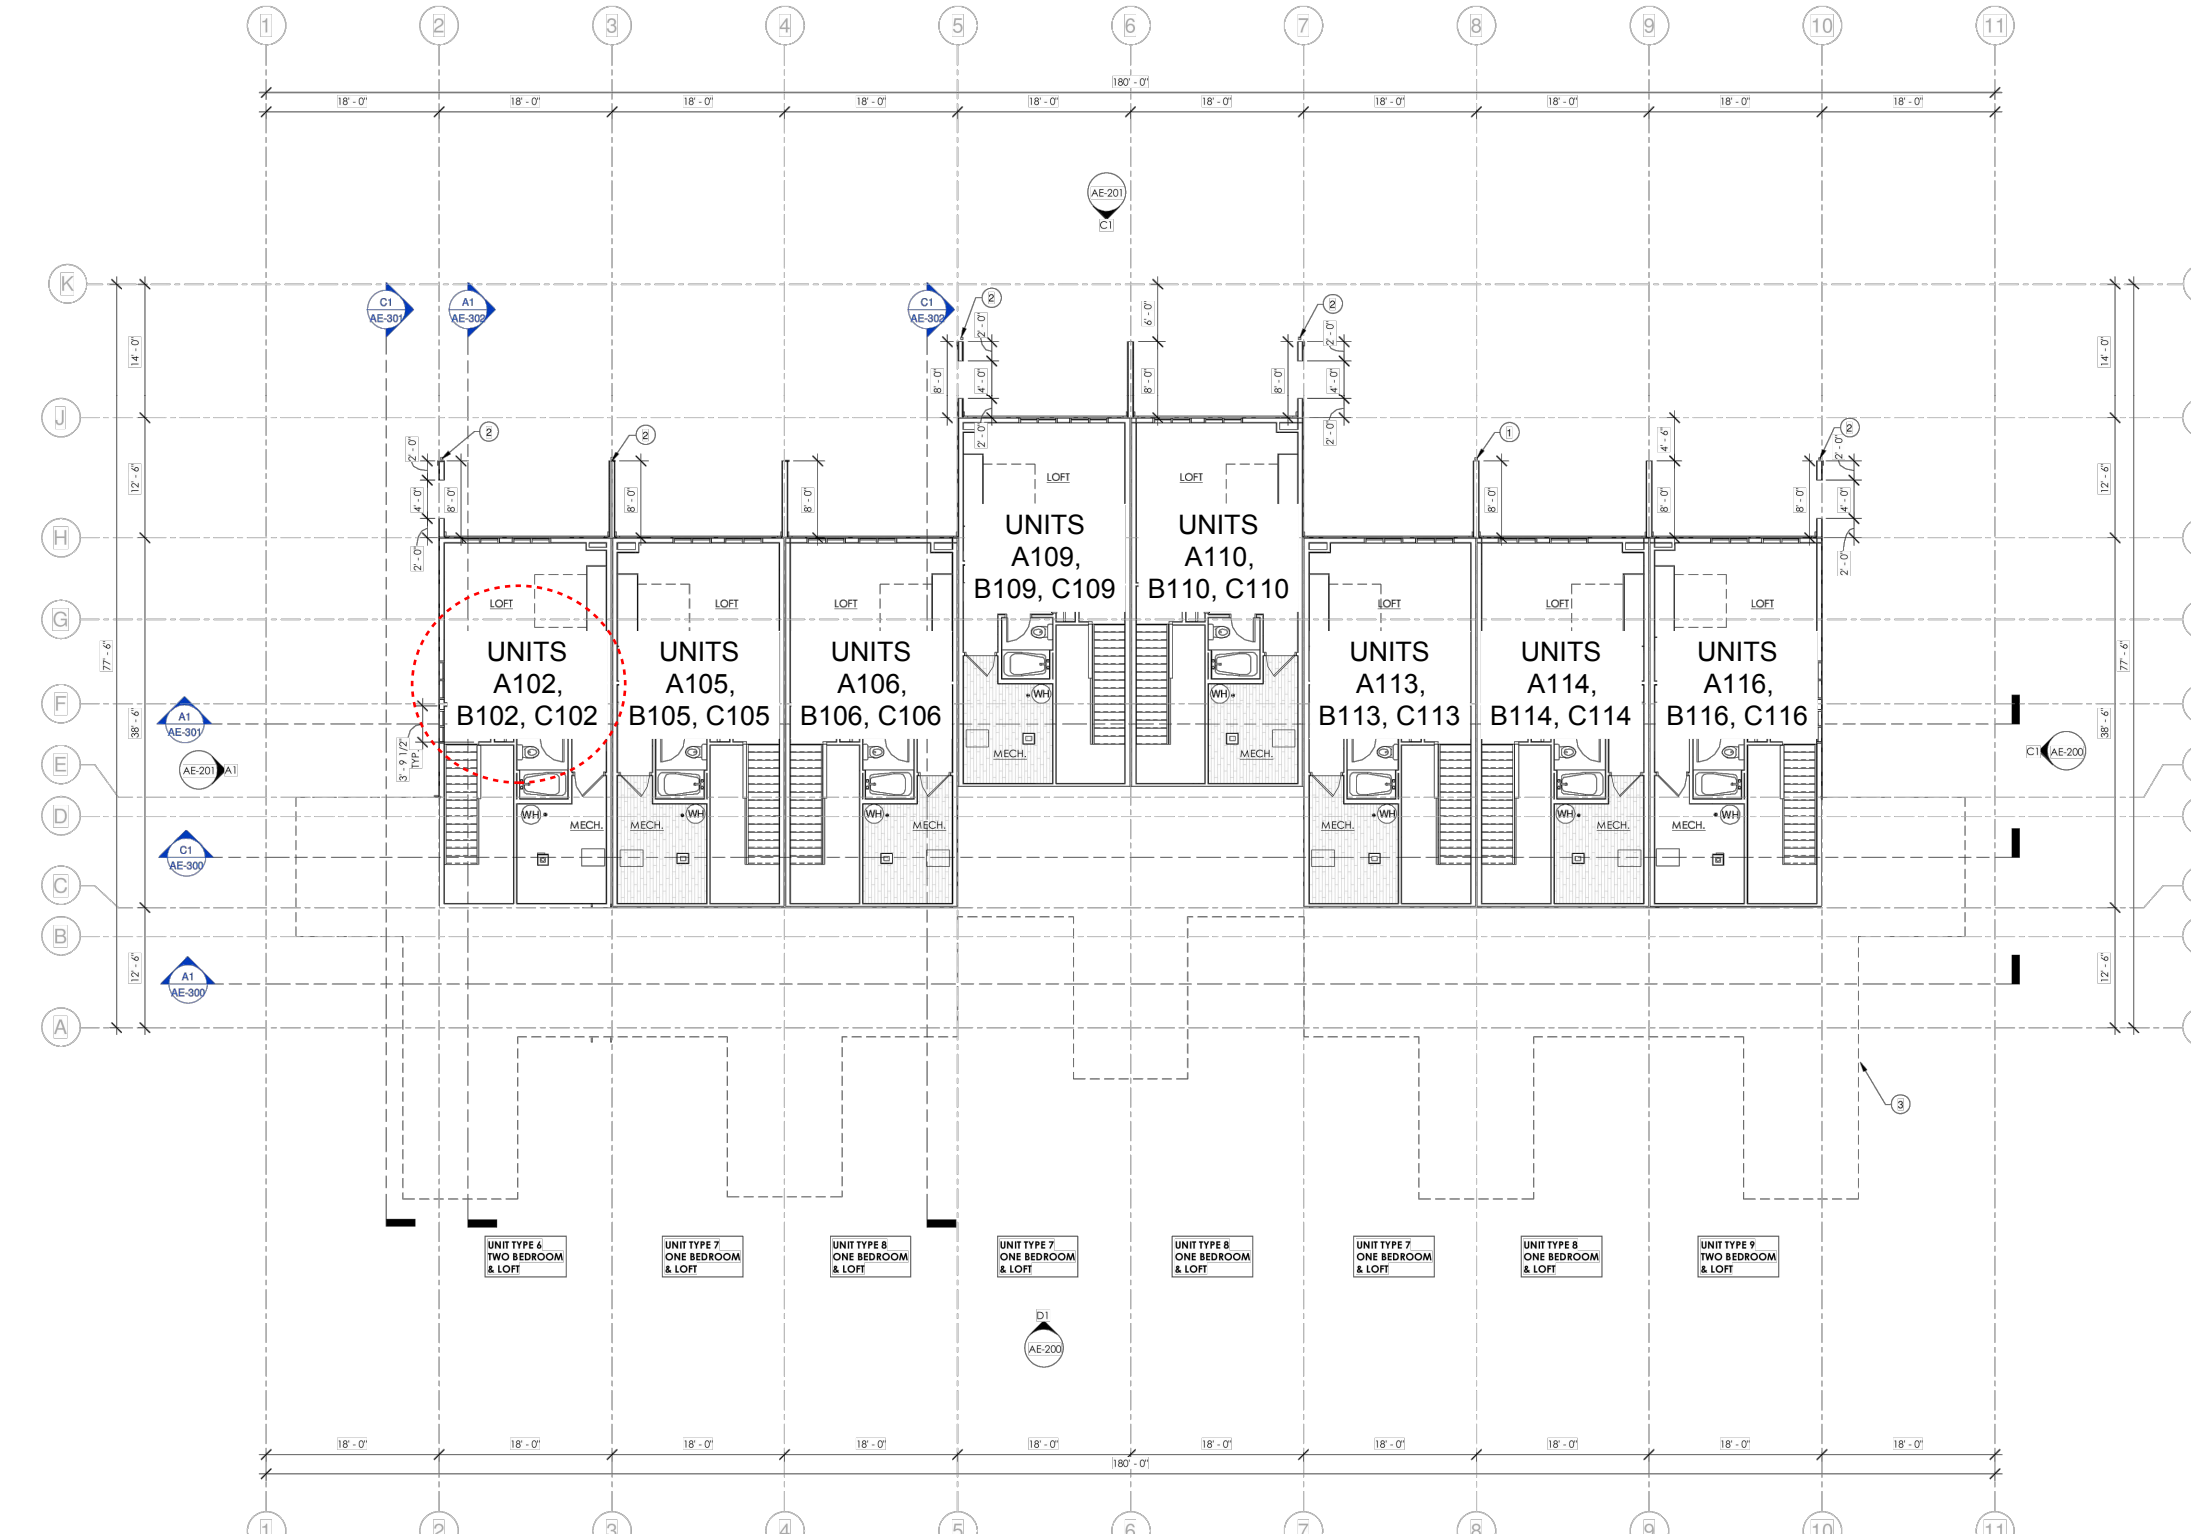

LOFT FLOOR PLAN

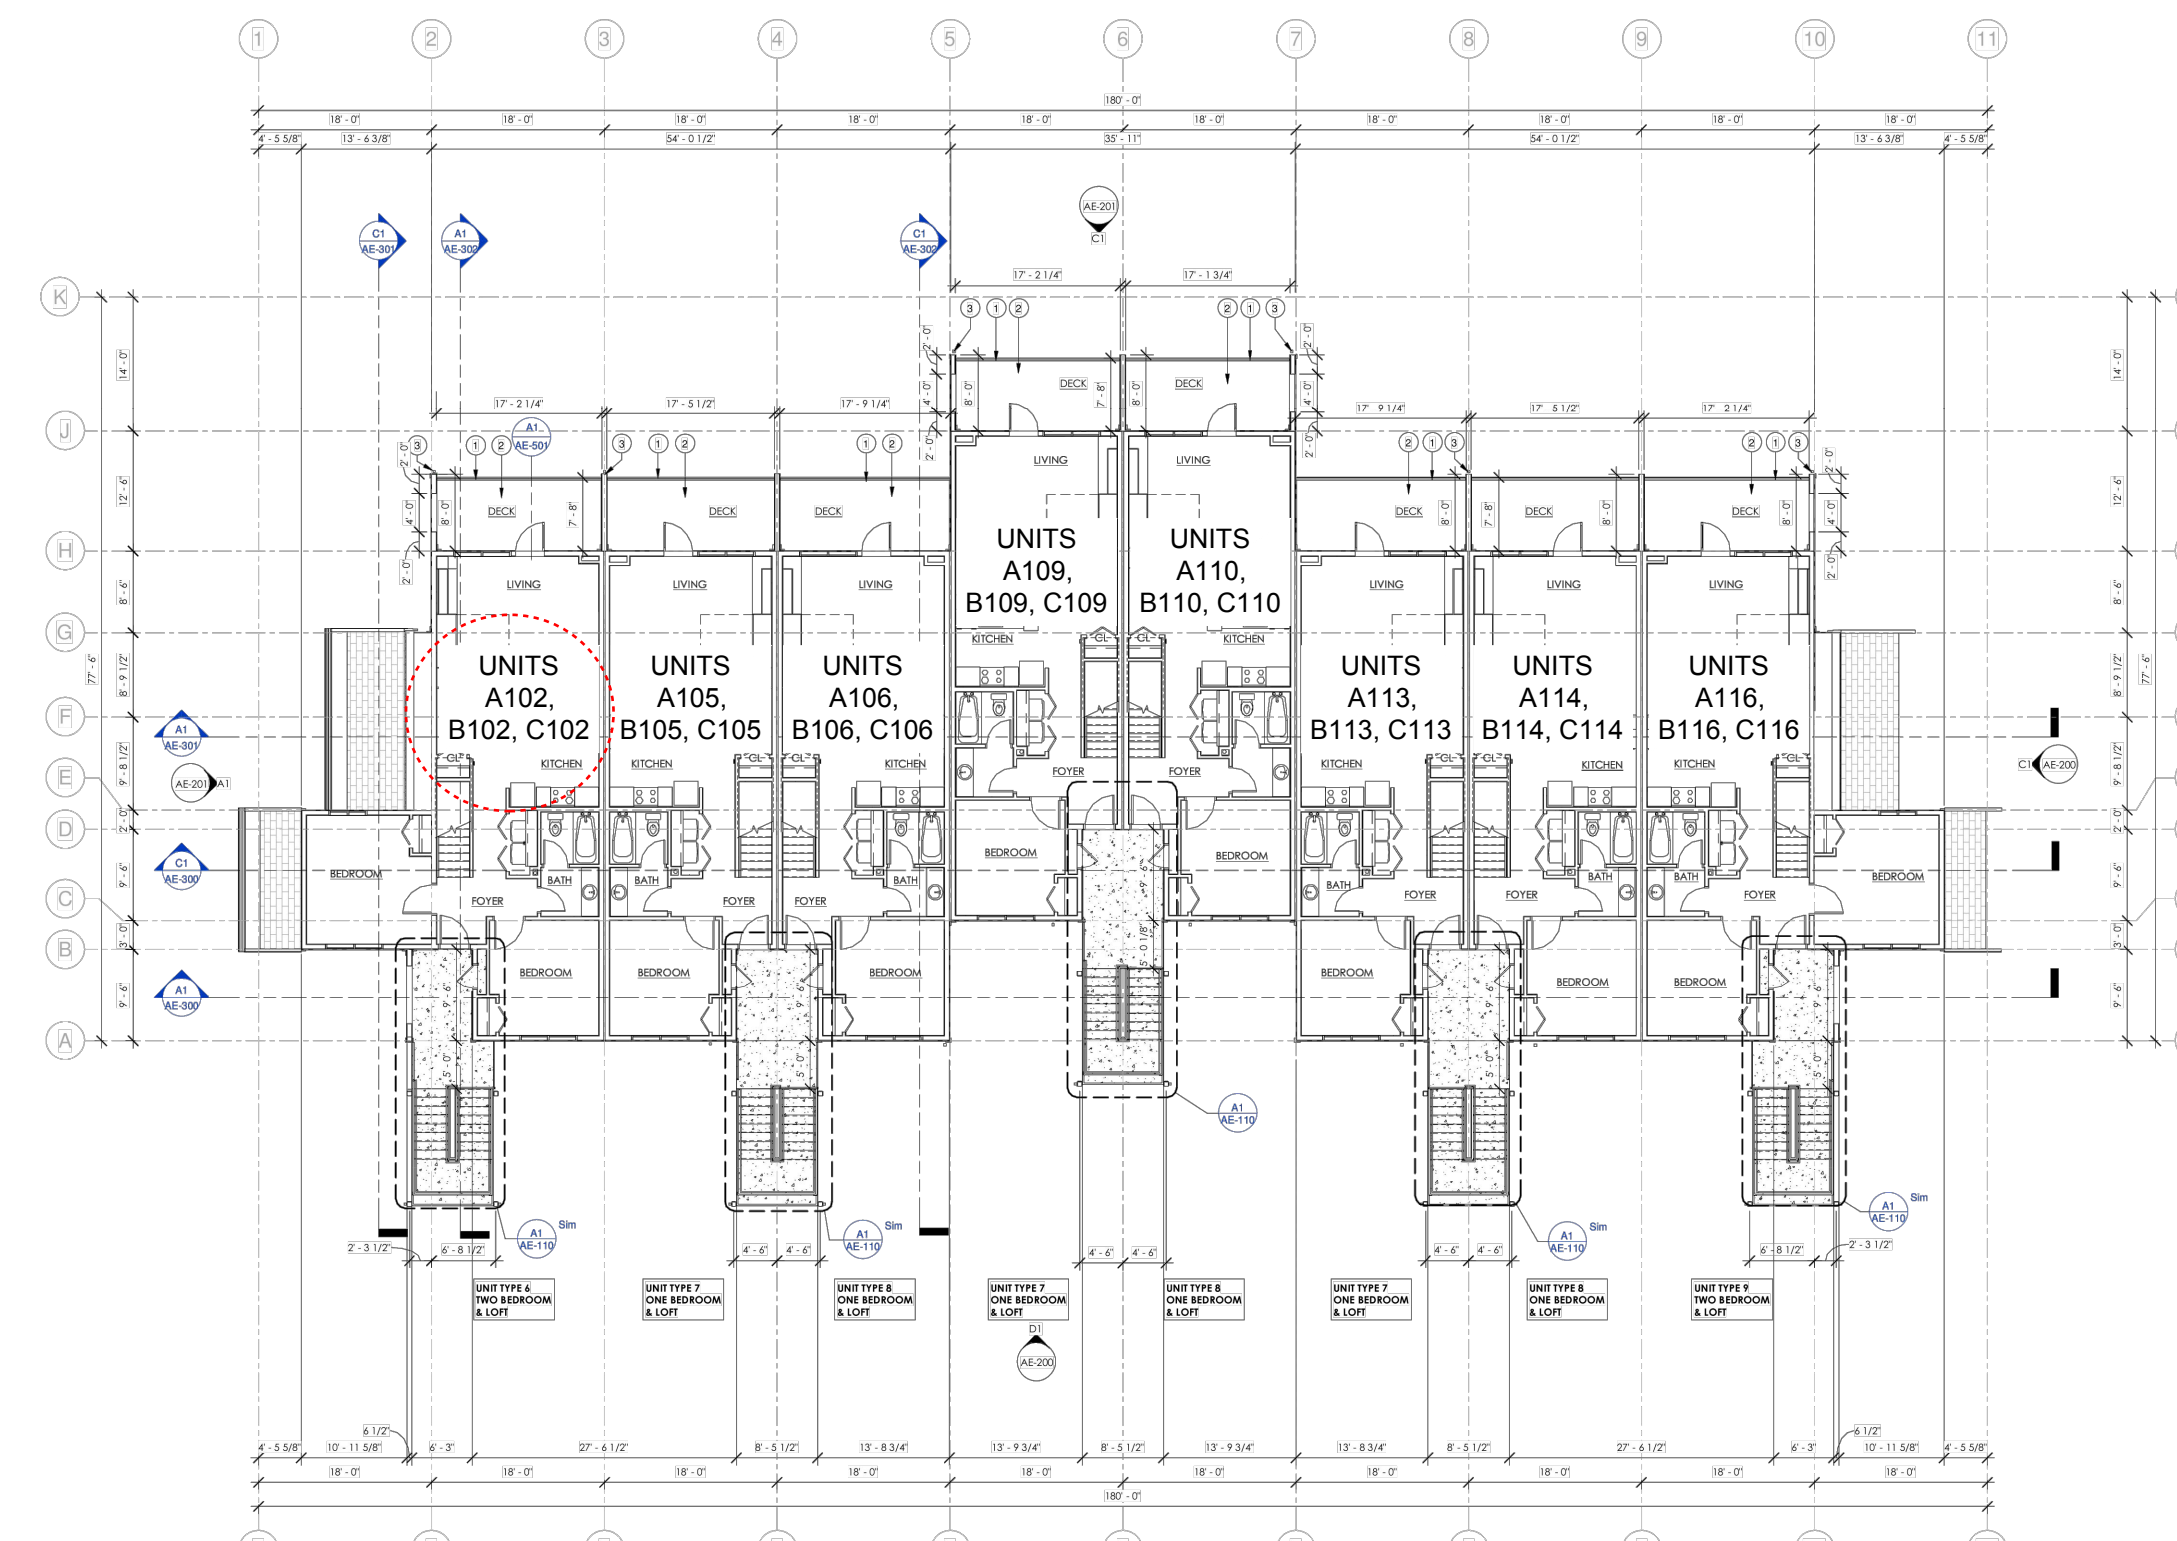

UPPER LEVEL FLOOR PLAN

R:\1201 - LEWIS HOMES\1802-THE POINTS\SURVEY\DWG\THE POINT - SUB PLAT.DWG

DEVELOPER:
 THE POINT AT WOLF CREEK, LLC
 JOHN L. LEWIS
 3718 NORTH WOLF CREEK DRIVE
 EDEN, UTAH 84310
 801-430-1507

S2
3

COUNTY RECORDER
 ENTRY NO. _____ FEE PAID _____
 FILED FOR AND RECORDED _____
 AT _____ IN BOOK _____ OF OFFICIAL
 RECORDS, PAGE _____ RECORDED
 FOR _____
 COUNTY RECORDER
 BY: _____

GARDNER ENGINEERING
 CIVIL • LAND PLANNING
 MUNICIPAL • LAND SURVEYING
 5150 SOUTH 375 EAST OGDEN, UT
 OFFICE: 801-476-0202 FAX: 801-476-0066


THE POINTE AT WOLF CREEK
 LOCATED IN THE SOUTHWEST QUARTER OF SECTION 22,
 TOWNSHIP 7 NORTH, RANGE 1 EAST, SALT LAKE BASE AND MERIDIAN,
 WEBER COUNTY, UTAH
 JUNE 2021




D1 FRONT ELEVATION
 1/8" = 1'-0"



C1 BACK ELEVATION
 1/8" = 1'-0"

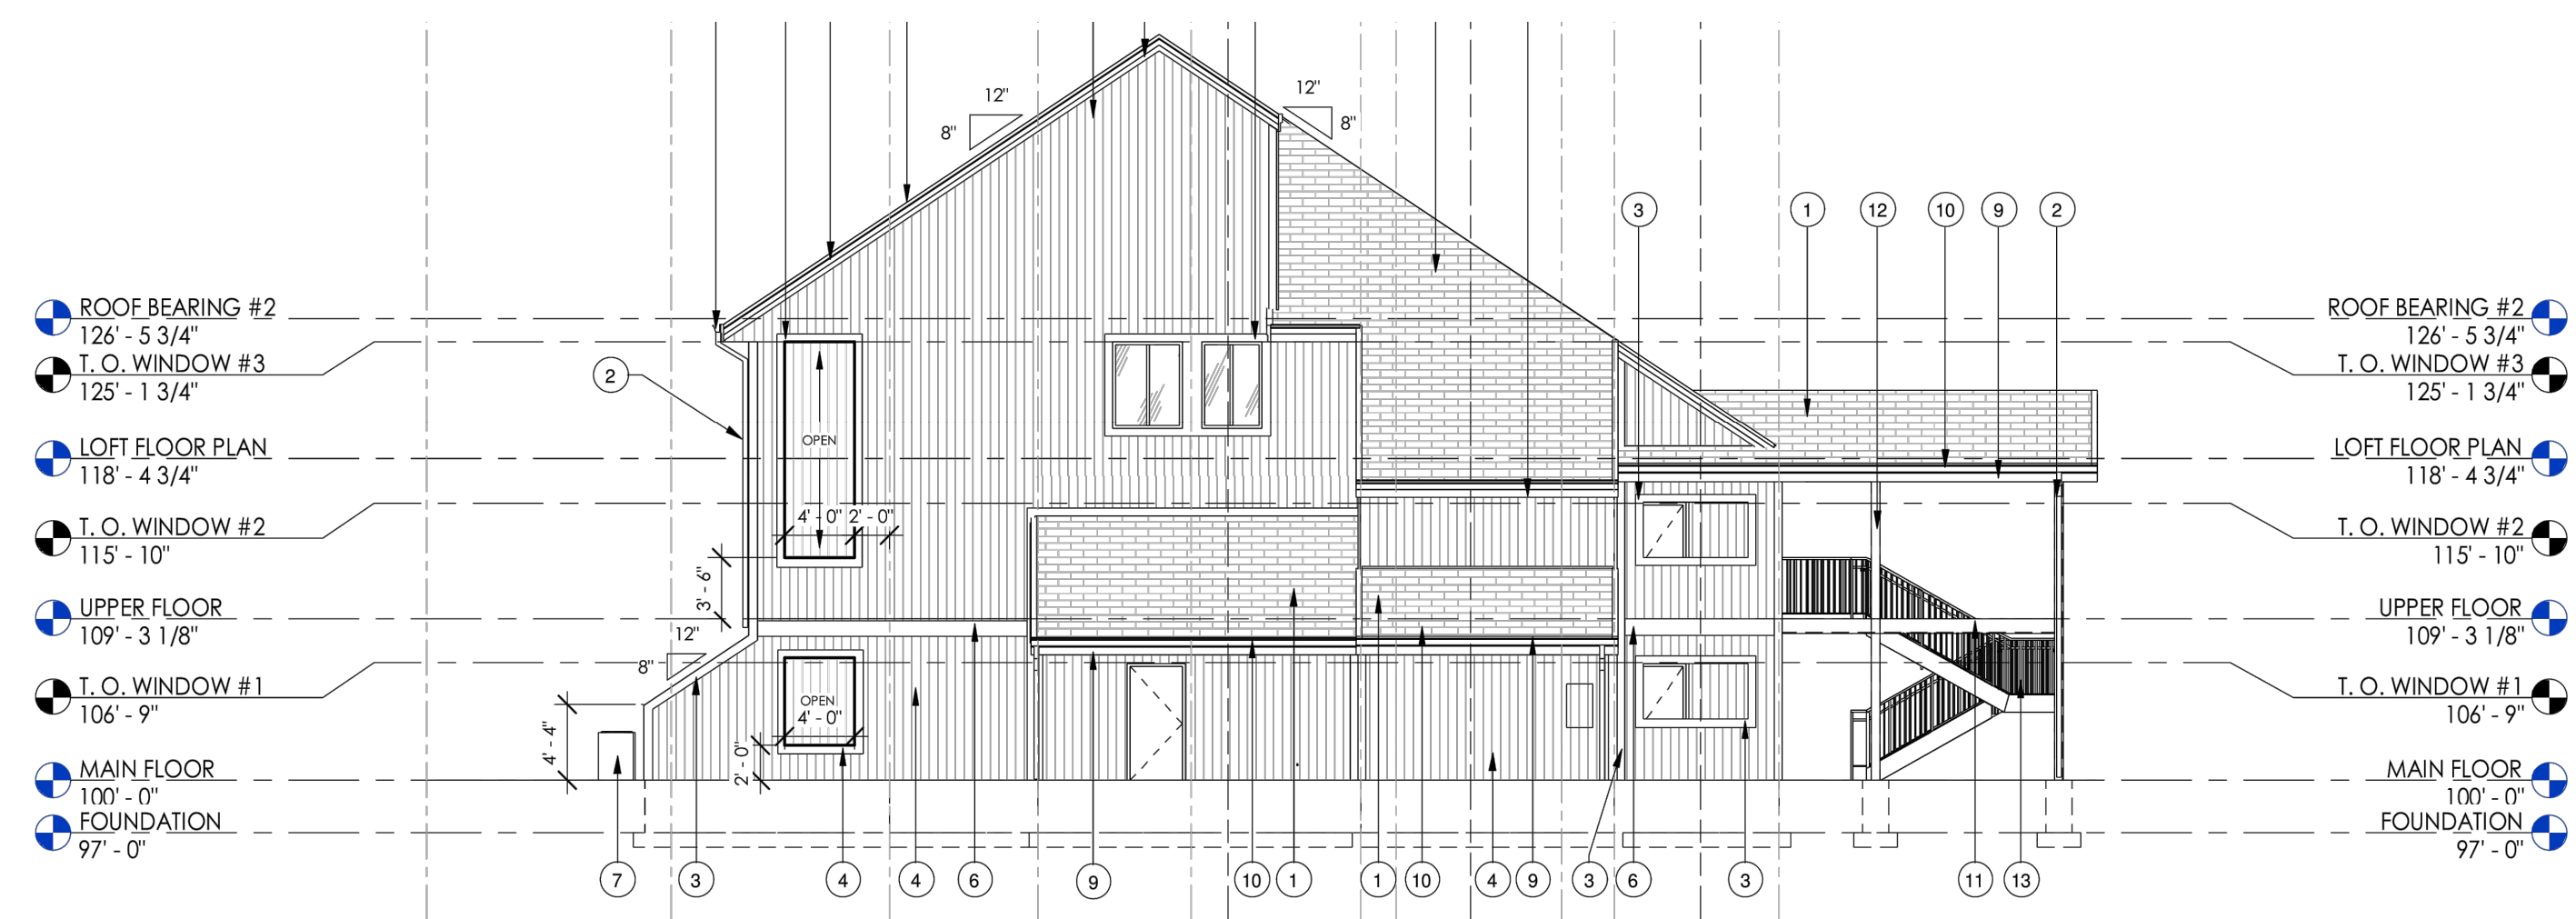

A1 LEFT ELEVATION
 1/8" = 1'-0"

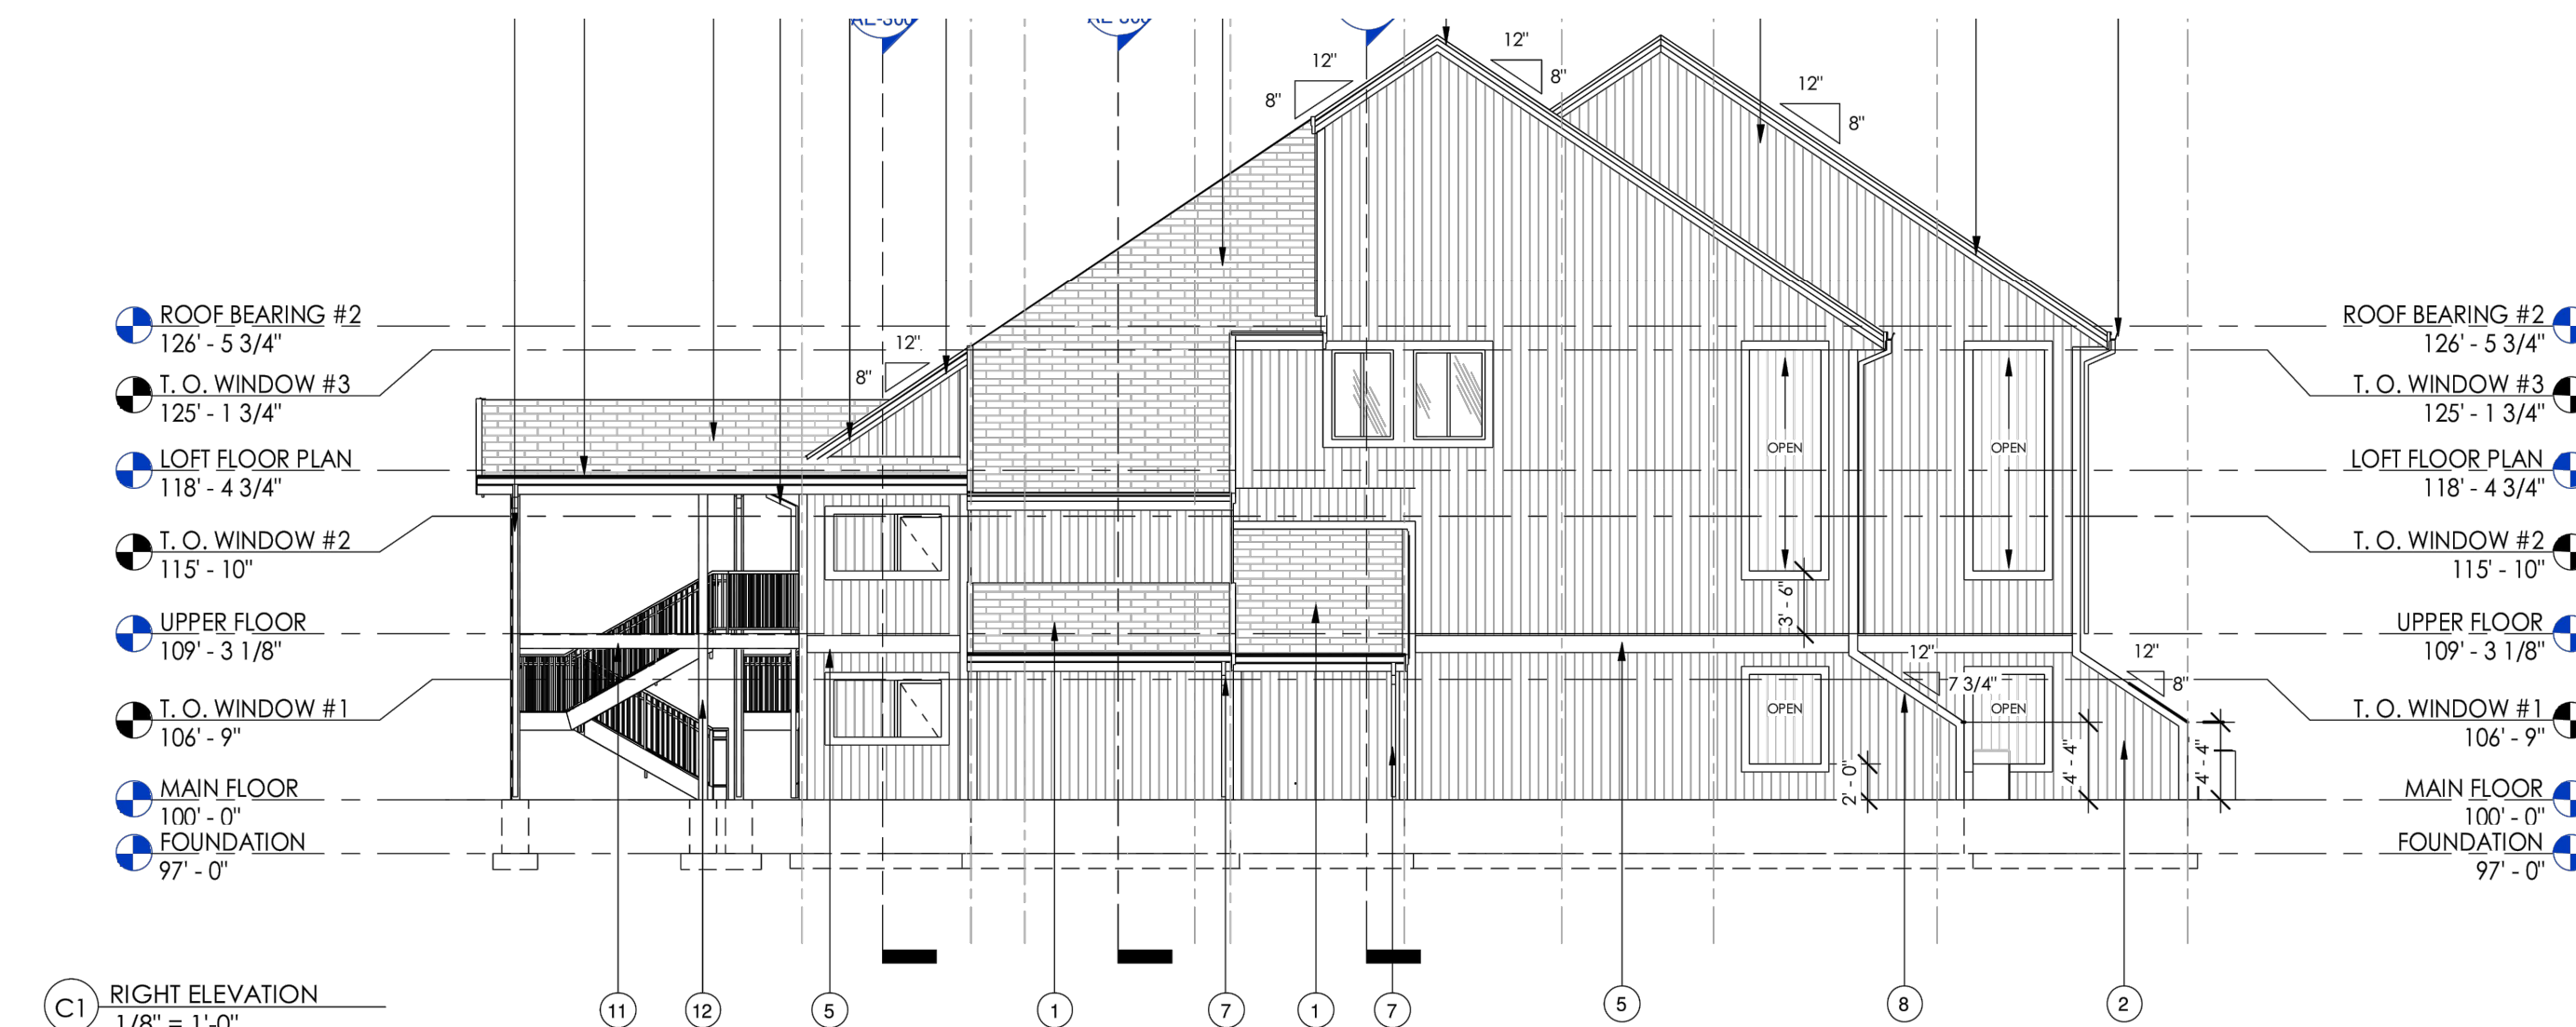

C1 RIGHT ELEVATION
 1/8" = 1'-0"

ELEVATIONS
 MAIN FLOOR BUILDING A = 5236.0'
 MAIN FLOOR BUILDING B = 5237.6'
 MAIN FLOOR BUILDING C = 5241.0'

DEVELOPER: THE POINT AT WOLF CREEK, LLC JOHN L. LEWIS 3718 NORTH WOLF CREEK DRIVE EDEN, UTAH 84310 801-430-1507	S3 <hr/> 3	COUNTY RECORDER
		ENTRY NO. _____ FEE PAID _____ FILED FOR AND RECORDED _____ AT _____ IN BOOK _____ OF OFFICIAL _____ RECORDS, PAGE _____ RECORDED _____ FOR _____ COUNTY RECORDER _____ BY: _____

R11201 - LEWIS HOMES1802, THE POINTE AT WOLF CREEK, SUB PLAT DAVIS