

MYERS SUBDIVISION

Preliminary Plat "Not To Be Recorded"

PART OF THE SOUTHEAST QUARTER OF SECTION 35, TOWNSHIP 7 NORTH, RANGE 1 EAST, SALT LAKE BASE AND MERIDIAN, U.S. SURVEY
WEBER COUNTY, UTAH
SEPTEMBER, 2021

Name too similar to "Myers Addition" Please add something to or change the name.

NAME CHANGED TO MYERS FAMILY SUBDIVISION



VICINITY MAP
NOT TO SCALE

RUTH G FULLER FAMILY LIMITED PARTNERSHIP LTD 220-051-0005


Update name and fix #

LINE TABLE

LINE	BEARING	DISTANCE
L1	S87°35'19"E	111.14
L2	S87°09'13"E	96.91
L3	S87°25'26"E	85.19
L4	S87°23'15"E	96.90
L5	N00°32'21"E	148.53
L6	N89°03'30"W	121.14
L7	S00°32'21"W	61.18
L8	S89°37'47"E	2.04
L9	S00°22'13"W	88.46

LEGEND

- SECTION CORNER
 - SET 5/8" REBAR AND PLASTIC CAP STAMPED "REEVE AND ASSOCIATES"
 - BOUNDARY LINE
 - MONUMENT TIE LINE
 - ADJOINING PROPERTY
 - EXISTING FENCE LINE
 - 10' PUBLIC UTILITY EASEMENT
 - ROAD CENTERLINE
 - EXISTING STRUCTURE
 - ROAD DEDICATION
- Scale: 1" = 60'

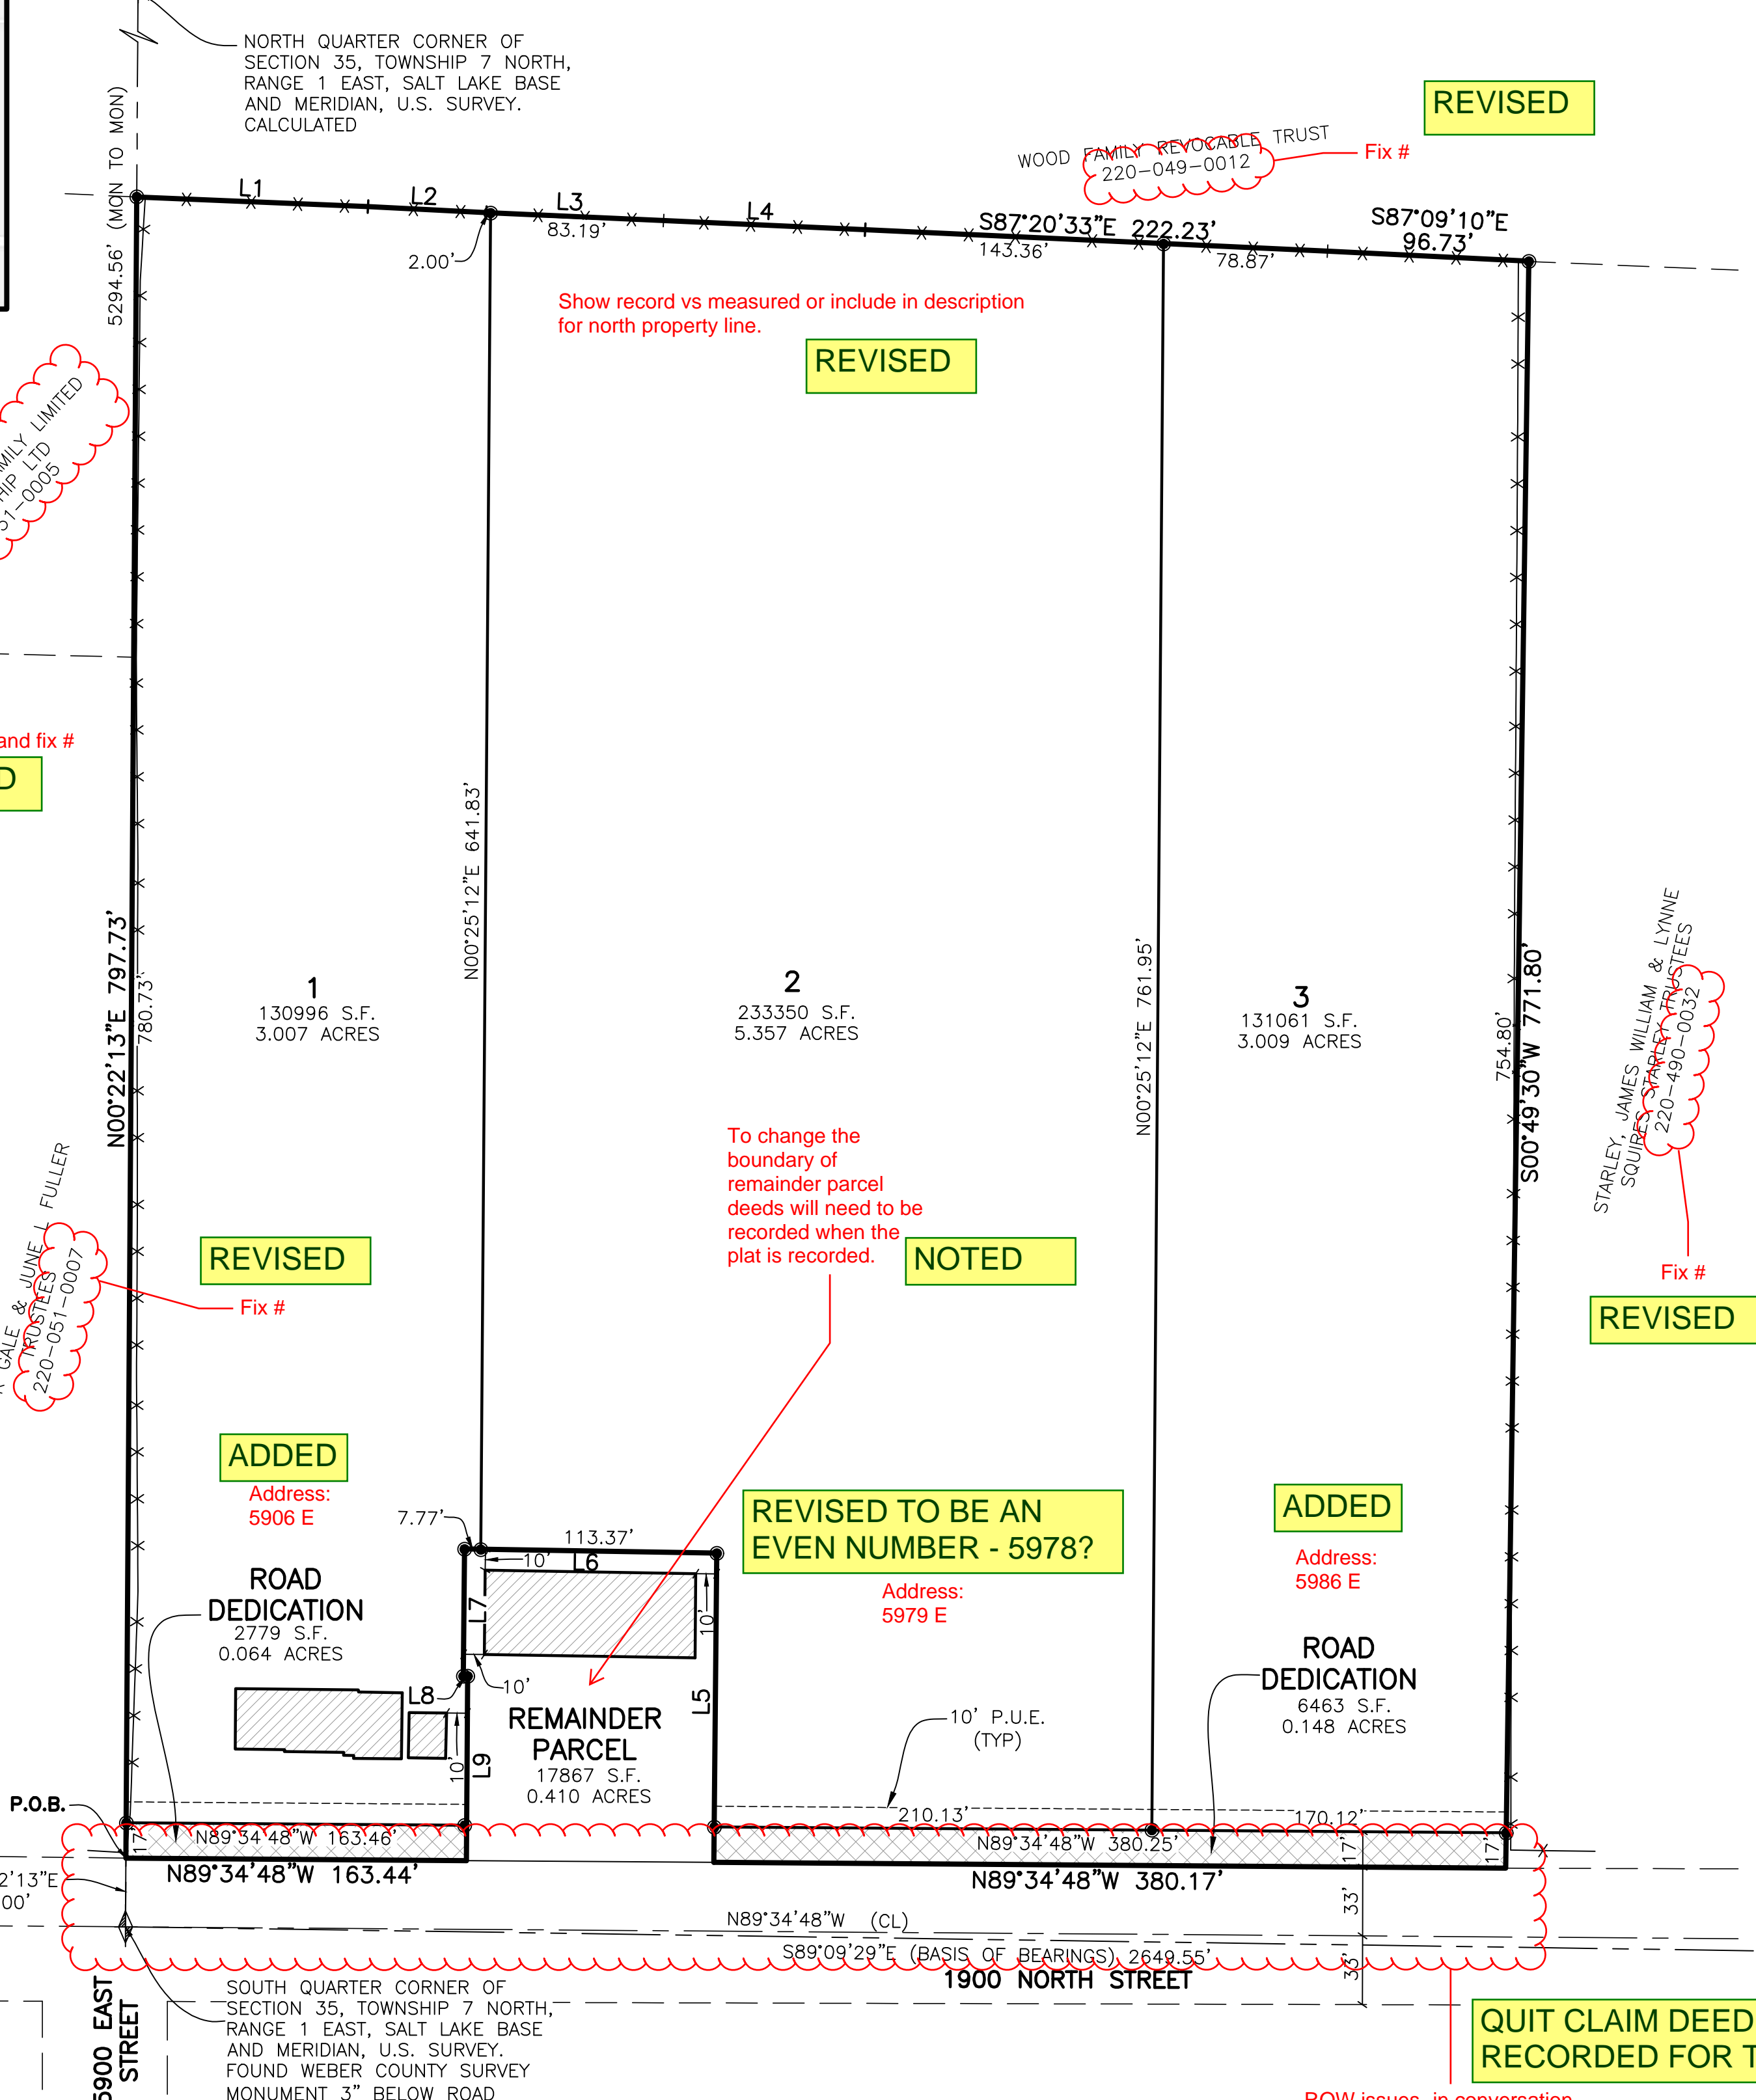

NOTES

- DUE TO THE TOPOGRAPHY AND THE LOCATION OF THIS SUBDIVISION, ALL OWNERS WILL ACCEPT RESPONSIBILITY FOR ANY STORM WATER RUNOFF FROM THE ROAD ADJACENT TO THIS PROPERTY UNTIL CURB AND GUTTER IS INSTALLED
- AGRICULTURE IS THE PREFERRED USE IN THE AGRICULTURAL ZONES. AGRICULTURAL OPERATIONS AS SPECIFIED IN THE LAND USE CODE FOR A PARTICULAR ZONE ARE PERMITTED AT ANY TIME INCLUDING THE OPERATION OF FARM MACHINERY AND NO ALLOWED AGRICULTURAL USE SHALL BE SUBJECT TO RESTRICTION ON THE BASIS THAT IT INTERFERES WITH ACTIVITIES OF FUTURE RESIDENTS OF THIS SUBDIVISION.

BASIS OF BEARINGS

THE BASIS OF BEARING FOR THIS PLAT IS THE SECTION LINE BETWEEN THE SOUTH QUARTER CORNER AND THE SOUTHEAST CORNER OF SECTION 35, TOWNSHIP 7 NORTH, RANGE 1 EAST, SALT LAKE BASE AND MERIDIAN, U.S. SURVEY, SHOWN HEREON AS: S89°09'29"E

NARRATIVE

THE PURPOSE OF THIS SURVEY IS TO ESTABLISH THE PROPERTY BOUNDARIES ON THE GROUND. THE BOUNDARY WAS DETERMINED AS FOLLOWS: THE WEST LINE WAS PLACED ALONG THE QUARTER SECTION LINE BETWEEN THE SOUTH AND NORTH QUARTER CORNERS OF SECTION 35, THE EAST LINE BY DEED, WHICH MATCHES A RECORD OF SURVEY PREPARED BY JOHN REEVE AND FILED AS SURVEY NO. 1408 IN THE OFFICE OF THE WEBER COUNTY SURVEYOR. SAID SURVEY APPEARS TO HAVE BEEN USED TO PREPARE THE DEED FOR PARCEL 22-049-0032. ON THE NORTH BY A LONGSTANDING FENCE LINE, AND ON THE SOUTH THE RIGHT OF WAY WAS DETERMINED USING A LINE BETWEEN THE SOUTH QUARTER CORNER OF SECTION 35 AND THE SOUTHEAST CORNER OF SECTION 36 AS PER CONVERSATIONS WITH THE COUNTY SURVEYOR'S OFFICE. ALL BOUNDARY AND LOT CORNERS TO BE SET WITH A 5/8" X 24" REBAR AND RED PLASTIC CAP STAMPED "REEVE & ASSOCIATES".

LEGAL DESCRIPTION

PART OF THE SOUTHEAST QUARTER OF SECTION 35, TOWNSHIP 7 NORTH, RANGE 1 EAST, SALT LAKE BASE AND MERIDIAN, U.S. SURVEY, DESCRIBED AS FOLLOWS:

BEGINNING AT A POINT ON THE NORTHERLY RIGHT OF WAY LINE OF 1900 NORTH STREET, SAID POINT BEING N00°22'13"E ALONG A SECTION LINE 33.00 FEET FROM THE SOUTH QUARTER CORNER OF SAID SECTION 35; THENCE N00°22'13"E ALONG THE SECTION LINE BETWEEN THE SOUTH AND NORTH QUARTER CORNER OF SAID SECTION 35 797.73 FEET TO A POINT IN AN EXISTING FENCE LINE; THENCE MORE OR LESS ALONG SAID FENCE THE FOLLOWING SIX (6) COURSES; (1) S87°35'19"E 111.14 FEET; (2) S87°09'13"E 96.91 FEET; (3) S87°25'26"E 85.19 FEET; (4) S87°23'15"E 96.90 FEET; (5) S87°20'33"E 222.23 FEET; (6) S87°09'10"E 96.73 FEET TO THE WEST LINE OF A JOHN REEVE RECORD OF SURVEY FILED AS NO. 1408; THENCE S00°49'30"W ALONG SAID SURVEY LINE 771.80 FEET TO THE NORTH RIGHT OF WAY LINE OF 1900 NORTH STREET; THENCE N89°34'48"W ALONG SAID RIGHT OF WAY LINE 380.17; THENCE N00°32'21"E 148.53 FEET; THENCE N89°03'30"W 121.14 FEET; THENCE S00°32'21"W 61.18 FEET; THENCE N89°37'47"E 2.04 FEET; THENCE S00°22'13"W 88.47 FEET TO THE NORTHERLY RIGHT OF WAY LINE OF 1900 NORTH STREET; THENCE N89°34'48"W ALONG SAID NORTHERLY LINE 163.4 FEET TO THE POINT OF BEGINNING.


CONTAINING 504,649 SQUARE FEET OR 11.585 ACRES MORE OR LESS.

SURVEYOR'S CERTIFICATE

I, TREVOR J. HATCH, DO HEREBY CERTIFY THAT I AM A PROFESSIONAL LAND SURVEYOR IN THE STATE OF UTAH IN ACCORDANCE WITH TITLE 58, CHAPTER 22, PROFESSIONAL ENGINEERS AND LAND SURVEYORS ACT; AND THAT I HAVE COMPLETED A SURVEY OF THE PROPERTY DESCRIBED ON THIS PLAT IN ACCORDANCE WITH SECTION 17-23-17 AND HAVE VERIFIED ALL MEASUREMENTS, AND HAVE PLACED MONUMENTS AS REPRESENTED ON THIS PLAT, AND THAT THIS PLAT OF MYERS SUBDIVISION IN WEBER COUNTY, UTAH, HAS BEEN DRAWN CORRECTLY TO THE DESIGNATED SCALE AND IS A TRUE AND CORRECT REPRESENTATION OF THE HEREIN DESCRIBED LANDS INCLUDED IN SAID SUBDIVISION, BASED UPON DATA COMPILED FROM RECORDS IN THE WEBER COUNTY RECORDER'S OFFICE AND FROM SAID SURVEY MADE BY ME ON THE GROUND. I FURTHER CERTIFY THAT THE REQUIREMENTS OF ALL APPLICABLE STATUTES AND ORDINANCES OF WEBER COUNTY CONCERNING ZONING REQUIREMENTS REGARDING LOT MEASUREMENTS HAVE BEEN COMPLIED WITH.

SIGNED THIS _____ DAY OF _____, 20____.

9031945
UTAH LICENSE NUMBER

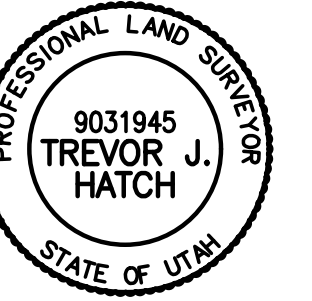

OWNERS DEDICATION AND CERTIFICATION

WE THE UNDERSIGNED OWNERS OF THE HEREIN DESCRIBED TRACT OF LAND, DO HEREBY SET APART AND SUBDIVIDE THE SAME INTO LOTS AS SHOWN ON THE PLAT AND NAME SAID TRACT MYERS SUBDIVISION, AND DO HEREBY GRANT AND DEDICATE TO WEBER COUNTY A PERPETUAL RIGHT AND EASEMENT OVER, UPON AND UNDER THE LANDS DESIGNATED HEREON AS PUBLIC UTILITY EASEMENTS, THE SAME TO BE USED FOR THE INSTALLATION MAINTENANCE AND OPERATION OF PUBLIC UTILITY SERVICE LINE, STORM DRAINAGE FACILITIES, IRRIGATION CANALS OR FOR THE PERPETUAL PRESERVATION OF WATER CHANNELS IN THEIR NATURAL STATE WHICHEVER IS APPLICABLE AS MAY BE AUTHORIZED BY THE GOVERNING AUTHORITY, WITH NO BUILDINGS OR STRUCTURES BEING ERRECTED WITHIN SUCH EASEMENTS.

SIGNED THIS _____ DAY OF _____, 20____.

Ownership Name in Owner's Dedication and Acknowledgement need match the current deed and latest County Ownership record.

ADDED

ACKNOWLEDGMENT

STATE OF UTAH)ss.
COUNTY OF _____)

ON THE _____ DAY OF _____, 20____, PERSONALLY APPEARED BEFORE ME, THE UNDERSIGNED NOTARY PUBLIC, _____ (AND) _____ SIGNER(S) OF THE ABOVE OWNER'S DEDICATION AND CERTIFICATION, WHO BEING BY ME DULY SWORN, DID ACKNOWLEDGE TO ME _____ SIGNED IT FREELY, VOLUNTARILY, AND FOR THE PURPOSES THEREIN MENTIONED.

COMMISSION EXPIRES _____ NOTARY PUBLIC

ACKNOWLEDGMENT

STATE OF UTAH)ss.
COUNTY OF _____)

ON THE _____ DAY OF _____, 20____, PERSONALLY APPEARED BEFORE ME, THE UNDERSIGNED NOTARY PUBLIC, _____ (AND) _____ BEING BY ME DULY SWORN, ACKNOWLEDGED TO ME THEY ARE _____ AND _____ OF SAID CORPORATION AND THAT THEY SIGNED THE ABOVE OWNER'S DEDICATION AND CERTIFICATION FREELY, VOLUNTARILY, AND IN BEHALF OF SAID CORPORATION FOR THE PURPOSES THEREIN MENTIONED.

COMMISSION EXPIRES _____ NOTARY PUBLIC

Project Info.

Surveyor: T. HATCH
Designer: E. ROCHE
Begin Date: 5-4-2020
Name: MYERS SUB
Number: 7347-01
Revision: 1"
Scale: 1"=60'
Checked: _____



WEBER COUNTY PLANNING COMMISSION APPROVAL

THIS IS TO CERTIFY THAT THIS SUBDIVISION PLAT WAS DULY APPROVED BY THE WEBER COUNTY PLANNING COMMISSION. SIGNED THIS _____ DAY OF _____, 20____.

CHAIRMAN, WEBER COUNTY PLANNING COMMISSION

WEBER COUNTY ENGINEER

I HEREBY CERTIFY THAT THE REQUIRED PUBLIC IMPROVEMENT STANDARDS AND DRAWINGS FOR THIS SUBDIVISION CONFORM WITH THE COUNTY STANDARDS AND THE AMOUNT OF THE FINANCIAL GUARANTEE IS SUFFICIENT FOR THE INSTALLATION OF THESE IMPROVEMENTS.

WEBER COUNTY ENGINEER

WEBER COUNTY COMMISSION ACCEPTANCE

THIS IS TO CERTIFY THAT THIS SUBDIVISION PLAT, THE DEDICATION OF STREETS AND OTHER PUBLIC WAYS AND FINANCIAL GUARANTEE OF PUBLIC IMPROVEMENTS ASSOCIATED WITH THIS SUBDIVISION, THEREON ARE HEREBY APPROVED AND ACCEPTED BY THE COMMISSIONERS OF WEBER COUNTY, UTAH. SIGNED THIS _____ DAY OF _____, 20____.

CHAIRMAN, WEBER COUNTY COMMISSION

ATTEST TITLE

WEBER COUNTY SURVEYOR

I HEREBY CERTIFY THAT THE WEBER COUNTY SURVEYOR'S OFFICE HAS REVIEWED THIS PLAT AND ALL CONDITIONS FOR APPROVAL BY THIS OFFICE HAVE BEEN SATISFIED. THE APPROVAL OF THIS PLAT BY THE WEBER COUNTY SURVEYOR DOES NOT RELIEVE THE LICENSED LAND SURVEYOR WHO EXECUTED THIS PLAT FROM THE RESPONSIBILITIES AND/OR LIABILITIES ASSOCIATED THEREWITH. SIGNED THIS _____ DAY OF _____, 20____.

WEBER COUNTY SURVEYOR

RECORD OF SURVEY # _____

WEBER COUNTY ATTORNEY

I HAVE EXAMINED THE FINANCIAL GUARANTEE AND OTHER DOCUMENTS ASSOCIATED WITH THIS SUBDIVISION PLAT, AND IN MY OPINION THEY CONFORM WITH THE COUNTY ORDINANCE APPLICABLE THERETO AND NOW IN FORCE AND AFFECT. SIGNED THIS _____ DAY OF _____, 20____.

WEBER COUNTY ATTORNEY

WEBER-MORGAN HEALTH DEPARTMENT

I HEREBY CERTIFY THAT THE SOILS, PERCOLATION RATES, AND SITE CONDITIONS FOR THIS SUBDIVISION HAVE BEEN INVESTIGATED BY THIS OFFICE AND ARE APPROVED FOR ON-SITE WASTEWATER DISPOSAL SYSTEMS. SIGNED THIS _____ DAY OF _____, 20____.

DIRECTOR, WEBER-MORGAN HEALTH DEPARTMENT

Weber County Recorder

Entry No. _____ Fee Paid _____
And Recorded, _____
At _____ in Book _____
Of The Official Records, Page _____
Recorded For: _____

Weber County Recorder

Deputy.