
## **BRIDGER BUTLER SUBDIVISION**

Reeve & Associates, Inc. - Solutions You Can Build

PART OF THE NORTHWEST QUARTER OF SECTION 32, TOWNSHIP 6 NORTH, RANGE 2 WEST, SALT LAKE BASE & MERIDIAN, U.S. SURVEY WEBER COUNTY, UTAH JUNE, 2020

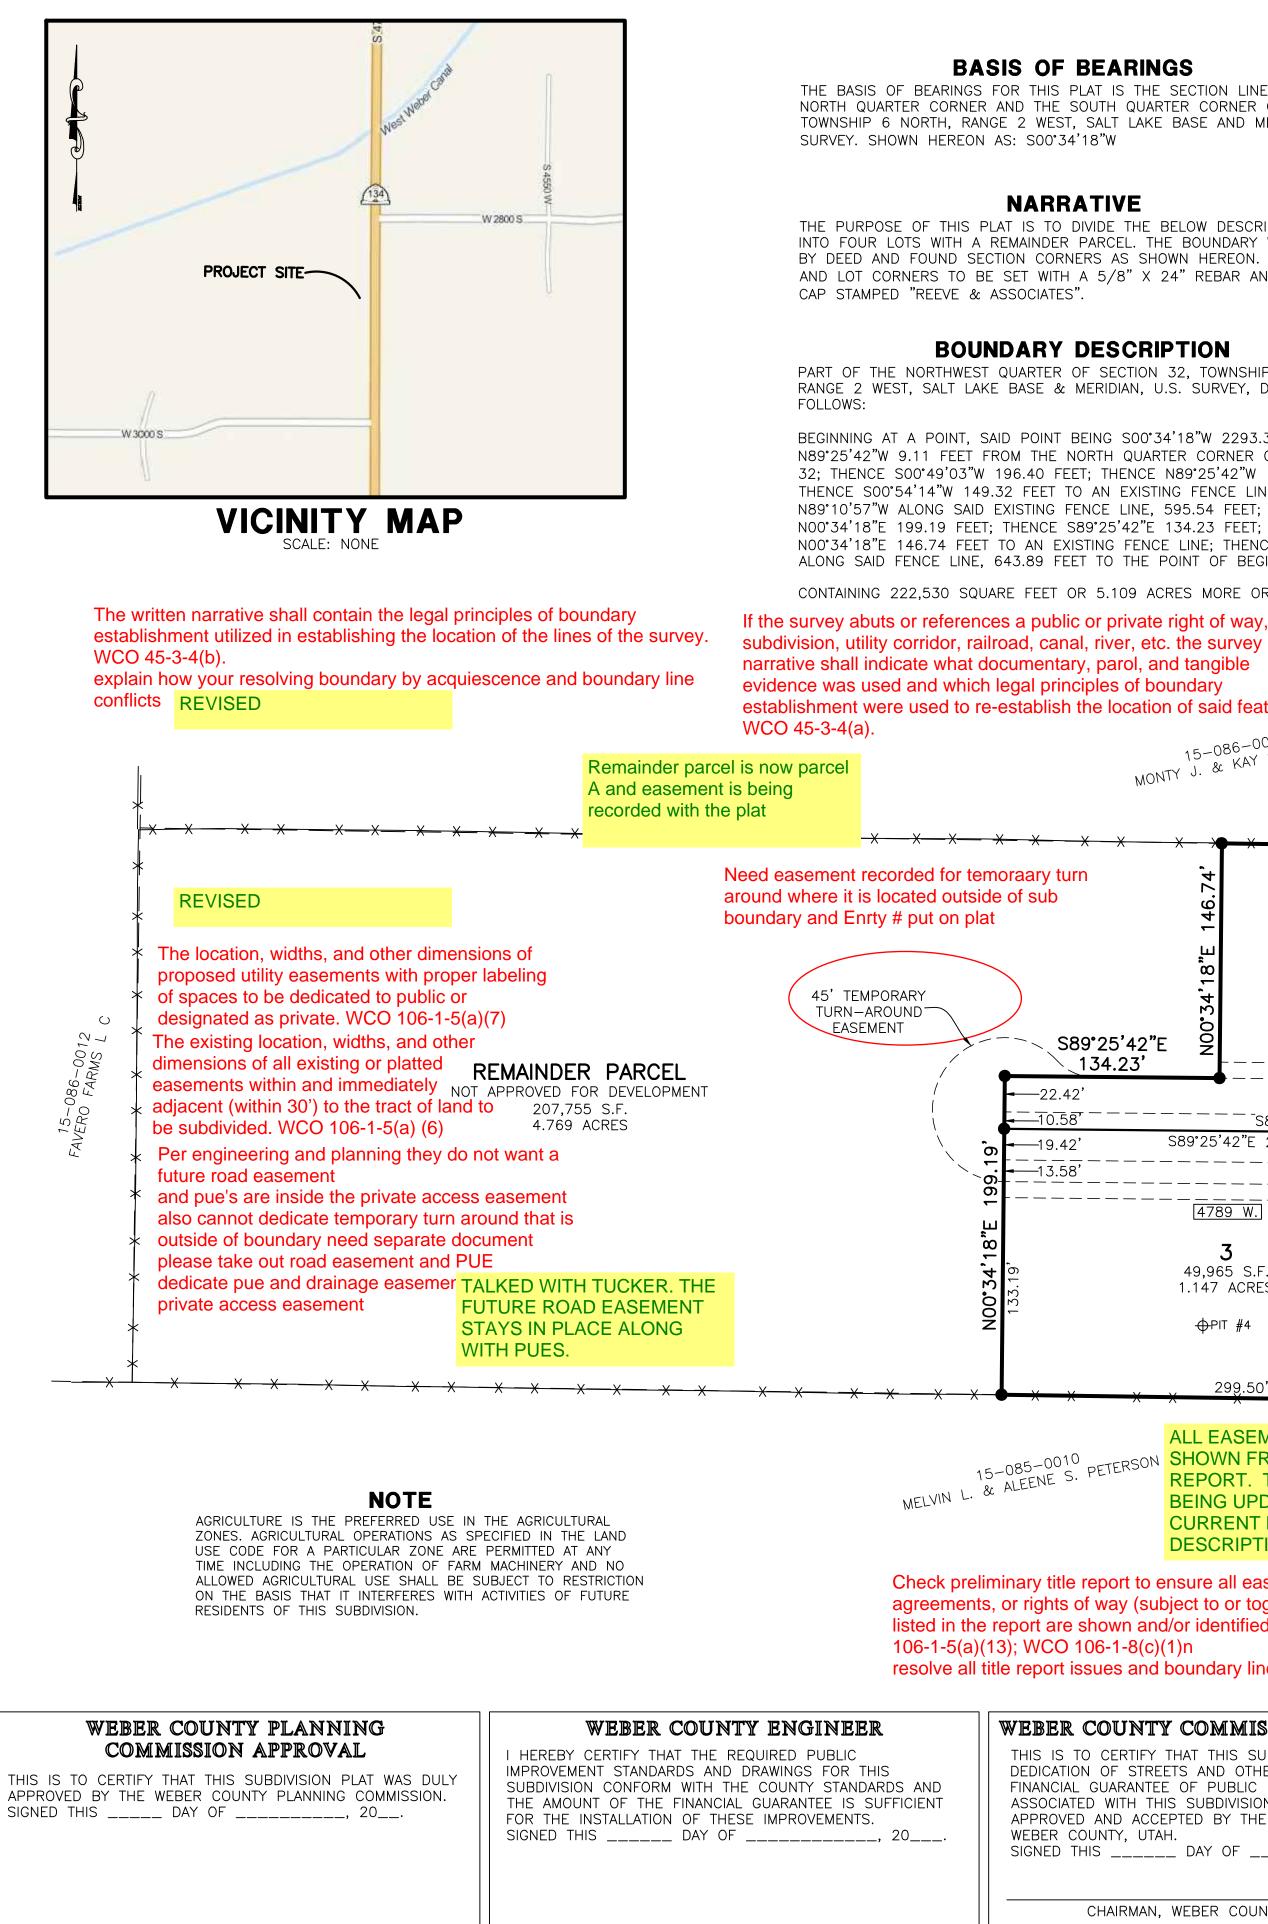

CHAIRMAN, WEBER COUNTY PLANNING COMMISSION

WEBER COUNTY ENGINEER

LEGEND **BASIS OF BEARINGS** <u>29</u> 32 THE BASIS OF BEARINGS FOR THIS PLAT IS THE SECTION LINE BETWEEN THE = SECTION CORNER NORTH QUARTER CORNER AND THE SOUTH QUARTER CORNER OF SECTION 32, R2W TOWNSHIP 6 NORTH, RANGE 2 WEST, SALT LAKE BASE AND MERIDIAN, U.S. 1963 = SET 5/8" REBAR AND PLASTIC CAP STAMPED MONUMENT M "REEVE & ASSOCIATES" DETAIL 1  $\oplus$  PIT # = EXPLORATION PIT LOCATION (NOT TO SCALE) NARRATIVE = BOUNDARY LINE THE PURPOSE OF THIS PLAT IS TO DIVIDE THE BELOW DESCRIBED PROPERTY INTO FOUR LOTS WITH A REMAINDER PARCEL. THE BOUNDARY WAS ESTABLISHED ---- = LOT LINEBY DEED AND FOUND SECTION CORNERS AS SHOWN HEREON. ALL BOUNDARY - X - X - X = EXISTING FENCELINE TA AND LOT CORNERS TO BE SET WITH A 5/8" X 24" REBAR AND RED PLASTIC ---- = Section the line ----- = ADJOINING PROPERTY LINE----= EASEMENT LINE S89°25'42"E **BOUNDARY DESCRIPTION** PART OF THE NORTHWEST QUARTER OF SECTION 32, TOWNSHIP 6 NORTH, \_4 S89°25'42" = EXISTING STRUCTURE RANGE 2 WEST, SALT LAKE BASE & MERIDIAN, U.S. SURVEY, DESCRIBED AS EXISTING STRUCTURE BEGINNING AT A POINT, SAID POINT BEING SO0'34'18"W 2293.38 FEET AND DEVELOF N89°25'42"W 9.11 FEET FROM THE NORTH QUARTER CORNER OF SAID SECTION 32: THENCE S00°49'03"W 196.40 FEET: THENCE N89°25'42"W 180.87 FEET: JEFF BUTLER 60 120 180 THENCE S00°54'14"W 149.32 FEET TO AN EXISTING FENCE LINE; THENCE 2843 S. 4700 W. N89°10'57"W ALONG SAID EXISTING FENCE LINE, 595.54 FEET; THENCE TAYLOR, UT 84401 Scale: 1'' = 60'N00°34'18"E 199.19 FEET; THENCE S89°25'42"E 134.23 FEET; THENCE 801-710-9568 NO0°34'18"E 146.74 FEET TO AN EXISTING FENCE LINE; THENCE S89°10'57"E A legend shall be included which ALONG SAID FENCE LINE, 643.89 FEET TO THE POINT OF BEGINNING. clearly identifies the lines, CONTAINING 222,530 SQUARE FEET OR 5.109 ACRES MORE OR LESS. symbols, and other markings used to create the survey map, or plat. WCO 45-3-3(d) NORTH QUARTER CORNER OF SECTION 32, TOWNSHIP 6 NORTH, REVISED RANGE 2 WEST, SALT LAKE BASE AND MERIDIAN, U.S. SURVEY, establishment were used to re-establish the location of said features. FOUND 3" BRASS CAP MONUMENT IN CONCRETE 4" BELOW SURFACE 15-086-0002 MONTY J. & KAY S. HADLEY IN FAIR CONDITION DATED 1963. (SEE DETAIL 1) N89°25'42"W-S89°25'42"E (R) 9.11' S89'10'57"E 643.89' (M) P.O.B.~ 274.00' 323.99 45.89 ⊕ PIT #3 88.1 53,518 S.F. 57,629 S.F. 1.229 ACRES 1.323 ACRES . XXXXXX  $\sim$ 36.4' 10' <mark>\_10'P.U.E.</mark> [4770 W.] S89°25'42"E P.U.E. 4726 W. 134.23' \_\_\_\_\_ ΨO -22.42 22.42'— S89°25'42"E 299.50' —19.42' S89°25'42"E 432.72' \_L3\_ 135.82' 19.42' 45.05 L4 N89°25'42"W 180.87 \_\_\_\_ 4745 W. ACCESS AND ROAD EASEMENT 10' P.U.E. PUBLIC UTILITY ′<del>\_X\_\_X\_\_X\_\_</del>X\_\_ 3 EASEMENT 15' IRR. 15-086-000 49,965 S.F. EASEMENT UTAH POWER & 1.147 ACRES LIGHT COMPANY 52,483 S.F. 50' 1.205 ACRES ⊕PIT #4 ⊕ PIT #2 <del>\_ X \_ X \_ X \_\_</del> ⊕PIT #1 299.50**'** 296.03 N89°1`0'57‴W 595.54' MELVIN L. & ALEENE S. PETERSON REPORT TITLE All measured bearings, angles, and distances separately indicated from **REPORT. TITLE REPORT** those of record. UCA 17-23-17(3)(e)CURRENT PLAT BOUNDARY NOTED. TITLE REPORT BEING SOUTH QUARTER CORNER OF DESCRIPTION. UPDATED TO CURRENT PLAT SECTION 32, TOWNSHIP 6 NORTH. **BOUNDARY DESCRIPTION.** RANGE 2 WEST, SALT LAKE BASE Check preliminary title report to ensure all easements, boundary line AND MERIDIAN, U.S. SURVEY, agreements, or rights of way (subject to or together with) that are FOUND 3" BRASS CAP MONUMENT listed in the report are shown and/or identified on the plat. WCO IN CONCRETE 4" BELOW SURFACE IN GOOD CONDITION DATED 2004. 106-1-5(a)(13); WCO 106-1-8(c)(1)n (SEE DETAIL 2) resolve all title report issues and boundary line conflicts. WEBER COUNTY COMMISSION ACCEPTANCE WEBER COUNTY SURVEYOR WEBER COUNTY THIS IS TO CERTIFY THAT THIS SUBDIVISION PLAT. THE HAVE EXAMINED THE FINANCIAL ( HEREBY CERTIFY THAT THE WEBER COUNTY SURVEYOR'S DEDICATION OF STREETS AND OTHER PUBLIC WAYS AND DOCUMENTS ASSOCIATED WITH THIS OFFICE HAS REVIEWED THIS PLAT AND ALL CONDITIONS FOR FINANCIAL GUARANTEE OF PUBLIC IMPROVEMENTS IN MY OPINION THEY CONFORM WIT APPROVAL BY THIS OFFICE HAVE BEEN SATISFIED. THE ASSOCIATED WITH THIS SUBDIVISION, THEREON ARE HEREBY ORDINANCE APPLICABLE THERETO A APPROVAL OF THIS PLAT BY THE WEBER COUNTY SURVEYOR APPROVED AND ACCEPTED BY THE COMMISSIONERS OF DOES NOT RELIEVE THE LICENSED LAND SURVEYOR WHO AFFECT. WEBER COUNTY, UTAH. SIGNED THIS \_\_\_\_ DAY OF \_\_\_\_ EXECUTED THIS PLAT FROM THE RESPONSIBILITIES AND/OR SIGNED THIS \_\_\_\_\_ DAY OF \_\_\_\_\_, 20\_\_\_\_, LIABILITIES ASSOCIATED THEREWITH. SIGNED THIS \_\_\_\_\_ DAY OF \_\_\_\_\_, 20\_\_\_\_, CHAIRMAN, WEBER COUNTY COMMISSION WEBER COUNTY WEBER COUNTY SURVEYOR ATTEST

$R2W \frac{32}{5}$ T5N 2004 <b>ONUMENT</b> <b>ONUMENT</b> <b>ONUMENT</b> <b>ONUMENT</b> <b>ONUMENT</b> <b>ONUMENT</b> <b>ONUMENT</b> <b>ONUMENT</b> <b>ONUMENT</b> <b>ONUMENT</b> <b>ONUMENT</b>		I, TREVOR J. HATCH, DO HE SURVEYOR IN THE STATE OF PROFESSIONAL ENGINEERS A SURVEY OF THE PROPERTY 17–23–17 AND HAVE VERIF REPRESENTED ON THIS PLA WEBER COUNTY, UTAH, HAS TRUE AND CORRECT REPRES SUBDIVISION, BASED UPON RECORDER'S OFFICE AND FF CERTIFY THAT THE REQUIRED WEBER COUNTY CONCERNING BEEN COMPLIED WITH. SIGNED THIS D 9031945 UTAH LICENSE NUMBER	F UTAH IN ACCOR AND LAND SURVEY DESCRIBED ON T TIED ALL MEASURE T, AND THAT THIS BEEN DRAWN CO SENTATION OF TH DATA COMPILED F ROM SAID SURVEY MENTS OF ALL AF G ZONING REQUIF	HAT I AM A RE RDANCE WITH T YORS ACT; ANI THIS PLAT IN A EMENTS, AND S PLAT OF <b>BR</b> ORRECTLY TO TE HEREIN DES FROM RECORDS Y MADE BY ME PPLICABLE STA REMENTS REGA	EGISTERED PRO TITLE 58, CHA D THAT I HAVE ACCORDANCE M HAVE PLACED DGER BUTLER THE DESIGNAT SCRIBED LANDS S IN THE WEE ON THE GRO TUTES AND O	PTER 22, E COMPLETED A WITH SECTION MONUMENTS AS SUBDIVISION IN ED SCALE AND IS A S INCLUDED IN SAID ER COUNTY DUND, I FURTHER RDINANCES OF
DISTANCE         597.99'         732.22'         596.40'         596.32'	OWNERS OP THE HEREIN DESCRIBED TRACT OF LAND, DO HEREBY SET APART AND SUBDIVIDE THE SAME INTO LOTS AND STREETS AS SHOWN ON THE PLAT AND NMME SAND TRACT BRIDGER BUTLER SUBDISION, AND DO HEREBY DEDICATE A PERPETUAL RICHT AND EASEMENT OVER, UPON AND UNDER THE LANDS DESIGNATED HEREON AS PUBLIC UTILITY. THE SAME TO BE USED FOR THE INSTALLATION MAINTEANCE AND OPERATION OF PUBLIC UTILITY SERVICE LINE, STORM DRAINAGE FACILITES, IRRIGATION CANALS OR FOR THE DEBLYED DED USED DATE CHANNELS IN THEIR NATURAL STATE WHICHEVER IS APPLICABLE AS MAY BE AUTHORIZED BY THE GOVERNING AUTHORITY, WITH NO BULLIONSS OR STRUCTURES BEING GREDETED WITHIN SUCH EASEMENTS AND ALSO DO DEDICATE TO PUBLIC USE ALL THOSE PARTS OR PORTIONS OF SAD TRACT OF LAND DESIGNATED AS STREETS, THE SAME TO BE USED AS PUBLIC THOROUGHFARES AND ALSO DO DEDICATE TO PUBLIC USE ALL THOSE PARTS OR PORTIONS OF SAD TRACT OF LAND DESIGNATED AS STREETS, THE SAME TO BE USED AS PUBLIC THOROUGHFARES AND ALSO DO DECOMPART TURN RACINDE VERY AND NULLIFIED THE EXPENSION OF THE ROAD WITHOUT FURTHER WRITTEN DOCUMENT AND THE ELEMPORARY TURN AROUND EASEMENT A SENDED HEREBY GRANT A TAME DAD DE HEREBY THE PUBLIC UNITL SUCH TIME THAT THE ROAD THE FULL AND EXCLUSIVE USE AND BENEFIT OF THE LOT OWNERS AND DO HEREBY GRANT A 30' PRIVATE ACCESS EASEMENT TO THE INDIVIDUAL LOT OWNERS TO BE OWNED AND MAINTAINED BY THE SAME AND DO HEREBY GRANT A 66' FUTURE ROAD EASEMENT TO WEBER COUNTY TO BE USED FOR A FUTURE ROAD AND TO BE OWNED AND MAINTAINED BY THE INDIVIDUAL LOT OWNERS.         SIGNED THIS					
190.40						)) THEY ARE Y AND THAT THEY DLUNTARILY, AND EREIN MENTIONED.
00 49 00 W 19	0408282 0-18" GRAVEL 18-44" 44-68" THROUG GROUND <b>EXPLOR</b> 0408240 0-08" 08-63" 63-73"	ATION PIT #1 – (UTM ZONE 2 E 4562964 N) LOAM, GRANULAR STRUCTU SANDY LOAM, MASSIVE STF SANDY LOAM, MANY MOTTL SHOUT @ 45 INCHES WATER @ 68" ATION PIT #2 – (UTM ZONE 0 E 4522966 N) LOAM, GRANULAR STRUCTU SANDY LOAM, MASSIVE STF	URE, 5% FINE RUCTURE, ES 12 NAD 83 URE RUCTURE	EXPLORATION           0408222 E           0-16"           17-48"           SAI           48-72"           GROUND WATE           EXPLORATION           0408181 E           0-11"           11-29"           SAI           GRAY TO WHIT	PIT #3 — (UT 563049 N) AM, GRANULAR NDY LOAM, MA NDY LOAM, MC R@ 71" PIT #4 — (UT 562972 N) AM, GRANULAR NDY LOAM, MA NDY LOAM, MA NDY LOAM, HO E INDICATING E EVALUATED II	SSIVE STRUCTURE TTLING @ 60 INCHES M ZONE 12 NAD 83 STRUCTURE SSIVE STRUCTURE RIZON AS A IS LIGHT SATURATED CONDITIONS. N EARLY SPRINGS SOIL
			& Asso	eev ciates, v, riverdale, utah 844 (801) 621–2666 www.r	Te Inc. 105 eeve-assoc.com	roject Info. Irveyor: T. HATCH esigner: N. ANDERSON egin Date: 6-25-2020 ame: BRIDGER BUTLER SUBDIVISION umber: 6403-01 eale: 1"=60'
ATTORNEY GUARANTEE AND OTHE S SUBDIVISION PLAT, TH THE COUNTY AND NOW IN FORCE A	ER I AND AN IN	<b>EBER-MORGAN HEA</b> HEREBY CERTIFY THAT THE S ND SITE CONDITIONS FOR TH VESTIGATED BY THIS OFFICE N-SITE WASTEWATER DISPOSA IGNED THIS DAY OF	SOILS, PERCOLATIO IS SUBDIVISION H AND ARE APPROV AL SYSTEMS.	ON RATES, IAVE BEEN VED FOR	Entry No And Record At	County Recorder Fee Paid _ Filed For Record ded, _ In Book icial Records, Page
ATTORNEY		WEBER-MORGAN HEA	LTH DEPARTMENT		Weber	County Recorder