

DAISY ESTATES

PART OF THE SE 1/4 OF SECTION 32, TOWNSHIP 6 NORTH, RANGE 2 WEST, SALT LAKE BASE & MERIDIAN
UNINCORPORATED WEBER COUNTY, UTAH - FEBRUARY 2023

OWNER'S DEDICATION

We the undersigned owner(s) of the herein described tract of land, do hereby set apart and subdivide the same into Lots and streets as shown or noted hereon and name said tract DAISY ESTATES:
(As used herein the term Local Entity is the same as defined in UCA 67-1a-6.5)

We hereby dedicate a right-of-way to the Local Entity, designee(s), successor(s), or assignee(s) for the purpose of public use all those parts or portions of said tract of land designated as public street(s) and/or public road(s), the same to be used as public thoroughfares. And further dedicate grant and convey an easement over, upon and under said street(s) or and/or road(s) as public utility corridors as may be authorized by the Local Entity.

We hereby grant and dedicate a perpetual right and easement over, upon and under the lands designated hereon as public utility easement(s) (PUE), storm water detention/retention ponds, and drainage easement(s), the same to be used for the installation maintenance and operation of public utility service line(s), storm drainage facilities, irrigation canal(s) or for the perpetual preservation of water channels in their natural state whichever is applicable to the Local Entity, designee(s), successor(s), or assignee(s) and other uses as may be authorized by recorded document by the Local Entity, with no buildings or structures being erected within such easements without written authorization of the Local Entity.

We hereby grant and dedicate unto ourselves, grantee(s), successor(s), and assign(s) of each lot upon which private land drains (PLDE) are constructed or which are otherwise dependent upon such land drains, a perpetual easement over such land drains for the purpose of maintenance and operation of said private land drains. We also hereby reserve unto ourselves, grantee(s), successor(s) and assign(s) said land drain easement across the public street dedication as shown and noted hereon.

Trust Acknowledgement

IN WITNESS WHEREOF, said THE KENNETH AND DEBRA IVERSON FAMILY TRUST, dated the 2nd day of October 2012, has caused this instrument to be executed by its trustee(s) hereunto duly authorized, this ____ day of _____, 20____.

KENNETH R. IVERSON: Trustee DEBRA M. IVERSON: Trustee
STATE OF UTAH) SS
COUNTY OF WEBER)

On the date first above written personally appeared before me the above named trustee(s) as signers, who, being by me duly sworn and affirmed, did say that [he/she/they is/are] the trustee(s) of said trust and that the within and foregoing instrument was signed in behalf of said trust by authority, and the said signer(s) acknowledged to me that [he/she/they] as trustee(s), executed the same in the name of the trust.
As a Notary Public commissioned in Utah, having commission number _____, I, _____, WITNESS my hand and official stamp the date in this certificate first above written:

Notary Signature: _____ My Commission Expires: _____
(print name below signature)

BOUNDARY DESCRIPTION

A part of the Southwest Quarter of Section 32, Township 6 North, Range 2 West, Salt Lake Base and Meridian; Beginning at a point on the South line of West Hills Subdivision, a subdivision in Weber County, Utah, being 2642.02 feet South 00°34'18" West and 659.99 feet South 89°25'42" East from the North Quarter of said Section 32; and running thence South 89°22'12" East 658.27 feet to the Southeast corner of said West Hills subdivision, said point being on a North-South fence line; thence along said fence line South 00°34'18" West 149.67 feet; thence North 89°25'42" West 298.11 feet; thence South 00°34'18" West 150.00 feet; thence North 89°25'42" West 360.00 feet; thence North 00°34'18" East 300.34 feet to the point of beginning.
Contains 3.51 acres

NARRATIVE


The purpose of this survey is to create a three (3) lot subdivision from an existing parcel.

- Documents used to aid in this survey:
- Weber County Tax Plot 15-084 & 15-113.
 - Deeds of record as found in the Weber County Recorders Office for subject and adjacent parcels.
 - Plats of Record: #17-016 West Hills Subdivision, #35-001 Lassen Subdivision.
 - Record of Survey's: #5575, #6008, #6694.

The basis of bearing is state plane grid from monuments as shown.


SURVEYOR'S CERTIFICATE

I, Tyler D. Knight, do hereby certify that I am a professional land surveyor in the State of Utah and hold license no. 9008384-2201 in accordance with Title 58, Chapter 22 known as the Professional Engineers and Professional Land Surveyor's Licensing Act, have made a survey of the property(s) shown hereon in accordance with UCA 17-23-17, verifying measurements, and placing monuments as represented. That this plat was prepared from the field notes of this survey and from documents and records as may be noted hereon or contained in the project files of Landmark Surveying, Inc. Any warranties, express or implied, are hereby limited to the current owner(s) of the properties surveyed. No certification or warranties are extended to successor(s), assign(s), or heir(s) of said owner(s) nor to adjacent owner(s) of the properties of which may or may not share a common boundary with the property(s) surveyed. In accordance with Weber County Ordinance, I further certify that, to the best of my knowledge and belief, all lots meet the current requirements of the Land Use Ordinance of Weber County as indicated by their approval hereon.

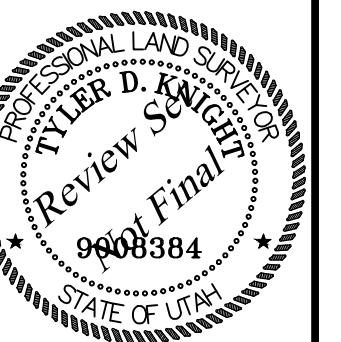


HOLE #	DEPTH, in.	SOILS EVALUATION WEBER COUNTY HEALTH DEPT. #15456
1	0-21"	Sandy Loam, Granular Structure
	21-40"	Sandy Loam, Blocky Structure
2	0-27"	Sandy Loam, Granular Structure
	27-50"	Sandy Loam, Blocky Structure
3	0-23"	Sandy Loam, Granular Structure
	23-46"	Sandy Loam, Blocky Structure

Landmark Surveying, Inc. A Complete Land Surveying Service www.LandmarkSurveyingUtah.com		4646 South 3500 West - #A-3 West Haven, UT 84401 801-731-4075	
DEVELOPER: Ken Iverson Address: 2832 S. 4550 W Taylor UT 84401		Weber County Recorder	
SW 1/4 of Section 32, Township 6 North, Range 2 West, Salt Lake Base and Meridian.		Subdivision	
Revisions	DRAWN BY: TK	Entry no. _____	Filed for record and recorded _____ day of _____ 20____
	CHECKED BY: ...	at _____ of _____	at _____ of official records, on page _____
	DATE: 10/17/2022	County Recorder: Leann H Kilts	
	PROJ: 4346	By Deputy: _____	Fee paid _____

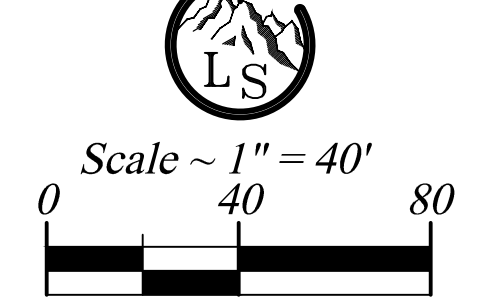

- Legend**
- - - - - EXISTING FENCE
 - - - - - EASEMENTS
 - - - - - STREET CENTERLINE
 - ◆ FND SECTION CORNER
 - FND REBAR AND CAP
 - SET #5x24" REBAR AND CAP STAMPED LANDMARK
 - R RECORD DATA
 - MD MEASURED DATA
 - ▨ ROAD/STREET DEDICATION

- NOTES:**
- Agriculture is the preferred use in the agricultural zones. Agricultural operations as specified in the Land Use Code for a particular zone are permitted at any time including the operation of farm machinery and no allowed agricultural use shall be subject to restriction on the basis that it interferes with activities of future residents of this subdivision. [Am. Ord. Sec. 106-1-8(c)(5)]
 - The following is required to be included on this plat by Weber County Engineering: "Due to the topography and the location of this subdivision all owners will accept responsibility for any storm water runoff from the road adjacent to this property until curb and gutter is installed."

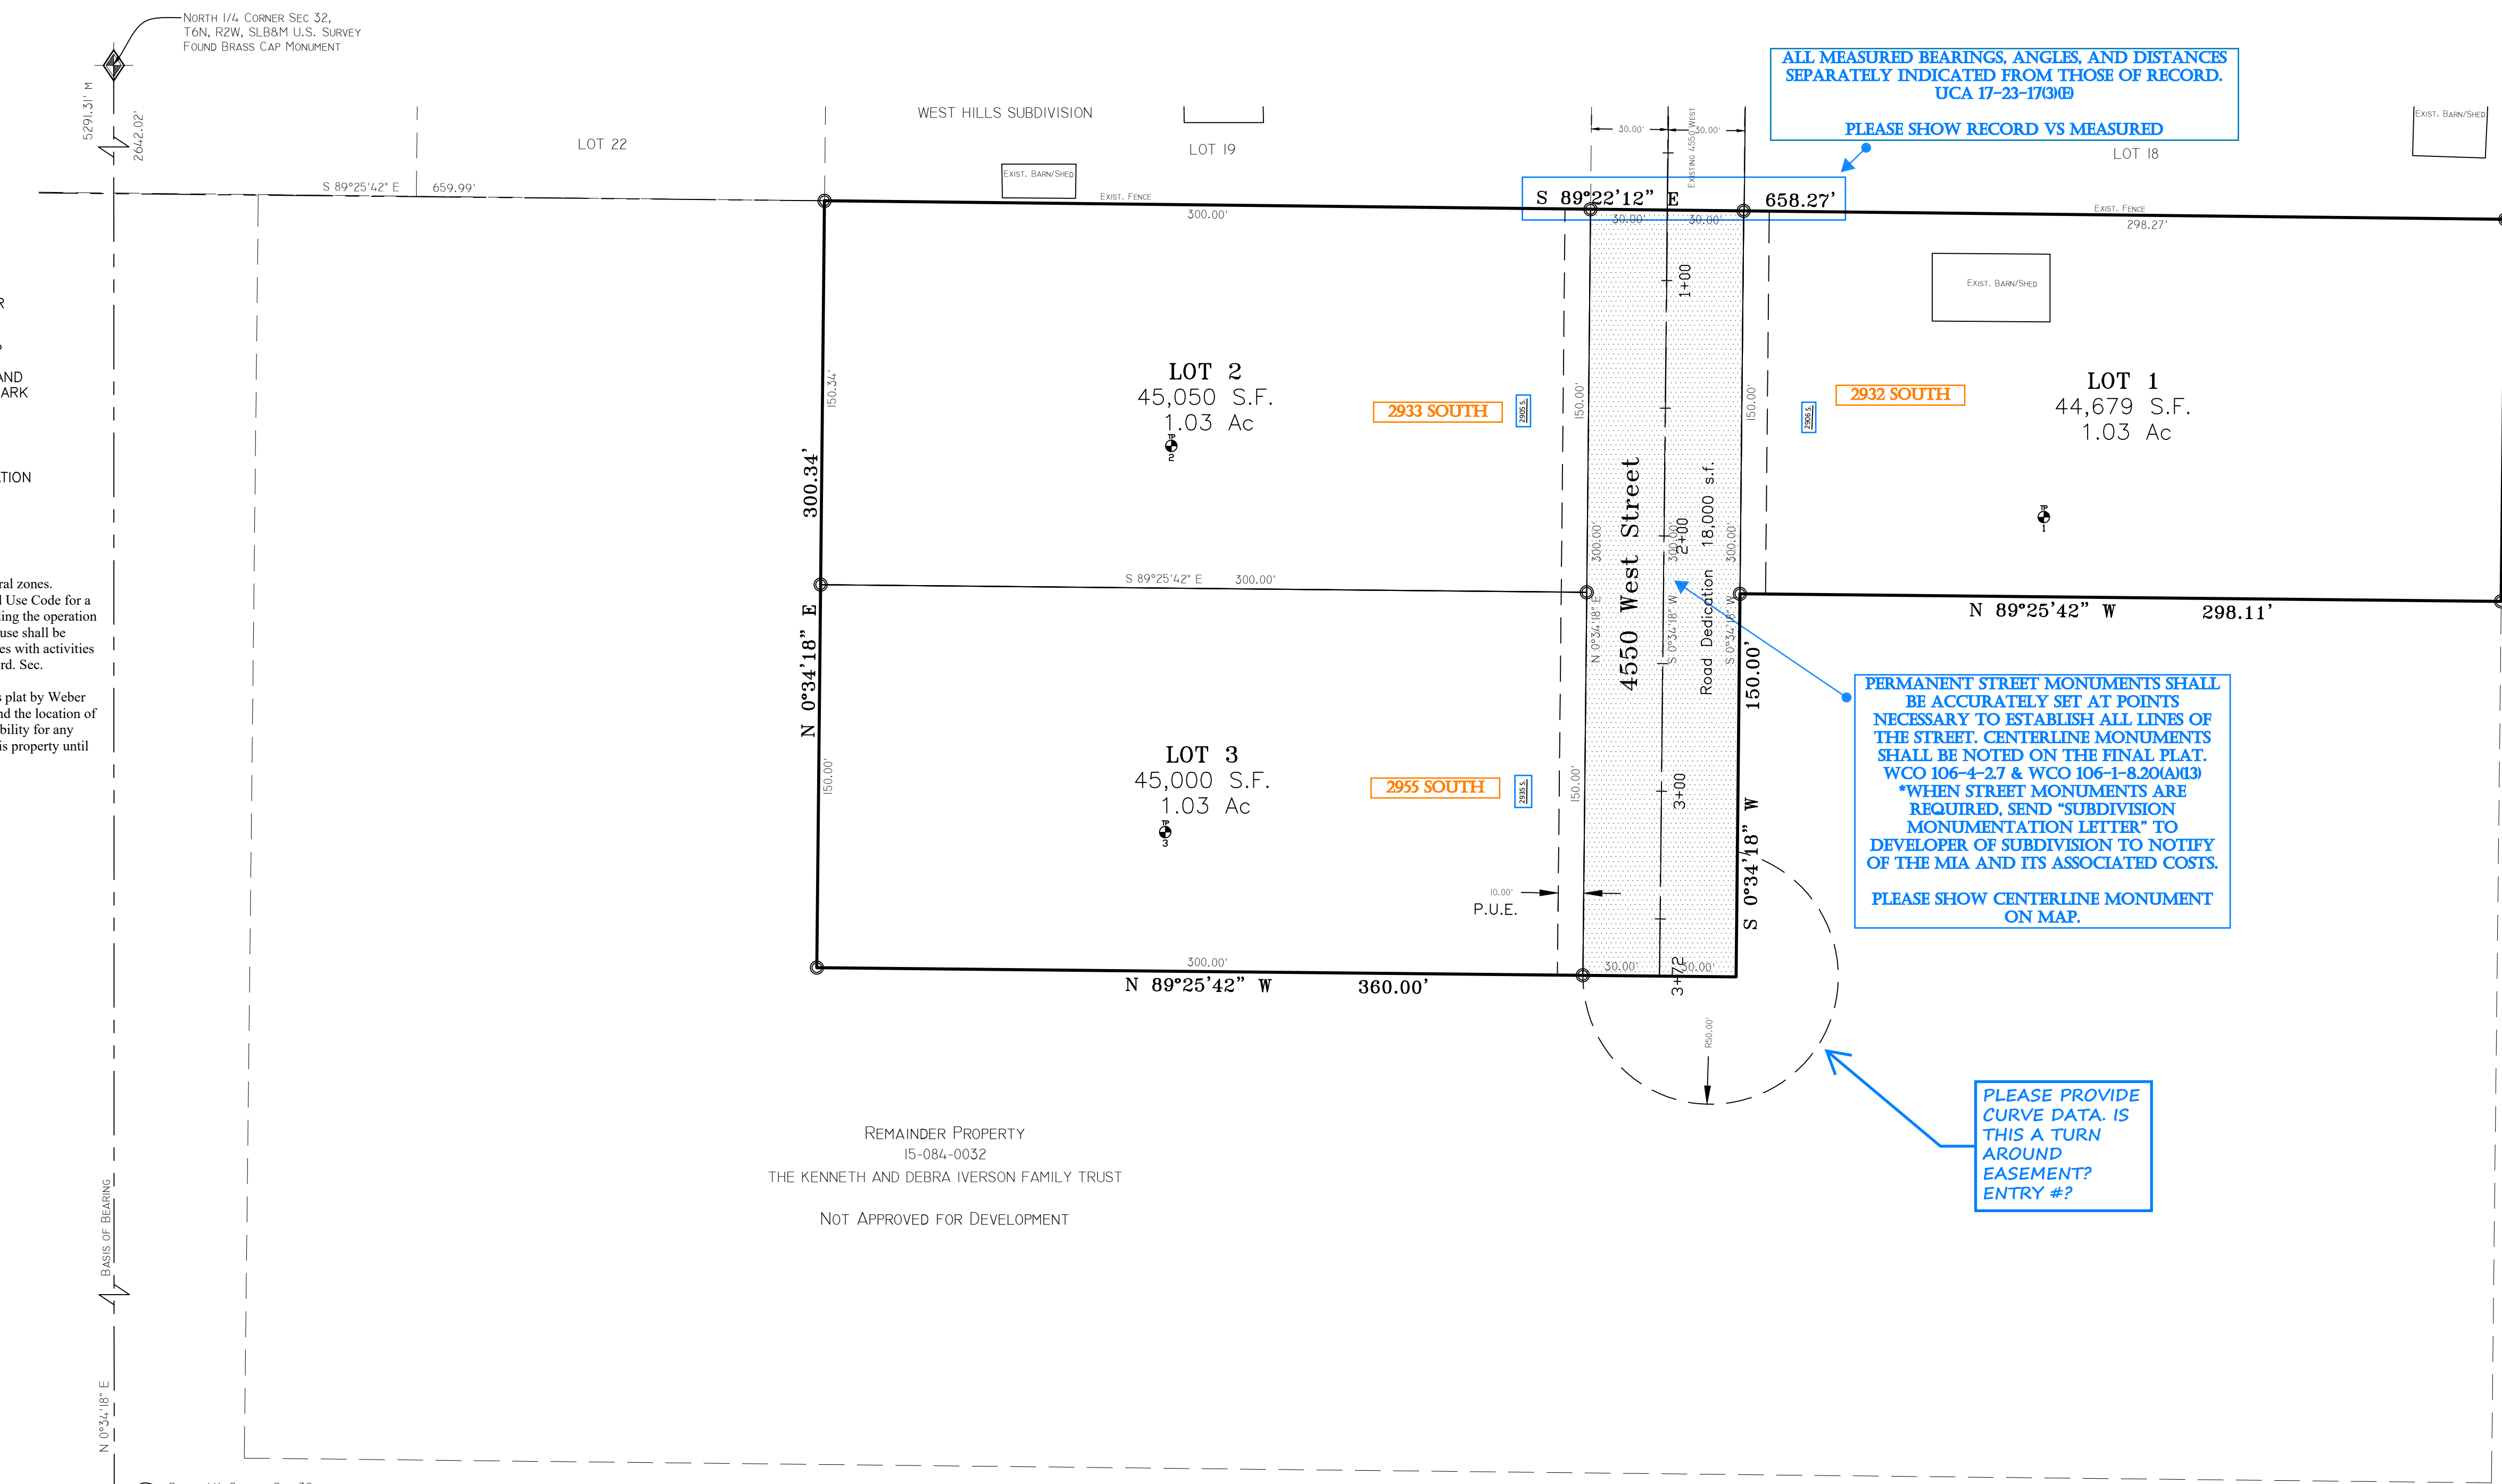

ALL MEASURED BEARINGS, ANGLES, AND DISTANCES SEPARATELY INDICATED FROM THOSE OF RECORD. UCA 17-23-17(6)

PLEASE SHOW RECORD VS MEASURED

PERMANENT STREET MONUMENTS SHALL BE ACCURATELY SET AT POINTS NECESSARY TO ESTABLISH ALL LINES OF THE STREET. CENTERLINE MONUMENTS SHALL BE NOTED ON THE FINAL PLAT. WCO 106-4-2.7 & WCO 106-1-8.20(A)(3)
*WHEN STREET MONUMENTS ARE REQUIRED, SEND "SUBDIVISION MONUMENTATION LETTER" TO DEVELOPER OF SUBDIVISION TO NOTIFY OF THE MIA AND ITS ASSOCIATED COSTS.
PLEASE SHOW CENTERLINE MONUMENT ON MAP.

PLEASE PROVIDE CURVE DATA. IS THIS A TURN AROUND EASEMENT? ENTRY #?

WEBER COUNTY COMMISSION ACCEPTANCE

This is to certify that this subdivision plat, the dedication of streets and other public ways and financial guarantee of public improvements associated with this subdivision thereon are hereby approved and accepted by the Commissioners of Weber County, Utah this ____ day of _____, 20____.

Chairman, Weber County Commission Title: Weber County Clerk

WEBER-MORGAN HEALTH DEPARTMENT

I hereby certify that the soils, percolation rates, and site conditions for this subdivision have been investigated by this office and are approved for on site wastewater disposal systems. Signed this ____ day of _____, 20____.

WEBER COUNTY PLANNING COMMISSION APPROVAL

This is to certify that this subdivision plat was duly approved by the Weber County Planning Commission on the ____ day of _____, 20____.

WEBER COUNTY ATTORNEY

I have examined the financial guarantee and other documents associated with this subdivision plat and in my opinion they conform with the County Ordinance applicable thereto and now in force and effect. Signed this ____ day of _____, 20____.

Signature _____

Taylor West Weber Water District

Approved as to form this ____ day of _____, 20____

Signature _____

WEBER COUNTY SURVEYOR'S CERTIFICATE

I hereby certify that the Weber County Surveyor's Office has reviewed this plat and all conditions for approval by this office have been satisfied. The approval of this plat by the Weber County Surveyor does not relieve the Licensed Land Surveyor who executed this plat from the responsibilities associated therewith. Signed this ____ day of _____, 20____.

Weber County Surveyor Record of Survey# _____

WEBER COUNTY ENGINEER

I hereby certify that the required public improvement standards and drawings for this subdivision conform with County standards and the amount of the financial guarantee is sufficient for the installation of these improvements. Signed this ____ day of _____, 20____.

Signature _____