

# HADLOCK SUBDIVISION - 2ND AMENDMENT

## AMENDING PARCEL 'A'

PART OF THE SOUTHEAST QUARTER OF SECTION 7, TOWNSHIP 7 NORTH, RANGE 1 EAST, S.L.B.&M., U.S. SURVEY  
 WEBER COUNTY, UTAH  
 AUGUST, 2023



VICINITY MAP  
NO SCALE

### NOTES

1. DUE TO THE TOPOGRAPHY AND THE LOCATION OF THIS SUBDIVISION ALL OWNERS WILL ACCEPT RESPONSIBILITY FOR ANY STORM WATER RUNOFF FROM THE ROAD ADJACENT TO THIS PROPERTY UNTIL CURB AND GUTTER IS INSTALLED.
2. "AGRICULTURE IS THE PREFERRED USE IN THE AGRICULTURAL ZONES. AGRICULTURAL OPERATIONS AS SPECIFIED IN THE ZONING ORDINANCE FOR A PARTICULAR ZONE ARE PERMITTED AT ANY TIME INCLUDING THE OPERATION OF FARM MACHINERY AND NO ALLOWED AGRICULTURAL USE SHALL BE SUBJECT TO RESTRICTION ON THE BASIS THAT IT INTERFERES WITH ACTIVITIES OF FUTURE RESIDENTS OF THIS SUBDIVISION." (AMD. ORD. #3-82, JANUARY 26, 1982; ORD., #2002-3, MARCH 05, 2002).

### BASIS OF BEARINGS

THE BASIS OF BEARINGS FOR THIS PLAT IS THE SECTION LINE BETWEEN THE EAST QUARTER CORNER AND THE SOUTHEAST OF SECTION 7, TOWNSHIP 7 NORTH, RANGE 1 EAST, SALT LAKE BASE AND MERIDIAN, U.S. SURVEY. SHOWN HEREON AS N00°45'13"E.

### NARRATIVE

THE PURPOSE OF THIS PLAT IS TO DIVIDE THE BELOW DESCRIBED PROPERTY INTO LOTS AS SHOWN. ALL BOUNDARY AND REAR LOT CORNERS WERE SET WITH A 5/8" X 24" REBAR AND PLASTIC CAP STAMPED "REEVE & ASSOCIATES". ALL FRONT LOT CORNERS WERE SET WITH A LEAD PLUG IN THE TOP BACK OF CURB AT THE EXTENSION OF THE SIDE LOT LINES.

### BOUNDARY DESCRIPTION

ALL OF PARCEL 'A' OF THE HADLOCK SUBDIVISION - 1ST AMENDMENT, AMENDING LOTS 1 AND 2. ALSO DESCRIBED AS FOLLOWS:



PART OF THE SOUTHEAST QUARTER OF SECTION 7, TOWNSHIP 7 NORTH, RANGE 1 EAST, SALT LAKE BASE AND MERIDIAN, U.S. SURVEY. MORE PARTICULARLY DESCRIBED AS FOLLOWS:

BEGINNING AT A POINT ON THE SOUTHERLY RIGHT OF WAY LINE OF SHAW DRIVE (1500 NORTH STREET) AND THE NORTHWEST CORNER OF LOT 101 OF THE HADLOCK SUBDIVISION - 1ST AMENDMENT, SAID POINT BEING 454.44 FEET NORTH 00°45'13" EAST AND 719.15 FEET NORTH 89°14'47" WEST FROM THE SOUTHEAST CORNER OF SAID SECTION 7 (SAID SOUTHEAST CORNER BEING SOUTH 00°45'13" WEST 2850.42 FEET FROM THE EAST QUARTER CORNER OF SAID SECTION 7); THENCE SOUTH 40°07'58" WEST 718.23 FEET ALONG THE WESTERLY LINE OF LOT 101 OF SAID HADLOCK SUBDIVISION; THENCE SOUTH 85°51'11" WEST 418.57 FEET ALONG THE SOUTH LINE OF SAID HADLOCK SUBDIVISION TO THE EASTERLY LINE OF PARCEL 'C' OF SAID HADLOCK SUBDIVISION; THENCE NORTH 40°07'58" EAST ALONG SAID EASTERLY LINE OF PARCEL 'C' AND LOT 102 OF SAID HADLOCK SUBDIVISION, 1026.08 FEET TO NORTH EAST CORNER OF LOT 102 OF SAID HADLOCK SUBDIVISION AND THE SOUTHERLY RIGHT OF WAY LINE OF SHAW DRIVE (1500 NORTH STREET); THENCE SOUTH 46°53'02" EAST ALONG SAID SOUTHERLY LINE, 300.08 FEET TO THE POINT OF BEGINNING.

CONTAINING 261,360 SQUARE FEET OR 6.000 ACRES.


### LEGEND

- ◆ = SECTION CORNER
- = SET 5/8" X 24" REBAR AND PLASTIC CAP STAMPED "REEVE & ASSOCIATES"
- = FOUND REBAR & CAP MARKED "SILVERPEAK ENG"
- = BOUNDARY LINE
- = LOT LINE
- - - = ADJOINING PROPERTY
- - - = EASEMENTS
- - - = SECTION TIE LINE
- - - = ROAD CENTERLINE
- x x x = EXISTING FENCELINE
- ▭ = EXISTING BUILDING

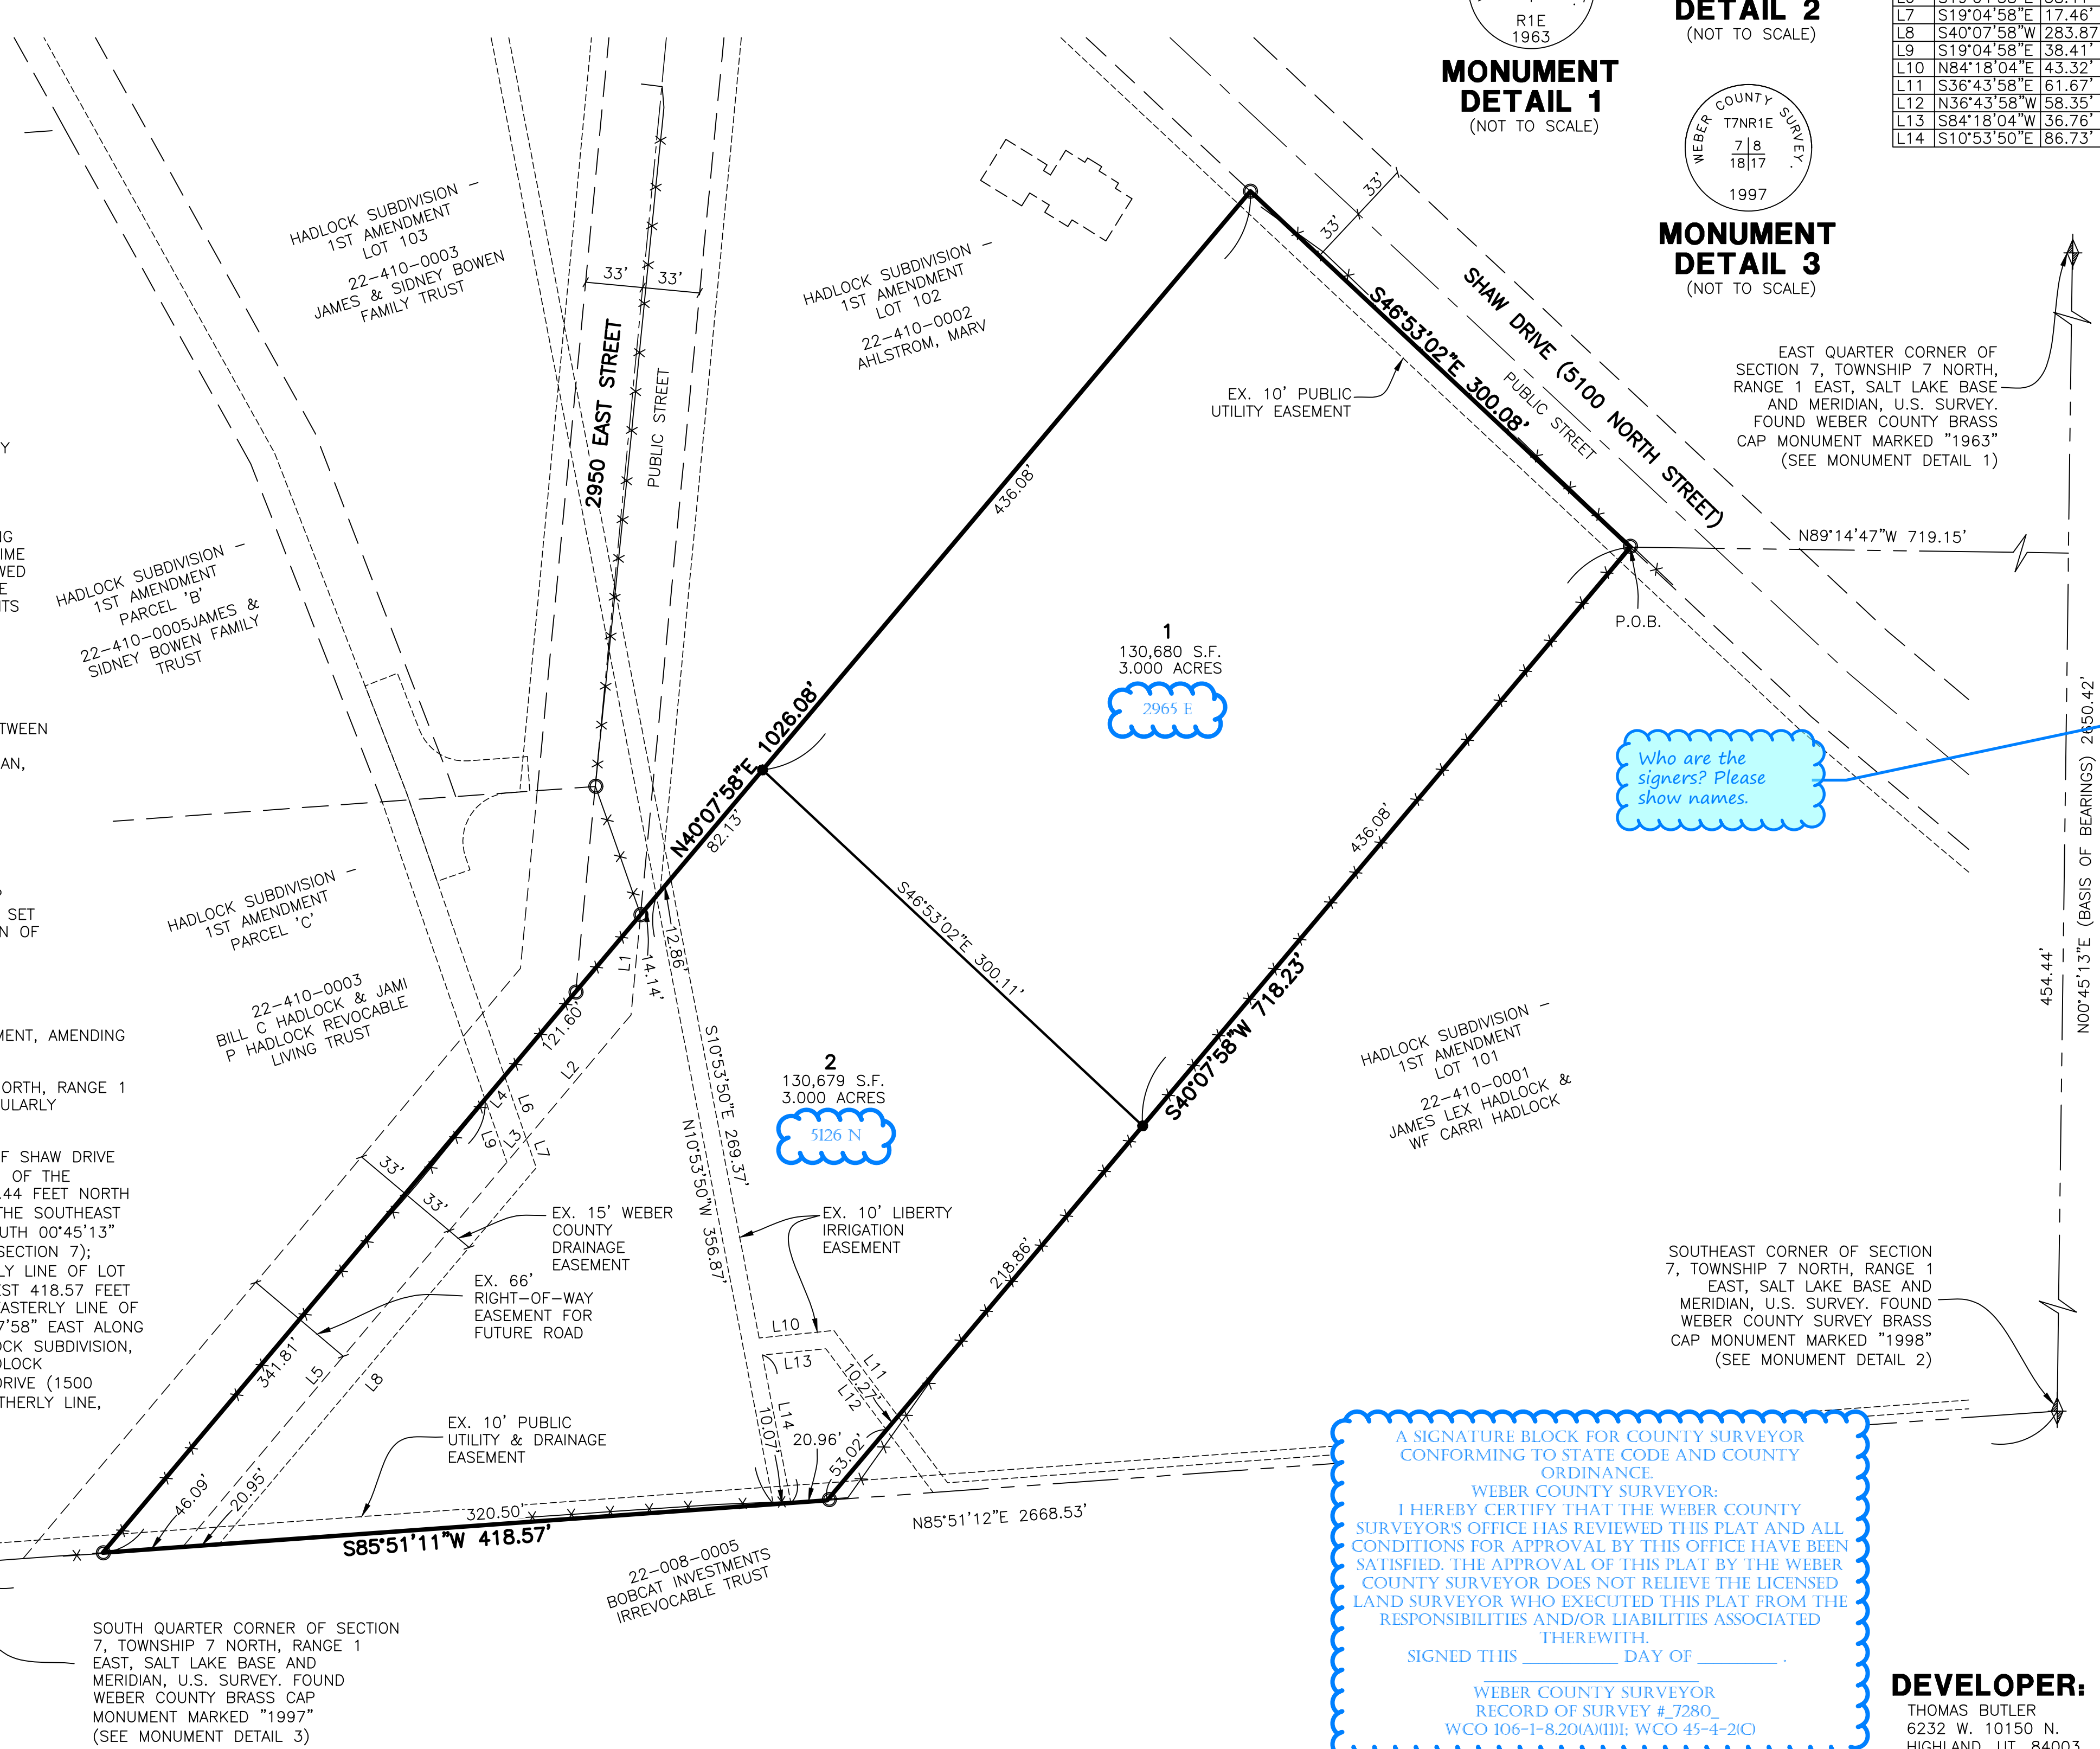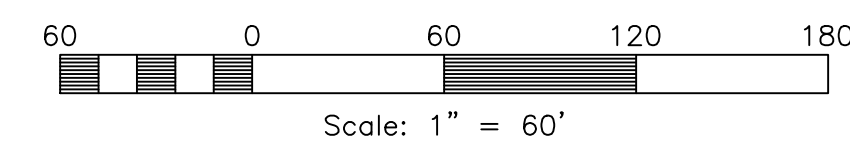


### LINE TABLE


#	BEARING	DISTANCE
L1	S05°25'46"W	57.96'
L2	S40°07'58"W	93.61'
L3	S40°07'58"W	17.46'
L4	S40°07'58"W	17.46'
L5	S40°07'58"W	289.97'
L6	S19°04'58"E	38.41'
L7	S19°04'58"E	17.46'
L8	S40°07'58"W	283.87'
L9	S19°04'58"E	38.41'
L10	N84°18'04"E	43.32'
L11	S36°43'58"E	61.67'
L12	N36°43'58"W	58.35'
L13	S84°18'04"W	36.76'
L14	S10°53'50"E	86.73'

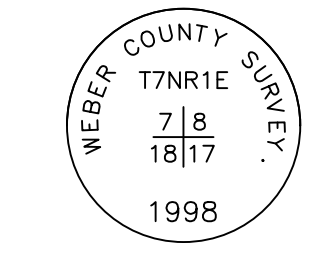

MONUMENT  
DETAIL 2  
(NOT TO SCALE)

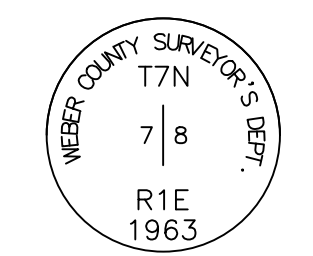

MONUMENT  
DETAIL 1  
(NOT TO SCALE)

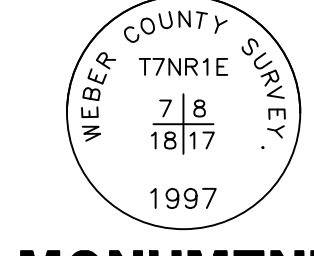

MONUMENT  
DETAIL 3  
(NOT TO SCALE)

EAST QUARTER CORNER OF SECTION 7, TOWNSHIP 7 NORTH, RANGE 1 EAST, SALT LAKE BASE AND MERIDIAN, U.S. SURVEY. FOUND WEBER COUNTY BRASS CAP MONUMENT MARKED "1963" (SEE MONUMENT DETAIL 1)

Who are the signers? Please show names.

A SIGNATURE BLOCK FOR COUNTY SURVEYOR CONFORMING TO STATE CODE AND COUNTY ORDINANCE.  
 WEBER COUNTY SURVEYOR:  
 I HEREBY CERTIFY THAT THE WEBER COUNTY SURVEYOR'S OFFICE HAS REVIEWED THIS PLAT AND ALL CONDITIONS FOR APPROVAL BY THIS OFFICE HAVE BEEN SATISFIED. THE APPROVAL OF THIS PLAT BY THE WEBER COUNTY SURVEYOR DOES NOT RELIEVE THE LICENSED LAND SURVEYOR WHO EXECUTED THIS PLAT FROM THE RESPONSIBILITIES AND/OR LIABILITIES ASSOCIATED THEREWITH.  
 SIGNED THIS \_\_\_\_\_ DAY OF \_\_\_\_\_, 20\_\_\_\_.  
 WEBER COUNTY SURVEYOR  
 RECORD OF SURVEY # 7280,  
 WCO 106-1-8.20(A)HDI; WCO 45-4-2(C)


DEVELOPER:  
 THOMAS BUTLER  
 6232 W. 10150 N.  
 HIGHLAND, UT. 84003

### SURVEYOR'S CERTIFICATE

I, **JASON T. FELT**, DO HEREBY CERTIFY THAT I AM A PROFESSIONAL LAND SURVEYOR IN THE STATE OF UTAH IN ACCORDANCE WITH TITLE 58, CHAPTER 22, PROFESSIONAL ENGINEERS AND LAND SURVEYORS ACT; AND THAT I HAVE COMPLETED A SURVEY OF THE PROPERTY DESCRIBED ON THIS PLAT IN ACCORDANCE WITH SECTION 17-23-17 AND HAVE VERIFIED ALL MEASUREMENTS, AND HAVE PLACED MONUMENTS AS REPRESENTED ON THIS PLAT, AND THAT THIS PLAT OF **HADLOCK SUBDIVISION - 2ND AMENDMENT** IN **WEBER COUNTY**, UTAH, HAS BEEN DRAWN CORRECTLY TO THE DESIGNATED SCALE AND IS A TRUE AND CORRECT REPRESENTATION OF THE HEREIN DESCRIBED LANDS INCLUDED IN SAID SUBDIVISION, BASED UPON DATA COMPILED FROM RECORDS IN THE **WEBER COUNTY** RECORDER'S OFFICE AND FROM SAID SURVEY MADE BY ME ON THE GROUND. I FURTHER CERTIFY THAT THE REQUIREMENTS OF ALL APPLICABLE STATUTES AND ORDINANCES OF **WEBER COUNTY**, CONCERNING ZONING REQUIREMENTS REGARDING LOT MEASUREMENTS HAVE BEEN COMPLIED WITH.

SIGNED THIS \_\_\_\_\_ DAY OF \_\_\_\_\_, 20\_\_\_\_.

9239283  
 UTAH LICENSE NUMBER

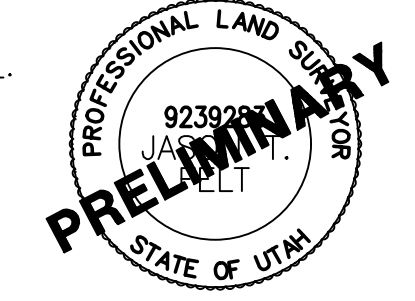

### OWNERS DEDICATION AND CERTIFICATION

WE THE UNDERSIGNED OWNERS OF THE HEREIN DESCRIBED TRACT OF LAND, DO HEREBY SET APART AND SUBDIVIDE THE SAME INTO LOTS AS SHOWN ON THE PLAT AND NAME SAID TRACT **HADLOCK SUBDIVISION - 2ND AMENDMENT**, AND DO HEREBY DEDICATE TO PUBLIC USE ALL THOSE PARTS OR PORTIONS OF SAID TRACT OF LAND DESIGNATED AS STREETS, THE SAME TO BE USED AS PUBLIC THOROUGHFARES AND ALSO TO GRANT AND DEDICATE A PERPETUAL RIGHT AND EASEMENT OVER, UPON AND UNDER THE LANDS DESIGNATED HEREON AS PUBLIC UTILITY, STORM WATER DETENTION PONDS DRAINAGE EASEMENTS AND CANAL MAINTENANCE EASEMENT, THE SAME TO BE USED FOR THE INSTALLATION MAINTENANCE AND OPERATION OF PUBLIC UTILITY SERVICE LINE, STORM DRAINAGE FACILITIES, IRRIGATION CANALS OR FOR THE PERPETUAL PRESERVATION OF WATER CHANNELS IN THEIR NATURAL STATE WHICHEVER IS APPLICABLE AS MAY BE AUTHORIZED BY THE GOVERNING AUTHORITY, WITH NO BUILDINGS OR STRUCTURES BEING ERRECTED WITHIN SUCH EASEMENTS.

SIGNED THIS \_\_\_\_\_ DAY OF \_\_\_\_\_, 20\_\_\_\_.

### ACKNOWLEDGMENT

STATE OF UTAH )ss.  
 COUNTY OF \_\_\_\_\_ )  
 ON THE \_\_\_\_\_ DAY OF \_\_\_\_\_, 20\_\_\_\_, PERSONALLY APPEARED BEFORE ME, THE UNDERSIGNED NOTARY PUBLIC, \_\_\_\_\_ (AND) \_\_\_\_\_ SIGNER(S) OF THE ABOVE OWNER'S DEDICATION AND CERTIFICATION, WHO BEING BY ME DULY SWORN, DID ACKNOWLEDGE TO ME \_\_\_\_\_ SIGNED IT FREELY, VOLUNTARILY, AND FOR THE PURPOSES THEREIN MENTIONED.  
 \_\_\_\_\_ NOTARY PUBLIC  
 COMMISSION EXPIRES \_\_\_\_\_

### ACKNOWLEDGMENT

STATE OF UTAH )ss.  
 COUNTY OF \_\_\_\_\_ )  
 ON THE \_\_\_\_\_ DAY OF \_\_\_\_\_, 20\_\_\_\_, PERSONALLY APPEARED BEFORE ME, THE UNDERSIGNED NOTARY PUBLIC, \_\_\_\_\_ (AND) \_\_\_\_\_ BEING BY ME DULY SWORN, ACKNOWLEDGED TO ME THEY ARE \_\_\_\_\_ AND \_\_\_\_\_ OF SAID CORPORATION AND THAT THEY SIGNED THE ABOVE OWNER'S DEDICATION AND CERTIFICATION FREELY, VOLUNTARILY, AND IN BEHALF OF SAID CORPORATION FOR THE PURPOSES THEREIN MENTIONED.  
 \_\_\_\_\_ NOTARY PUBLIC  
 COMMISSION EXPIRES \_\_\_\_\_

**Project Info.**

Surveyor:	J. FELT
Designer:	E. ROCHE
Begin Date:	08-24-23
Name:	HADLOCK SUBDIVISION 2ND AMENDMENT
Number:	8228-01
Revision:	
Scale:	1"=60'
Checked:	

**Reeve & Associates, Inc.**  
 5160 S 1500 W, RIVERDALE, UTAH 84405  
 TEL: (801) 621-3100 FAX: (801) 621-2666 www.reeve-associ.com

**WEBER COUNTY PLANNING COMMISSION APPROVAL**  
 THIS IS TO CERTIFY THAT THIS SUBDIVISION PLAT WAS DULY APPROVED BY THE WEBER COUNTY PLANNING COMMISSION.  
 SIGNED THIS \_\_\_\_\_ DAY OF \_\_\_\_\_, 20\_\_\_\_.  
 \_\_\_\_\_  
 CHAIRMAN, WEBER COUNTY PLANNING COMMISSION

**WEBER COUNTY ENGINEER**  
 I HEREBY CERTIFY THAT THE REQUIRED PUBLIC IMPROVEMENT STANDARDS AND DRAWINGS FOR THIS SUBDIVISION CONFORM WITH THE COUNTY STANDARDS AND THE AMOUNT OF THE FINANCIAL GUARANTEE IS SUFFICIENT FOR THE INSTALLATION OF THESE IMPROVEMENTS.  
 \_\_\_\_\_  
 WEBER COUNTY ENGINEER

**WEBER COUNTY COMMISSION ACCEPTANCE**  
 THIS IS TO CERTIFY THAT THIS SUBDIVISION PLAT, THE DEDICATION OF STREETS AND OTHER PUBLIC WAYS AND FINANCIAL GUARANTEE OF PUBLIC IMPROVEMENTS ASSOCIATED WITH THIS SUBDIVISION, THEREON ARE HEREBY APPROVED AND ACCEPTED BY THE COMMISSIONERS OF WEBER COUNTY, UTAH.  
 SIGNED THIS \_\_\_\_\_ DAY OF \_\_\_\_\_, 20\_\_\_\_.  
 \_\_\_\_\_  
 CHAIRMAN, WEBER COUNTY COMMISSION

**WEBER COUNTY SURVEYOR**  
 I HEREBY CERTIFY THAT THE WEBER COUNTY SURVEYOR'S OFFICE HAS REVIEWED THIS PLAT FOR MATHEMATICAL CORRECTNESS, SECTION CORNER DATA, AND FOR HARMONY WITH LINES AND MONUMENTS ON RECORD IN COUNTY OFFICES. THE APPROVAL OF THIS PLAT BY THE WEBER COUNTY SURVEYOR DOES NOT RELIEVE THE LICENSED LAND SURVEYOR WHO EXECUTED THIS PLAT FROM THE RESPONSIBILITIES AND/OR LIABILITIES ASSOCIATED THEREWITH.  
 SIGNED THIS \_\_\_\_\_ DAY OF \_\_\_\_\_, 20\_\_\_\_.  
 \_\_\_\_\_  
 WEBER COUNTY SURVEYOR

**WEBER COUNTY ATTORNEY**  
 I HAVE EXAMINED THE FINANCIAL GUARANTEE AND OTHER DOCUMENTS ASSOCIATED WITH THIS SUBDIVISION PLAT, AND IN MY OPINION THEY CONFORM WITH THE COUNTY ORDINANCE APPLICABLE THERETO AND NOW IN FORCE AND AFFECT.  
 SIGNED THIS \_\_\_\_\_ DAY OF \_\_\_\_\_, 20\_\_\_\_.  
 \_\_\_\_\_  
 WEBER COUNTY ATTORNEY

**Weber County Recorder**  
 Entry No. \_\_\_\_\_ Fee Paid \_\_\_\_\_  
 \_\_\_\_\_ Filed For Record  
 And Recorded, \_\_\_\_\_  
 At \_\_\_\_\_ in Book \_\_\_\_\_  
 Of The Official Records, Page \_\_\_\_\_  
 Recorded For: \_\_\_\_\_  
 \_\_\_\_\_  
 Weber County Recorder  
 \_\_\_\_\_ Deputy.