


SUMMIT EDEN RIDGE NESTS - PRUD AMENDED AND RESTATED

LOCATED IN THE SOUTH 1/2 OF SECTIONS 5 & 6,
TOWNSHIP 7 NORTH, RANGE 2 EAST,
SALT LAKE BASE AND MERIDIAN
SEPTEMBER 2015

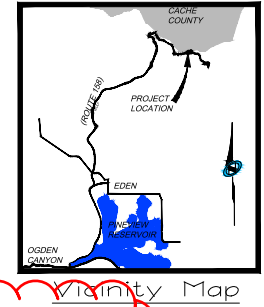

SURVEYOR'S CERTIFICATE

I, RICHARD N. HILLER, DO HEREBY CERTIFY THAT I AM A REGISTERED PROFESSIONAL LAND SURVEYOR IN THE STATE OF UTAH IN ACCORDANCE WITH TITLE 58, CHAPTER 22, PROFESSIONAL ENGINEERS AND LAND SURVEYORS ACT; AND THAT I HAVE COMPLETED A SURVEY OF THE PROPERTY DESCRIBED ON THIS PLAT IN ACCORDANCE WITH UTAH CODE SECTION 17-23-17 AND HAVE VERIFIED ALL MEASUREMENTS AND HAVE PLACED MONUMENTS AS REPRESENTED IN THIS PLAT, AND THAT THIS PLAT SUMMIT EDEN RIDGE NESTS-PRUD AMENDED AND RESTATED IN WEBER COUNTY, UTAH, HAS BEEN DRAWN CORRECTLY TO THE DESIGNATED SCALE AND IS A TRUE AND CORRECT REPRESENTATION OF THE HEREON DESCRIBED LANDS INCLUDING SAID SUBDIVISION, BASED UPON DATA COMPILED FROM RECORDS IN THE WEBER COUNTY RECORDER'S OFFICE AND FROM SAID SURVEY MADE BY ME ON THE GROUND. I FURTHER CERTIFY THAT THE REQUIREMENTS OF ALL APPLICABLE STATUTES AND ORDINANCES OF WEBER COUNTY CONCERNING ZONING REQUIREMENTS REGARDING LOT MEASUREMENTS HAVE BEEN COMPLIED WITH.



RICHARD N. HILLER
PROFESSIONAL LAND SURVEYOR
UTAH CERTIFICATE NO. 155641

LEGAL DESCRIPTION

DEVELOPMENT PARCEL B OF THE SUMMIT EDEN PHASE 1B SUBDIVISION, AS RECORDED WITH THE WEBER COUNTY RECORDER, AS ENTRY NO. 2672944 IN BOOK 75 AT PAGES 32 - 34. **Please add the "also described as" (metes and bounds description) as discussed at the 12/9/15 ARC meeting.**

SURVEY NARRATIVE:

1. THIS SURVEY WAS PERFORMED TO AMEND AND RESTATE SUMMIT EDEN RIDGE NEST PRUD AS RECORDED IN THE OFFICE OF THE WEBER COUNTY RECORDER'S OFFICE (ENTRY NUMBER 2672944, BOOK 75, PAGES 43 - 44). THE CHANGES INCLUDE ADDING LIMITED COMMON AREAS, MINOR CHANGES TO THE TYPICAL LOT CONFIGURATION, A MINOR SHIFT OF LOT 5 AND LOT 6, AND REVISIONS TO PLAT NOTES #5, #9, AND #13.
2. THE BASIS OF BEARINGS FOR THIS PLAT IS NORTH 04°55'51" WEST BETWEEN THE NORTHEAST CORNER OF SECTION 7, TOWNSHIP 7 NORTH, RANGE 2 EAST, SALT LAKE BASE AND MERIDIAN AND A FOUND WEBER COUNTY LINE MONUMENT SET BY THE WEBER COUNTY SURVEYOR'S OFFICE. THIS BEARING DIFFERS FROM WEBER COUNTY SURVEYORS BEARING BY 0°00'01" AS SHOWN ON COUNTY LINE DECLARATION RECORDED PLAT BOOK 74, PAGE 64.

PLAT NOTES:

SUMMIT EDEN RIDGE NESTS AMENDED AND RESTATED PLAT NOTES

- THIS PRUD PLAT IS SUBJECT TO THAT CERTAIN NEIGHBORHOOD DECLARATION OR COVENANT, CONDITION, EASEMENT, OR RESTRICTION FOR SUMMIT EDEN RIDGE NESTS ("NEIGHBORHOOD DECLARATION") EXECUTED BY SP14G PHASE I, LLC ("DECLARANT") AS WELL AS THAT CERTAIN MASTER DECLARATION OF COVENANTS, CONDITIONS, EASEMENTS AND RESTRICTIONS FOR SUMMIT EDEN ("MASTER DECLARATION") THAT HAVE BEEN RECORDED IN THE OFFICE OF THE WEBER COUNTY RECORDER WHICH SET FORTH THE RESTRICTIONS AND GENERAL PLAN OF IMPROVEMENT FOR THE PROPERTY DESCRIBED IN THIS PLAT. CERTAIN TERMS NOT OTHERWISE DEFINED IN THIS PLAT SHALL HAVE THE MEANINGS SET FORTH IN THE NEIGHBORHOOD DECLARATION OR MASTER DECLARATION.
- PURSUANT TO THE NEIGHBORHOOD DECLARATION, THE SUMMIT EDEN RIDGE NESTS ASSOCIATION (ASSOCIATION) IS RESPONSIBLE FOR MAINTAINING ALL COMMON AREA, AND SHALL HAVE A PERPETUAL NON-EXCLUSIVE EASEMENT OVER ALL LOTS AND PARCELS FOR SUCH MAINTENANCE PURPOSES AS FURTHER DESCRIBED IN THE NEIGHBORHOOD DECLARATION. SUCH RESPONSIBILITY AND EASEMENT MAY BE DELEGATED AND ASSIGNED TO THE SUMMIT EDEN OWNERS ASSOCIATION, INC., A UTAH NON-PROFIT CORPORATION ("COMMUNITY ASSOCIATION").
- THE PROJECT IS WITHIN DEVELOPMENT PARCEL B OF THE SUMMIT EDEN PHASE 1B SUBDIVISION PLAT ("SUBDIVISION PLAT") AND SUBJECT TO THE NOTES, TERMS AND CONDITIONS OF SUCH PLAT.
- ACCESS TO THE PROJECT IS THROUGH AN EASEMENT OVER THE PRIVATE ROAD AS NOTED ON THE SUBDIVISION PLAT.
- LIMITED COMMON AREAS SHALL MEAN THOSE PARTS OF THE COMMON AREA WHICH ARE LIMITED TO AND RESERVED FOR THE USE OF OWNERS OF ONE OR MORE, BUT FEWER THAN ALL, OF THE LOTS, THE LIMITED COMMON AREAS SHALL INCLUDE ALL COMMON AREAS DESIGNATED AS LIMITED COMMON AREAS ON THE PLAT OR BY THE NEIGHBORHOOD DEVELOPER OR THE NEIGHBORHOOD ASSOCIATION ASSOCIATIONS IN THE NEIGHBORHOOD DECLARATION. LIMITED COMMON AREAS DESIGNATED HEREON ARE APPURTENANT TO THE ADJACENT LOT. NO REFERENCE TO ANY LIMITED COMMON AREAS HEREON IS TO BE MADE IN ANY INSTRUMENT OF CONVEYANCE, ENCUMBRANCE OR OTHER INSTRUMENT. EACH OWNER SHALL BE RESPONSIBLE FOR THE MAINTENANCE, REPAIR AND REPAIR OR IMPROVEMENT OF ANY LIMITED COMMON AREA APPURTENANT TO SUCH OWNER'S LOT AND THE USE THEREOF AS MORE SPECIFICALLY SET FORTH IN THE NEIGHBORHOOD DECLARATION.

PLAT NOTES:

- DECLARANT RESERVES FOR THE BENEFIT OF ITSELF, ITS SUCCESSORS AND ASSIGNS, THE RIGHT TO UNILATERALLY AMEND THE PLAT, WITHOUT THE CONSENT OF THE AFFECTED OWNER, AT ANY TIME AND FROM TIME TO TIME IF SUCH AMENDMENT IS NECESSARY TO SATISFY THE REQUIREMENTS OF ANY GOVERNMENTAL AUTHORITY, TO CORRECT MISTAKES, REMOVE/CLARIFY AMBIGUITIES OR FOR ANY OTHER PURPOSE SO LONG AS SUCH AMENDMENT TO THE PLAT DOES NOT MATERIALLY ADVERSELY AFFECT TITLE TO ANY PROPERTY AND IS IN ACCORDANCE WITH WEBER COUNTY ORDINANCES AND UTAH LAW.
- DECLARANT HEREBY RESERVES FOR THE BENEFIT OF ITSELF, ITS SUCCESSORS AND ASSIGNS, A BLANKET EASEMENT ACROSS ALL COMMON AREA, INCLUDING ALL LIMITED COMMON AREA, FOR CONSTRUCTING AND MAINTAINING HIKING AND BIKING TRAILS ("TRAIL EASEMENT"). THE EXACT LOCATION OF THE TRAILS MAY BE DESIGNATED, ADDED TO, DELETED, OR MODIFIED BY DECLARANT WITHOUT AN AMENDMENT TO THIS PLAT AS MORE FULLY DESCRIBED IN THE NEIGHBORHOOD DECLARATION. DECLARANT HEREBY GRANTS TO THE NEIGHBORHOOD ASSOCIATION, COMMUNITY ASSOCIATION, AND THEIR MEMBERS AN EASEMENT FOR USE AND ENJOYMENT OF THE TRAIL EASEMENT, IN THE AS-CONSTRUCTED LOCATIONS, AS MAY BE MODIFIED OR RELOCATED FROM TIME TO TIME, IN ACCORDANCE WITH ANY RULES AND REGULATIONS ADOPTED BY DECLARANT.
- DECLARANT HEREBY RESERVES FOR THE BENEFIT OF ITSELF, ITS SUCCESSORS AND ASSIGNS, AN EASEMENT ACROSS THE AREA DESIGNATED HEREON AS A SKI EASEMENT FOR CONSTRUCTING AND MAINTAINING SKI TRAILS AND OTHER SKI IMPROVEMENTS ("SKI EASEMENT"). DECLARANT MAY DESIGNATE, DEFINE, LOCATE, RELOCATE, AND MODIFY THE EXACT LOCATION OF THE SKI EASEMENT WITHOUT AN AMENDMENT TO THIS PLAT AS MORE FULLY DESCRIBED IN THE NEIGHBORHOOD DECLARATION. DECLARANT HEREBY GRANTS AN EASEMENT IN FAVOR OF THE NEIGHBORHOOD ASSOCIATION, COMMUNITY ASSOCIATION, AND THEIR MEMBERS FOR USE AND ENJOYMENT OF THE SKI EASEMENT, IN THE AS-CONSTRUCTED LOCATIONS, AS MAY BE MODIFIED OR RELOCATED FROM TIME TO TIME, IN ACCORDANCE WITH ANY RULES AND REGULATIONS ADOPTED BY DECLARANT.
- CERTAIN PARCELS MAY BE DESIGNATED HEREON AS "OPEN SPACE." SUCH OPEN SPACE PARCELS SHALL BE INITIALLY DESIGNATED BY DECLARANT AND ARE NOT PART OF ANY COMMON AREA UNLESS DESIGNATED AS SUCH BY DECLARANT OR CONVEYED BY DECLARANT TO THE NEIGHBORHOOD ASSOCIATION OR COMMUNITY ASSOCIATION. NOTWITHSTANDING THE DESIGNATION AS OPEN SPACE, THE PERMITTED USES AND ANY APPLICABLE RESTRICTIONS FOR SUCH PARCELS SHALL BE AS SET FORTH IN THE NEIGHBORHOOD DECLARATION AND MASTER DECLARATION. DECLARANT RESERVES THE RIGHT TO BUILD FACILITIES AND AMENITIES WITHIN ANY AREA DESIGNATED AS OPEN SPACE, AND RESERVES THE RIGHT TO AMEND, RELOCATE, REDUCE, OR OTHERWISE CHANGE THE AREAS DESIGNATED AS OPEN SPACE SO LONG AS THE AMOUNT OF DESIGNATED OPEN SPACE FOR THE ENTIRE COMMUNITY COMPLIES WITH THE OPEN SPACE REQUIREMENTS IMPOSED BY WEBER COUNTY.
- DECLARANT GIVES NOTICE THAT THE LOTS SHOWN FALLING ARE IN A SKI REPORT AREA ("SKI REPORT") IN WHICH HEAVY SNOW FELLING WIND PATTERNS, AND OTHER CONDITIONS HAVE THE POTENTIAL TO CAUSE AVALARANCHES IN CERTAIN AREAS. NO STUDIES HAVE BEEN CONDUCTED TO DETERMINE WHETHER ANY BUILDING OR DEVELOPMENT SHOULD BE CONSIDERED IN THESE AREAS. THE POTENTIAL AVALARANCH INFLUENCE AND AVALARANCH CONTROL ZONES. CERTAIN AREAS WITHIN THE SKI REPORT MAY BE SUBJECT TO AVALARANCH CONTROLS BY THE STATE OF UTAH AND SKI REPORT CONTROL PROCEDURES MAY INVOLVE THE USE OF EXPLOSIVE CHARGES AND MAY TRIGGER AVALARANCHES AS WELL AS OCCASIONAL ROAD, DRIVEWAY, AND SKI TRAIL CLOSURES. DECLARANT MAKES NO REPRESENTATION WITH RESPECT TO THE OPERATIONS OF THE SKI REPORT OR THE POTENTIAL RISKS OR HAZARDS ASSOCIATED WITH AVALARANCHES OR AVALARANCH CONTROL. EACH OWNER OF A LOT SHOULD CONDUCT ITS OWN STUDIES PRIOR TO CONSTRUCTING ANY IMPROVEMENTS ON A LOT.
- ALL LOTS AS DEPICTED ON THIS PLAT ARE LOCATED IN A LIGHTLY DEVELOPED BETH-HILDENESS AREA CONTAINING ANIMALS TYPICALLY FOUND IN THE MOUNTAIN REGION INCLUDING BUT NOT LIMITED TO BEARS, MOUNTAIN LIONS, MOOSE, DEER, ELK, SKUNKS, SKURRELS, RACCOONS, AND OTHER ANIMALS, BIRDS, INSECTS, AND REPTILES NATIVE OR MIGRATORY TO THE AREA. SUCH ANIMALS ROAM FREELY AND MAY ENTER THE LOTS AND OTHERS PRIVATELY OWNED PROPERTIES, SCAVENGING, EATING AND DAMAGING PLANTS, FLOOD DAMAGES, AND CREATING POTENTIAL HAZARDS, NUISANCES AND DAMAGE TO PERSONS AND PROPERTY. EACH OWNER SHALL ASSUME ALL SUCH RISKS AND CONDITIONS FOR ANY SUCH DAMAGE.
- DUE TO THE TOPOGRAPHY AND THE LOCATION OF THIS PRUD, THE NEIGHBORHOOD ASSOCIATION WILL ACCEPT RESPONSIBILITY FOR ANY STORM WATER RUNOFF FROM THE ROAD ADJACENT TO THIS PROPERTY UNTIL CURB AND GUTTER IS INSTALLED.
- THE NEIGHBORHOOD DECLARATION AND MASTER DECLARATION SET FORTH THE TERMS AND RESTRICTIONS FOR NIGHTLY RENTALS AND LEASING OF LOTS IN THE PROJECT.
- ACCESS TO THE PROJECT IS BY WAY OF A STATE HIGHWAY MAINTAINED BY THE UTAH DEPARTMENT OF TRANSPORTATION, PUBLIC ROADS, AS WELL AS PRIVATE ROADS. SEVERE WEATHER CONDITIONS MAY MAKE CERTAIN ROADS IMPASSABLE OR SUBJECT TO REDUCED VISIBILITY, SNOW, ICE, AND OTHER RISKS THAT MAY BE DANGEROUS TO CERTAIN PERIODS.
- THIS PLAT DOES NOT AMEND ANY WEBER COUNTY ORDINANCES. IN THE EVENT OF A CONFLICT BETWEEN THIS PLAT AND WEBER COUNTY ORDINANCES, THE WEBER COUNTY ORDINANCES SHALL CONTROL.
- THIS PLAT AMENDS IN ITS ENTIRETY, RESTATES, SUPERSEDES AND REPLACES THE SUMMIT EDEN RIDGE NESTS PRUD PLAT RECORDED ON JANUARY 27, 2014 IN THE OFFICIAL RECORDS OF WEBER COUNTY AS ENTRY NO. 2672949.

Remove the "@"
OWNER'S DEDICATION:

SP14G PHASE I, LLC, DECLARANT AS THE OWNER OF THE HEREIN DESCRIBED TRACT OF LAND, DOES HEREBY SET APART AND SUBDIVIDE THE SAME INTO LOTS AND COMMON AREA AS SHOWN HEREON, SUBJECT TO ALL OF THE RESTRICTIONS, RIGHTS AND LIMITATIONS SET FORTH IN THE PLAT NOTES, AND NAME SAID TRACT, TO BE KNOWN AS SUMMIT EDEN RIDGE NESTS, AND DOES HEREBY:

- PUBLIC UTILITY AND DRAINAGE EASEMENTS. GRANT AND DEDICATE A PERPETUAL RIGHT AND EASEMENT OVER, UPON AND UNDER THE LANDS DESIGNATED HEREOF AS PUBLIC UTILITY, STORM WATER DETENTION PONDS AND DRAINAGE EASEMENTS, THE SAME TO BE USED FOR THE INSTALLATION MAINTENANCE AND OPERATION OF PUBLIC UTILITY SERVICE LINE, STORM DRAINAGE FACILITIES, OR FOR THE PERPETUAL PRESERVATION OF WATER CHANNELS IN THEIR NATURAL STATE WHICHEVER IS APPLICABLE AS MAY BE AUTHORIZED BY THE GOVERNING AUTHORITY, WITH NO BUILDINGS OR STRUCTURES BEING ERRECTED WITHIN SUCH EASEMENTS.
- PRIVATE EASEMENTS. GRANT AND DEDICATE THOSE CERTAIN EASEMENTS DESCRIBED IN NOTES 4, 15, AND 14 ON THIS PLAT. SUCH NOTES AND THE RESERVATION AND GRANT OF EASEMENTS DESCRIBED THEREIN ARE INCORPORATED HEREBY BY REFERENCE.

IN WITNESS WHEREOF, DECLARANT HAS EXECUTED THIS OWNER'S DEDICATION AS OF THE _____ DAY OF _____ 2015.

SP14G PHASE I, LLC, A DELAWARE LIMITED LIABILITY COMPANY
BY: SP14G PHASE I, LLC, A DELAWARE LIMITED LIABILITY COMPANY

BY: JEFFREY HERBELON
TITLE: AUTHORIZED SIGNATORY
Add all ownership to the Owner's Dedication and a signature and acknowledgment blocks for owners of Lots 3 & 4 per Title report & Weber County Recorder's records as required in LUC §106-1-5-(b)(1)(h)
ACKNOWLEDGEMENT:
STATE OF UTAH, COUNTY OF _____, S.S.

THE FOREGOING INSTRUMENT WAS ACKNOWLEDGED BEFORE ME THIS _____ DAY OF _____ 2015 BY JEFFREY HERBELON, THE AUTHORIZED SIGNATORY FOR SP14G PHASE I, LLC.

NOTARY PUBLIC
MY COMMISSION EXPIRES:
RESIDING IN: _____



Please add the following information per LUC §106-1-5(a)(4): The individual or company names and addresses of the subdivider.

*add "Attest" & "Title" to County Commission Block
Sheet 1 of 2

SUMMIT EDEN RIDGE NEST PRUD AMENDED AND RESTATED

LOCATED IN THE SOUTH 1/2 OF SECTIONS 5 & 6,
TOWNSHIP 7 NORTH, RANGE 2 EAST, SALT LAKE
BASE AND MERIDIAN, WEBER COUNTY, UTAH

WEBER COUNTY ATTORNEY
I HAVE EXAMINED THE FINANCIAL GUARANTEE AND OTHER DOCUMENTS ASSOCIATED WITH THIS SUBDIVISION PLAT AND IN MY OPINION THEY CONFORM WITH THE COUNTY ORDINANCE APPLICABLE THERETO AND NOW IN FORCE AND AFFECT.
SIGNED THIS _____ DAY OF _____, 20____

WEBER COUNTY SURVEYOR
I HEREBY CERTIFY THAT THE WEBER COUNTY SURVEYOR'S OFFICE HAS REVIEWED THIS PLAT FOR MATHEMATICAL CORRECTNESS, SECTION CORNER DATA AND FOR HARMONY WITH LINES AND MONUMENTS ON RECORD IN THE OFFICE OF THE WEBER COUNTY SURVEYOR'S OFFICE. IF THE WEBER COUNTY SURVEYOR DOES NOT BELIEVE THE LICENSED LAND SURVEYOR WHO EXECUTED THIS PLAT FROM RESPONSIBILITIES AND/OR LIABILITIES ASSOCIATED THERETHIN, SIGNED THIS _____ DAY OF _____, 20____

WEBER COUNTY ENGINEER
I HEREBY CERTIFY THAT THE REQUIRED PUBLIC IMPROVEMENT STANDARDS AND DRAWINGS FOR THIS SUBDIVISION CONFORM WITH COUNTY STANDARDS AND THE APPLICABLE FINANCIAL GUARANTEE IS SUFFICIENT FOR THE INSTALLATION OF THESE IMPROVEMENTS.
SIGNED THIS _____ DAY OF _____, 20____

WEBER COUNTY PLANNING/COMMISSION APPROVAL
THIS IS TO CERTIFY THAT THIS SUBDIVISION PLAT WAS FULLY APPROVED BY THE WEBER COUNTY PLANNING COMMISSION ON THE DAY OF _____, 20____
CHAIRMAN-WEBER COUNTY PLANNING COMMISSION
ASSESS
TITLE

WEBER COUNTY COMMISSION ACCEPTANCE
THIS IS TO CERTIFY THAT THIS SUBDIVISION PLAT, THE DEDICATION OF STREETS AND OTHER PUBLIC WAYS AND FINANCIAL GUARANTEE OF PUBLIC IMPROVEMENTS, IN ACCORDANCE WITH AN INTERLOCAL AGREEMENT BETWEEN WEBER COUNTY AND CACHE COUNTY, ENTRY #2673651, RECORDED 28 MAY 2013, ASSOCIATED WITH THIS SUBDIVISION THEREON ARE HEREBY APPROVED AND ACCEPTED BY THE COMMISSIONERS OF WEBER COUNTY, UTAH
THIS _____ DAY OF _____, 20____
CHAIRMAN, WEBER COUNTY COMMISSION

CACHE RECORDED #
STATE OF UTAH, COUNTY OF CACHE,
RECORDED AND FILED AT THE
REQUEST OF:
ENTRY NO. _____
DATE: _____ TITLE: _____
BOOK: _____ PAGE: _____
FILE # _____
CACHE COUNTY RECORDER
WEBER RECORDED #
STATE OF UTAH, COUNTY OF WEBER,
RECORDED AND FILED AT THE
REQUEST OF:
ENTRY NO. _____
DATE: _____ TITLE: _____
BOOK: _____ PAGE: _____
FILE # _____
WEBER COUNTY RECORDER

SUMMIT EDEN RIDGE NESTS - PRUD AMENDED AND RESTATED

A PART OF SUMMIT EDEN PHASE 1B SUBDIVISION, LOCATED IN THE SOUTH 1/2 OF SECTIONS 5 & 6,
TOWNSHIP 7 NORTH, RANGE 2 EAST, SALT LAKE BASE AND MERIDIAN
SEPTEMBER 2015

FOUND WEBER COUNTY LINE MONUMENT PER WEBER COUNTY SURVEYOR 2013, GOOD CONDITION

(N 84°56'05" W 1360.98' RECORD)
BASIS OF BEARINGS
N 84°55'51" W 1361.07'

S 0°23'40" W 2676.58'

SOUTH 1090.71' (TIE)

NORTHEAST CORNER SECTION 6, TOWNSHIP 7 NORTH, RANGE 2 EAST SALT LAKE BASE AND MERIDIAN FOUND 1944 GLO BRASS CAP, GOOD CONDITION (CLOSING CORNER 17.68' SOUTH)

EAST QUARTER CORNER SECTION 6, TOWNSHIP 7 NORTH, RANGE 2 EAST SALT LAKE BASE AND MERIDIAN FOUND 1944 GLO BRASS CAP, GOOD CONDITION

WEST 150.96' (TIE)

POINT OF BEGINNING

LINE	LENGTH	DIRECTION
L1	22.04'	S 82°44'56" W
L2	49.03'	S 60°09'33" W
L3	60.24'	S 50°09'24" W
L4	67.41'	S 62°27'14" W
L5	78.15'	N 86°21'42" W
L6	105.46'	N 84°28'01" W
L7	23.37'	N 67°56'24" W
L8	114.11'	S 84°28'01" E
L9	247.63'	S 86°21'42" E
L10	33.00'	N 3°36'18" E
L11	165.11'	N 86°21'42" W
L12	67.41'	N 62°27'14" E
L13	40.24'	N 50°09'24" E
L14	49.03'	N 60°09'33" E
L15	71.93'	N 82°44'56" E
L16	13.97'	S 86°28'04" E

LOT #	ACRES	SQFT
1	0.033	1419.95
2	0.033	1419.95
3	0.033	1419.95
Please add the "Area Table" that was part of the original plat identifying the overall area in Weber & Cache County

STALLS	TYPE
15	STANDARD
1	HANDICAPPED
16	TOTAL

CURVE #	LENGTH	RADIUS	DELTA	CHORD LENGTH	CHORD BEARING
C1	108.42'	275.00'	22°39'23"	107.72'	S37°27'14"W
C2	48.00'	275.00'	10°00'04"	47.14'	S55°09'31"W
C3	48.24'	225.00'	12°17'48"	48.19'	S56°18'22"W
C4	136.58'	145.00'	53°58'12"	131.84'	S35°28'08"W
C5	44.94'	30.00'	85°09'14"	40.60'	S51°03'42"W
C6	98.91'	2490.74'	1°53'41"	98.90'	N85°24'51"W
C7	2.25'	2490.74'	0°02'38"	2.25'	N84°29'18"W
C8	100.00'	3023.74'	1°53'41"	100.00'	S85°24'51"E
C9	123.18'	120.00'	58°48'56"	117.85'	S33°02'46"W
C10	53.65'	250.00'	12°17'45"	53.55'	N86°16'22"E
C12	43.64'	250.00'	10°00'04"	43.58'	S55°09'31"W
C13	48.67'	250.00'	22°39'23"	47.93'	S71°27'14"W


ADJACENT OWNER:
SUMMIT MOUNTAIN HOLDING GROUP
16-001-0009

WATER AND SEWER EASEMENT
SUMMIT MOUNTAIN HOLDING GROUP LLC, TO
POWDER MOUNTAIN WATER AND SEWER DISTRICT,
RECORDED IN THE OFFICE OF THE WEBER COUNTY
RECORDER ENTRY NO. 2472964, JANUARY 27, 2014

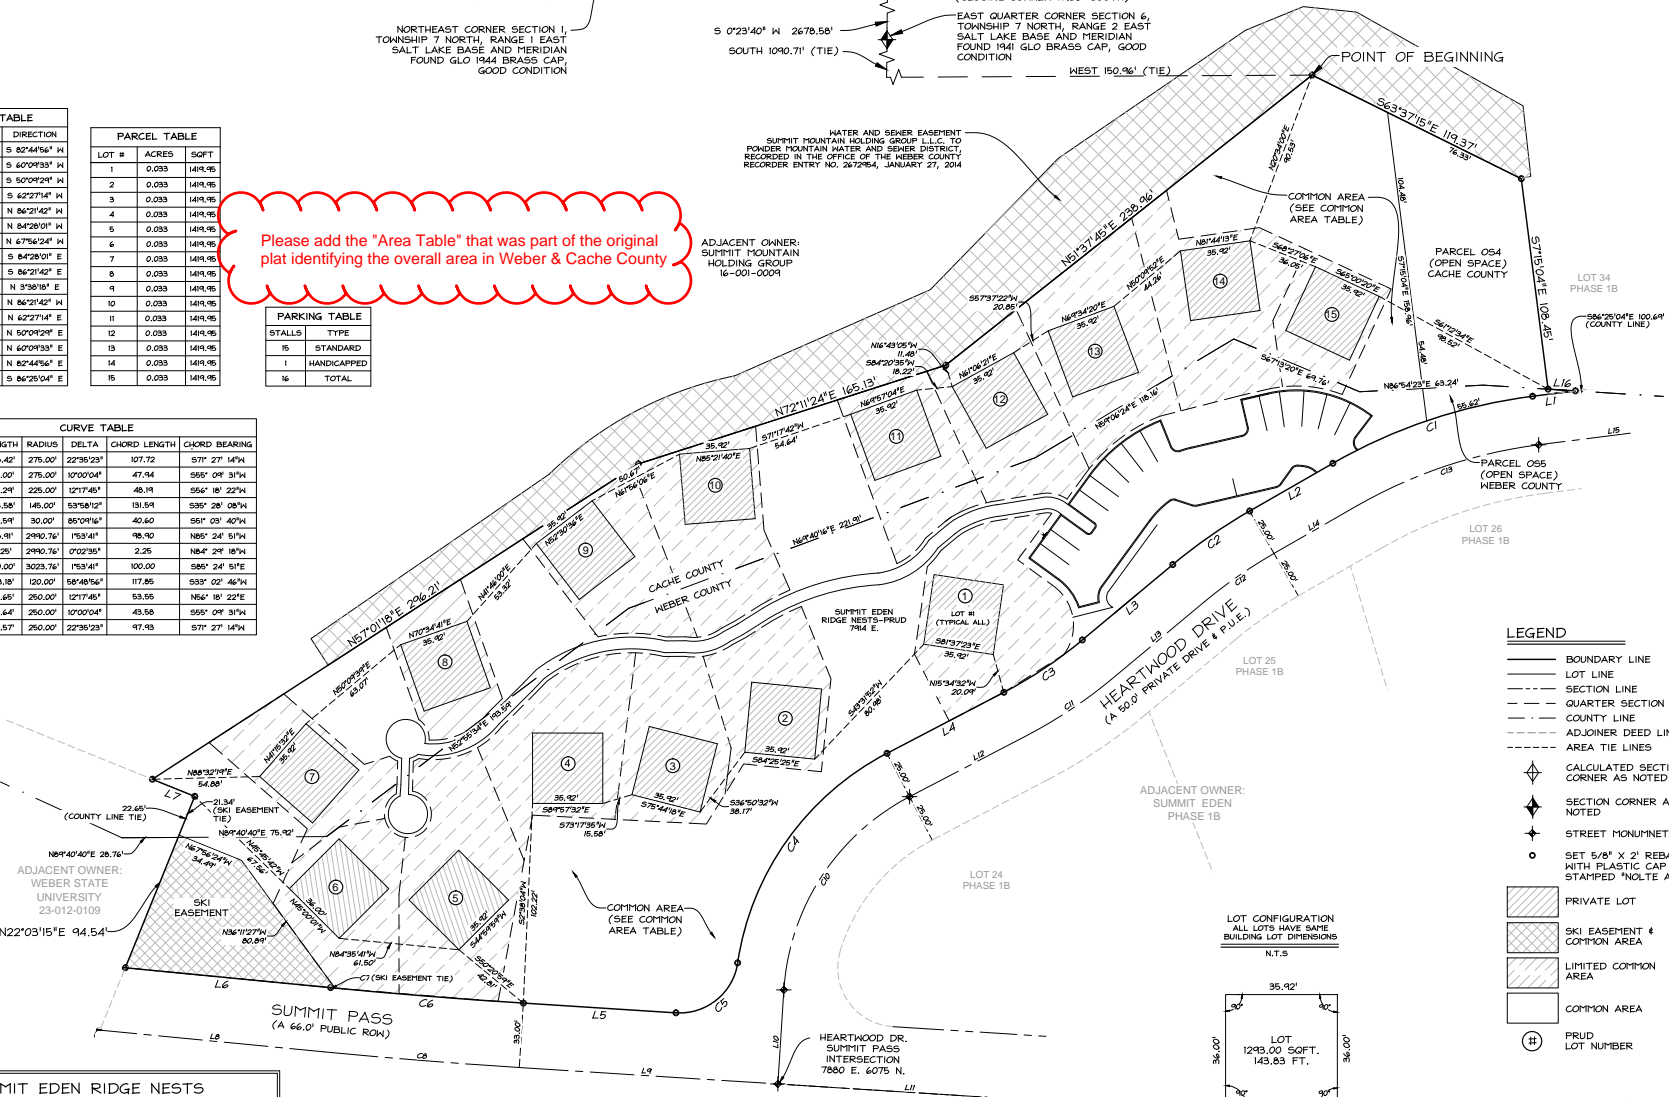

LEGEND

- BOUNDARY LINE
- LOT LINE
- SECTION LINE
- QUARTER SECTION LINE
- COUNTY LINE
- ADJOINER DEED LINES
- AREA TIE LINES
- CALCULATED SECTION CORNER AS NOTED
- SECTION CORNER AS NOTED
- STREET MONUMENT
- SET 5/8" X 2" REBAR WITH PLASTIC CAP STAMPED "NOLTE ASSOC."
- PRIVATE LOT
- SKI EASEMENT & COMMON AREA
- LIMITED COMMON AREA
- COMMON AREA
- PRUD LOT NUMBER

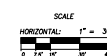


SUMMIT EDEN RIDGE NESTS PRUD AMENDED AND RESTATED

LOCATED IN THE SOUTH 1/2 OF SECTIONS 5 & 6,
TOWNSHIP 7 NORTH, RANGE 2 EAST, SALT LAKE
BASE AND MERIDIAN, WEBER COUNTY, UTAH

COMMON AREA TABLE							
TOTAL ACRES	TOTAL SQFT	COMMON AREA ACRES	COMMON AREA SQFT	LIMITED COMMON AREA ACRES	LIMITED COMMON AREA SQFT	OPEN SPACE AREA ACRES	OPEN SPACE AREA SQFT
3.137	136,654	0.918	40,042	1.533	66,787	0.196	8,525

LOT CONFIGURATION
ALL LOTS HAVE SAME
BUILDING LOT DIMENSIONS
N.T.S.

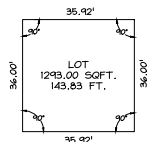

Sheet 2 of 2



CACHE RECORDED #
STATE OF UTAH, COUNTY OF CACHE,
RECORDED AND FILED AT THE
REQUEST OF:
ENTRY NO. _____
DATE: _____ TIME: _____
BOOK: _____ PAGE: _____
FEE \$ _____
CACHE COUNTY RECORDER

WEBER RECORDED #
STATE OF UTAH, COUNTY OF WEBER,
RECORDED AND FILED AT THE
REQUEST OF:
ENTRY NO. _____
DATE: _____ TIME: _____
BOOK: _____ PAGE: _____
FEE \$ _____
WEBER COUNTY RECORDER