
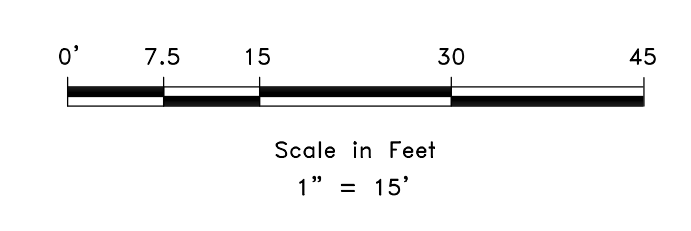
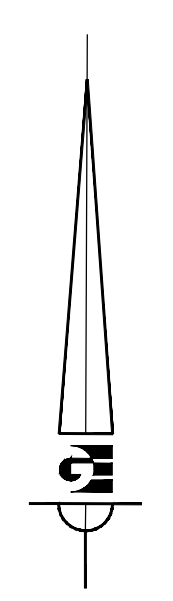
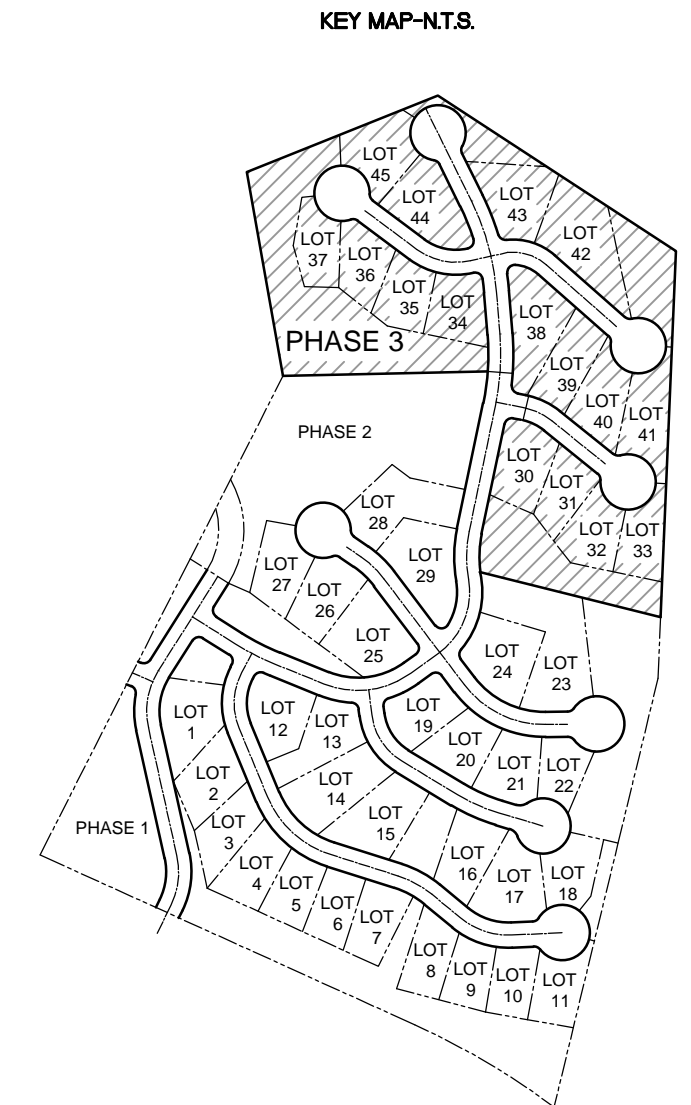


THE RETREAT AT WOLF CREEK
LOT 41
 5447 EAST FRASERS RIDGE DRIVE
 CONTAINING 18,095 SQ. FT.
 BUILDING ENVELOPE 8,747 SQ. FT.

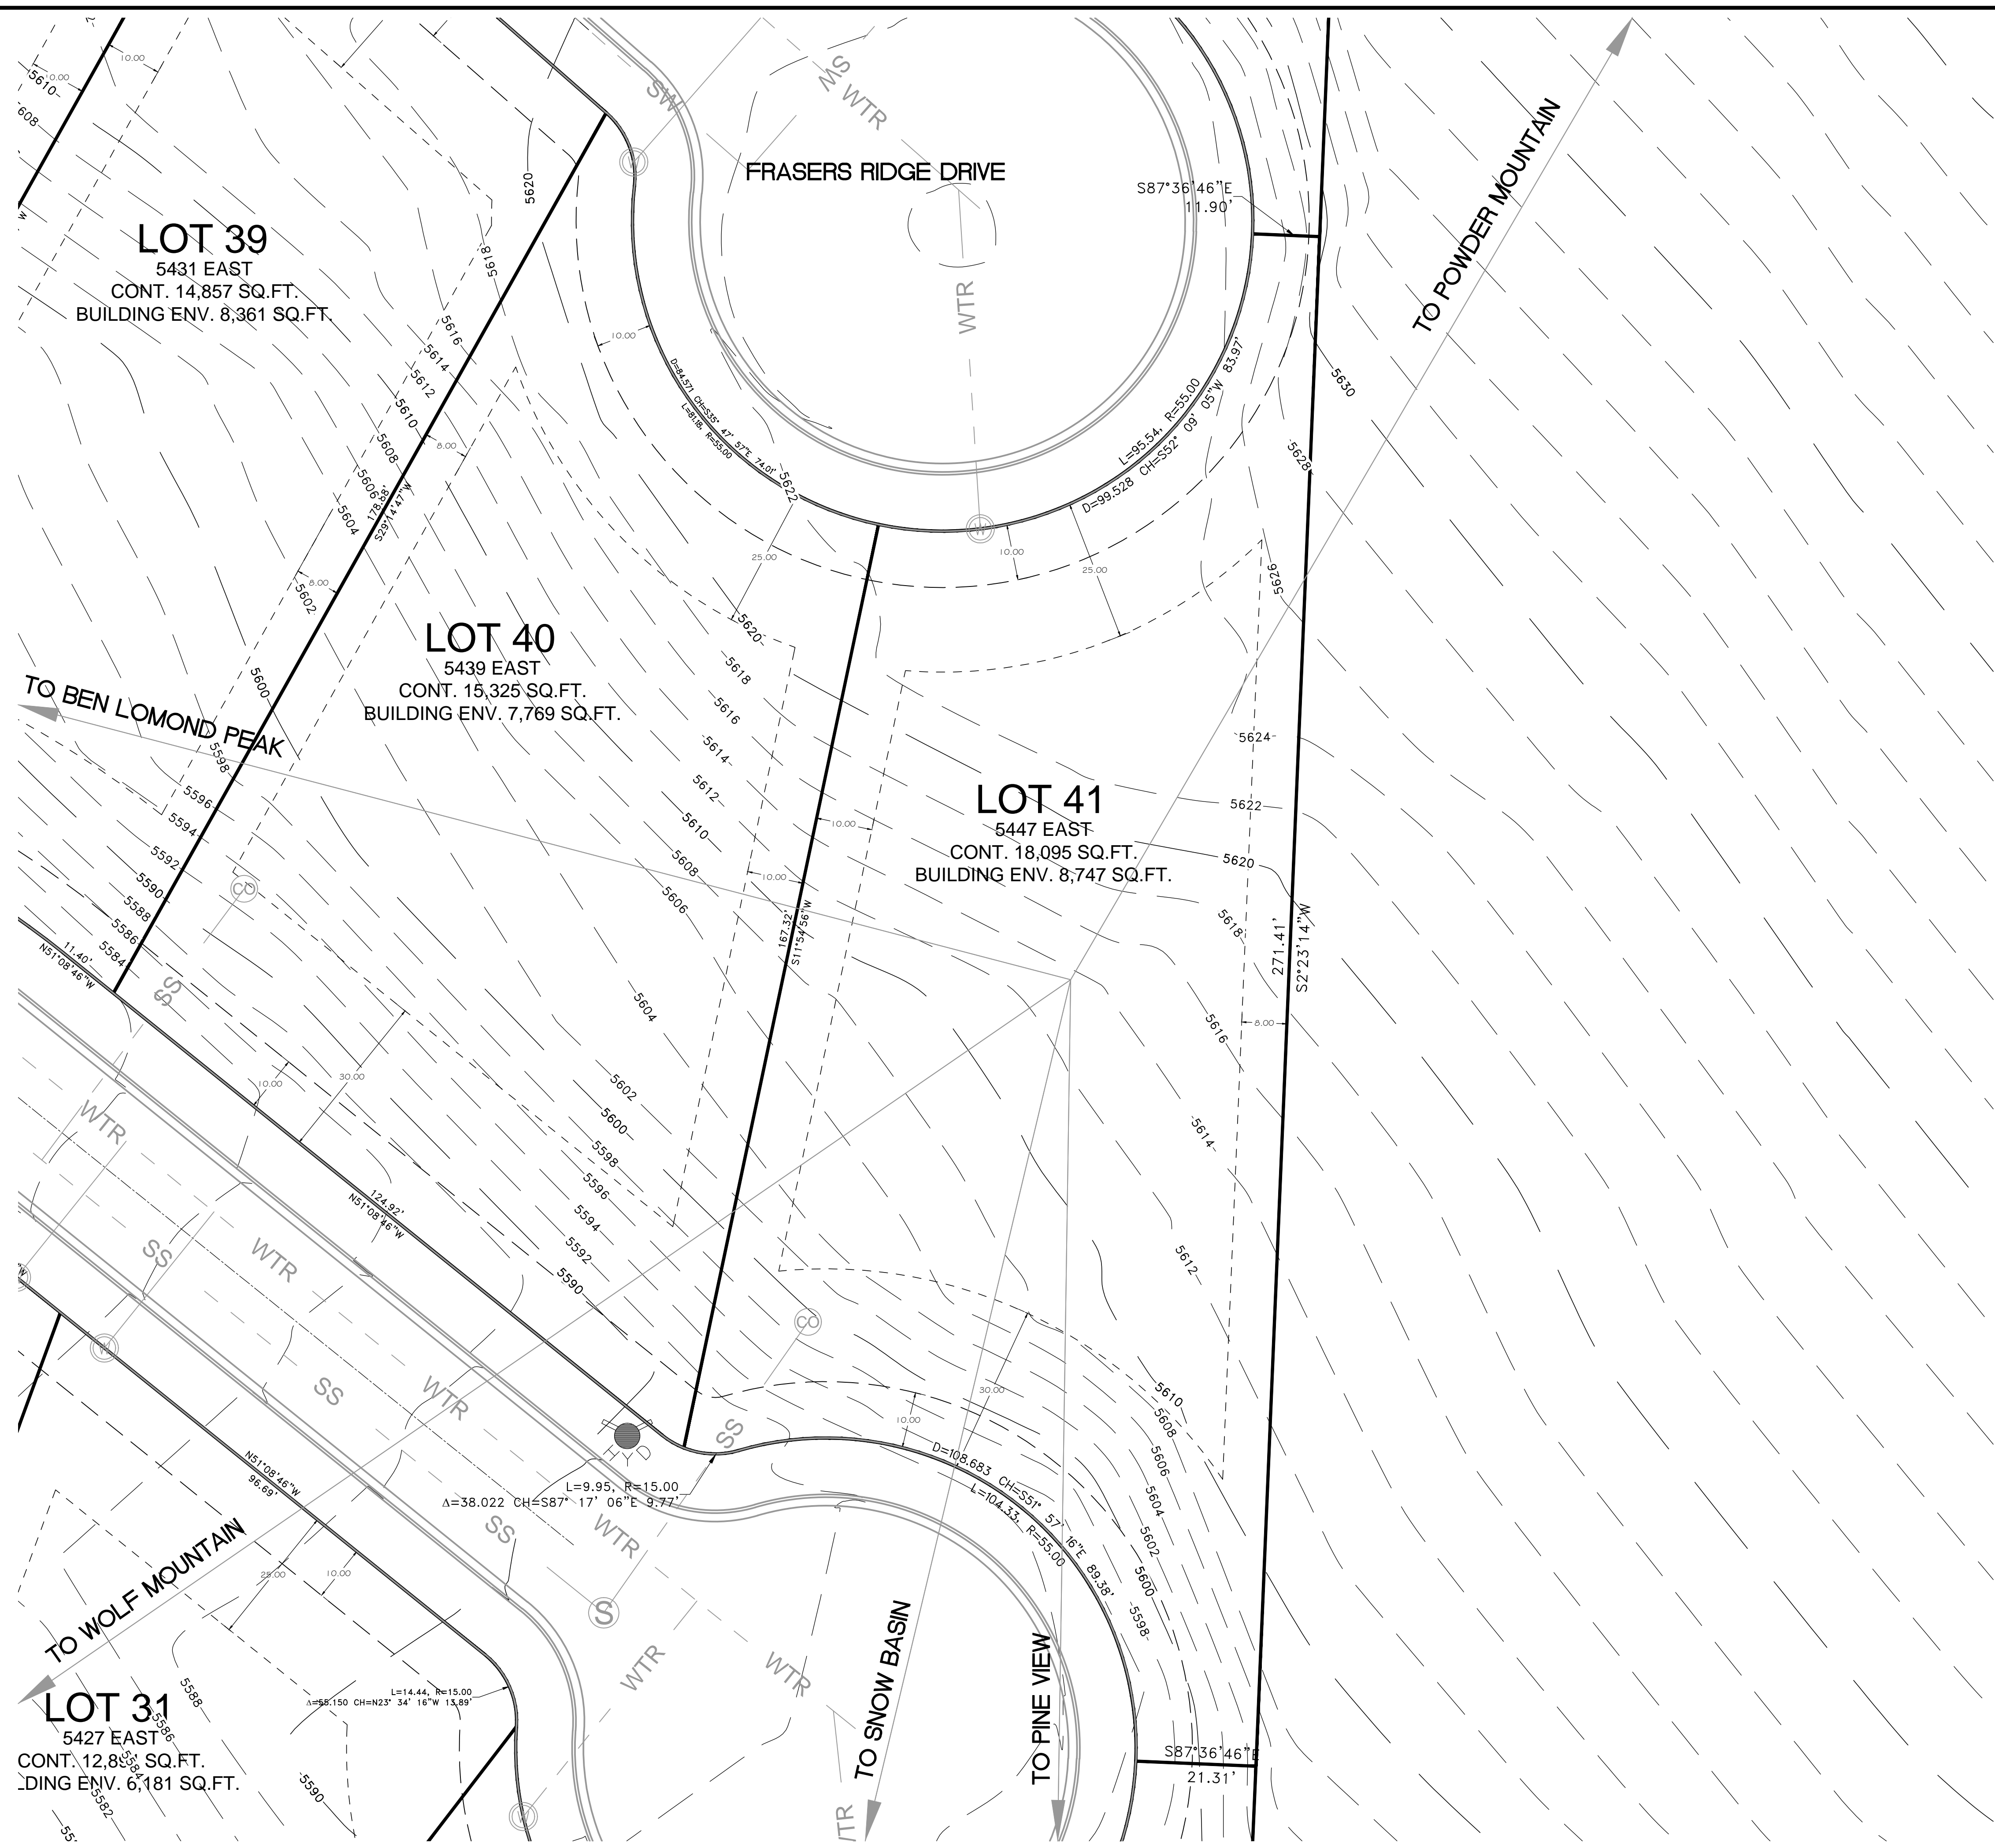

- (R) EXISTING SECONDARY WATER STUB
- (W) EXISTING WATER METER
- (S) EXISTING SEWER STUB
- (SM) EXISTING SEWER MANHOLE
- 10' CONTOUR
- - - 2' CONTOUR
- LOT LINE
- - - EASEMENT LINE
- SETBACK LINE
- EXISTING CURB AND GUTTER
- PLATTED EASEMENT

SCALE	1" = 15'
DATE	2/4/15
DESIGN	
DRAWN	SGP
CHECKED	KHW

REVISIONS	DESCRIPTION
DATE	

AS BUILT TOPOGRAPHY FOR
 LEWIS HOMES
 THE RETREAT AT WOLF CREEK
 PHASE 3, LOT 41

GARDNER ENGINEERING
 CIVIL • LAND PLANNING
 MUNICIPAL • LAND SURVEYING

S1
 1

DWG: R:\1201 - LEWIS HOMES\1201 - THE RETREAT\PHASE 1 AS BUILT\PHASE 3 AS BUILT.DWG