

Ry-Ky Acres Subdivision - 1st Amendment

A part of the Northeast 1/4 of Section 7, T6N, R2E, SLB&M, U.S. Survey

Weber County, Utah

August 2015

SURVEYOR'S CERTIFICATE

I, Andy Hubbard, do hereby certify that I am a Registered Professional Land Surveyor in the State of Utah, and that I hold Certificate No. 6242920 in accordance with Title 58, Chapter 22, of the Professional Engineers and Land Surveyors Licensing Act. I also certify that I have completed a survey of the property described hereon in accordance with Section 17-23-17 and that I have verified all measurements shown hereon this plat of Wright Ry-Ky Acres Subdivision - 1st Amendment in Weber County, Utah and that it has been correctly drawn to the designated scale and is a true and correct representation of the following description of lands included in said subdivision, based on data compiled from records in the Weber County Recorder's Office. Monuments have been found or placed as represented on this plat.

Signed this _____ day of _____, 2015.

6242920

License No.

Andy Hubbard

BOUNDARY DESCRIPTION

All of Lots 2 and 3, Ry-Ky Acres Subdivision, being a part of the Northeast Quarter of Section 7, Township 6 North, Range 2 East, Salt Lake Base and Meridian, U.S. Survey, Weber County, Utah

Beginning at the Southeast corner of Lot 1, Middle Fork Meadows Subdivision, being on the South line of 1000 North Street, and being 271.74 feet North 89°49'00" West along the Section line and 702.23 feet South 0°11'00" West from the North Quarter Corner of said Section 7, and running thence Southerly two (2) courses along the East line of said Ry-Ky Acres Subdivision as follows: (1) South 3°06'34" West 21.32 feet; and (2) South 0°59'42" West 612.06 feet to the Northeast corner of Lot 4, said Ry-Ky Acres Subdivision; thence North 89°49'00" West 655.11 feet along the North line of said Lot 4 to the Northwest corner thereof, being the Easterly line of 7800 East Street; thence North 0°15'10" East 633.29 feet along said Easterly line to said South line of 1000 North Street, being the Southwest corner of said Lot 1, Middle Fork Meadows Subdivision; thence South 89°49'00" East 664.11 feet along the South line of said Lot 1, being said South line of 1000 North Street to the point of beginning.

Contains: 9.584 acres

OWNER'S DEDICATION

We, the undersigned owners of the hereon described tract of land, hereby set apart and subdivide the same into Lots as shown on this plat, and name said tract Wright Ry-Ky Acres Subdivision - 1st Amendment and hereby dedicate, grant and convey to Weber County, Utah, those certain strips as easements for public utility and drainage purposes as shown hereon, the same to be used for the installation, maintenance, and operation of public utility service lines and drainage, as may be authorized by Weber County.

Signed this _____ day of _____, 2015.

Matthew Wright - Owner

Jeffery C. Gay

Patricia J. Gay

ACKNOWLEDGMENT

State of Utah } ss
County of Weber }

The foregoing instrument was acknowledged before me this _____ day of _____, 20____ by _____.

Residing At: _____
Commission Number: _____ A Notary Public commissioned in Utah
Commission Expires: _____
Print Name

ACKNOWLEDGMENT

State of Utah } ss
County of Weber }

The foregoing instrument was acknowledged before me this _____ day of _____, 20____ by _____.

Residing At: _____
Commission Number: _____ A Notary Public commissioned in Utah
Commission Expires: _____
Print Name

NARRATIVE

This survey and subdivision plat were requested by Mrs. Mary Wright for the purpose of Amending the Line between Lots 2 and 3, Ry-Ky Acres Subdivision.
Centerline of 7800 East Street was established by Ry-Ky Acres Subdivision.
A Brass Cap Monument was found for the Northeast Corner of Section 8, and Brass Cap Witness Monuments were found for the North Quarter and Northeast Corner of Section 7, Township 6 North, Range 2 East, Salt Lake Base and Meridian
A line bearing South 88°56'18" East between the Brass Cap Witness Monument for the North Quarter Corner of Section 7 and the Brass Cap Monument for the Northeast Corner of Section 8, was used as the Basis of Bearings for the survey.

WEBER COUNTY PLANNING COMMISSION APPROVAL

This is to certify that this subdivision plat was duly approved by the Weber County Planning Commission.
Signed this _____ day of _____, 2015.

Chairman, Weber County Planning Commission

WEBER COUNTY ATTORNEY

I have examined the financial guarantee and other documents associated with this subdivision plat, and in my opinion they conform with the County Ordinance applicable thereto and now in force and effect.
Signed this _____ day of _____, 2015.


Weber County Attorney

WEBER-MORGAN HEALTH DEPARTMENT

I hereby certify that the soils, percolation rates, and site conditions for this subdivision have been investigated by this office and are approved for on-site wastewater disposal systems.
Signed this _____ day of _____, 2015.

Weber County Surveyor


WEBER COUNTY RECORDER	
ENTRY NO. _____	FEE PAID _____
RECORDED _____	FILED FOR RECORD AND AT _____
IN BOOK _____	OF OFFICIAL RECORDS, PAGE _____
RECORDED FOR _____	
WEBER COUNTY RECORDER	
BY: _____	DEPUTY

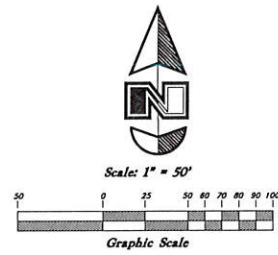

Bobbie D Wicox & Betty D Wicox Revocable Trust

Lot 1 Hubbard Subdivision

Shadow & Jensen LLC, Rural Collector Street

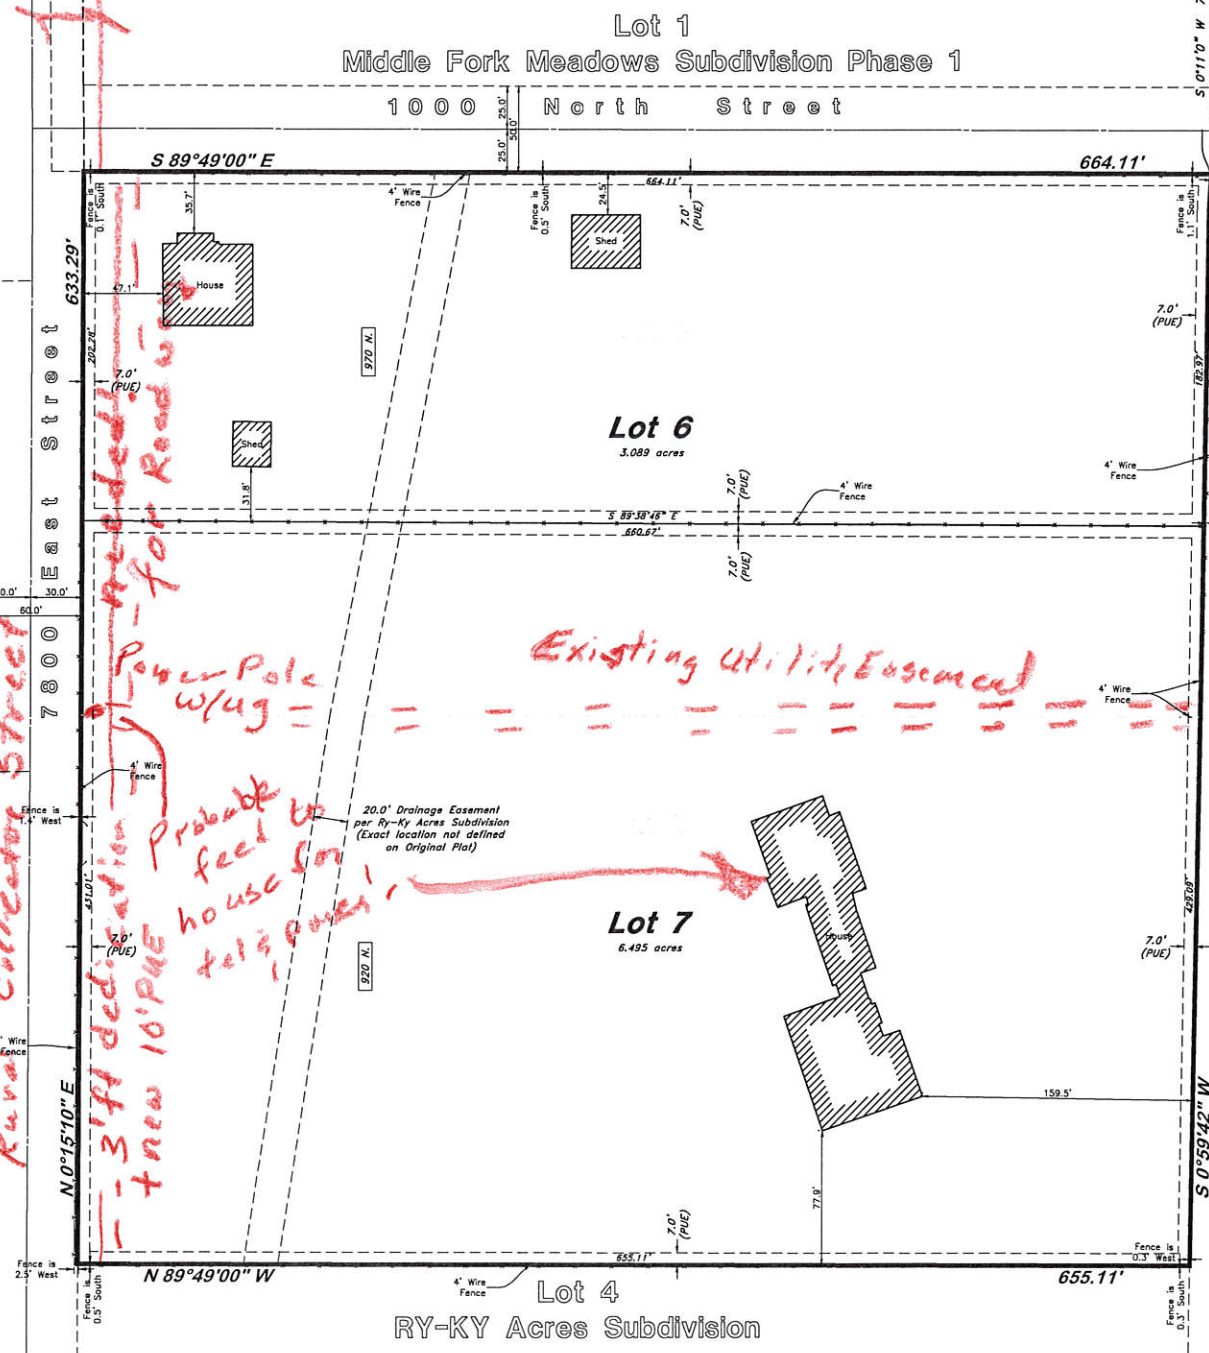

North 1/4 Corner Section 7, T6N, R2E, SLB&M, U.S. Survey (Not Found, Calc. from W.C.S. Tie Sheet)

Witness Corner (Found Brass Cap)

Witness Corner (Found Brass Cap)

Northeast Corner Section 7, T6N, R2E, SLB&M, U.S. Survey (Not Found, Calc. from Middle Fork Meadows Subdivision Plat)

Northeast Corner Section 8, T6N, R2E, SLB&M, U.S. Survey (Found Brass Cap)

Adam & Karen Williams

Witness Corner (Found Brass Cap)

Existing 33 1/2' A

Power Pole w/pug

Probably feed to house for tel & power

31ft dedication

20.0' Drainage Easement per Ry-Ky Acres Subdivision (Exact location not defined on Original Plat)

Existing Utility Easement

DEVELOPER INFORMATION

Mary Wright
1002 N. 7800 E.
Huntsville, UT 84317
(914) 443-1488

WEBER COUNTY ENGINEER

I hereby certify that the required public improvement standards and drawings for this subdivision conform with County standards and the amount of the financial guarantee is sufficient for the installation of these improvements.

Weber County Engineer

WEBER COUNTY COMMISSION ACCEPTANCE

This is to certify that this subdivision plat, the dedication of streets and other public ways and financial guarantee of public improvements associated with this subdivision, thereon are hereby approved and accepted by the commissioners of Weber County, Utah.
Signed this _____ day of _____, 2015.

Chairman, Weber County Commission

Allst: _____
Title: _____

WEBER COUNTY SURVEYOR

I hereby certify that the Weber County Surveyor's Office has reviewed this plat for mathematical correctness, section corner data, and for harmony with lines and monument on record in County Offices. The approval of this plat by the Weber County Surveyor does not relieve the licensed Land Surveyor who executed this plat from the responsibilities and/or liabilities associated therewith.
Signed this _____ day of _____, 2015.

Weber County Surveyor

GREAT BASIN ENGINEERING INC.
5746 SOUTH 1475 EAST OGDEN, UTAH 84403
PH: (801) 224-4515 FAX: (801) 224-4522
WWW.GREATBASINENGINEERING.COM