
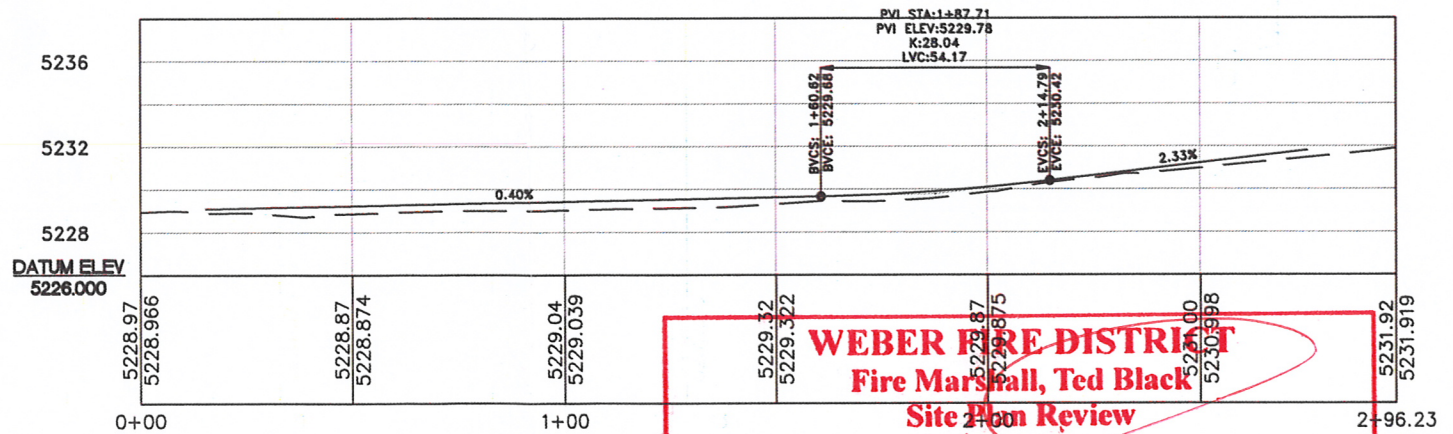


RELOCATE FIRE HYDRANT OR IE
8-23-11

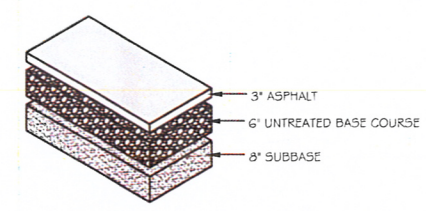


WEBER FIRE DISTRICT
Fire Marshall, Ted Black
Site Plan Review

Reviewed By: *[Signature]*

Code compliance is the responsibility of the owner, contractor, and/or developer. Errors or omissions in this review shall not relieve this responsibility.
This Project: (See review letter)

is feasible
 is feasible with corrections
 is not feasible

Fees Due: *[Signature]* Date: 8-23-11

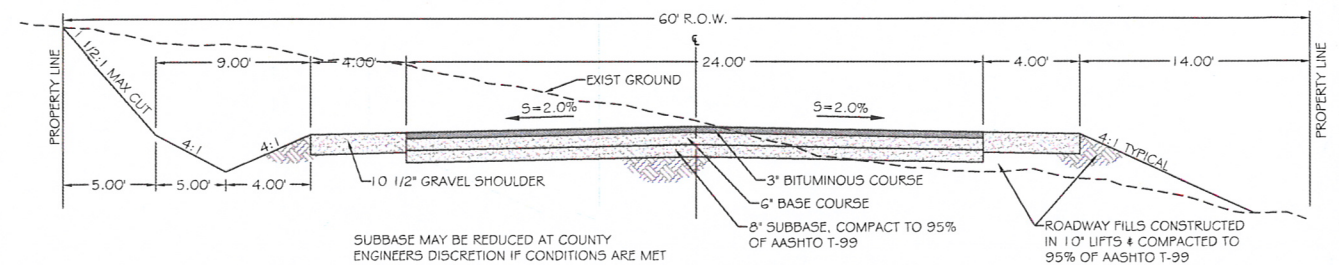

NOTE: ALL CONSTRUCTION TO CONFORM TO WEBER COUNTY STANDARDS AND SPECIFICATIONS.

SCALE: 1" = 20'		DATE: JULY 2011	DESIGN: TMN/SCC	DRAWN: SCC	CHECKED: TMN
REVISIONS	DESCRIPTION	DATE			
VINCE AND ALYSON FELT FELT SUBDIVISION STREET PLAN AND PROFILE WEBER COUNTY, UTAH					
 9875 South Adams Ave., Parkway, Suite 200 • Ogden, UT 84405 Phone (801) 776-0222 • Fax (801) 476-0286					
1		1			

R:\2011 - Misc Surveys\1035 - Fel_Alyson\Engineering\2011_1035_Fel_Subdivision\Plan & Profile\3.dwg, 8/15/2011 4:51:53 PM