

IVY SPRING SUBDIVISION

AMENDING ALL OF LOT 7 AND A PORTION OF LOT 8 OF EASTWOOD SUBDIVISION
PART OF THE SOUTHEAST QUARTER OF SECTION 23, TOWNSHIP 5 NORTH, RANGE 1 WEST, SALT LAKE BASE AND MERIDIAN, U.S. SURVEY
WEBER COUNTY, UTAH
MARCH, 2018

LINE TABLE


LINE	BEARING	DISTANCE
L1	S68°44'51"E	99.86'
L2	N02°17'19"E	34.46'
L3	S75°06'02"E	21.27'
L4	N14°53'58"E	6.00'
L5	N14°53'58"E	6.00'
L6	N75°06'02"W	36.49'
L7	N02°17'19"E	44.11'

OWNER/DEVELOPER

JEROLD AND VALERIE B. IVE
6340 BORG CIRCLE
OGDEN, UT 84403


CURVE TABLE

#	RADIUS	ARC LENGTH	CHD LENGTH	TANGENT	CHD BEARING	DELTA
C1	90.00'	79.31'	76.77'	42.44'	N02°14'53"W	50°29'29"
C2	50.00'	25.99'	25.70'	13.30'	N12°38'09"W	29°46'56"
C3	267.85'	2.11'	2.11'	1.05'	S10°30'09"E	0°27'05"
C4	160.00'	138.00'	133.76'	73.62'	N26°59'49"E	49°24'59"
C5	20.00'	38.04'	32.56'	28.02'	N56°46'14"E	108°57'50"
C6	28.00'	50.15'	43.71'	34.96'	N53°35'39"E	102°36'39"
C7	28.00'	37.82'	35.01'	22.43'	N36°24'21"W	77°23'21"

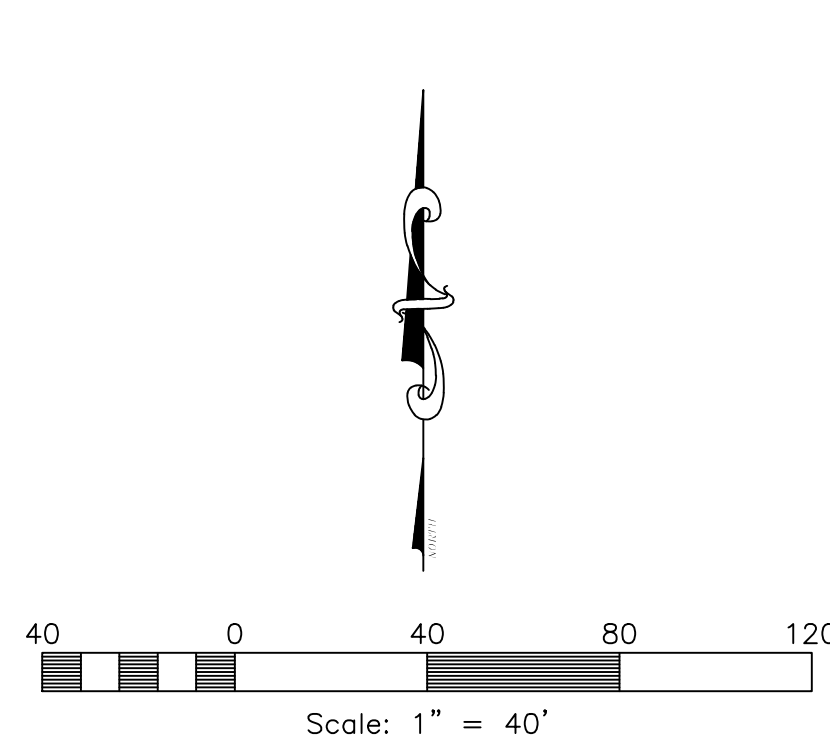

LEGEND

- o — SECTION CORNER
- SET 5/8" X 24" REBAR AND PLASTIC CAP STAMPED "REEVE & ASSOCIATES"
- BOUNDARY LINE
- LOT LINE
- - - - ADJOINING PROPERTY
- - - - EASEMENTS
- - - - SECTION TIE LINE
- ROAD CENTERLINE
- [Hatched Box] = BUILDABLE AREA Area of non-disturbance
- [Dotted Box] = 10' UTILITY EASEMENT
- [Shaded Box] = EXISTING BUILDING
- P.U.E. = PUBLIC UTILITY EASEMENT

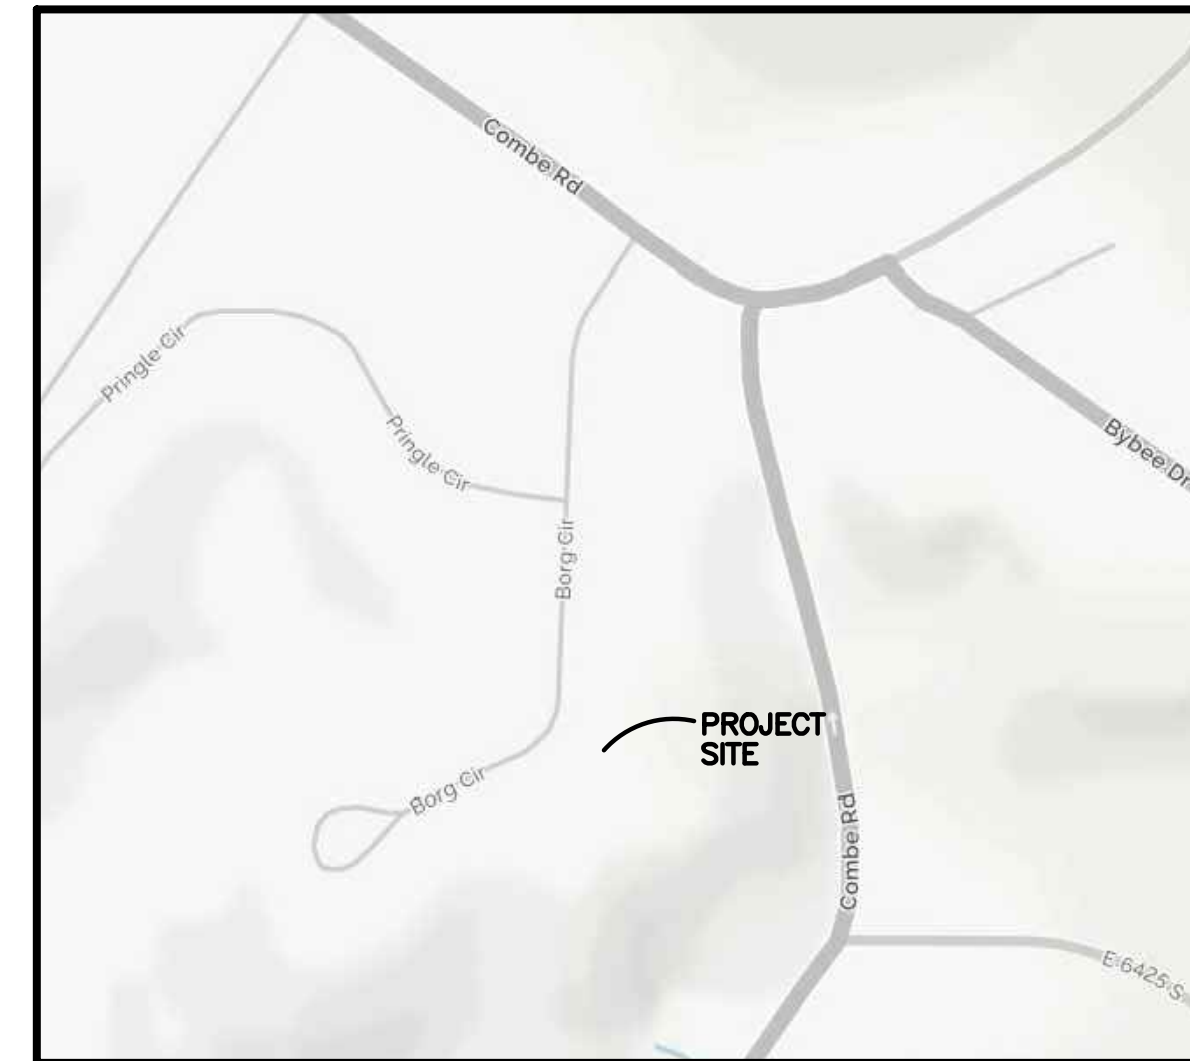

VICINITY MAP

SCALE: NONE

BASIS OF BEARINGS

THE BASIS OF BEARINGS FOR THIS PLAT IS THE SECTION LINE BETWEEN THE SOUTH QUARTER CORNER AND THE SOUTHEAST CORNER OF SECTION 23, TOWNSHIP 5 NORTH, RANGE 1 WEST, SALT LAKE BASE AND MERIDIAN, U.S. SURVEY. SHOWN HEREON AS S89°42'41"E UTAH STATE PLANE NORTH AS PER WEBER COUNTY SURVEY.

NARRATIVE

THE PURPOSE OF THIS PLAT IS TO DIVIDE THE BELOW DESCRIBED PROPERTY INTO A 3 LOT SUBDIVISION AS SHOWN. ALL BOUNDARY AND LOT CORNERS WERE SET WITH A 5/8" X 24" REBAR AND PLASTIC CAP STAMPED "REEVE & ASSOCIATES". BOUNDARY OF LOT 7 OF EASTWOOD SUBDIVISION ROTATED TO MATCH WEBER COUNTY SECTION BEARING SHEETS. THE BOUNDARY WAS DETERMINED BY RETRACING THE ORIGINAL PLAT USING THE SECTION CORNERS SHOWN HEREON. NO ORIGINAL, LOCAL SURVEY MONUMENTS WERE RECOVERED WITHIN THE SUBDIVISION AND THE RECORD TIES TO THE SECTION CORNER MONUMENTS FIT STREET IMPROVEMENTS AND FENCE LINE OCCUPATIONS RELATIVELY WELL IN THIS AREA. THE SOUTH LINE WAS DETERMINED BY A BOUNDARY LINE AGREEMENT RECORDED AS ENTRY NO. _____ NO DIMENSIONS SHOWN ON RECORDED EASTWOOD SUBDIVISION FOR THE 10' UTILITY EASEMENT. EASEMENT PLACED FROM LOCATION OF EXISTING OVERHEAD POWER LINES OBSERVED DURING FIELD SURVEY.

BOUNDARY DESCRIPTION



ALL OF LOT 7 AND A PORTION OF LOT 8 OF EASTWOOD SUBDIVISION BEING MORE PARTICULARLY DESCRIBED AS FOLLOWS:

PART OF THE SOUTHEAST QUARTER OF SECTION 23, TOWNSHIP 5 NORTH, RANGE 1 WEST, SALT LAKE BASE AND MERIDIAN, U.S. SURVEY, DESCRIBED AS FOLLOWS:

BEGINNING AT A POINT ON THE EASTERLY RIGHT OF WAY LINE OF BORG CIRCLE, SAID POINT BEING S89°42'41"E ALONG THE SECTION LINE, 1145.04 FEET AND N00°17'19"E 298.67 FEET FROM THE SOUTH QUARTER CORNER OF SAID SECTION 23; THENCE ALONG SAID EASTERLY RIGHT OF WAY LINE OF BORG CIRCLE THE FOLLOWING TWO (2) COURSES: (1) ALONG A NON-TANGENT CURVE TURNING TO THE LEFT WITH A RADIUS OF 90.00 FEET, AN ARC LENGTH OF 79.31 FEET, A DELTA ANGLE OF 50°29'29", A CHORD BEARING OF N02°14'53"W, A RADIAL BEARING OF N67°00'09"W, AND A CHORD LENGTH OF 76.77 FEET AND (2) ALONG A REVERSE CURVE TURNING TO THE RIGHT WITH A RADIUS OF 50.00 FEET, AN ARC LENGTH OF 25.99 FEET, A DELTA ANGLE OF 29°46'56", A CHORD BEARING OF N12°36'09"W, AND A CHORD LENGTH OF 25.70 FEET TO THE NORTHWEST CORNER OF LOT 7 OF EASTWOOD SUBDIVISION; THENCE S87°42'41"E ALONG THE NORTH LINE OF LOT 7 OF EASTWOOD SUBDIVISION, 378.15 FEET TO THE NORTHEAST CORNER OF LOT 7 OF EASTWOOD SUBDIVISION AND THE WESTERLY RIGHT OF WAY LINE OF COMBE ROAD; THENCE ALONG SAID WESTERLY RIGHT OF WAY LINE OF COMBE ROAD THE FOLLOWING TWO (2) COURSES: (1) S10°43'41"E 250.92 FEET TO THE SOUTHEAST CORNER OF LOT 7 OF EASTWOOD SUBDIVISION AND (2) ALONG A TANGENT CURVE TURNING TO THE RIGHT WITH A RADIUS OF 267.85 FEET, AN ARC LENGTH OF 2.11 FEET, A DELTA ANGLE OF 00°27'05", A CHORD BEARING OF S10°30'09"E, AND A CHORD LENGTH OF 2.11 FEET; THENCE N68°44'51"W ALONG A BOUNDARY LINE AGREEMENT ON AN EXISTING FENCELINE RECORDED AS ENTRY NO. _____ 446.70 FEET TO THE POINT OF BEGINNING.

CONTAINING 66,512 SQUARE FEET OR 1.527 ACRES MORE OR LESS

SOUTHEAST CORNER OF SECTION 23, TOWNSHIP 5 NORTH, RANGE 1 WEST, SALT LAKE BASE AND MERIDIAN, U.S. SURVEY. FOUND 3" WEBER COUNTY BRASS CAP MONUMENT ENCASED IN CONCRETE FLUSH WITH GROUND DATED 1960 IN GOOD CONDITION.

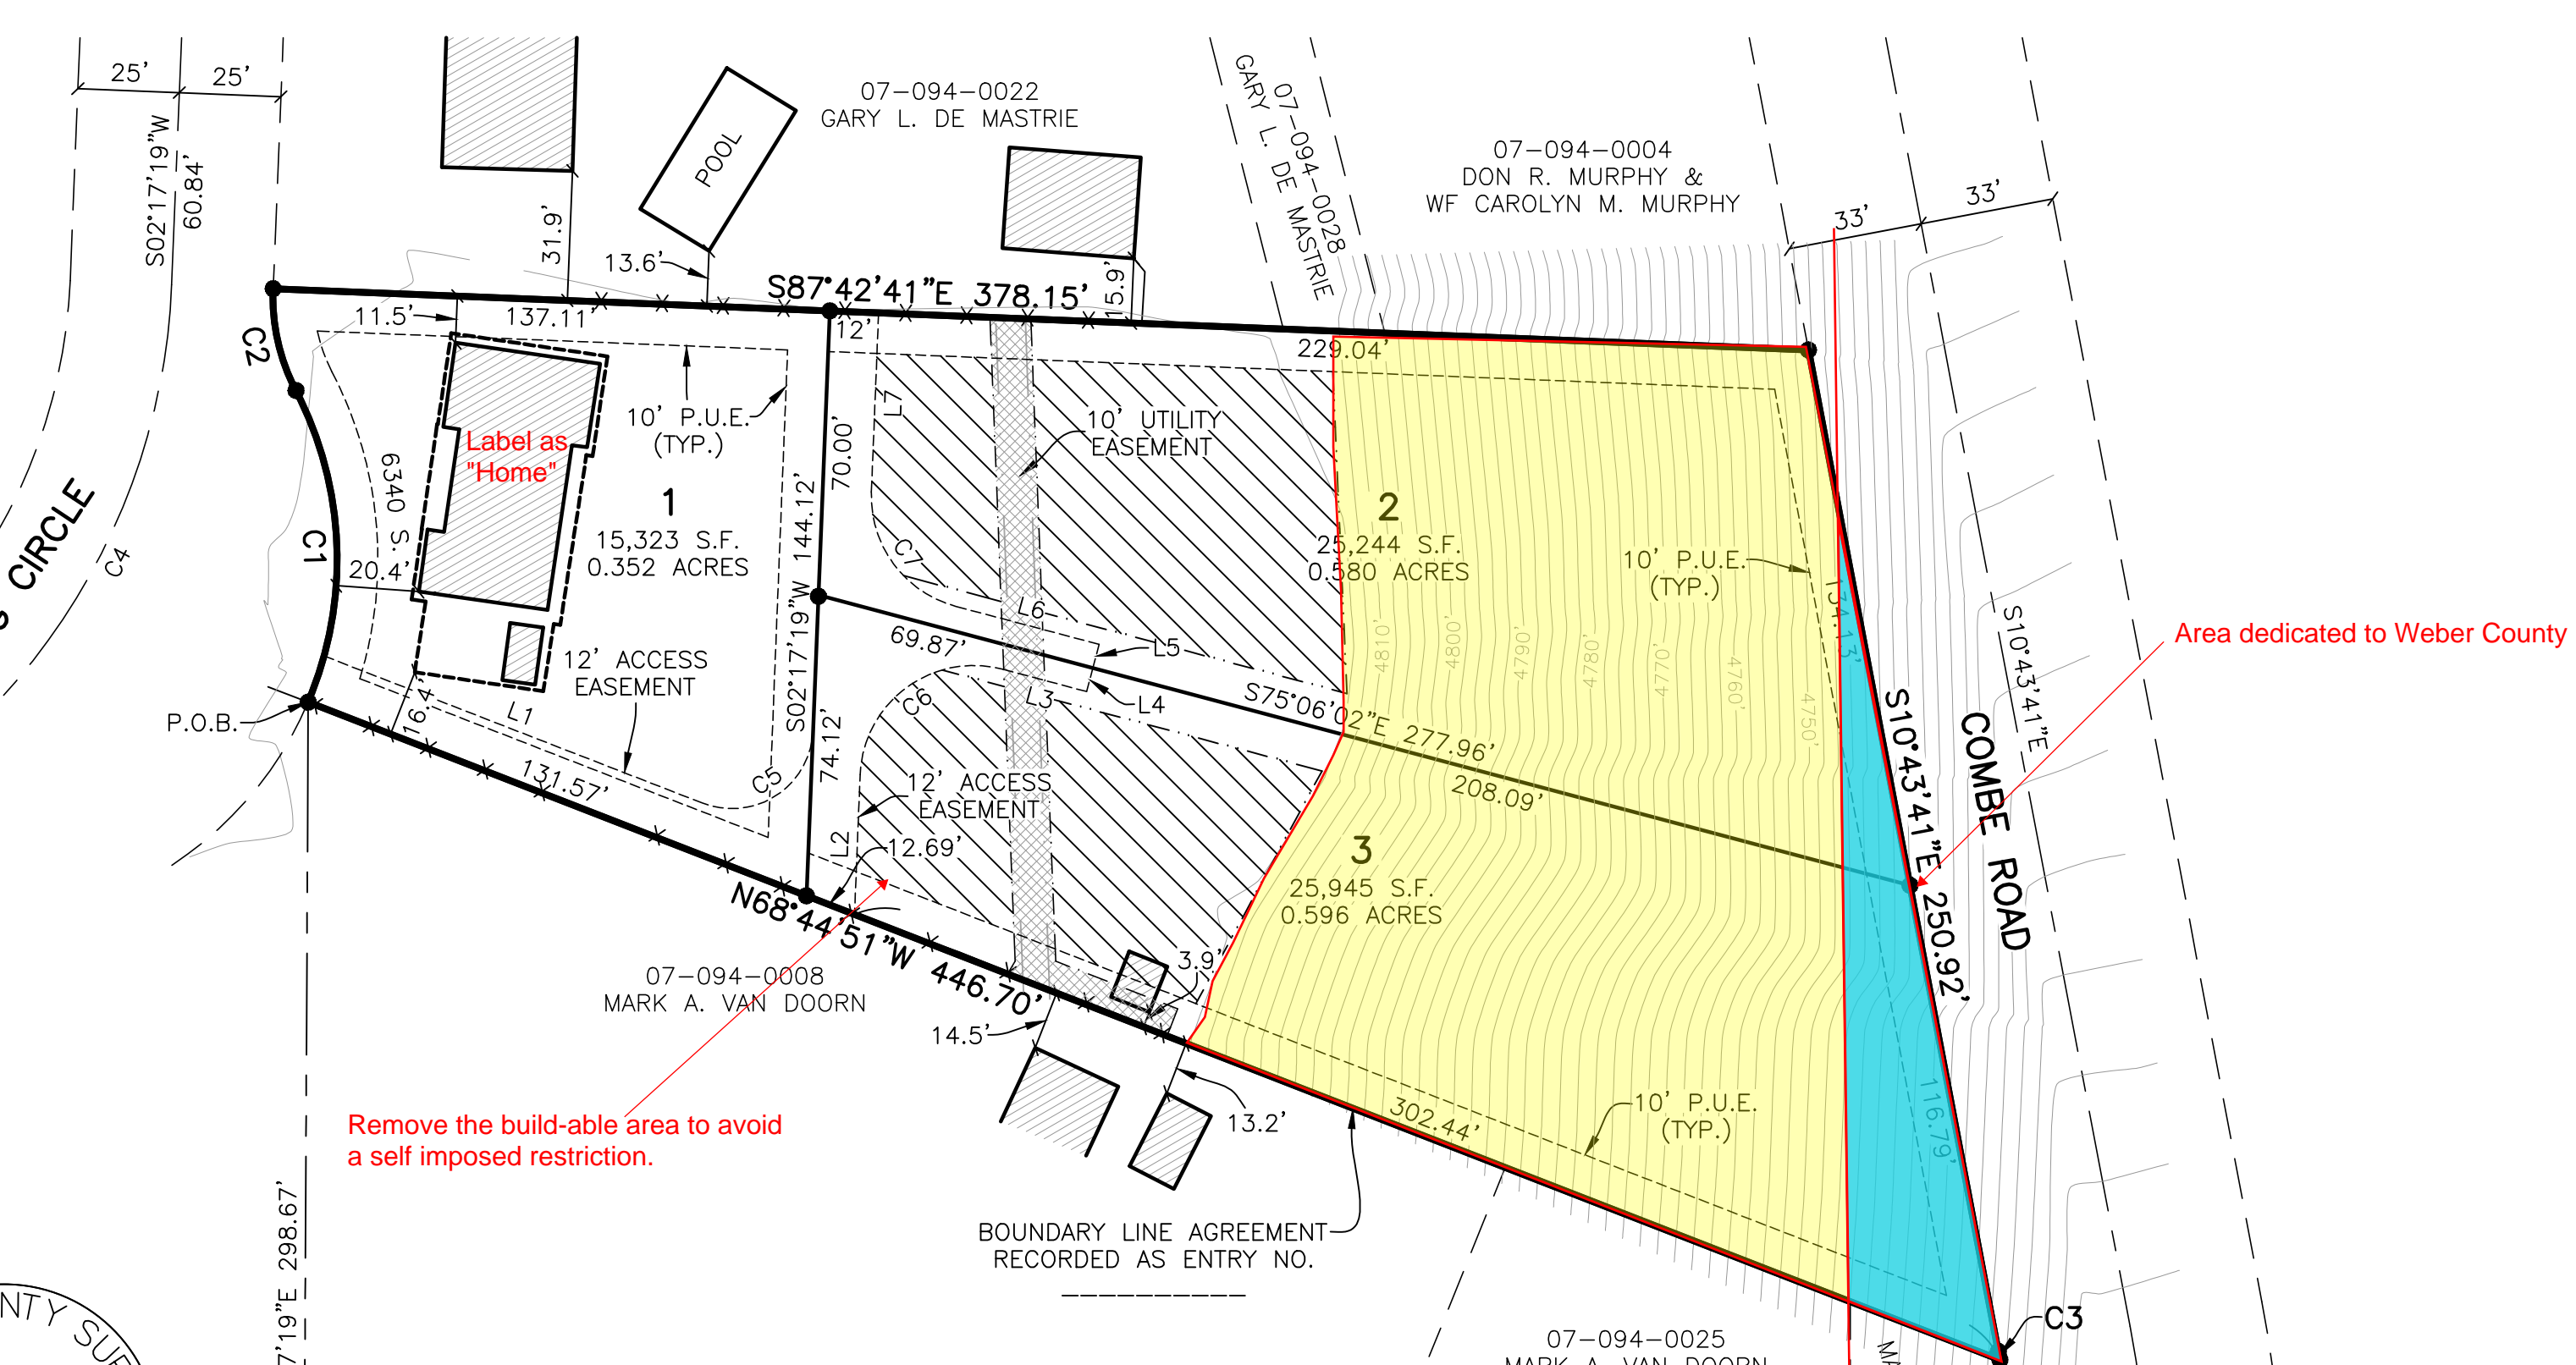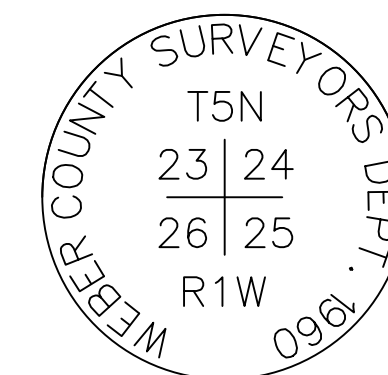

Remove the build-able area to avoid a self imposed restriction.

Area dedicated to Weber County

NOTES


NOTICE TO PURCHASERS OF LOTS WITH DESIGNATED BUILDING AREAS. LOTS WITH DESIGNATED "BUILDING AREAS" HAVE BEEN APPROVED SUBJECT TO THE CONDITION THAT BUILDING DEVELOPMENT SHALL TAKE PLACE ONLY WITHIN SUCH DESIGNATED AREAS.

There is a geologic report available for public review that was prepared by Charles Peyton P.G., C.E.G. Dated February 20, 2018, Job No. 01-18 which designates an area of non-disturbance as found on page 3 of the report. "The eastern portion of the property which is a shrub oak covered slope down to Combe Road should not be planned for any development. It is recommended that a geologic review be made of the excavations to be certain that geologic features observed are not detrimental to home construction."

DUE TO THE TOPOGRAPHY AND THE LOCATION OF THIS SUBDIVISION ALL OWNERS WILL ACCEPT RESPONSIBILITY FOR ANY STORM WATER RUNOFF FROM THE ROAD ADJACENT TO THIS PROPERTY UNTIL CURB AND GUTTER IS INSTALLED.

NO ACCESS THROUGH PROPERTY TO COMBE ROAD

10' UTILITY EASEMENT LOCATION NOT GIVEN ON ORIGINAL SUBDIVISION PLAT. EASEMENT PLACED FRO SCALING.

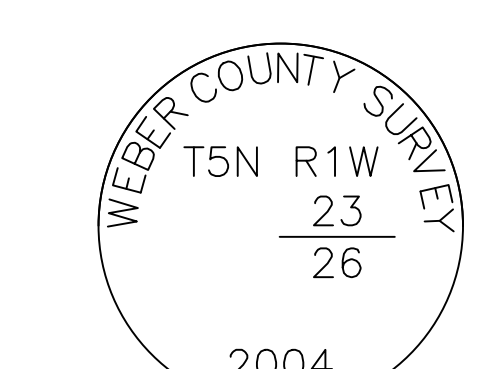

SOUTH QUARTER CORNER OF SECTION 23, TOWNSHIP 5 NORTH, RANGE 1 WEST, SALT LAKE BASE AND MERIDIAN, U.S. SURVEY. FOUND 3" WEBER COUNTY BRASS CAP MONUMENT ENCASED IN CONCRETE BELOW GROUND DATED 2004 IN GOOD CONDITION.

1145.04' S89°42'41"E (BASIS OF BEARINGS) 2592.73' (RECORD) 2592.62' (MEASURED) WEST 2592.73' AS PER RECORDED EASTWOOD SUBDIVISION

SURVEYOR'S CERTIFICATE

I, **TREVOR J. HATCH**, DO HEREBY CERTIFY THAT I AM A PROFESSIONAL LAND SURVEYOR IN THE STATE OF UTAH IN ACCORDANCE WITH TITLE 58, CHAPTER 22, PROFESSIONAL ENGINEERS AND PROFESSIONAL LAND SURVEYORS ACT; AND THAT I HAVE COMPLETED A SURVEY OF THE PROPERTY DESCRIBED ON THIS PLAT IN ACCORDANCE WITH SECTION 17-23-17 AND HAVE VERIFIED ALL MEASUREMENTS, AND HAVE PLACED MONUMENTS AS REPRESENTED ON THIS PLAT, AND THAT THIS PLAT OF **IVY SPRING SUBDIVISION** IN WEBER COUNTY, UTAH, HAS BEEN DRAWN CORRECTLY TO THE DESIGNATED SCALE AND IS A TRUE AND CORRECT REPRESENTATION OF THE HEREIN DESCRIBED LANDS INCLUDED IN SAID SUBDIVISION, BASED UPON DATA COMPILED FROM RECORDS IN THE WEBER COUNTY RECORDER'S OFFICE AND FROM SAID SURVEY MADE BY ME ON THE GROUND. I FURTHER CERTIFY THAT THE REQUIREMENTS OF ALL APPLICABLE STATUTES AND ORDINANCES OF WEBER COUNTY CONCERNING ZONING REQUIREMENTS REGARDING LOT MEASUREMENTS HAVE BEEN COMPLIED WITH.

SIGNED THIS _____ DAY OF _____, 20____.

9031945
UTAH LICENSE NUMBER

OWNERS DEDICATION AND CERTIFICATION

WE THE UNDERSIGNED OWNERS OF THE HEREIN DESCRIBED TRACT OF LAND, DO HEREBY SET APART AND SUBDIVIDE THE SAME INTO A THREE LOT SUBDIVISION AS SHOWN ON THE PLAT AND NAME SAID TRACT **IVY SPRING SUBDIVISION**, AND DO HEREBY GRANT AND DEDICATE A PERPETUAL RIGHT AND EASEMENT OVER, UPON AND UNDER THE LANDS DESIGNATED HEREON AS PUBLIC UTILITY, THE SAME TO BE USED FOR THE INSTALLATION MAINTENANCE AND OPERATION OF PUBLIC UTILITY SERVICE LINE, STORM DRAINAGE FACILITIES, IRRIGATION CANALS FOR THE PERPETUAL PRESERVATION OF WATER CHANNELS IN THEIR NATURAL STATE WHICHEVER IS APPLICABLE AS MAY BE AUTHORIZED BY THE GOVERNING AUTHORITY, WITH NO BUILDINGS OR STRUCTURES BEING ERRECTED WITHIN SUCH EASEMENTS AND ALSO DO GRANT AND DEDICATE A 12 FOOT ACCESS AND PRIVATE UTILITY EASEMENT AS SHOWN ON PLAT IN FAVOR OF THE OWNERS OF LOTS 18 AND 19.

SIGNED THIS _____ DAY OF _____, 20____.

JEROLD IVE

VALERIE B. IVE

ACKNOWLEDGMENT

STATE OF UTAH)ss.
COUNTY OF _____)

ON THE _____ DAY OF _____, 20____, PERSONALLY APPEARED BEFORE ME, THE UNDERSIGNED NOTARY PUBLIC, _____ (AND) _____ SIGNER(S) OF THE ABOVE OWNER'S DEDICATION AND CERTIFICATION, WHO BEING BY ME DULY SWORN, DID ACKNOWLEDGE TO ME _____ SIGNED IT FREELY, VOLUNTARILY, AND FOR THE PURPOSES THEREIN MENTIONED.

COMMISSION EXPIRES _____ NOTARY PUBLIC

ACKNOWLEDGMENT

STATE OF UTAH)ss.
COUNTY OF _____)

ON THE _____ DAY OF _____, 20____, PERSONALLY APPEARED BEFORE ME, THE UNDERSIGNED NOTARY PUBLIC, _____ (AND) _____ BEING BY ME DULY SWORN, ACKNOWLEDGED TO ME THEY ARE _____ AND _____ OF SAID CORPORATION AND THAT THEY SIGNED THE ABOVE OWNER'S DEDICATION AND CERTIFICATION FREELY, VOLUNTARILY, AND IN BEHALF OF SAID CORPORATION FOR THE PURPOSES THEREIN MENTIONED.

COMMISSION EXPIRES _____ NOTARY PUBLIC

Project Info.

Surveyor: T. HATCH
Designer: N. ANDERSON
Begin Date: 03-20-18
Name: IVY SPRING SUBDIVISION
Number: 6993-01
Revision:
Scale: 1"=40'
Checked:

5160 S 1500 W, RIVERDALE, UTAH 84405
TEL: (801) 621-3100 FAX: (801) 621-2666 www.reeve-assoc.com

WEBER COUNTY PLANNING COMMISSION APPROVAL

THIS IS TO CERTIFY THAT THIS SUBDIVISION PLAT WAS DULY APPROVED BY THE WEBER COUNTY PLANNING COMMISSION.

SIGNED THIS _____ DAY OF _____, 20____.

CHAIRMAN, WEBER COUNTY PLANNING COMMISSION

WEBER COUNTY ENGINEER

I HEREBY CERTIFY THAT THE REQUIRED PUBLIC IMPROVEMENT STANDARDS AND DRAWINGS FOR THIS SUBDIVISION CONFORM WITH THE COUNTY STANDARDS AND THE AMOUNT OF THE FINANCIAL GUARANTEE IS SUFFICIENT FOR THE INSTALLATION OF THESE IMPROVEMENTS.

WEBER COUNTY ENGINEER

WEBER COUNTY COMMISSION ACCEPTANCE

THIS IS TO CERTIFY THAT THIS SUBDIVISION PLAT, THE DEDICATION OF STREETS AND OTHER PUBLIC WAYS AND FINANCIAL GUARANTEE OF PUBLIC IMPROVEMENTS ASSOCIATED WITH THIS SUBDIVISION, THEREON ARE HEREBY APPROVED AND ACCEPTED BY THE COMMISSIONERS OF WEBER COUNTY, UTAH.

SIGNED THIS _____ DAY OF _____, 20____.

CHAIRMAN, WEBER COUNTY COMMISSION

ATTEST _____ TITLE

WEBER COUNTY SURVEYOR

I HEREBY CERTIFY THAT THE WEBER COUNTY SURVEYOR'S OFFICE HAS REVIEWED THIS PLAT AND ALL CONDITIONS FOR APPROVAL BY THIS OFFICE HAVE BEEN SATISFIED. THE APPROVAL OF THIS PLAT BY THE WEBER COUNTY SURVEYOR DOES NOT RELIEVE THE LICENSED LAND SURVEYOR WHO EXECUTED THIS PLAT FROM THE RESPONSIBILITIES AND/OR LIABILITIES ASSOCIATED THEREWITH.

SIGNED THIS _____ DAY OF _____, 20____.

WEBER COUNTY SURVEYOR

WEBER COUNTY ATTORNEY

I HAVE EXAMINED THE FINANCIAL GUARANTEE AND OTHER DOCUMENTS ASSOCIATED WITH THIS SUBDIVISION PLAT, AND IN MY OPINION THEY CONFORM WITH THE COUNTY ORDINANCE APPLICABLE THERETO AND NOW IN FORCE AND AFFECT.

SIGNED THIS _____ DAY OF _____, 20____.

WEBER COUNTY ATTORNEY

WEBER-MORGAN HEALTH DEPARTMENT

I HEREBY CERTIFY THAT THE SOILS, PERCOLATION RATES, AND SITE CONDITIONS FOR THIS SUBDIVISION HAVE BEEN INVESTIGATED BY THIS OFFICE AND ARE APPROVED FOR ON-SITE WASTEWATER DISPOSAL SYSTEMS.

SIGNED THIS _____ DAY OF _____, 20____.

DIRECTOR, WEBER-MORGAN HEALTH DEPARTMENT

Weber County Recorder

Entry No. _____ Fee Paid _____

And Recorded, _____

At _____ in Book _____

Of The Official Records, Page _____

Recorded For: _____

Weber County Recorder

Deputy.