


HALCYON LAKE ESTATES PHASE 1

"A LOT AVERAGED SUBDIVISION"
Part of the SW Quarter of Section 21, Township 6 North, Range 2 West, S.L.B.&M.
Weber County, Utah
31 August, 2019

Range 2 West, S.L.B.&M., West 1/4 Corner of Section 21, Township 6 North, Weber County Surveyors Office 2004 Monument 3" Brass Cap in Manhole Collar

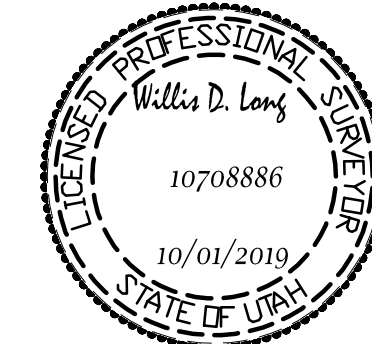


Scale: 1" = 50'
8334 South Wilson Crest Way
West Jordan, Utah
801-663-1641
willislong21@yahoo.com

NOTE: 5' WIDE PUBLIC UTILITY EASEMENT FOR ALL SIDE YARDS AND 10' WIDE PUBLIC UTILITY EASEMENT FOR ALL REAR AND FRONT PORTION OF DISPLAYED LOTS UNLESS OTHERWISE MENTIONED

NOTE: STANDARD SET BACK FOR ALL LOTS IS 30' ON THE FRONT AND REAR, STANDARD SET BACK FOR ALL LOTS IS 10' ON THE SIDE YARDS.

NOTE: FOR EACH ZONE IN THIS SUBDIVISION, THE AVERAGE AREA AND AVERAGE WIDTH OF LOTS WITHIN THE ZONE QUAL OR EXCEED THE MINIMUM AREA AND MINIMUM WIDTH ALLOWED IN THE ZONE, AN AMENDMENT TO ANY PART OF THIS SUBDIVISION SHALL COMPLY WITH SECTION 106-2-4(b) OF THE WEBER COUNTY CODE.

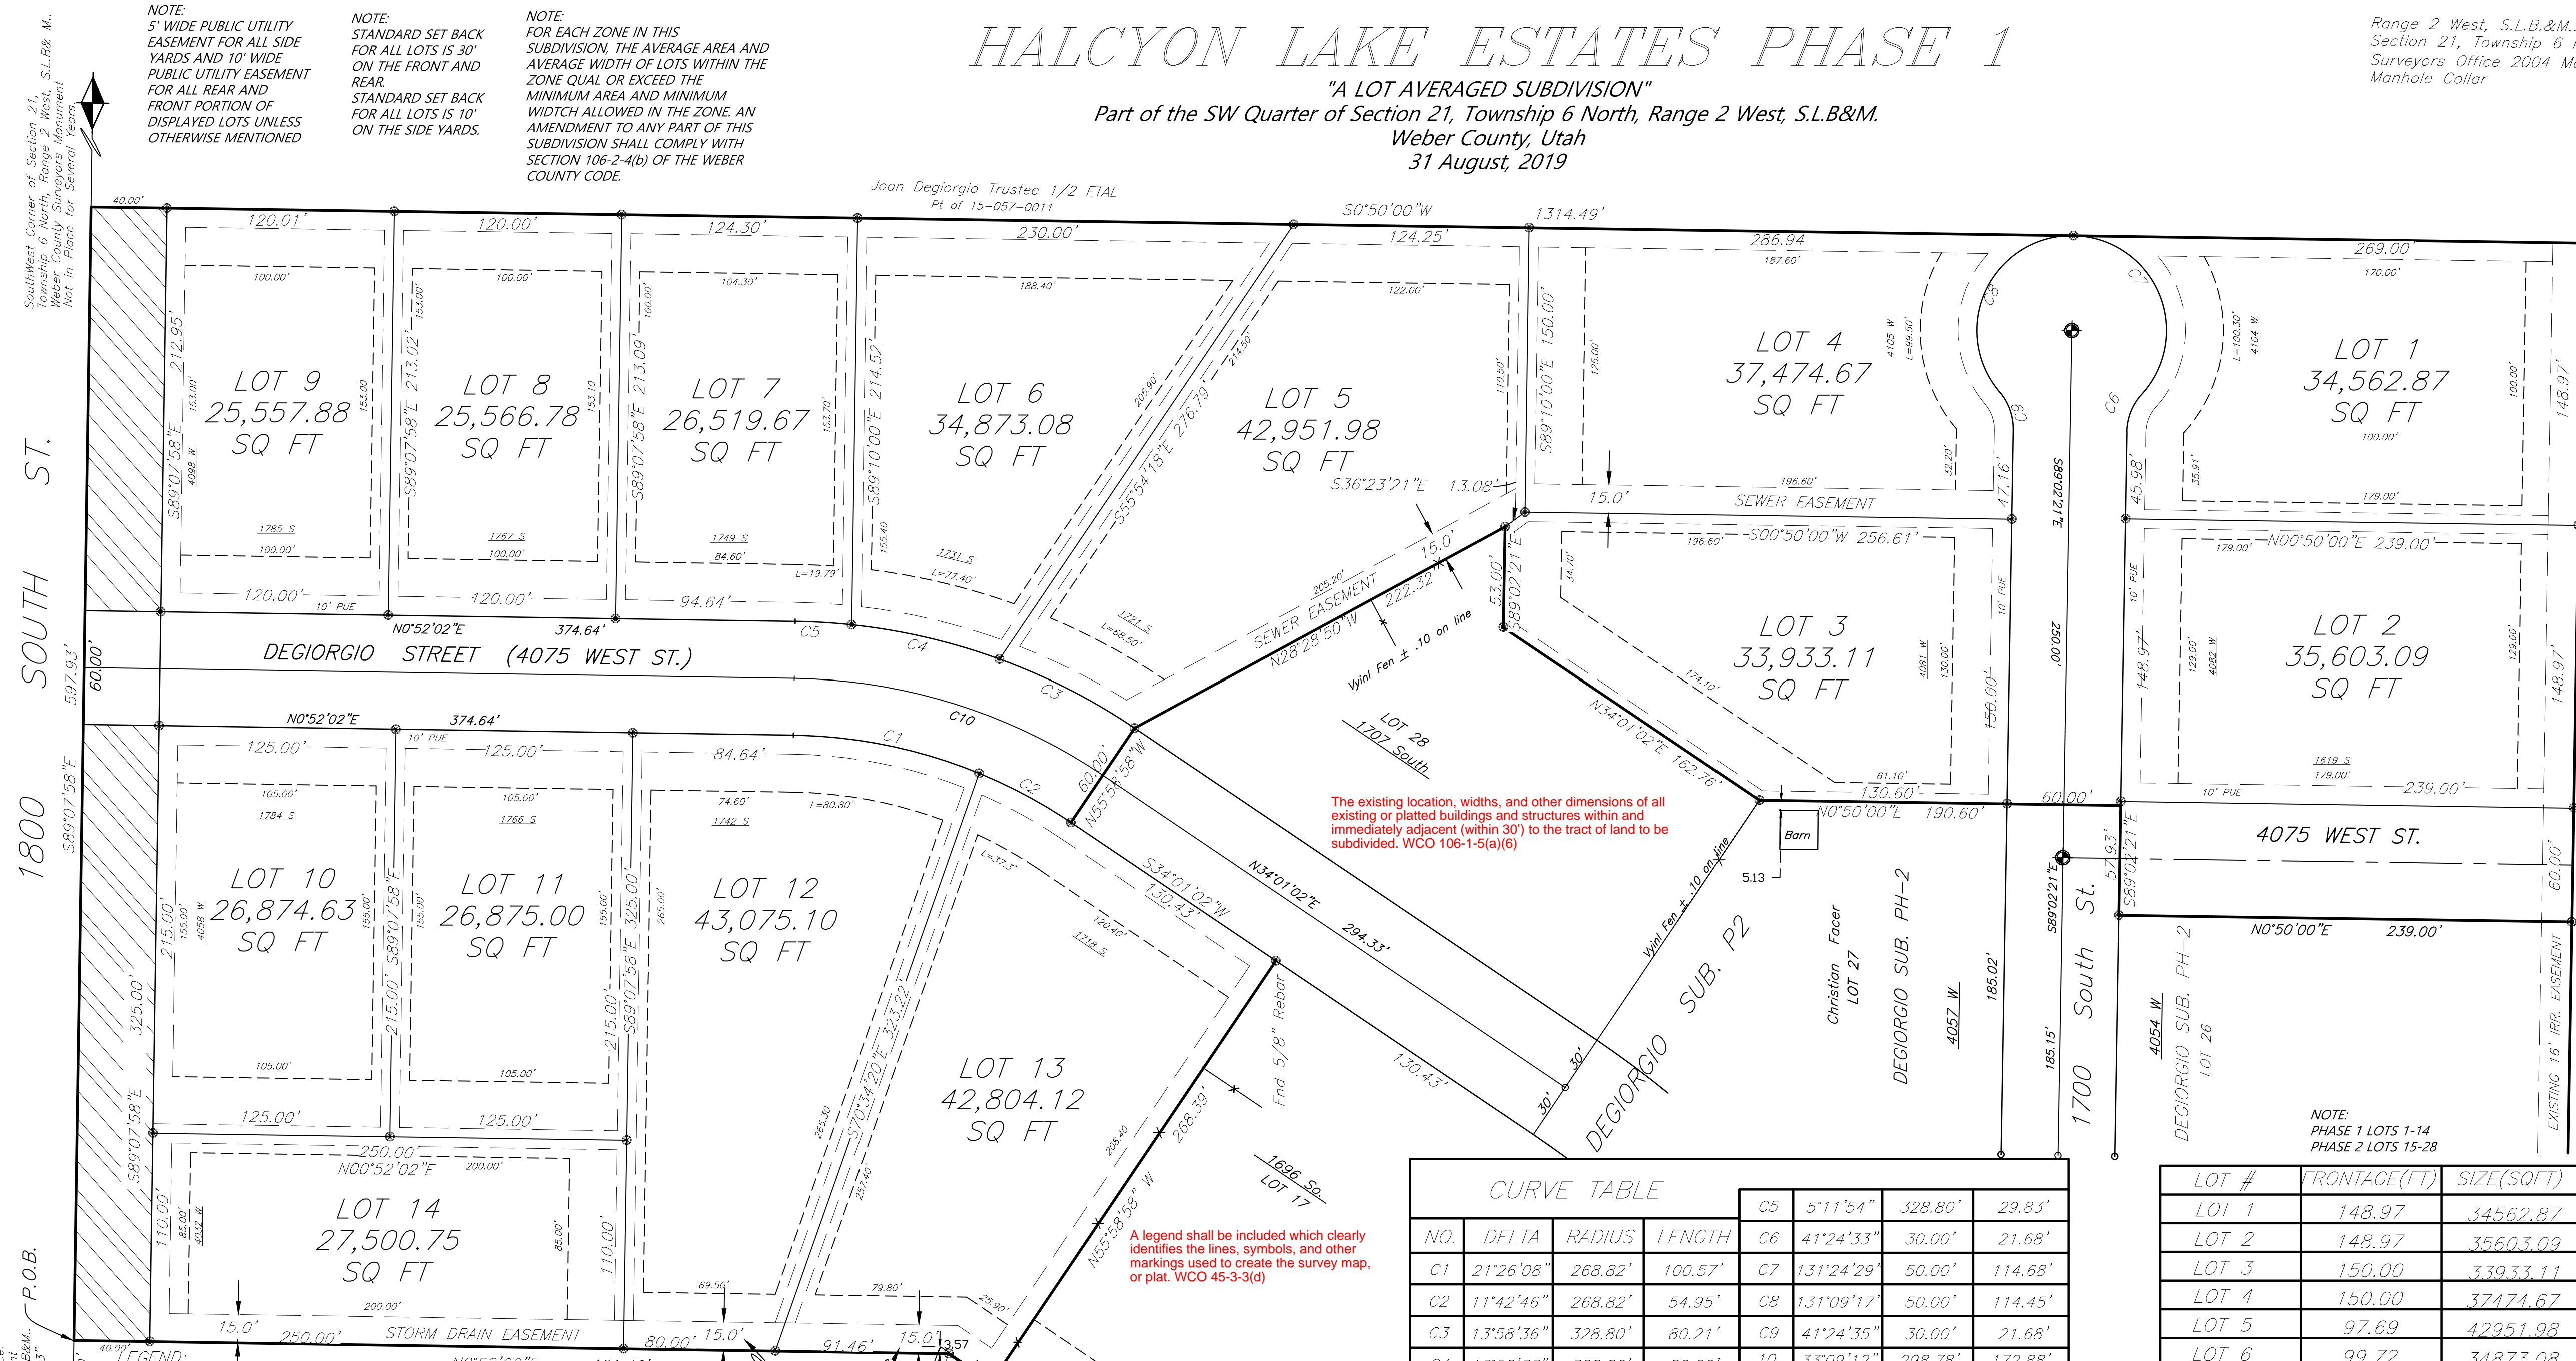

BOUNDARY DESCRIPTION
A PART OF THE SOUTHWEST QUARTER OF SECTION 21, TOWNSHIP 6 NORTH, RANGE 2 WEST, SALT LAKE BASE AND MERIDIAN, BEGINNING AT A POINT WHICH IS N89°07'58"W 826.00 FEET FROM THE SOUTHEAST CORNER OF SAID QUARTER SECTION, RUNNING THENCE N0°52'02"E 461.46 FEET, THENCE N34°01'02"E 27.00 FEET, THENCE N55°58'58"W 268.39 FEET, THENCE S34°01'02"W 130.43 FEET, THENCE N55°58'58"W 60.00 FEET, THENCE N28°28'50"W 222.32 FEET, THENCE S89°02'21"E 53.00 FEET, THENCE N34°01'02"E 162.78 FEET, THENCE N0°50'00"E 190.60 FEET, THENCE S89°02'21"E 57.93 FEET, THENCE N0°50'00"E 239.00 FEET, THENCE N89°02'21"W 357.93 FEET, THENCE S0°50'00"W 1314.49 FEET MORE OR LESS TO SECTION LINE, THENCE S89°07'58"E 597.93 FEET ALONG SAID SECTION LINE TO THE POINT OF BEGINNING.

EXCEPTING THAT AREA WITHIN THE DEDICATION OF 4075 WEST STREET PER DEGIORGIO SUBDIVISION PHASE-3, CONTAINING 522,512.1 Sq Ft/11.995 ACRES, MORE OR LESS.

SURVEYOR'S CERTIFICATE
I, WILLIS D. LONG DO HEREBY CERTIFY THAT I AM A REGISTERED PROFESSIONAL LAND SURVEYOR IN THE STATE OF UTAH IN ACCORDANCE WITH TITLE 58, CHAPTER 22, PROFESSIONAL ENGINEERS AND LAND SURVEYORS LICENSING ACT, AND THAT I HAVE COMPLETED A SURVEY OF THE PROPERTY DESCRIBED ON THIS PLAT IN ACCORDANCE WITH SECTION 17-23-17 AND HAVE VERIFIED ALL MEASUREMENTS, AND HAVE PLACED MONUMENTS AS REPRESENTED ON THIS PLAT, AND THAT THIS PLAT OF Halcyon Lake Estates Phase 1 IN WEBER COUNTY, UTAH, HAS BEEN DRAWN CORRECTLY TO THE DESIGNATED SCALE AND IS A TRUE AND CORRECT REPRESENTATION OF THE HEREIN DESCRIBED LANDS INCLUDED IN SAID SUBDIVISION, BASED UPON DATA COMPILED FROM RECORDS IN THE WEBER COUNTY RECORDER'S OFFICE AND FROM SAID SURVEY MADE BY ME ON THE GROUND. I FURTHER CERTIFY THAT THE REQUIREMENTS OF ALL APPLICABLE STATUTES AND ORDINANCES OF WEBER COUNTY CONCERNING ZONING REQUIREMENTS REGARDING LOT MEASUREMENTS HAVE BEEN COMPLIED WITH.

SIGNED THIS _____ DAY OF _____, 2019

OWNERS DEDICATION
WE, THE UNDERSIGNED OWNERS OF THE HEREIN DESCRIBED TRACT OF LAND, DO HEREBY SET APART AND SUBDIVIDE THE SAME INTO LOTS AND STREETS AS SHOWN ON THE PLAT AND NAME SAID TRACT Halcyon Lake Estates Phase 1 AND DO HEREBY DEDICATE, GRANT AND CONVEY TO PUBLIC USE ALL THOSE PARTS OR PORTIONS OF SAID TRACT OF LAND DESIGNATED AS STREETS THE SAME TO BE USED AS PUBLIC THOROUGHFARES FOREVER, AND ALSO DO HEREBY GRANT AND DEDICATE A PERPETUAL RIGHT AND EASEMENT OVER UPON AND UNDER THE LANDS DESIGNATED ON THE PLAT AS PUBLIC UTILITY, STORM WATER DETENTION PONDS AND DRAINAGE EASEMENTS, THE SAME TO BE USED FOR THE INSTALLATION, MAINTENANCE AND OPERATION OF PUBLIC UTILITY SERVICE LINES, STORM DRAINAGE FACILITIES OR FOR THE PERPETUAL PRESERVATION OF WATER DRAINAGE CHANNELS IN THEIR NATURAL STATE WHICHEVER IS APPLICABLE AS MAY BE AUTHORIZED BY GOVERNMENTAL AUTHORITY WITH NO BUILDINGS OR STRUCTURES BEING ERECTED WITHIN SUCH EASEMENTS.

SIGNED THIS _____ DAY OF _____, 2020

KEITH R. WARD, A MEMBER OF WAKLESS HOLDINGS, LLC

TYLOR BRENCHLY, A MEMBER OF WAKLESS HOLDINGS, LLC

CURVE TABLE

| NO. | DELTA | RADIUS | LENGTH | C5 | 5'11'54" | 328.80' | 29.83' |
|-----|-----------|---------|---------|----|------------|---------|---------|
| C1 | 21°26'08" | 268.82' | 100.57' | C6 | 41°24'33" | 30.00' | 21.68' |
| C2 | 11°42'46" | 268.82' | 54.95' | C8 | 131°09'17" | 50.00' | 114.45' |
| C3 | 13°58'36" | 328.80' | 80.21' | C9 | 41°24'35" | 30.00' | 21.68' |
| C4 | 13°58'33" | 328.80' | 80.20' | 10 | 33°09'12" | 298.78' | 172.88' |

| LOT # | FRONTAGE(FT) | SIZE(SQFT) | LOT # | FRONTAGE(FT) | SIZE(SQFT) |
|--------|--------------|------------|--------|--------------|------------|
| LOT 1 | 148.97 | 34562.87 | LOT 16 | 143.77 | 41941.05 |
| LOT 2 | 148.97 | 35603.09 | LOT 17 | 150.00 | 42675.00 |
| LOT 3 | 150.00 | 33933.11 | LOT 18 | 150.00 | 42675.00 |
| LOT 4 | 150.00 | 37474.67 | LOT 19 | 150.00 | 42675.00 |
| LOT 5 | 97.69 | 42951.98 | LOT 20 | 150.00 | 42675.00 |
| LOT 6 | 99.72 | 34873.08 | LOT 21 | 150.00 | 42675.00 |
| LOT 7 | 124.47 | 26519.67 | LOT 22 | 150.00 | 42675.00 |
| LOT 8 | 120.00 | 25566.78 | LOT 23 | 150.00 | 42675.00 |
| LOT 9 | 120.00 | 25557.88 | LOT 24 | 150.00 | 42675.00 |
| LOT 10 | 125.00 | 26874.63 | LOT 25 | 150.00 | 42675.00 |
| LOT 11 | 125.00 | 26875.00 | LOT 26 | 150.00 | 42675.00 |
| LOT 12 | 185.21 | 43075.10 | LOT 27 | 214.68 | 148013.03 |
| LOT 13 | 185.35 | 42804.12 | LOT 28 | 150.00 | 41161.07 |
| LOT 14 | 110.00 | 27500.75 | | | |
| LOT 15 | 343.32 | 42270.49 | | | |

LOT AVERAGES

| | |
|--------------|----------|
| FRONTAGE(FT) | 151.50 |
| SIZE(SQFT) | 41582.00 |

WEBER-MORGAN HEALTH DEPARTMENT
WEBER-MORGAN HEALTH DEPARTMENT:
I HEREBY CERTIFY THAT THE SOILS, PERCOLATION RATES, AND SITE CONDITIONS FOR THIS SUBDIVISION HAVE BEEN INVESTIGATED BY THIS OFFICE AND ARE APPROVED FOR ON-SITE WASTEWATER DISPOSAL SYSTEMS.
SIGNED THIS _____ DAY OF _____, 20_____
DIRECTOR, WEBER-MORGAN HEALTH DEPARTMENT

LEGEND:
() DISTANCE AND OR BEARING PER DEED OR PLAT. NO PARENTHESES IS MEASURED DISTANCE OR ROTATED PLAT OR DEED BEARING TO STATE PLANE GRID BEARING.
X EXISTING FENCES.
SET 5/8" REBAR (24x5/8") & 10708886 CAP.
STREET DEDICATION - 21,517.8 Sq. Ft.
WC-105 4235.00
STREET MONUMENT (6 TOTAL)
5' WIDE PUBLIC UTILITY EASEMENT
LOT SETBACK
SECTION/QUARTER CORNER

NOTE: AGRICULTURE IS THE PREFERRED USE IN THE AGRICULTURAL ZONES. AGRICULTURAL OPERATIONS AS SPECIFIED IN THE ZONING ORDINANCE FOR A PARTICULAR ZONE ARE PERMITTED AT ANY TIME INCLUDING THE OPERATION OF FARM MACHINERY AND NO ALLOWED AGRICULTURAL SHALL BE SUBJECT TO RESTRICTION ON THE BASIS THAT IT INTERFERES WITH ACTIVITIES OF FUTURE RESIDENTS OF THIS SUBDIVISION.
NOTE: ALL LOTS ARE TO RETAIN THEIR OWN STORM WATER AS SHOWN ON THE IMPROVEMENT PLANS. ALL INHABITABLE SPACE BELOW NATURAL GRADE WILL REQUIRE THE APPROVAL OF THE ENGINEER TO VERIFY THAT SUMP PUMPS ARE NOT DISCHARGING INTO THE SEWER SYSTEM.

WEBER COUNTY ENGINEER
I HEREBY CERTIFY THAT THE REQUIRED PUBLIC IMPROVEMENT STANDARDS AND DRAWINGS FOR THIS SUBDIVISION CONFORM WITH COUNTY STANDARDS AND THE AMOUNT OF FINANCIAL GUARANTEE IS SUFFICIENT FOR THE INSTALLATION OF THESE IMPROVEMENTS. SIGNED THIS DAY OF _____, 20_____
SIGNATURE _____

WEBER COUNTY PLANNING COMMISSION APPROVAL
THIS IS TO CERTIFY THAT THIS SUBDIVISION PLAT WAS DULY APPROVED BY THE WEBER COUNTY PLANNING COMMISSION ON THE _____ DAY OF _____, 20_____
CHAIRMAN, WEBER COUNTY PLANNING COMMISSION

WEBER COUNTY ATTORNEY
I HAVE EXAMINED THE FINANCIAL GUARANTEE AND OTHER DOCUMENTS ASSOCIATED WITH THIS SUBDIVISION PLAT AND IN MY OPINION THEY CONFORM WITH THE COUNTY ORDINANCE APPLICABLE THERETO AND NOW IN FORCE AND AFFECT. SIGNED THIS _____ DAY OF _____, 20_____
SIGNATURE _____

ACKNOWLEDGEMENT
STATE OF UTAH }
COUNTY OF WEBER }
ON THIS _____ DAY OF _____, 20_____
PERSONALLY APPEARED _____, AND
KEITH R. WARD, MEMBER OF WAKLESS HOLDINGS, LLC
TYLOR BRENCHLY, MEMBER OF WAKLESS HOLDINGS, LLC
SIGNER(S) OF THE ADJACENT INSTRUMENT, WHO DULY ACKNOWLEDGED TO ME THAT THEY EXECUTED THE SAME.
NOTARY PUBLIC _____ RESIDING AT _____
MY COMMISSION EXPIRES: _____

COUNTY RECORDER
ENTRY No. _____ FEE PAID _____
FILED FOR RECORD AND RECORDED: _____ 20_____, AT _____
IN BOOK _____ PAGE _____
OF OFFICIAL RECORDS.
RECORDED FOR: _____
COUNTY RECORDER: _____
BY: _____

WEBER COUNTY COMMISSION ACCEPTANCE
THIS IS TO CERTIFY THAT THIS SUBDIVISION PLAT, THE DEDICATION OF STREETS AND OTHER PUBLIC WAYS AND FINANCIAL GUARANTEE OF PUBLIC IMPROVEMENTS ASSOCIATED WITH THIS SUBDIVISION, THEREON ARE HEREBY APPROVED AND ACCEPTED BY THE COMMISSIONERS OF WEBER COUNTY, UTAH THIS _____ DAY OF _____, 20_____
TITLE _____
CHAIRMAN, WEBER COUNTY COMMISSION

WEBER COUNTY SURVEYOR
I HEREBY CERTIFY THAT THE WEBER COUNTY SURVEYOR'S OFFICE HAS REVIEWED THIS PLAT AND ALL CONDITIONS FOR APPROVAL BY THIS OFFICE HAVE BEEN SATISFIED. THE APPROVAL OF THIS PLAT BY THE WEBER COUNTY SURVEYOR DOES NOT RELIEVE THE LICENSED LAND SURVEYOR WHO EXECUTED THIS PLAT FROM THE RESPONSIBILITIES AND/OR LIABILITIES ASSOCIATED THEREWITH. SIGN THIS _____ DAY OF _____, 20_____
SIGNATURE WEBER COUNTY SURVEYOR

NARRATIVE
THE PURPOSE OF THIS SURVEY IS TO ACCURATELY LOCATE THE EXTERIOR BOUNDARIES OF SAID PROPOSED SUBDIVISION AND TO MAKE THE SUBDIVISION OF THESE LANDS AND MARK THE SAME ON THE GROUND IN HARMONY WITH EXISTING BOUNDARIES.
BASIS OF BEARINGS IS BETWEEN THE W1/4 CORNER AND THE SOUTH QUARTER CORNER OF SECTION 21, TOWNSHIP 6 NORTH, RANGE 2 WEST, AS MONUMENTED BY WEBER COUNTY SURVEYORS OFFICE WHICH BEARS N44°25'34"W 3741.99 FEET (GRID BEARING AND GROUND DISTANCE) SURROUNDING ENTITIES TO INCLUDE IRRIGATION, STORM, SEWER, SUBDIVISIONS, ROAD RIGHTS OF WAY AND INDIVIDUAL PROPERTIES WERE PLACED USING DEEDS OF RECORD PROVIDED ON MULTIPLE TITLE REPORTS AS WELL AS BEST AVAILABLE PHYSICAL EVIDENCE TO INCLUDE FOUND LOT / SUBDIVISION CORNER AND EXISTING FENCE LINES, EDGES OF ROADS, EXISTING OCCUPATION AND PAROLE EVIDENCE.

KEITH WARD - WAKLESS HOLDINGS, LLC - DEVELOPER - 1064 SPYGLASS HILL, SYRACUSE, UTAH 84075
BRUCE WARD - ENGINEER - WRB CONSULTING P.O. BOX 1117, SALEM, UTAH 84653