

STATE OF UTAH, DEPARTMENT OF ENVIRONMENTAL QUALITY, DIVISION OF WATER QUALITY
195 North 1950 West, P.O. Box 144870, Salt Lake City, Utah 84114-4870 (801) 536-4300

NOI Notice of Intent (NOI) for Storm Water Discharges Associated with Construction Activity Under the UPDES General Permit UTRH92111 SEE REVERSE FOR INSTRUCTIONS

Submission of this Notice of Intent constitutes notice that the party(s) identified in Section I of this form intends to be authorized by UPDES General Permit No. UTRH92111 issued for storm water discharges associated with construction activity in the State of Utah. Becoming a permittee obligates such discharger to comply with the terms and conditions of the permit. **ALL NECESSARY INFORMATION MUST BE PROVIDED ON THIS FORM.**

PERMIT PERIOD	Permit Start Date: 03/22/2019 Permit Expiration Date: 06/30/2019
PERMIT TYPE	Construction General Permit (CGP, this permit covers any construction project): <input type="checkbox"/> Common Plan Permit (this only covers single lot residential construction disturbing less than an acre): <input checked="" type="checkbox"/>

Is this NOI seeking continuation for previously expired permit coverage at the same site? Y <input checked="" type="checkbox"/> N <input type="checkbox"/>	If yes, what is the number of the previous permit coverage? Permit No. UTR
--	--

I. OWNER INFORMATION
Owner Name: Lync Construction Phone: 801-710-2234
Address: 1407 N Mountain Road Status of Owner: PRIVATE
City: OGDEN State: UT Zip: 84404
Contact Person: Pat Burns Phone: 801-710-2234


GENERAL CONTRACTOR: Lync Construction Phone: 801-710-2234
Address: 1407 N Mountain Road Status of General Contractor: PRIVATE
City: OGDEN State: UT Zip: 84404
Contact Person: Pat Burns Phone: 801-710-2234

II. FACILITY SITE / LOCATION INFORMATION Name: Vaquero LOT 12 Project No. (if any): Address: 738 S 7100 W County: WEBER City: WEBER COUNTY (UNINCORPORATED AREA) State: UT Zip: 84404 Latitude: 0.00 Longitude: 0.00 Method (check one): <input type="checkbox"/> USGS Topo Map, Scale <input type="checkbox"/> EPA Web site <input type="checkbox"/> GPS <input checked="" type="checkbox"/> Other	Is the facility located in Indian Country? Y <input type="checkbox"/> N <input checked="" type="checkbox"/>
--	--

III. SITE INFORMATION
Municipal Separate Storm Sewer System (MS4) Operator Name: Weber County
Receiving Water Body: Salt Lake guess this is known this is a guess (see <http://wq.deq.utah.gov/>)
Estimate of distance to the nearest water body? 6 miles ft. miles.
Is the receiving water an impaired or high quality water body (see <http://wq.deq.utah.gov/>)? Yes No
List the Number of any other UPDES permits at the site:

IV. THIS SECTION IS ONLY FOR PROJECTS INVOLVED IN DEVELOPMENT OF A SUBDIVISION.
List the lots proposed for the development (please add another sheet of paper if there is not enough room to list all lots).
.5 Acres

PLOT PLAN FOR LYNC CONST.

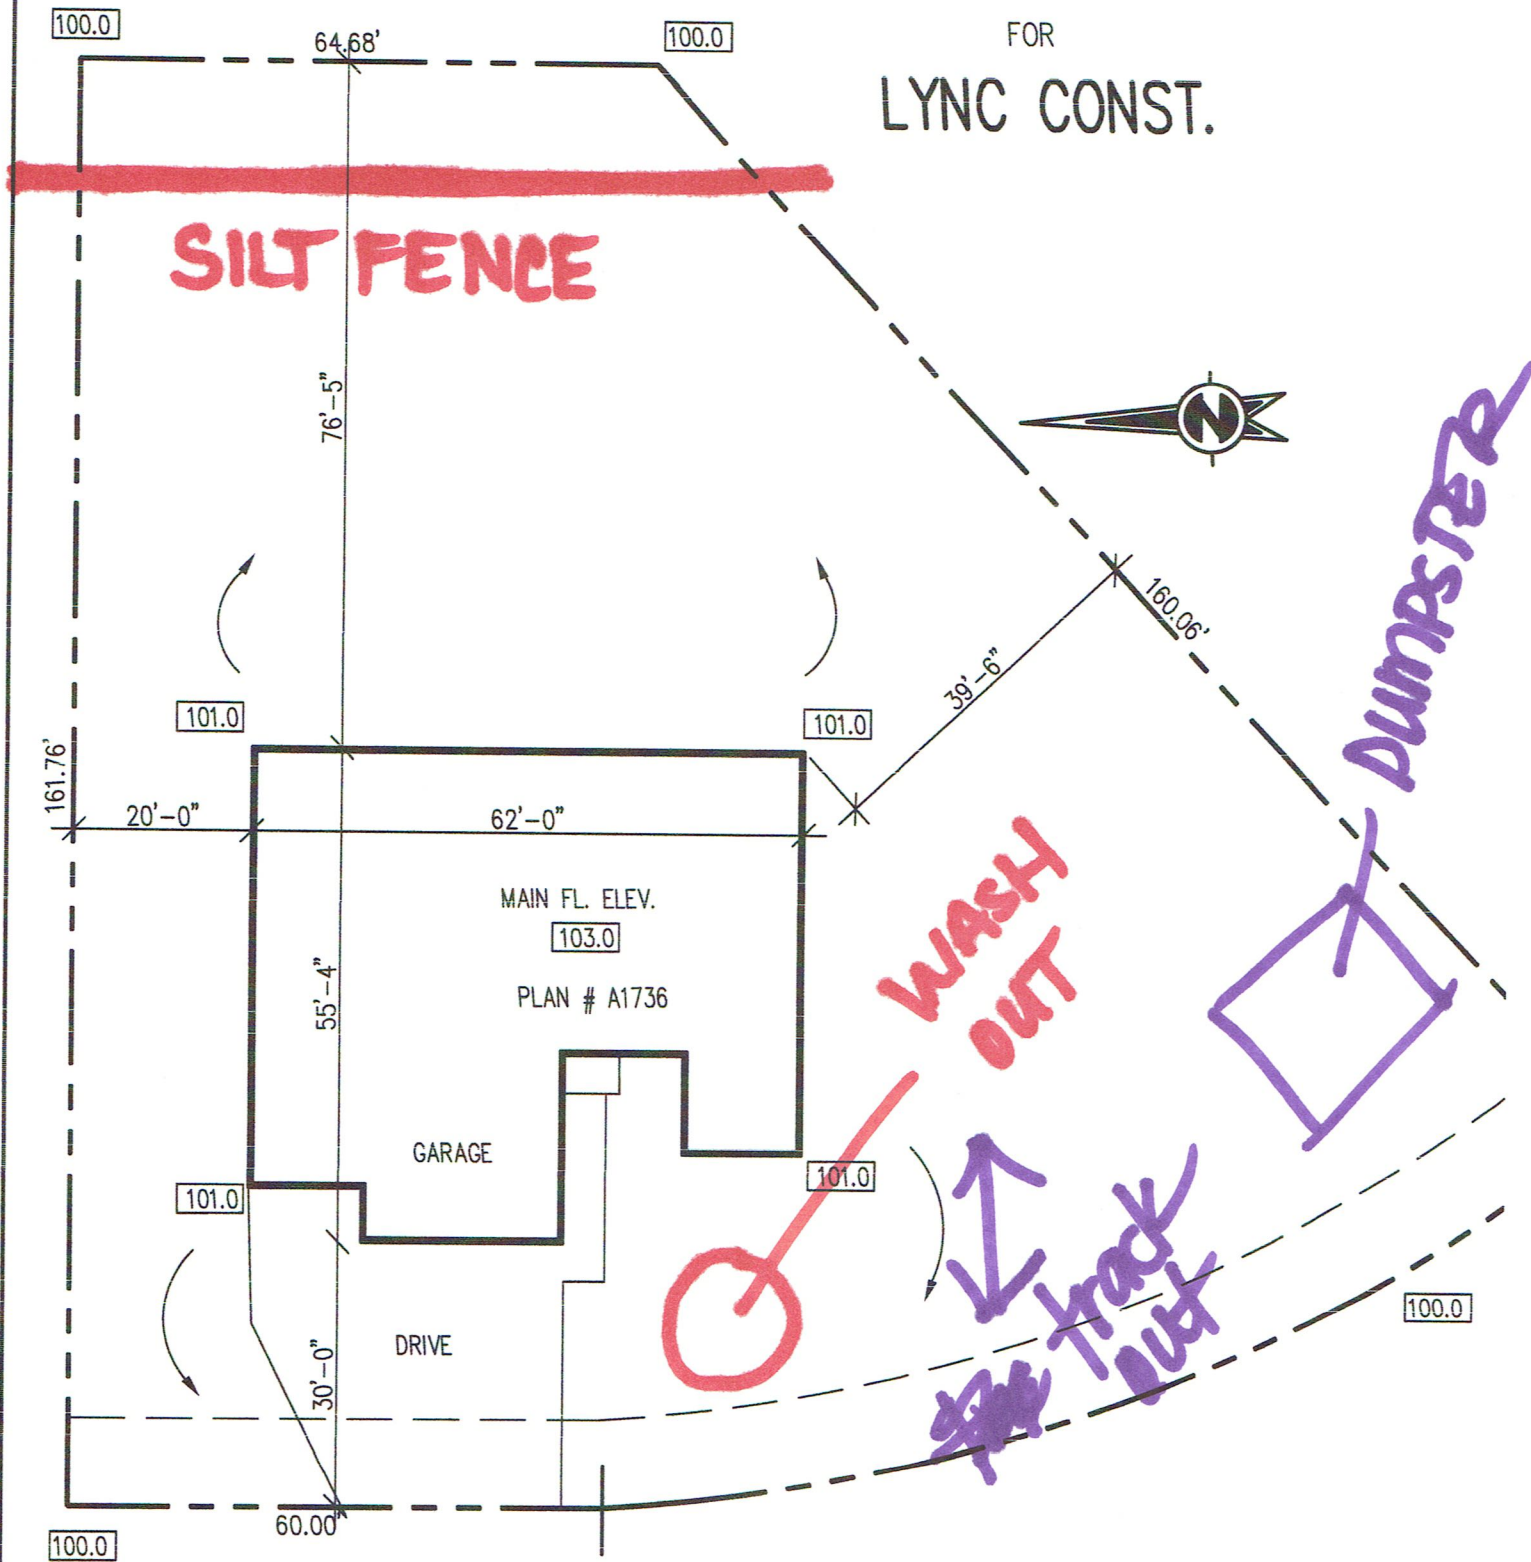

LOT # 12 VAQUERO VILLAGE

WEBER CO., UTAH

TYPE 'B' GRADING, 2% GRADE 10' AWAY FROM HOUSE

SCALE 1" = 20' - 0"

MAR. 2019