


LIBERTY CREEK ESTATES PHASE 1

A PART OF THE SOUTHEAST QUARTER OF SECTION 19, AND THE SOUTHWEST QUARTER OF SECTION 20,
TOWNSHIP 7 NORTH, RANGE 1 EAST, SALT LAKE BASE & MERIDIAN, U.S. SURVEY
WEBER COUNTY, UTAH
JULY 2019

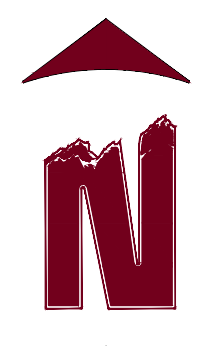

SCALE: 1" = 100'

DEVELOPER:

BRETT SATTERTHWAITE
2594 W. 2275 N.
FARR WEST, UT 84404

CENTER OF SECTION 19
TOWNSHIP 7 NORTH,
RANGE 1 EAST, S.L.B.&M.
(CALC. POSITION)

EAST QUARTER CORNER
OF SECTION 19
TOWNSHIP 7 NORTH,
RANGE 1 EAST, S.L.B.&M.
(ALUMINUM PIPE NOT
FOUND CALC. POSITION)

CENTER OF SECTION 20,
TOWNSHIP 7 NORTH,
RANGE 1 EAST, S.L.B.&M.
FOUND BRASS CAP IN
GOOD CONDITION


COLE P SCHLACK & WIFE
STACI A SCHLACK
TAX. 22-011-0024
ENTRY NO. 2061437

MARTIN J ENGELER & WIFE BRENDA
TIMOTHY ENGELER
TAX. 22-014-0013
ENTRY NO. 2706845

SURVEYORS CERTIFICATE

I, MATTHEW ABRAM MURDOCK, A LICENSED PROFESSIONAL LAND SURVEYOR, AS PRESCRIBED BY THE LAWS OF THE STATE OF UTAH IN ACCORDANCE WITH TITLE 58, CHAPTER 22 AND HOLDING LICENSE NUMBER 6541909, DO HEREBY CERTIFY THAT A SURVEY OF THIS PLAT AND THE FOLLOWING DESCRIPTION OF LANDS INCLUDED IN SAID SUBDIVISION BASED ON DATA COMPILED FROM THE RECORDS OF THE WEBER COUNTY RECORDERS OFFICE AND OF A SURVEY MADE ON THE GROUND, I FURTHER CERTIFY THAT THE REQUIREMENTS OF ALL APPLICABLE STATUTES AND ORDINANCES OF WEBER COUNTY CONCERNING ZONING REQUIREMENTS REGARDING LOT MEASUREMENTS HAVE BEEN COMPLIED WITH.

SIGNED THIS _____ DAY OF _____, 20____.

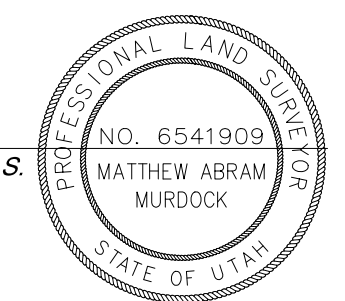

MATTHEW ABRAM MURDOCK, P.L.S.

BOUNDARY DESCRIPTION

A PART OF THE SOUTHEAST QUARTER OF SECTION 19, AND THE SOUTHWEST QUARTER OF SECTION 20, TOWNSHIP 7 NORTH, RANGE 1 EAST, SALT LAKE BASE & MERIDIAN, U.S. SURVEY:
BEGINNING AT A POINT ON THE SOUTH LINE OF THE NORTHWEST QUARTER OF THE SOUTHWEST QUARTER OF SAID SECTION 20, SAID POINT ALSO BEING ON THE NORTH LINE OF THE UTAH POWER & LIGHT COMPANY PROPERTY AS RECORDED IN BOOK 869 AT PAGE 597 IN THE WEBER COUNTY RECORDERS OFFICE, SAID POINT BEING NORTH 00°08'00" WEST 1,333.16 FEET AND NORTH 89°42'10" WEST 1,171.13 FEET FROM THE SOUTH QUARTER CORNER OF SAID SECTION 20, CONTINUING THENCE NORTH 89°42'10" WEST 570.42 FEET ALONG SAID SOUTH LINE OF THE NORTHWEST QUARTER OF THE SOUTHWEST QUARTER OF SAID SECTION 20 TO SOUTHERLY EXTENSION OF AN ANCIENT FENCE, THENCE NORTH 26°17'50" EAST 148.60 FEET ALONG SAID ANCIENT FENCE, THENCE NORTH 88°00'10" WEST 756.00 FEET, THENCE NORTH 73°28'10" WEST 319.36 FEET TO THE EAST RIGHT-OF-WAY LINE OF 2900 EAST STREET, THENCE THE FOLLOWING THREE (3) COURSES AND DISTANCES ALONG SAID EAST RIGHT-OF-WAY LINE: (1) NORTH 29°08'16" WEST 328.83 FEET TO A POINT OF CURVATURE WITH A 467.00 FOOT RADIUS CURVE TO THE RIGHT, (2) 238.25 FEET ALONG THE ARC OF SAID CURVE THROUGH A CENTRAL ANGLE OF 29°21'13" (CHORD BEARS NORTH 14°27'40" WEST 236.64 FEET) TO A POINT OF TANGENCY, (3) NORTH 00°12'57" EAST 8.73 FEET TO THE SOUTHWEST CORNER OF THAT PROPERTY AS RECORDED IN ENTRY NO. 2694513 IN THE WEBER COUNTY RECORDERS OFFICE AND AS SHOWN IN THAT RECORD OF SURVEY NO. 597 AS RECORDED IN THE WEBER COUNTY SURVEYORS OFFICE, THENCE THE FOLLOWING TWO COURSES AND DISTANCES ALONG SAID PROPERTY: (1) SOUTH 84°54'54" EAST 185.56 FEET, (2) NORTH 00°10'33" WEST 93.46 FEET TO A BOUNDARY LINE AGREEMENT AS RECORDED IN ENTRY NO. XXXX, THENCE THE FOLLOWING TEN (10) COURSES AND DISTANCES ALONG SAID BOUNDARY LINE AGREEMENT: (1) SOUTH 88°55'01" EAST 102.95 FEET, (2) SOUTH 76°46'57" EAST 233.76 FEET, (3) SOUTH 75°14'26" EAST 246.52 FEET, (4) SOUTH 76°58'05" EAST 131.53 FEET, (5) SOUTH 74°56'37" EAST 205.64 FEET, (6) SOUTH 79°21'52" EAST 187.65 FEET, (7) SOUTH 82°44'18" EAST 210.21 FEET, (8) NORTH 26°37'12" EAST 270.04 FEET, (9) NORTH 31°12'49" EAST 40.28 FEET, (10) NORTH 80°15'00" EAST 309.39 FEET TO THE NORTHWEST CORNER OF THAT PARCEL AS RECORDED IN ENTRY NO. XXXX IN THE WEBER COUNTY RECORDERS OFFICE, THENCE SOUTH 10°44'25" WEST 880.42 FEET ALONG THE WEST LINE OF SAID PARCEL TO THE POINT OF BEGINNING.
CONTAINS 1,099,723 SQUARE FEET OR 25.246 ACRES MORE OR LESS.

OWNER'S DEDICATION

WE, THE UNDERSIGNED OWNERS OF THE HEREIN DESCRIBED TRACT OF LAND DO HEREBY SET APART AND SUBDIVIDE THE SAME INTO LOTS AS SHOWN ON THE PLAT AND NAME SAID TRACT LIBERTY CREEK SUBDIVISION, AND DO HEREBY GRANT AND CONVEY TO NORTH OGDEN CITY, UTAH, ALL PORTIONS OF PARCEL "B" FOR STORM WATER PURPOSES, AND THOSE PARTS OR PORTIONS OF SAID TRACT OF LAND DESIGNATED AS STREETS, THE SAME TO BE USED FOR PUBLIC THROUGH HIGHWAYS, TRAILWAYS, AND ALSO DESIGNATE GRANT AND CONVEY A PERPETUAL RIGHT AND EASEMENT OVER, UPON AND UNDER ALL THOSE PARTS OR PORTIONS OF SAID TRACT OF LAND DESIGNATED AS EASEMENTS, THE SAME TO BE USED FOR PUBLIC UTILITY AND DRAINAGE PURPOSES AS SHOWN HEREON. THE SAME TO BE USED FOR THE INSTALLATION, MAINTENANCE AND OPERATION OF PUBLIC UTILITY SERVICE LINES AND DRAINAGE, AS MAY BE AUTHORIZED BY WEBER COUNTY.

SIGNED THIS _____ DAY OF _____, 20____.

BRETT SATTERTHWAITE, MANAGING MEMBER OF
LIBERTY CREEK INVESTMENTS, LLC

CORPORATE ACKNOWLEDGMENT

STATE OF UTAH } SS
COUNTY OF WEBER }
ON THE _____ DAY OF _____, 20____, PERSONALLY APPEARED BEFORE ME, THE UNDERSIGNED NOTARY PUBLIC, IN AND FOR SAID STATE AND COUNTY, OF WEBER, AND AFTER BEING DULY SWORN, ACKNOWLEDGED TO ME, BRETT SATTERTHWAITE IS MANAGING MEMBER OF LIBERTY CREEK INVESTMENTS, LLC, A UTAH LIMITED LIABILITY COMPANY WHO INADVERTENTLY ACQUIRED TITLE AS LIBERTY CREEK INVESTMENTS, LLC, A UTAH LIMITED LIABILITY AND THAT HE SIGNED THE OWNERS DEDICATION FREELY, VOLUNTARILY AND IN BEHALF OF SAID OWNERSHIP FOR THE PURPOSES THEREIN MENTIONED.

MY COMMISSION EXPIRES: _____, 20____.


NOTARY PUBLIC

NARRATIVE

THIS SURVEY AND SUBDIVISION PLAT WERE REQUESTED BY MR. CEIL SATTERTHWAITE FOR THE PURPOSE OF CREATING TWO BUILDING LOTS. THE BASIS OF BEARINGS IS STATE PLANE GRID PER WEBER COUNTY NORTH 07°09'09" WEST 2646.14 FEET BETWEEN THE BRASS CAPS FOUND MARKING THE SOUTH QUARTER CORNER OF SECTION 20 AND THE CENTER OF SECTION 20, TOWNSHIP 7 NORTH, RANGE 1 EAST, SALT LAKE BASE AND MERIDIAN. LOT CORNERS HAVE BEEN MONUMENTED AS DEPICTED ON THIS PLAT.

NOTE: AGRICULTURE ZONE

1. AGRICULTURE IS THE PREFERRED USE IN THE AGRICULTURAL ZONES. AGRICULTURAL OPERATIONS AS SPECIFIED IN THE ZONING ORDINANCE FOR A PARTICULAR ZONE ARE PERMITTED AT ANY TIME INCLUDING THE OPERATION OF MACHINES AND NO ALLOWED AGRICULTURAL USE SHALL BE SUBJECT TO RESTRICTION ON THE BASIS THAT IT INTERFERES WITH ACTIVITIES OF FUTURE RESIDENTS OF THIS SUBDIVISION.

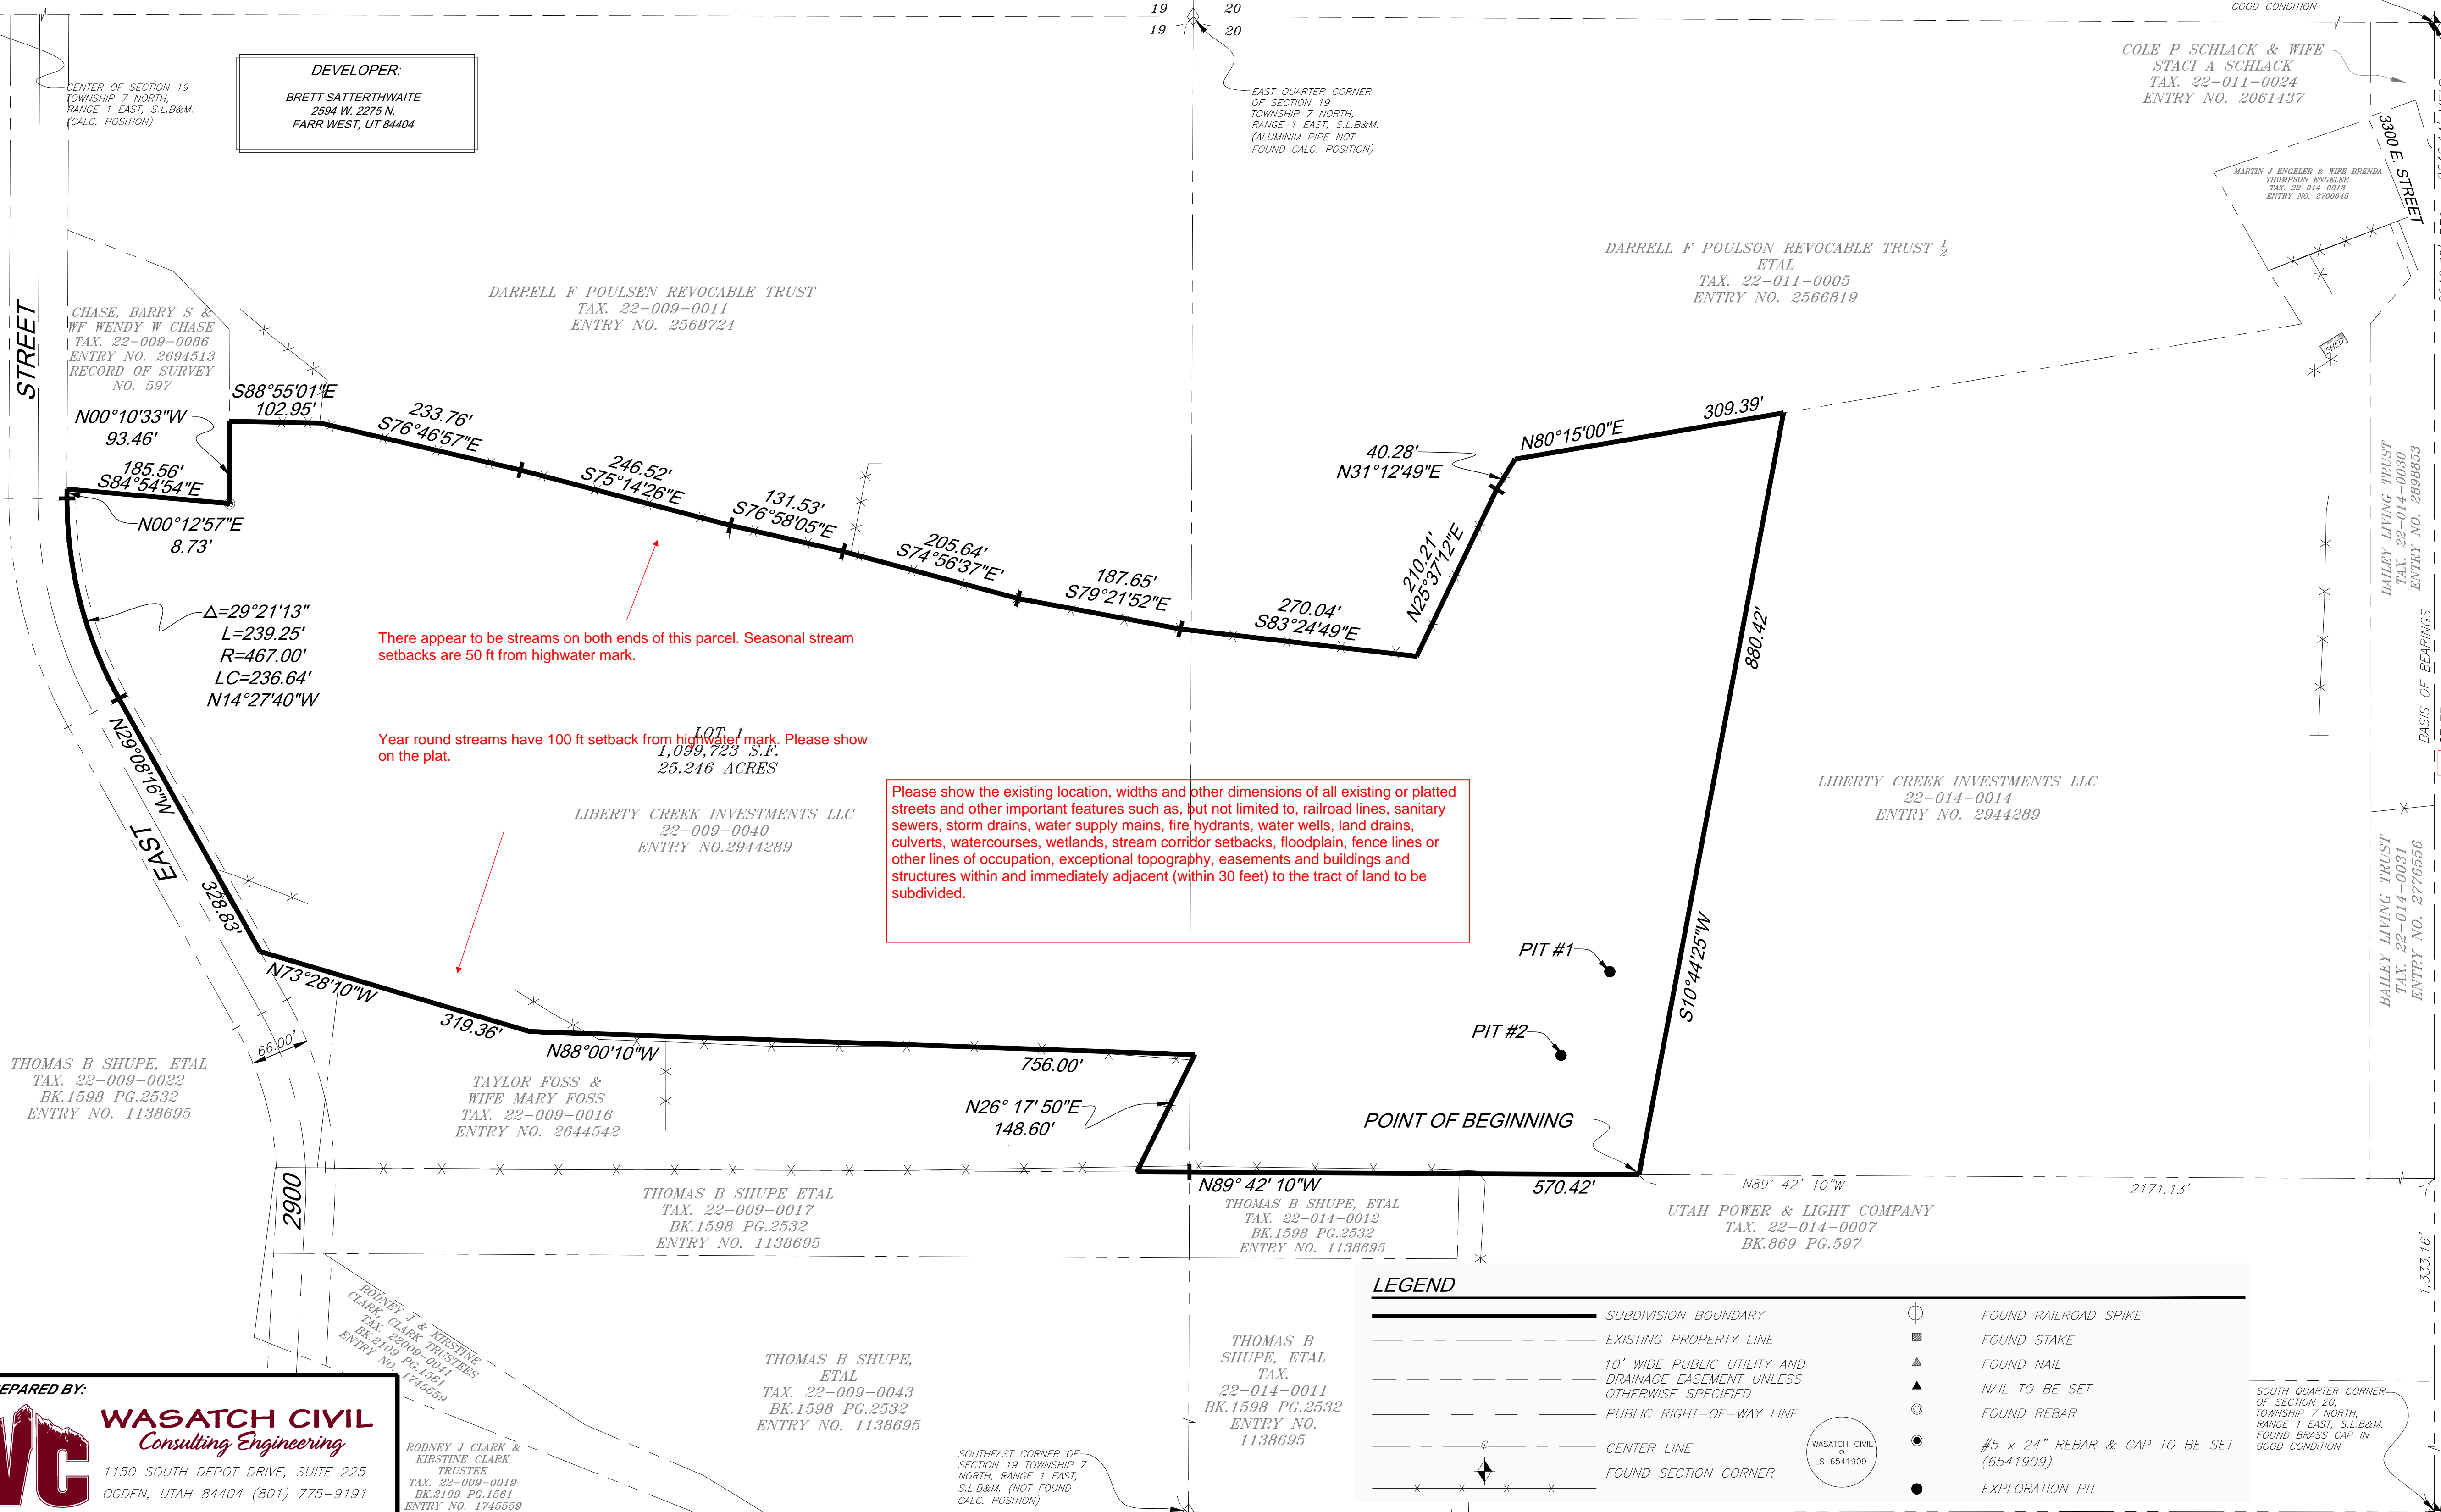

There appear to be streams on both ends of this parcel. Seasonal stream setbacks are 50 ft from highwater mark.

Year round streams have 100 ft setback from highwater mark. Please show on the plat.

Please show the existing location, widths and other dimensions of all existing or platted streets and other important features such as, but not limited to, railroad lines, sanitary sewers, storm drains, water supply mains, fire hydrants, water wells, land drains, culverts, watercourses, wetlands, stream corridor setbacks, floodplain, fence lines or other lines of occupation, exceptional topography, easements and buildings and structures within and immediately adjacent (within 30 feet) to the tract of land to be subdivided.

LEGEND

- SUBDIVISION BOUNDARY
- EXISTING PROPERTY LINE
- - - 10' WIDE PUBLIC UTILITY AND DRAINAGE EASEMENT UNLESS OTHERWISE SPECIFIED
- - - PUBLIC RIGHT-OF-WAY LINE
- CENTER LINE
- FOUND SECTION CORNER
- ⊕ FOUND RAILROAD SPIKE
- FOUND STAKE
- ▲ FOUND NAIL
- ▲ NAIL TO BE SET
- FOUND REBAR
- #5 x 24" REBAR & CAP TO BE SET (6541909)
- EXPLORATION PIT

PREPARED BY:
WASATCH CIVIL
Consulting Engineering
1150 SOUTH DEPOT DRIVE, SUITE 225
OGDEN, UTAH 84404 (801) 775-9191

RODNEY J CLARK & KRISTINE CLARK TRUSTEES
TAX. 22-009-0019
BK.2109 PG.1561
ENTRY NO. 1743559

THOMAS B SHUPE, ETAL
TAX. 22-009-0043
BK.1598 PG.2532
ENTRY NO. 1138695

THOMAS B SHUPE, ETAL
TAX. 22-014-0011
BK.1598 PG.2532
ENTRY NO. 1138695

WEBER COUNTY PLANNING COMMISSION APPROVAL
THIS IS TO CERTIFY THAT THIS SUBDIVISION PLAT WAS DULY APPROVED BY THE WEBER COUNTY PLANNING COMMISSION.
SIGNED THIS _____ DAY OF _____, 20____.
CHAIRMAN, WEBER COUNTY PLANNING COMMISSION

WEBER COUNTY ENGINEER
I HEREBY CERTIFY THAT THE REQUIRED PUBLIC IMPROVEMENT STANDARDS AND DRAWINGS FOR THIS SUBDIVISION CONFORM WITH THE COUNTY STANDARDS AND THE AMOUNT OF THE FINANCIAL GUARANTEE IS SUFFICIENT FOR THE INSTALLATION OF THESE IMPROVEMENTS.
SIGNED THIS _____ DAY OF _____, 20____.
WEBER COUNTY ENGINEER

WEBER COUNTY ATTORNEY
I HAVE EXAMINED THE FINANCIAL GUARANTEE AND OTHER DOCUMENTS ASSOCIATED WITH THIS SUBDIVISION PLAT AND IN MY OPINION THEY CONFORM WITH THE COUNTY ORDINANCE APPLICABLE THERETO AND NOW IN FORCE AND AFFECT.
SIGNED THIS _____ DAY OF _____, 20____.
WEBER COUNTY ATTORNEY

WEBER-MORGAN HEALTH DEPARTMENT
I HEREBY CERTIFY THAT THE SOILS, PERCOLATION RATES, AND SITE CONDITIONS FOR THIS SUBDIVISION PLAT HAVE BEEN INVESTIGATED BY THIS OFFICE AND ARE APPROVED FOR ON-SITE WASTEWATER DISPOSAL SYSTEMS.
SIGNED THIS _____ DAY OF _____, 20____.
WEBER-MORGAN HEALTH DEPARTMENT

WEBER COUNTY COMMISSION ACCEPTANCE
THIS IS TO CERTIFY THAT THIS SUBDIVISION PLAT, THE DEDICATION OF STREETS AND OTHER PUBLIC WAYS AND FINANCIAL GUARANTEE OF PUBLIC IMPROVEMENTS ASSOCIATED WITH THIS SUBDIVISION, THEREON ARE HEREBY APPROVED AND ACCEPTED BY THE COMMISSIONERS OF WEBER COUNTY, UTAH THIS _____ DAY OF _____, 20____.
ATTEST:
TITLE: _____

WEBER COUNTY SURVEYOR ACCEPTANCE
I HEREBY CERTIFY THAT THE WEBER COUNTY SURVEYOR'S OFFICE HAS REVIEWED THIS PLAT FOR MATHEMATICAL CORRECTNESS, SECTION CORNER DATA, AND FOR HARMONY WITH LINES AND MONUMENTS ON RECORD IN COUNTY OFFICES. THE APPROVAL OF THIS PLAT BY THE WEBER COUNTY SURVEYOR DOES NOT RELIEVE THE LICENSED LAND SURVEYOR WHO EXECUTED THIS PLAT FROM THE RESPONSIBILITIES AND/OR LIABILITIES ASSOCIATED THEREWITH.
SIGNED THIS _____ DAY OF _____, 20____.
SIGNATURE _____

COUNTY RECORDER
ENTRY NO. _____ FEE PAID _____
FILED FOR RECORD AND RECORDED _____ AT _____
IN BOOK _____
OF OFFICIAL RECORDS PAGE _____
RECORDED FOR _____
COUNTY RECORDER
BY: _____ DEPUTY