


Ritter Ranch Subdivision

PART OF THE NE 1/4 OF SECTION 11, TOWNSHIP 6 NORTH, RANGE 1 EAST, SALT LAKE BASE & MERIDIAN
UNINCORPORATED WEBER COUNTY, UTAH - Date of Survey: July 2020

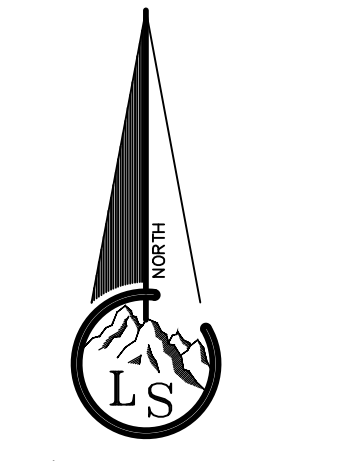

- Scale ~ 1" = 150'
- Legend
- EXISTING FENCE
 - EASEMENTS (as labeled or granted)
 - STREET CENTERLINE
 - FND SECTION CORNER
 - CALC SECTION CORNER
 - FND STREET MONUMENT
 - FND USFS AL Cap
 - FND REBAR AND CAP
 - SET PK Nail
 - SET #5x24" REBAR AND CAP STAMPED LANDMARK
 - ELEVATION BENCHMARK
 - RIGHT OF WAY MONUMENT
 - RECORD DATA
 - MEASURED DATA
 - ROAD/STREET DEDICATION



N 1/4 cor Sec 2, T6N, R1E, SLB&M, WCo BC 3" under asphalt
RTK GPS observed coordinates
N=3630708.193 E=1556293.624 U.S.R.
A BOR BM used as a ref. mon located N 12°08'49" W 36.56' md
RTK GPS observed coordinates
N=3630743.935 E=1556285.931 U.S.R.

N 1/4 cor Sec 11, T6N, R1E, SLB&M, Fnd Rebar unknown origin, 2" under asphalt, RTK GPS observed coordinates
N=3625457.029 E=1556239.204 U.S.R.

Ref. Mon. for N 1/4 cor Sec 11, T6N, R1E, SLB&M, BLM BC on pipe, RTK GPS observed coordinates
N=3625429.327 E=1556267.069 U.S.R.

Ref. Mon. N 1/4 cor Sec 11, T6N, R1E, SLB&M, BLM BC on pipe, RTK GPS observed coordinates
N=3625430.314 E=1556211.946 U.S.R.

Curve	Delta	Radius	Tangent	Length	Chord Bearing & Distance
1	90°00'00"	28.00'	28.00'	43.98'	N 45°00'00" W 39.60'
2	90°00'00"	28.00'	28.00'	43.98'	S 45°00'00" W 39.60'

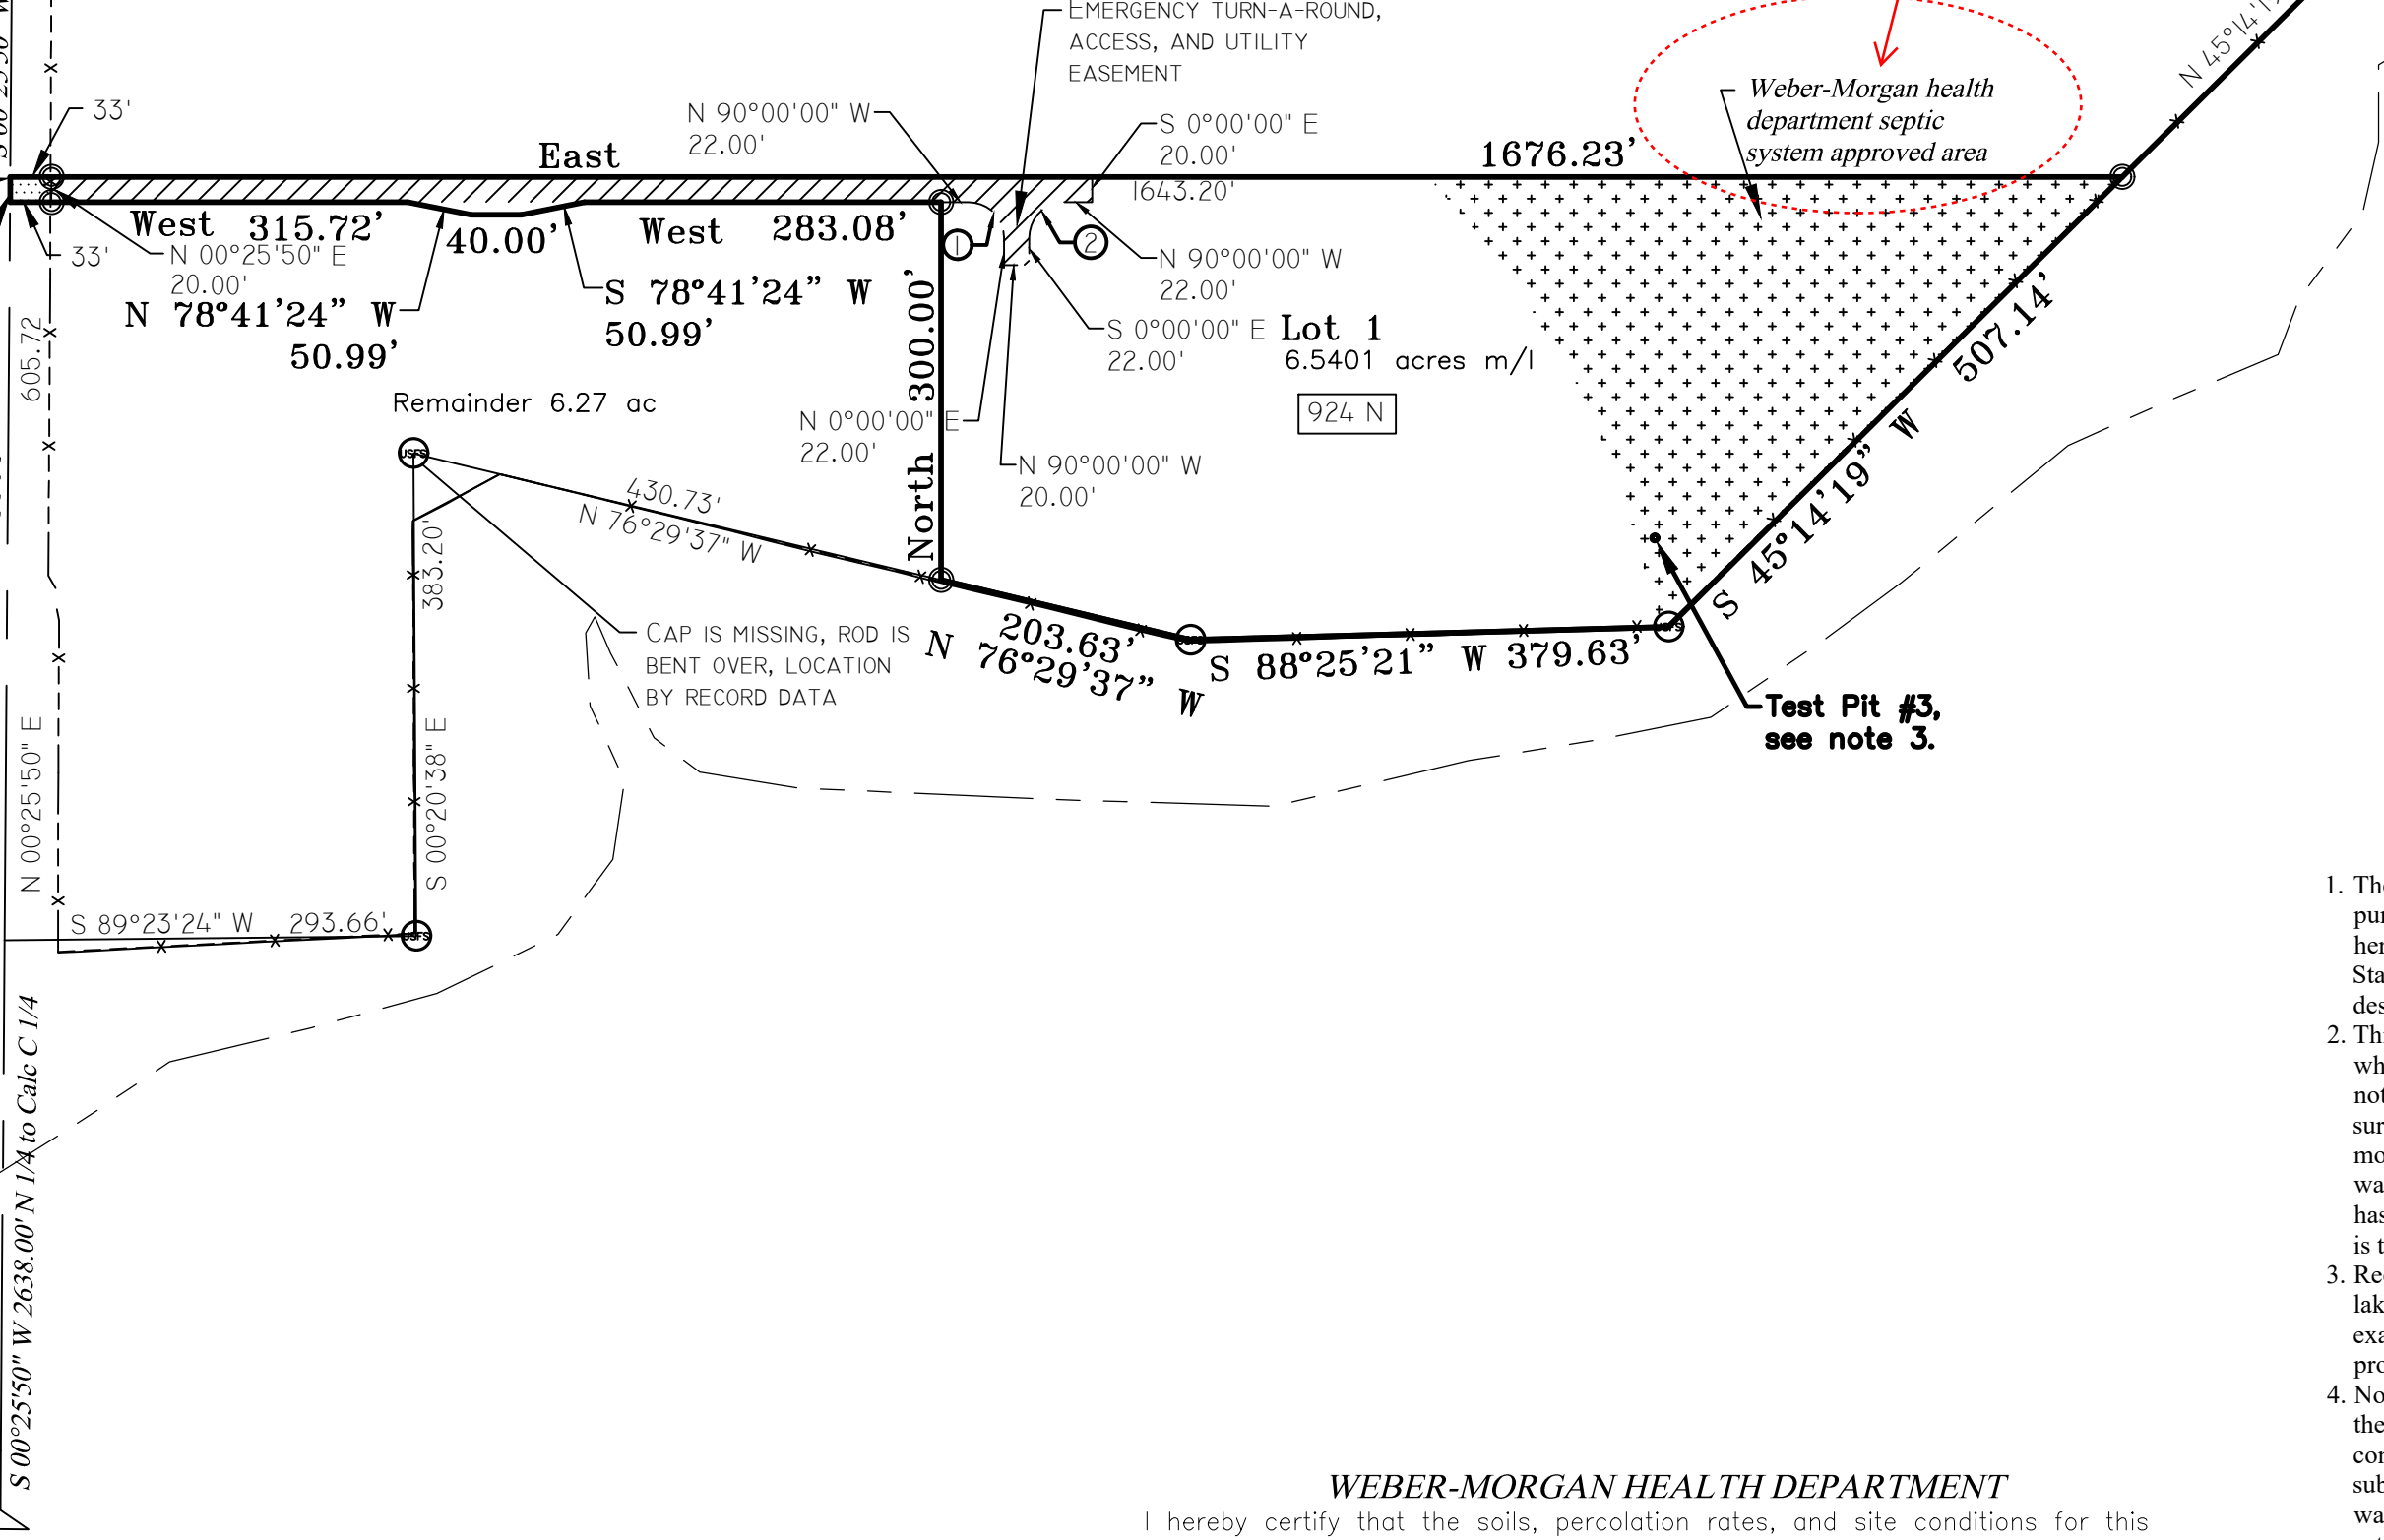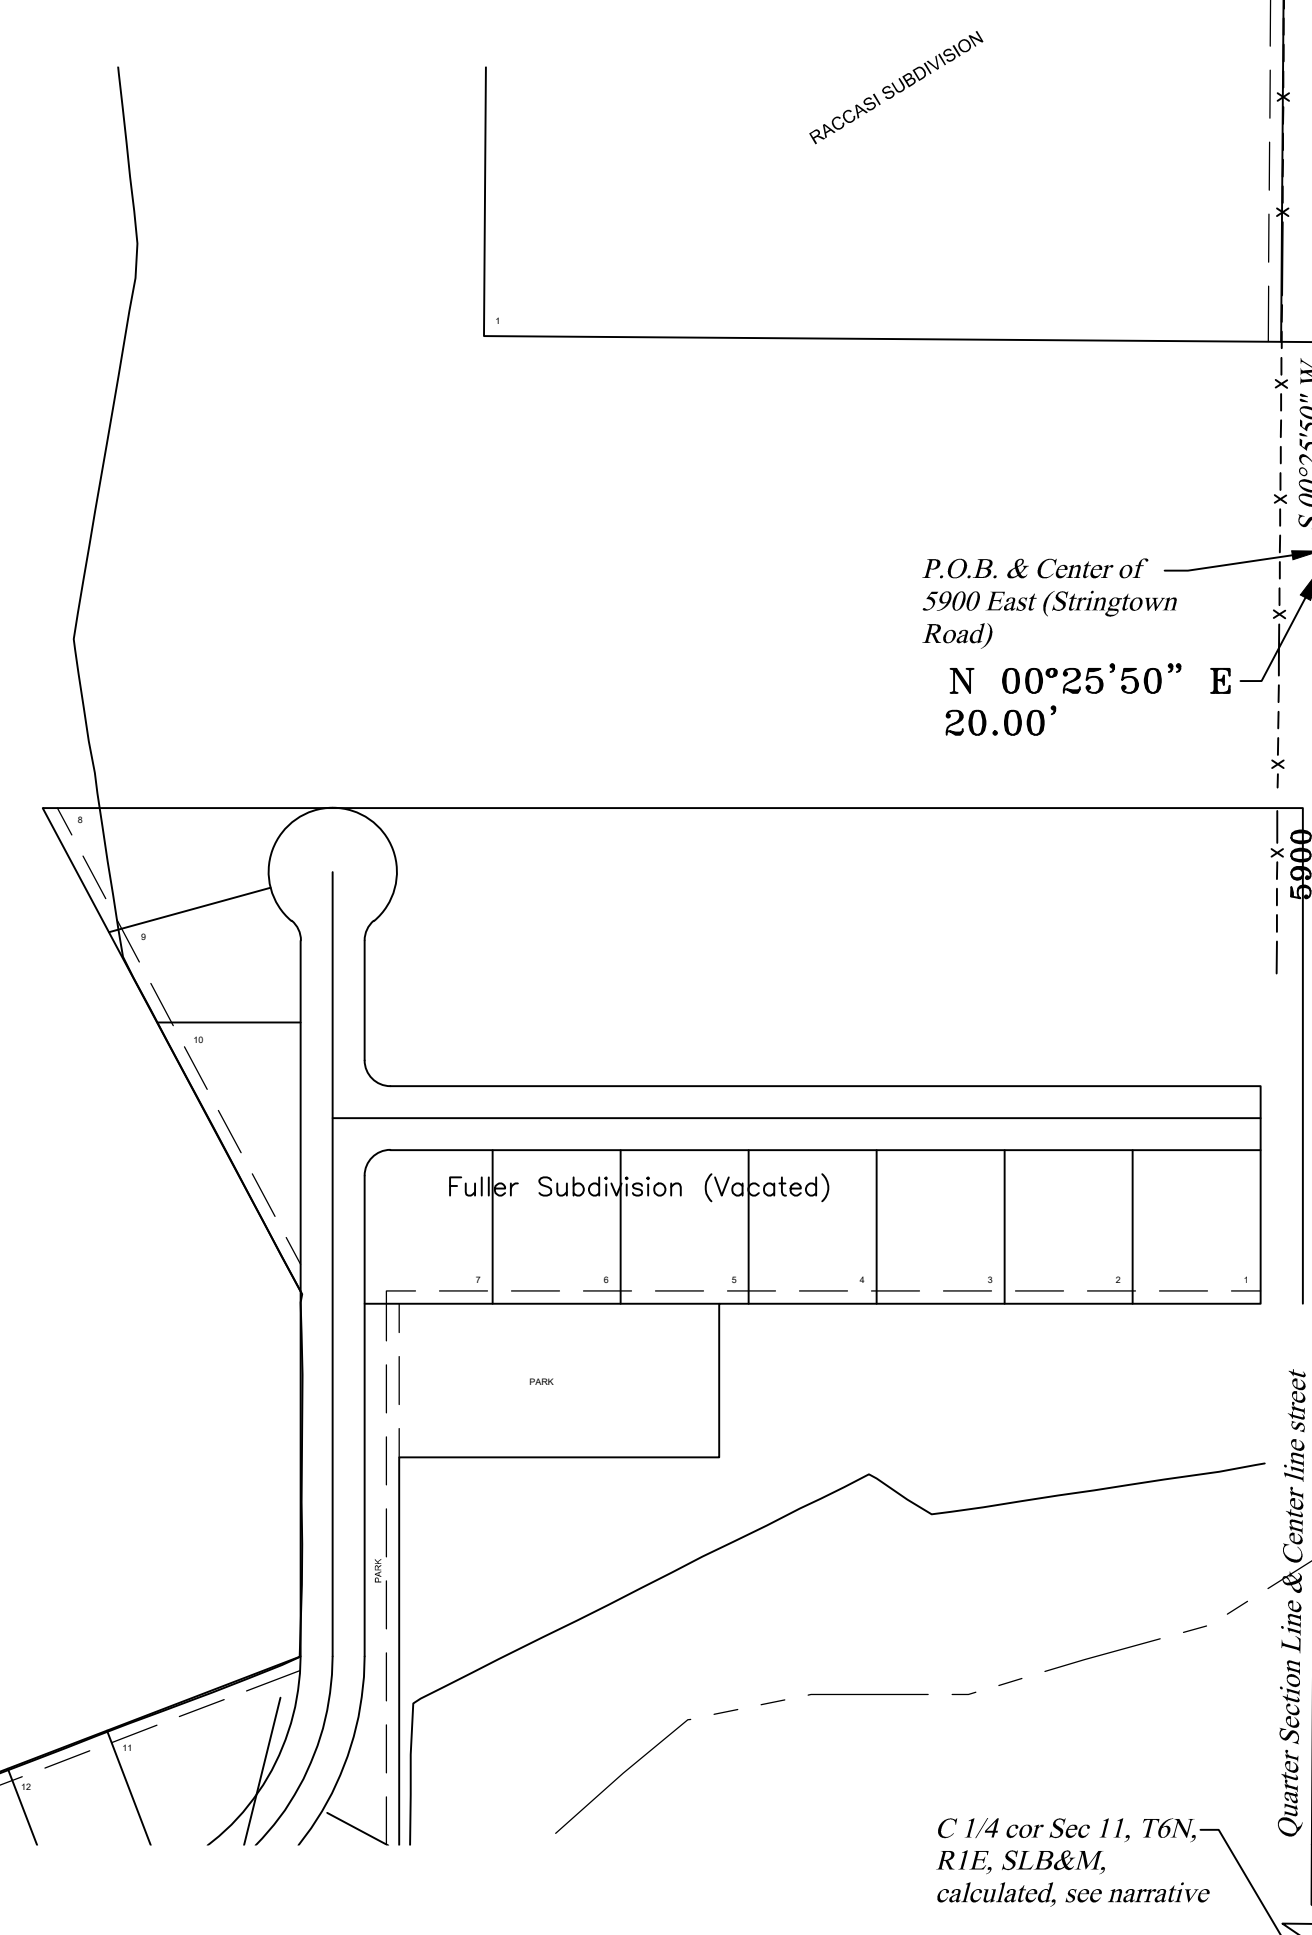

NARRATIVE

1. The purpose of this survey is to create a 1 lot subdivision plat as shown herein. Additionally, the purpose of the survey is not to identify utility locations, above or underground, any utilities shown herein are based on physical survey ties of visible utilities or from 811 Locator Services (Blue Stakes). No representation as to accuracy is made herein. The basis of bearing of bearing is as described in the description.

2. This survey is building on work that I did while employed by Weber County Surveyor's Office in which I worked with the USFS in establishing the boundary around Pineview Reservoir. It should be noted that the USFS ran out of funding for the project and much of the boundary has not been surveyed. There are some areas around the lake such as the south boundary of this subdivision which monumentation was set but the plat and supporting documentation on the boundary determination was not produced due to lack of funding. While the monumentation, specifically for this subdivision, has not been officially accepted by the USFS, it is my professional opinion that the boundary shown is the USFS boundary for this portion of the lake.

3. Records or documents relating to the establishment, research, and evaluation of this portion of the lake boundary are part of the Weber County Surveyor's records and should be available for examination. In regard to the establishment of the boundary there are some basic facts that I will provide herein.

4. Noted on the plat is a basic chain of title related to the acquisition of the USA for the expansion of the lake boundary. These documents were recorded in 1959. The relevant one, B632 pg 465, contains a description of the property that creates the boundary around the southern part of this subdivision. The bearings and distances contained in that description are for comparison and was known in the condemnation proceedings as Tract No. 15. The bearings of that description were rotated 0°14'36" CCW. I have numbered the monuments for the purposes of this drawing.

5. Because of the closing error of the description when holding the location of the NE corner of the Section, which is the tie monument, the description did not coincide with the existing fencing. However, after evaluating the position and bearings of the fence it is obvious that the fence is a close construction of the intent of the condemnation description. The USFS monuments were set in 2012 under my supervision. I am holding this monumented line as the subdivision boundary.

6. The establishment of the West boundary of the subdivision was established by splitting the existing fences and holding the rebar monument at the North Quarter of the section. This provides an alignment for the center of the street as well as the Quarter Section line. The South Quarter corner of the section is in the lake and in an attempt to use the BLM plat data to reconstruct their description of the section it was found that there are slight differences between the locations of existing monuments and data noted on the plat. Because of the differences I have held the fence split of the road for the north half of the quarter section line.

7. The center of the section identified as calculated on this plat is a result of holding another section of fence that was the south boundary of the Fuller Subdivision (now vacated). This south boundary is also fenced and extending that fence east to intersect with the line of 5900 East Street provides the calculated center quarter corner.

8. The north boundary is set at a location to provide the acreage that the owner wants in the plat and is a portion of what they own.

WEBER-MORGAN HEALTH DEPARTMENT
I hereby certify that the soils, percolation rates, and site conditions for this subdivision have been investigated by this office and are approved for on site wastewater disposal systems. Signed this _____ day of _____, 20____.
Director, Weber-Morgan Health Department

WEBER COUNTY SURVEYOR'S CERTIFICATE
I hereby certify that the Weber County Surveyor's Office has reviewed this plat and all conditions for approval by this office have been satisfied. The approval of this plat by the Weber County Surveyor does not relieve the Licensed Land Surveyor who executed this plat from the responsibilities and/or liabilities associated therewith.
Signed this _____ day of _____, 20____.
Weber County Surveyor

WEBER COUNTY PLANNING COMMISSION APPROVAL
This is to certify that this subdivision plat was duly approved by the Weber County Planning Commission on the _____ day of _____, 20____.
Chairman, Weber County Planning Commission

WEBER COUNTY COMMISSION ACCEPTANCE
This is to certify that this subdivision plat, the dedication of streets and other public ways and financial guarantee of public improvements associated with this subdivision thereon are hereby approved and accepted by the Commissioners of Weber County, Utah this _____ day of _____, 20____.
Attest:
Chairman, Weber County Commission Title: Weber County Clerk

WEBER COUNTY ATTORNEY
I have examined the financial guarantee and other documents associated with this subdivision plat and in my opinion they conform with the County Ordinance applicable thereto and now in force and effect. Signed this _____ day of _____, 20____.
Signature _____

WEBER COUNTY ENGINEER
I hereby certify that the required public improvement standards and drawings for this subdivision conform with County standards and the amount of the financial guarantee is sufficient for the installation of these improvements. Signed this _____ day of _____, 20____.
Signature _____

OWNER'S DEDICATION
We the undersigned owner(s) of the herein described tract of land, do hereby set apart and subdivide the same into lots and streets as shown or noted hereon and name said tract RITTER RANCH SUBDIVISION: (As shown herein the term Local Entity is the same as defined in UCA 67-1a-6.5) We hereby dedicate a right-of-way to the Local Entity for the purpose of public use all those parts or portions of said tract of land designated as street(s) and/or road(s), the same to be used as public thoroughfares. And further dedicate grant and convey an easement over, upon and under said street(s) or road(s) as public utility corridors as may be authorized by the Local Entity.
We hereby grant and dedicate a perpetual right and easement over, upon and under the lands designated herein as public utility (PUE), storm water detention/retention ponds, and drainage easement(s), the same to be used for the installation maintenance and operation of public utility service line(s), storm drainage facilities, irrigation canal(s) or for the perpetual preservation of water channels in their natural state whichever is applicable to the Local Entity, and other uses as may be authorized by the Local Entity, with no buildings or structures being erected within such easements without written authorization of the Local Entity.
We hereby grant a perpetual right and easement over and upon the lands designated herein as "Emergency turn-a-round easement" for the use of and for emergency services, to the Local Entity, their successors and/or assigns, for the limited purpose of emergency access and emergency vehicle turn-a-round as may be authorized by the Local Entity. This easement is deemed a no parking zone. This easement is intended to be situated on a driveway as constructed.

Limited Liability Company Acknowledgement
IN WITNESS WHEREOF, said Limited Liability Company hereinafter named has caused this instrument to be executed by its proper officers hereunto duly authorized, this _____ day of _____, 20____.
RITTER RANCH COMPANY, LC, a Utah Limited Liability Company

By: _____ State of Utah)
COUNTY OF WEBER)
By: _____
On the date first above written personally appeared before me the above named signer(s), who, being by me duly sworn said that [he/she/they] is/are the Manager of said Limited Liability Company, and that the within and foregoing instrument was signed in behalf of said company by authority of its Articles of Organization, and the said signer(s) acknowledged to me that said company executed the same.
As a Notary Public commissioned in Utah, WITNESS my hand and official stamp the date in this certificate first above written:

Notary Signature: _____ My Commission Expires: _____
(print name below signature): _____

BOUNDARY DESCRIPTION
A tract of land located in the Northeast Quarter of Section 11, Township 6 North, Range 1 East, Salt Lake Base and Meridian, being all of that certain parcel of land described in Special Warranty Deed recorded as Entry No. 2783749 on March 21, 2016 and a portion of that certain parcel of land described in Warranty Deed recorded as Entry No. 2787461 on April 11, 2016, said tract of land having a basis of bearing of North 00°35'38" East, by RTK GPS observation, between the monumented North Quarter corner of said Section 11 (having RTK GPS NAD83 Utah North coordinates of N=3625457.029 E=1556239.204 U.S.R.) and the monumented North Quarter corner of Section 2 said Township and Range (having RTK GPS NAD83 Utah North coordinates of N=3630708.193 E=1556293.624 U.S.R.), described by survey as follows:
COMMENCING at a point located 1159.59 feet South 00°25'50" West, along the center line of 5900 East Street (Stringtown Road) and the Quarter Section line, FROM said North Quarter corner of Section 11; RUNNING thence East 1676.23 feet, to the boundary of U.S.A. property as monumented by U.S. Forest Service aluminum cap;
Thence the following Three (3) courses along said monumented U.S.A. property boundary, 1) South 45°14'19" West (S 45°14'19" W) by said Special Warranty Deed) 507.14 feet, to a U.S. Forest Service Aluminum cap, 2) South 88°25'21" West 379.63 feet (S 88°25'21" W 379.63 feet by said Special Warranty Deed), to a U.S. Forest Service Aluminum cap, 3) North 76°29'37" West 203.63 feet (N 76°29'37" W by said Special Warranty Deed).
Thence leaving said U.S.A. property boundary North 300.00 feet;
Thence West 283.08 feet, along a line being parallel to and 20 feet perpendicularly distant southerly of the north line of this subdivision;
Thence South 78°41'24" West 50.99 feet;
Thence West 40.00 feet;
Thence North 78°41'24" West 50.99 feet;
Thence West 315.72 feet, along a line being parallel to and 20 feet perpendicularly distant southerly of the north line of this subdivision;
Thence North 00°25'50" East 20.00 feet, along said center line and the evidenced Quarter Section line of said Section 11, to the point of beginning.
Containing 6.551 acres, more or less.

SURVEYOR'S CERTIFICATE
I, Ernest D. Rowley, do hereby certify that I am a professional land surveyor in the State of Utah and hold license no. 171781-2201 in accordance with Title 58, Chapter 22 known as the Professional Engineers and Professional Land Surveyor's Licensing Act, have made a survey of the property(s) shown herein in accordance with UCA 17-23-17, verifying measurements, and placing monuments as represented. That this plat was prepared from the field notes of this survey and from documents and records as noted herein. I further certify that, to the best of my knowledge and belief, all lots meet the current requirements of the Land Use Ordinance of Weber county.



Landmark Surveying, Inc. A Complete Land Surveying Service www.LandmarkSurveyUtah.com		4646 South 3500 West - #A-3 West Haven, UT 84403 801-731-4075	
DEVELOPER: Ritter Ranch Company, LC Address: 1090 N 900 E, Eden, Utah 84310		1 of 1	
NE 1/4 of Section 11, Township 6 North, Range 1 East, Salt Lake Base and Meridian.		Subdivision	
Revisions	DRAWN BY: EDR	County Recorder: Leann H Kitts	
	CHECKED BY: ...	By Deputy: _____	
	DATE: March 26, 2021	Fee paid _____	
	PROJ: 4018		

Project Name: 4018 Ritter Ranch Sub-6.51ac-WFZ.dwg Sine Date: July 13, 2021 10:27 AM Sheet: ###