

This is not a full review- there may be other red lines to follow once these are addressed.

MARZIALE SUBDIVISION

LOCATED IN THE SOUTHEAST QUARTER OF SECTION 29,
TOWNSHIP 6 NORTH, RANGE 2 WEST, SALT LAKE BASE AND MERIDIAN,
WEBER COUNTY, UTAH
JUNE 2021

VICINITY MAP
NOT TO SCALE



BOUNDARY DESCRIPTION

A PART OF THE SOUTHEAST QUARTER OF SECTION 29, TOWNSHIP 6 NORTH, RANGE 2 WEST, OF THE SALT LAKE BASE AND MERIDIAN. BEGINNING AT A POINT BEING LOCATED SOUTH 00°40'10" WEST 766.47 FEET ALONG THE WEST LINE OF SAID SOUTHEAST QUARTER AND NORTH 90°00'00" EAST 40.00 FEET FROM THE NORTHWEST CORNER OF SAID SOUTHEAST QUARTER; RUNNING THENCE SOUTH 89°19'49" EAST 312.37 FEET; THENCE NORTH 00°48'07" EAST 119.79 FEET; THENCE SOUTH 89°11'53" EAST 957.73 FEET; THENCE SOUTH 00°51'40" WEST 677.86 FEET; THENCE NORTH 88°59'30" WEST 1268.12 FEET; THENCE NORTH 00°40'10" EAST 552.78 FEET TO THE POINT OF BEGINNING. CONTAINING 18.823 ACRES.

SURVEYOR'S CERTIFICATE

I, KLINT H. WHITNEY, DO HEREBY CERTIFY THAT I AM A LICENSED PROFESSIONAL LAND SURVEYOR IN THE STATE OF UTAH AND THAT I HOLD CERTIFICATE NO. 8227228 IN ACCORDANCE WITH TITLE 58, CHAPTER 22, OF THE PROFESSIONAL ENGINEERS AND LAND SURVEYORS ACT; I FURTHER CERTIFY THAT BY AUTHORITY OF THE OWNERS I HAVE COMPLETED A SURVEY OF THE PROPERTY AS SHOWN AND DESCRIBED ON THIS PLAT, AND HAVE SUBDIVIDED SAID PROPERTY INTO LOTS AND STREETS, TOGETHER WITH EASEMENTS, HEREAFTER TO BE KNOWN AS MARZIALE SUBDIVISION IN ACCORDANCE WITH SECTION 17-23-17 AND HAVE VERIFIED ALL MEASUREMENTS; THAT THE REFERENCE MONUMENTS SHOWN HEREON ARE LOCATED AS INDICATED AND ARE SUFFICIENT TO RETRACE OR REESTABLISH THIS SURVEY; THAT ALL LOTS MEET THE REQUIREMENTS OF THE LAND USE CODE; AND THAT THE INFORMATION SHOWN HEREIN IS SUFFICIENT TO ACCURATELY ESTABLISH THE LATERAL BOUNDARIES OF THE HEREIN DESCRIBED TRACT OF REAL PROPERTY.

SIGNED THIS _____ DAY OF _____, 2021.



KLINT H. WHITNEY, PLS NO. 8227228

OWNER'S DEDICATION

I, THE UNDERSIGNED OWNER OF THE HEREON DESCRIBED TRACT OF LAND, HEREBY SET APART AND SUBDIVIDE THE SAME INTO LOTS, PARCELS AND STREETS AS SHOWN ON THIS PLAT AND NAME SAID TRACT:

MARZIALE SUBDIVISION

AND HEREBY DEDICATE, GRANT AND CONVEY TO WEBER COUNTY, UTAH ALL THOSE PARTS OR PORTIONS OF SAID TRACT OF LAND DESIGNATED AS STREETS, THE SAME TO BE USED AS PUBLIC THOROUGHFARES FOREVER, AND ALSO GRANT AND DEDICATE A PERPETUAL EASEMENT OVER, UPON AND UNDER THE LANDS DESIGNATED ON THE PLAT AS PUBLIC UTILITY, THE SAME TO BE USED FOR THE INSTALLATION, MAINTENANCE AND OPERATION OF PUBLIC UTILITY SERVICE LINES, STORM DRAINAGE FACILITIES OR FOR THE PERPETUAL PRESERVATION OF WATER DRAINAGE CHANNELS IN THEIR NATURAL STATE WHICH EVER IS APPLICABLE AS MAY BE AUTHORIZED BY WEBER COUNTY, UTAH, WITH NO BUILDINGS OR STRUCTURES BEING ERRECTED WITHIN SUCH EASEMENTS.

SIGNED THIS ___ DAY OF _____, 2021.

BY: JAMES MARZIALE,
A.K.A. JAMES R MARZIALE JR.

BY: STEPHANIE MARZIALE
A.K.A. STEPHANIE H MARZIALE

ACKNOWLEDGEMENT

STATE OF UTAH)
COUNTY OF WEBER)

On this _____ day of _____, 2021, before me _____, A Notary Public, personally appeared JAMES MARZIALE, also known as, JAMES R MARZIALE JR., Proved on the basis of satisfactory evidence to be the person(s) whose name(s) (is/are) subscribed to this instrument, and acknowledged (he/she/they) executed the same. Witness my hand and official seal.

STAMP

NOTARY PUBLIC

ACKNOWLEDGEMENT

STATE OF UTAH)
COUNTY OF WEBER)

On this _____ day of _____, 2021, before me _____, A Notary Public, personally appeared STEPHANIE MARZIALE, also known as, STEPHANIE H MARZIALE, Proved on the basis of satisfactory evidence to be the person(s) whose name(s) (is/are) subscribed to this instrument, and acknowledged (he/she/they) executed the same. Witness my hand and official seal.

STAMP

NOTARY PUBLIC

NOTES

- ZONE A-1 CURRENT YARD SETBACKS: FRONT 30', SIDE 10' WITH TOTAL WIDTH OF 2 SIDE YARDS NOT LESS THAN 24', REAR 30'
- SUBJECT PROPERTY FALLS WITHIN FEMA FLOOD ZONE "X" - AREAS DETERMINED TO BE OUTSIDE THE 0.2% ANNUAL CHANCE FLOODPLAIN, PER FEMA MAP NO. 49057C0425E WITH AN EFFECTIVE DATE OF DECEMBER 16, 2005.
-


AGRICULTURAL NOTE:
AGRICULTURE IS THE PREFERRED USE IN THE AGRICULTURE ZONES. AGRICULTURE OPERATIONS AS SPECIFIED IN THE ZONING ORDINANCE FOR A PARTICULAR ZONE ARE PERMITTED AT ANY TIME INCLUDING THE OPERATION OF FARM MACHINERY AND NO ALLOWED AGRICULTURE USE SHALL BE SUBJECT TO RESTRICTION ON THAT IT INTERFERES WITH ACTIVITIES OF FUTURE RESIDENTS OF THIS SUBDIVISION.

NARRATIVE

THE PURPOSE OF THIS SURVEY WAS TO CREATE A FOURTEEN LOT SUBDIVISION ON THE PROPERTY AS SHOWN AND DESCRIBED HEREON. THE SURVEY WAS ORDERED BY JAMES MARZIALE. THE CONTROL USED TO ESTABLISH THE BOUNDARY WAS THE EXISTING WEBER COUNTY SURVEY MONUMENTATION SURROUNDING SECTION 29, TOWNSHIP 6 NORTH, RANGE 2 WEST OF THE SALT LAKE BASE AND MERIDIAN AS SHOWN AND NOTED HEREON. THE BASIS OF BEARING IS THE WEST LINE OF THE SOUTHEAST QUARTER OF SAID SECTION 29, WHICH BEARS SOUTH 00°40'10" WEST WEBER COUNTY, UTAH NORTH, NAD 83 STATE PLANE GRID BEARING. THE RIGHT-OF-WAY OF 4700 STREET WAS ESTABLISHED BY HONORING THE PROJECTED RIGHT-OF-WAY DEDICATION OF THE OLSEN ESTATES SUBDIVISION AND THE NELSON ESTATES SUBDIVISION. WARRANTY DEED RECORDED AS ENTRY NUMBER 3051635 AND 2986547 ALONG WITH DEEDS OF ADJOINING PROPERTIES WERE USED TO DETERMINE BOUNDARY LOCATION.

CENTER QUARTER CORNER SEC. 29, T6N, R2W, S.L.B.&M. (FOUND 3" WEBER COUNTY BRASS CAP MONUMENT IN 8" CONCRETE 8" BELOW ROAD GOOD COND. 1963)

EAST QUARTER CORNER SEC. 29, T6N, R2W, S.L.B.&M. (FOUND 3" WEBER COUNTY BRASS CAP MONUMENT IN RING AND COLLAR 4" BELOW ROAD GOOD COND. 2004)

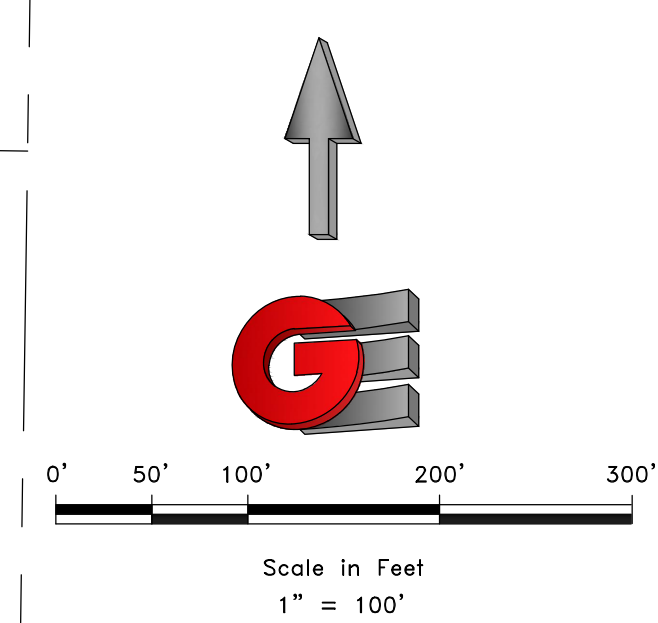

LEGEND

- ◆ WEBER COUNTY MONUMENT AS NOTED
- SET 24" REBAR AND CAP MARKED GARDNER ENGINEERING
- SUBDIVISION BOUNDARY
- LOT LINE
- - - ADJACENT PARCEL
- - - SECTION LINE
- - - EASEMENT
- - - EXISTING FENCE LINE

PUE?

CURVE #	LENGTH	RADIUS	DELTA	CHORD BEARING	CHORD LENGTH
C1	78.30	210.00	21°21'44"	S79° 21' 20"E	77.84
C2	78.30	210.00	21°21'43"	S79° 21' 20"E	77.84
C3	98.01	200.51	28°00'16"	N75° 57' 40"E	97.03
C4	106.61	210.52	29°00'56"	N76° 27' 59"E	105.47
C5	65.99	177.00	21°21'44"	S79° 21' 20"E	65.61
C6	90.60	243.00	21°21'43"	S79° 21' 20"E	90.08
C7	114.13	233.51	28°00'16"	N75° 57' 40"E	113.00
C8	89.90	177.52	29°00'56"	N76° 27' 59"E	88.94
C9	90.60	243.00	21°21'44"	S79° 21' 20"E	90.08
C10	65.99	177.00	21°21'43"	S79° 21' 20"E	65.61
C11	123.32	243.52	29°00'56"	S76° 27' 59"W	122.01
C12	81.88	167.51	28°00'16"	S75° 57' 40"W	81.06
C13	4.42	243.00	1°02'33"	S89° 30' 56"E	4.42
C14	86.18	243.00	20°19'11"	S78° 50' 04"E	85.73
C15	16.52	177.00	5°20'51"	S71° 20' 53"E	16.51
C16	49.47	177.00	16°00'53"	S82° 01' 45"E	49.31
C17	20.49	243.52	4°49'17"	N64° 22' 10"E	20.49
C18	102.83	243.52	24°11'39"	N78° 52' 38"E	102.07
C19	7.93	177.52	2°33'39"	N63° 14' 21"E	7.93
C20	81.96	177.52	26°27'16"	N77° 44' 49"E	81.24

Our current records show parcel 150790122 under the ownership of Ferrin Jenkins. If this has not changed they will need to sign the plat as well or deeds will need to be recorded prior to the plat being recorded.

Lots 1-4 have a closure error

10.8' PUE?


Are lot corners set, or going to be set?

Not parallel? If the 10' dedication is not parallel, you need to dimension it.

Show evidence of occupation throughout the property.

A signature block for County Surveyor conforming to state code and county ordinance. Weber County Surveyor: I hereby certify that the Weber County Surveyor's Office has reviewed this plat and all conditions for approval by this office have been satisfied. The approval of this plat by the Weber County Surveyor does not relieve the Licensed Land Surveyor who executed this plat from the responsibilities and/or liabilities associated therewith. Signed this _____ day of _____, 2021.

Webber County Surveyor Record of Survey # _____ SOUTH QUARTER CORNER SEC. 29, T6N, R2W, S.L.B.&M. (FOUND 3" WEBER COUNTY BRASS CAP MONUMENT IN 8" CONCRETE 4" BELOW ROAD FAIR COND. 1963)

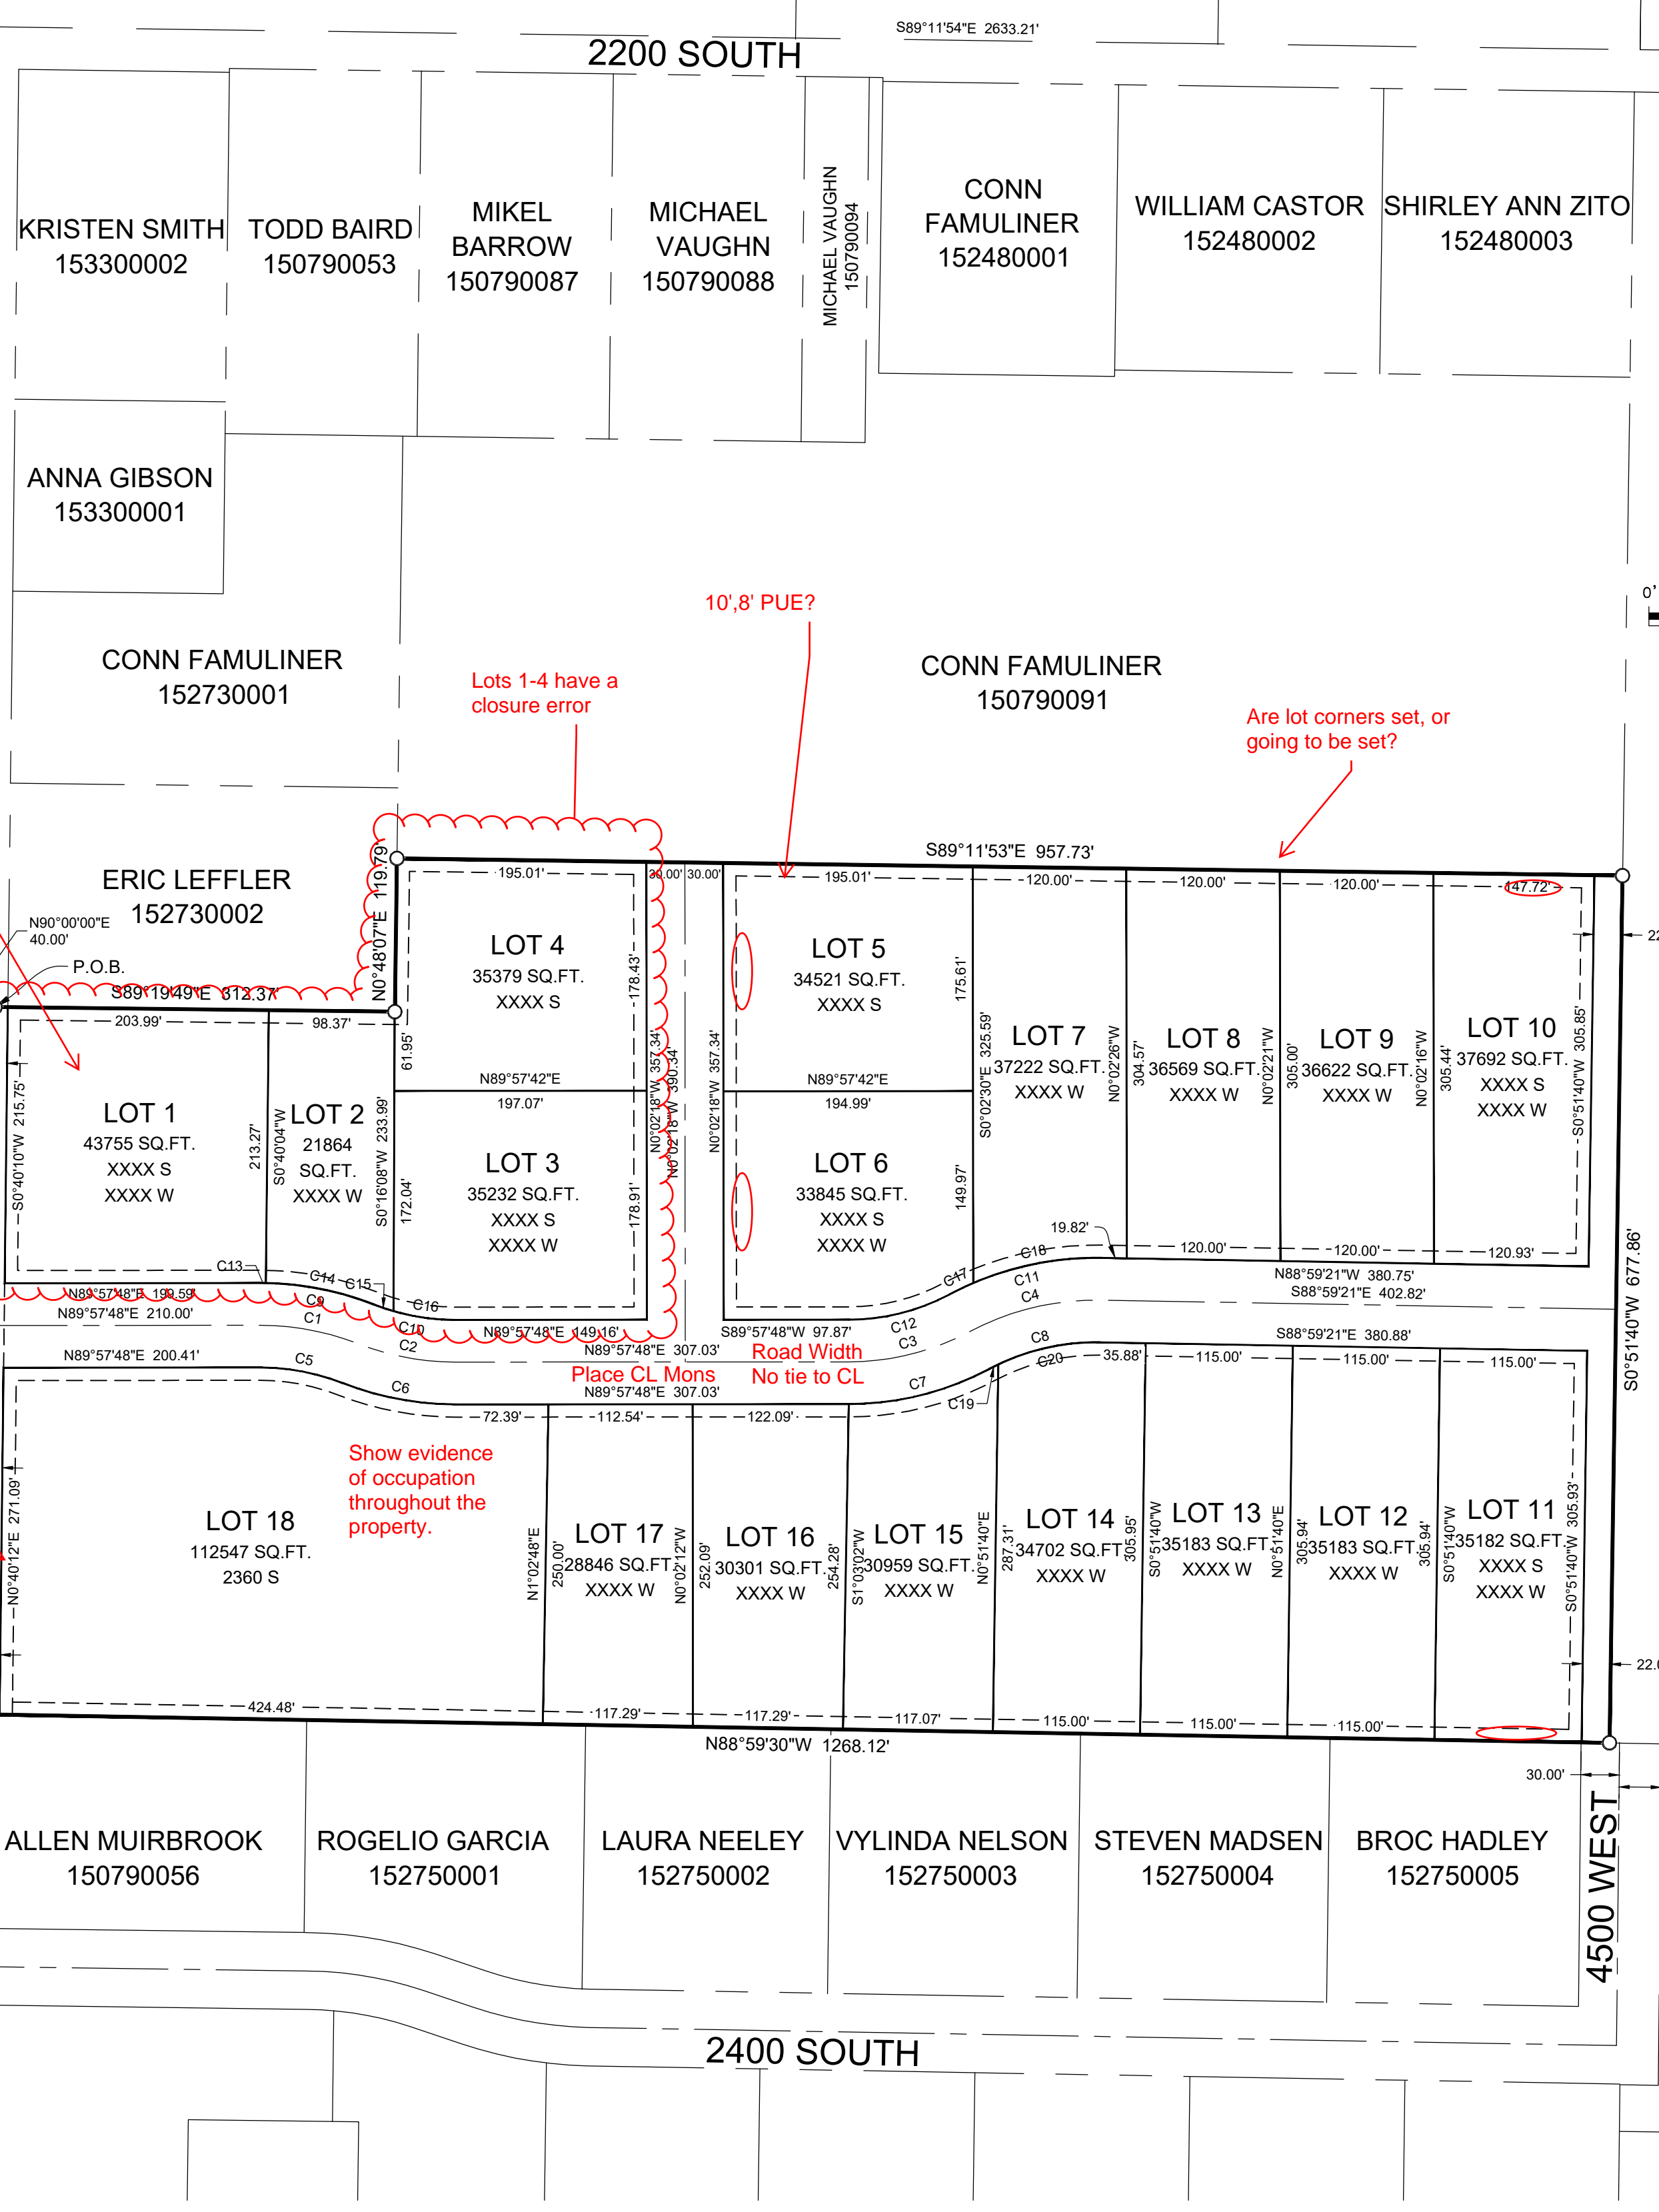

WEBER COUNTY SURVEYOR
I HEREBY CERTIFY THAT THE WEBER COUNTY SURVEYOR'S OFFICE HAS REVIEWED THIS PLAT FOR MATHEMATICAL CORRECTNESS, SECTION CORNER DATA, AND FOR HARMONY WITH LINES AND MONUMENTS ON RECORD IN COUNTY OFFICES. THE APPROVAL OF THIS PLAT BY THE WEBER COUNTY SURVEYOR DOES NOT RELIEVE THE LICENSED LAND SURVEYOR WHO EXECUTED THIS PLAT FROM THE RESPONSIBILITIES AND/OR LIABILITIES ASSOCIATED THEREWITH.
SIGNED THIS _____ DAY OF _____, 2021.

WEBER COUNTY ATTORNEY
I HAVE EXAMINED THE FINANCIAL GUARANTEE AND OTHER DOCUMENTS ASSOCIATED WITH THIS SUBDIVISION PLAT AND IN MY OPINION THEY CONFORM WITH THE COUNTY ORDINANCE APPLICABLE THERETO AND NOW IN FORCE AND EFFECT.
SIGNED THIS _____ DAY OF _____, 2021.

WEBER COUNTY ENGINEER
I HEREBY CERTIFY THAT THE REQUIRED PUBLIC IMPROVEMENT STANDARDS AND DRAWINGS FOR THIS SUBDIVISION CONFORM WITH COUNTY STANDARDS AND THE AMOUNT OF THE FINANCIAL GUARANTEE IS SUFFICIENT FOR THE INSTALLATION OF THESE IMPROVEMENTS.
SIGNED THIS _____ DAY OF _____, 2021.

WEBER COUNTY COMMISSION ACCEPTANCE
THIS IS TO CERTIFY THAT THIS SUBDIVISION PLAT, THE DEDICATION OF STREETS AND OTHER PUBLIC WAYS AND FINANCIAL GUARANTEE OF PUBLIC IMPROVEMENTS ASSOCIATED WITH THIS SUBDIVISION THEREON ARE HEREBY APPROVED AND ACCEPTED BY THE COMMISSIONERS OF WEBER COUNTY, UTAH.
SIGNED THIS _____ DAY OF _____, 2021.

WEBER COUNTY PLANNING COMMISSION APPROVAL
THIS IS TO CERTIFY THAT THIS SUBDIVISION WAS DULY APPROVED BY THE WEBER COUNTY PLANNING COMMISSION.
SIGNED THIS _____ DAY OF _____, 2021.

WEBER - MORGAN HEALTH DEPARTMENT
I DO HEREBY CERTIFY THAT THE SOILS, PERCOLATION RATES, AND SITE CONDITION FOR THIS SUBDIVISION HAVE BEEN INVESTIGATED BY THIS OFFICE AND ARE APPROVED FOR ON-SITE WASTEWATER DISPOSAL SYSTEMS.
SIGNED THIS _____ DAY OF _____, 2021.

DEVELOPER: JAMES MARZIALE 2360 SOUTH 4700 WEST TAYLOR, UTAH 801-	S1 1	COUNTY RECORDER
ENTRY NO. _____ FEE PAID _____ FILED FOR AND RECORDED _____ AT _____ IN BOOK _____ OF OFFICIAL RECORDS, PAGE _____ RECORDED FOR _____ COUNTY RECORDER		
		BY: _____
5150 SOUTH 875 EAST OGDEN, UT OFFICE: 801.476.0202 FAX: 801.476.0066		

R1345E - MARZIALE, JAMES R 2021 - 4700 WEST SUBDIVISION SURVEYOR'S OFFICE 4700 WEST SUBDIVISION.DWG