

# Terakee Farm® - No. 1

A PRUD Subdivision

A part of the Southeast Quarter of Section 9, T6N, R2W, SLB&M, U.S. Survey

Weber County, Utah

January 2022

## SURVEYOR'S CERTIFICATE

I, Andy Hubbard, do hereby certify that I am a Professional Land Surveyor in the State of Utah, and that I hold Certificate No. 6242920 in accordance with Title 58, Chapter 22, of the Professional Engineers and Land Surveyors Licensing Act. I also certify that I have completed a survey of the property described herein in accordance with Section 17-23-17 and that I have verified all measurements shown hereon this plat of Terakee Farm No. 1 - A PRUD Subdivision in Weber County, Utah and that it has been correctly drawn to the designated scale and is a true and correct representation of the following description of lands included in said subdivision, based on data compiled from records in the Weber County Recorder's Office. Monuments have been found or placed as represented on this plat. I furthermore certify that all lots within this Subdivision hereby meet all current lot width and area requirements of the Weber County Zoning Ordinance.

Signed this \_\_\_\_\_ day of \_\_\_\_\_, 2022.

6242920  
License No.

Andy Hubbard

## OWNERS DEDICATION

We the undersigned owners of the herein described tract of land, do hereby set apart and subdivide the same into lots as shown on the plat and name said tract Terakee Farms No. 1 - A PRUD Subdivision and do hereby dedicate and grant to Weber County a perpetual right and easement on and over the Open Space parcels for agriculture preservation easements to guarantee to Weber County that the Open Space parcels remain open and undeveloped except for approved agricultural, recreational, and open space purposes except to be used and maintained by the owner of said parcel(s) for approved agricultural purposes, and also do grant and dedicate a perpetual right and easement over, upon and under the lands designated hereon as Private Streets and/or public utility easements, the same to be used for the maintenance and operation of Sanitary Sewer lines and Structures, Storm Drainage Lines and Structures and/or public utility service lines and storm drainage facilities, whichever is applicable as may be authorized by the governing authority, with no buildings or structures being erected within such easements.

We also dedicate and reserve unto themselves, their heirs, their grantees and assigns, a right-of-way to be used in common with all others within said Subdivision (and those adjoining Subdivisions that may be subdivided by the undersigned owners, their successors, or assigns) on, over and across all those portions or parts of said tract of land designated on said plat as Private Streets (Private rights-of-way) as access to the individual lots, to be maintained by Terakee Farms, Inc. their grantees, successors, or assigns.

We also do hereby dedicate, grant and convey to Terakee Farm, Inc. the Parcels and also dedicate and grant a perpetual right and easement over, upon and under the lands designated hereon as Parcels, for Storm Water Detention, Landscaping, and Secondary Water facility purposes. The same to be used for the maintenance and operation of storm drainage facilities, Secondary Water facilities as applicable as may be authorized by the governing authority, with no residential buildings or structures being erected within such parcels unless otherwise defined in the Codes, Covenants, and Restrictions (CC&R's) for this development.

Terakee Farms Inc.

Brad Blanch

## ACKNOWLEDGMENT

State of Utah }  
County of } ss

The foregoing instrument was acknowledged before me this \_\_\_\_\_ day of \_\_\_\_\_, 2022 by \_\_\_\_\_, Owner.

Residing At: \_\_\_\_\_  
Commission Number: \_\_\_\_\_  
Commission Expires: \_\_\_\_\_  
A Notary Public commissioned in Utah  
Print Name

## AGRICULTURAL NOTE

Agriculture is the preferred use in the agriculture zones. Agricultural operations as specified in the Land Use Code for a particular zone are permitted at any time including the operation of farm machinery and no allowed agricultural use shall be subject to restrictions on the basis that it interferes with activities of future residents of this subdivision.

## WEBER COUNTY ENGINEER

I hereby certify that the required public improvement standards and drawings for this subdivision conform with County standards and the amount of the financial guarantee is sufficient for the installation of these improvements.  
Signed this \_\_\_\_\_ of \_\_\_\_\_, 2022.

Chairman, Weber County Planning Commission  
Weber County Engineer

## WEBER COUNTY PLANNING COMMISSION APPROVAL

This is to certify that this subdivision plat was duly approved by the Weber County Planning Commission.  
Signed this \_\_\_\_\_ day of \_\_\_\_\_, 2022.

Chairman, Weber County Commission

Attest: \_\_\_\_\_  
Title: \_\_\_\_\_

## WEBER COUNTY COMMISSION ACCEPTANCE

This is to certify that this subdivision plat, the dedication of streets and other public ways and financial guarantee of public improvements associated with this subdivision, thereon are hereby approved and accepted by the Commissioners of Weber County, Utah.  
Signed this \_\_\_\_\_ day of \_\_\_\_\_, 2022.

Chairman, Weber County Commission

Attest: \_\_\_\_\_  
Title: \_\_\_\_\_

# TENTATIVE FINAL

Sheet 1 of 2

## WEBER COUNTY RECORDER

ENTRY NO. \_\_\_\_\_ FEE PAID \_\_\_\_\_  
RECORDED \_\_\_\_\_ FILED FOR RECORD AND \_\_\_\_\_ AT \_\_\_\_\_  
RECORDS, PAGE \_\_\_\_\_ OF OFFICIAL RECORDS, RECORDED FOR \_\_\_\_\_

## WEBER COUNTY RECORDER


BY: \_\_\_\_\_ DEPUTY

Curve	Delta	Radius	Length	Chord	Chord Bearing
(C1)	15°42'21"	225.00'	61.68'	61.48'	N 41°21'26" E
(C2)	89°49'10"	10.00'	15.68'	14.12'	N 78°24'50" E
(C3)	2°44'11"	442.54'	21.14'	21.13'	S 58°14'47" E
(C4)	7°00'39"	442.54'	54.15'	54.12'	S 63°07'12" E
(C5)	80°51'07"	10.08'	14.22'	13.07'	S 26°01'47" E
(C6)	4°42'42"	617.64'	50.79'	50.78'	S 12°24'53" W
(C7)	4°56'48"	617.64'	53.33'	53.31'	S 7°35'08" W
(C8)	5°35'43"	617.64'	60.32'	60.29'	S 2°18'52" W
(C9)	3°45'55"	617.64'	62.15'	62.12'	S 3°21'37" E
(C10)	5°59'12"	617.64'	64.53'	64.51'	S 9°14'30" E
(C11)	13°04'28"	15.00'	3.42'	3.42'	S 5°41'29" E
(C12)	30°21'49"	15.00'	7.95'	7.86'	S 16°01'39" W
(C13)	35°03'23"	80.00'	48.95'	48.19'	S 13°40'52" W
(C14)	38°27'31"	80.00'	53.70'	52.70'	S 23°04'35" E
(C15)	43°33'19"	80.00'	60.81'	59.36'	S 64°05'00" E
(C16)	42°04'39"	80.00'	58.75'	57.44'	N 73°08'00" E
(C17)	39°57'44"	80.00'	55.80'	54.67'	N 32°04'49" E
(C18)	36°03'01"	80.00'	50.34'	48.51'	S 5°55'34" W
(C19)	32°55'22"	80.00'	45.97'	45.34'	N 40°24'45" W
(C20)	38°14'01"	80.00'	53.38'	52.40'	N 75°59'27" W

Curve	Delta	Radius	Length	Chord	Chord Bearing
(C21)	85°52'48"	15.00'	22.48'	20.44'	N 52°10'03" W
(C22)	5°31'12"	567.64'	54.69'	54.67'	N 6°28'24" W
(C23)	5°29'26"	567.64'	54.40'	54.38'	N 0°58'05" W
(C24)	6°10'10"	567.64'	61.12'	61.09'	N 4°51'44" E
(C25)	6°20'55"	567.64'	62.90'	62.86'	N 11°07'16" E
(C26)	89°15'24"	10.03'	15.63'	14.10'	N 59°06'17" E
(C27)	9°11'09"	425.00'	68.14'	68.06'	S 80°40'22" E
(C28)	6°06'39"	425.00'	45.33'	45.31'	S 88°19'16" E
(C29)	23°54'38"	125.00'	52.16'	51.79'	N 76°40'06" E
(C30)	5°38'41"	10.00'	0.99'	0.98'	N 67°32'07" E
(C31)	68°51'43"	10.00'	12.02'	11.31'	S 75°12'40" E
(C32)	1°28'01"	3701.68'	94.78'	94.78'	S 41°30'49" E
(C33)	0°55'40"	3701.68'	59.95'	59.94'	S 42°42'40" E
(C34)	0°55'38"	3701.68'	59.90'	59.90'	S 43°38'19" E
(C35)	0°55'36"	3701.68'	59.91'	59.91'	S 44°33'37" E
(C36)	1°15'56"	3701.68'	81.76'	81.76'	S 45°39'45" E
(C37)	0°17'53"	3701.68'	19.26'	19.26'	S 46°26'39" E
(C38)	64°48'27"	15.00'	16.97'	16.08'	S 14°11'22" E
(C39)	33°13'35"	80.00'	46.39'	45.75'	S 1°36'04" W
(C40)	36°33'40"	80.00'	51.05'	50.19'	S 33°17'34" E

## Legend

- Monument to be set
- Found Centerline Monument (Rad.) Radial Line (N/R) Non-Radial Line
- PUE Public Utility Easement
- PU&DE Public Utility & Drainage Easement
- Fence
- Buildable Area
- Easement
- Existing Boundary
- Set Hub & Tack
- A will be set Nail in Curb
- Extension of Property
- Set 5/8"x 24" Long Rebar & Cap w/ Lathe

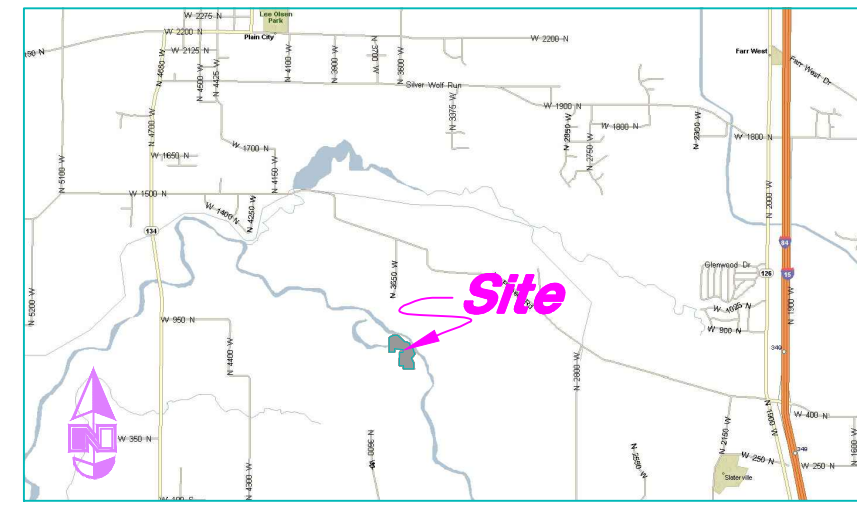

VICINITY MAP (Not to Scale)

## NARRATIVE

This Subdivision Plat was requested by Mr. Brad Blanch for the purpose of creating forty (40) residential Lots and five (1) Open Space Parcel.

Brass Cap Monuments were found at the Southeast Corner and the South Quarter Corner of Section 9, T6N, R2W, SLB&M.

A line bearing South 89°26'17" East between these two monuments was used as the Basis of Bearings.

Property Corners were monumented as depicted on this plat.

If Curb and Gutter is installed, "Rivets will be set in the Top Back of Curb on the extension of the Property Line.

If Curb and Gutter is deferred, the front Property Corners will be required to have Rebar and Cap set.

SEE ROS# \_\_\_\_\_ Filed with the Weber County Surveyor's Office for Overall Boundary Retracement Details.

## DESCRIPTION

A part of the Southeast Quarter of Section 9, Township 6 North, Range 2 West, Salt Lake Base and Meridian, U.S. Survey Beginning at the Northwest corner of Lot 1 McFarland Subdivision (Weber County Recorder Entry # 1672850) said point being 937.19 feet South 89°26'19" East along the Section line and 1,049.27 feet North 00°33'41" East from the South Quarter corner of said Section, and running thence North 89°03'48" West 17.49 feet along the North line of said McFarland Subdivision to the East line of the Richard and Carisa Hipwell property (Property #15-028-0054); thence North 00°46'31" East 55.61 feet along said Eastern line; thence South 89°13'18" East 64.06 feet to the point of curve of a non-tangent curve, of which the radius point lies North 00°46'47" East; thence Easterly along the arc of a 74.97 foot radius curve to the left a distance of 54.39 feet (Central Angle equals 41°34'11" and Long Chord bears North 69°59'42" East 53.21 feet); thence North 49°12'36" East 448.50 feet to the point of curve of a non-tangent curve, of which the radius point lies North 39°43'30" West; thence Northeasterly along the arc of a 154.15 foot radius curve to the left a distance of 47.78 feet (Central Angle equals 17°45'32" and Long Chord bears North 41°23'44" East 47.59 feet) to the point of curve of a non-tangent curve, of which the radius point lies North 56°25'09" West; thence Northerly along the arc of a 10.00 foot radius curve to the left a distance of 15.75 feet (Central Angle equals 90°15'26" and Long Chord bears North 11°32'52" West 14.17 feet); thence North 33°19'25" East 50.00 feet; thence South 56°40'35" East 233.49 feet to a point of curvature; thence Easterly along the arc of a 375.00 foot radius curve to the left a distance of 227.11 feet (Central Angle equals 34°42'00" and Long Chord bears South 74°01'35" East 223.66 feet); thence North 88°37'31" East 53.32 feet to the point of curve of a non-tangent curve, of which the radius point lies North 01°22'34" West; thence Northeasterly along the arc of a 75.00 foot radius curve to the left a distance of 107.01 feet (Central Angle equals 81°45'13" and Long Chord bears North 47°44'49" East 98.16 feet); thence South 83°07'46" East 50.00 feet to the point of curve of a non-tangent curve, of which the radius point lies North 83°07'46" West; thence Southerly along the arc of a 125.00 foot radius curve to the right a distance of 4.82 feet (Central Angle equals 02°12'30" and Long Chord bears South 07°58'29" West 4.82 feet); thence South 73°49'55" East 79.81 feet to the point of curve of a non-tangent curve, of which the radius point lies North 48°41'54" East; thence Southeasterly along the arc of a 3,551.71 foot radius curve to the left a distance of 277.57 feet (Central Angle equals 04°28'40" and Long Chord bears South 43°32'26" East 277.50 feet) to a point of compound curvature thence Easterly along the arc of a 15.00 foot radius curve to the left a distance of 11.81 feet (Central Angle equals 45°05'36" and Long Chord bears South 68°19'33" East 11.50 feet) to the point of curve of a non-tangent curve, of which the radius point lies South 00°48'02" East; thence Southeasterly along the arc of a 180.00 foot radius curve to the right a distance of 297.22 feet (Central Angle equals 94°36'33" and Long Chord bears South 43°29'46" East 264.59 feet); thence South 01°26'04" West 292.07 feet; thence North 89°04'26" West 1,056.92 feet to the Southeast corner of said McFarland Subdivision; thence two (2) courses along the East and North boundaries of said subdivision as follows: (1) North 00°56'30" East 362.32 feet; (2) North 89°03'30" West 438.81 feet to the point of curve of a non-tangent curve, of which the radius point lies South 30°56'18" East; thence Southwesterly along the arc of a 88.68 foot radius curve to the left a distance of 89.65 feet (Central Angle equals 57°55'25" and Long Chord bears South 30°06'00" West 85.88 feet) to the East right of way line of 3600 West Street as dedicated on said Subdivision; thence North 00°59'41" East 74.99 feet along said East right of way line to the POINT OF BEGINNING.

Containing 17.7043 acres, more or less

## AGRICULTURAL NOTE

Agriculture is the preferred use in the agriculture zones. Agricultural operations as specified in the Land Use Code for a particular zone are permitted at any time including the operation of farm machinery and no allowed agricultural use shall be subject to restrictions on the basis that it interferes with activities of future residents of this subdivision.

## NOTES:

- 10' wide Public Utility and Drainage Easements (P.U.&D.E.) on front lot lines as indicated by dashed lines except as otherwise shown.
- All Lots will have a 20' Frontage and 5' Side (20' Corner) and Rear Yard Building Setback except as otherwise shown.
- Second Fire Apparatus Access Road approved by the Weber County Fire Marshall must be capable of carrying 75,000 pounds in all weather conditions year-round. The Second Fire Apparatus Access Road surface will include 8" road base to support this capacity.

## WEBER COUNTY SURVEYOR

I hereby certify that the Weber County Surveyor's Office has reviewed this plat and all conditions for approval by this office have been satisfied. The approval of this plat by the Weber County Surveyor does not relieve the Licensed Land Surveyor who executed this plat from the responsibilities and/or liabilities associated therewith.  
Signed this \_\_\_\_\_ day of \_\_\_\_\_, 2022.

Weber County Surveyor  
Record of Survey # \_\_\_\_\_

## WEBER COUNTY ATTORNEY

I have examined the financial guarantee and other documents associated with this subdivision plat, and in my opinion they conform with the County Ordinance applicable thereto and now in force and effect.  
Signed this \_\_\_\_\_ day of \_\_\_\_\_, 2022.

Weber County Attorney

ENGINEER:  
Great Basin Engineering Inc  
c/o Andy Hubbard, PLS  
5746 South 1475 East Suite 200  
Ogden, Utah 84405  
(801) 394-4515

DEVELOPER:  
Terakee Investments, LLC  
c/o Brad Blanch  
1060 East 3400 North  
North Ogden, UT 84414  
(801) 688-8365



# Terakee Farm® PRUD No. 1

A PRUD Subdivision

A part the Southeast Quarter of Section 9, T6N, R2W, SLB&M, U.S. Survey  
Weber County, Utah  
January 2022




Northeast Corner of Section 9, T6N, R2W, SLB&M, U.S. Survey (Found Weber County Brass Cap in good condition Flush with Ground Dated 1963)

Reference Monument to East 1/4 Corner of Section 9, T6N, R2W, SLB&M, U.S. Survey (Found Weber County Reference Monument Flush w/ Ground Dated 2001)

East 1/4 Corner of Section 9, T6N, R2W, SLB&M, U.S. Survey (Calc'd Position per Weber County Tie Sheet and Reference Monuments)

### Legend

- Monument to be set
- Found Centerline Monument (Rad.) Radial Line (N/R) Non-Radial Line
- PUE Public Utility Easement
- PU&DE Public Utility & Drainage Easement
- Fence
- Buildable Area
- Easement
- Existing Boundary
- Set Hub & Tack
- A will be set Nail in Curb
- Extension of Property
- Set 5/8" x 24" Long Rebar & Cap w/ Lathe

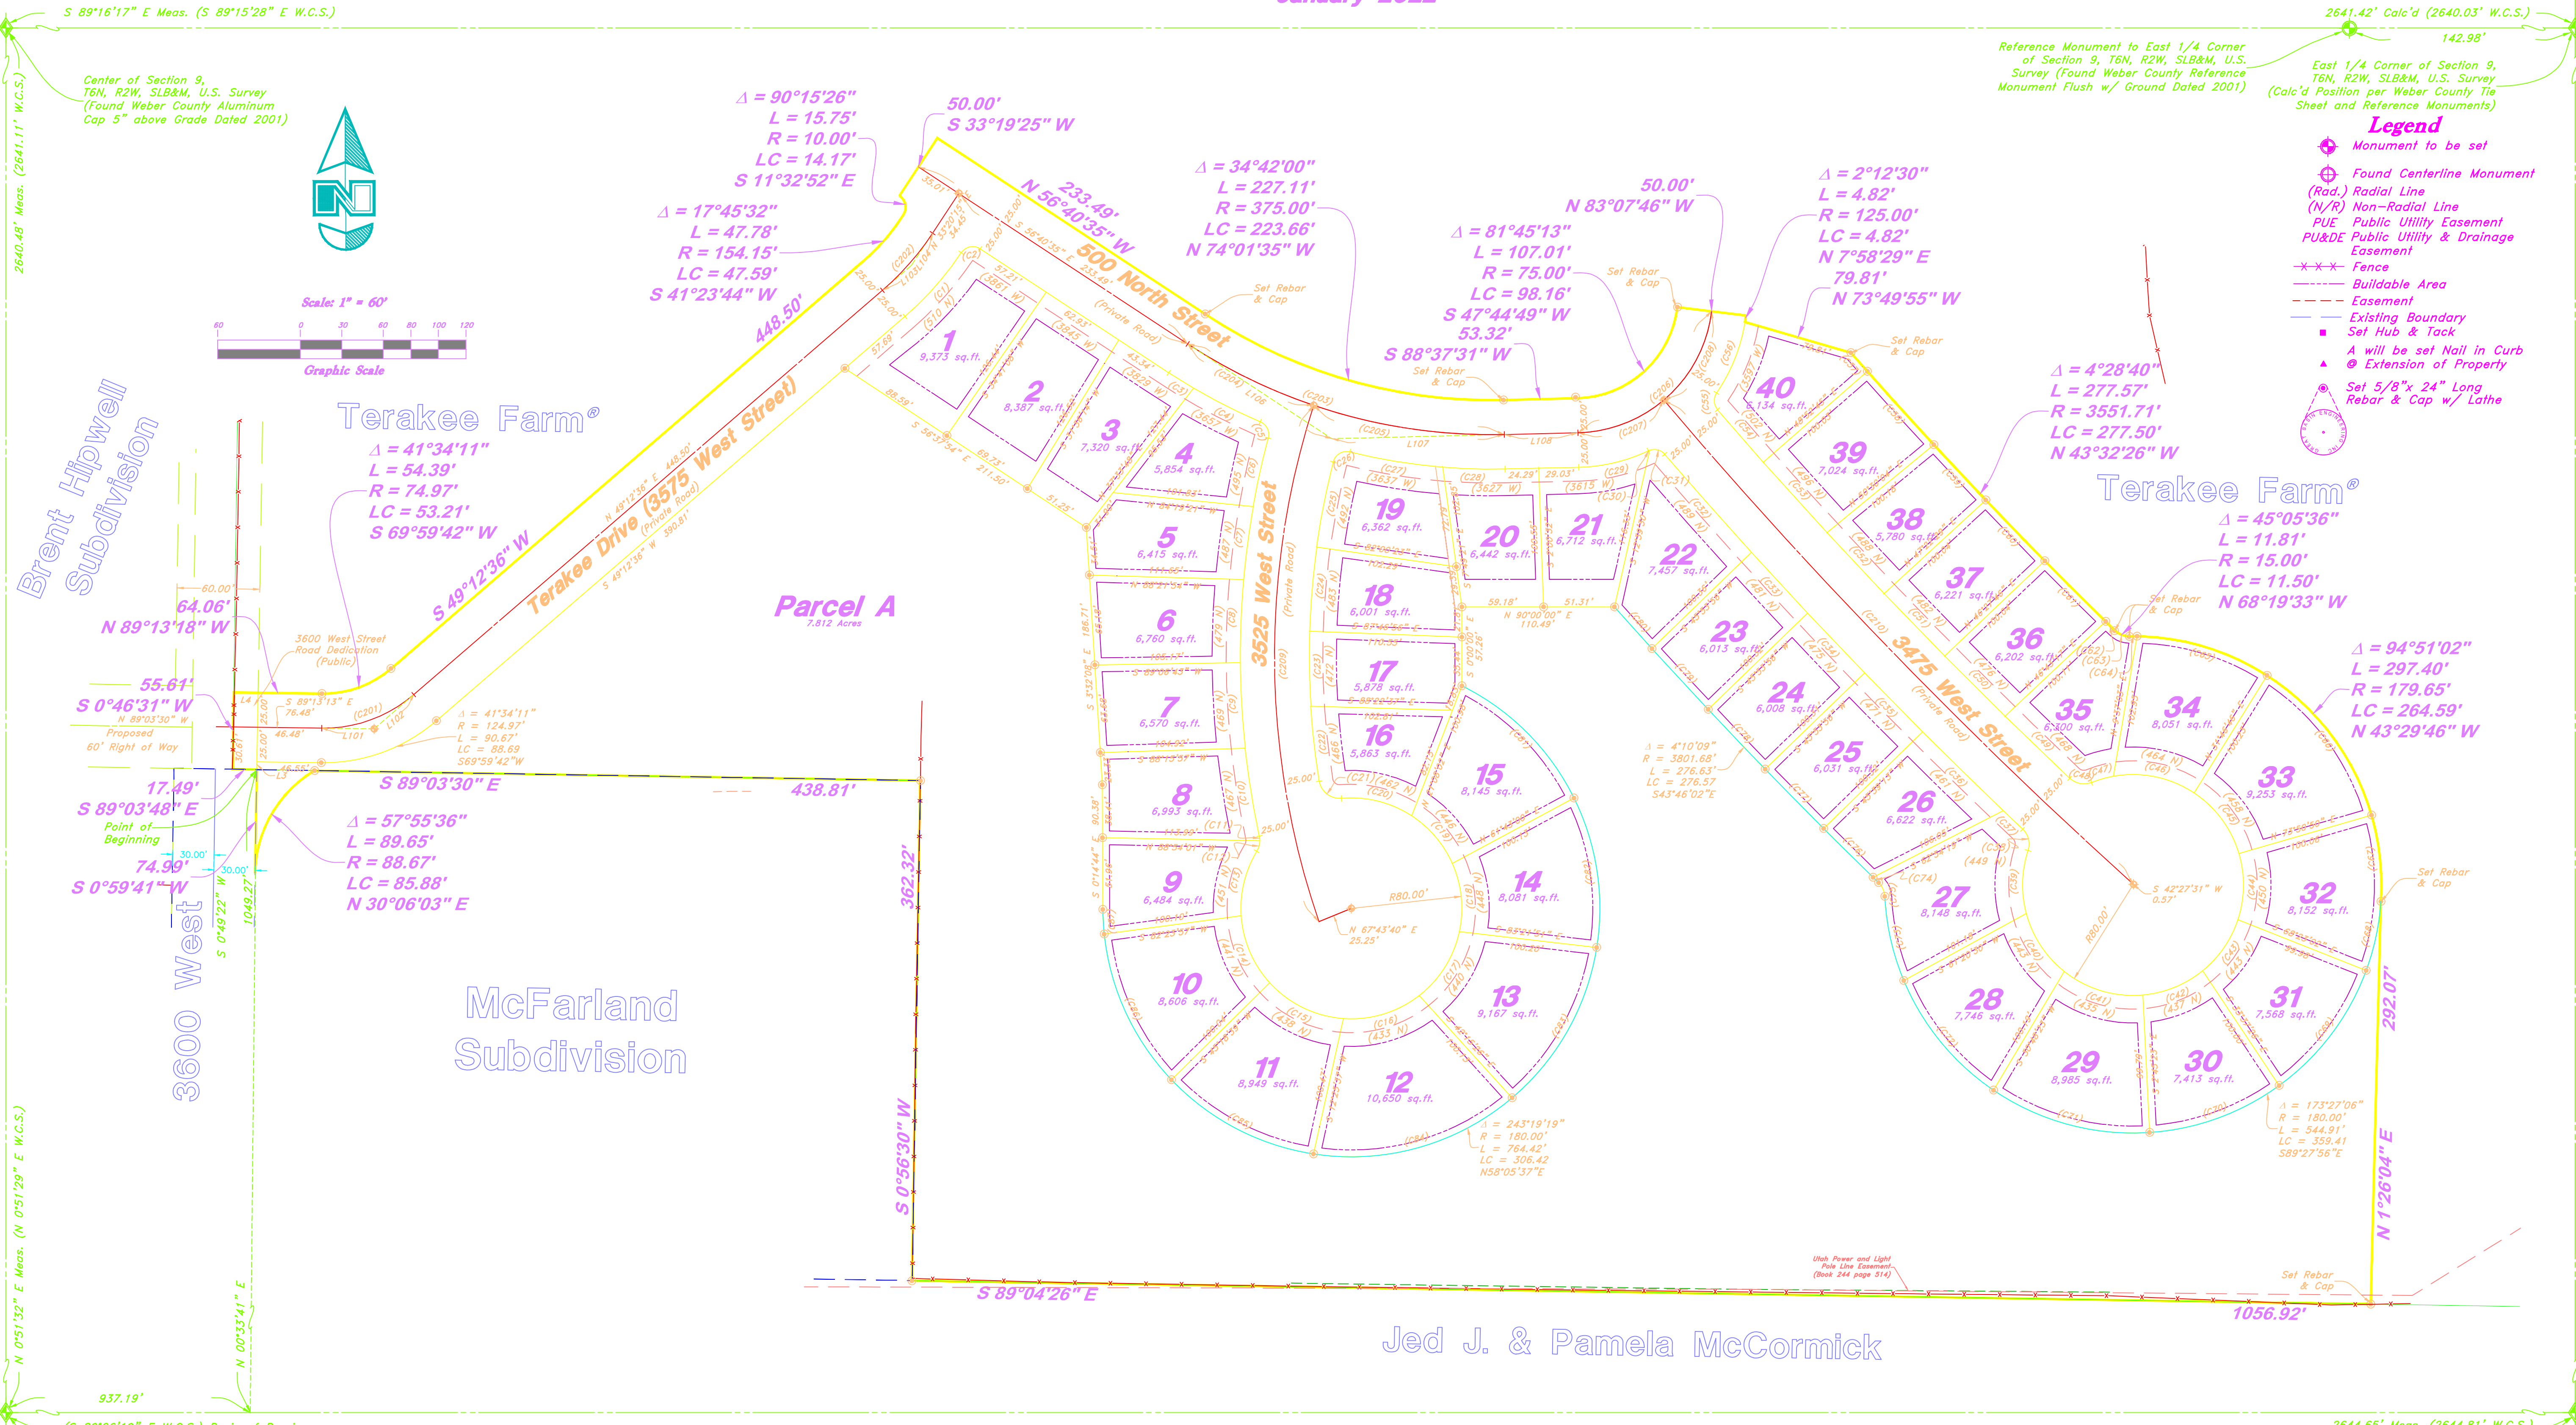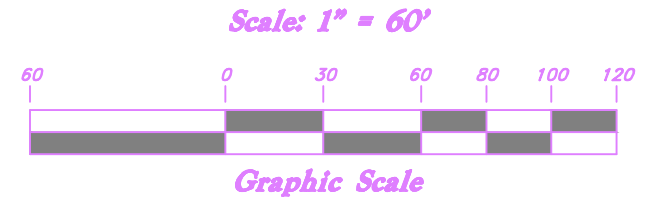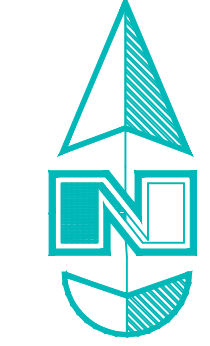

Terakee Farm®

Terakee Farm®

McFarland Subdivision

Parcel A  
7.812 Acres

Jed J. & Pamela McCormick

### NOTES:

1. 10' wide Public Utility and Drainage Easements (P.U.&D.E.) on front lot lines as indicated by dashed lines except as otherwise shown.
2. Setbacks for the Lots are as Follows:
  - 2.1. Small Lots (60' wide): 20' front, 5' side and 5' back.
  - 2.2. All Other Lots (80' feet wide or more): 20' front, 10' foot side and 5' back.
3. Subdivision Boundary and Lot Corners will be set prior to final recording of plat.

### AGRICULTURAL NOTE

Agriculture is the preferred use in the agriculture zones. Agricultural operations as specified in the Land Use Code for a particular zone are permitted at any time including the operation of farm machinery and no allowed agricultural use shall be subject to restrictions on the basis that it interferes with activities of future residents of this subdivision.

# TENTATIVE FINAL

**GREAT BASIN ENGINEERING**  
5746 SOUTH 1475 EAST OGDEN, UTAH 84403  
MAIN (801)394-4515 S.L.C (801)521-0222 FAX (801)392-7544  
WWW.GREATBASINENGINEERING.COM

ENGINEER:  
Great Basin Engineering Inc  
c/o Andy Hubbard  
3746 South 1475 East Suite 200  
Ogden, Utah 84405  
(801) 394-4515

DEVELOPER:  
Terakee Investments, LLC  
c/o Brad Blanch  
1060 East 3400 North  
North Ogden, UT 84414  
(801) 668-8565

Sheet 2 of 2

WEBER COUNTY RECORDER

ENTRY NO. \_\_\_\_\_ FEE PAID \_\_\_\_\_

RECORDED \_\_\_\_\_ AT \_\_\_\_\_

IN BOOK \_\_\_\_\_ OF OFFICIAL RECORDS, PAGE \_\_\_\_\_, RECORDED FOR \_\_\_\_\_

WEBER COUNTY RECORDER

BY: \_\_\_\_\_ DEPUTY \_\_\_\_\_