

MONUMENT AT POWDER MOUNTAIN

Civil Construction Drawings


Approximately 8050 Summit Road
Eden, Utah

OWNER

OWNER Mike Brenny
PHONE: 801.808.9328
EMAIL: mike@thirdriverre.com

CIVIL ENGINEER

Fawkes Consultants
ADDRESS: 2701 N. Thanksgiving Way
Suite 100
Lehi, Utah 84043
CONTACT: Jordan "Guy" Williams, P.E.
PHONE: (213) 500-5936

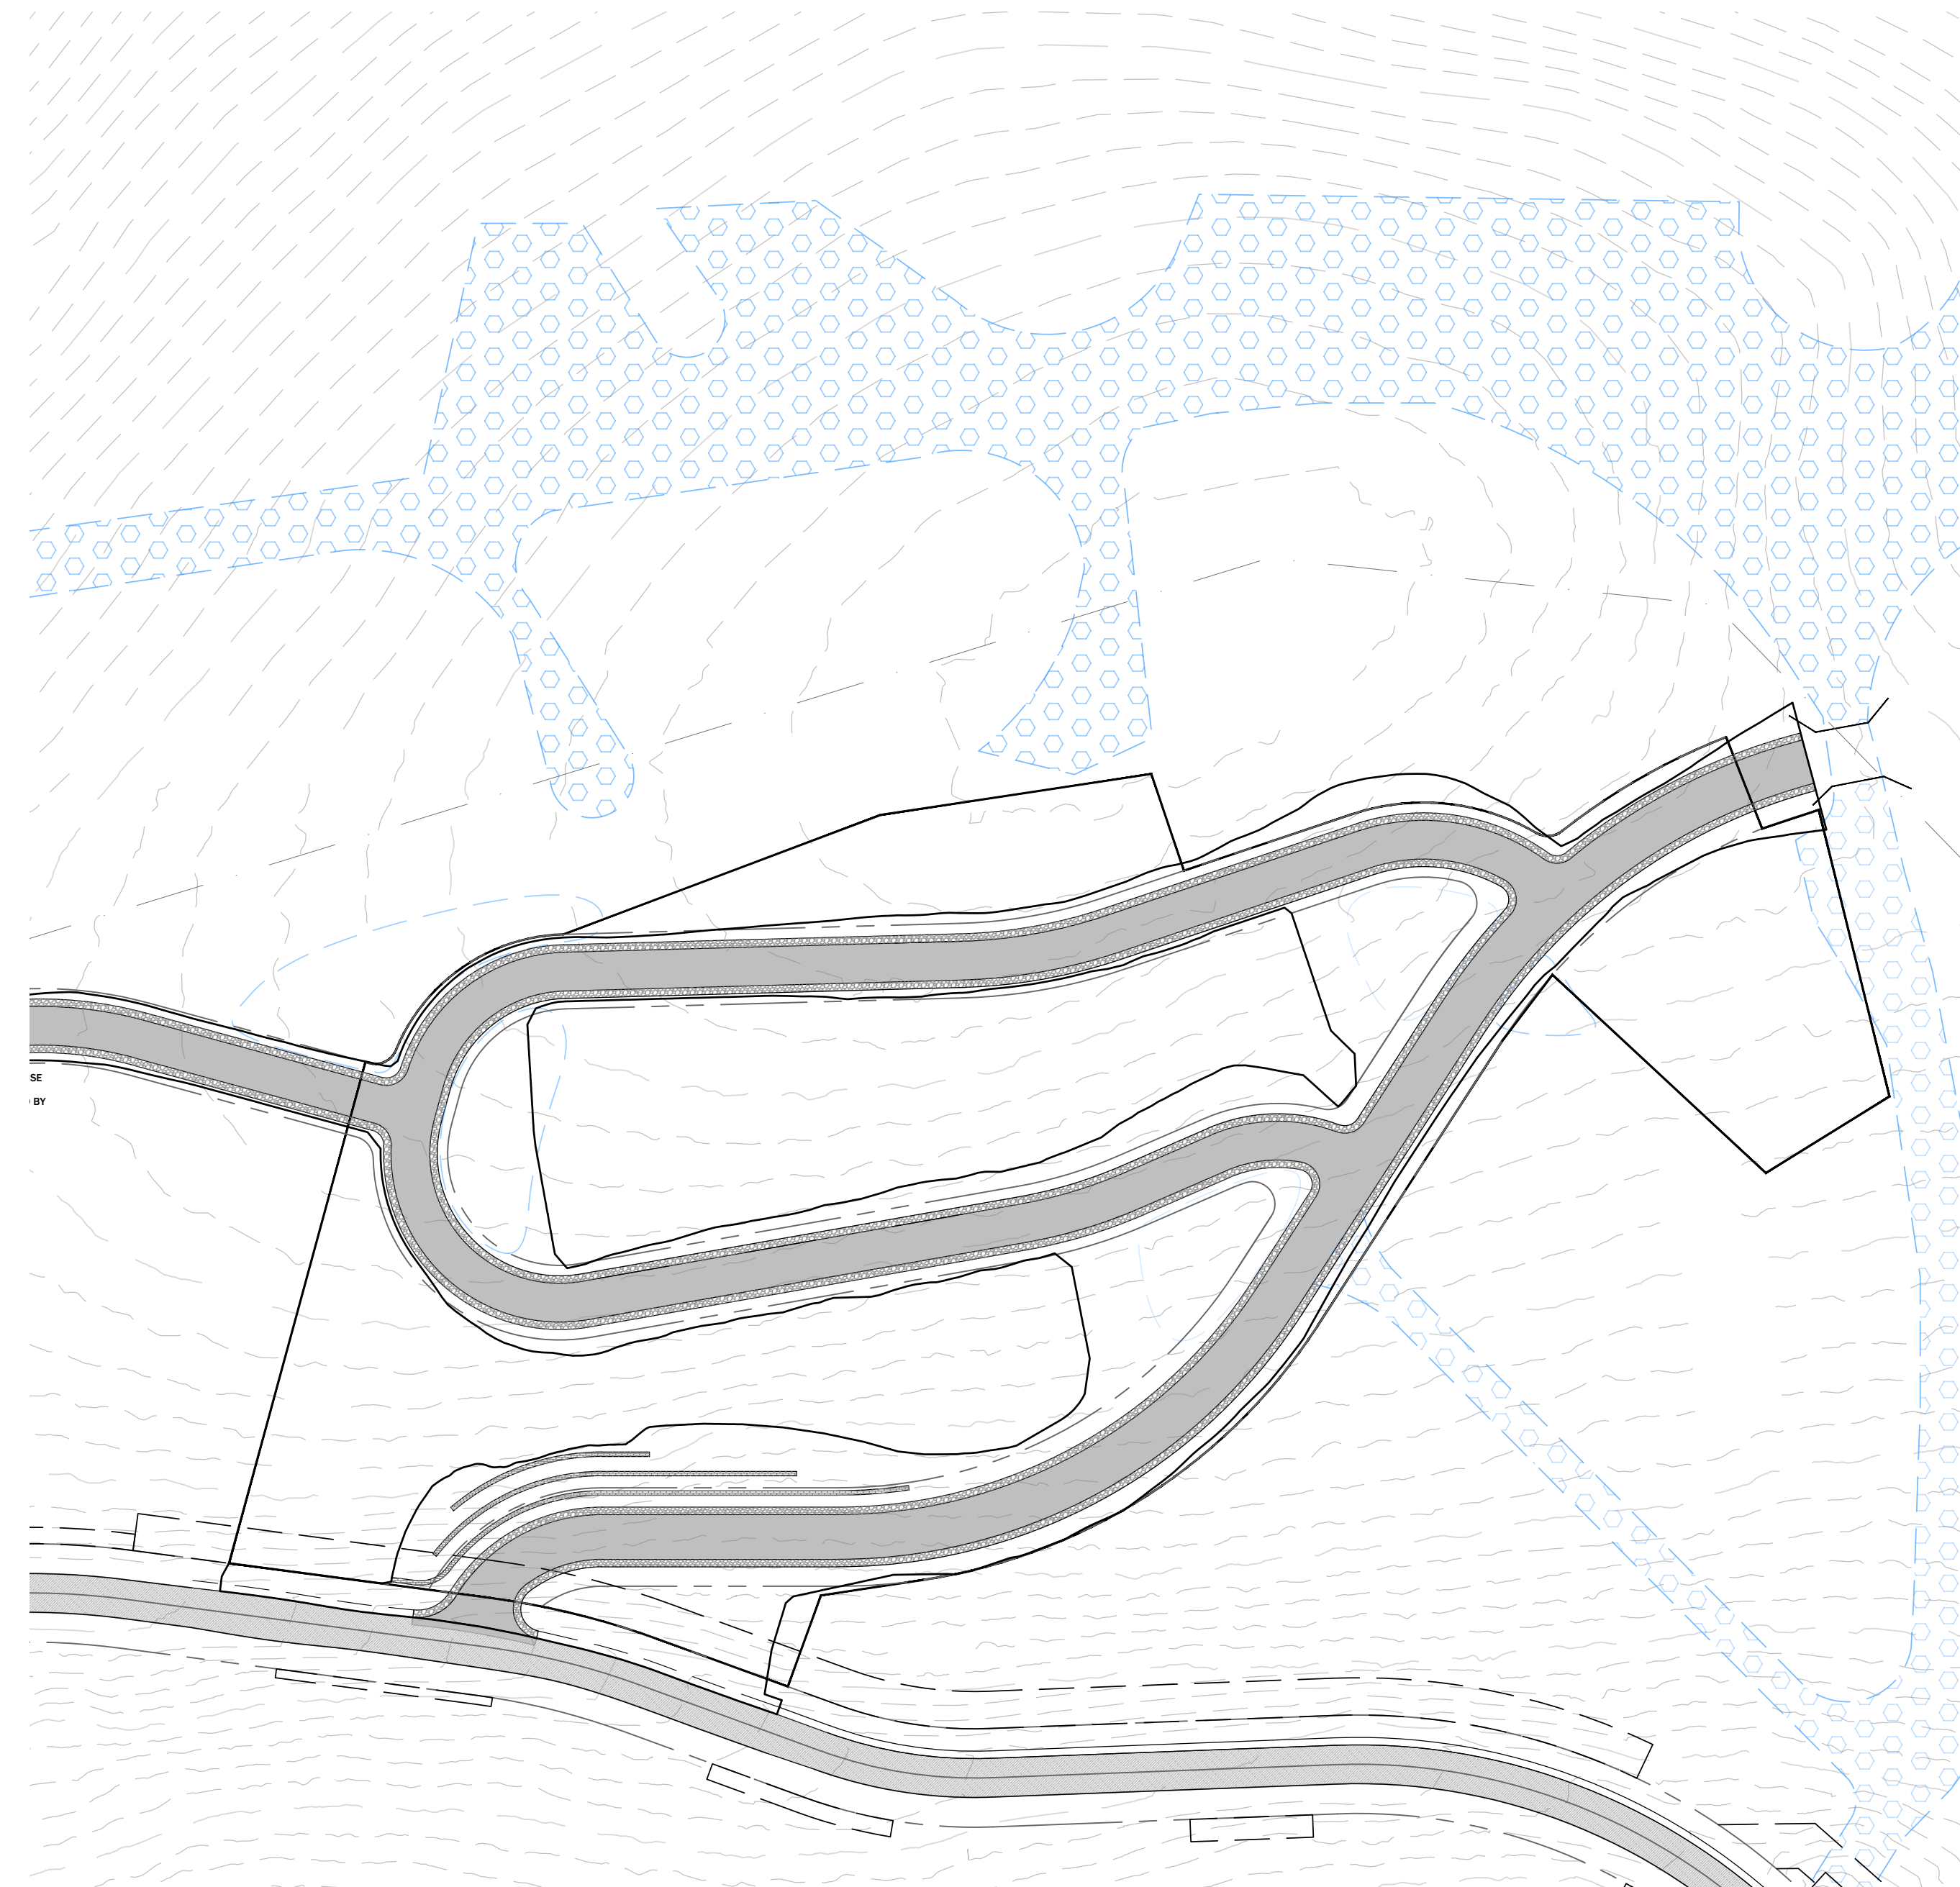


SHEET INDEX

Sheet Number	Sheet Title
CV	COVER SHEET
SM	SITE MAP
GN	GENERAL NOTES
C100	DEMOLITION PLAN
C200	SITE PLAN
C300	GRADING & DRAINAGE PLAN
C400	UTILITY PLAN
C500	PLAN & PROFILE
C501	PLAN & PROFILE
C502	PLAN & PROFILE
C503	PLAN & PROFILE
C800	DETAILS
C801	DETAILS
C802	DETAILS

BID SET



DATE	PROJECT NO.	DATE
5/26/2023	23.001	
REVISION	DATE	
1		
2		
3		
4		
5		
6		

COVER SHEET
MONUMENT AT POWDER MOUNTAIN
Approx. 8050 Summit Pass Road, Eden, Utah

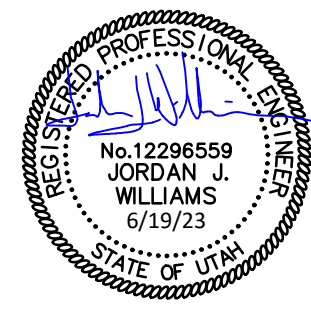

SCALE:
CV
DRAWN BY: CGW
1/14

VICINITY MAP

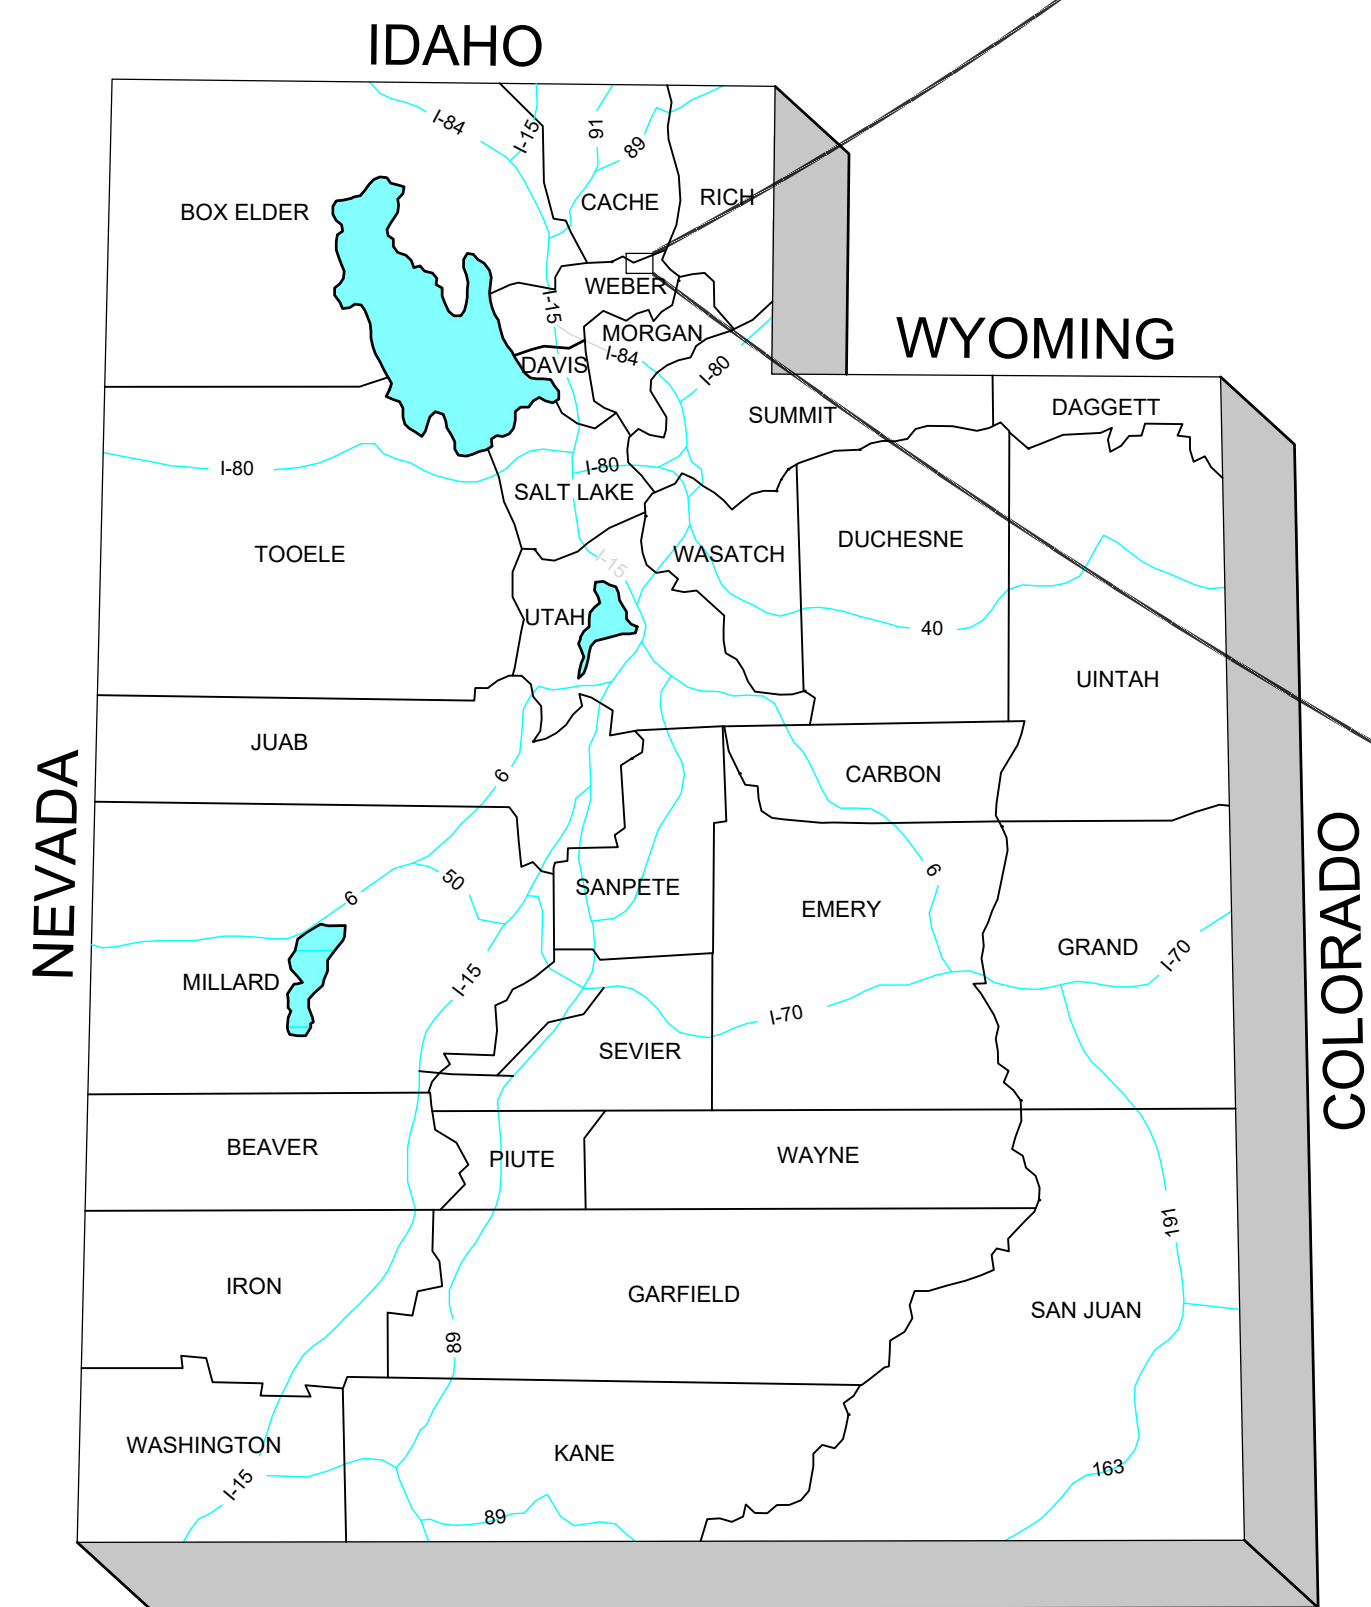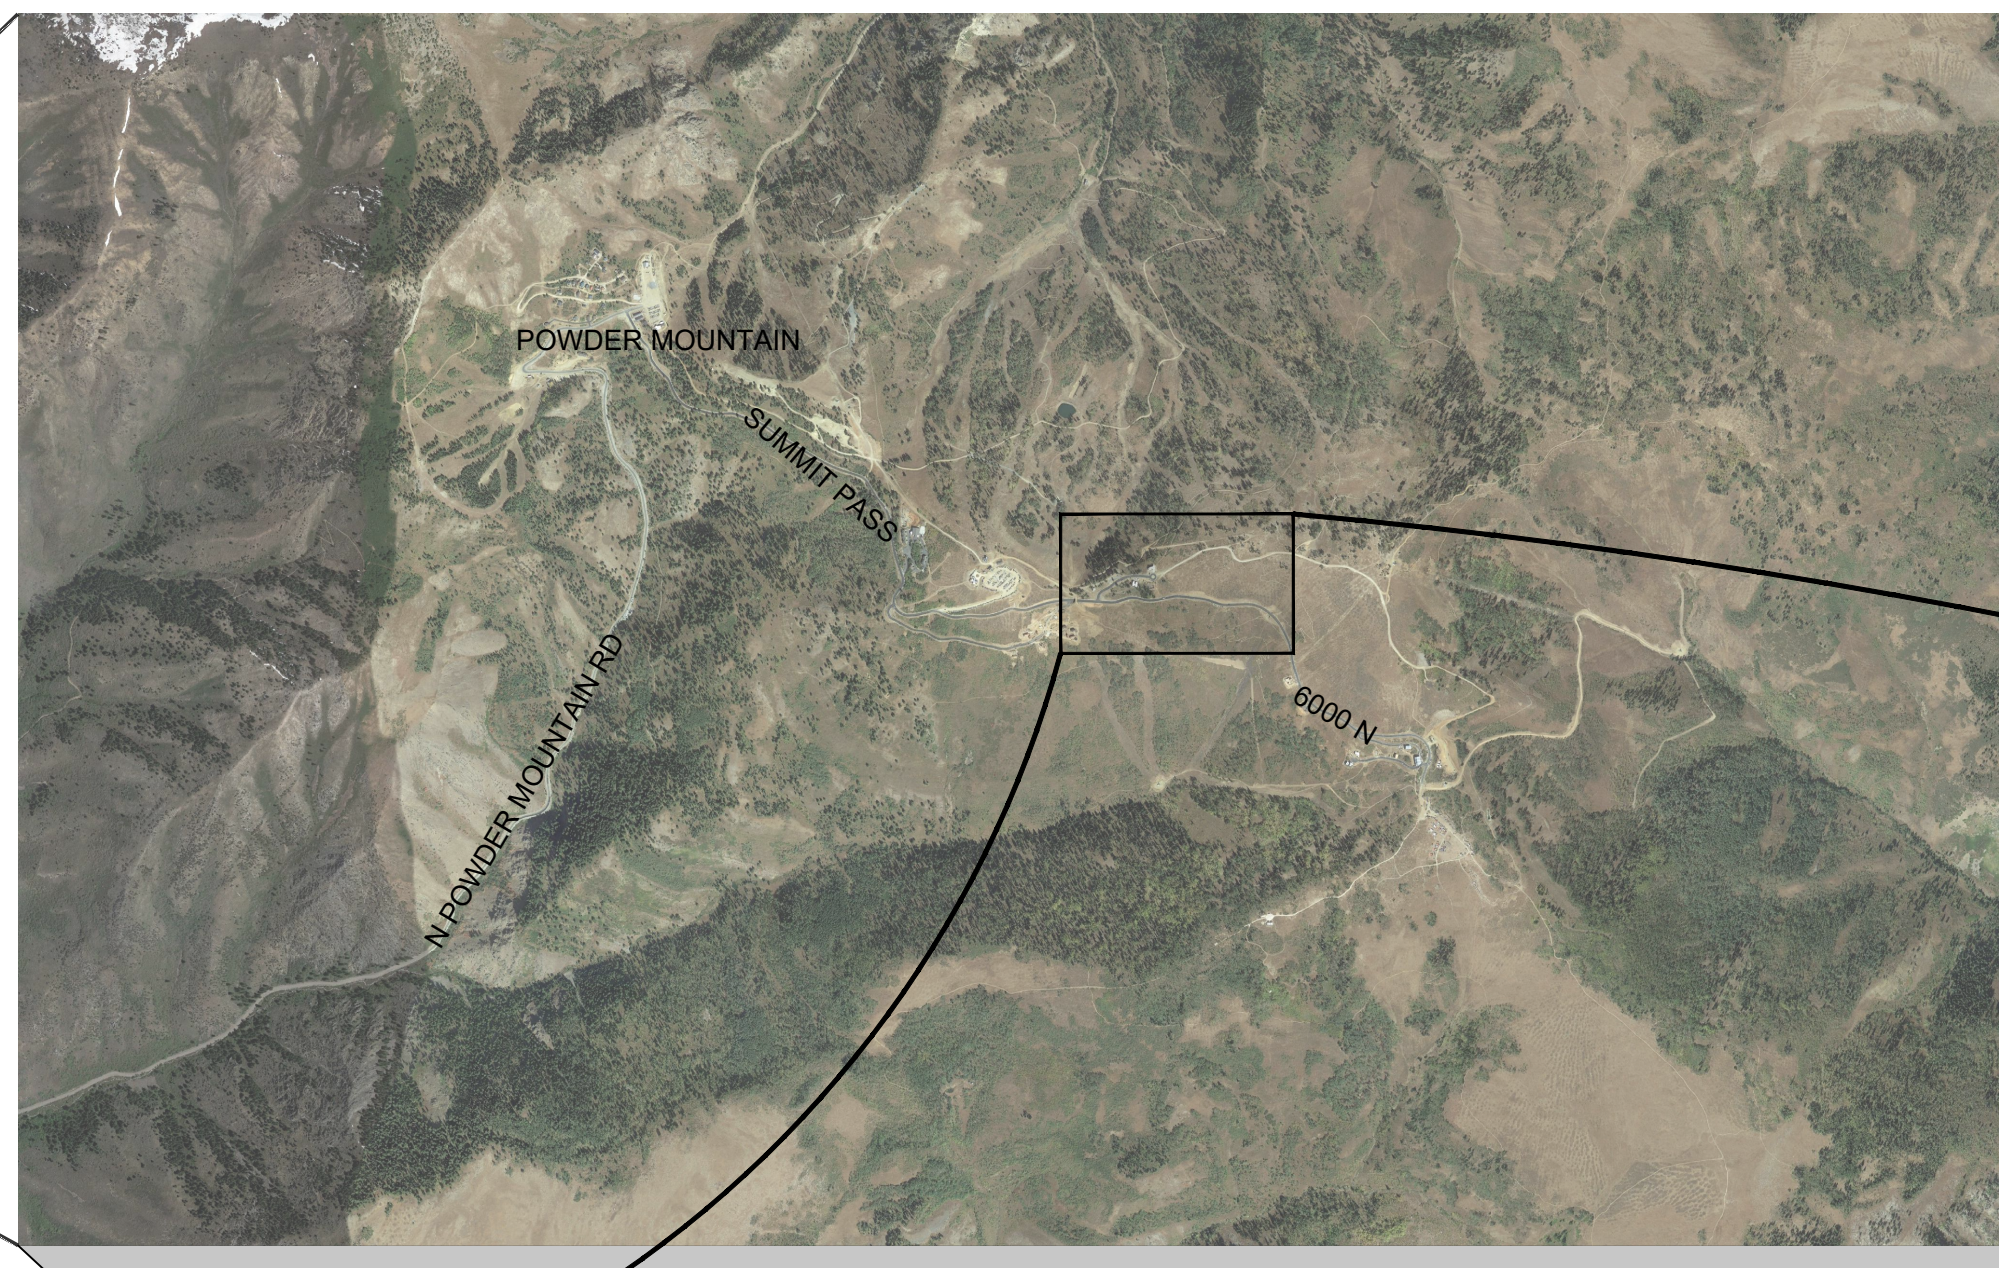

STATE MAP




SITE MAP

BID SET

DATE:	5/26/2023
PROJECT NO.:	23.001
REVISION	DATE
1	
2	
3	
4	
5	
6	

SITE MAP

MONUMENT AT POWDER MOUNTAIN
Approx. 8050 Summit Pass Road, Eden, Utah

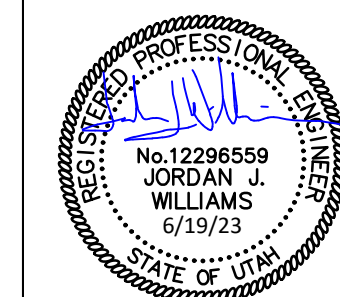

SCALE:

SM

DRAWN BY: CGW

THE CONTRACTOR SHALL CAREFULLY READ ALL OF THE NOTES AND SPECIFICATIONS, THE CONTRACTOR SHALL BE SATISFIED AS TO THE TRUE MEANING AND INTENTION AND SHALL BE RESPONSIBLE FOR COMPLYING WITH EACH.

GENERAL NOTES:

- 1) ALL IMPROVEMENTS SHALL BE CONSTRUCTED IN STRICT ACCORDANCE WITH THE FOLLOWING: CURRENT REGULATORY AGENCY STANDARDS AND SPECIFICATIONS, AND REGULATORY AGENCY COMPREHENSIVE PLAN, WHERE APPLICABLE.
- 2) PRIOR TO ANY WORK BEING PERFORMED, THE CONTRACTOR SHALL CONTACT REGULATORY AGENCY FOR A PRE-CONSTRUCTION CONFERENCE AS DIRECTED BY THE OWNER. CONTRACTOR SHALL ALSO NOTIFY THE BELOW LISTED PROJECT CONTACTS (48) HOURS IN ADVANCE OF SAID MEETING:
- | | |
|--|---|
| A. REGULATORY AGENCY:
WATER, SEWER, & STORM WATER | Weber County
170 N Main St.
Kamas, UT 84036
(435) 783-4630 |
| B. DEVELOPER: | DEV. Name |
| C. ENGINEER: | Fawkes Consultants
2701 N. Thanksgiving Way
LEHI, UT 84043
213.500.9336
CONTACT: gwilliams@fawkesconsultants.com
Guy Williams, P.E.
casey@fawkesconsultants.com
Casey Walker, PM |
| D. GAS | DOMINION ENERGY
CUSTOMER SERVICE LINE: (800) 923-5517 |
| E. POWER COMPANY: | ROCKY MOUNTAIN POWER
CUSTOMER SERVICE LINE: (801) 465-8020 |
| F. TELEPHONE COMPANY: | CENTURYLINK
CUSTOMER SERVICE LINE: (800) 603-6000 |

- 3) IT IS INTENDED THAT THESE PLANS AND SPECIFICATIONS REQUIRE ALL LABOR AND MATERIALS NECESSARY AND PROPER FOR THE WORK CONTEMPLATED AND THAT THE WORK BE COMPLETED IN ACCORDANCE WITH THEIR TRUE INTENT AND PURPOSE. THE CONTRACTOR SHALL NOTIFY THE ENGINEER IMMEDIATELY REGARDING ANY DISCREPANCIES OR AMBIGUITIES WHICH MAY EXIST IN THE PLANS OR SPECIFICATIONS. THE ENGINEER'S INTERPRETATION THEREOF SHALL BE CONCLUSIVE.
- 4) WHERE THE PLANS OR SPECIFICATIONS DESCRIBE PORTIONS OF THE WORK IN GENERAL TERMS BUT NOT IN COMPLETE DETAIL, IT IS UNDERSTOOD THAT ONLY THE BEST GENERAL PRACTICE IS TO PREVAIL AND THAT ONLY MATERIALS AND WORKMANSHIP OF THE FIRST QUALITY ARE TO BE USED.
- 5) THE CONTRACTOR SHALL BE SKILLED AND REGULARLY ENGAGED IN THE GENERAL CLASS AND TYPE OF WORK CALLED FOR IN THE PROJECT PLANS AND SPECIFICATIONS. THEREFORE, THE OWNER IS RELYING UPON THE EXPERIENCE AND EXPERTISE OF THE CONTRACTOR, IT SHALL BE EXPECTED THAT PRICES PROVIDED WITHIN THE CONTRACT DOCUMENTS SHALL INCLUDE ALL LABOR AND MATERIALS NECESSARY AND PROPER FOR THE WORK CONTEMPLATED AND THAT THE WORK BE COMPLETED IN ACCORDANCE WITH THEIR TRUE INTENT AND PURPOSE. THE CONTRACTOR SHALL BE COMPETENT, KNOWLEDGEABLE AND HAVE SPECIAL SKILLS IN THE NATURE, EXTENT AND INHERENT CONDITIONS OF THE WORK TO BE PERFORMED. CONTRACTOR SHALL ALSO ACKNOWLEDGE THAT THERE ARE CERTAIN PECULIAR AND INHERENT CONDITIONS EXISTENT IN THE CONSTRUCTION OF THE PARTICULAR FACILITIES, WHICH MAY CREATE, DURING THE CONSTRUCTION PROGRAM, UNUSUAL OR UNSAFE CONDITIONS HAZARDOUS TO PERSONS, PROPERTY AND THE ENVIRONMENT. CONTRACTOR SHALL BE AWARE OF SUCH PECULIAR RISKS AND HAVE THE SKILL AND EXPERIENCE TO FORSEE AND TO ADOPT PROTECTIVE MEASURES TO ADEQUATELY AND SAFELY PERFORM THE CONSTRUCTION WORK WITH RESPECT TO SUCH HAZARDS.
- 6) THE CONTRACTOR SHALL BE RESPONSIBLE FOR ALL PERMITS AND LICENSES REQUIRED FOR THE CONSTRUCTION AND COMPLETION OF THE PROJECT, AND SHALL PERFORM ALL WORK IN ACCORDANCE WITH THE REQUIREMENTS AND CONDITIONS OF ALL PERMITS AND APPROVALS APPLICABLE TO THIS PROJECT. THE CONTRACTOR SHALL ENSURE THAT THE NECESSARY RIGHT-OF-WAYS, EASEMENTS, AND/OR PERMITS ARE SECURED PRIOR TO CONSTRUCTION.
- 7) CONTRACTOR SHALL OBTAIN A LAND DISTURBANCE PERMIT WHERE APPLICABLE FOR ANY WORK DONE WITHIN RIGHT-OF-WAYS OR EASEMENTS FROM REGULATORY AGENCY AND/OR UDOT. CONTRACTOR SHALL NOTIFY REGULATORY AGENCY AND/OR STATE, 24 HOURS IN ADVANCE OF COMMENCING THE WORK, OR AS REQUIRED BY SAID PERMITS.
- 8) THE CONTRACTOR SHALL, AT THE TIME OF BIDDING, AND, THROUGHOUT THE PERIOD OF THE CONTRACT, BE LICENSED IN THE STATE OF UTAH AND SHALL BE BONDABLE FOR AN AMOUNT EQUAL TO OR GREATER THAN THE AMOUNT BID AND TO DO THE TYPE OF WORK CONTEMPLATED IN THE PLANS AND SPECIFICATIONS. CONTRACTOR SHALL BE SKILLED AND REGULARLY ENGAGED IN THE GENERAL CLASS AND TYPE OF WORK CALLED FOR IN THE PLANS AND SPECIFICATIONS.
- 9) OWNER SHALL FILE NOTICE OF INTENT WITH THE STATE OF UTAH DIVISION OF WATER QUALITY AND ALSO OBTAIN A FUGITIVE DUST CONTROL PERMIT AS REQUIRED.
- 10) CONTRACTOR SHALL INSPECT THE SITE OF THE WORK PRIOR TO BIDDING TO SATISFY THEMSELVES BY PERSONAL EXAMINATION OR BY SUCH OTHER MEANS AS THEY MAY PREFER, OF THE LOCATION OF THE PROPOSED WORK, AND OF THE ACTUAL CONDITIONS OF AND AT THE SITE OF WORK.

IF, DURING THE COURSE OF THEIR EXAMINATION, A BIDDER FINDS FACTS OR CONDITIONS WHICH APPEAR TO THEM TO BE IN CONFLICT WITH THE LETTER OR SPIRIT OF THE PROJECT PLANS AND SPECIFICATIONS, THEY SHALL CONTACT THE ENGINEER FOR ADDITIONAL INFORMATION AND EXPLANATION BEFORE SUBMITTING THEIR BID.

SUBMISSION OF A BID BY THE CONTRACTOR SHALL CONSTITUTE ACKNOWLEDGMENT THAT, IF AWARDED THE CONTRACT, THEY HAVE RELIED AND ARE RELYING ON THEIR OWN EXAMINATION OF (1) THE SITE OF THE WORK, (2) ACCESS TO THE SITE, AND (3) ALL OTHER DATA AND MATTERS REQUISITE TO THE FULFILLMENT OF THE WORK AND ON THEIR OWN KNOWLEDGE OF EXISTING FACILITIES ON AND IN THE VICINITY OF THE SITE OF THE WORK TO BE CONSTRUCTED UNDER THIS CONTRACT.

THE INFORMATION PROVIDED BY THE OWNER OR THE ENGINEER IS NOT INTENDED TO BE A SUBSTITUTE FOR, OR A SUPPLEMENT TO THE INDEPENDENT VERIFICATION BY THE CONTRACTOR TO THE EXTENT SUCH INDEPENDENT INVESTIGATION OF SITE CONDITIONS IS DEEMED NECESSARY OR DESIRABLE BY THE CONTRACTOR. CONTRACTOR SHALL ACKNOWLEDGE THAT THEY HAVE NOT RELIED SOLELY UPON OWNER OR ENGINEER FURNISHED INFORMATION REGARDING SITE CONDITIONS IN PREPARING AND SUBMITTING THEIR BID.

- 11) THE CONTRACTOR SHALL PROVIDE ALL LIGHTS, BARRICADES, SIGNS, FLAGMEN OR OTHER DEVICES NECESSARY FOR PUBLIC SAFETY, AS REQUIRED BY REGULATORY AGENCY. IF TRAFFIC CONTROL IS NECESSARY, A TRAFFIC CONTROL PLAN SHOULD BE SUBMITTED TO REGULATORY AGENCY ENGINEERING DEPARTMENT FOR APPROVAL PRIOR TO ANY WORK BEING STARTED.
- 12) THE CONTRACTOR SHALL BE RESPONSIBLE TO PROVIDE ALL WATER, POWER, SANITARY FACILITIES AND TELEPHONE SERVICES AS REQUIRED FOR THE CONTRACTORS USE DURING CONSTRUCTION.
- 13) THE CONTRACTOR SHALL BE HELD RESPONSIBLE FOR ANY FIELD CHANGES MADE WITHOUT PRIOR WRITTEN AUTHORIZATION FROM THE OWNER, ENGINEER, AND/OR REGULATORY AGENCY.
- 14) THE CONTRACTOR SHALL EXERCISE DUE CAUTION AND SHALL CAREFULLY PRESERVE BENCH MARKS, CONTROL POINTS, REFERENCE POINTS AND ALL SURVEY STAKES, AND SHALL BEAR ALL EXPENSES FOR REPLACEMENT AND/OR ERRORS CAUSED BY THEIR UNNECESSARY LOSS OR DISTURBANCE.
- 15) THE CONTRACTOR AGREES THAT:
- A. THEY SHALL BE RESPONSIBLE TO CLEAN THE JOB SITE AT THE END OF EACH PHASE OF WORK.
 - B. THEY SHALL BE RESPONSIBLE TO REMOVE AND DISPOSE OF ALL TRASH, SCRAP AND UNUSED MATERIAL AT THEIR OWN EXPENSE IN A TIMELY MANNER.
 - C. THEY SHALL BE RESPONSIBLE TO MAINTAIN THE SITE IN A NEAT, SAFE AND ORDERLY MANNER AT ALL TIMES.
 - D. THEY SHALL BE RESPONSIBLE TO KEEP MATERIALS, EQUIPMENT, AND TRASH OUT OF THE WAY OF OTHER CONTRACTORS SO AS NOT TO DELAY THE JOB. FAILURE TO DO SO WILL RESULT IN A DEDUCTION FOR THE COST OF CLEAN UP FROM THE FINAL PAYMENT.
 - E. THEY SHALL BE RESPONSIBLE FOR THEIR OWN SAFETY, TRAFFIC CONTROL, PERMITS, RETESTING AND RE-INSPECTIONS AT THEIR OWN EXPENSE.

16) THE CONTRACTOR SHALL ASSUME SOLE AND COMPLETE RESPONSIBILITY FOR JOBSITE CONDITIONS DURING THE COURSE OF CONSTRUCTION OF THIS PROJECT, INCLUDING SAFETY OF ALL PERSONS AND PROPERTY. THIS REQUIREMENT SHALL APPLY CONTINUOUSLY AND NOT BE LIMITED TO NORMAL WORKING HOURS. THE CONTRACTOR SHALL DEFEND, INDEMNIFY AND HOLD THE OWNER AND ENGINEER HARMLESS FROM ANY AND ALL LIABILITY, REAL OR ALLEGED, IN CONNECTION WITH THE PERFORMANCE OF WORK ON THIS PROJECT, EXCEPTING FOR LIABILITY ARISING FROM THE SOLE NEGLIGENCE OF THE OWNER OR THE ENGINEER.

17) DUST CONTROL SHALL BE PROVIDED AT ALL TIMES, AT THE CONTRACTOR'S EXPENSE, TO MINIMIZE ANY DUST NUISANCE AND SHALL BE IN ACCORDANCE WITH REGULATORY AGENCY COMPREHENSIVE PLAN.

18) FOR ALL WORK WITHIN PUBLIC RIGHT-OF-WAYS OR EASEMENTS, THE CONTRACTOR SHALL PRESERVE THE INTEGRITY AND LOCATION OF ANY AND ALL PUBLIC UTILITIES AND PROVIDE THE NECESSARY CONSTRUCTION TRAFFIC CONTROL. CONTRACTOR SHALL THROUGH THE ENFORCEMENT PERMIT PROCESS, VERIFY WITH THE NECESSARY REGULATORY AGENCIES, THE NEED FOR ANY TRAFFIC ROUTING PLAN. IF PLAN IS REQUIRED, CONTRACTOR SHALL PROVIDE PLAN AND RECEIVE PROPER APPROVALS PRIOR TO BEGINNING CONSTRUCTION.

19) THE CONTRACTOR SHALL BE RESPONSIBLE FOR ADEQUATELY SCHEDULING INSPECTION AND TESTING OF ALL FACILITIES CONSTRUCTED UNDER THIS CONTRACT. ALL TESTING SHALL CONFORM TO THE REGULATORY AGENCY'S STANDARD SPECIFICATIONS. ALL TESTING AND INSPECTION SHALL BE PAID FOR BY THE OWNER; ALL RE-TESTING AND/OR RE-INSPECTION SHALL BE PAID FOR BY THE CONTRACTOR.

20) IF EXISTING IMPROVEMENTS NEED TO BE DISTURBED AND/OR REMOVED FOR THE PROPER PLACEMENT OF IMPROVEMENTS TO BE CONSTRUCTED BY THESE PLANS, THE CONTRACTOR SHALL BE RESPONSIBLE FOR PROTECTING EXISTING IMPROVEMENTS FROM DAMAGE. COST OF REPLACING OR REPAIRING EXISTING IMPROVEMENTS SHALL BE INCLUDED IN THE UNIT PRICE BID FOR ITEMS REQUIRING REMOVAL AND/OR REPLACEMENT OF EXISTING IMPROVEMENTS. THERE WILL BE NO EXTRA COST DUE THE CONTRACTOR FOR REPLACING OR REPAIRING EXISTING IMPROVEMENTS.

21) WHENEVER EXISTING FACILITIES ARE REMOVED, DAMAGED, BROKEN, OR CUT IN THE INSTALLATION OF THE WORK COVERED BY THESE PLANS OR SPECIFICATIONS, SAID FACILITIES SHALL BE REPLACED AT THE CONTRACTOR'S EXPENSE, AFTER PROPER BACKFILLING AND/OR CONSTRUCTION, WITH MATERIALS EQUAL TO OR BETTER THAN THE MATERIALS USED IN THE ORIGINAL EXISTING FACILITIES. THE FINISHED PRODUCT SHALL BE SUBJECT TO THE APPROVAL OF THE OWNER, THE ENGINEER, AND THE RESPECTIVE REGULATORY AGENCY.

22) THE CONTRACTOR SHALL MAINTAIN A NEATLY MARKED SET OF FULL-SIZE AS-BUILT RECORD DRAWINGS SHOWING THE FINAL LOCATION AND LAYOUT OF ALL STRUCTURES AND OTHER FACILITIES. AS-BUILT RECORD DRAWINGS SHALL REFLECT CHANGE ORDERS, ACHIEVEMENTS, AND ADJUSTMENTS TO ALL IMPROVEMENTS CONSTRUCTED. WHERE NECESSARY, SUPPLEMENTAL DRAWINGS SHALL BE PREPARED AND SUBMITTED BY THE CONTRACTOR.

PRIOR TO COMPLETION OF THE PROJECT, THE CONTRACTOR SHALL DELIVER TO THE ENGINEER, ONE SET OF NEATLY MARKED AS-BUILT RECORD DRAWINGS SHOWING THE INFORMATION REQUIRED ABOVE. AS-BUILT RECORD DRAWINGS SHALL BE REVIEWED AND THE COMPLETE AS-BUILT RECORD DRAWING SET SHALL BE CURRENT WITH ALL CHANGES AND DEVIATIONS REDLINED AS A PRECONDITION TO THE FINAL PROGRESS PAYMENT APPROVAL AND/OR FINAL ACCEPTANCE.

23) WORK IN EASEMENT AND/OR RIGHT-OF-WAY IS SUBJECT TO THE APPROVAL AND ACCEPTANCE OF THE REGULATORY AGENCY RESPONSIBLE FOR OPERATION AND/OR MAINTENANCE OF SAID EASEMENT AND/OR RIGHT-OF-WAY.

CLEARING AND GRADING NOTES:

- 1) CONTRACTOR SHALL PERFORM EARTHWORK IN ACCORDANCE WITH REGULATORY AGENCY STANDARD SPECIFICATIONS AND DIVISION 2 OF THE AMERICAN PUBLIC WORKS ASSOCIATION STANDARD SPECIFICATIONS.
- 2) IF THE PROJECT REQUIRES ANY IMPORT OR EXPORT TO ACHIEVE A BALANCED SITE, A SEPARATE UNIT PRICE PER CUBIC YARD SHALL BE INCLUDED IN THE BID FOR SAID IMPORT OR EXPORT. ANY EXPORT MATERIAL SHALL BE STOCKPILED OR REMOVED FROM THE PROJECT SITE AS DIRECTED BY THE OWNER AND/OR ENGINEER.

UNDERGROUND UTILITIES:

- 1) THE INFORMATION SHOWN ON THE PLANS WITH REGARD TO THE EXISTING UTILITIES AND/OR IMPROVEMENTS, WAS DERIVED FROM FIELD INVESTIGATIONS AND/OR RECORD INFORMATION. THE ENGINEER DOES NOT GUARANTEE THESE LOCATIONS TO BE EITHER TRUE OR EXACT. PRIOR TO CONSTRUCTION, IT SHALL BE THE CONTRACTOR'S SOLE RESPONSIBILITY TO VERIFY ALL EXISTING IMPROVEMENTS AND TO EXPOSE ALL EXISTING UNDERGROUND UTILITIES RELATED TO THE PROJECT, INCLUDING BUT NOT LIMITED TO, SEWER, STORM DRAIN, WATER, IRRIGATION, GAS, ELECTRICAL, ETC. AND SHALL NOTIFY THE ENGINEER IN WRITING FORTY-EIGHT (48) HOURS IN ADVANCE OF EXPOSING THE UTILITIES, SO THAT THE EXACT LOCATION AND ELEVATION CAN BE VERIFIED AND DOCUMENTED. THE COST ASSOCIATED TO PERFORM THIS WORK SHALL BE INCLUDED IN EITHER THE LUMP SUM CLEARING COST OR IN THE VARIOUS ITEMS OF WORK. IF LOCATION AND/OR ELEVATION DIFFERS FROM THAT SHOWN ON THE DESIGN PLANS, PROVISIONS TO ACCOMMODATE NEW LOCATION/ELEVATION MUST BE MADE PRIOR TO CONSTRUCTION.
- 2) PRIOR TO COMMENCING ANY WORK, IT SHALL BE THE CONTRACTOR'S RESPONSIBILITY TO HAVE EACH UTILITY COMPANY LOCATE, IN THE FIELD, THE FIDELITY AND SERVICE LINES. THE CONTRACTOR SHALL NOTIFY BLUE STAKES OF UTAH BY DIALING 811 OR 1-800-662-4111 48 HOURS IN ADVANCE OF PERFORMING ANY EXCAVATION WORK. THE CONTRACTOR SHALL RECORD THE BLUE STAKES ORDER NUMBER AND FURNISH ORDER NUMBER TO OWNER AND ENGINEER PRIOR TO ANY EXCAVATION. IT WILL BE THE CONTRACTORS SOLE RESPONSIBILITY TO DIRECTLY CONTACT ANY OTHER UTILITY COMPANIES THAT ARE NOT MEMBERS OF BLUE STAKES CALL. IT SHALL BE THE CONTRACTOR'S SOLE RESPONSIBILITY TO PROTECT ALL EXISTING UTILITIES SO THAT THE PERFORMANCE OF THIS CONTRACT. ANY REPAIRS NECESSARY TO DAMAGED UTILITIES SHALL BE PAID FOR BY THE CONTRACTOR. THE CONTRACTOR SHALL BE REQUIRED TO COOPERATE WITH OTHER CONTRACTORS AND UTILITY COMPANIES INSTALLING NEW STRUCTURES, UTILITIES AND SERVICE TO THE PROJECT.
- 3) THE CONTRACTOR SHALL PROVIDE ALL SHORING, BRACING, SLOPING OR OTHER PROVISIONS NECESSARY TO PROTECT WORKMEN FOR ALL AREAS TO BE EXCAVATED TO A DEPTH OF 4' OR MORE. FOR EXCAVATIONS 4 FEET OR MORE IN DEPTH, THE CONTRACTOR SHALL COMPLY WITH INDUSTRIAL COMMISSION OF UTAH SAFETY ORDERS FOR EXCAVATIONS AND TRENCHES, ALONG WITH ANY LOCAL CODES OR ORDINANCES.
- 4) PRIOR TO OPENING AN EXCAVATION, EFFORT SHALL BE MADE TO DETERMINE WHETHER UNDERGROUND INSTALLATIONS, I.E. SEWER, WATER, FUEL, ELECTRIC LINES, ETC., WILL BE ENCOUNTERED AND IF SO, WHERE SUCH UNDERGROUND INSTALLATIONS ARE LOCATED. WHEN THE EXCAVATION APPROACHES THE APPROXIMATE LOCATION OF SUCH AN INSTALLATION, THE EXACT LOCATION SHALL BE DETERMINED BY CAREFUL PROBING OR HAND DIGGING; AND, WHEN IT IS UNCOVERED, ADEQUATE PROTECTION SHALL BE PROVIDED FOR THE EXISTING INSTALLATION. ALL KNOWN OWNERS OF UNDERGROUND FACILITIES IN THE AREA CONCERNED SHALL BE ADVISED OF PROPOSED WORK AT LEAST 48 HOURS PRIOR TO THE START OF ACTUAL EXCAVATION.

THE CONTRACTOR WILL VERIFY DEPTHS OF ALL UTILITIES IN THE FIELD BY POT HOULING A MINIMUM OF 300 FEET AHEAD OF PIPELINE CONSTRUCTION TO AVOID CONFLICTS WITH DESIGNED PIPELINE GRADE AND ALIGNMENT. IF A CONFLICT ARISES RESULTING FROM THE CONTRACTOR NEGLECTING TO POT HOLE UTILITIES THE CONTRACTOR WILL BE REQUIRED TO RESOLVE THE CONFLICT WITHOUT ADDITIONAL COST OR CLAIM TO THE OWNER.

5) IT SHALL BE THE CONTRACTOR'S RESPONSIBILITY TO INSTALL PIPE OF ADEQUATE CLASSIFICATION WITH SUFFICIENT BEDDING TO MEET ALL REQUIREMENTS AND RECOMMENDATIONS OF THE REGULATORY AGENCY FOR H-20 LOAD REQUIREMENTS.

- 6) SANITARY SEWER AND WATER SYSTEM CONSTRUCTION TO BE INSTALLED PER THE REQUIREMENTS OF THE REGULATORY AGENCY.
 - A. ALL SANITARY SEWER CONSTRUCTION SHALL COMPLY WITH THE REGULATORY AGENCY STANDARDS.
 - B. ALL WATER SERVICE LINES SHALL BE CONSTRUCTED ACCORDING TO REGULATORY AGENCY STANDARDS.
 - C. ALL WATERLINE BENDS, ELBOWS, TEES, AND CROSSES SHALL HAVE THRUST BLOCKS PLACED ACCORDING TO REGULATORY AGENCY STANDARDS.
 - D. ALL WATERLINE LOOPS SHALL BE CONSTRUCTED ACCORDING TO REGULATORY AGENCY STANDARDS.
- E. CONTRACTOR TO VERIFY ALL PIPE LENGTHS. PIPE LENGTHS SHOWN ARE MEASURED FROM EDGE OF MH TO EDGE OF MH. NO ADJUSTMENT WAS MADE FOR SLOPE.

7) THE CONTRACTOR SHALL NOTIFY INFINITY CONSULTANTS, INC. IN WRITING AT LEAST 48 HOURS PRIOR TO BACKFILLING OF ANY PIPE WHICH STUBS TO A FUTURE PHASE OF CONSTRUCTION FOR INVERT VERIFICATION. TOLERANCE SHALL BE IN ACCORDANCE WITH THE REGULATORY AGENCY STANDARD SPECIFICATIONS.

8) ALL UNDERGROUND UTILITIES SHALL BE IN PLACE PRIOR TO INSTALLATION OF CURB, GUTTER, SIDEWALK AND STREET PAVING.

9) THE CONTRACTOR IS RESPONSIBLE FOR ALL STREET LIGHT TRENCHING.

SURFACE IMPROVEMENTS:

- 1) ALL MANHOLE RIMS, LAMPHOLES, VALVES AND MONUMENT BOXES, ETC. SHALL BE ADJUSTED TO FINISHED GRADE & COLLARED AFTER STREET PAVING, UNLESS OTHERWISE NOTED. COST FOR THIS WORK SHALL BE INCLUDED IN THE UNIT PRICES FOR SAID FACILITIES.
- 2) PAYMENT FOR PAVEMENT WILL BE MADE ONLY FOR AREAS SHOWN ON THESE PLANS. REPLACEMENT OF PAVEMENT WHICH IS BROKEN OR CUT DURING THE INSTALLATION OF THE WORK COVERED BY THESE SPECIFICATIONS, AND WHICH LIES OUTSIDE OF SAID AREAS, SHALL BE INCLUDED IN THE CONTRACTOR'S UNIT PRICE FOR PAVEMENT, AND NO ADDITIONAL PAYMENT SHALL BE MADE FOR SUCH WORK.

3) THE CONTRACTOR SHALL BE RESPONSIBLE FOR THE REMOVAL OF ALL STRIPING AND/OR PAVEMENT MARKINGS NECESSARY TO TIE EXISTING STRIPING INTO FUTURE STRIPING. METHOD OF REMOVAL SHALL BE BY GRINDING OR SANDBLASTING.

4) STRIPING AND PAVEMENT MARKINGS SHALL BE IN CONFORMANCE WITH REGULATORY AGENCY STANDARDS.

ROADWAY MATERIALS:

ROADWAY MATERIALS SPECIFICATIONS AND CONSTRUCTION REQUIREMENTS SHALL BE AS OUTLINED BY REGULATORY AGENCY STANDARDS AND THESE PLANS.

SEWER IMPROVEMENT COMPLIANCE:

- 1) ALL CONSTRUCTION SHALL COMPLY WITH THE REGULATORY AGENCY'S DESIGN STANDARDS AND SPECIFICATIONS.
- 2) CONTRACTOR SHALL FIELD VERIFY LOCATIONS AND INVERT ELEVATIONS OF EXISTING MANHOLES AND OTHER UTILITIES BEFORE STAKING OR CONSTRUCTING ANY NEW SEWER LINES.

SWPPP NOTES

- 1) SEE EROSION CONTROL SHEET FOR DETAILS AND BMP'S.
- 2) CONTRACTOR IS REQUIRED TO OBTAIN AN NOI FROM THE STATE OF UTAH FOR SWPPP PURPOSES.
- 3) CONTRACTOR IS REQUIRED TO SCHEDULE AND ATTEND A PRE-CONSTRUCTION MEETING WITH REGULATORY AGENCY PRIOR TO COMMENCING ANY SITE WORK FOR THIS PROJECT.

GENERAL DEMOLITION NOTES:

1. Demolition and site clearing for this contract are to include all areas shown within demolition limits or by note.
2. Refer to site improvement plans for more details on limits of removal.
3. Demolish existing buildings and clear from site, (including removal of all footings and foundations.)
4. All curbs, gutters, walks, slabs, walls, fences, flatwork, asphalt, waterlines and meters, gas lines, sewer lines, light poles, buried cables, storm drain piping and structures to be cleared from site unless otherwise shown.
5. All utilities, sewer, water, gas, telephone and electrical services to be disconnected and capped according to city, county and utility company requirements, unless otherwise shown.
6. Basements and other excavated areas to be backfilled with clean granular material compacted to 95% of maximum lab density as determined by ASTM D 1557-78. (Test results to be given to owner)
7. Clear and grub trees, shrubs, and vegetation within construction limits, disposal to be off-site except where noted otherwise.
8. DO NOT interrupt any services or disrupt the operation of any businesses shown outside the demolition limits.
9. If ASBESTOS is found in existing structures, the Asbestos must be removed in a legal manner by a contractor licensed to handle asbestos materials. (Not a part of contract)
10. Remove debris, rubbish, and other materials resulting from the demolition and site clearing operations from the site and dispose of in a legal manner.
11. The location and/or elevation of existing utilities as shown on these plans is based on records of the various utility companies and, where possible, measurements taken in the field. The information is not to be relied upon as being exact or complete. Contractor shall contact authorities having jurisdiction for field locations. Contractor shall be responsible for protection of in place and relocated utilities during construction.

12. Stockpiles shall be graded to maintain slopes not greater than 3 horizontal to 1 vertical. Provide erosion control as needed to prevent sediment transport to adjacent drainage ways.
13. Contractor shall be responsible for disposal of all waste material. Disposal shall be at an approved site for such material. Burning onsite is not permitted.
14. Contractor shall verify with city any street removal, curb cuts, and any restoration required for utility line removal.
15. Install traffic warning devices as needed in accordance with local standards.
16. Contractor shall obtain all permits necessary for demolition from City, County, State or Federal Agencies as required.

GENERAL SITE NOTES:

1. Stalls designated as accessible will require a painted accessible symbol and sign.
2. Fire lane markings and signs to be installed as directed by the Fire Marshall. Road widths equal to or less than 32 feet shall require red curbside painting and "No Parking" signs that are approved positioned along the fire apparatus access routes.
3. Aisle markings, directional arrows and stop bars will be painted at each driveway as shown on the plans.
4. Building sidewalks, ramps, and bollards are building contractor responsible items. See architectural plans.
5. All dimensions are to back of curb unless otherwise noted.
6. Fire hydrants and access roads shall be installed prior to construction of any buildings. All fire hydrants shall be placed with the 4 1/2" connection facing the point of access for Fire Department Apparatus.
7. All Street lighting installed within the project will be installed by the developer(s) and will be owned and maintained by the property owner(s).

GENERAL GRADING NOTES:

1. Survey Provided by Owner. Civil Engineer not responsible for inaccuracies in survey information. Contractor to verify field data and report any discrepancies.
2. All work shall be in accordance with the City Public Works Standard.
3. Cut slopes shall be no steeper than 2 horizontal to 1 vertical.
4. Fill slopes shall be no steeper than 2 horizontal to 1 vertical.
5. Fills shall be compacted per the recommendations of the geotechnical report prepared for the project and shall be certified by the geotechnical engineer.
6. Areas to receive fill shall be properly prepared and approved by the City inspector and geotechnical Engineer prior to placing fill.
7. Fills shall be benched into competent material as per specifications and geotechnical report.
8. All trench backfill shall be tested and certified by the site geotechnical engineer per the grading code.
9. A geotechnical engineer shall perform periodic inspections and submit a complete report and map upon completion of the rough grading.
10. The final compaction report and certification from the geotechnical engineer shall contain the type of field testing performed. Each test shall be identified with the method of obtaining the in-place density, whether sand cone or drive ring and shall be so noted for each test. Sufficient maximum density determinations shall be performed to verify the accuracy of the maximum density curves used by the field technician.
11. Dust shall be controlled by watering.
12. The location and protection of all utilities is the responsibility of the permittee.
13. Approved protective measures and temporary drainage provisions must be used to protect adjoining properties during the grading project.
14. All public roadways must be cleared daily of all dirt, mud and debris deposited on them as a result of the grading operation. Cleaning is to be done to the satisfaction of the city engineer.
15. The site shall be cleared and grubbed of all vegetation and deleterious matter prior to grading.
16. The contractor shall provide shoring in accordance with OSHA requirements for trench walls.
17. Aggregate base shall be compacted per the geotechnical report prepared for the project.
18. Elevations shown on this plan are finish grades. Rough grades are the subgrades of the improvements shown hereon.
19. As part of the construction documents, owner has provided contractor with a topographic survey performed by manual or aerial means. Such survey was prepared for project design purposes and is provided to the contractor as a courtesy. It is expressly understood that such survey may not accurately reflect existing topographic conditions.
20. Erosion Control: Protect all inlet boxes, catch basins, etc. with straw bales or other approved method to strain the storm water during construction. Protect surrounding properties and streets from site runoff with sandbags and earth berms.

GENERAL UTILITY NOTES:

1. Coordinate all utility connections to building with plumbing plans and building contractor.
 2. Verify depth and location of all existing utilities prior to constructing any new utility lines. Notify Civil Engineer of any discrepancies or conflicts prior to any connections being made.
 3. All catch basin and inlet box grates are to be bicycle proof.
 4. All inlet boxes located in curb and gutter are to be placed parallel to the curb and gutter and set under the frame and grate. Improperly placed boxes will be removed and replaced at no additional cost to the owner. Precast or cast in place boxes are acceptable.
 5. Refer to the site electrical plan for details and locations of electrical lines, transformers and light poles.
 6. Gas lines, telephone lines, and cable TV lines are not a part of these plans unless otherwise noted.
 7. Water meters are to be installed per city standards and specifications. It will be the contractor's responsibility to install all items required.
 8. Water lines, valves, fire hydrants, fittings etc. are to be constructed as shown. Contractor is responsible to construct any vertical adjustments necessary to clear sewer, storm drain or other utilities as necessary including valve boxes and hydrant spools to proper grade.
 9. Field verify all existing and/or proposed Roof Drain/Roof Drain down spout connections to Storm Water System with Civil, Plumbing & Architectural plans. Notify Engineer of any discrepancies.
 10. All gravity flow utility lines shall be installed prior to any pressurized utilities unless written permission is obtained from the engineer of record before construction begins.
 11. Fire hydrants and access roads shall be installed prior to construction of any buildings. All hydrants shall be placed with the 4 1/2" connection facing the point of access for Fire Department Apparatus.
 12. Prior to the construction of any buildings, a fire flow test of the new hydrants shall be conducted to verify the actual fire flow available for this project. The Fire Prevention Division of this department shall witness this test and shall be notified a minimum of 48 hours prior to the test.
 13. As a Private Development, the private fire hydrants shall be annually maintained and a 5-year flow test shall be performed in accordance with NFPA 24 and 25. All records shall be provided and submitted through The Compliance Engine found at <http://www.thecomplianceengine.com>.
- UTILITY PIPING MATERIALS:
All piping to be installed per manufacturers recommendations. Refer to project specifications for more detailed information regarding materials, installation, etc.

CULINARY SERVICE LATERALS

- MAIN TO METER
- Type "K" copper or HDPE CTS-OD SDR-9 poly tubing.
- METER TO BUILDING
- 3/4" to 2" diameter pipe - CTS Poly, Soft Temp
- Over 2" diameter pipe - AWWA C-900 Class 150 pipe

WATER MAIN LINES AND FIRE LINES

Water material as shown on utility plan view or to meet city standards.

WATER MAIN LINES AND FIRE LINES

2. Pipe material as shown on utility plan view or to meet city standards.

SANITARY SEWER LINES

2. All sewer piping to be Polyvinyl Chloride (PVC) sewer pipe, ASTM D 3034, Type PSM, SDR 35

STORM DRAIN LINES

2. 12" pipes or smaller - Polyvinyl Chloride (PVC) sewer pipe, ASTM D3034, Type PSM, SDR 35
2. 12" or larger - Reinforced Concrete Pipe, ASTM C76, Class III up to 13' of cover, Class IV for 13' to 21' of cover, Class V for 21' to 32' of cover, and Special Design for cover greater than 32 feet.


NATURAL GAS SERVICE LATERALS (QUESTAR)

1. PLASTIC PIPING MATERIAL: Plastic polyethylene pipe materials and compression couplings must be approved for natural gas applications and must be installed underground. All plastic pipe and fittings must conform to ASTM D2513 (60 psi and above high density pipe approved 3408).
2. Plastic pipe must be joined by individuals qualified in the heat fusion method of connecting pipe and fittings or approved mechanical fittings. A minimum number 18 insulated yellow copper tracer wire shall be installed with underground nonmetallic gas piping and shall terminate above grade at each end. Tracer wire shall not come in contact with plastic piping.
3. Risers and prefabricated risers inserted with plastic pipe shall conform to ASTM D2513, shall be metallic, have a space of 10 inches from the bottom of the service valve and grade, and shall be wrapped or coated to a point at least 6 inches above grade or protected in an approved manner. When a riser connects underground to plastic pipe, the underground horizontal metallic portion of the riser shall extend at least 12 inches before connecting to the plastic pipe by means of an approved transition fitting, adapter or heat fusion.
4. Plastic pipe used underground for customer fuel lines must be approved polyethylene material and be buried a minimum of 12 inches. It shall not be used inside buildings or above ground. PVC (Polyvinyl Chloride) is not approved for piping systems in Questar Gas's service area. Individual gas lines (metallic or plastic) to single outside appliance (outside lights, grilles, etc.) shall be installed a minimum of 8 inches below grade, provided such installation is approved and installed in locations not susceptible to physical damage.


ABBREVIATIONS:

AC	ASPHALTIC CONCRETE	MAX	MAXIMUM
APPR.	APPROXIMATELY	MH	MANHOLE
BW	BOTTOM OF WALL	MIN	MINIMUM
CB	CATCH BASIN	NTS	NOT TO SCALE
CL OR Ě	CENTERLINE	OH	OVERHEAD
CONC	CONCRETE	PC	POINT OF CURVATURE
DET	DETAIL	PL	PROPERTY LINE
DIA	DIAMETER	POC	POINT ON CURVE
DIP	DUCTILE IRON PIPE	PP	POWER POLE
DWG	DRAWING	PVC	POLYVINYL CHLORIDE
EA	EACH	PURDE	PUBLIC UTILITY / DRAINAGE EASEMENT
EG	EXISTING GRADE	PUE	PUBLIC UTILITY EASEMENT
EP	EDGE OF PAVEMENT	RCP	REINFORCED CONCRETE PIPE
ELEV	ELEVATION	R.O.W.	RIGHT-OF-WAY
ESMT	EASEMENT	SS	SANITARY SEWER
EXIST.	EXISTING	SD	STORM DRAIN
FF	FINISH FLOOR	S.F.	SQUARE FEET
FH	FIRE HYDRANT	SHT	SHEET
FL	FLOWLINE	STD	STANDARD
FT	FEET	TBC	TOP BACK OF CURB
GB	GRADE BREAK	TG	TOP OF GRATE
HP	HIGH POINT	TOA	TOP OF ASPHALT
HORIZ	HORIZONTAL	TOC	TOP OF CONCRETE
HYD	HYDRANT	TOS	TOP OF SLAB
ID	INSIDE DIAMETER	TW	TOP OF WALL
I.E.	INVERT ELEVATION	TYP	TYPICAL
IRR	IRRIGATION	VAR	VARIES
LENTH	LENGTH	VERT	VERTICAL
L.F.	LINEAR FEET	WS	WATER SURFACE
LP	LOW POINT		

GRAPHIC SCALE:

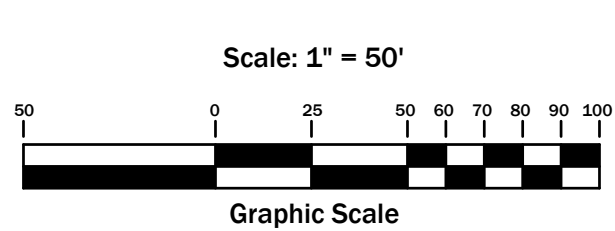

NORTH ARROW:

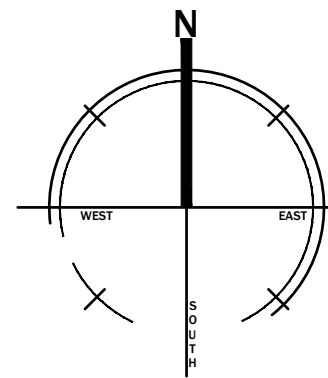

Legend

(Note: All items may not appear on drawing)

- San. Sewer Manhole
 - Water Manhole
 - Storm Drain Manhole Cleanout
 - Electrical Manhole
 - Catch Basins
 - Exist. Fire Hydrant
 - Fire Hydrant
 - Exist. Water Valve
 - Water Valve
 - Power pole
 - Power pole w/guy
 - Light Pole
 - Fence
 - Metal Pipe Concrete Pipe
 - Reinforced Concrete Pipe
 - Ductile Iron Pipe
 - Top of Asphalt
 - EA
 - TA
 - CL
 - EG
 - FL
 - EG
 - FL
 - FF
 - FG
 - TC
 - TWL
 - Top of Walk
 - Top of Concrete
 - Natural Ground
 - TCN
 - NG
 - Match Existing
 - Fire Department Connection
 - Ridge Line
 - FEL
 - ME
 - FEL
 - Direction of Flow
- | | |
|---------------------|--|
| Existing Asphalt | |
| New Asphalt | |
| Heavy Duty Asphalt | |
| Existing Concrete | |
| New Concrete | |
| Spill Curb & Gutter | |




2701 N. Thanksgiving Way - Suite 100
LEHI, UT 84043
601.448.5000
casey@fawkesconsultants.com
Casey@fawkesconsultants.com

BID SET

DATE: 5/26/2023
PROJECT NO.: 23001

REVISION	DATE
1	
2	
3	
4	
5	
6	

GENERAL NOTES
MONUMENT AT POWDER MOUNTAIN
Approx. 8050 Summit Pass Road, Eden, Utah

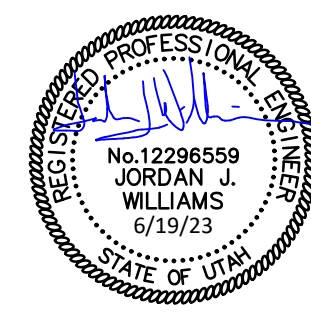

SCALE:

GN

DRAWN BY: CGW

3/14






RETAIN & PROTECTION KEYNOTES

- P1 SEWER MAIN, NO DISTURBANCE INTO PRESSURIZED LINE ON SUMMIT PASS ROAD
- P2 POWER & ELECTRICAL CABLES NOT TO BE DISTURBED
- P3 COMMUNICATIONS CABLES NOT TO BE DISTURBED
- P4 WATER MAIN, NO DISTURBANCE INTO PRESSURIZED LINE ON SUMMIT PASS ROAD
- P5 EXISTING ASPHALT ROADWAY
- P6 POWER & ELECTRICAL CABLES TO REMAIN EXTENDED INTO FAWKES DR
- P7 COMMUNICATIONS CABLES NOT TO BE DISTURBED
- P8 SEWER MANHOLE TO REMAIN, TIE LOCATION FOR SEWER LOCATION


DEMOLITION KEYNOTES

- D1 SAWCUT AND REMOVE ASPHALT
- D2 CLEAR & GRUB SURFACE
- D3 DEMO LIMIT LINE

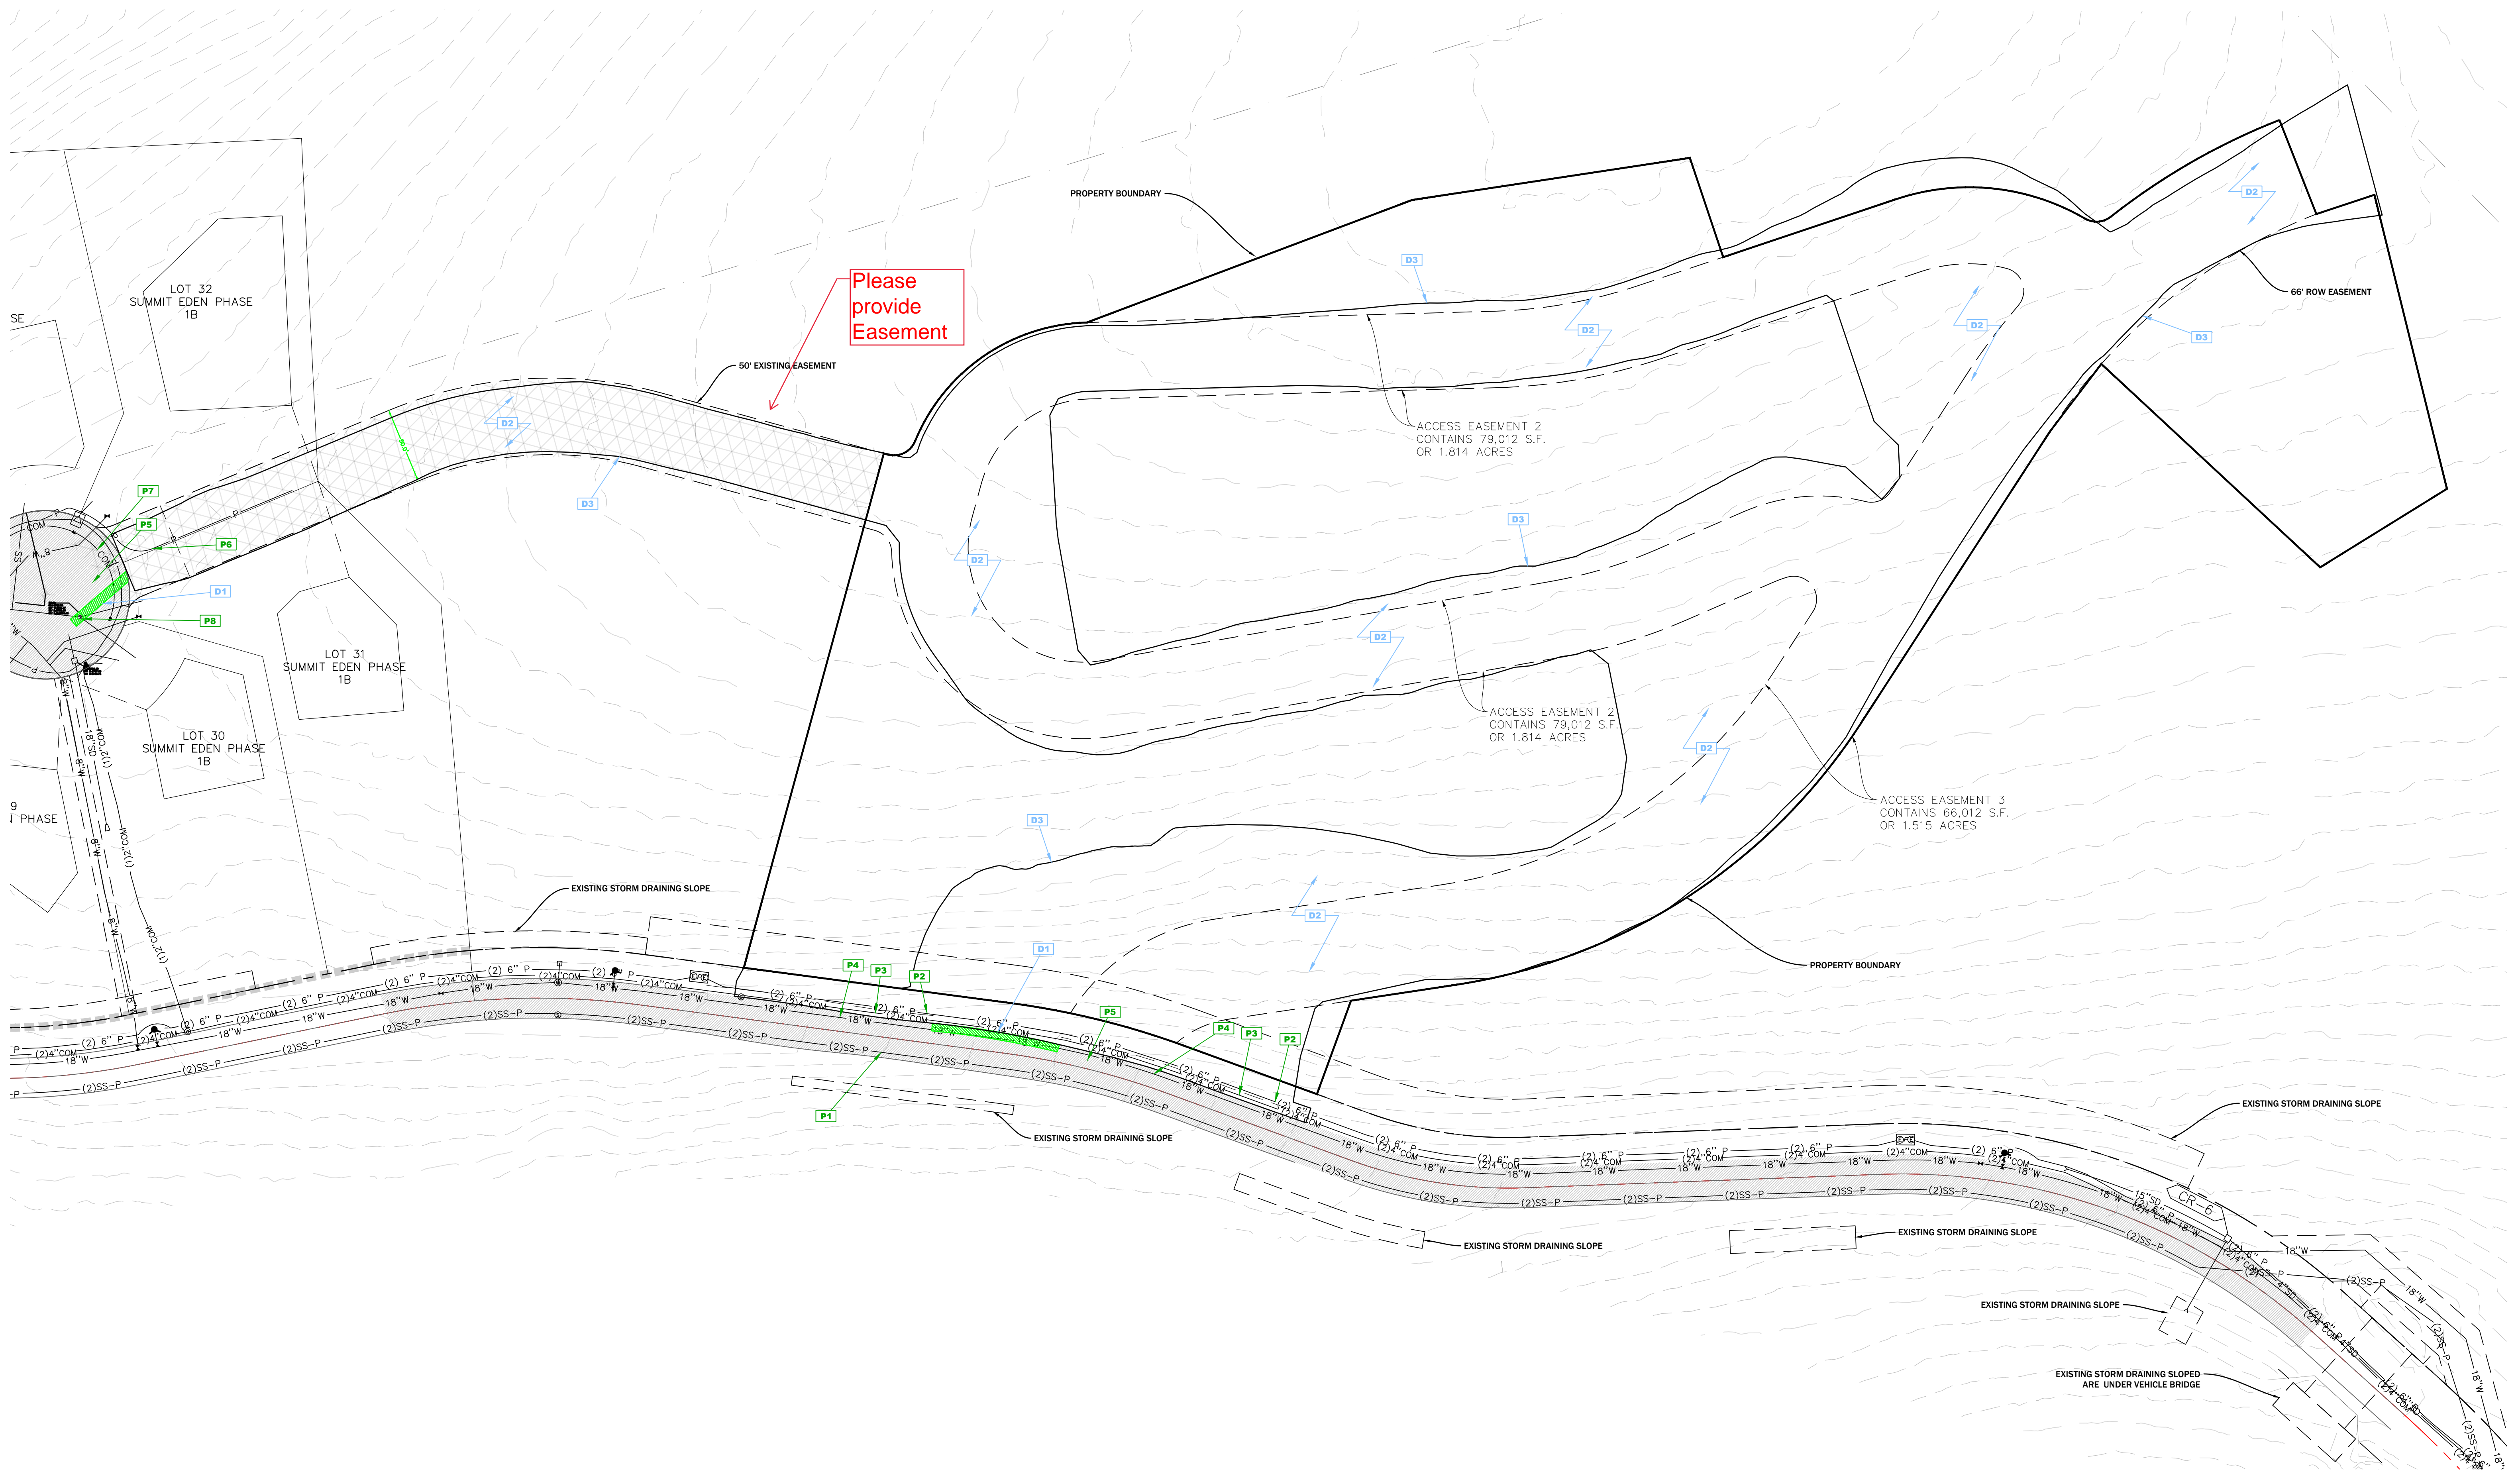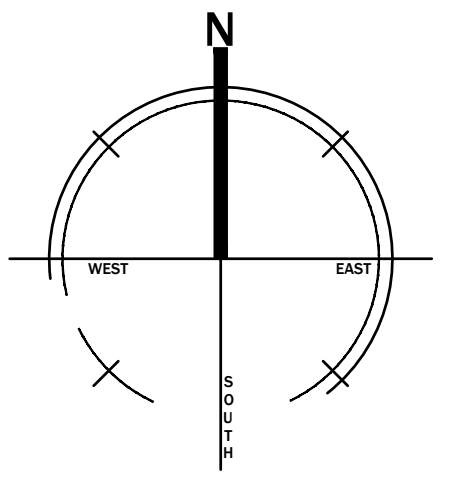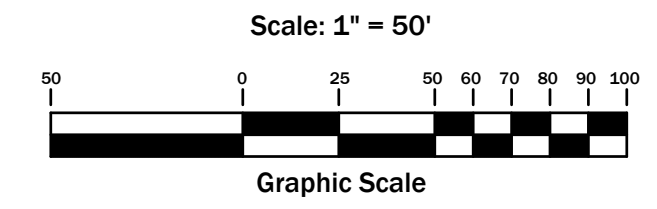

REVISION	DATE
1	
2	
3	
4	
5	
6	


DEMOLITION
MONUMENT AT POWDER MOUNTAIN
Approx. 8050 Summit Pass Road, Eden, Utah

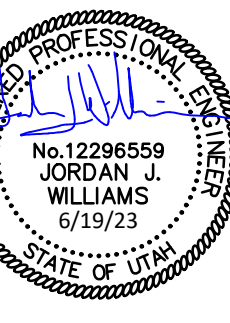





BID SET

DATE:	5/26/2023
PROJECT NO.:	23.001
REVISION	DATE
1	
2	
3	
4	
5	
6	


SITE
MONUMENT AT POWDER MOUNTAIN
Approx. 8050 Summit Pass Road, Eden, Utah

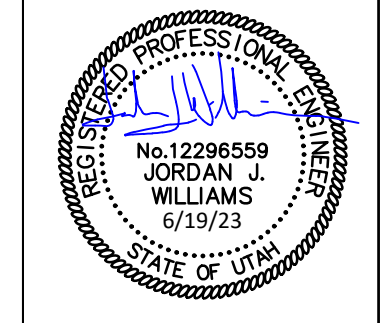

SCALE:
C2.00
DRAWN BY: CGW
5/14

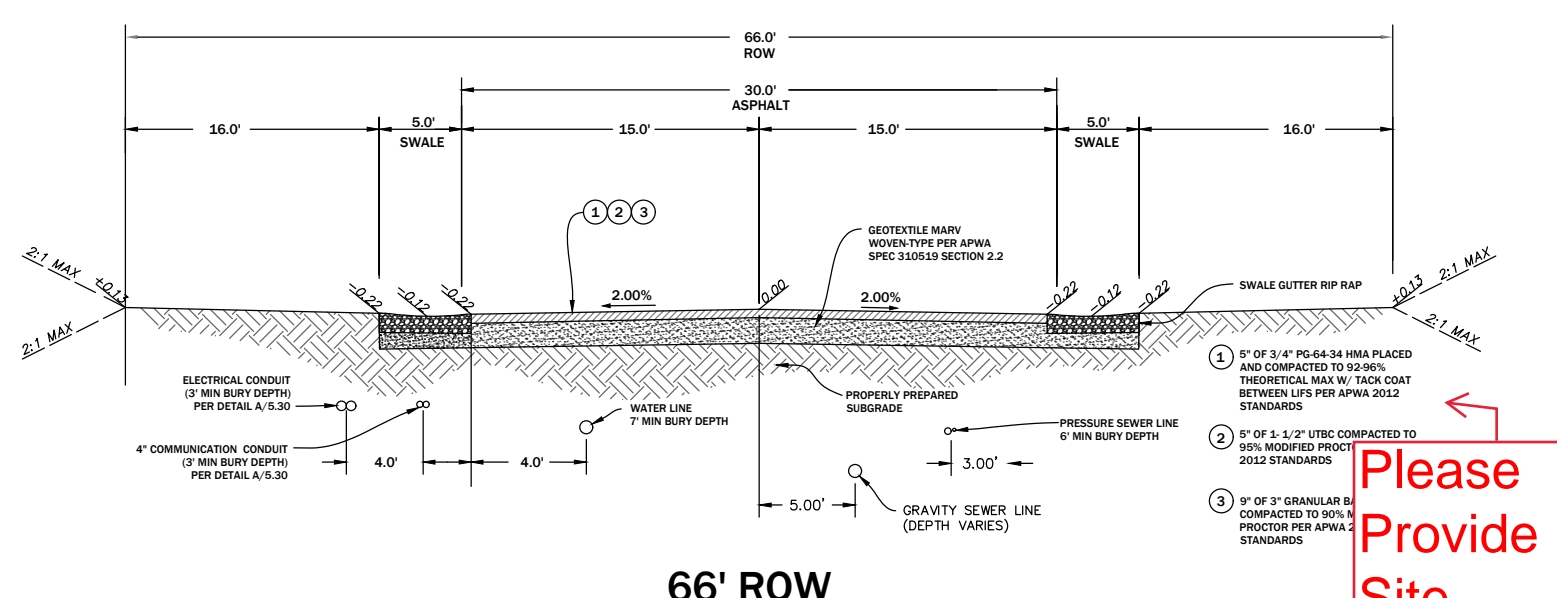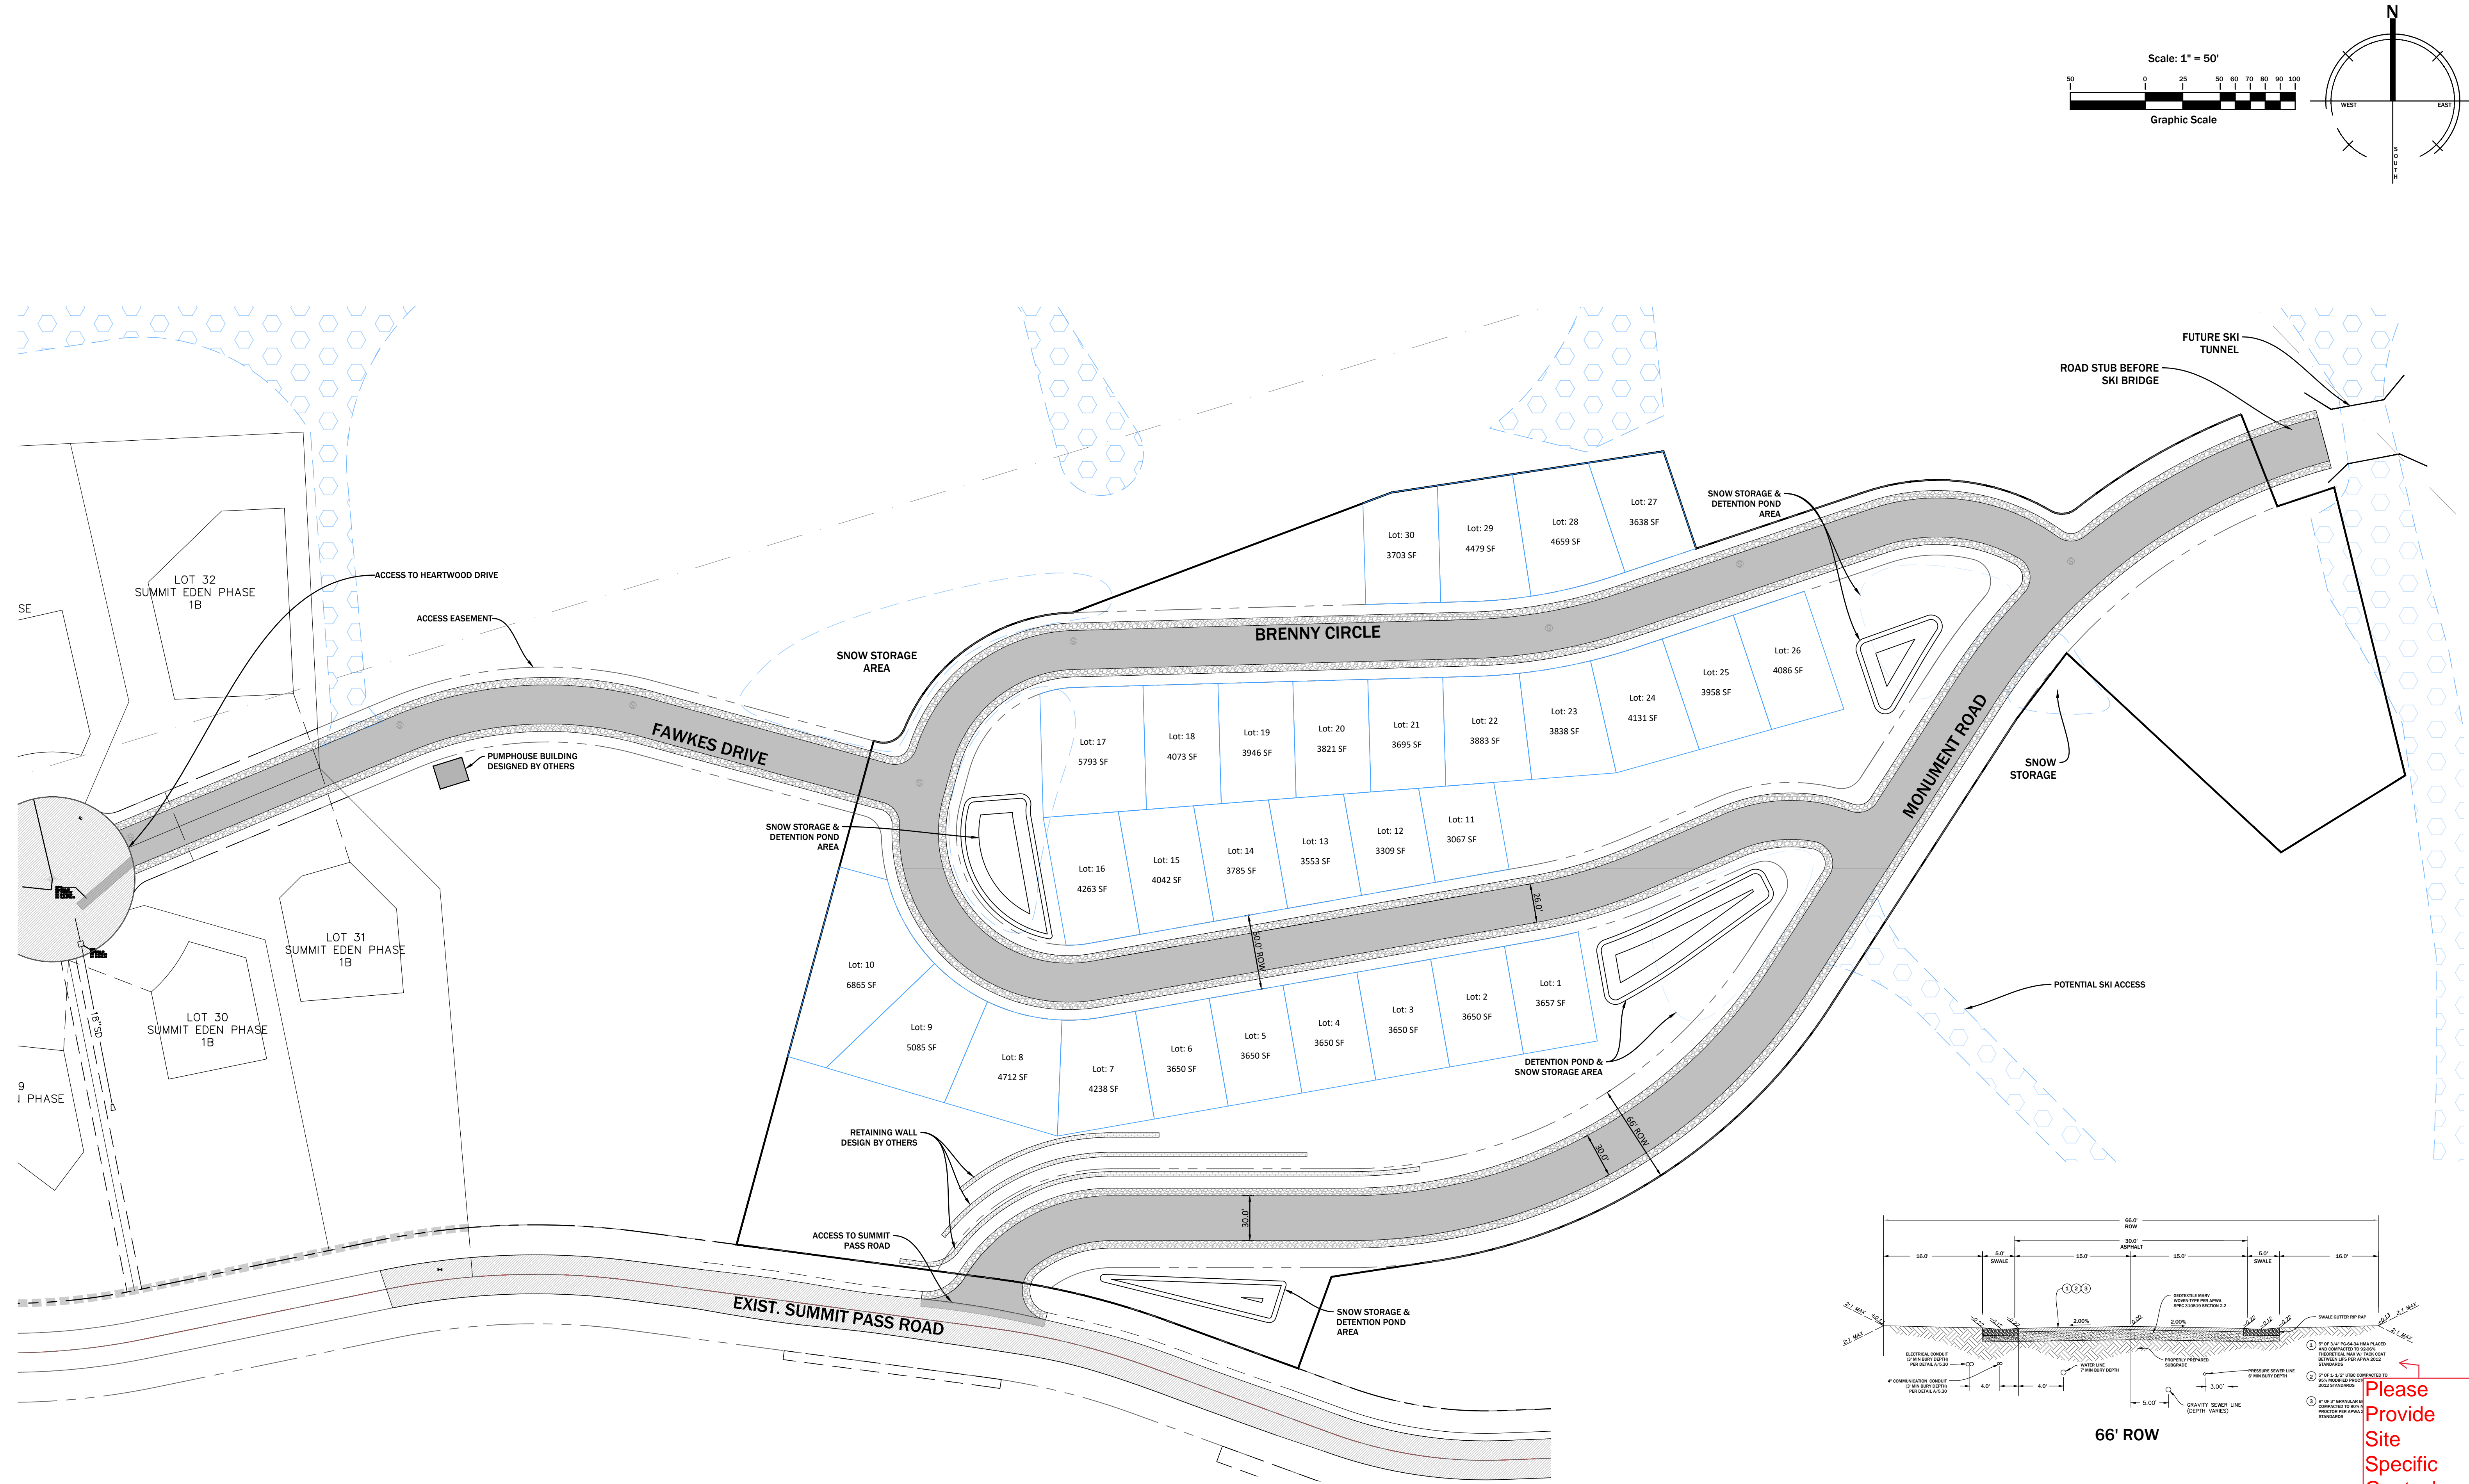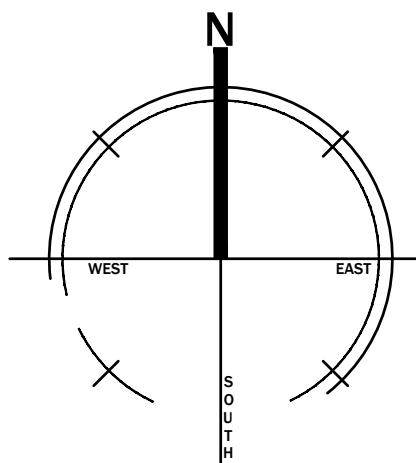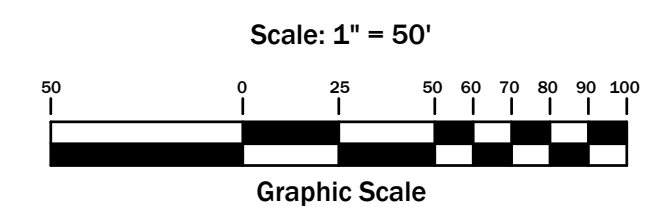


Please Provide Site Specific Geotech

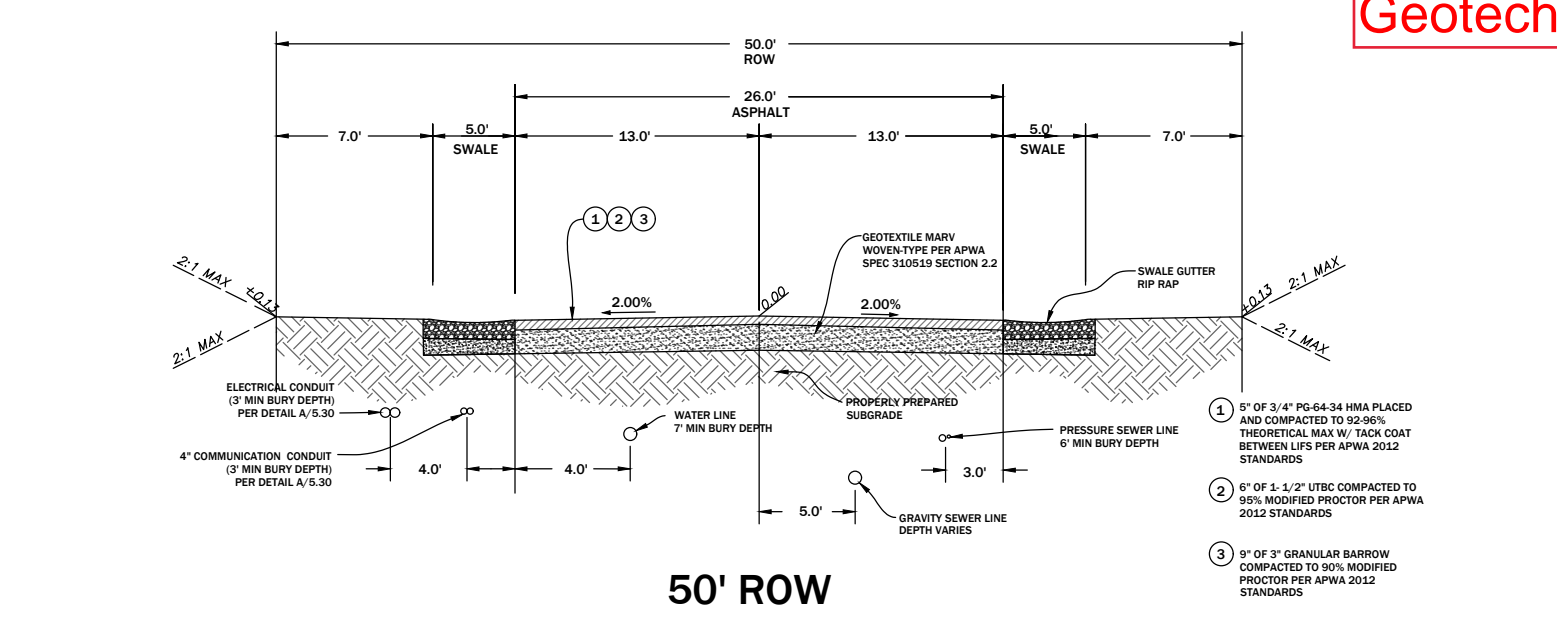

BID SET

DATE:	5/26/2023
PROJECT NO.:	23.001
REVISION	DATE
1	
2	
3	
4	
5	
6	

GRADING & DRAINAGE
MONUMENT AT POWDER MOUNTAIN
Approx. 8050 Summit Pass Road, Eden, Utah



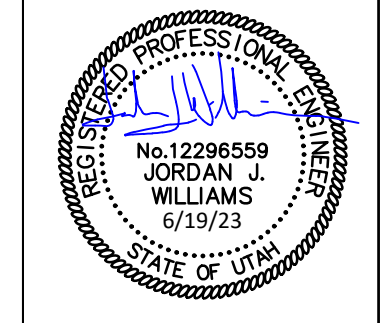


SCALE:

C3.00

DRAWN BY: CGW

6/14

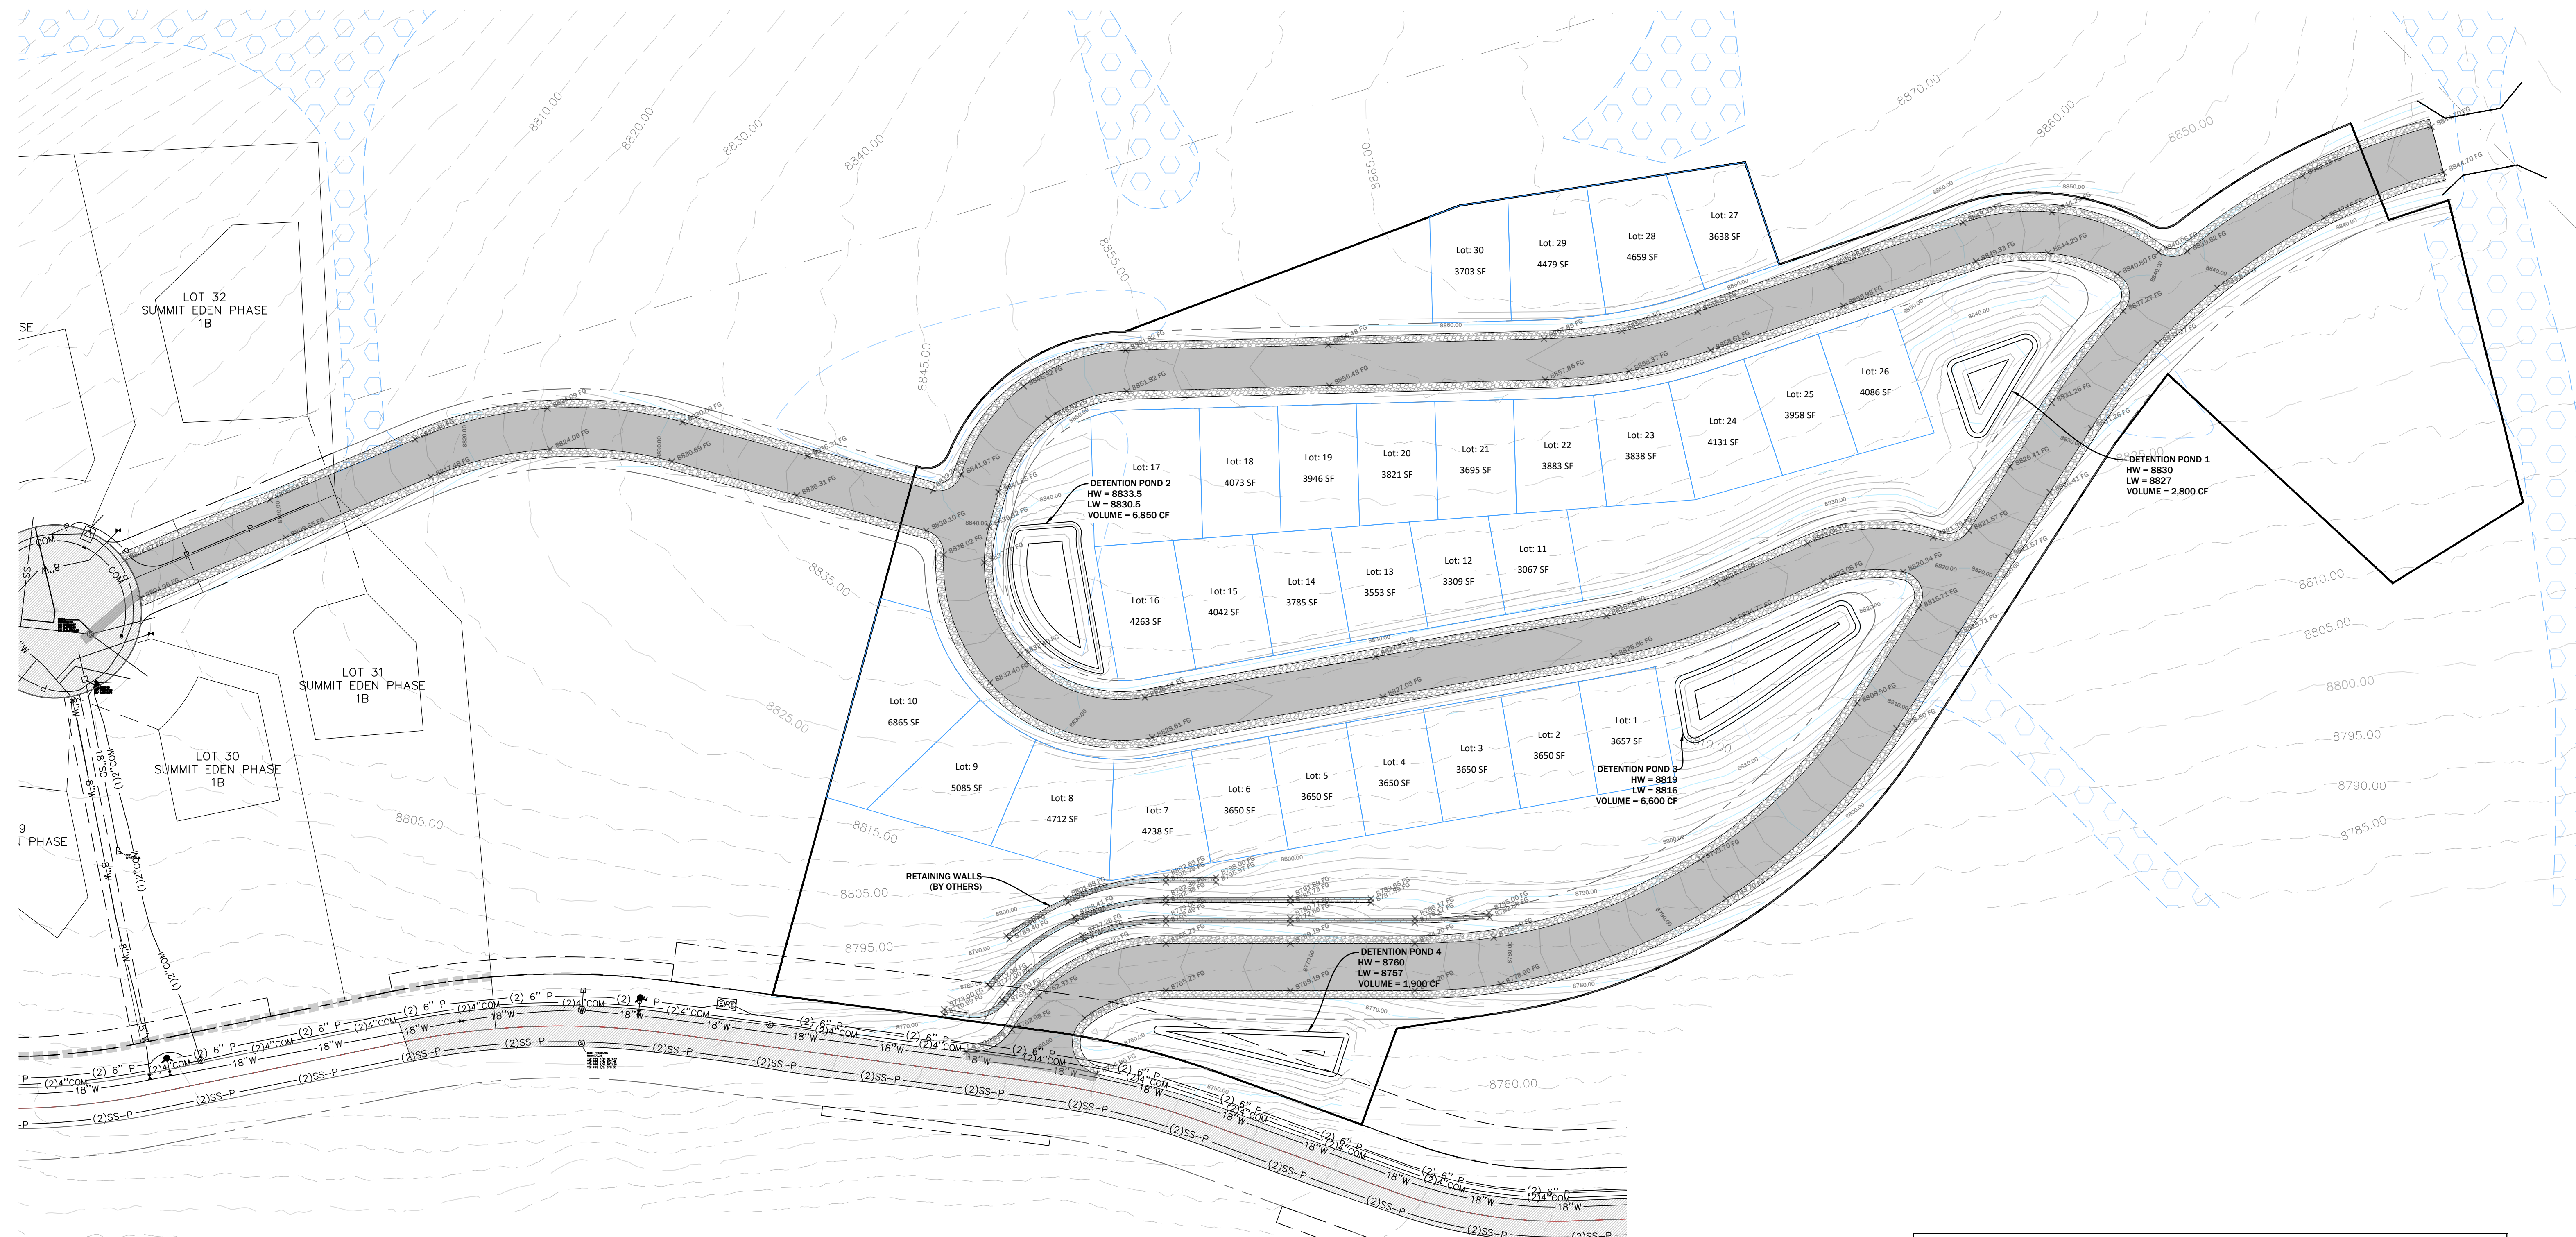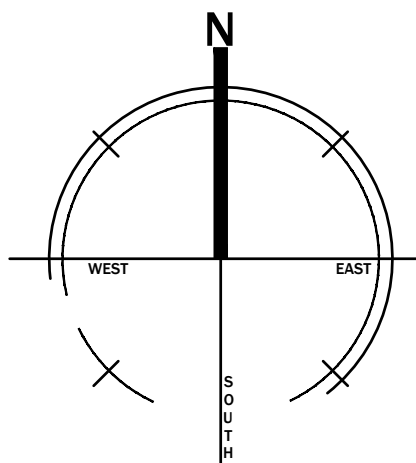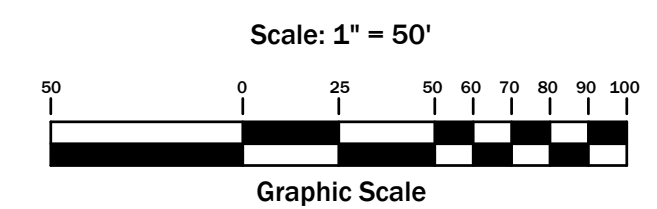

Volume Summary							
Name	Type	Cut Factor	Fill Factor	2d Area (Sq. Ft.)	Cut (Cu. Yd.)	Fill (Cu. Yd.)	Net (Cu. Yd.)
CUT-FILL	fill	1.000	1.000	234302.72	26001.96	4752.59	21249.37<Cut>
Totals							
				2d Area (Sq. Ft.)	Cut (Cu. Yd.)	Fill (Cu. Yd.)	Net (Cu. Yd.)
Total				234302.72	26001.96	4752.59	21249.37<Cut>


* Value adjusted by cut or fill factor other than 1.0

BID SET

DATE:	5/26/2023
PROJECT NO.:	23001
REVISION:	DATE
1	
2	
3	
4	
5	
6	

UTILITY

MONUMENT AT POWDER MOUNTAIN
Approx. 8050 Summit Pass Road, Eden, Utah


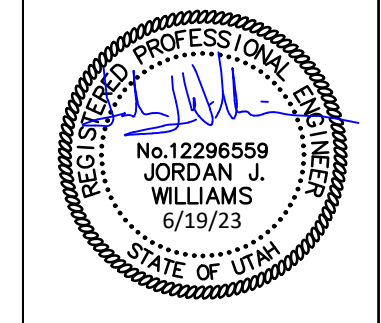


SCALE:

C4.00

DRAWN BY: CGW

7/14

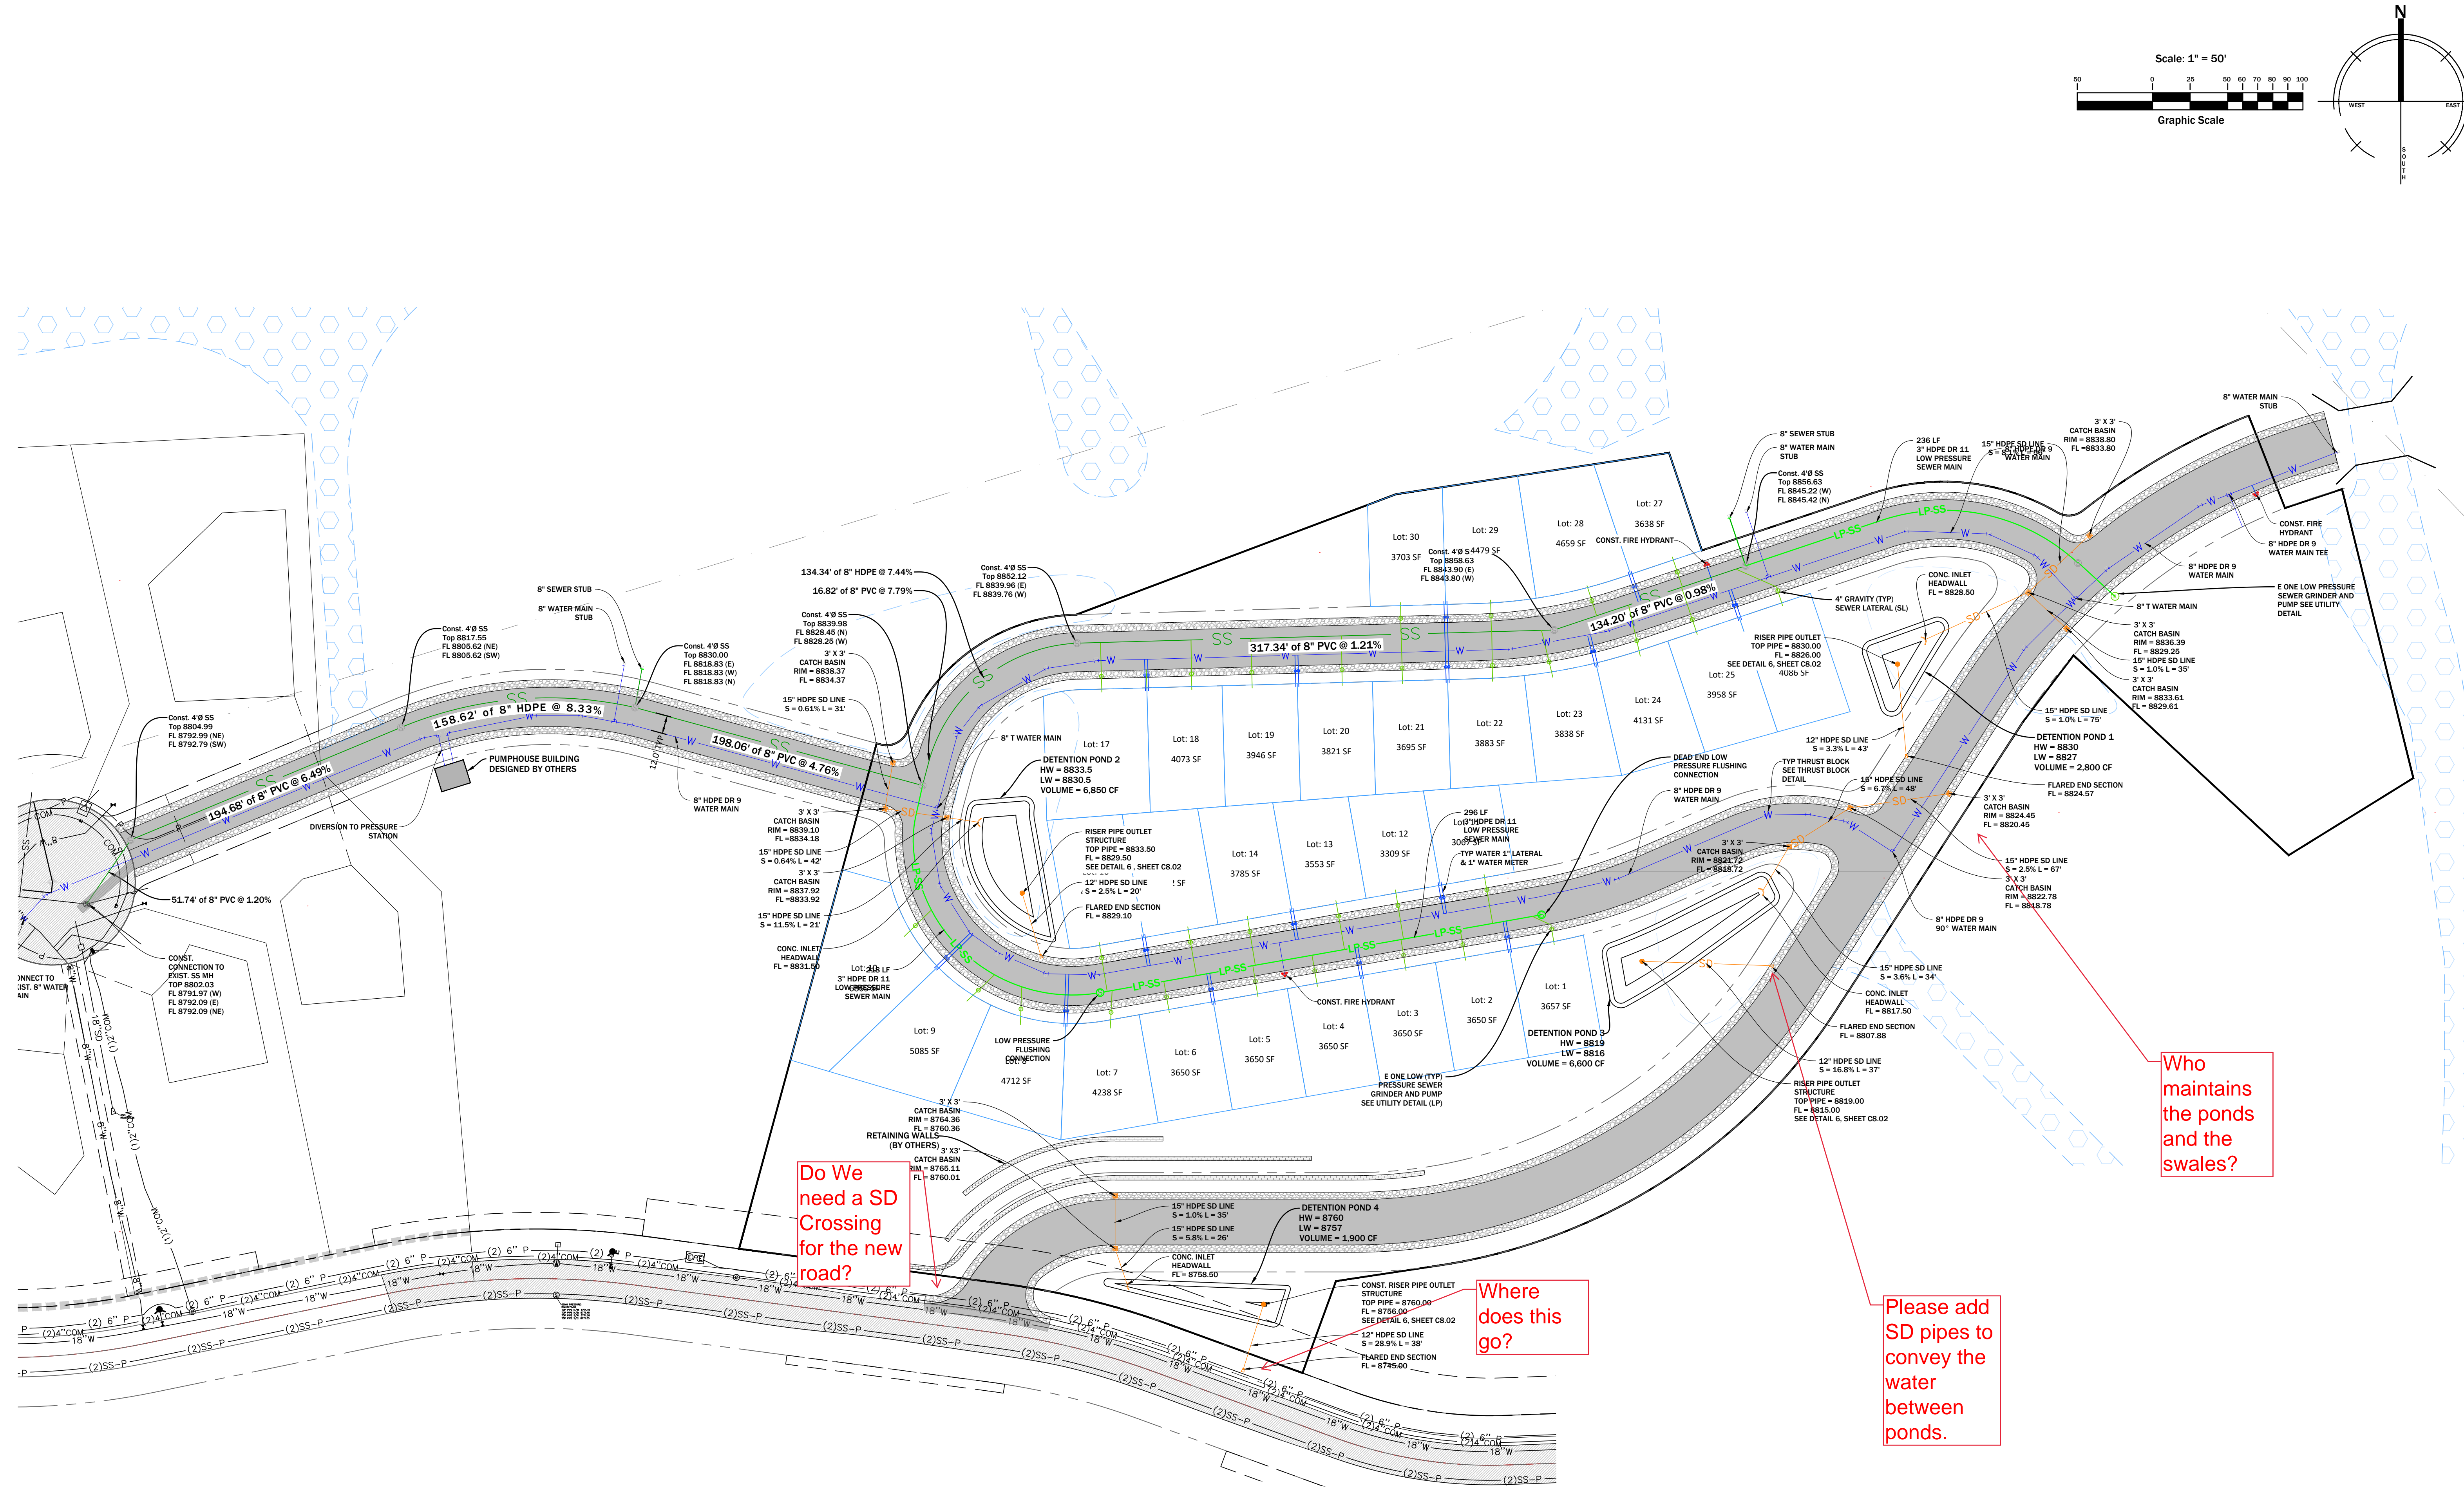
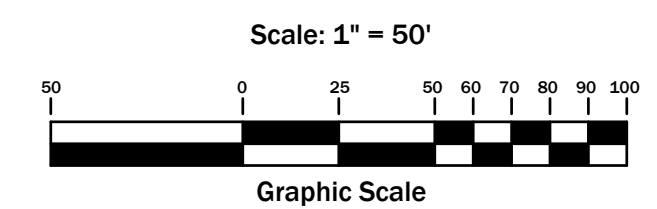


Do We need a SD Crossing for the new road?


Where does this go?

Please add SD pipes to convey the water between ponds.

Who maintains the ponds and the swales?

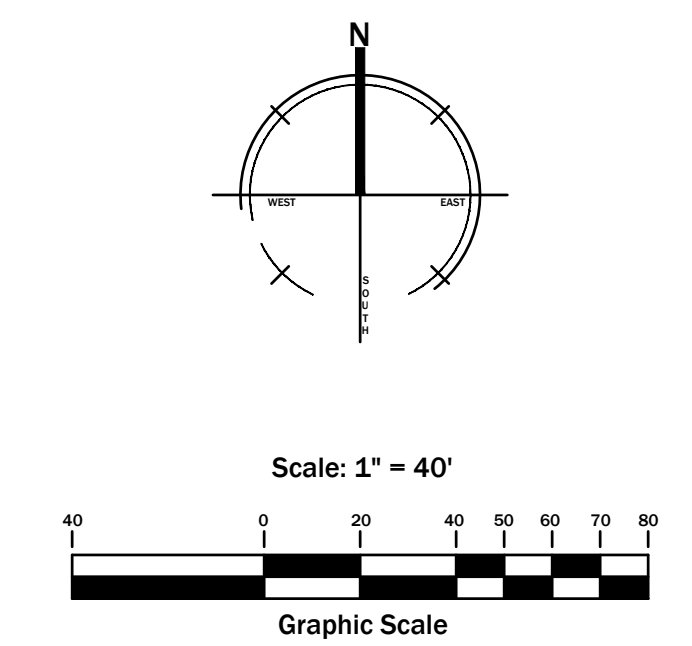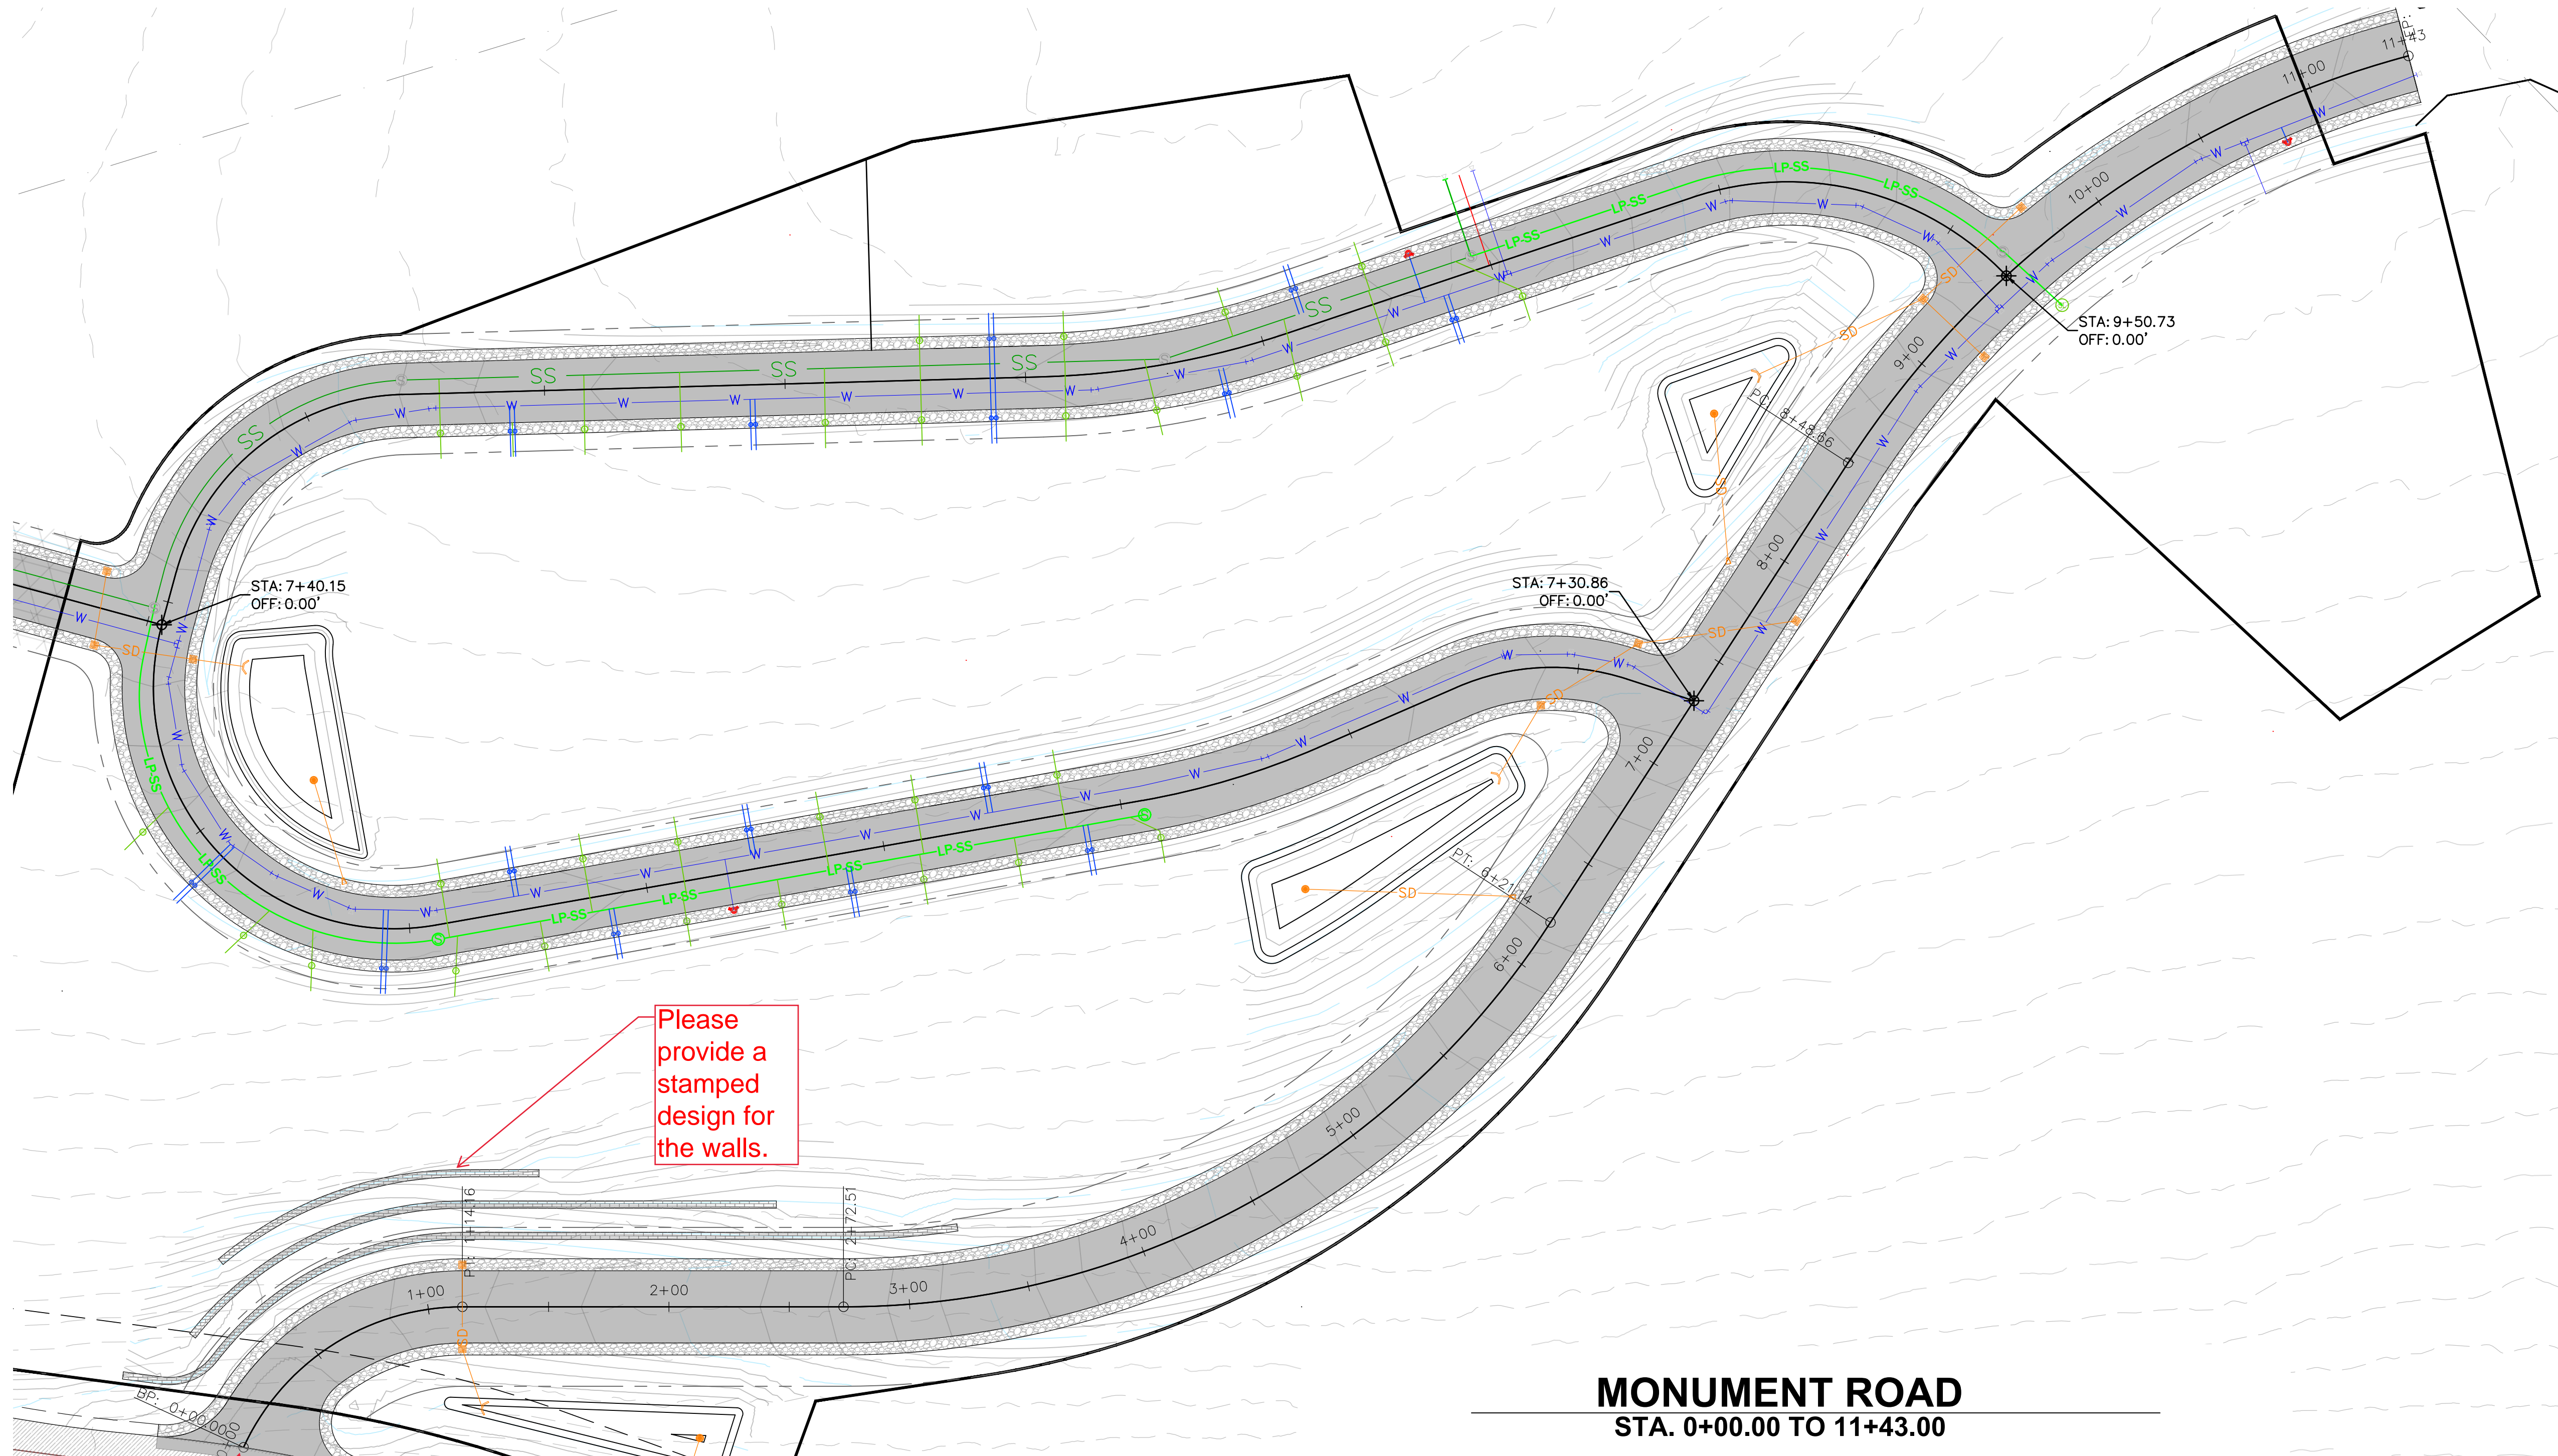

MONUMENT ROAD
STA. 0+00.00 TO 11+43.00

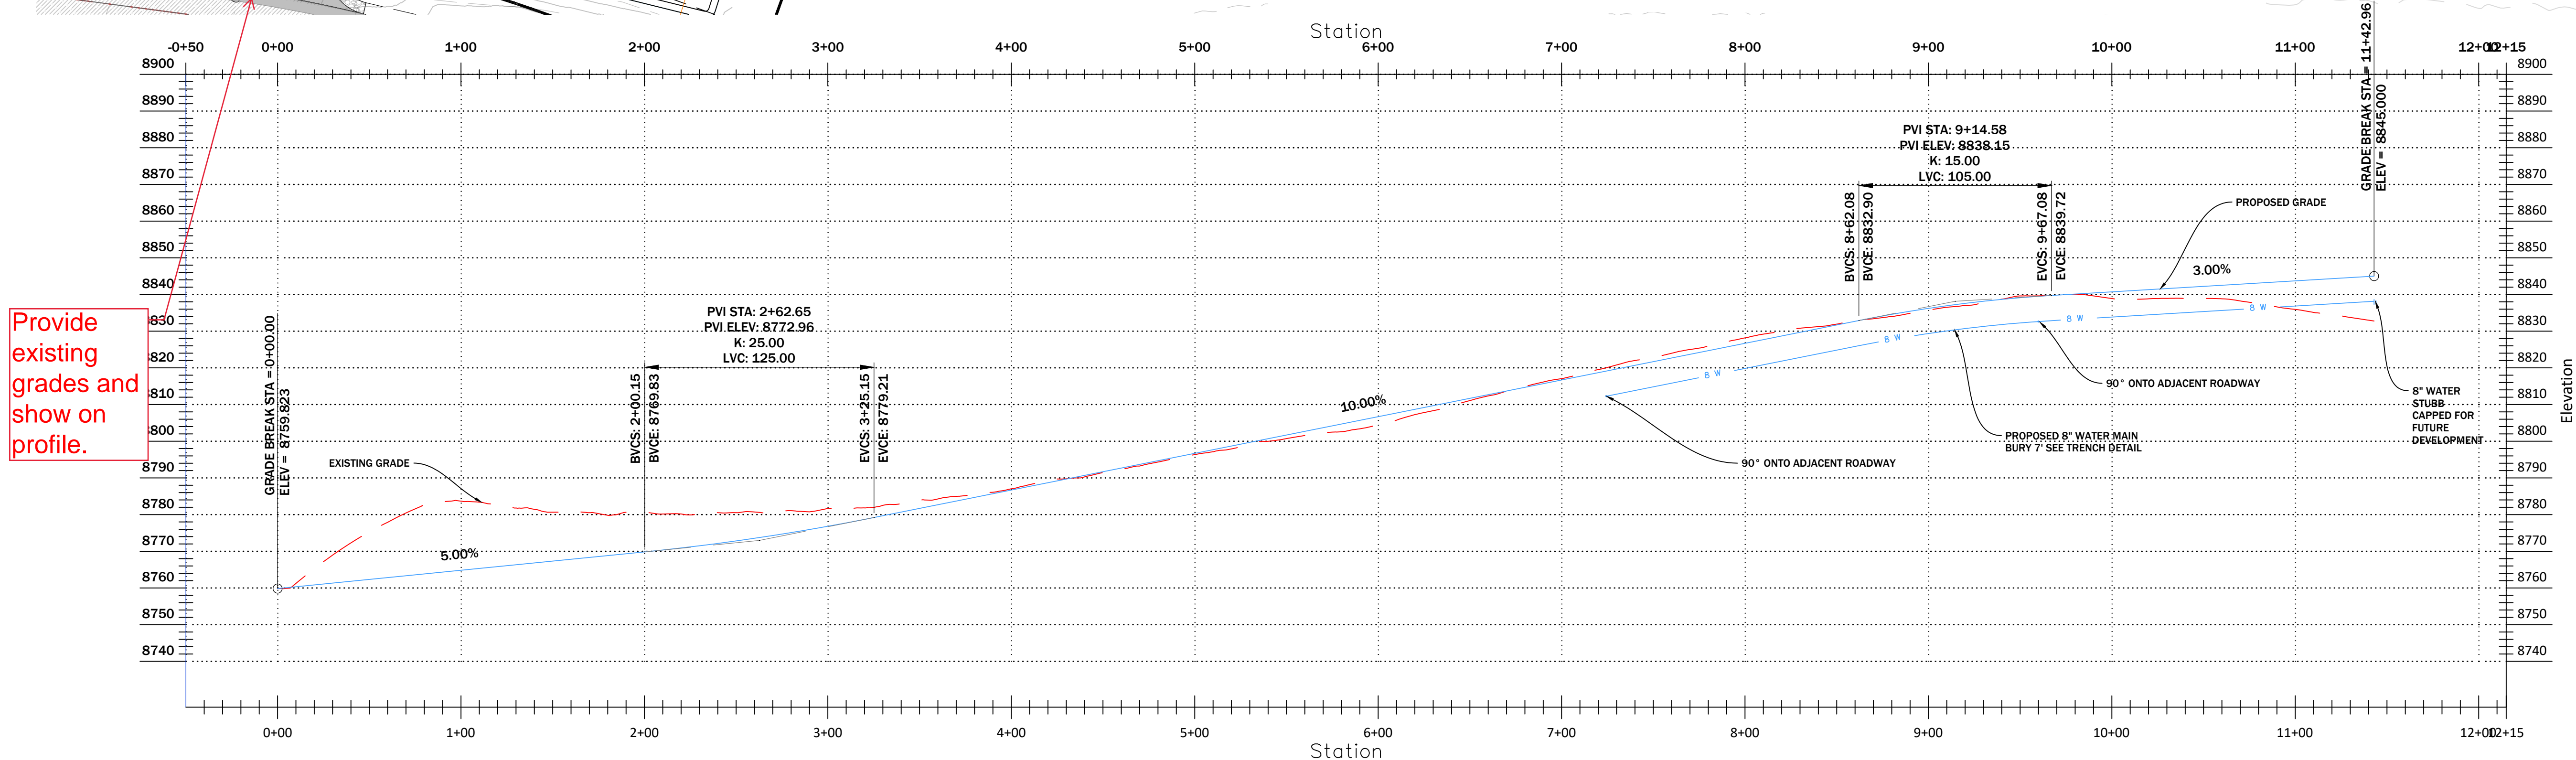


Provide existing grades and show on profile.

Please provide a stamped design for the walls.

BID SET

REVISION	DATE
1	
2	
3	
4	
5	
6	

PLAN & PROFILE
MONUMENT AT POWDER MOUNTAIN
Approx. 8050 Summit Pass Road, Eden, Utah

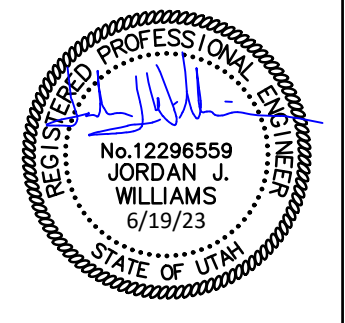

SCALE:


C5.00

DRAWN BY: CGW




8/14

BID SET


DATE:	5/26/2023
PROJECT NO.:	23.001
REVISION	DATE
1	
2	
3	
4	
5	
6	

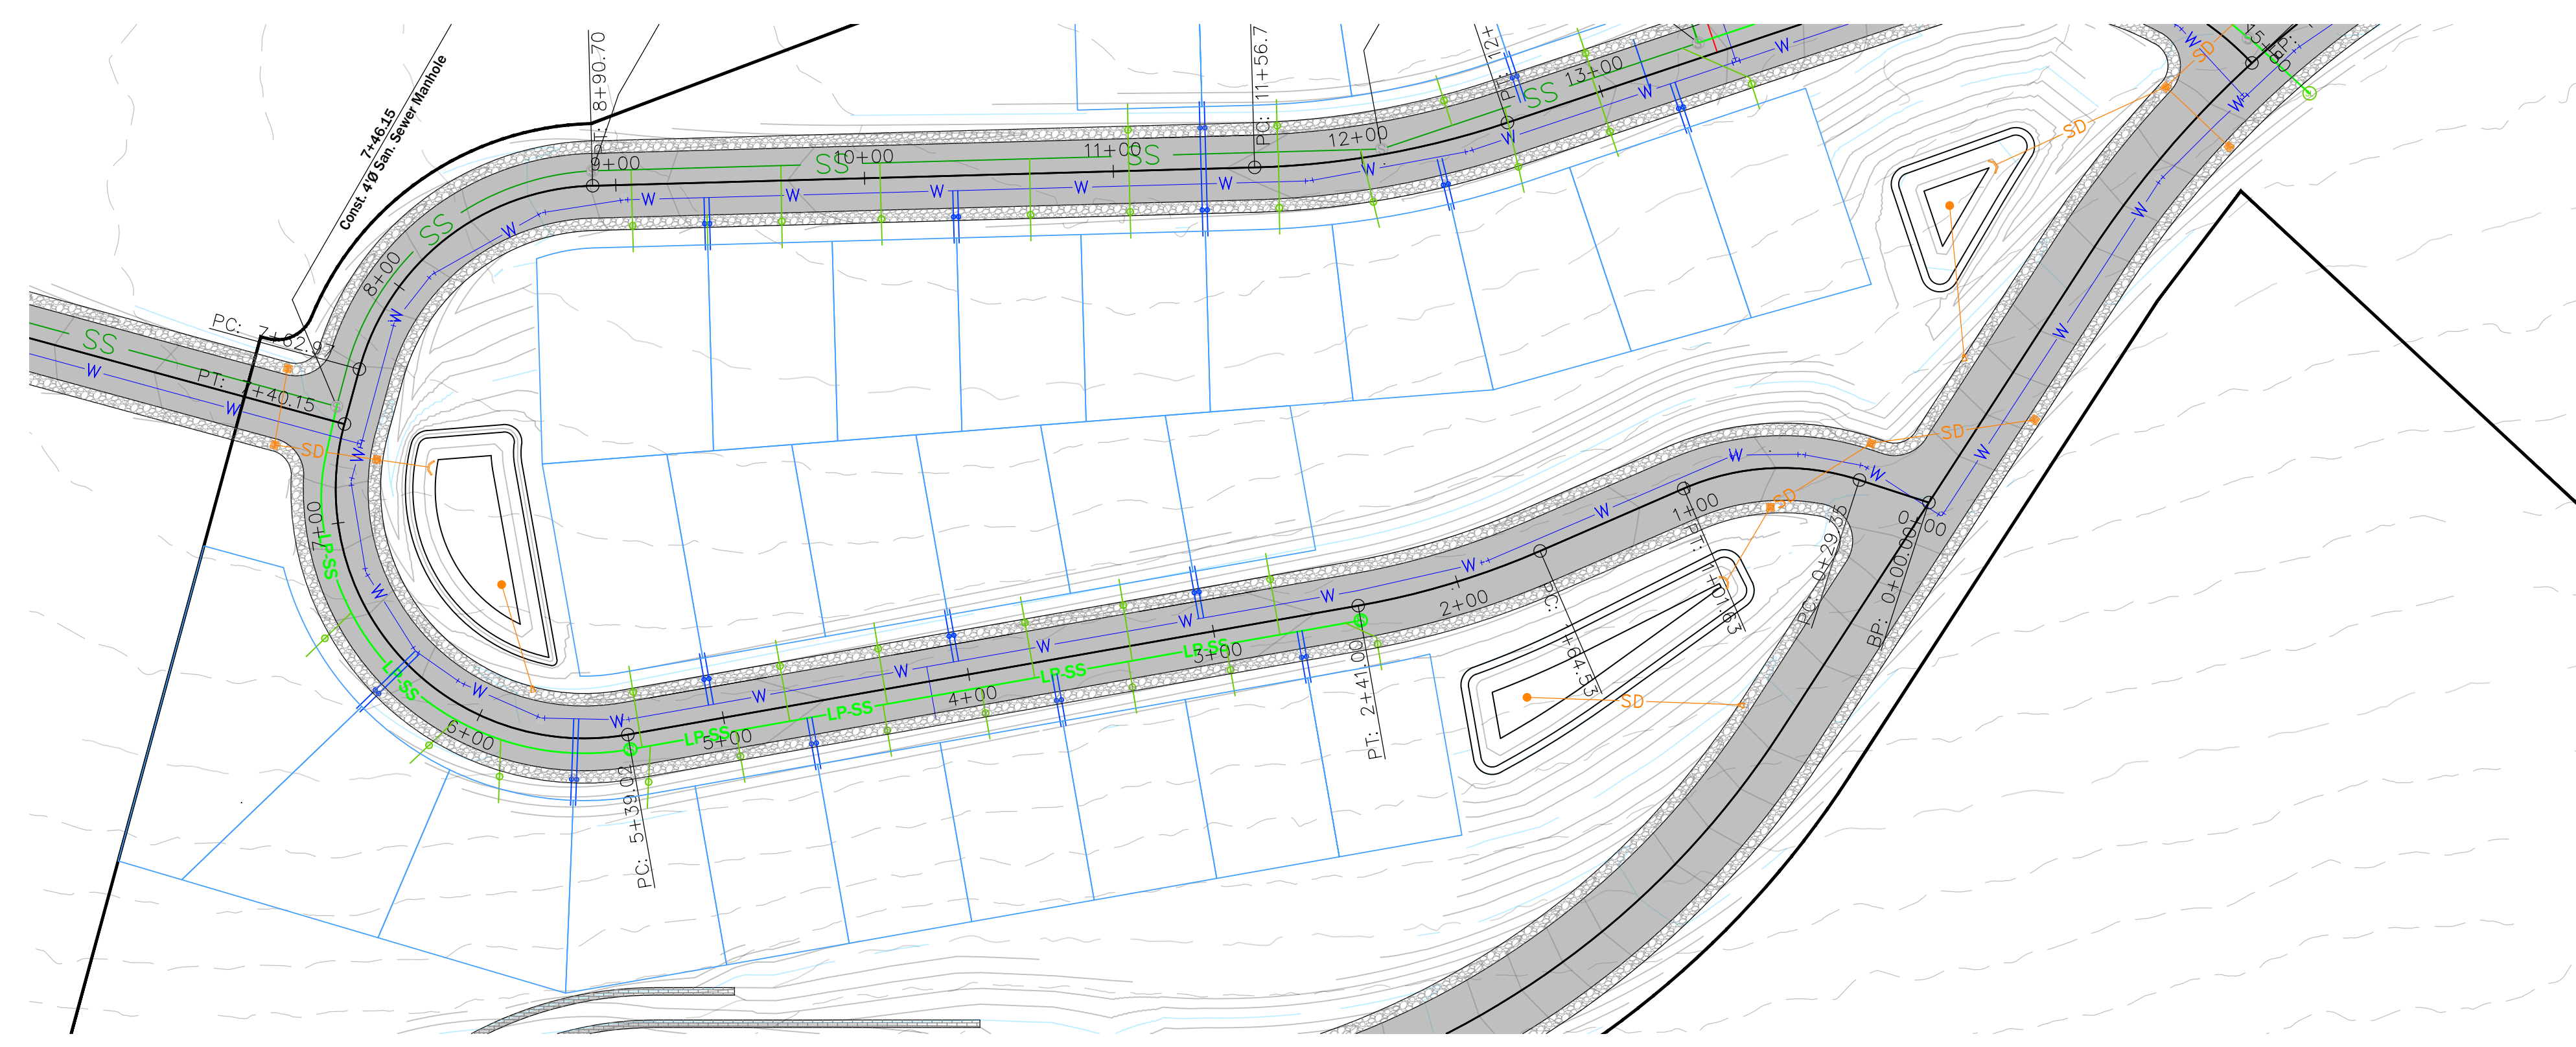

BRENNY CIRCLE
STA. 0+00.00 TO 8+00.00

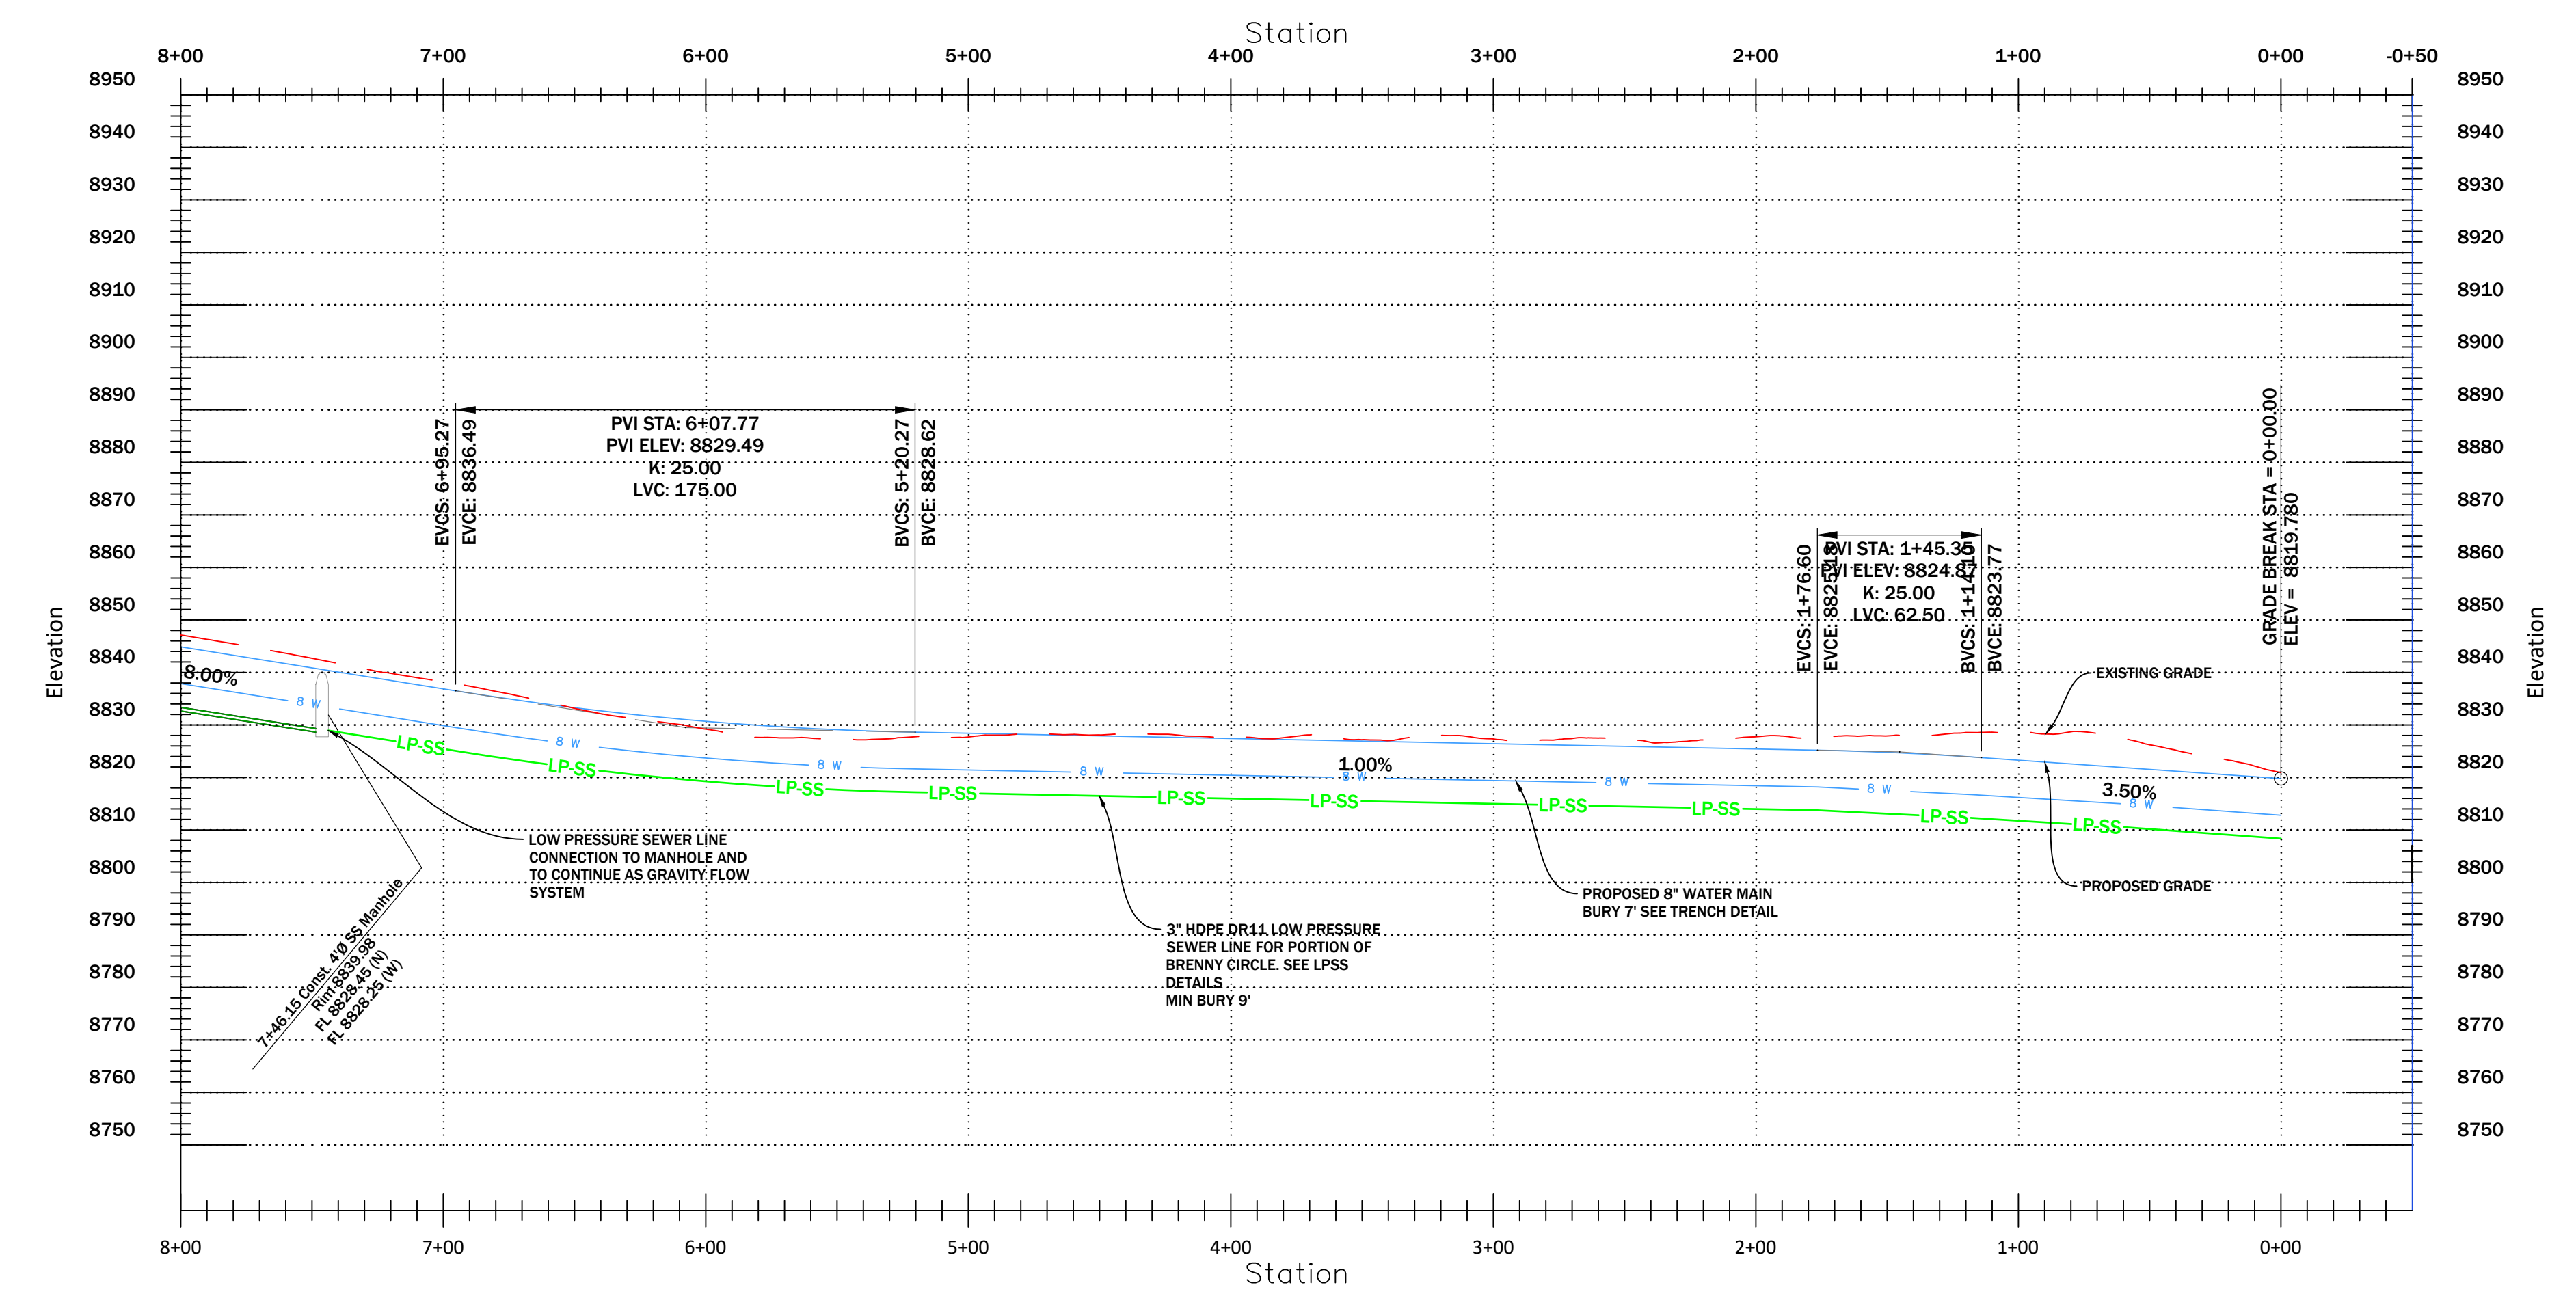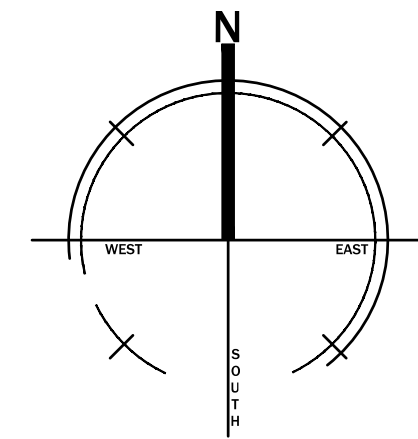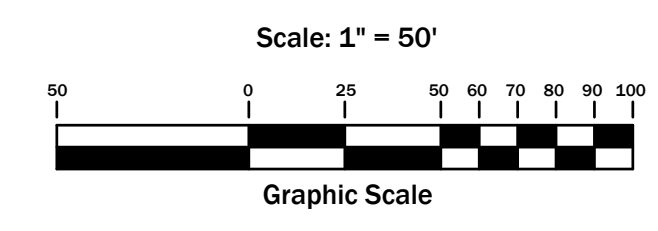

PLAN & PROFILE
MONUMENT AT POWDER MOUNTAIN
Approx. 8050 Summit Pass Road, Eden, Utah

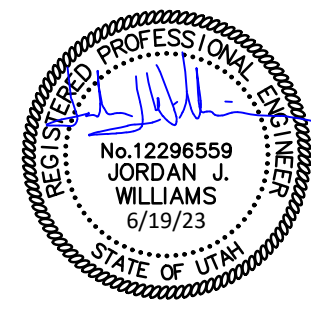

SCALE:

C5.01




DRAWN BY: CGW

9/14


BID SET

DATE:	5/26/2023
PROJECT NO.:	23.001
REVISION	DATE
1	
2	
3	
4	
5	
6	

PLAN & PROFILE
MONUMENT AT POWDER MOUNTAIN
Approx. 8050 Summit Pass Road, Eden, Utah

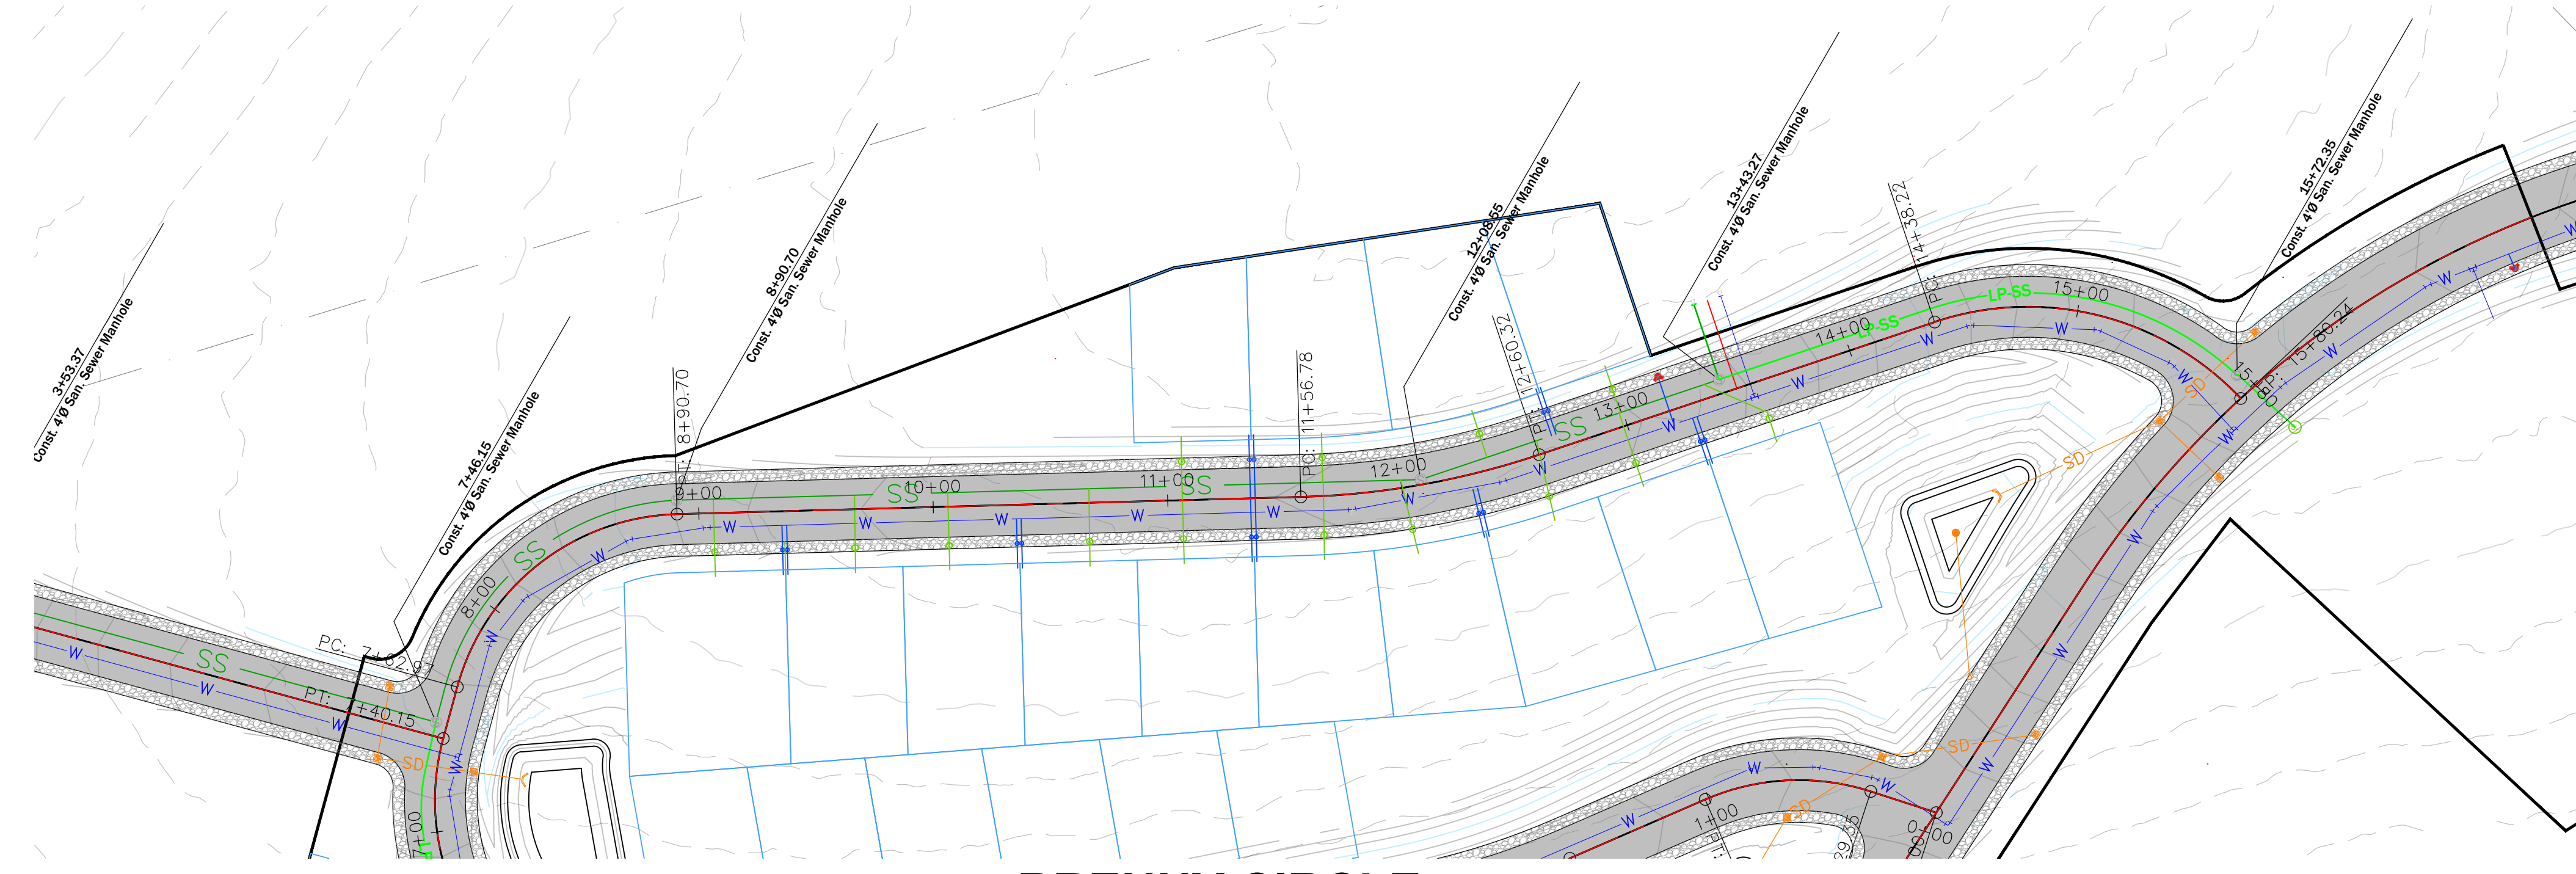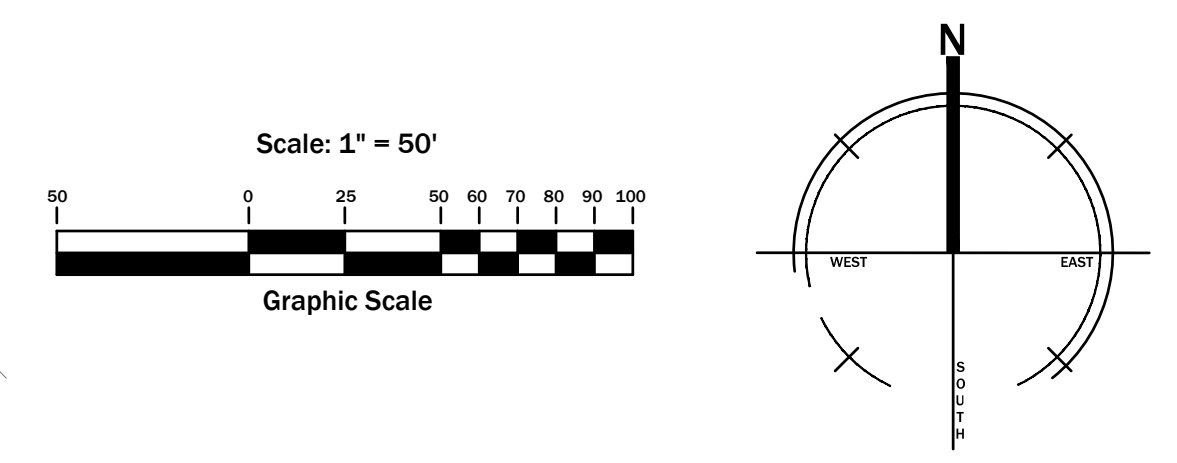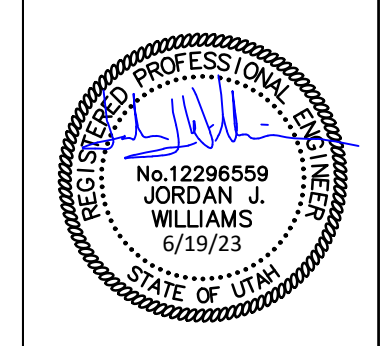


BRENNY CIRCLE
STA. 7+40.15 TO 15+80.24

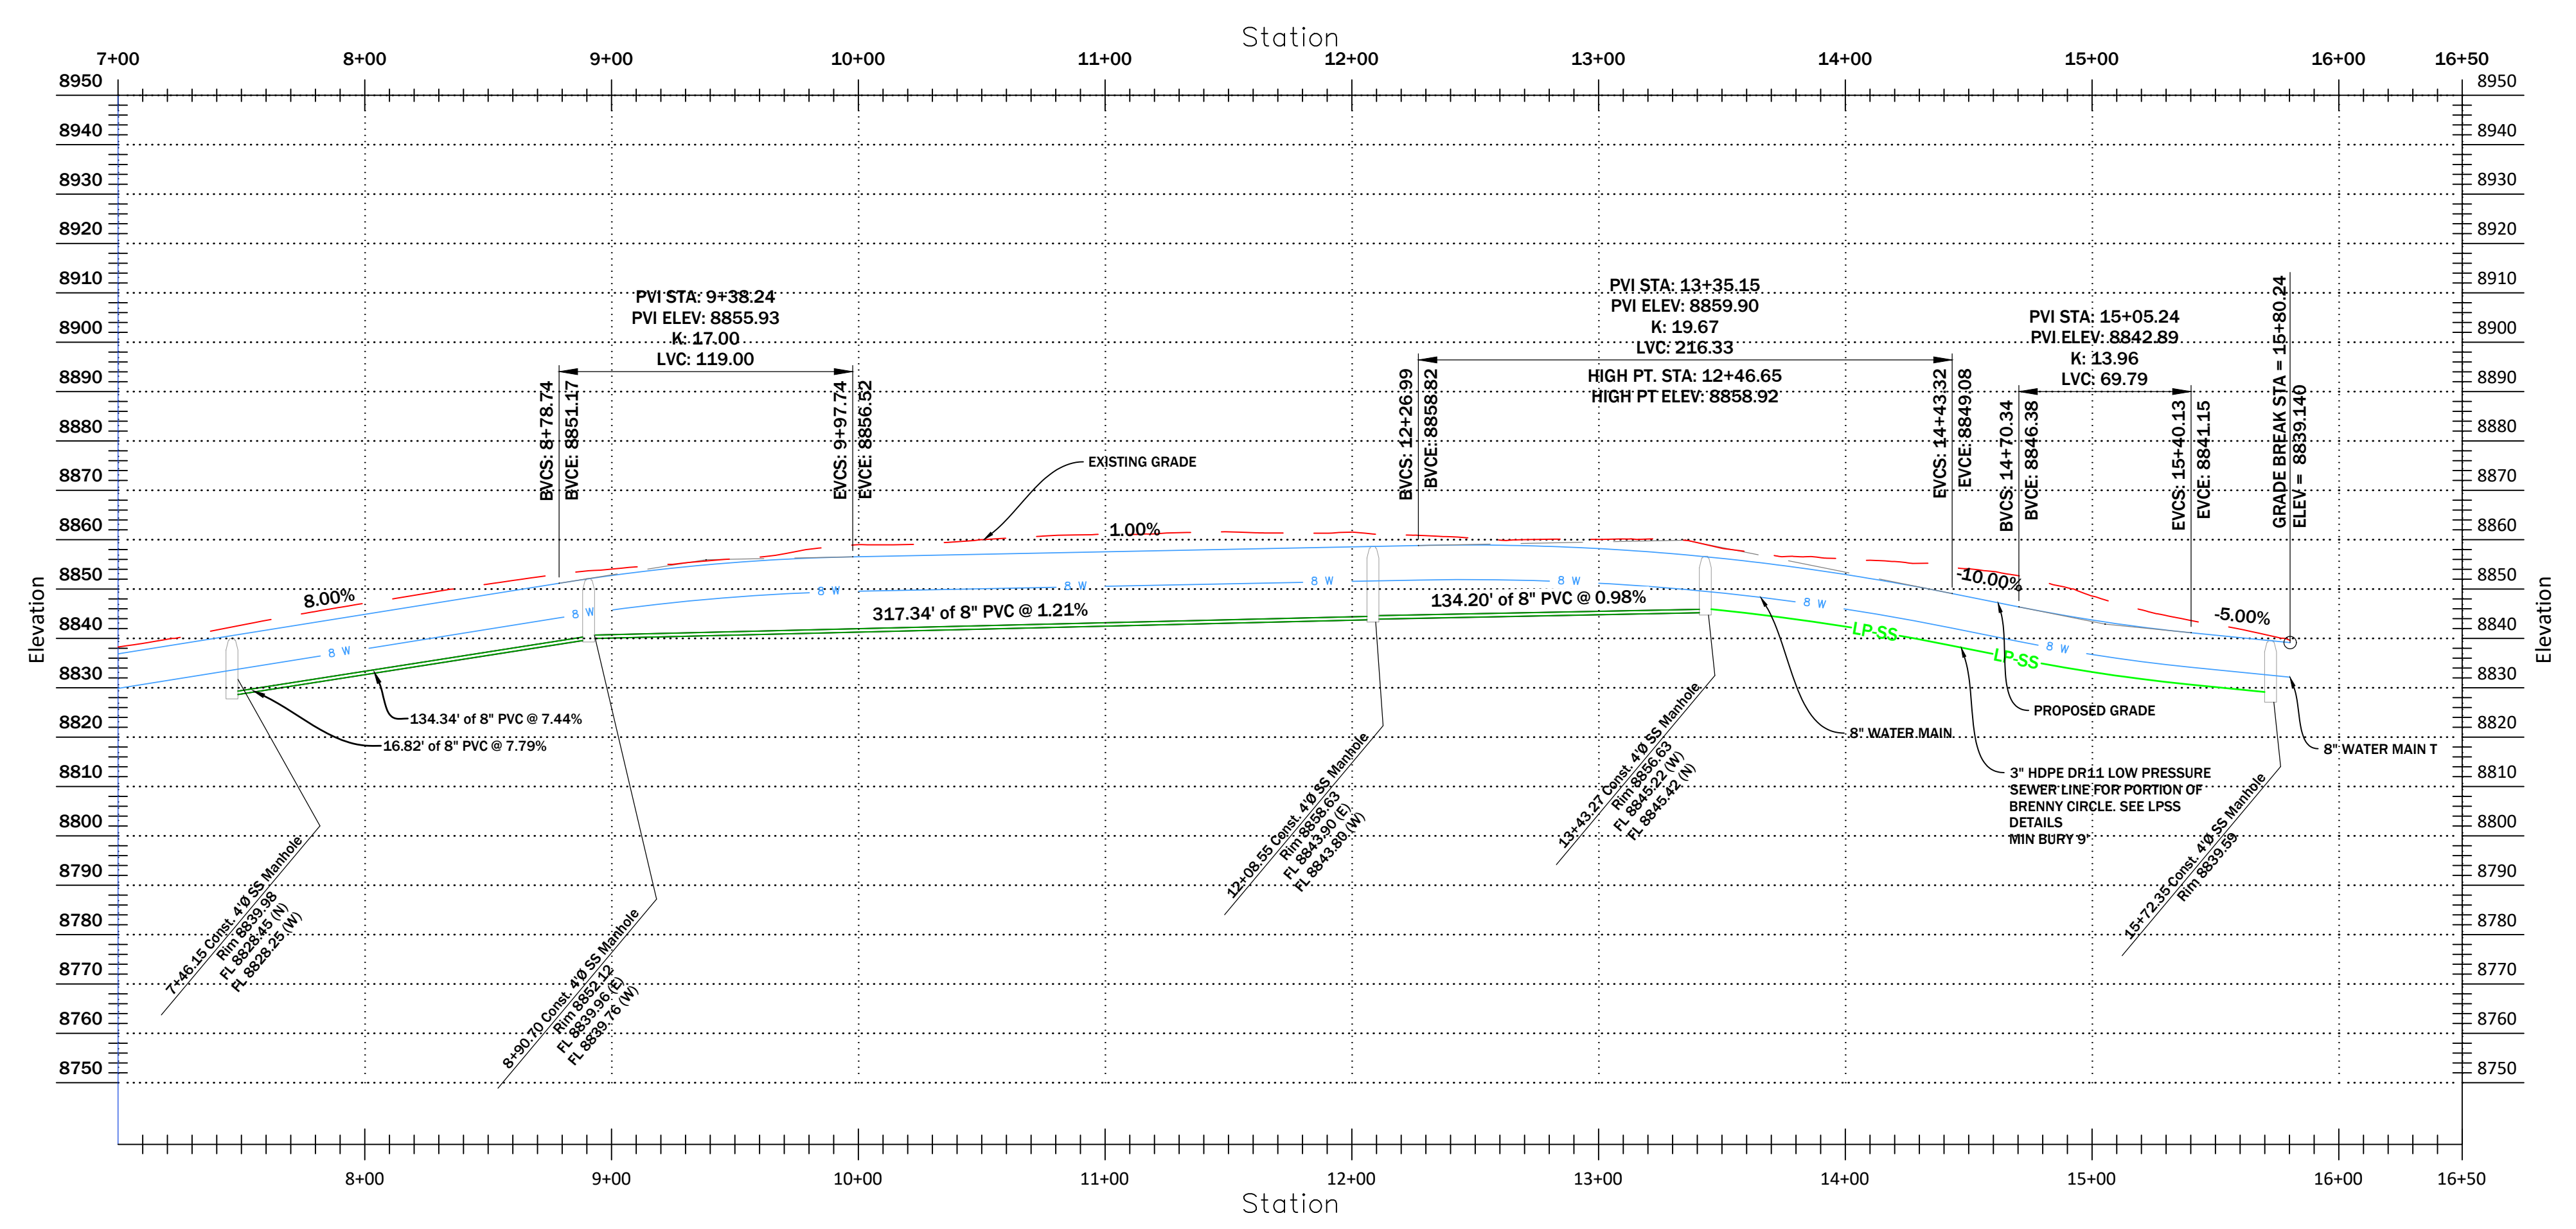

BID SET

DATE:	5/26/2023
PROJECT NO.:	23.001
REVISION	DATE
1	
2	
3	
4	
5	
6	

PLAN & PROFILE
MONUMENT AT POWDER MOUNTAIN
Approx. 8050 Summit Pass Road, Eden, Utah


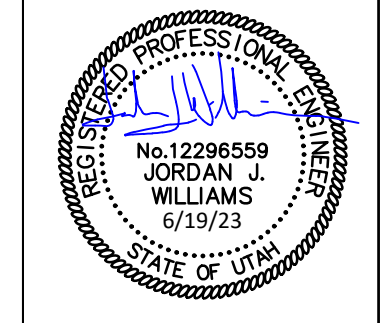


SCALE:

C5.03


DRAWN BY: CGW


11/14

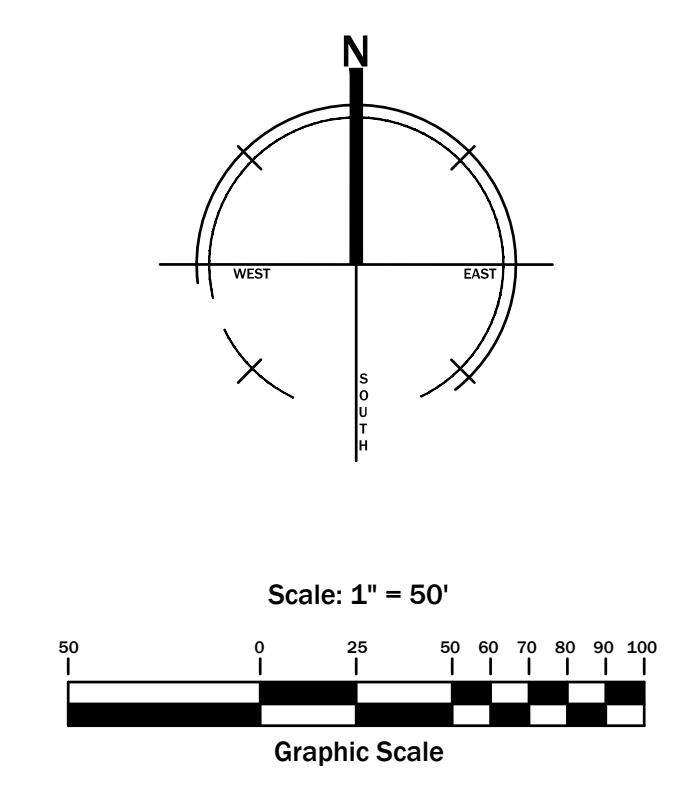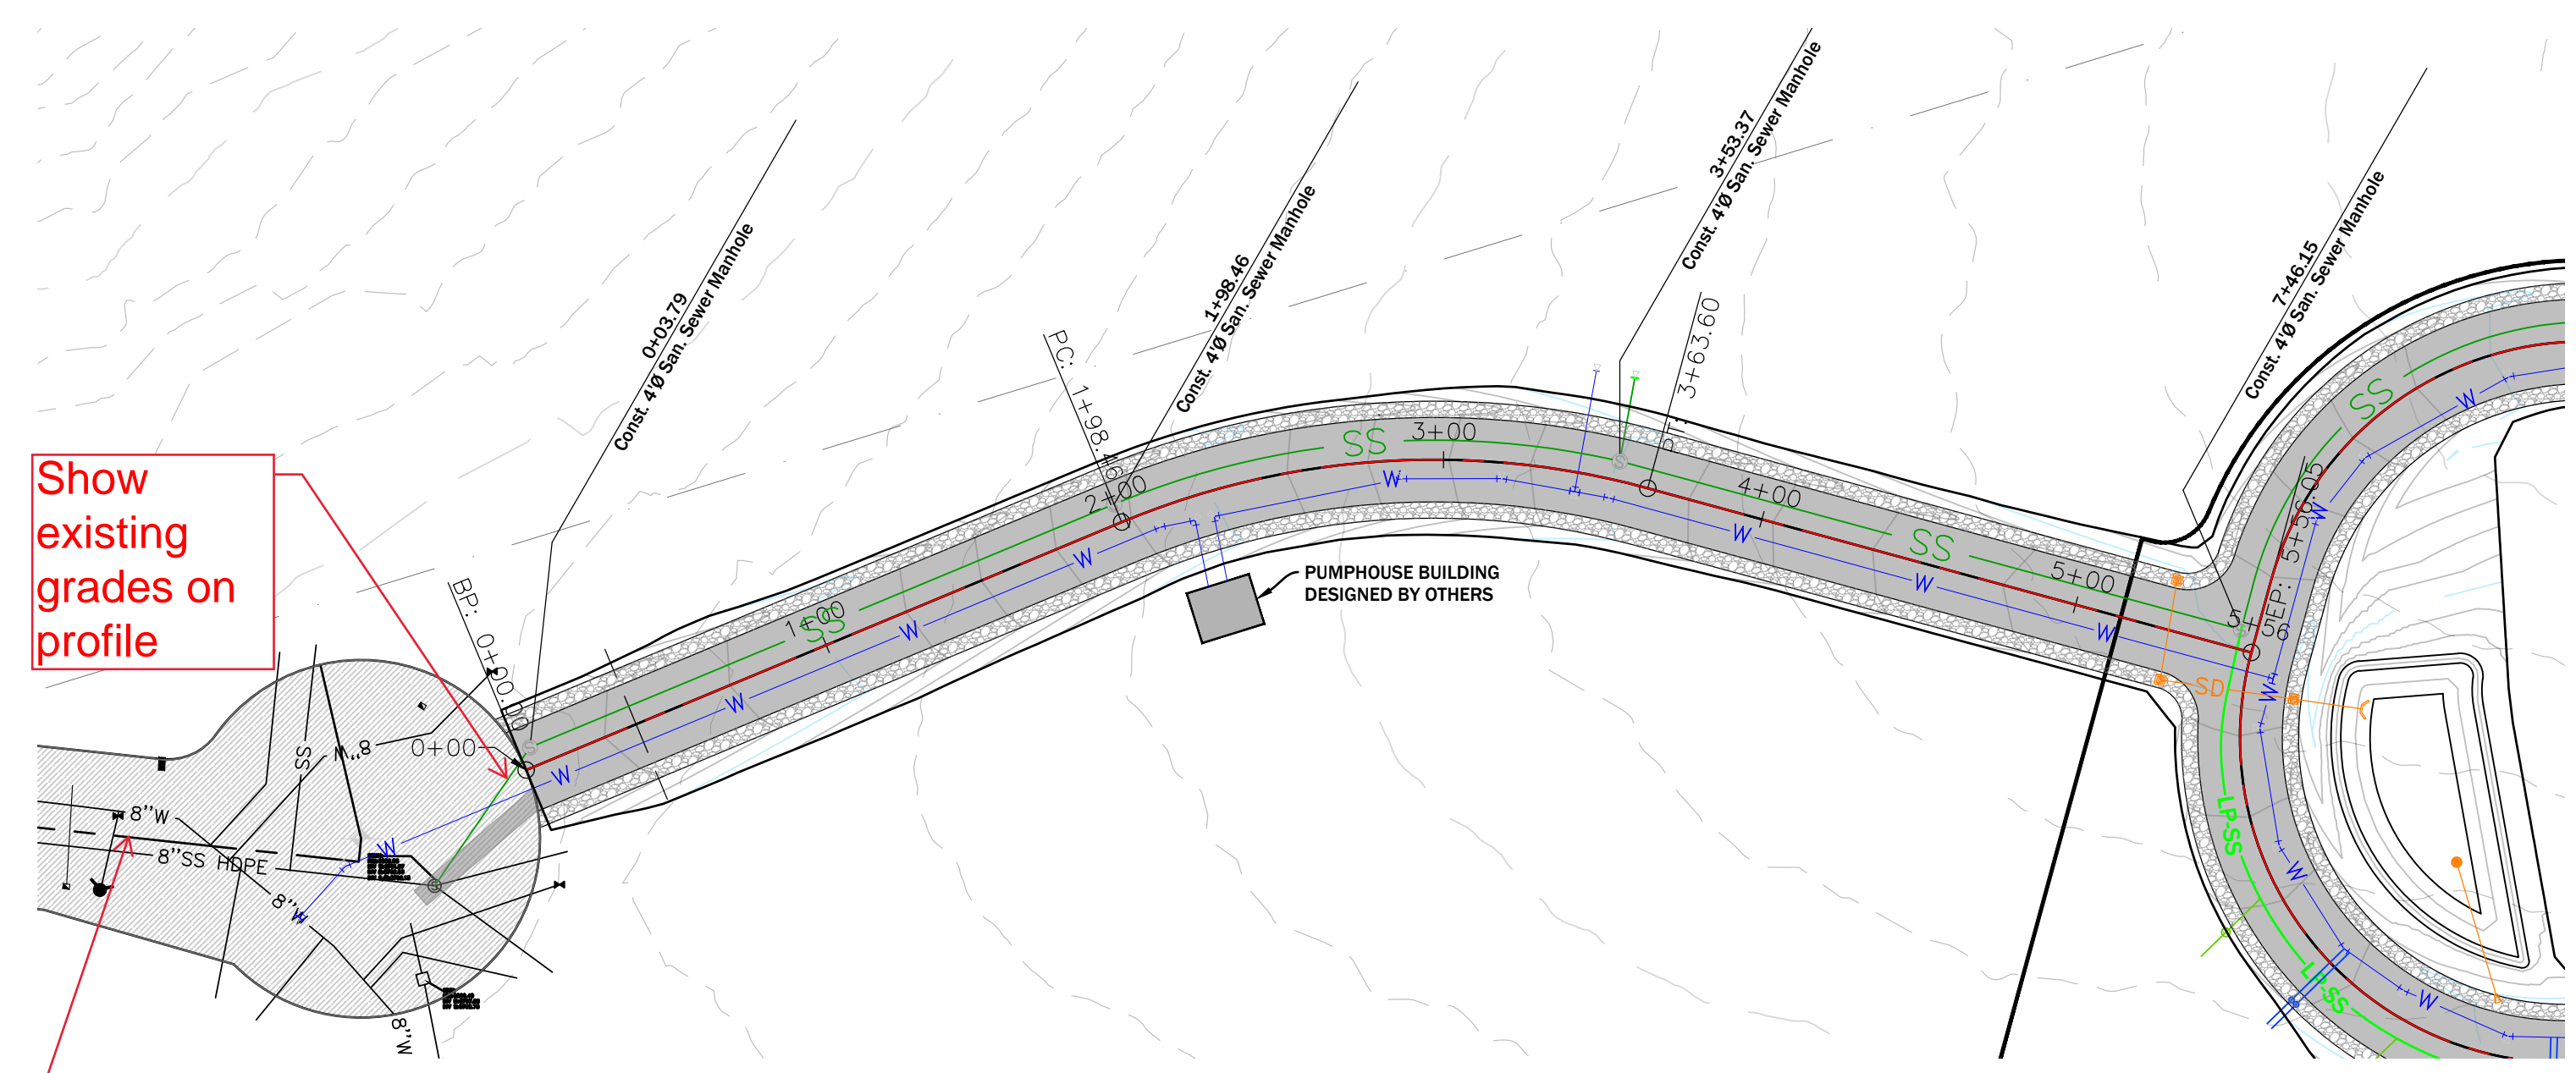


Provide documentation that shows you can use this road

FAWKES DRIVE
STA. 0+00 TO 5+56

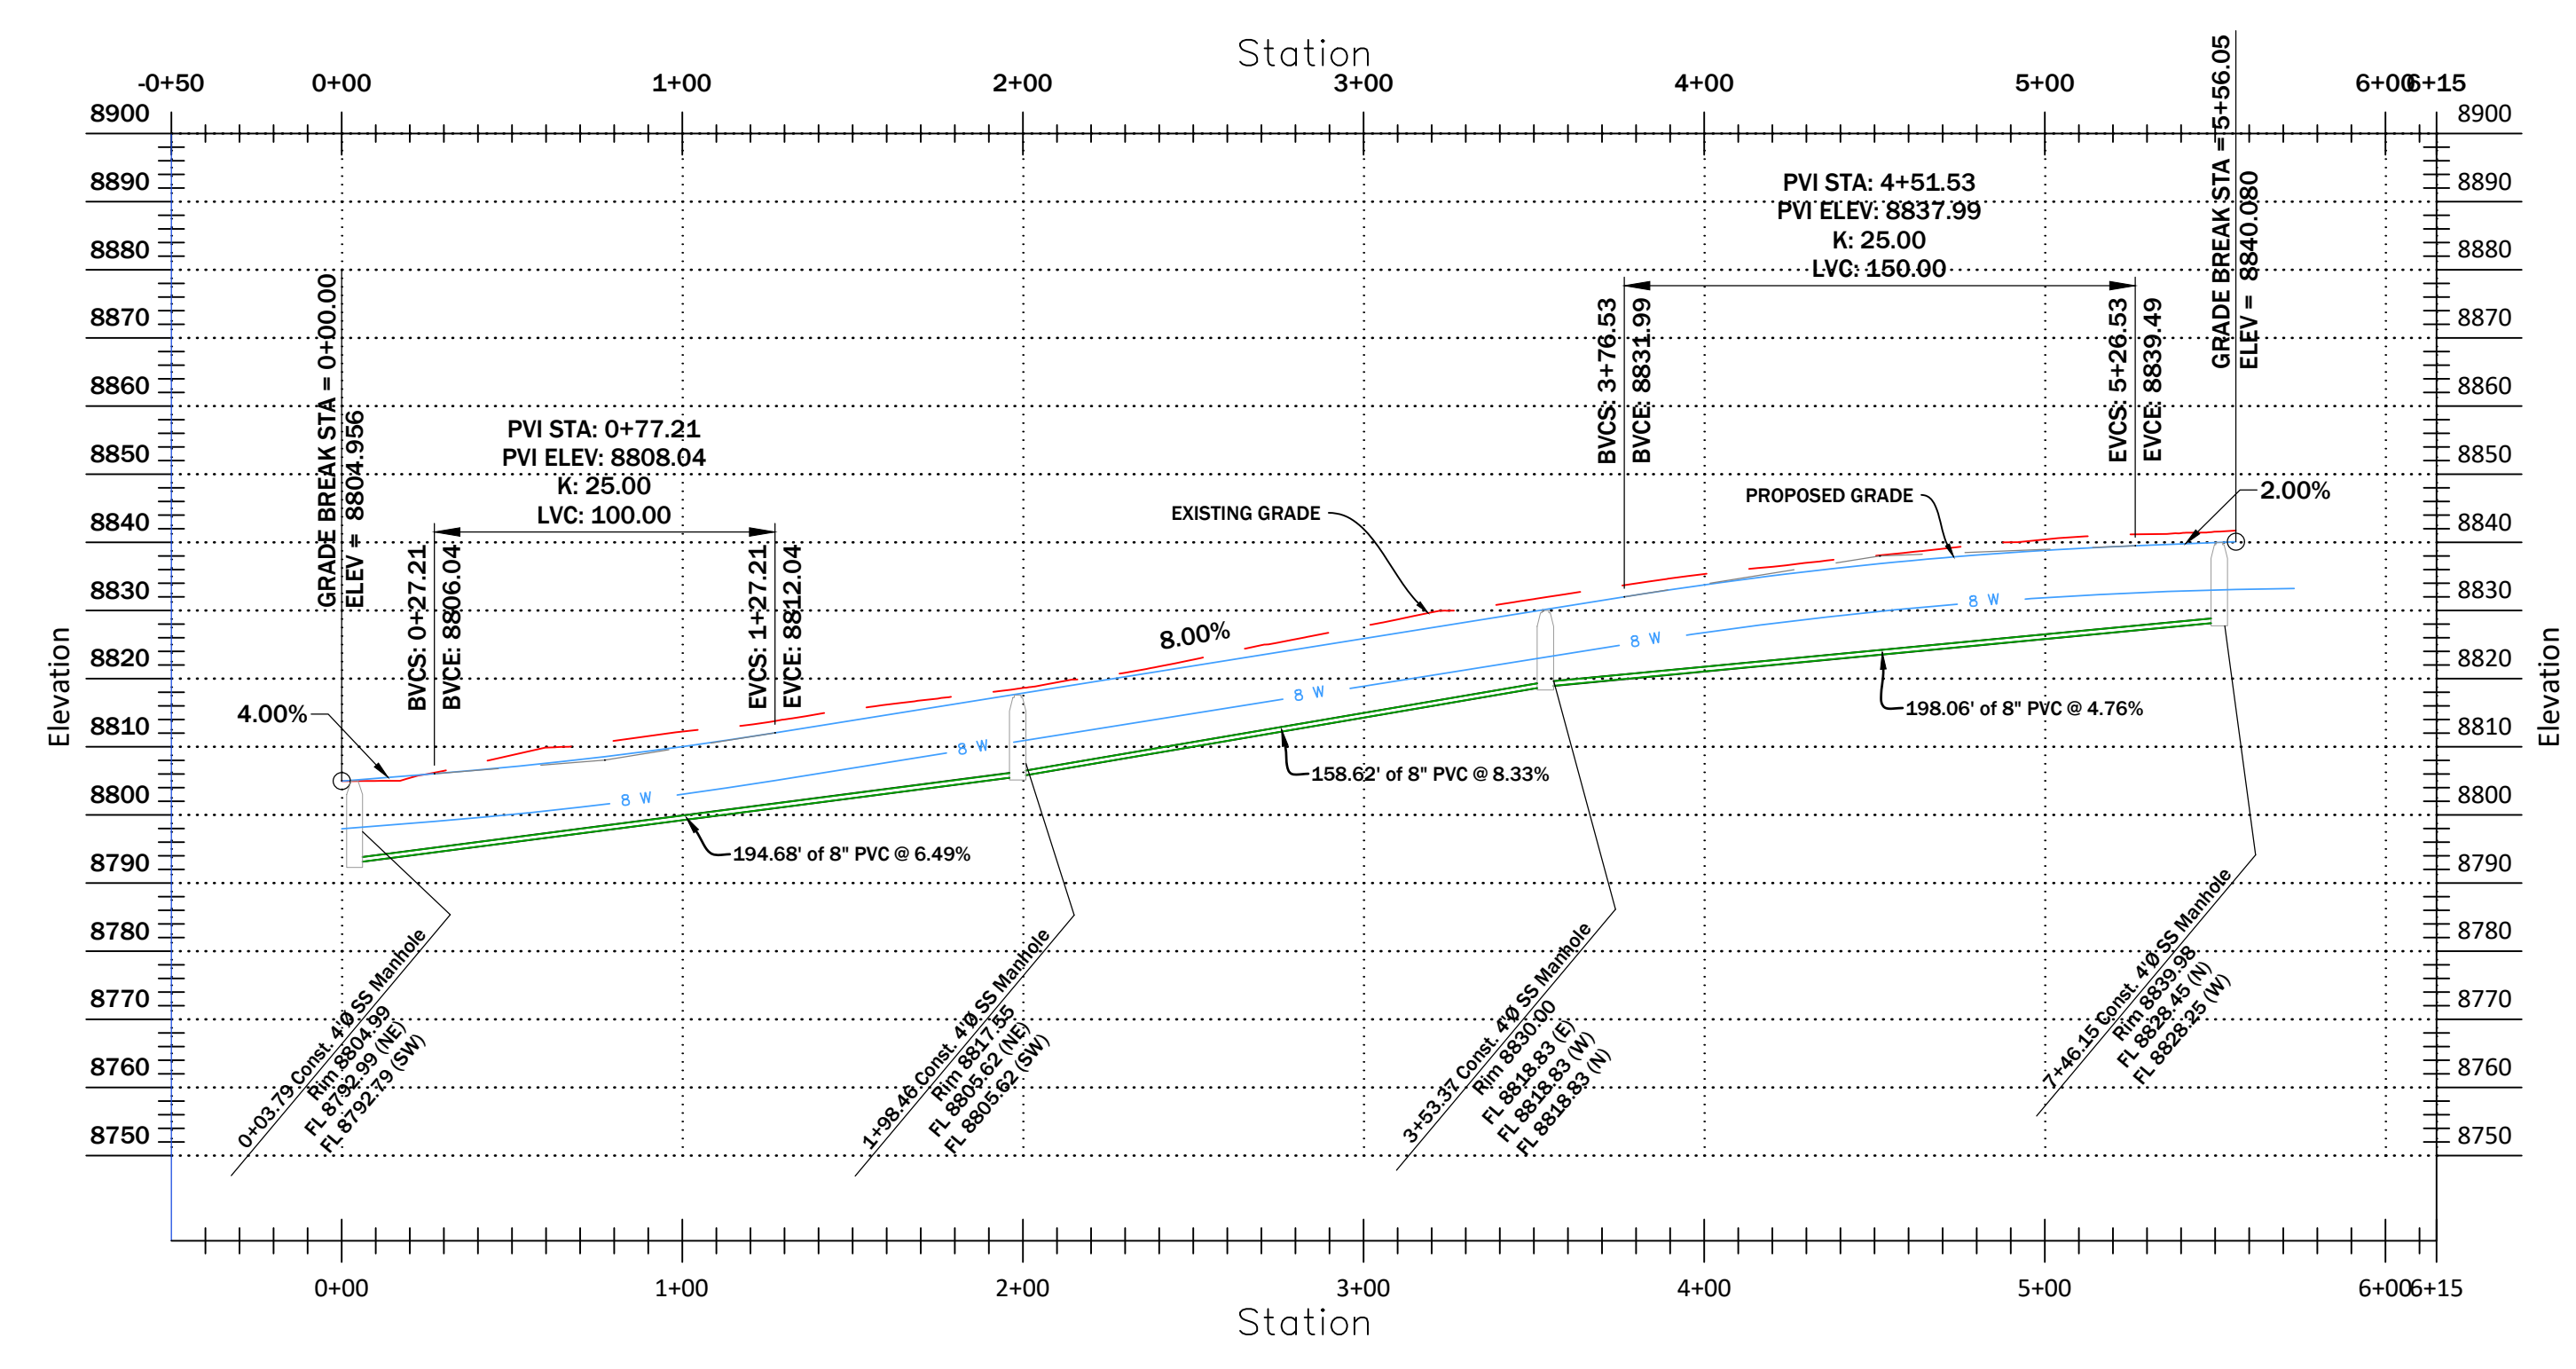


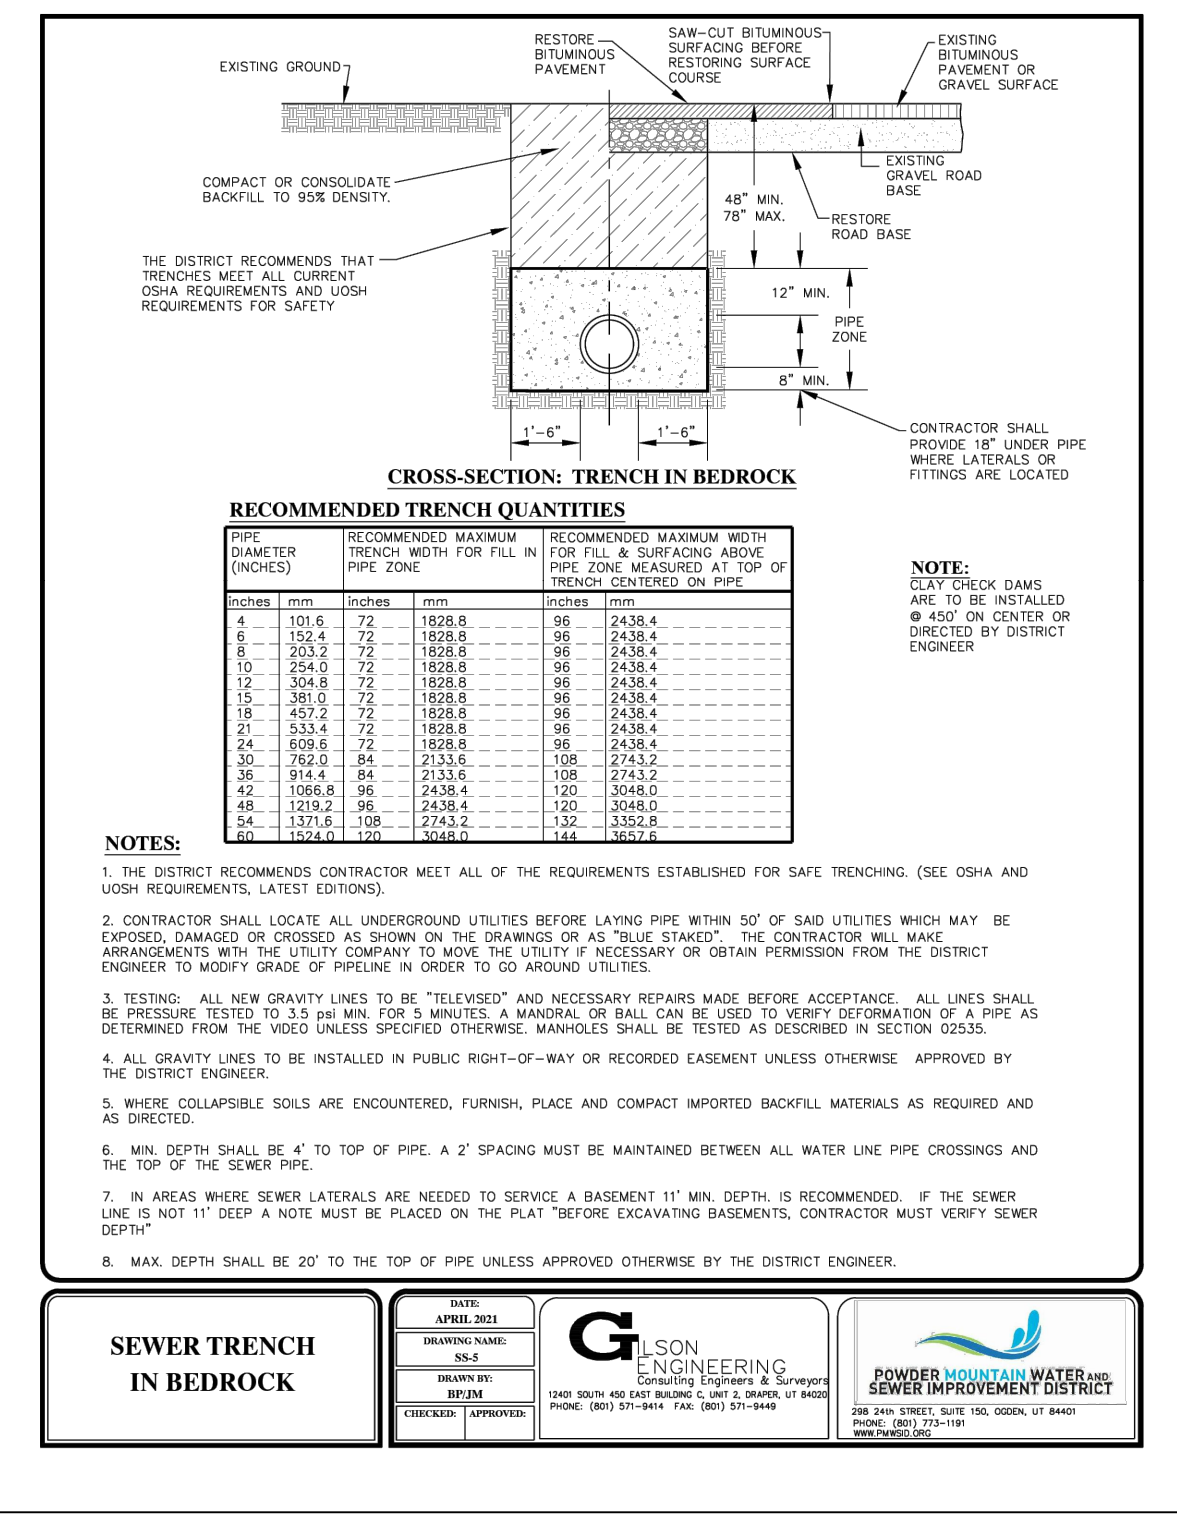


5 SEWER TRENCH - PMW&S

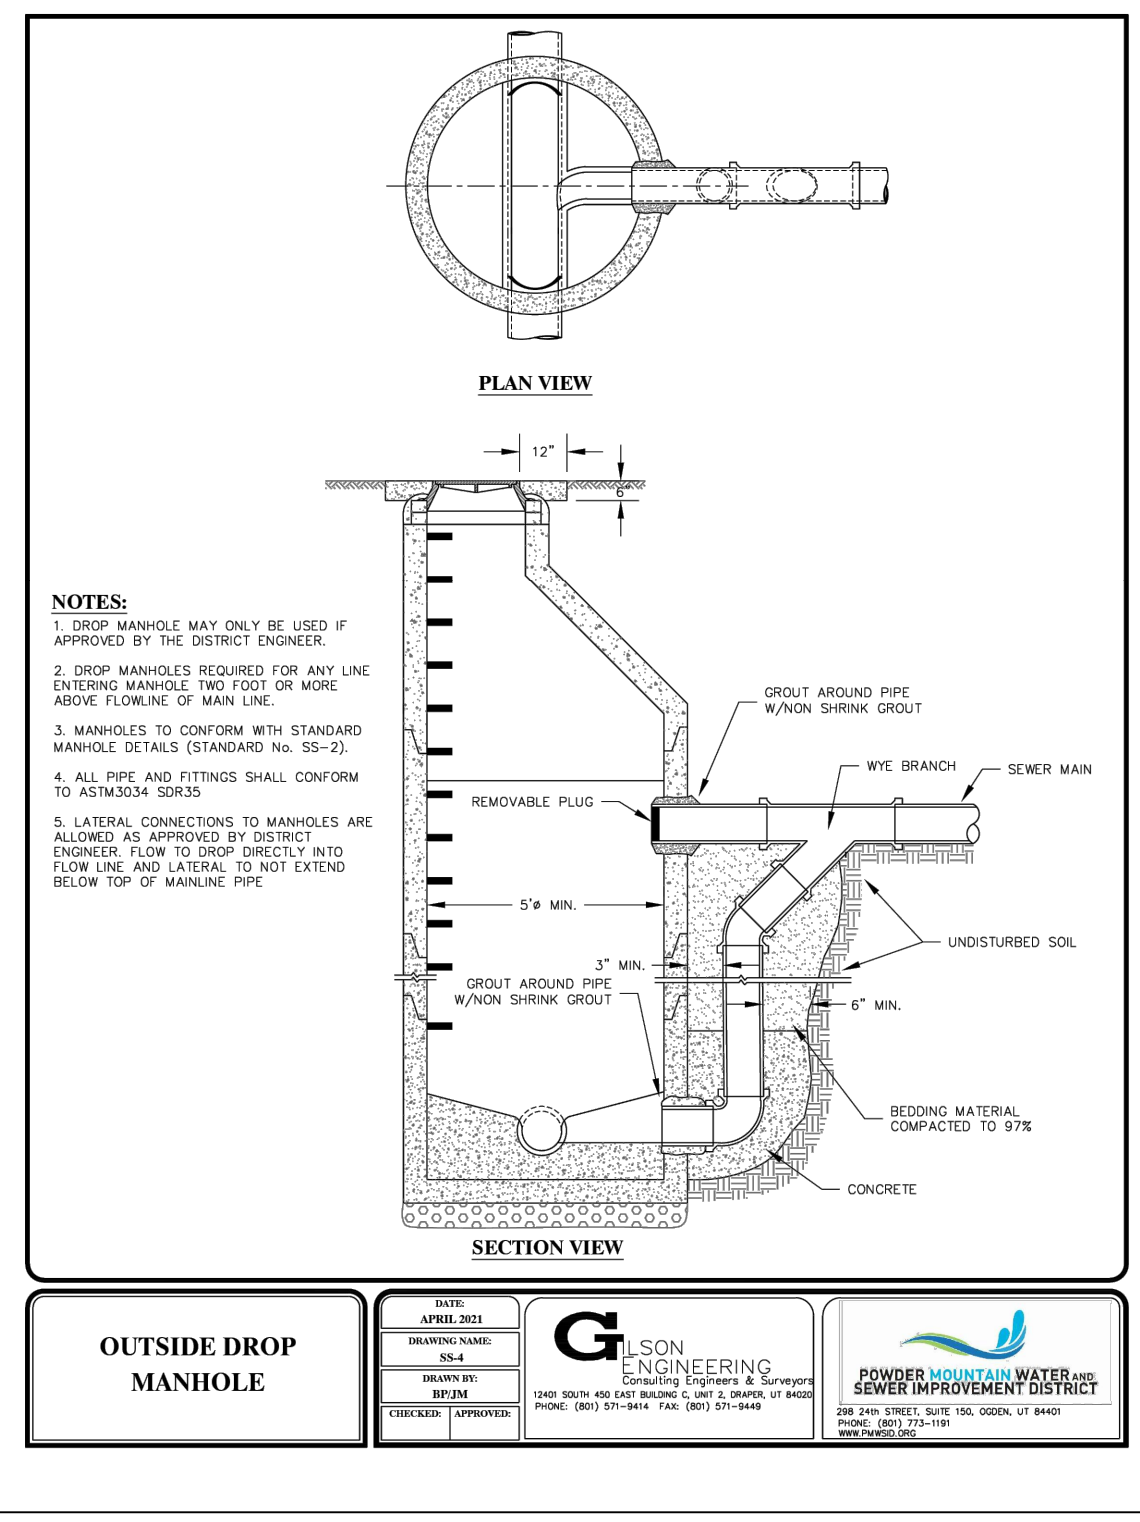


4 SEWER DROP MANHOLE - PMW&S

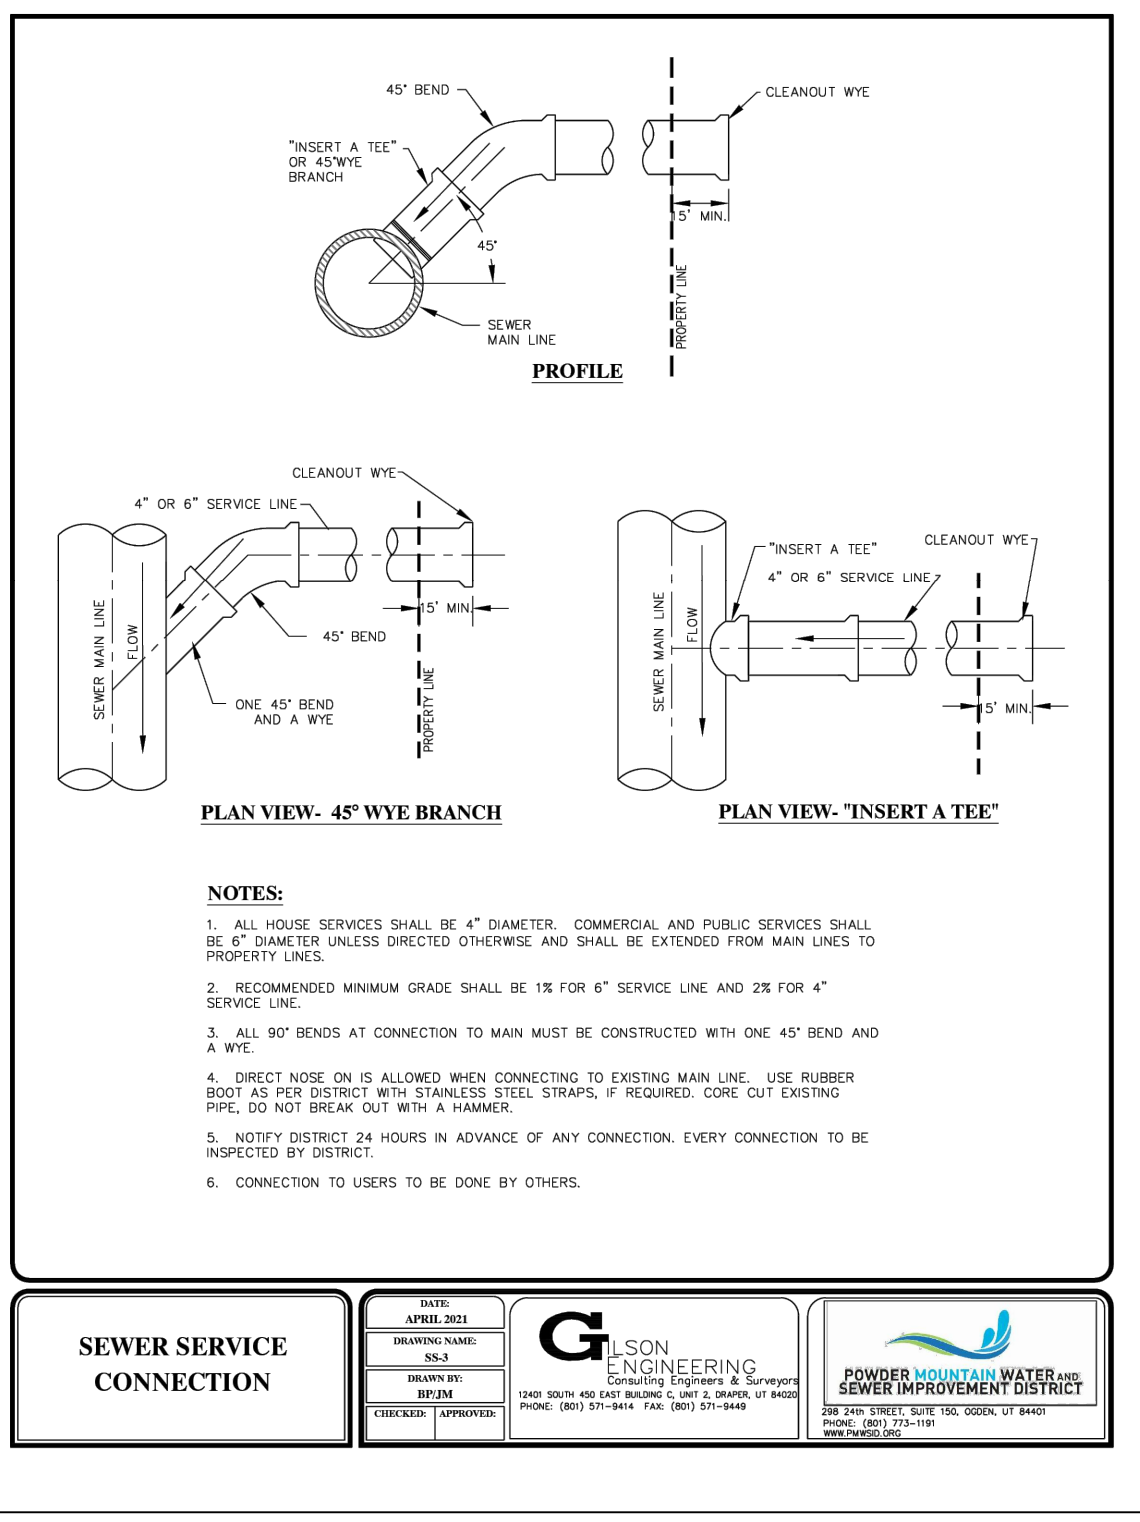


3 SEWER CONNECTION - PMW&S

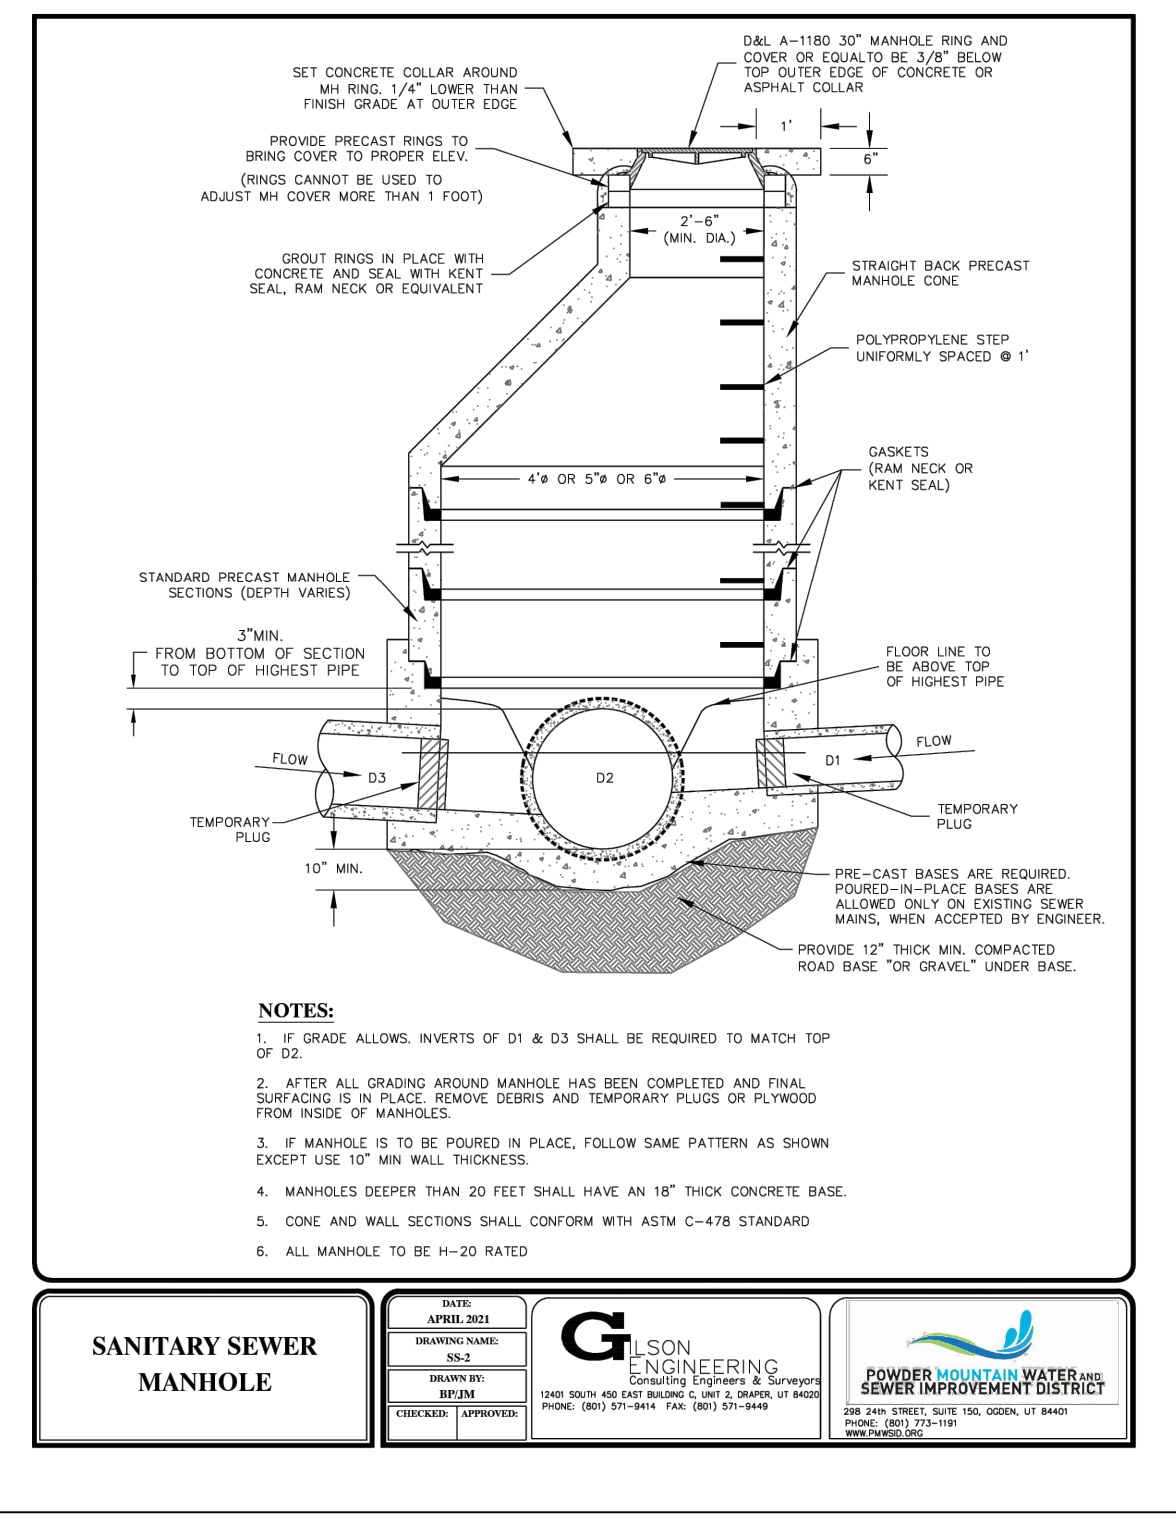


2 SEWER MANHOLE - PMW&S

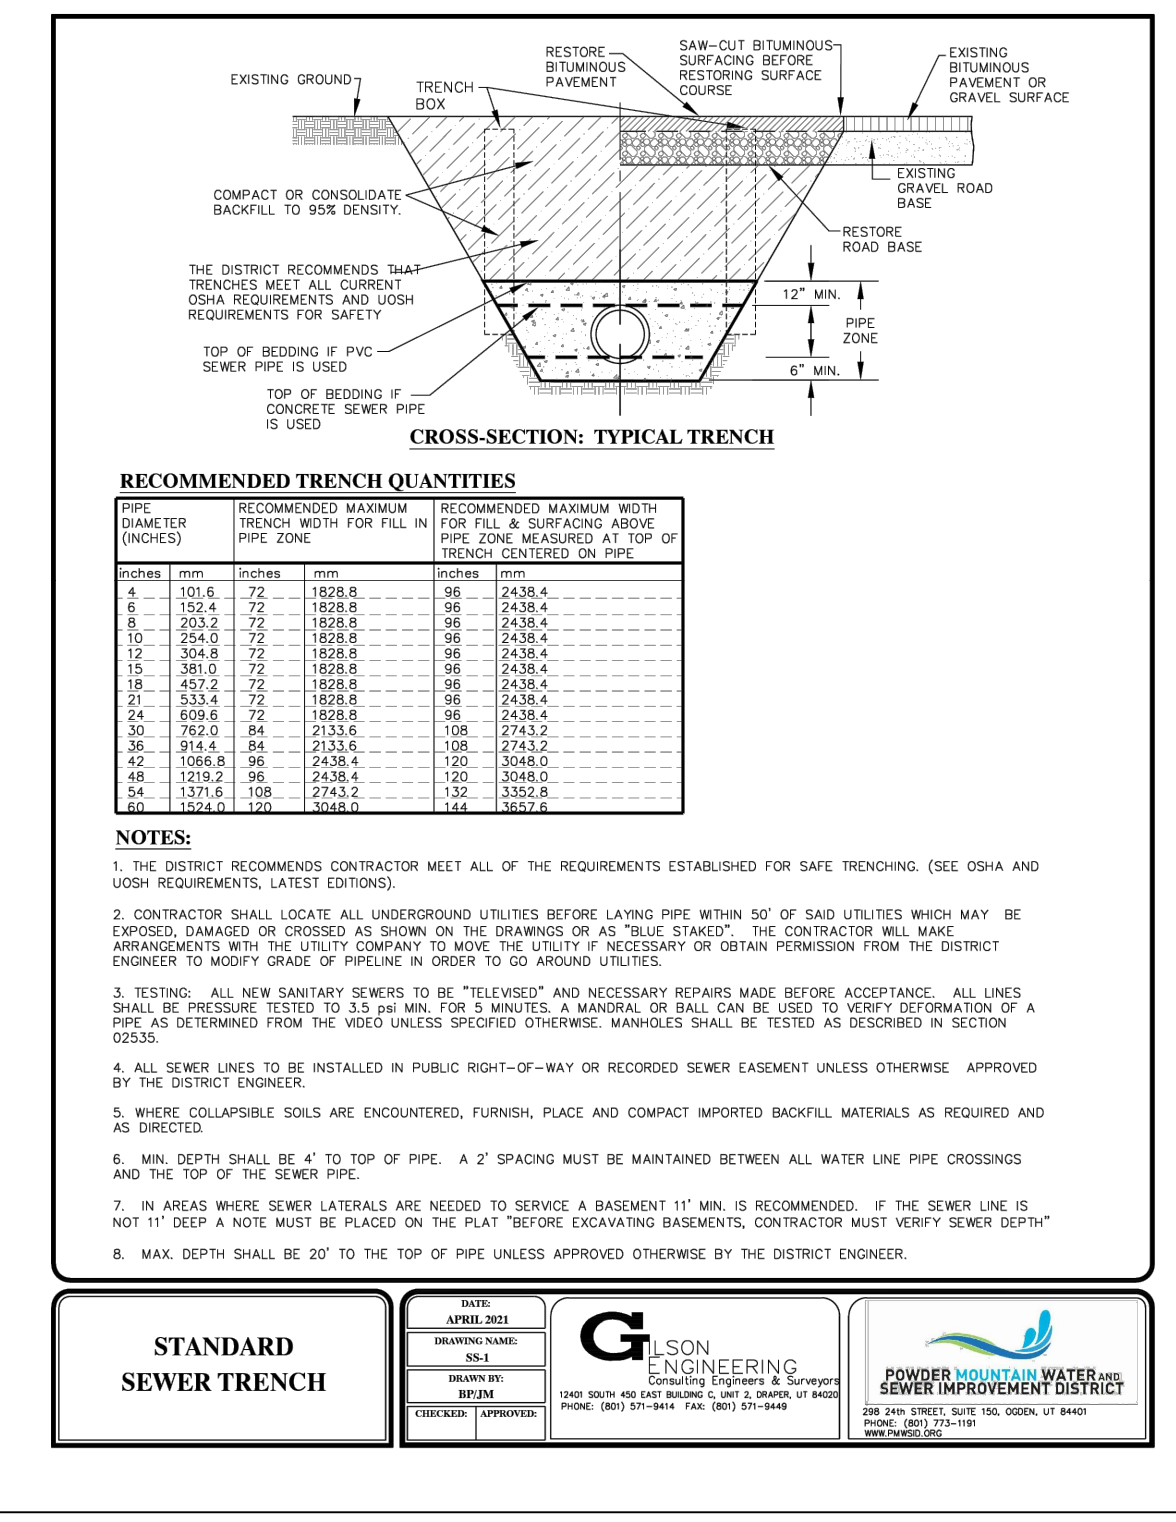


1 SEWER TRENCH - PMW&S

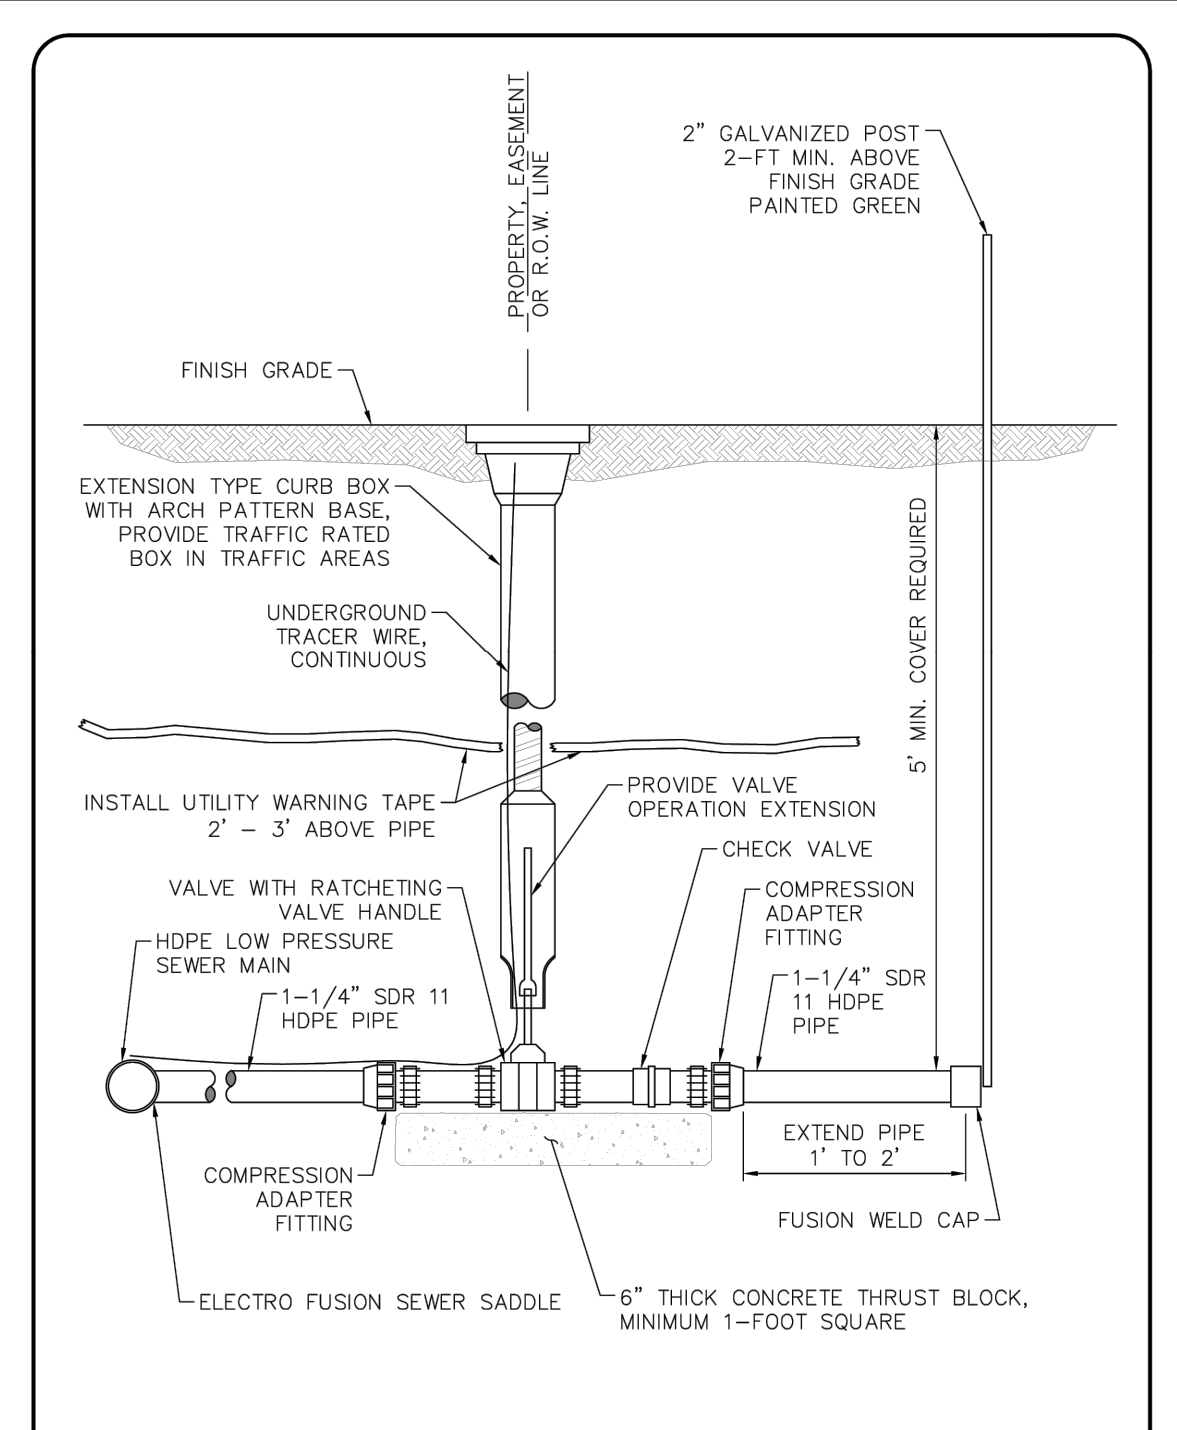


10 LOW PRESSURE PRIVATE LATERAL STUB

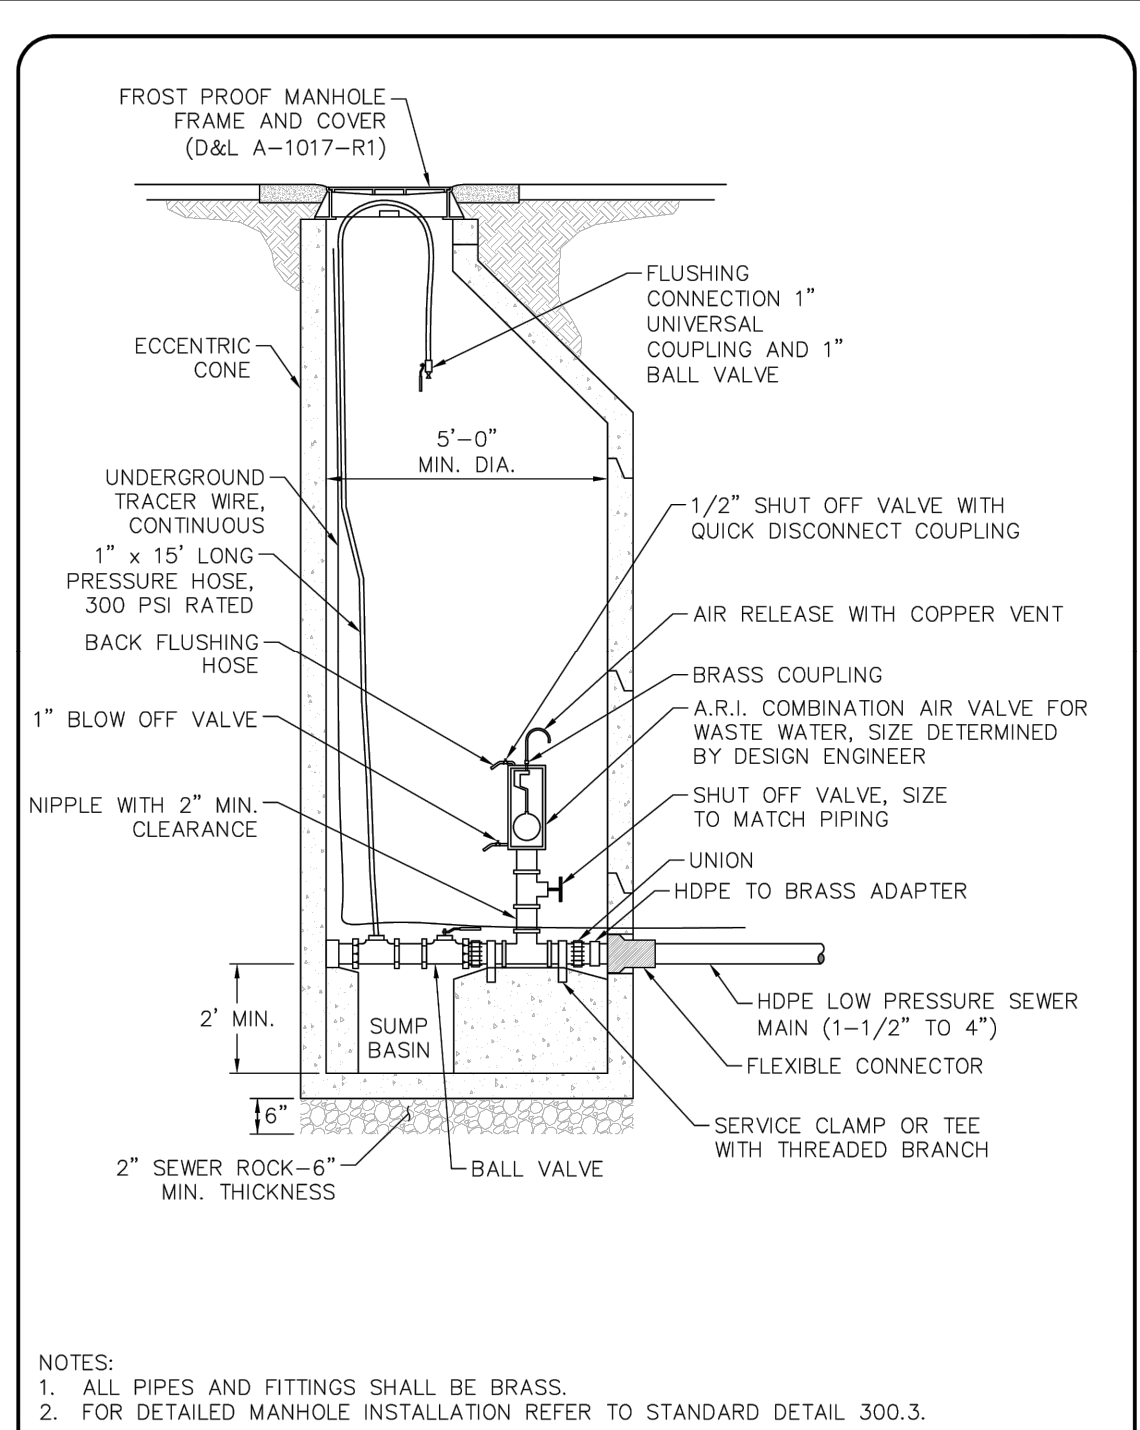


9 LOW PRESSURE DEAD END CAV/FLUSHING

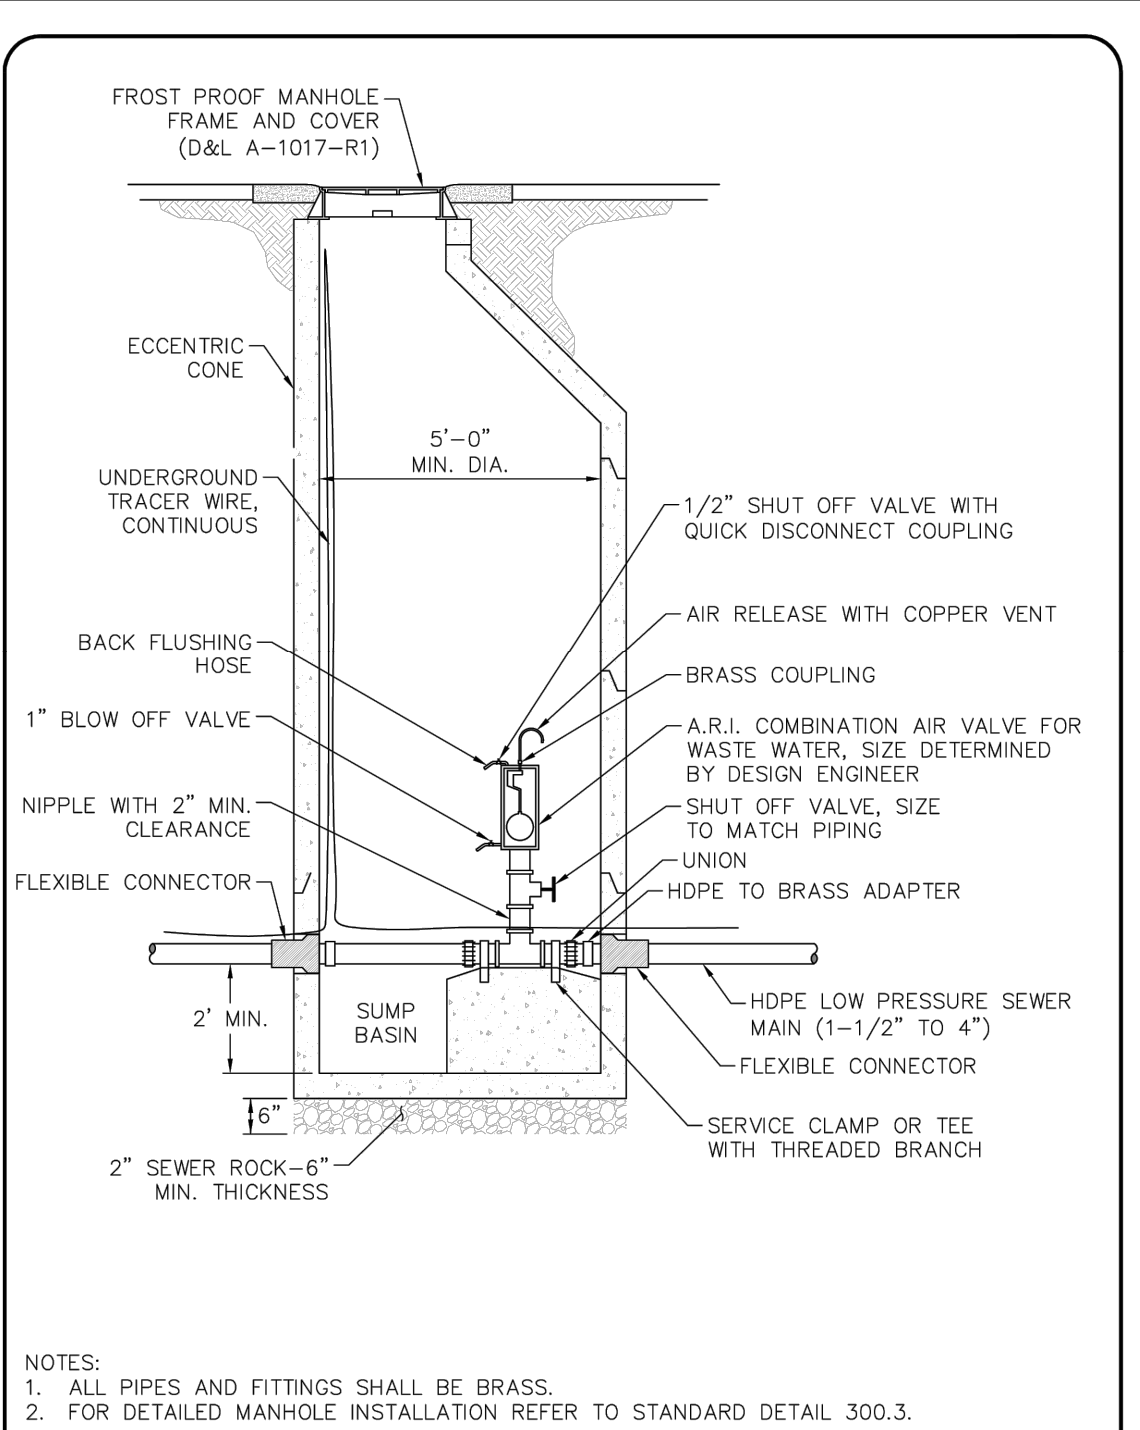

8 LOW PRESSURE COMBINATION AIR VALVE

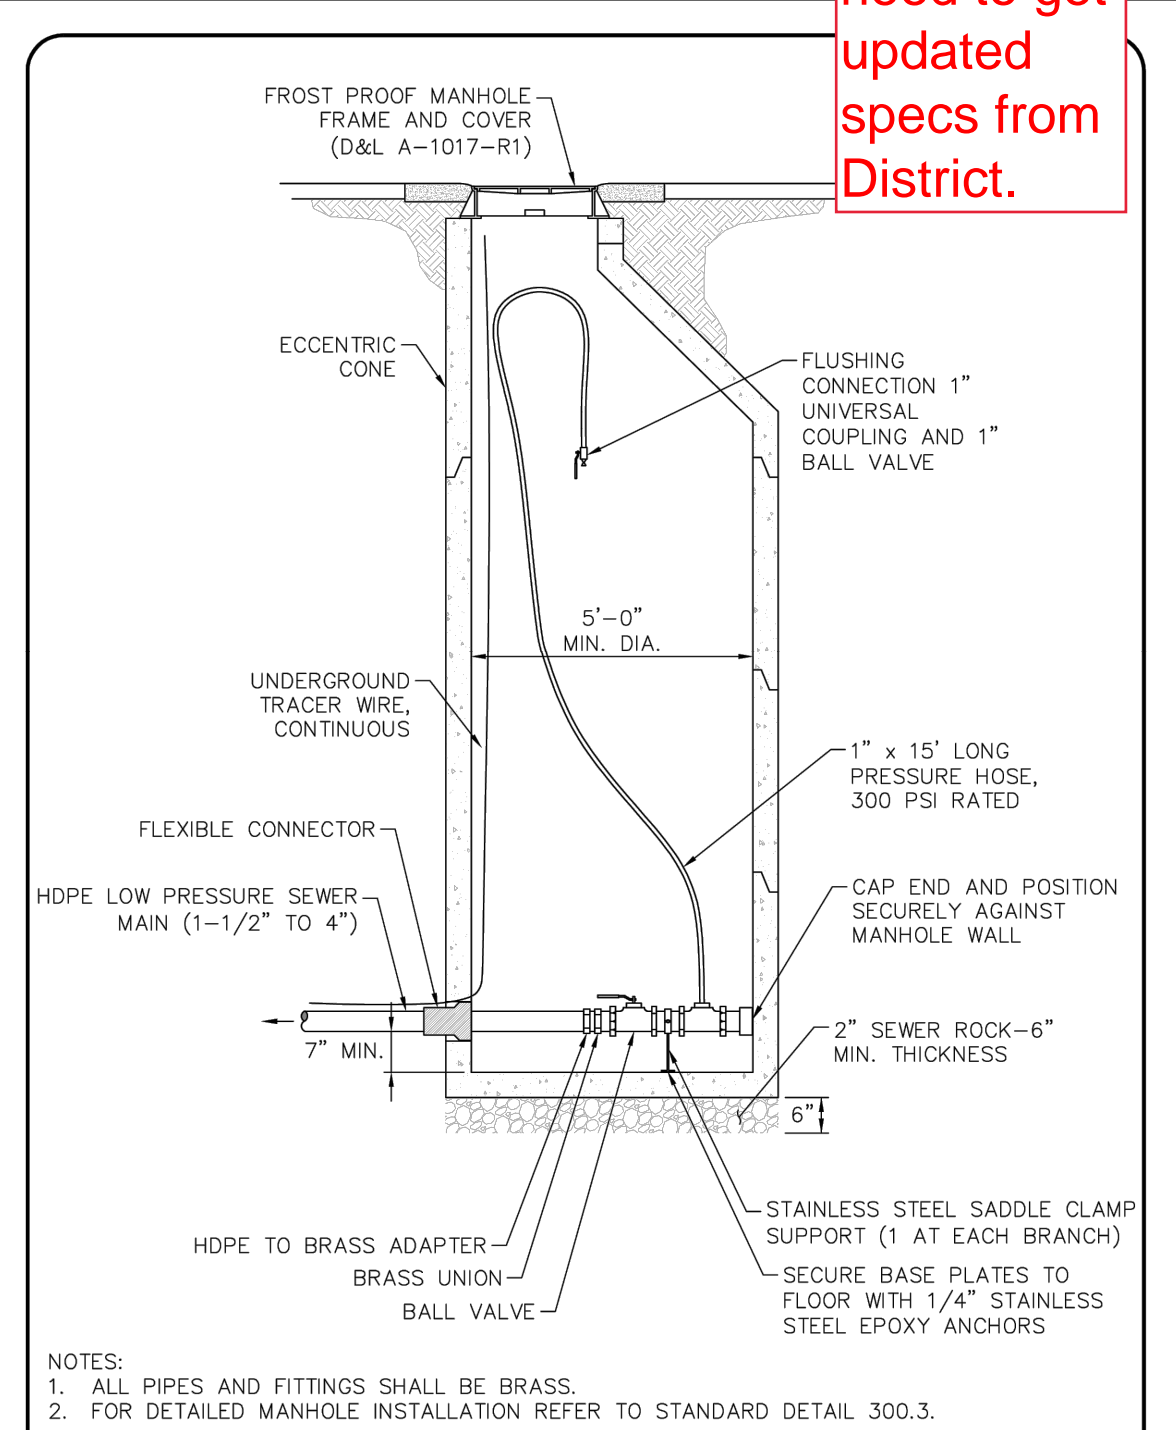

7 DEAD END LOW PRESSURE FLUSHING CONNECTION

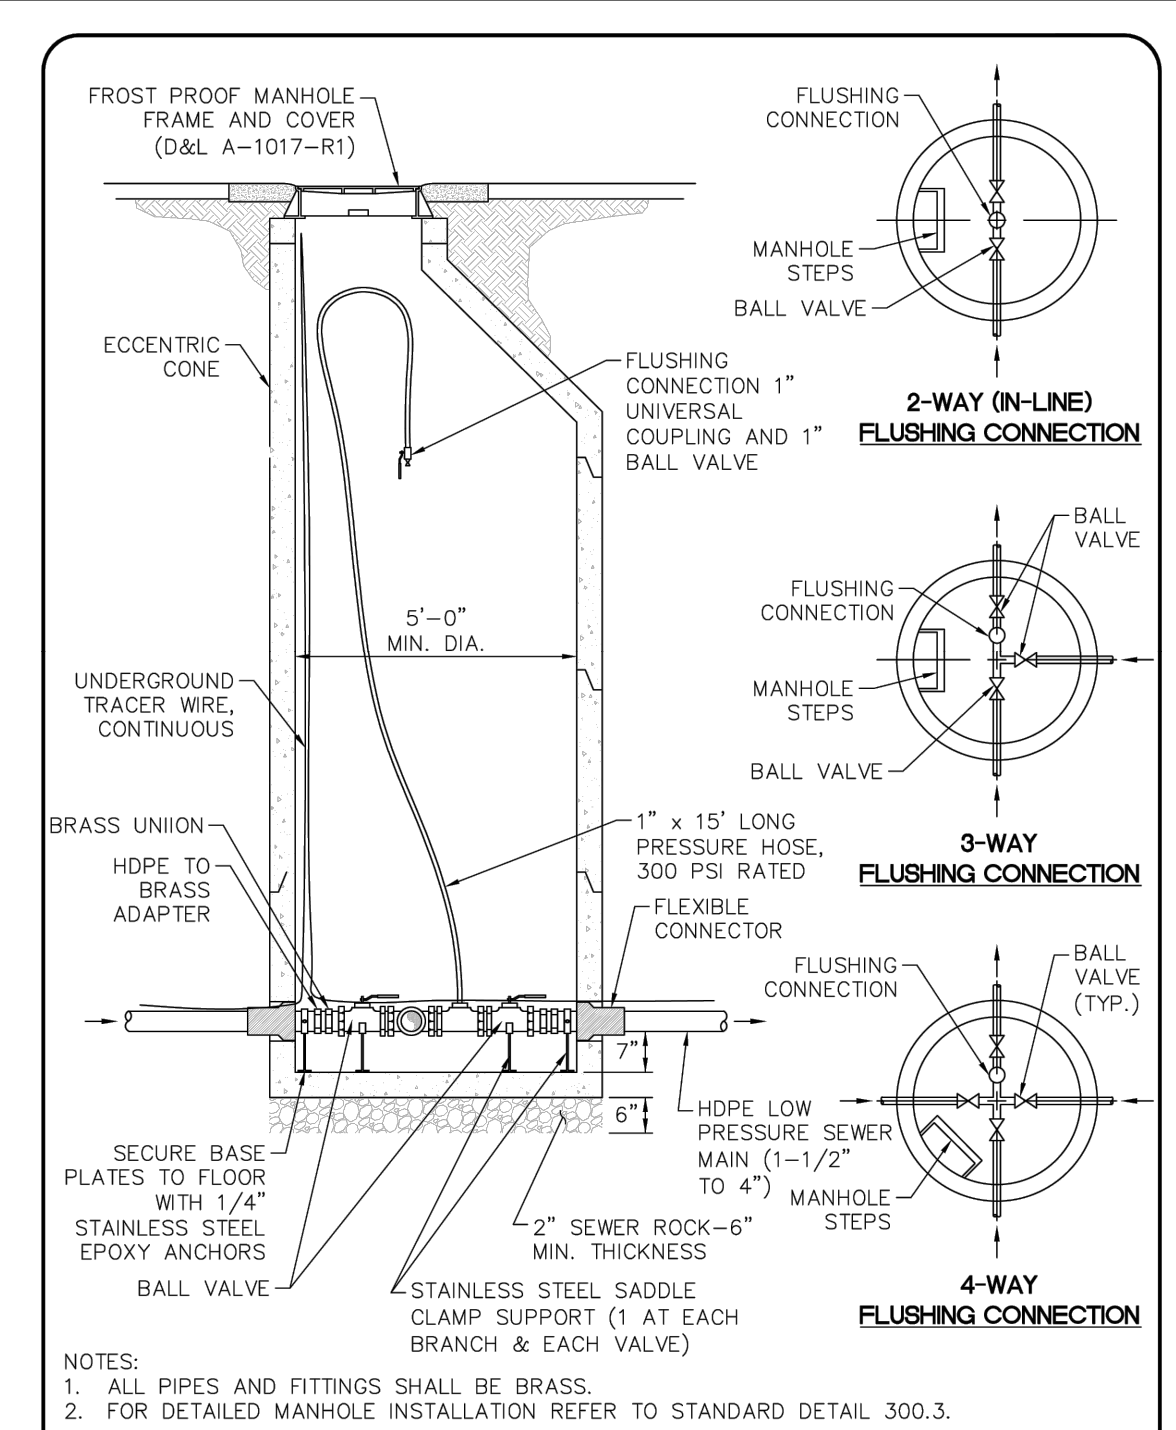

6 LOW PRESSURE FLUSHING CONNECTION

You may need to get updated specs from District.

BID SET

DATE:	5/26/2023
PROJECT NO.:	23001
REVISION	DATE
1	
2	
3	
4	
5	
6	

CROSS-SECTION TYPICAL TRENCH

SOIL TYPE	SAFE BEARING LOAD (PSF)
SAND	3000
SAND & GRAVEL (CEMENTED WITH CLAY)	5000

PIPE SIZE	150 PSI	180 PSI	200 PSI	250 PSI
4"	36	57	26.1	14.7
6"	85.8	95	30.4	25.3
8"	102.4	102	30.4	43.7
12"	103	294	117.2	56.4
14"	180.8	265	141.0	71.5
16"	237.8	328.3	162.8	82.7
18"	328	423	207	106.5

WATERLINE TRENCH DETAIL

UNIMPROVED TERRAIN TRENCH SECTION

IMPROVED TERRAIN TRENCH SECTION

CLASS A PIPE BEDDING

PIPE DIAMETER	MINIMUM WIDTH	MAXIMUM WIDTH
4"	1'-0"	2'-0"
6"	1'-0"	2'-0"
8"	1'-0"	2'-0"
12"	2'-0"	3'-0"
14"	2'-0"	3'-0"
16"	2'-0"	3'-0"

CLASS B PIPE BEDDING

PIPE BEDDING SPECIFICATIONS

SECTION VIEW

PLAN VIEW

FIRE HYDRANT CONNECTION

WATER LOOP

TYPICAL METER PIT DETAIL

1 WATERLINE TRENCH - PMW&S

2 PIPE BEDDING - PMW&S

3 FIRE HYDRANT - PMW&S

4 WATER LOOP - PMW&S

5 METER PIT - PMW&S

METER VAULT 2 INCH

BACKFLOW PREVENTER 3" LINES AND ABOVE 1 OF 2

BACKFLOW PREVENTER 3" LINES AND ABOVE 2 OF 2

SERVICE BACKFLOW PREVENTER 1" TO 2 1/2" LINES 1 OF 2

SERVICE BACKFLOW PREVENTER 1" TO 2 1/2" LINES 2 OF 2

6 2" WATER METER - PMW&S


7 BACKFLOW PREVENTER - PMW&S

8 BACKFLOW PREVENTER - PMW&S

9 BACKFLOW PREVENTER - PMW&S

10 BACKFLOW PREVENTER - PMW&S

DETAILS
MONUMENT AT POWDER MOUNTAIN
Approx. 8050 Summit Pass Road, Eden, Utah

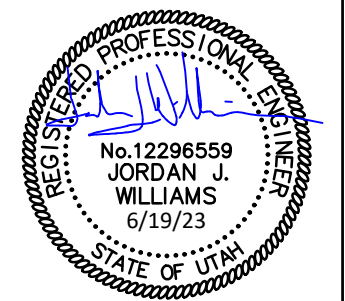

SCALE:

C8.01

DRAWN BY: CGW

13/14

8" PRESSURE REDUCING VALVE STATION
1 OF 2

NOTE:
ALL EXPOSED METAL PARTS SHALL BE GALVANIZED

8" PRESSURE REDUCING VALVE STATION
2 OF 2

PIPE SCHEDULE

#	QTY	DESCRIPTION
1	2	1/2" WELDED CONNECTION
2	2	1/2" WELDED CONNECTION
3	2	1/2" WELDED CONNECTION
DETAIL: DRAIN SUMP

DETAIL: ITEM 14

AIR VACUUM RELIEF VALVE

NOTE:
INSTALL AIR-VACUUM RELIEF VALVES WHERE REQUIRED AND AS SPECIFIED.

TYPICAL SMALL DIAMETER WATER SERVICE LINE DETAIL

NOTE:
1. PLACEMENT OF CURB STOP SHALL BE A MAXIMUM OF 5 FEET OUTSIDE THE PROPERTY LINE INSIDE STREET RIGHT OF WAY.
2. PROPERTY OWNER'S RESPONSIBILITY FOR LEAK REPAIR SHALL BE UP TO AND INCLUDING THE SERVICE PIPE WHICH THREADS ONTO THE WATER METER. PROPERTY OWNER'S RESPONSIBILITY FOR REPAIRS OTHER THAN LEAKS EXTENDS TO THE CORPORATION STOP.
3. DISTRICT'S RESPONSIBILITY SHALL BE THE WATER MAIN, THE CORPORATION STOP, CURB STOP, WATER METER, AND WHERE NEEDED, THE DOUBLE STRAP TAPPING SADDLE. THE DISTRICT WILL ONLY REPAIR LEAKS OCCURRING BETWEEN THE CORPORATION STOP AND THE WATER METER.
4. SEE STANDARD DETAIL WT-1 AND WT-2 FOR WATER TRENCH REQUIREMENTS.
5. NO LATERAL ARE TO BE INSTALLED WITHIN 5' OF BEDROCK.
6. 12" THICK CLAY CUTOFF AT EACH END OF WATER SERVICE INSULATION FROM IMPERVIOUS GEOTEXTILE TO BOTTOM OF TRENCH.
7. INSULATED SERVICE PIPE: SERVICE LINE ENCASED IN 8" SEAMLESS HDPE WITH CLOSED-CELL CROSS-LINKED POLYETHYLENE FOAM AND HEAT TAPE.
8. 6" MINIMUM COVER REQUIRED OVER PIPE. COVER REQUIREMENT MAY BE REDUCED PER RECOMMENDATION BY APPROVED GEOTECHNICAL REPORT. IN NO CASE SHALL MINIMUM COVER OVER PIPE BE LESS THAN 7'-0". GEOTECHNICAL REPORT SHALL SPECIFICALLY ADDRESS FROST DEPTH AND PIPE FREEZING POTENTIAL.

DETECTOR CHECK VALVE

NOTE:
1. INSPECTION: VALVE AND SERVICE LINE SHALL BE INSPECTED BY DISTRICT PRIOR TO BACKFILLING.
2. BACKFILL: INSTALL BACKFILL IN 6" LIFTS NOT EXCEEDING 8" AFTER COMPACTING EACH LIFT TO AN AVERAGE DRY DENSITY OF 95% WITH NO DENSITY TEST RESULTS LESS THAN 90%.
3. ALL EXPOSED METAL PARTS SHALL BE GALVANIZED.
4. FURNISH AND INSTALL CHROMIUM/ALUMINUM BLOW HEATER LHM-10-05-83-22-41-1 (OR EQUAL).
5. FURNISH AND INSTALL WALL MOUNT VAPOR PROOF LUMINAIRE W/ JUNCTION BOX GLOBE & GUARD AND INSTALL ELECTRICAL BOX W/ COVER PLATE.

① 8" PRESSURE REDUCING VALVE - PMW&S

② 8" PRESSURE REDUCING VALVE - PMW&S

③ AIR VACUUM RELIEF VALVE - PMW&S

④ WATER LATERAL - PMW&S

⑤ WATER LATERAL - PMW&S

EMERGENCY SPILLWAY-TOP VIEW

SECTION A-A

DETENTION POND OUTLET & SPILLWAY
NTS

RISER PIPE
NTS

Notes:
1. Drill four (4) 1/2" diameter holes, 3 inches from bottom of riser pipe and insert two (2) #4 bars in an "X" configuration. Length of bars = 24-16 inches.
2. Embed riser 12 inches into concrete base.

⑥ RISER PIPE DETENTION OUTFLOW

3X3 CONTROL BOX

Plan

Section

NOTE: Pipes shall be placed as shown on plans.

⑦ 3X3 CONTROL BOX

