



**BENCHMARK**  
 NORTHWEST CORNER OF SECTION 27  
 TOWNSHIP 7 NORTH, RANGE 2 WEST  
 SALT LAKE BASE AND MERIDIAN  
 ELEV = 4231.00'

# THE ORCHARDS AT JDC RANCH PHASE 1

2800 WEST 2600 NORTH STREET  
 WEBER COUNTY, UTAH

FOR REVIEW  
 NOT FOR CONSTRUCTION

DATE PRINTED  
 October 9, 2023

**EN SIGN**  
 THE STANDARD IN ENGINEERING

LAYTON  
 919 North 400 West  
 Layton, UT 84041  
 Phone: 801.547.1100

SANDY  
 Phone: 801.255.0529

TOOELE  
 Phone: 435.843.3590

CEDAR CITY  
 Phone: 435.865.1453

RICHFIELD  
 Phone: 435.896.2983

WWW.ENSIGNENG.COM

FOR:  
 NILSON HOMES  
 1740 COMBE RD, SUITE 2  
 SOUTH OGDEN, UT 84403

CONTACT:  
 STEVE ANDERSON  
 PHONE: 801.392.8100

INDEX OF DRAWINGS

1 OF 2	PHASE 1 PLAT	PP-0	PLAN AND PROFILE KEY MAP
2 OF 2	PHASE 1 PLAT	PP-1	2675 NORTH STREET PLAN AND PROFILE
C-001	GENERAL NOTES	PP-2	2675 NORTH STREET PLAN AND PROFILE
C-002	OVERALL DEVELOPMENT SITE PLAN	PP-3	ABERDEEN DRIVE PLAN AND PROFILE
C-100	SITE PLAN	PP-4	2825 WEST STREET PLAN AND PROFILE
C-200	OVERALL GRADING AND DRAINAGE PLAN	PP-5	2830 WEST STREET, 2810 WEST STREET
C-201	GRADING AND DRAINAGE PLAN	AND	2780 WEST STREET PLAN AND PROFILE
C-202	GRADING AND DRAINAGE PLAN	PP-6	2720 NORTH STREET PLAN AND PROFILE
C-203	GRADING AND DRAINAGE PLAN	PP-7	2710 NORTH STREET PLAN AND PROFILE
C-204	GRADING AND DRAINAGE PLAN	PP-8	2705 NORTH STREET PLAN AND PROFILE
C-300	UTILITY PLAN	C-500	DETAILS
C-400	EROSION CONTROL PLAN	C-501	DETAILS

NOTICE TO CONTRACTOR

ALL CONTRACTORS AND SUBCONTRACTORS PERFORMING WORK SHOWN ON OR RELATED TO THESE PLANS SHALL CONDUCT THEIR OPERATIONS SO THAT ALL EMPLOYEES ARE PROVIDED A SAFE PLACE TO WORK AND THE PUBLIC IS PROTECTED. ALL CONTRACTORS AND SUBCONTRACTORS SHALL COMPLY WITH THE OCCUPATIONAL SAFETY AND HEALTH REGULATIONS OF THE U.S. DEPARTMENT OF LABOR AND THE STATE OF UTAH DEPARTMENT OF INDUSTRIAL RELATIONS CONSTRUCTION SAFETY ORDERS. THE CIVIL ENGINEER SHALL NOT BE RESPONSIBLE IN ANY WAY FOR THE CONTRACTORS AND SUBCONTRACTORS COMPLIANCE WITH SAID REGULATIONS AND ORDERS.



CONTRACTOR FURTHER AGREES TO ASSUME SOLE AND COMPLETE RESPONSIBILITY FOR JOB-SITE CONDITIONS DURING THE COURSE OF CONSTRUCTION OF THIS PROJECT, INCLUDING SAFETY OF ALL PERSONS AND PROPERTY. THAT THIS REQUIREMENT SHALL APPLY CONTINUOUSLY AND NOT BE LIMITED TO NORMAL WORKING HOURS, AND THAT THE CONTRACTOR SHALL DEFEND, INDEMNIFY AND HOLD THE OWNER AND THE CIVIL ENGINEER HARMLESS FROM ANY AND ALL LIABILITY, REAL OR ALLEGED IN CONNECTION WITH THE PERFORMANCE OF WORK ON THIS PROJECT, EXCEPTING FOR LIABILITY ARISING FROM THE SOLE NEGLIGENCE OF THE OWNER OR ENGINEER.

NOTICE TO DEVELOPER/ CONTRACTOR

UNAPPROVED DRAWINGS REPRESENT WORK IN PROGRESS, ARE SUBJECT TO CHANGE, AND DO NOT CONSTITUTE A FINISHED ENGINEERING PRODUCT. ANY WORK UNDERTAKEN BY DEVELOPER OR CONTRACTOR BEFORE PLANS ARE APPROVED IS UNDERTAKEN AT THE SOLE RISK OF THE DEVELOPER, INCLUDING BUT NOT LIMITED TO BIDS, ESTIMATION, FINANCING, BONDING, SITE CLEARING, GRADING, INFRASTRUCTURE CONSTRUCTION, ETC.

UTILITY DISCLAIMER

THE CONTRACTOR IS SPECIFICALLY CAUTIONED THAT THE LOCATION AND / OR ELEVATIONS OF EXISTING UTILITIES AS SHOWN ON THESE PLANS IS BASED ON RECORDS OF THE VARIOUS UTILITY COMPANIES AND WHERE POSSIBLE, MEASUREMENTS TAKEN IN THE FIELD. THE INFORMATION IS NOT TO BE RELIED ON AS BEING EXACT OR COMPLETE. THE CONTRACTOR MUST CALL THE LOCAL UTILITY LOCATION CENTER AT LEAST 48 HOURS BEFORE ANY EXCAVATION TO REQUEST EXACT FIELD LOCATIONS OF UTILITIES. IT SHALL BE THE RESPONSIBILITY OF THE CONTRACTOR TO RELOCATE ALL EXISTING UTILITIES WHICH CONFLICT WITH THE PROPOSED IMPROVEMENTS SHOWN ON THE PLANS.

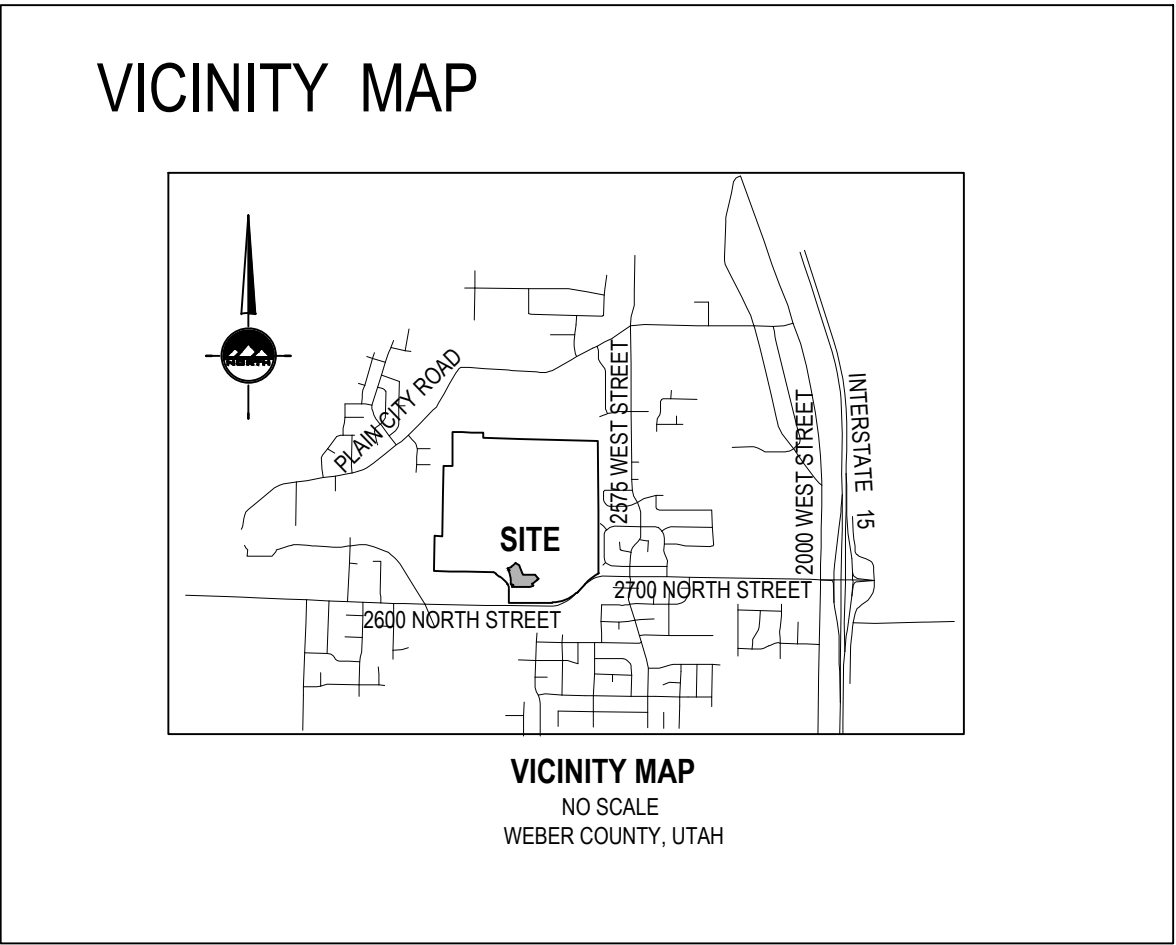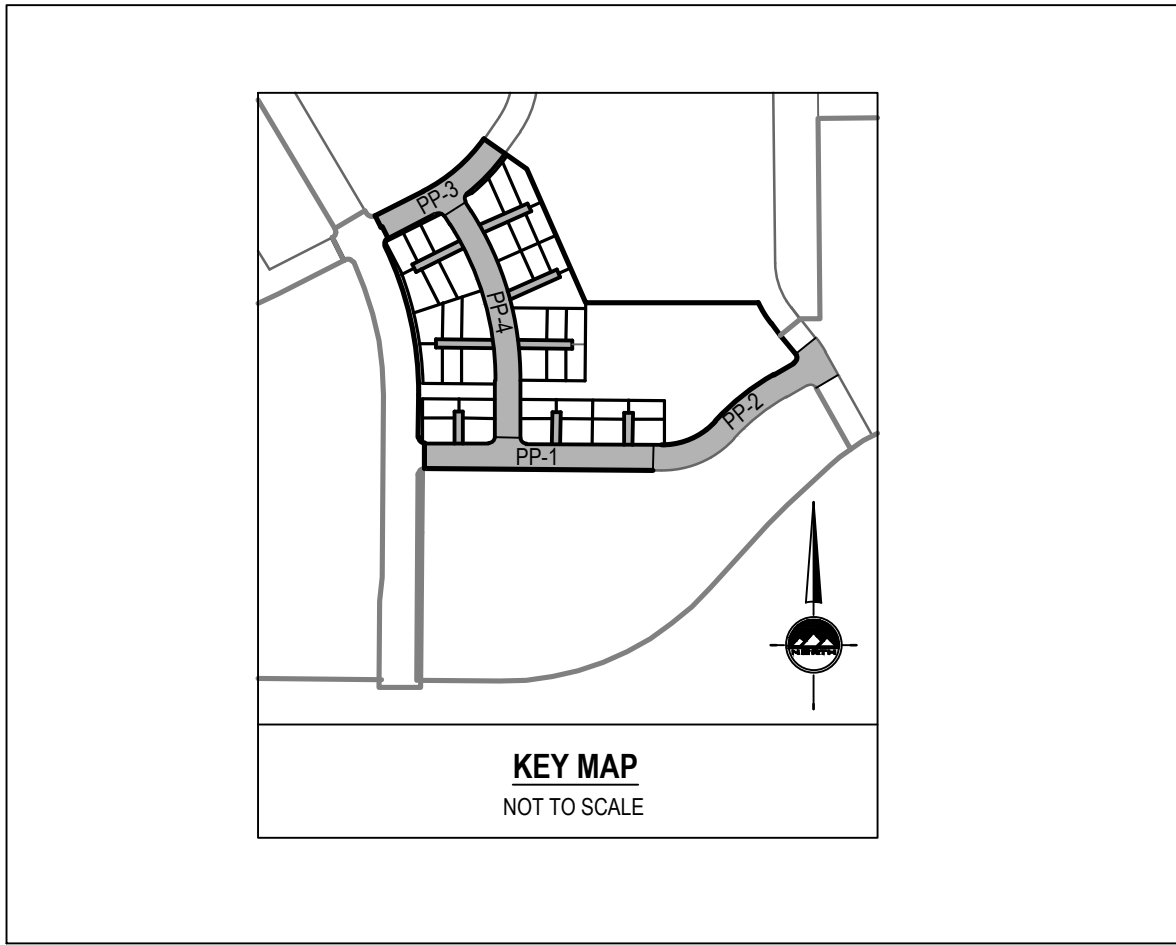

**GENERAL NOTES**

- ALL WORK SHALL CONFORM TO WEBER COUNTY STANDARDS & SPECIFICATIONS.
- CALL BLUE STAKES AT LEAST 48 HOURS PRIOR TO THE COMMENCEMENT OF ANY CONSTRUCTION ACTIVITIES.

THE ORCHARDS AT JDC RANCH  
 PHASE 1  
 2800 WEST 2600 NORTH STREET  
 WEBER COUNTY, UTAH



NO. DATE REVISION FOR REVIEW

COVER

PROJECT NUMBER 9872 PRINT DATE 2023-10-09  
 PROJECT MANAGER CP DESIGNED BY TS



# THE ORCHARDS AT JDC RANCH PHASE 1

LOCATED IN PART OF SECTION 27 AND PART OF THE NORTHEAST HALF OF SECTION 34  
 SECTION 34  
 TOWNSHIP 7 NORTH, RANGE 2 WEST  
 SALT LAKE BASE AND MERIDIAN  
 WEBER COUNTY, UTAH



### LEGEND

- SECTION CORNER
- PROPOSED STREET MONUMENT
- SET 5/8" X 24" REBAR WITH YELLOW PLASTIC CAP, OR NAIL STAMPED "ENSGN ENG. & LAND SURV."
- PROPERTY LINE
- ROAD CENTERLINE
- SECTION LINE
- EASEMENT
- LAND DRAIN EASEMENT

These will be dedicated to the HOA.

These SD Easements need to be at least 10' Can you go just to the prop line?

Add a Temp Turnaround

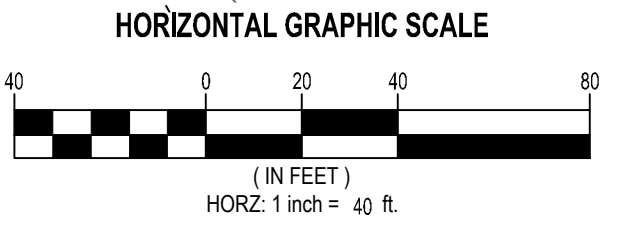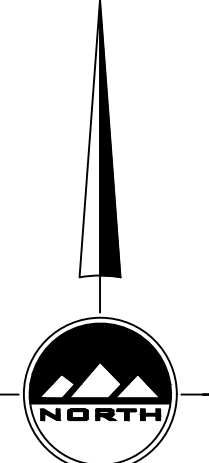

## THE ORCHARDS AT JDC PHASE 1

LOCATED IN PART OF SECTION 27 AND PART OF THE NORTHEAST HALF OF SECTION 34  
 TOWNSHIP 7 NORTH, RANGE 2 WEST  
 SALT LAKE BASE AND MERIDIAN  
 WEBER COUNTY, UTAH

### WEBER COUNTY RECORDER

ENTRY NO. \_\_\_\_\_ FEE \_\_\_\_\_  
 PAID \_\_\_\_\_ FILED FOR RECORD AND  
 RECORDED THIS \_\_\_\_\_ DAY OF \_\_\_\_\_ 20\_\_\_\_  
 AT \_\_\_\_\_ IN BOOK \_\_\_\_\_ OF OFFICIAL RECORDS  
 PAGE \_\_\_\_\_

### SHEET 2 OF 2

PROJECT NUMBER: 9630  
 MANAGER: C.PRESTON  
 DRAWN BY: J.MOSS  
 CHECKED BY: T.WILLIAMS  
 DATE: 10/9/2023


WEBER COUNTY RECORDER

DEPUTY RECORDER

LAYTON  
 919 North 400 West  
 Layton UT 84041  
 Phone: 801.547.1100  
 Fax: 801.593.6315  
 WWW.ENSGNENG.COM

SALT LAKE CITY  
 Phone: 801.255.0529  
 TOOELE  
 Phone: 435.843.3590  
 CEDAR CITY  
 Phone: 435.866.1653  
 RICHFIELD  
 Phone: 435.866.2983

DEVELOPER  
**NILSON HOMES**  
 1740 COMBE RD, SUITE 2  
 SOUTH OGDEN, UTAH 84403  
 801-392-8100

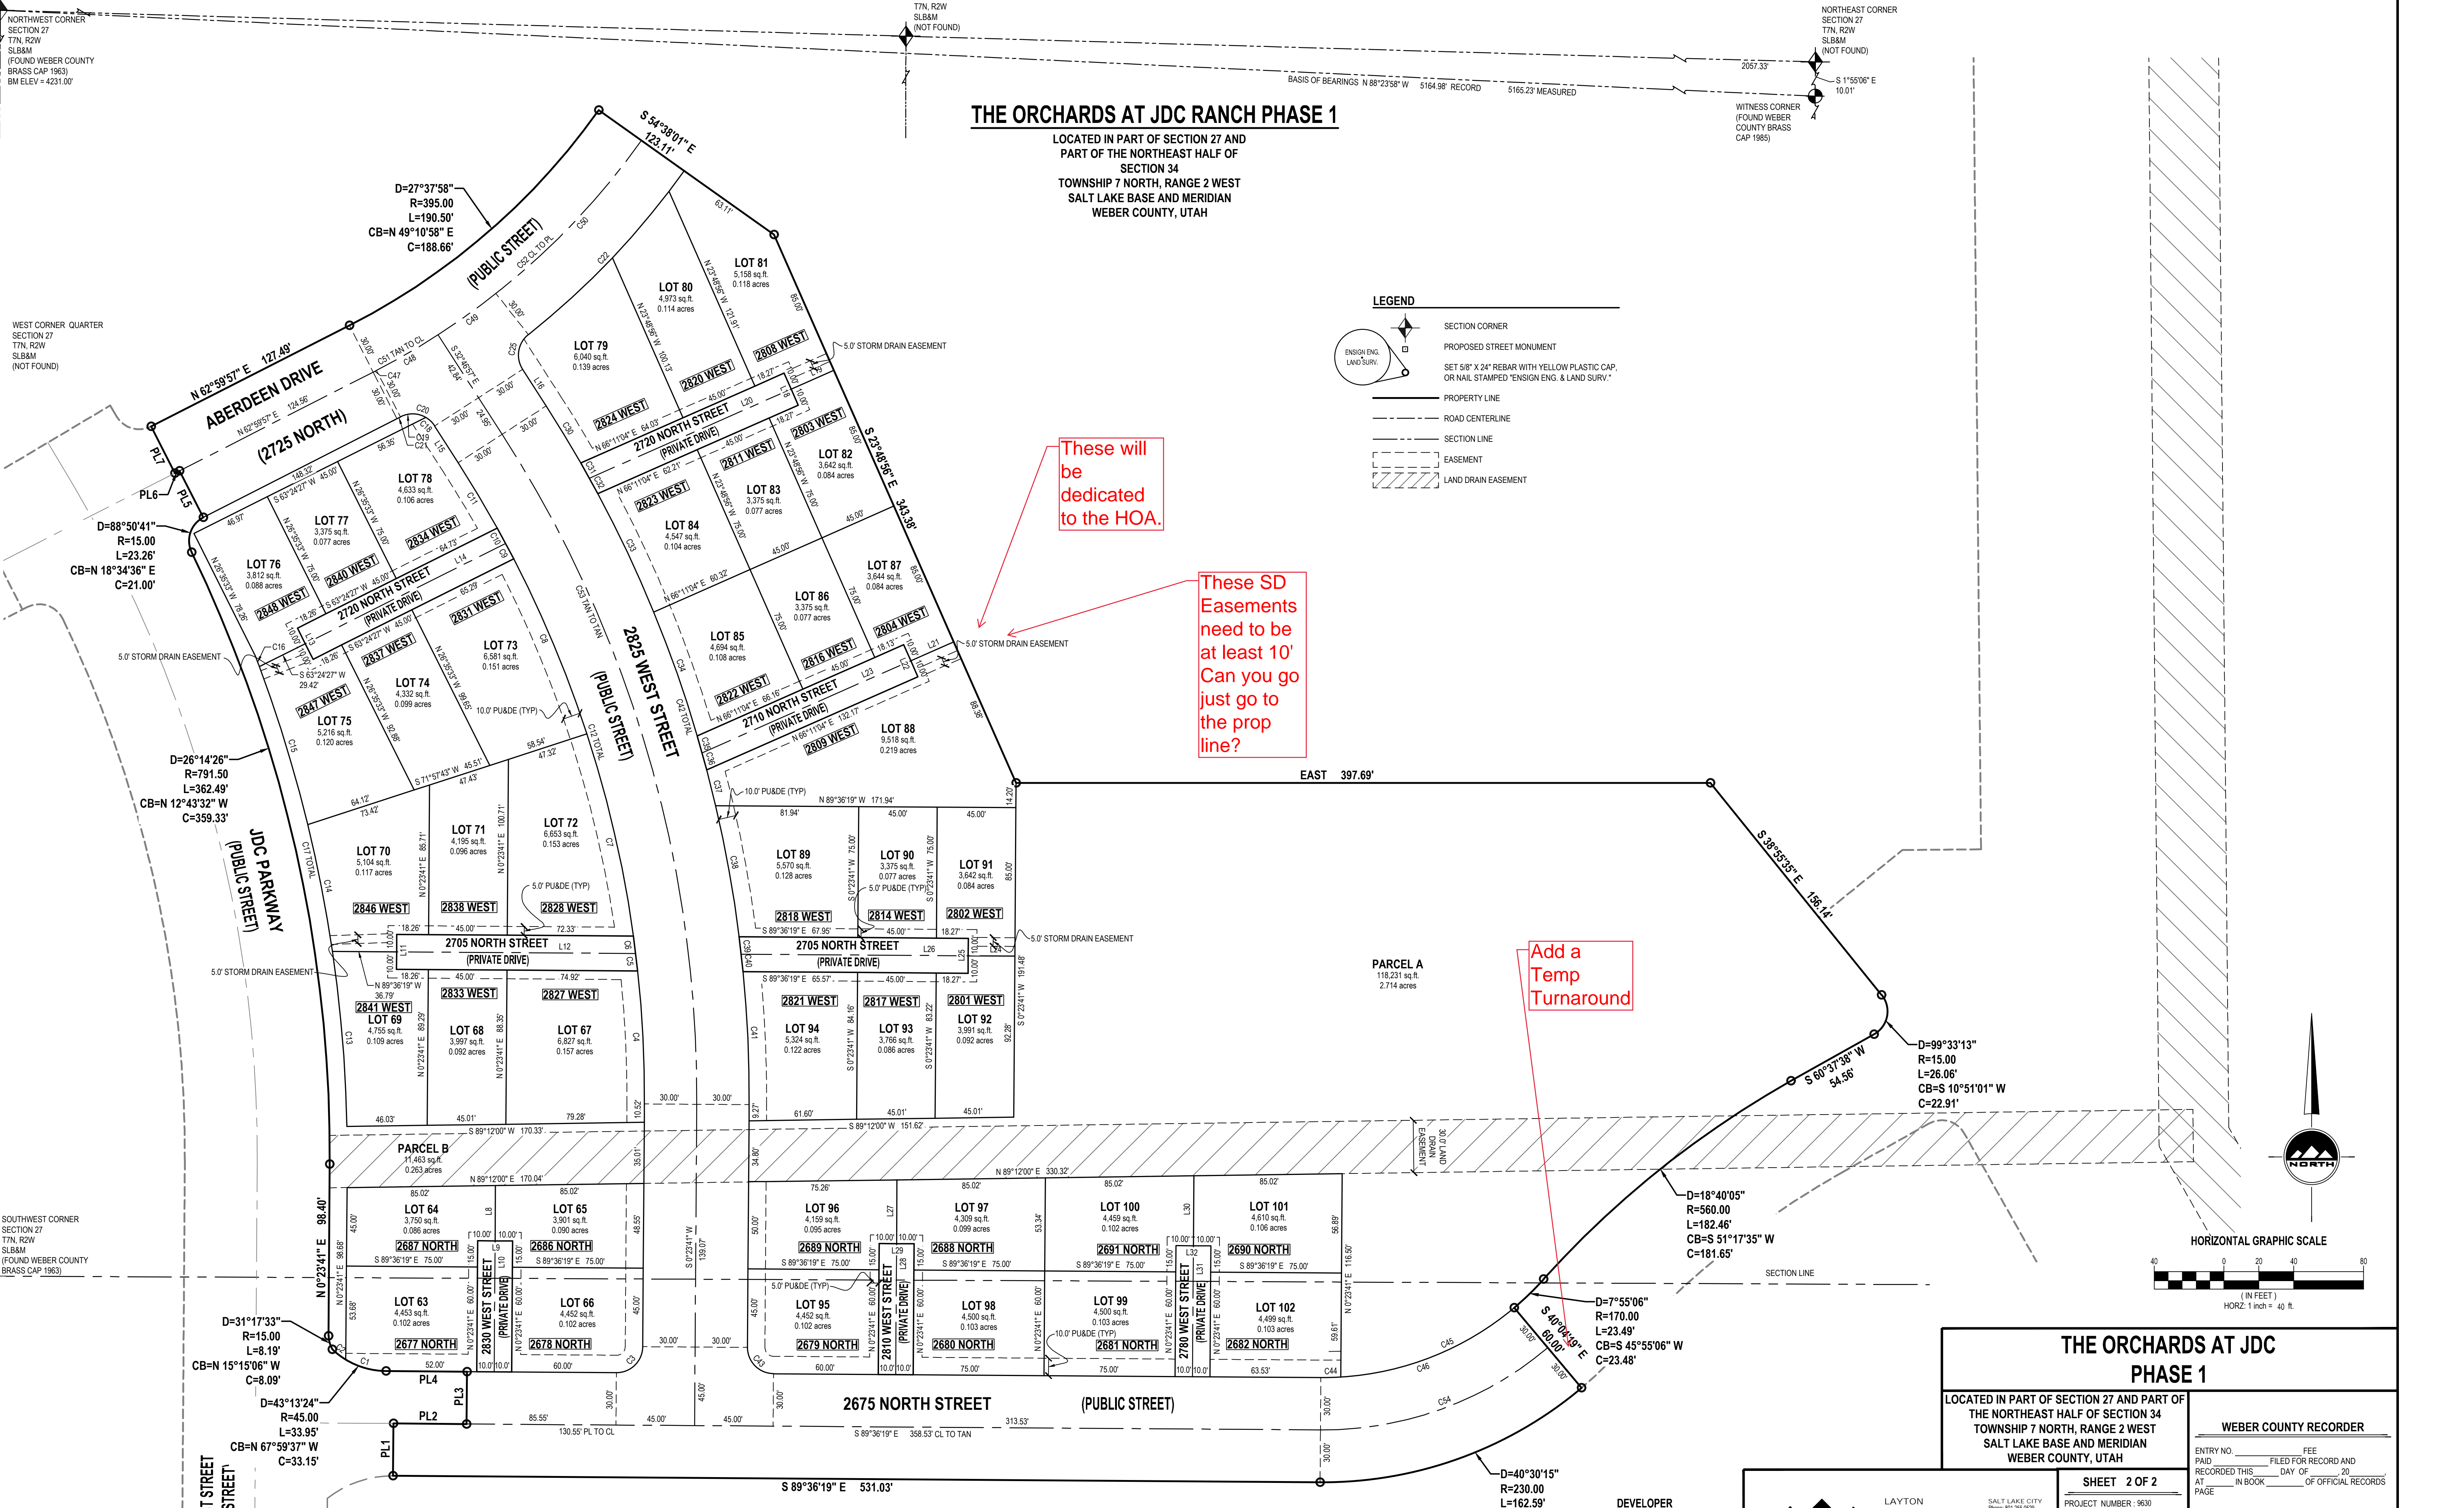

NORTHWEST CORNER SECTION 27 T7N, R2W SLB&M (FOUND WEBER COUNTY BRASS CAP 1963) BM ELEV = 4231.00'

WEST QUARTER CORNER SECTION 27 T7N, R2W SLB&M (NOT FOUND)

NORTH QUARTER CORNER SECTION 27 T7N, R2W SLB&M (NOT FOUND)

NORTHEAST CORNER SECTION 27 T7N, R2W SLB&M (NOT FOUND)  
 WITNESS CORNER (FOUND WEBER COUNTY BRASS CAP 1965)

SOUTHWEST CORNER SECTION 27 T7N, R2W SLB&M (FOUND WEBER COUNTY BRASS CAP 1963)

BASIS OF BEARINGS N 88°23'58" W 5164.98' RECORD 5165.23' MEASURED

N 0°29'00" E 2614.44'

D=31°17'33" R=15.00 L=8.19' CB=N 15°15'06" W C=8.09'

D=43°13'24" R=45.00 L=33.95' CB=N 67°59'37" W C=33.15'

D=26°14'26" R=791.50 L=362.49' CB=N 12°43'32" W C=359.33'

D=88°50'41" R=15.00 L=23.26' CB=N 18°34'36" E C=21.00'

D=27°37'58" R=395.00 L=190.50' CB=N 49°10'58" E C=188.66'

D=88°50'41" R=15.00 L=23.26' CB=N 18°34'36" E C=21.00'

D=40°30'15" R=230.00 L=162.59' CB=S 70°08'34" W C=159.23'

D=7°55'06" R=170.00 L=23.49' CB=S 45°55'06" W C=23.48'

D=18°40'05" R=560.00 L=182.46' CB=S 51°17'35" W C=181.65'

D=99°33'13" R=15.00 L=26.06' CB=S 10°51'01" W C=22.91'











# THE ORCHARDS AT JDC RANCH PHASE 1

LOCATED IN PART OF SECTION 27 AND PART OF THE NORTHEAST HALF OF SECTION 34  
TOWNSHIP 7 NORTH, RANGE 2 WEST  
SALT LAKE BASE AND MERIDIAN  
WEBER COUNTY, UTAH  
SEPTEMBER 2023

### GENERAL NOTES:

- PROPERTY IS WITHIN RESIDENTIAL OVERLAY ZONE.
  - FRONT YARD SETBACK IS 10' FROM PUBLIC RIGHT OF WAY (5' FROM PRIVATE DRIVEWAY)
  - REAR YARD SETBACK IS 10'
  - SIDE YARD SETBACK IS 5' TOTAL (MINIMUM 10' BETWEEN STRUCTURES)
- ALL PUBLIC UTILITY AND DRAINAGE EASEMENTS (PU&DE) ARE 10' FRONT FROM PUBLIC RIGHT OF WAY, 5' FROM PRIVATE DRIVEWAY.
- PARCEL A IS TO BE DEDICATED TO THE COUNTY. PARCEL B IS TO BE OWNED AND MAINTAINED BY THE ORCHARDS PHASE 1 HOME OWNERS ASSOCIATION.
- UTILITIES SHALL HAVE THE RIGHT TO INSTALL, MAINTAIN, AND OPERATE THEIR EQUIPMENT ABOVE AND BELOW GROUND AND ALL OTHER RELATED FACILITIES WITHIN THE PUBLIC UTILITY EASEMENTS IDENTIFIED ON THIS PLAT MAP AS MAY BE NECESSARY OR DESIRABLE IN PROVIDING UTILITY SERVICES WITHIN AND WITHOUT THE LOTS IDENTIFIED HEREIN, INCLUDING THE RIGHT OF ACCESS TO SUCH FACILITIES AND THE RIGHT TO REQUIRE REMOVAL OF ANY OBSTRUCTIONS INCLUDING STRUCTURES, TREES AND VEGETATION THAT MAY BE PLACED WITHIN THE P.U.E. THE UTILITY MAY REQUIRE THE LOT OWNER TO REMOVE ALL STRUCTURES WITHIN THE P.U.E. AT THE LOT OWNER'S EXPENSE. OR THE UTILITY MAY REMOVE SUCH STRUCTURES AT THE LOT OWNER'S EXPENSE. AT NO TIME MAY ANY PERMANENT STRUCTURES BE PLACED WITHIN THE P.U.E. OR ANY OTHER OBSTRUCTION WHICH INTERFERES WITH THE USE OF THE P.U.E. WITHOUT THE PRIOR WRITTEN APPROVAL OF THE UTILITIES WITH FACILITIES IN THE P.U.E.
- 5/8" x 24" REBAR AND CAP WILL BE PLACED AT ALL REAR LOT CORNERS AND FRONT CORNERS WILL BE MARKED WITH A NAIL OR RIVET AT THE EXTENSION IN THE CURB.
- PROTECT ALL EXISTING SECTION CORNERS AND STREET MONUMENTS. COORDINATE ALL SURVEY STREET MONUMENT INSTALLATION, GRADE ADJUSTMENT, AND ALL REQUIRED FEES AND PERMITS WITH THE COUNTY SURVEYOR PRIOR TO DISRUPTION OF ANY EXISTING MONUMENTS.

CURVE TABLE					
CURVE	RADIUS	LENGTH	DELTA	BEARING	CHORD
C1	45.00'	24.14'	30°44'16"	S74°14'11"E	23.85'
C2	45.00'	9.81'	12°29'07"	S52°37'29"E	9.79'
C3	15.00'	23.56'	90°00'00"	N45°23'41"E	21.21'
C4	670.00'	76.34'	6°31'42"	N2°52'10"W	76.30'
C5	670.00'	10.07'	0°51'41"	S6°33'51"E	10.07'
C6	670.00'	10.09'	0°51'48"	S7°25'36"E	10.09'
C7	670.00'	119.04'	10°10'47"	N12°56'53"W	118.88'
C8	670.00'	108.73'	9°17'54"	N22°41'14"W	108.61'
C9	670.00'	10.00'	0°51'19"	S27°45'51"E	10.00'
C10	670.00'	10.01'	0°51'21"	S28°37'11"E	10.01'
C11	670.00'	43.68'	3°44'06"	N30°54'54"W	43.67'
C12	670.00'	387.97'	33°10'38"	N16°11'38"W	382.57'
C13	801.50'	100.72'	7°11'59"	N4°44'58"W	100.65'
C14	801.50'	73.96'	5°17'19"	N10°59'37"W	73.96'
C15	801.50'	94.72'	6°46'15"	N17°01'25"W	94.66'
C16	801.50'	6.78'	0°28'04"	N20°39'04"W	6.78'
C17	801.50'	276.19'	19°44'38"	N11°01'18"W	274.83'
C18	15.00'	7.14'	27°15'38"	N46°24'46"W	7.07'
C19	15.00'	14.99'	57°14'43"	N88°39'57"W	14.37'
C20	15.00'	22.12'	84°30'21"	N75°02'08"W	20.17'
C21	455.00'	2.28'	0°17'15"	N62°51'19"E	2.28'
C22	455.00'	129.89'	16°21'25"	N43°32'41"E	129.45'
C25	15.00'	22.12'	84°30'21"	S9°28'13"W	20.17'
C30	730.00'	38.19'	2°59'50"	N31°17'02"W	38.18'
C31	730.00'	10.05'	0°47'19"	S29°23'28"E	10.05'
C32	730.00'	10.04'	0°47'15"	S28°36'11"E	10.04'
C33	730.00'	75.06'	5°53'28"	N25°15'49"W	75.02'
C34	730.00'	75.26'	5°54'25"	N19°21'53"W	75.23'
C35	730.00'	10.09'	0°47'32"	S16°00'54"E	10.09'
C36	730.00'	10.11'	0°47'38"	S15°13'19"E	10.11'
C37	730.00'	21.13'	1°39'31"	N13°59'45"W	21.13'
C38	730.00'	76.33'	5°59'27"	N10°10'16"W	76.29'
C39	730.00'	10.08'	0°47'28"	S6°46'49"E	10.08'
C40	730.00'	10.06'	0°47'23"	S5°59'23"E	10.06'
C41	730.00'	76.31'	5°59'23"	N2°36'00"W	76.28'
C42	730.00'	422.71'	33°10'38"	N16°11'38"W	416.83'
C43	15.00'	23.56'	90°00'00"	S44°36'19"E	21.21'
C44	170.00'	11.48'	3°52'13"	N88°27'34"E	11.48'
C45	170.00'	132.23'	44°33'55"	N64°14'30"E	128.92'
C46	170.00'	120.22'	40°31'02"	N70°08'10"E	117.73'

CURVE TABLE					
CURVE	RADIUS	LENGTH	DELTA	BEARING	CHORD
C47	425.00'	2.13'	0°17'15"	N62°51'19"E	2.13'
C48	425.00'	40.75'	5°29'39"	N59°57'52"E	40.74'
C49	425.00'	40.75'	5°29'39"	N54°28'13"E	40.74'
C50	425.00'	121.33'	16°21'25"	N43°32'41"E	120.92'
C51	425.00'	42.89'	5°46'54"	N60°06'30"E	42.87'
C52	425.00'	162.08'	21°51'04"	N46°17'31"E	161.10'
C53	700.00'	405.34'	33°10'38"	N16°11'38"W	399.70'
C54	200.00'	141.39'	40°30'15"	N70°08'34"E	138.46'

PARCEL LINE TABLE		
LINE	BEARING	LENGTH
PL1	N0°23'41"E	30.00'
PL2	S89°36'19"E	41.95'
PL3	N0°23'41"E	30.00'
PL4	N89°36'19"W	46.45'
PL5	N27°00'03"W	30.00'
PL6	S62°59'57"W	2.93'
PL7	N27°00'03"W	30.00'

LINE TABLE		
LINE	BEARING	LENGTH
L8	N0°23'41"E	31.77'
L9	S89°36'19"E	20.00'
L10	N0°23'41"E	75.00'
L11	N0°23'41"E	20.00'
L12	S89°36'19"E	136.96'
L13	N26°35'33"W	20.00'
L14	S63°24'27"W	128.34'
L15	S32°46'57"E	24.95'
L16	S32°46'57"E	24.95'
L18	N23°48'56"W	20.00'
L19	N66°11'04"E	26.73'
L20	N66°11'04"E	126.32'
L21	N66°11'04"E	26.87'
L22	N23°48'56"W	20.00'
L23	N66°11'04"E	130.66'
L24	S89°36'19"E	26.73'
L25	S0°23'41"W	20.00'
L26	S89°36'19"E	129.96'
L27	N0°23'41"E	36.57'
L28	N0°23'41"E	75.00'
L29	S89°36'19"E	20.00'
L30	N0°23'41"E	40.11'
L31	N0°23'41"E	75.00'
L32	S89°36'19"E	20.00'

### SURVEYOR'S CERTIFICATE

I, TRENT R. WILLIAMS, do hereby certify that I am a Licensed Professional Land Surveyor in the State of Utah and that I hold License No. 8034679, in accordance with Title 58, Chapter 22 of the Professional Engineers and Land Surveyors Act. I further certify that by authority of The Owners, I have completed a survey of the property described on this subdivision plat in accordance with Section 17-23-17 and have verified all measurements and that the monuments shown on this plat are located as indicated and are sufficient to accurately establish the boundaries of the herein described tract of real property and that it has been drawn correctly and is a true and correct representation of the herein described lands included in said subdivision based on data compiled from The County Recorder's office. I further certify that all lots meet frontage width and area requirements of applicable zoning ordinances.

### BOUNDARY DESCRIPTION

Trent R. Williams, PLS License no. 8034679 Date

### OWNER'S DEDICATION

We(I) the undersigned owners of the above described tract of land, do hereby set apart and subdivide the same into lots and streets (private streets/private right-of-way's) as shown hereon and name said tract.

## THE ORCHARDS AT JDC RANCH PHASE 1

Convey to **CITY NAME**, or its designee, all those parts or portions of said tract of land designated as parks to be used as public open space. Dedicate to public use all those parts or portions of said tract of land designated as streets, the same to be used as public thoroughfares.

Dedicate and reserve unto themselves, their heirs, their grantees and assigns, a right-of-way to be used in common with all others within said subdivision (and those adjoining subdivisions that may be subdivided by the undersigned owners, their successors, or assigns) on, over and across all those portions or parts of said tract of land designated on this plat as private streets (private rights-of-way) as access to the individual lots, to be maintained by a home owners association whose membership consists of said owners, their grantees, successors, or assigns.

Grant and convey to the subdivision home owners association, all those part or portions of said tract of land designated as common areas to be used for recreational and open space purposes for the benefit of each home owners association member in common with all others in the subdivision and grant and dedicate to the city a perpetual open space right and easement on and over the common areas to guarantee to **CITY NAME** that the common areas remain open and undeveloped except for approved recreational, parking and open space purposes.

Grant and dedicate a perpetual right and easement over, upon and under the lands designated hereon as public utility and drainage easements with no buildings or structures being erected within such easements.

Grant and dedicate unto all owners of lots upon which private land drains are constructed or which are otherwise dependent upon such land drains, an easement over such land drains for the purpose of perpetual maintenance and operation.

In witness whereof We(I) have hereto set our hands(s) this \_\_\_\_\_ day of \_\_\_\_\_ A.D., 20\_\_\_\_\_.

By: \_\_\_\_\_

### LIMITED LIABILITY COMPANY ACKNOWLEDGMENT

STATE OF UTAH  
County of Weber JS.S.

On the \_\_\_\_\_ day of \_\_\_\_\_, A.D. 20\_\_\_\_\_, \_\_\_\_\_ personally appeared before me, the undersigned Notary Public, in and for said County of \_\_\_\_\_ in the State of Utah, who after being duly sworn, acknowledged to me that He is the Manager, of West Park Community LLC a Limited Liability Company and that He signed the Owner's Dedication freely and voluntarily for and in behalf of said Limited Liability Company for the purposes therein mentioned and acknowledged to me that said Limited Liability Company executed the same.

MY COMMISSION EXPIRES: \_\_\_\_\_

RESIDING IN \_\_\_\_\_ COUNTY.

NOTARY PUBLIC

## THE ORCHARDS AT JDC RANCH PHASE 1

LOCATED IN THE NORTH HALF OF SECTION 27 OF SECTION 27 TOWNSHIP 7 NORTH RANGE 2 WEST SALT LAKE BASE & MERIDIAN PLAIN CITY, WEBER COUNTY, UTAH

### WEBER COUNTY RECORDER

ENTRY NO. \_\_\_\_\_ FEE \_\_\_\_\_ PAID \_\_\_\_\_ FILED FOR RECORD AND RECORDED THIS \_\_\_\_\_ DAY OF \_\_\_\_\_, 20\_\_\_\_\_. AT \_\_\_\_\_ IN BOOK \_\_\_\_\_ OF OFFICIAL RECORDS PAGE \_\_\_\_\_

WEBER COUNTY RECORDER

BY \_\_\_\_\_ DEPUTY RECORDER

### SHEET 1 OF 2

PROJECT NUMBER : 9630  
MANAGER : C.PRESTON  
DRAWN BY : J.MOSS  
CHECKED BY : T.WILLIAMS  
DATE : 10/9/2023

### COUNTY COUNCIL APPROVAL

APPROVED THIS \_\_\_\_\_ DAY OF \_\_\_\_\_, 20\_\_\_\_\_,  
BY THE WEBER COUNTY COUNCIL

COUNTY RECORDER COUNCIL CHAIR

### COUNTY ENGINEER'S APPROVAL

APPROVED THIS \_\_\_\_\_ DAY OF \_\_\_\_\_, 20\_\_\_\_\_,  
BY THE WEBER COUNTY ENGINEER

WEBER COUNTY ENGINEER

### PLANNING COMMISSION APPROVAL

APPROVED THIS \_\_\_\_\_ DAY OF \_\_\_\_\_, 20\_\_\_\_\_,  
BY THE COUNTY PLANNING COMMISSION APPROVAL

CHAIRMAN, WEBER COUNTY PLANNING COMMISSION

### COUNTY ATTORNEY'S APPROVAL

APPROVED THIS \_\_\_\_\_ DAY OF \_\_\_\_\_, 20\_\_\_\_\_,  
BY THE WEBER COUNTY ATTORNEY.

WEBER COUNTY ATTORNEY



LAYTON  
919 North 400 West  
Layton UT 84041  
Phone: 801.547.1100  
Fax: 801.593.6315  
www.ensigneng.com

SALT LAKE CITY  
Phone: 801.255.0023

TOOELE  
Phone: 435.843.3590

CEDAR CITY  
Phone: 435.965.1463

RICHFIELD  
Phone: 435.996.3963

DEVELOPER  
NILSON HOMES  
1740 COMBE RD, SUITE 2  
SOUTH OGDEN, UTAH 84403  
801-392-8100



**ENSIGN**  
THE STANDARD IN ENGINEERING

**LAYTON**  
919 North 400 West  
Layton, UT 84041  
Phone: 801.547.1100

**SANDY**  
Phone: 801.255.0529

**TOEELE**  
Phone: 435.843.3590

**CEDAR CITY**  
Phone: 435.865.1453

**RICHFIELD**  
Phone: 435.896.2983

---

**WWW.ENSIGNENG.COM**

FOR:  
NILSON HOMES  
1740 COMBE RD, SUITE 2  
SOUTH OGDEN, UT 84403

CONTACT:  
STEVE ANDERSON  
PHONE: 801.392.8100

**THE ORCHARDS AT JDC RANCH  
PHASE 1  
2800 WEST 2600 NORTH STREET  
WEBER COUNTY, UTAH**



NO. \_\_\_\_\_ DATE \_\_\_\_\_ REVISION  
FOR REVIEW

**GENERAL NOTES**

PROJECT NUMBER: 9872 | PRINT DATE: 2023-10-09  
PROJECT MANAGER: CP | DESIGNED BY: TS

**C-001**

**GENERAL NOTES**

- ALL CONSTRUCTION MUST STRICTLY FOLLOW THE STANDARDS AND SPECIFICATIONS SET FORTH BY: THE DESIGN ENGINEER, LOCAL AGENCY JURISDICTION, APWA (CURRENT EDITION), AND THE MANUAL ON UNIFORM TRAFFIC CONTROL DEVICES (M.U.T.C.D.). THE ORDER LISTED ABOVE IS ARRANGED BY SENIORITY. THE LATEST EDITION OF ALL STANDARDS AND SPECIFICATIONS MUST BE ADHERED TO. IF A CONSTRUCTION PRACTICE IS NOT SPECIFIED BY ANY OF THE LISTED SOURCES, CONTRACTOR MUST CONTACT DESIGN ENGINEER FOR DIRECTION.
- CONTRACTOR TO STRICTLY FOLLOW THE MOST CURRENT COPY OF THE SOILS REPORT FOR THIS PROJECT. ALL GRADING INCLUDING BUT NOT LIMITED TO CUT, FILL, COMPACTION, ASPHALT SECTION, SUBBASE, TRENCH EXCAVATION/BACKFILL, SITE GRUBBING, AND FOOTINGS MUST BE COORDINATED DIRECTLY WITH SOILS REPORT.
- CONTRACTOR MUST VERIFY ALL EXISTING CONDITIONS BEFORE BIDDING, AND BRINGS UP ANY QUESTIONS BEFORE SUBMITTING BID.
- CONTRACTOR SHALL PROVIDE A CONSTRUCTION SCHEDULE IN ACCORDANCE WITH THE CITY, STATE, OR COUNTY REGULATIONS FOR WORKING IN THE PUBLIC WAY.
- CONTRACTOR SHALL BE RESPONSIBLE FOR DUST CONTROL ACCORDING TO GOVERNING AGENCY STANDARDS. WET DOWN DRY MATERIALS AND RUBBISH TO PREVENT BLOWING.
- CONTRACTOR SHALL BE RESPONSIBLE FOR ANY DAMAGE TO ADJACENT SURFACE IMPROVEMENTS.
- CONTRACTOR SHALL BE RESPONSIBLE FOR CORRECTING ANY SETTLEMENT OF OR DAMAGE TO EXISTING UTILITIES.
- THE CONTRACTOR IS RESPONSIBLE TO FURNISH ALL MATERIALS TO COMPLETE THE PROJECT.
- ALL EXPOSED SURFACES WILL HAVE A TEXTURED FINISH, RUBBED, OR BROOMED. ANY "PLASTERING" OF NEW CONCRETE WILL BE DONE WHILE IT IS STILL "GREEN".
- PRIOR TO STARTING CONSTRUCTION, THE CONTRACTOR SHALL BE RESPONSIBLE FOR VERIFYING THAT ALL REQUIRED PERMITS AND APPROVALS HAVE BEEN OBTAINED. NO CONSTRUCTION OR FABRICATION SHALL BEGIN UNTIL THE CONTRACTOR HAS RECEIVED AND THOROUGHLY REVIEWED ALL PLANS AND OTHER DOCUMENTS APPROVED BY ALL OF THE PERMITTING AUTHORITIES.
- THE LOCATIONS OF UNDERGROUND FACILITIES SHOWN ON THESE PLANS ARE BASED ON FIELD SURVEYS AND LOCAL UTILITY COMPANY RECORDS. IT SHALL BE THE CONTRACTOR'S FULL RESPONSIBILITY TO CONTACT THE VARIOUS UTILITY COMPANIES TO LOCATE THEIR FACILITIES PRIOR TO PROCEEDING WITH CONSTRUCTION. NO ADDITIONAL COMPENSATION SHALL BE PAID TO THE CONTRACTOR FOR DAMAGE AND REPAIR TO THESE FACILITIES CAUSED BY HIS WORK FORCE. CONTRACTOR SHALL START INSTALLATION AT LOW POINT OF ALL NEW GRAVITY UTILITY LINES.
- ALL DIMENSIONS, GRADES, AND UTILITY DESIGN SHOWN ON THE PLANS SHALL BE VERIFIED BY THE CONTRACTOR PRIOR TO CONSTRUCTION. CONTRACTOR SHALL NOTIFY THE ENGINEER IF ANY DISCREPANCIES EXIST, PRIOR TO PROCEEDING WITH CONSTRUCTION FOR NECESSARY PLAN OR GRADE CHANGES. NO EXTRA COMPENSATION SHALL BE PAID TO THE CONTRACTOR FOR WORK HAVING TO BE REDONE DUE TO THE DIMENSIONS OR GRADES SHOWN INCORRECTLY ON THESE PLANS, IF SUCH NOTIFICATION HAS NOT BEEN GIVEN.
- NO CHANGE IN DESIGN LOCATION OR GRADE WILL BE MADE BY THE CONTRACTOR WITHOUT THE WRITTEN APPROVAL OF THE PROJECT ENGINEER.
- NATURAL VEGETATION AND SOIL COVER SHALL NOT BE DISTURBED PRIOR TO ACTUAL CONSTRUCTION OF A REQUIRED FACILITY OR IMPROVEMENT. MASS CLEARING OF THE SITE IN ANTICIPATION OF CONSTRUCTION SHALL BE AVOIDED.
- CONTRACTOR SHALL BE RESPONSIBLE FOR FURNISHING, MAINTAINING, OR RESTORING ALL MONUMENTS AND MONUMENT REFERENCE MARKS WITHIN THE PROJECT SITE. CONTACT THE CITY OR COUNTY SURVEYOR FOR MONUMENT LOCATIONS AND CONSTRUCTION DETAILS.
- EXISTING UTILITY INFORMATION SHOWN IS FOR INFORMATIONAL PURPOSES ONLY. IT IS DERIVED FROM ON-SITE SURVEY AND/OR UTILITY MAPPING PROVIDED TO THE ENGINEER, AND THEREFORE UTILITIES MAY NOT BE LOCATED CORRECTLY, EITHER HORIZONTALLY OR VERTICALLY, AND MAY NOT BE ALL INCLUSIVE. CONTRACTOR IS REQUIRED TO FOLLOW THE PROCEDURE OUTLINED BELOW:
  - CONTRACTOR IS REQUIRED TO LOCATE AND POTHOLE ALL EXISTING UTILITY LINES (BOTH HORIZONTALLY AND VERTICALLY) THAT AFFECT THE PROJECT CONSTRUCTION, EITHER ON-SITE OR OFF-SITE, AND DETERMINE IF THERE ARE ANY CONFLICTS WITH THE DESIGN OF THE SITE AS SHOWN ON THE APPROVED PLANS PRIOR TO ANY CONSTRUCTION. IF IT IS DETERMINED THAT CONFLICTS EXIST BETWEEN EXISTING UTILITIES AND DESIGN UTILITIES (OR ANOTHER ASPECT OF PROPOSED CONSTRUCTION) THE ENGINEER MUST BE NOTIFIED IMMEDIATELY TO CORRECT THE CONFLICTS BEFORE ANY WORK CAN BEGIN. IF THE CONTRACTOR FAILS TO FOLLOW THIS ABSOLUTE REQUIREMENT AND CONFLICTS ARISE DURING CONSTRUCTION THE CONTRACTOR WILL BEAR THE SOLE RESPONSIBILITY TO FIX THE CONFLICTS.
  - CONTRACTOR IS REQUIRED TO VERIFY THAT PROPER COVER AND PROTECTION OF EXISTING UTILITY LINES IS MAINTAINED OR ATTAINED WITHIN THE DESIGN ONCE VERIFICATION OF THE EXISTING UTILITIES IS COMPLETED AS OUTLINED IN 16.1 ABOVE.
  - IN ADDITION TO 16.1 AND 16.2 ABOVE THE CONTRACTOR WILL VERIFY DEPTHS OF UTILITIES IN THE FIELD BY "POT-HOLING" A MINIMUM OF 300 FEET AHEAD OF PROPOSED PIPELINE CONSTRUCTION TO AVOID POTENTIAL CONFLICTS WITH DESIGNED PIPELINE ALIGNMENT AND GRADE AND EXISTING UTILITIES.
  - IF A CONFLICT ARISES BETWEEN EXISTING UTILITIES AND DESIGN UTILITIES (OR ANOTHER ASPECT OF PROPOSED CONSTRUCTION) AS DETERMINED UNDER 16.1, 16.2 OR 16.3 THE CONTRACTOR WILL NOTIFY THE ENGINEER IMMEDIATELY TO RESOLVE THE CONFLICT.
  - IF A CONFLICT ARISES BETWEEN EXISTING UTILITIES AND DESIGN UTILITIES (OR ANOTHER ASPECT OF PROPOSED CONSTRUCTION) RESULTING FROM THE CONTRACTOR'S NEGLIGENCE TO IDENTIFY AND/OR "POT-HOLE" EXISTING UTILITIES AS REQUIRED IN 16.1, 16.2 AND 16.3 ABOVE, THE CONTRACTOR WILL BE REQUIRED TO RESOLVE THE CONFLICT WITHOUT ADDITIONAL COST OR CLAIM TO THE OWNER OR ENGINEER.
- ANY AREA OUTSIDE THE LIMIT OF WORK THAT IS DISTURBED SHALL BE RESTORED TO ITS ORIGINAL CONDITION AT NO COST TO OWNER.
- CONSULT ALL OF THE DRAWINGS AND SPECIFICATIONS FOR COORDINATION REQUIREMENTS BEFORE COMMENCING CONSTRUCTION.
- AT ALL LOCATIONS WHERE EXISTING PAVEMENT ABUTS NEW CONSTRUCTION, THE EDGE OF THE EXISTING PAVEMENT SHALL BE SAWCUT TO A CLEAN, SMOOTH EDGE.
- ALL CONSTRUCTION AND MATERIALS SHALL BE IN ACCORDANCE WITH THE MOST RECENT, ADOPTED EDITION OF ADA ACCESSIBILITY GUIDELINES.
- CONTRACTOR SHALL, AT THE TIME OF BIDDING AND THROUGHOUT THE PERIOD OF THE CONTRACT, BE LICENSED IN THE STATE OF UTAH AND SHALL BE BONDABLE FOR AN AMOUNT REQUIRED BY THE OWNER.
- CONTRACTOR SHALL BE RESPONSIBLE TO PROVIDE ALL WATER, POWER, SANITARY FACILITIES AND TELEPHONE SERVICES AS REQUIRED FOR THE CONTRACTOR'S USE DURING CONSTRUCTION.
- CONTRACTOR SHALL BE RESPONSIBLE FOR ADEQUATELY SCHEDULING INSPECTION AND TESTING OF ALL FACILITIES CONSTRUCTED UNDER THIS CONTRACT. ALL TESTING SHALL CONFORM TO THE REGULATORY AGENCY'S STANDARD SPECIFICATIONS. ALL RE-TESTING AND/OR RE-INSPECTION SHALL BE PAID FOR BY THE CONTRACTOR.
- IF EXISTING IMPROVEMENTS NEED TO BE DISTURBED AND/OR REMOVED FOR THE PROPER PLACEMENT OF IMPROVEMENTS TO BE CONSTRUCTED BY THESE PLANS, THE CONTRACTOR SHALL BE RESPONSIBLE FOR PROTECTING EXISTING IMPROVEMENTS FROM DAMAGE. COST OF REPLACING OR REPAIRING EXISTING IMPROVEMENTS SHALL BE INCLUDED IN THE UNIT PRICE BID FOR ITEMS REQUIRING REMOVAL AND/OR REPLACEMENT. THERE WILL BE NO EXTRA COST DUE TO THE CONTRACTOR FOR REPLACING OR REPAIRING EXISTING IMPROVEMENTS.
- WHenever existing facilities are removed, damaged, broken, or cut in the installation of the work covered by these plans or specifications, said facilities shall be replaced at the contractor's expense with materials equal to or better than the materials used in the original existing facilities. The finished product shall be subject to the approval of the owner, the engineer, and the respective regulatory agency.
- CONTRACTOR SHALL MAINTAIN A NEATLY MARKED SET OF FULL-SIZE RECORD DRAWINGS SHOWING THE FINAL LOCATION AND LAYOUT OF ALL STRUCTURES AND OTHER FACILITIES. RECORD DRAWINGS SHALL REFLECT CHANGE ORDERS, ACCOMMODATIONS, AND ADJUSTMENTS TO ALL IMPROVEMENTS CONSTRUCTED. WHERE NECESSARY, SUPPLEMENTAL DRAWINGS SHALL BE PREPARED AND SUBMITTED BY THE CONTRACTOR. PRIOR TO ACCEPTANCE OF THE PROJECT, THE CONTRACTOR SHALL DELIVER TO THE ENGINEER ONE SET OF NEATLY MARKED RECORD DRAWINGS SHOWING THE INFORMATION REQUIRED ABOVE. RECORD DRAWINGS SHALL BE REVIEWED AND THE COMPLETE RECORD DRAWINGS SET SHALL BE CURRENT WITH ALL CHANGES AND DEVIATIONS REDLINED AS A PRECONDITION TO THE FINAL PROGRESS PAYMENT APPROVAL AND/OR FINAL ACCEPTANCE.
- WHERE THE PLANS OR SPECIFICATIONS DESCRIBE PORTIONS OF THE WORK IN GENERAL TERMS BUT NOT IN COMPLETE DETAIL, IT IS UNDERSTOOD THAT ONLY THE BEST GENERAL PRACTICE IS TO PREVAIL AND THAT ONLY MATERIALS AND WORKMANSHIP OF THE FIRST QUALITY ARE TO BE USED.
- ALL EXISTING GATES AND FENCES TO REMAIN UNLESS OTHERWISE NOTED ON PLANS. PROTECT ALL GATES AND FENCES FROM DAMAGE.
- ALL EXISTING TREES ARE TO REMAIN UNLESS OTHERWISE NOTED ON PLANS. PROTECT ALL TREES FROM DAMAGE.
- ASPHALT MIX DESIGN MUST BE SUBMITTED AND APPROVED BY THE GOVERNING AGENCY PRIOR TO THE PLACEMENT.
- CONTRACTORS ARE RESPONSIBLE FOR ALL OSHA REQUIREMENTS ON THE PROJECT SITE.
- A UPDES (UTAH POLLUTANT DISCHARGE ELIMINATION SYSTEM) PERMIT IS REQUIRED FOR ALL CONSTRUCTION ACTIVITIES 1 ACRE OR MORE AS WELL AS A STORM WATER POLLUTION PREVENTION PLAN.

**UTILITY NOTES**

- ALL CONSTRUCTION AND MATERIALS SHALL BE IN ACCORDANCE WITH THESE CONTRACT DOCUMENTS, CITY AND STATE REQUIREMENTS AND THE MOST RECENT EDITIONS OF THE FOLLOWING: THE INTERNATIONAL PLUMBING CODE, UTAH DRINKING WATER REGULATIONS, APWA MANUAL OF STANDARD PLANS AND SPECIFICATIONS. THE CONTRACTOR IS REQUIRED TO ADHERE TO ALL OF THE ABOVE-MENTIONED DOCUMENTS UNLESS OTHERWISE NOTED AND APPROVED BY THE ENGINEER.
- CONTRACTOR SHALL COORDINATE LOCATION OF NEW "DRY UTILITIES" WITH THE APPROPRIATE UTILITY COMPANY, INCLUDING BUT NOT LIMITED TO: TELEPHONE & INTERNET SERVICE, GAS SERVICE, CABLE, AND POWER.
- EXISTING UTILITIES HAVE BEEN SHOWN ON THE PLANS BASED ON ON-SITE SURVEY. PRIOR TO COMMENCING ANY WORK, IT SHALL BE THE CONTRACTOR'S RESPONSIBILITY TO HAVE EACH UTILITY COMPANY LOCATE, IN THE FIELD, THEIR MAIN AND SERVICE LINES. THE CONTRACTOR SHALL NOTIFY BLUE STAKES AT 1-800-662-4111 48 HOURS IN ADVANCE OF PERFORMING ANY EXCAVATION WORK. THE CONTRACTOR SHALL RECORD THE BLUE STAKES' ORDER NUMBER AND FURNISH ORDER NUMBER TO OWNER AND ENGINEER PRIOR TO ANY EXCAVATION. IT WILL BE THE CONTRACTOR'S SOLE RESPONSIBILITY TO DIRECTLY CONTACT ANY OTHER UTILITY COMPANIES THAT ARE NOT MEMBERS OF BLUE STAKES. IT SHALL BE THE CONTRACTOR'S SOLE RESPONSIBILITY TO PROTECT ALL EXISTING UTILITIES SO THAT NO DAMAGE RESULTS TO THEM DURING THE PERFORMANCE OF THIS CONTRACT. ANY REPAIRS NECESSARY TO DAMAGED UTILITIES SHALL BE PAID FOR BY THE CONTRACTOR. THE CONTRACTOR SHALL BE REQUIRED TO COOPERATE WITH OTHER CONTRACTORS AND UTILITY COMPANIES INSTALLING NEW STRUCTURES, UTILITIES AND SERVICE TO THE PROJECT.
- CARE SHOULD BE TAKEN IN ALL EXCAVATIONS DUE TO POSSIBLE EXISTENCE OF UNRECORDED UTILITY LINES. EXCAVATION REQUIRED WITHIN PROXIMITY OF EXISTING UTILITY LINES SHALL BE DONE BY HAND. CONTRACTOR SHALL REPAIR ANY DAMAGE TO EXISTING UTILITY LINES OR STRUCTURES INCURRED DURING CONSTRUCTION OPERATIONS AT CONTRACTOR'S EXPENSE.
- TRENCH BACKFILL MATERIAL AND COMPACTION TESTS ARE TO BE TAKEN PER APWA STANDARD SPECIFICATIONS (CURRENT EDITION), SECTION 30.05 20 - BACKFILLING TRENCHES, OR AS REQUIRED BY THE GEOTECHNICAL REPORT IF NATIVE MATERIALS ARE USED. NO NATIVE MATERIALS ARE ALLOWED IN THE PIPE ZONE. THE MAXIMUM LIFT FOR BACKFILLING EXCAVATIONS IS DETERMINED BY THE GEOTECHNICAL RECOMMENDATIONS.
- THE CONTRACTOR IS SOLELY RESPONSIBLE FOR CONFORMING TO LOCAL AND FEDERAL CODES GOVERNING SHORING AND BRACING OF EXCAVATIONS AND TRENCHES AND FOR THE PROTECTION OF WORKERS.
- THE CONTRACTOR IS REQUIRED TO KEEP ALL CONSTRUCTION ACTIVITIES WITHIN THE APPROVED PROJECT LIMITS. THIS INCLUDES, BUT IS NOT LIMITED TO VEHICLE AND EQUIPMENT STAGING, MATERIAL STORAGE AND LIMITS OF TRENCH EXCAVATION. IT IS THE CONTRACTOR'S RESPONSIBILITY TO OBTAIN PERMISSION AND/OR EASEMENTS FROM THE APPROPRIATE GOVERNING ENTITY AND/OR INDIVIDUAL PROPERTY OWNER(S) FOR WORK OR STAGING OUTSIDE OF THE PROJECT LIMITS.
- THE CONTRACTOR IS RESPONSIBLE FOR REPAIRING ANY DAMAGE, CAUSED BY ANY CONDITION INCLUDING SETTLEMENT, TO EXISTING UTILITIES FROM WORK PERFORMED AT OR NEAR EXISTING UTILITIES. THE CONTRACTOR SHALL TAKE ALL MEASURES NECESSARY TO PROTECT ALL EXISTING PUBLIC AND PRIVATE ROADWAY AND UTILITY FACILITIES. DAMAGE TO EXISTING FACILITIES CAUSED BY THE CONTRACTOR MUST BE REPAIRED BY THE CONTRACTOR AT HIS/HER EXPENSE TO THE SATISFACTION OF THE OWNER OF SAID FACILITIES.
- ALL WATER LINE AND SEWER LINE INSTALLATION AND TESTING TO BE IN ACCORDANCE WITH LOCAL GOVERNING AGENCY'S STANDARDS AND SPECIFICATIONS.
- ALL MANHOLES, HYDRANTS, VALVES, CLEANOUT BOXES, CATCH BASINS, METERS, ETC. MUST BE RAISED OR LOWERED TO FINAL GRADE PER APWA (CURRENT EDITION) STANDARDS AND INSPECTOR REQUIREMENTS. CONCRETE COLLARS MUST BE CONSTRUCTED ON ALL MANHOLES, CLEANOUT BOXES, CATCH BASINS, AND VALVES PER APWA STANDARDS. ALL MANHOLE, CATCH BASIN, OR CLEANOUT BOX CONNECTIONS MUST BE MADE WITH THE PIPE CUT FLUSH WITH THE INSIDE OF THE BOX AND GROUTED OR SEALED.
- CONTRACTOR SHALL NOT ALLOW ANY GROUNDWATER OR DEBRIS TO ENTER THE NEW OR EXISTING PIPE DURING CONSTRUCTION.
- SILT AND DEBRIS ARE TO BE CLEANED OUT OF ALL STORM DRAIN BOXES. CATCH BASINS ARE TO BE MAINTAINED IN A CLEANED CONDITION AS NEEDED UNTIL AFTER THE FINAL BOND RELEASE INSPECTION.
- CONTRACTOR SHALL CLEAN ASPHALT, TAR OR OTHER ADHESIVES OFF OF ALL MANHOLE LIDS AND INLET GRATES TO ALLOW ACCESS.
- EACH TRENCH SHALL BE EXCAVATED SO THAT THE PIPE CAN BE LAID TO THE ALIGNMENT AND GRADE AS REQUIRED. THE TRENCH WALL SHALL BE SO BRACED THAT THE WORKMEN MAY WORK SAFELY AND EFFICIENTLY. ALL TRENCHES SHALL BE DRAINED SO THE PIPE LAYING MAY TAKE PLACE IN DEWATERED CONDITIONS.
- CONTRACTOR SHALL PROVIDE AND MAINTAIN AT ALL TIMES EMPTER MEANS AND DEVICES WITH WHICH TO REMOVE PROMPTLY AND TO PROPERLY DISPOSE OF ALL WATER ENTERING THE TRENCH EXCAVATION.
- ALL SEWER LINES AND SEWER SERVICES SHALL HAVE A MINIMUM SEPARATION OF 10 FEET, EDGE TO EDGE, FROM THE WATER LINES. IF A 10 FOOT SEPARATION CAN NOT BE MAINTAINED, CONSTRUCT PER GOVERNING AGENCY'S MINIMUM SEPARATION STANDARDS.
- CONTRACTOR SHALL INSTALL THRUST BLOCKING AT ALL WATERLINE ANGLE POINTS AND TEES.
- ALL UNDERGROUND UTILITIES SHALL BE IN PLACE PRIOR TO INSTALLATION OF CURB, GUTTER, SIDEWALK AND STREET PAVING.
- CONTRACTOR SHALL INSTALL MAGNETIC LOCATING TAPE CONTINUOUSLY OVER ALL NONMETALLIC PIPE.

**TRAFFIC CONTROL AND SAFETY NOTES**

- TRAFFIC CONTROL AND STRIPING TO CONFORM TO THE CURRENT MANUAL OF UNIFORM TRAFFIC CONTROL DEVICES (M.U.T.C.D.).
- BARRICADING AND DETOURING SHALL BE IN CONFORMANCE WITH THE REQUIREMENTS OF THE CURRENT M.U.T.C.D.
- NO STREET SHALL BE CLOSED TO TRAFFIC WITHOUT WRITTEN PERMISSION FROM THE APPROPRIATE AGENCY, EXCEPT WHEN DIRECTED BY LAW ENFORCEMENT OR FIRE OFFICIALS.
- THE CONTRACTOR SHALL MAKE EVERY EFFORT TO PROVIDE FOR SMOOTH TRAFFIC FLOW AND SAFETY. ACCESS SHALL BE MAINTAINED FOR ALL PROPERTIES ADJACENT TO THE WORK.
- DETOURING OPERATIONS FOR A PERIOD OF SIX CONSECUTIVE CALENDAR DAYS, OR MORE, REQUIRE THE INSTALLATION OF TEMPORARY STREET STRIPING AND REMOVAL OF INTERFERING STRIPING BY SANDBLASTING. THE DETOURING STRIPING PLAN OR CONSTRUCTION TRAFFIC CONTROL PLAN MUST BE SUBMITTED TO THE GOVERNING AGENCY FOR REVIEW AND APPROVAL.
- ALL TRAFFIC CONTROL DEVICES SHALL BE RESTORED TO THEIR ORIGINAL CONDITION AT THE END OF THE WORK TO THE SATISFACTION OF THE GOVERNING AGENCY.
- TRAFFIC CONTROL DEVICES (TCDs) SHALL REMAIN VISIBLE AND OPERATIONAL AT ALL TIMES.
- ALL PERMANENT TRAFFIC CONTROL DEVICES CALLED FOR HEREON SHALL BE IN PLACE AND IN FINAL POSITION PRIOR TO ALLOWING ANY PUBLIC TRAFFIC ONTO THE PORTIONS OF THE ROAD(S) BEING IMPROVED HEREUNDER, REGARDLESS OF THE STATUS OF COMPLETION OF PAVING OR OTHER OFF-SITE IMPROVEMENTS CALLED FOR BY THESE PLANS.
- THE CONTRACTOR SHALL PROVIDE BARRICADES, SIGNS, FLASHERS, OTHER EQUIPMENT AND FLAG PERSONS NECESSARY TO INSURE THE SAFETY OF WORKERS AND VISITORS.
- THE CONTRACTOR SHALL BE RESPONSIBLE FOR NOTIFYING UTAH TRANSIT AUTHORITY (UTA) IF THE CONSTRUCTION INTERRUPTS OR RELOCATES A BUS STOP OR HAS AN ADVERSE EFFECT ON BUS SERVICE ON THAT STREET TO ARRANGE FOR TEMPORARY RELOCATION OF A STOP.

**DEMOLITION NOTES**

- EXISTING UTILITY INFORMATION SHOWN IS FOR INFORMATIONAL PURPOSES ONLY. IT IS DERIVED FROM ON-SITE SURVEY AND MAY NOT BE LOCATED CORRECTLY AND IS NOT ALL INCLUSIVE. CONTRACTOR SHALL FIELD LOCATE ALL UTILITIES WITHIN THE PROJECT LIMITS BEFORE BEGINNING DEMOLITION/CONSTRUCTION.
- THERE MAY BE BURIED UTILITIES WITHIN THE LIMITS OF DISTURBANCE THAT ARE NOT SHOWN ON THE PLANS DUE TO LACK OF MAPPING OR RECORD INFORMATION. CONTRACTOR SHALL NOTIFY THE ENGINEER WHEN UNEXPECTED UTILITIES ARE DISCOVERED.
- THE CONTRACTOR SHALL BE FULLY RESPONSIBLE FOR LOCATING AND PROTECTING FROM DAMAGE ALL EXISTING UTILITIES AND IMPROVEMENTS WHETHER OR NOT SHOWN ON THESE PLANS. THE FACILITIES AND IMPROVEMENTS ARE BELIEVED TO BE CORRECTLY SHOWN BUT THE CONTRACTOR IS REQUIRED TO SATISFY HIMSELF AS TO THE COMPLETENESS AND ACCURACY OF THE LOCATIONS. ANY CONTRACTOR PERFORMING WORK ON THIS PROJECT SHALL FAMILIARIZE HIMSELF WITH THE SITE AND SHALL BE HELD SOLELY RESPONSIBLE FOR ANY DAMAGE TO EXISTING FACILITIES RESULTING DIRECTLY, OR INDIRECTLY, FROM HIS OPERATIONS, WHETHER OR NOT SAID FACILITIES ARE SHOWN ON THESE PLANS.

**GRADING AND DRAINAGE NOTES**

- SITE GRADING SHALL BE PERFORMED IN ACCORDANCE WITH THESE PLANS AND SPECIFICATIONS AND THE RECOMMENDATIONS SET FORTH IN THE GEOTECHNICAL REPORT AND ALL RELATED ADDENDUMS.
- THE CONTRACTOR SHALL STRIP AND CLEAR THE TOPSOIL, MAJOR ROOTS AND ORGANIC MATERIAL FROM ALL PROPOSED BUILDING AND PAVEMENT AREAS PRIOR TO SITE GRADING. (THE TOPSOIL MAY BE STOCKPILED FOR LATER USE IN LANDSCAPED AREAS.)
- THE CONTRACTOR SHALL REMOVE ALL ORGANIC MATERIAL AND OTHER DELETERIOUS MATERIALS PRIOR TO PLACING GRADING FILL OR BASE COURSE. THE AREA SHOULD BE PROOF-ROLLED TO IDENTIFY ANY SOFT AREAS. WHERE SOFT AREAS ARE ENCOUNTERED, THE CONTRACTOR SHALL REMOVE THE SOIL AND REPLACE WITH COMPACTED FILL.
- ALL DEBRIS PILES AND BERMS SHOULD BE REMOVED AND HAULED AWAY FROM SITE OR USED AS GENERAL FILL IN LANDSCAPED AREAS.
- THE CONTRACTOR SHALL CONSTRUCT THE BUILDING PAD TO THESE DESIGN PLANS AS PART OF THE SITE GRADING CONTRACT, AND STRICTLY ADHERE TO THE SITE PREPARATION AND GRADING REQUIREMENTS OUTLINED IN THE GEOTECHNICAL REPORT.
- THE CONTRACTOR SHALL GRADE THE PROJECT SITE TO PROVIDE A SMOOTH TRANSITION BETWEEN NEW AND EXISTING ASPHALT, CURB AND GUTTER, AND ADJOINING SITE IMPROVEMENTS.
- THE CONTRACTOR SHALL BE RESPONSIBLE FOR DAMAGE AND DEBRIS ON ADJACENT STREETS WHEN EQUIPMENT IS TRAVELING THOSE STREETS.
- THE CONTRACTOR SHALL BE FAMILIAR WITH ALL CONDITIONS AND RECOMMENDATIONS OUTLINED IN THE GEOTECHNICAL REPORT AND TAKE ALL NECESSARY PRECAUTIONS AND RECOMMENDED PROCEDURES TO ASSURE SOUND GRADING PRACTICES.
- THE CONTRACTOR SHALL TAKE APPROPRIATE GRADING MEASURES TO DIRECT STORM SURFACE RUNOFF TOWARDS CATCH BASINS.
- THE LOCATIONS OF UNDERGROUND FACILITIES SHOWN ON THESE PLANS ARE BASED ON ON-SITE SURVEY. IT SHALL BE THE CONTRACTOR'S FULL RESPONSIBILITY TO CONTACT THE VARIOUS UTILITY COMPANIES TO LOCATE THEIR FACILITIES PRIOR TO PROCEEDING WITH CONSTRUCTION. NO ADDITIONAL COMPENSATION SHALL BE PAID TO THE CONTRACTOR FOR DAMAGE AND REPAIR TO THESE FACILITIES CAUSED BY HIS WORK FORCE.
- IT SHALL BE THE RESPONSIBILITY OF THE CONTRACTOR TO PERFORM ALL NECESSARY CUTS AND FILLS WITHIN THE LIMITS OF THIS PROJECT AND THE RELATED OFF-SITE WORK, SO AS TO GENERATE THE DESIRED SUBGRADE, FINISH GRADES, AND SLOPES SHOWN.
- THE CONTRACTOR IS WARNED THAT AN EARTHWORK BALANCE WAS NOT NECESSARILY THE INTENT OF THIS PROJECT. ANY ADDITIONAL MATERIAL REQUIRED OR LEFTOVER MATERIAL FOLLOWING EARTHWORK OPERATIONS BECOMES THE RESPONSIBILITY OF THE CONTRACTOR.
- THE GRADING CONTRACTOR IS RESPONSIBLE TO COORDINATE WITH THE OWNER TO PROVIDE FOR THE REQUIREMENTS OF THE PROJECT STORM WATER POLLUTION PREVENTION PLAN (SWPPP) AND ASSOCIATED PERMIT. ALL CONTRACTOR ACTIVITIES 1 ACRE OR MORE IN SIZE ARE REQUIRED TO PROVIDE A STORM WATER POLLUTION PREVENTION PLAN.
- ALL CUT AND FILL SLOPES SHALL BE PROTECTED UNTIL EFFECTIVE EROSION CONTROL HAS BEEN ESTABLISHED.
- THE USE OF POTABLE WATER WITHOUT A SPECIAL PERMIT FOR BUILDING OR CONSTRUCTION PURPOSES INCLUDING CONSOLIDATION OF BACKFILL OR DUST CONTROL IS PROHIBITED. THE CONTRACTOR SHALL OBTAIN ALL NECESSARY PERMITS FOR CONSTRUCTION WATER FROM GOVERNING AGENCY.
- THE CONTRACTOR SHALL MAINTAIN THE STREETS, SIDEWALKS, AND ALL OTHER PUBLIC RIGHT-OF-WAYS IN A CLEAN, SAFE AND USABLE CONDITION. ALL SPLILLS OF SOIL, ROCK OR CONSTRUCTION DEBRIS SHALL BE PROMPTLY REMOVED FROM THE PUBLICLY-OWNED PROPERTY DURING CONSTRUCTION AND UPON COMPLETION OF THE PROJECT. ALL ADJACENT PROPERTY, PRIVATE OR PUBLIC, SHALL BE MAINTAINED IN A CLEAN, SAFE, AND USABLE CONDITION.

**ABBREVIATIONS**

APWA	AMERICAN PUBLIC WORKS ASSOCIATION
AR	ACCESSIBLE ROUTE
ASTM	AMERICAN SOCIETY FOR TESTING AND MATERIALS
AWWA	AMERICAN WATER WORKS ASSOCIATION
BOS	BOTTOM OF STEP
BVC	BEGIN VERTICAL CURVE
C	CURB
CB	CATCH BASIN
CF	CURB FACE OR CURB FEET
CL	CENTER LINE
CO	CLEAN OUT
COMM	COMMUNICATION
CONC	CONCRETE
CONT	CONTINUOUS
DIA	DIAMETER
DIP	DUCTILE IRON PIPE
ELEC	ELECTRICAL
ELEV	ELEVATION
EOA	EDGE OF ASPHALT
EVC	END OF VERTICAL CURVE
EW	EACH WAY
EXIST	EXISTING
FF	FINISH FLOOR
FG	FINISH GRADE
FH	FIRE HYDRANT
FL	FLOW LINE OR FLANGE
GB	GRADE BREAK
GF	GARAGE FLOOR
GV	GATE VALVE
HC	HANDICAP
HP	HIGH POINT
IRR	IRRIGATION
K	RATE OF VERTICAL CURVATURE
LD	LAND DRAIN
LF	LINEAR FEET
LP	LOW POINT
MEX	MATCH EXISTING
MH	MANHOLE
MJ	MECHANICAL JOINT
NG	NATURAL GROUND
NIC	NOT IN CONTRACT
NO	NUMBER
OC	ON CENTER
OCEW	ON CENTER EACH WAY
OHP	OVERHEAD POWER
PC	POINT OF CURVATURE OR PRESSURE CLASS
PCC	POINT OF COMPOUND CURVATURE
PI	POINT OF INTERSECTION
PVI	POST INDICATOR VALVE
PL	PROPERTY LINE
PRC	POINT OF REVERSE CURVATURE
PRO	PROPOSED
PT	POINT OF TANGENCY
PVC	POINT OF VERTICAL CURVATURE
PVI	POINT OF VERTICAL INTERSECTION
PVT	POINT OF VERTICAL TANGENCY
R	RADIUS
RD	ROCK DRAIN
ROW	RIGHT OF WAY
S	SLOPE
SAN SWR	SANITARY SEWER
SD	STORM DRAIN
SEC	SECONDARY
SS	SANITARY SEWER
STA	STATION
SW	SECONDARY WATER LINE
TBC	TOP BACK OF CURB
TGG	TOP OF GRATE
TOA	TOP OF ASPHALT
TCC	TOP OF CONCRETE
TOF	TOP OF FOUNDATION
TOW	TOP OF WALL
TOS	TOP OF STEP
TYP	TYPICAL
VC	VERTICAL CURVE
WV	WALL INDICATOR VALVE
W	WATER LINE

NOTE: MAY CONTAIN ABBREVIATIONS THAT ARE NOT USED IN THIS PLAN SET.

**LEGEND**

	SECTION CORNER		EXISTING EDGE OF ASPHALT
	EXISTING MONUMENT		PROPOSED EDGE OF ASPHALT
	PROPOSED MONUMENT		EXISTING STRIPING
	EXISTING REBAR AND CAP		PROPOSED STRIPING
	SET ENSIGN REBAR AND CAP		EXISTING FENCE
	EXISTING WATER METER		PROPOSED FENCE
	PROPOSED WATER METER		EXISTING FLOW LINE
	EXISTING WATER MANHOLE		EXISTING WATER MANHOLE
	PROPOSED WATER MANHOLE		GRADE BREAK
	EXISTING WATER BOX		EXISTING STORM DRAIN LINE
	EXISTING WATER VALVE		PROPOSED STORM DRAIN LINE
	PROPOSED WATER VALVE		ROOF DRAIN LINE
	EXISTING FIRE HYDRANT		CATCHMENTS
	PROPOSED FIRE HYDRANT		HIGHWATER LINE
	PROPOSED FIRE DEPARTMENT CONNECTION		EXISTING SANITARY SEWER
	EXISTING SECONDARY WATER VALVE		PROPOSED SANITARY SEWER LINE
	PROPOSED SECONDARY WATER VALVE		PROPOSED SAN. SWR. SERVICE LINE
	EXISTING IRRIGATION BOX		EXISTING LAND DRAIN LINE
	EXISTING IRRIGATION VALVE		PROPOSED LAND DRAIN LINE
	PROPOSED IRRIGATION VALVE		PROPOSED LAND DRAIN SERVICE LINE
	EXISTING SANITARY SEWER MANHOLE		EXISTING CULINARY WATER LINE
	PROPOSED SANITARY SEWER MANHOLE		PROPOSED CULINARY WATER LINE
	EXISTING SANITARY CLEAN OUT		PROPOSED CULINARY WATER SERVICE LINE
	EXISTING STORM DRAIN CLEAN OUT BOX		EXISTING SECONDARY WATER LINE
	PROPOSED STORM DRAIN CLEAN OUT BOX		PROPOSED SECONDARY WATER LINE
	EXISTING STORM DRAIN INLET BOX		PROPOSED SEC. WATER SERVICE LINE
	EXISTING STORM DRAIN CATCH BASIN		EXISTING IRRIGATION LINE
	PROPOSED STORM DRAIN CATCH BASIN		PROPOSED IRRIGATION LINE
	EXISTING STORM DRAIN COMBO BOX		EXISTING OVERHEAD POWER LINE
	PROPOSED STORM DRAIN COMBO BOX		EXISTING ELECTRICAL LINE
	EXISTING STORM DRAIN CLEAN OUT		EXISTING GAS LINE
	EXISTING STORM DRAIN CULVERT		EXISTING TELEPHONE LINE
	PROPOSED STORM DRAIN CULVERT		ACCESSIBLE ROUTE
	TEMPORARY SAG INLET PROTECTION		SAW CUT LINE
	TEMPORARY IN-LINE INLET PROTECTION		STRAW WATTLE
	ROOF DRAIN		TEMPORARY BERM
	EXISTING ELECTRICAL MANHOLE		TEMPORARY SILT FENCE
	EXISTING ELECTRICAL BOX		LIMITS OF DISTURBANCE
	EXISTING TRANSFORMER		EXISTING WALL
	EXISTING UTILITY POLE		PROPOSED WALL
	EXISTING LIGHT		EXISTING CONTOURS
	PROPOSED LIGHT		PROPOSED CONTOURS
	EXISTING GAS METER		BUILDABLE AREA WITHIN SETBACKS
	EXISTING GAS MANHOLE		PUBLIC DRAINAGE EASEMENT
	EXISTING TELEPHONE MANHOLE		EXISTING ASPHALT TO BE REMOVED
	EXISTING TELEPHONE BOX		PROPOSED ASPHALT
	EXISTING TRAFFIC SIGNAL BOX		EXISTING CURB AND GUTTER
	EXISTING CABLE BOX		PROPOSED CURB AND GUTTER
	EXISTING BOLLARD		PROPOSED REVERSE PAN CURB AND GUTTER
	PROPOSED BOLLARD		TRANSITION TO REVERSE PAN CURB
	EXISTING SIGN		CONCRETE TO BE REMOVED
	PROPOSED SIGN		EXISTING CONCRETE
	EXISTING SPOT ELEVATION		PROPOSED CONCRETE
	PROPOSED SPOT ELEVATION		BUILDING TO BE REMOVED
	EXISTING FLOW DIRECTION		EXISTING BUILDING
	EXISTING TREE		PROPOSED BUILDING
	DENSE VEGETATION		

NOTE: MAY CONTAIN SYMBOLS THAT ARE NOT USED IN THIS PLAN SET.






CALL BLUESTAKES  
@ 811 AT LEAST 48 HOURS  
PRIOR TO THE  
COMMENCEMENT OF ANY  
CONSTRUCTION.

**BENCHMARK**

NORTHWEST CORNER OF SECTION 27  
TOWNSHIP 7 NORTH, RANGE 2 WEST  
SALT LAKE BASE AND MERIDIAN  
ELEV = 4231.00'

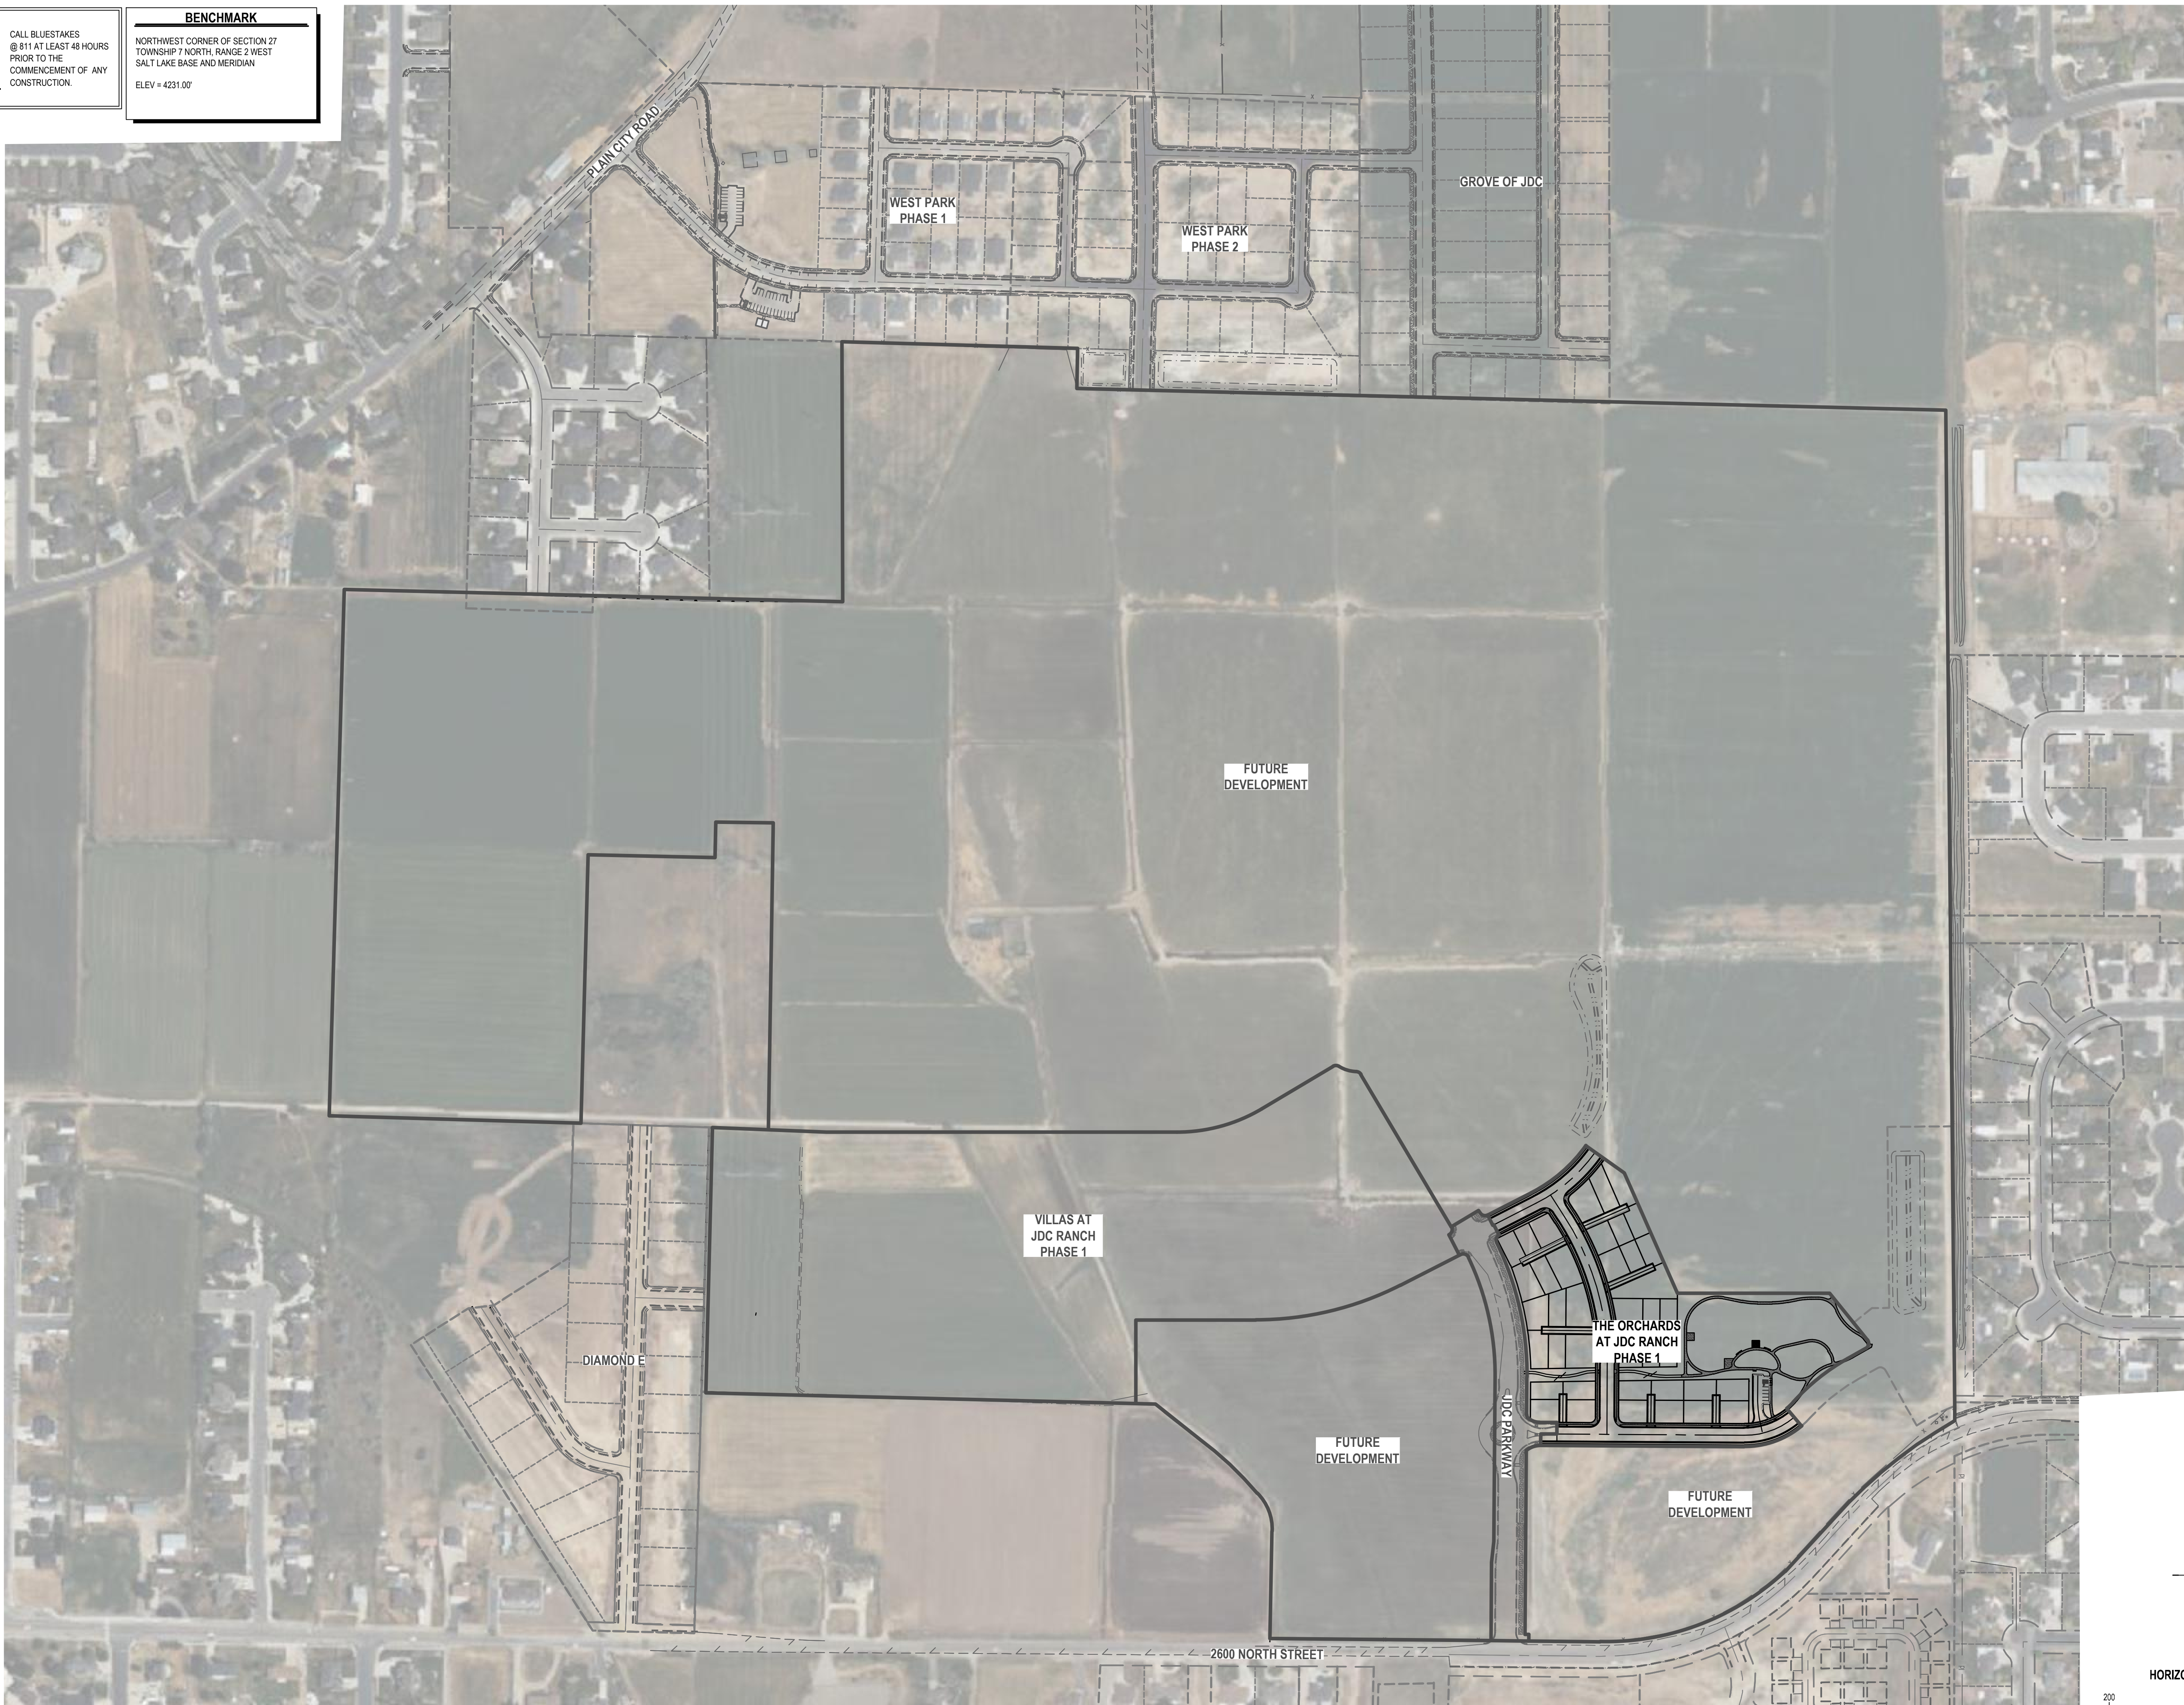

**THE STANDARD IN ENGINEERING**

**LAYTON**  
919 North 400 West  
Layton, UT 84041  
Phone: 801.547.1100

**SANDY**  
Phone: 801.255.0529

**TOOELE**  
Phone: 435.843.3590

**CEDAR CITY**  
Phone: 435.865.1453


**RICHFIELD**  
Phone: 435.896.2983

[WWW.ENSIGNENG.COM](http://WWW.ENSIGNENG.COM)

FOR:  
NILSON HOMES  
1740 COMBE RD, SUITE 2  
SOUTH OGDEN, UT 84403

CONTACT:  
STEVE ANDERSON  
PHONE: 801.392.8100

**THE ORCHARDS AT JDC RANCH  
PHASE 1  
2800 WEST 2600 NORTH STREET  
WEBER COUNTY, UTAH**


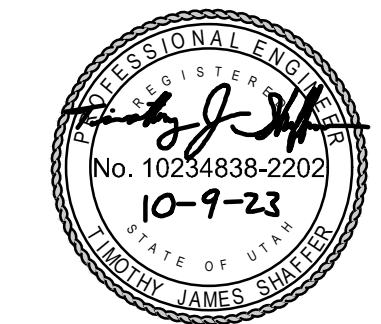


NO. DATE REVISION FOR REVIEW

**OVERALL DEVELOPMENT  
SITE PLAN**

PROJECT NUMBER 9872 PRINT DATE 2023-10-09  
PROJECT MANAGER CP DESIGNED BY TS

**C-002**

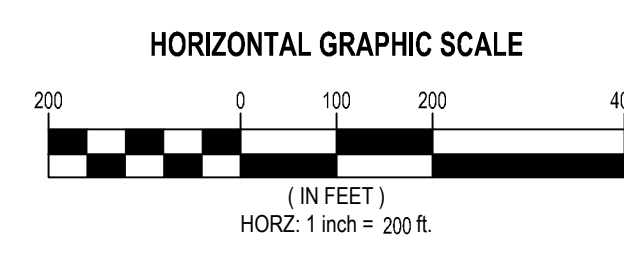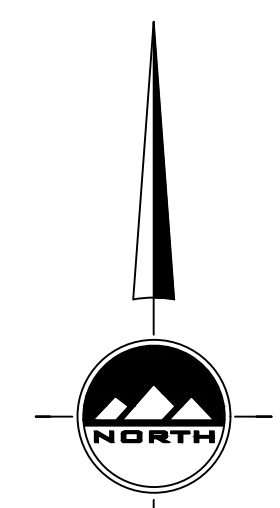



**811**  
Know what's below.  
Call before you dig.

CALL BLUESTAKES  
@ 811 AT LEAST 48 HOURS  
PRIOR TO THE  
COMMENCEMENT OF ANY  
CONSTRUCTION.

**BENCHMARK**

NORTHWEST CORNER OF SECTION 27  
TOWNSHIP 7 NORTH, RANGE 2 WEST  
SALT LAKE BASE AND MERIDIAN  
ELEV = 4231.00'

- GENERAL NOTES:**
1. ALL WORK TO COMPLY WITH THE GOVERNING AGENCY'S STANDARDS AND SPECIFICATIONS.
  2. ALL IMPROVEMENTS MUST COMPLY WITH ADA STANDARDS AND RECOMMENDATIONS.
  3. SEE LANDSCAPE/ARCHITECTURAL PLANS FOR CONCRETE MATERIAL, COLOR, FINISH, AND SCORE PATTERNS THROUGHOUT SITE.
  4. ALL PAVEMENT MARKINGS SHALL CONFORM TO THE LATEST EDITION OF THE M.U.T.C.D. (MANUAL ON UNIFORM TRAFFIC CONTROL DEVICES).
  5. ALL SURFACE IMPROVEMENTS DISTURBED BY CONSTRUCTION SHALL BE RESTORED OR REPLACED, INCLUDING TREES AND DECORATIVE SHRUBS, SOIL, FENCES, WALLS AND STRUCTURES, WHETHER OR NOT THEY ARE SPECIFICALLY SHOWN ON THE CONTRACT DOCUMENTS.
  6. NOTIFY ENGINEER OF ANY DISCREPANCIES IN DESIGN OR STAKING BEFORE PLACING CONCRETE OR ASPHALT.
  7. THE CONTRACTOR IS TO PROTECT AND PRESERVE ALL EXISTING IMPROVEMENTS, UTILITIES, AND SIGNS, ETC. UNLESS OTHERWISE NOTED ON THESE PLANS.

- SCOPE OF WORK:**  
PROVIDE, INSTALL AND/OR CONSTRUCT THE FOLLOWING PER THE SPECIFICATIONS GIVEN OR REFERENCED, THE DETAILS NOTED, AND/OR AS SHOWN ON THE CONSTRUCTION DRAWINGS:
1. INSTALL FIRE HYDRANT AND VALVE PER BONA VISTA WATER IMPROVEMENT DISTRICT STANDARDS AND SPECIFICATIONS.
  2. INSTALL HANDICAP ACCESSIBLE RAMP PER APWA PLAN 235.2
  3. INSTALL 30" TYPE A CURB AND GUTTER PER APWA STANDARDS AND SPECIFICATIONS PLAN 205.1
  4. INSTALL CONCRETE SIDEWALK PER APWA PLAN 231. WIDTH PER PLAN
  5. MATCH EXISTING IMPROVEMENTS
  6. EXISTING STREET LIGHT
  7. INSTALL STREET LIGHT PER PLAIN CITY STANDARDS AND SPECIFICATIONS. COORDINATE ALL PROPOSED STREET LIGHT LOCATIONS WITH PLAIN CITY AND THE STREET LIGHT INSTALLATION WITH ROCKY MOUNTAIN POWER
  8. EXISTING FIRE HYDRANT
  9. INSTALL DRIVE APPROACH PER APWA PLAN 221.1
  10. INSTALL ASPHALT DRIVEWAY
  11. EXISTING CURB AND GUTTER
  12. EXISTING SIDEWALK
  13. INSTALL 24" MODIFIED TYPE 'F' MOUNTABLE CURB AND GUTTER PER DETAIL 9/C-500
  14. INSTALL 24" MODIFIED TYPE 'F' REVERSE MOUNTABLE CURB AND GUTTER PER DETAIL 10/C-500
  15. TRANSITION FROM 24" MODIFIED TYPE 'F' MOUNTABLE CURB AND GUTTER TO 24" MODIFIED TYPE 'F' REVERSE PAN MOUNTABLE CURB AND GUTTER
  16. INSTALL HANDICAP ACCESSIBLE RAMP PER APWA PLAN NO. 236.3
  17. INSTALL HANDICAP ACCESSIBLE RAMP PER APWA PLAN NO. 236.1
  18. INSTALL 24" COLLECTION CURB AND GUTTER PER DETAIL 11/C-500
  19. INSTALL 24" REVERSE PAN CURB AND GUTTER PER DETAIL 12/C-500
  20. TRANSITION FROM 24" COLLECTION CURB AND GUTTER TO 24" REVERSE PAN CURB AND GUTTER
  21. INSTALL CLASS 2 TRAIL PER DETAIL 1/C-501
  22. INSTALL CLASS 3 TRAIL PER DETAIL 2/C-501



**ENSIGN**  
THE STANDARD IN ENGINEERING

**LAYTON**  
919 North 400 West  
Layton, UT 84041  
Phone: 801.547.1100

**SANDY**  
Phone: 801.255.0529

**TOOELE**  
Phone: 435.843.3590

**CEDAR CITY**  
Phone: 435.865.1453

**RICHFIELD**  
Phone: 435.896.2983

[WWW.ENSIGNENG.COM](http://WWW.ENSIGNENG.COM)

FOR:  
NILSON HOMES  
1740 COMBE RD, SUITE 2  
SOUTH OGDEN, UT 84403

CONTACT:  
STEVE ANDERSON  
PHONE: 801.392.8100

**THE ORCHARDS AT JDC RANCH  
PHASE 1  
2800 WEST 2600 NORTH STREET  
WEBER COUNTY, UTAH**

PROFESSIONAL ENGINEER  
No. 10234838-2202  
10-9-23  

NO. DATE REVISION FOR REVIEW

**SITE PLAN**

PROJECT NUMBER 9872 PRINT DATE 2023-10-09  
PROJECT MANAGER CP DESIGNED BY TS

**C-100**






**BENCHMARK**  
 NORTHWEST CORNER OF SECTION 27  
 TOWNSHIP 7 NORTH, RANGE 2 WEST  
 SALT LAKE BASE AND MERIDIAN  
 ELEV = 4231.00'

**GENERAL NOTES**

1. ALL WORK TO COMPLY WITH THE GOVERNING AGENCY'S STANDARDS AND SPECIFICATIONS.
2. ALL IMPROVEMENTS MUST COMPLY WITH ADA STANDARDS AND RECOMMENDATIONS.
3. ALL WORK SHALL COMPLY WITH THE RECOMMENDATIONS OF THE GEOTECHNICAL ENGINEER POSSIBLY INCLUDING, BUT NOT LIMITED TO, REMOVAL OF UNCONSOLIDATED FILL, ORGANICS, AND DEBRIS, PLACEMENT OF SUBSURFACE DRAIN LINES AND GEOTEXTILE, AND OVEREXCAVATION OF UNSUITABLE BEARING MATERIALS AND PLACEMENT OF ACCEPTABLE FILL MATERIAL.
4. THE CONTRACTOR SHALL BECOME FAMILIAR WITH THE EXISTING SOIL CONDITIONS.
5. LANDSCAPED AREAS REQUIRE SUBGRADE TO BE MAINTAINED AT A SPECIFIC ELEVATION BELOW FINISHED GRADE AND REQUIRE SUBGRADE TO BE PROPERLY PREPARED AND SCARIFIED. SEE LANDSCAPE PLANS FOR ADDITIONAL INFORMATION.
6. SLOPE ALL LANDSCAPED AREAS AWAY FROM BUILDING FOUNDATIONS TOWARD CURB AND GUTTER OR STORM DRAIN INLETS.
7. EXISTING UNDERGROUND UTILITIES AND IMPROVEMENTS ARE SHOWN IN THEIR APPROXIMATE LOCATIONS BASED UPON RECORD INFORMATION AVAILABLE AT THE TIME OF PREPARATION OF THESE PLANS. LOCATIONS MAY NOT HAVE BEEN VERIFIED IN THE FIELD AND NO GUARANTEE IS MADE AS TO THE ACCURACY OR COMPLETENESS OF THE INFORMATION SHOWN. IT SHALL BE THE RESPONSIBILITY OF THE CONTRACTOR TO DETERMINE THE EXISTENCE AND LOCATION OF THE UTILITIES SHOWN ON THESE PLANS OR INDICATED IN THE FIELD BY LOCATING SERVICES. ANY ADDITIONAL COSTS INCURRED AS A RESULT OF THE CONTRACTOR'S FAILURE TO VERIFY THE LOCATIONS OF EXISTING UTILITIES PRIOR TO THE BEGINNING OF CONSTRUCTION IN THEIR VICINITY SHALL BE BORNE BY THE CONTRACTOR AND ASSUMED INCLUDED IN THE CONTRACT. THE CONTRACTOR IS TO VERIFY ALL CONNECTION POINTS WITH THE EXISTING UTILITIES. THE CONTRACTOR IS RESPONSIBLE FOR ANY DAMAGE CAUSED TO THE EXISTING UTILITIES AND UTILITY STRUCTURES THAT ARE TO REMAIN. IF CONFLICTS WITH EXISTING UTILITIES OCCUR, THE CONTRACTOR SHALL NOTIFY THE ENGINEER PRIOR TO CONSTRUCTION TO DETERMINE IF ANY FIELD ADJUSTMENTS SHOULD BE MADE.
8. ALL STORM DRAIN INFRASTRUCTURE TO BE INSTALLED PER GOVERNING AGENCY OR APWA STANDARD PLANS AND SPECIFICATIONS.
9. ENSURE MINIMUM COVER OVER ALL STORM DRAIN PIPES PER MANUFACTURER'S RECOMMENDATIONS. NOTIFY ENGINEER IF MINIMUM COVER CANNOT BE ATTAINED.
10. THE CONTRACTOR SHALL ADJUST TO GRADE ALL EXISTING UTILITIES AS NEEDED PER LOCAL GOVERNING AGENCY'S STANDARDS AND SPECIFICATIONS.
11. NOTIFY ENGINEER OF ANY DISCREPANCIES IN DESIGN OR STAKING BEFORE PLACING CONCRETE, ASPHALT, OR STORM DRAIN STRUCTURES OR PIPES.
12. THE CONTRACTOR IS TO PROTECT AND PRESERVE ALL EXISTING IMPROVEMENTS, UTILITIES, AND SIGNS, ETC. UNLESS OTHERWISE NOTED ON THESE PLANS.

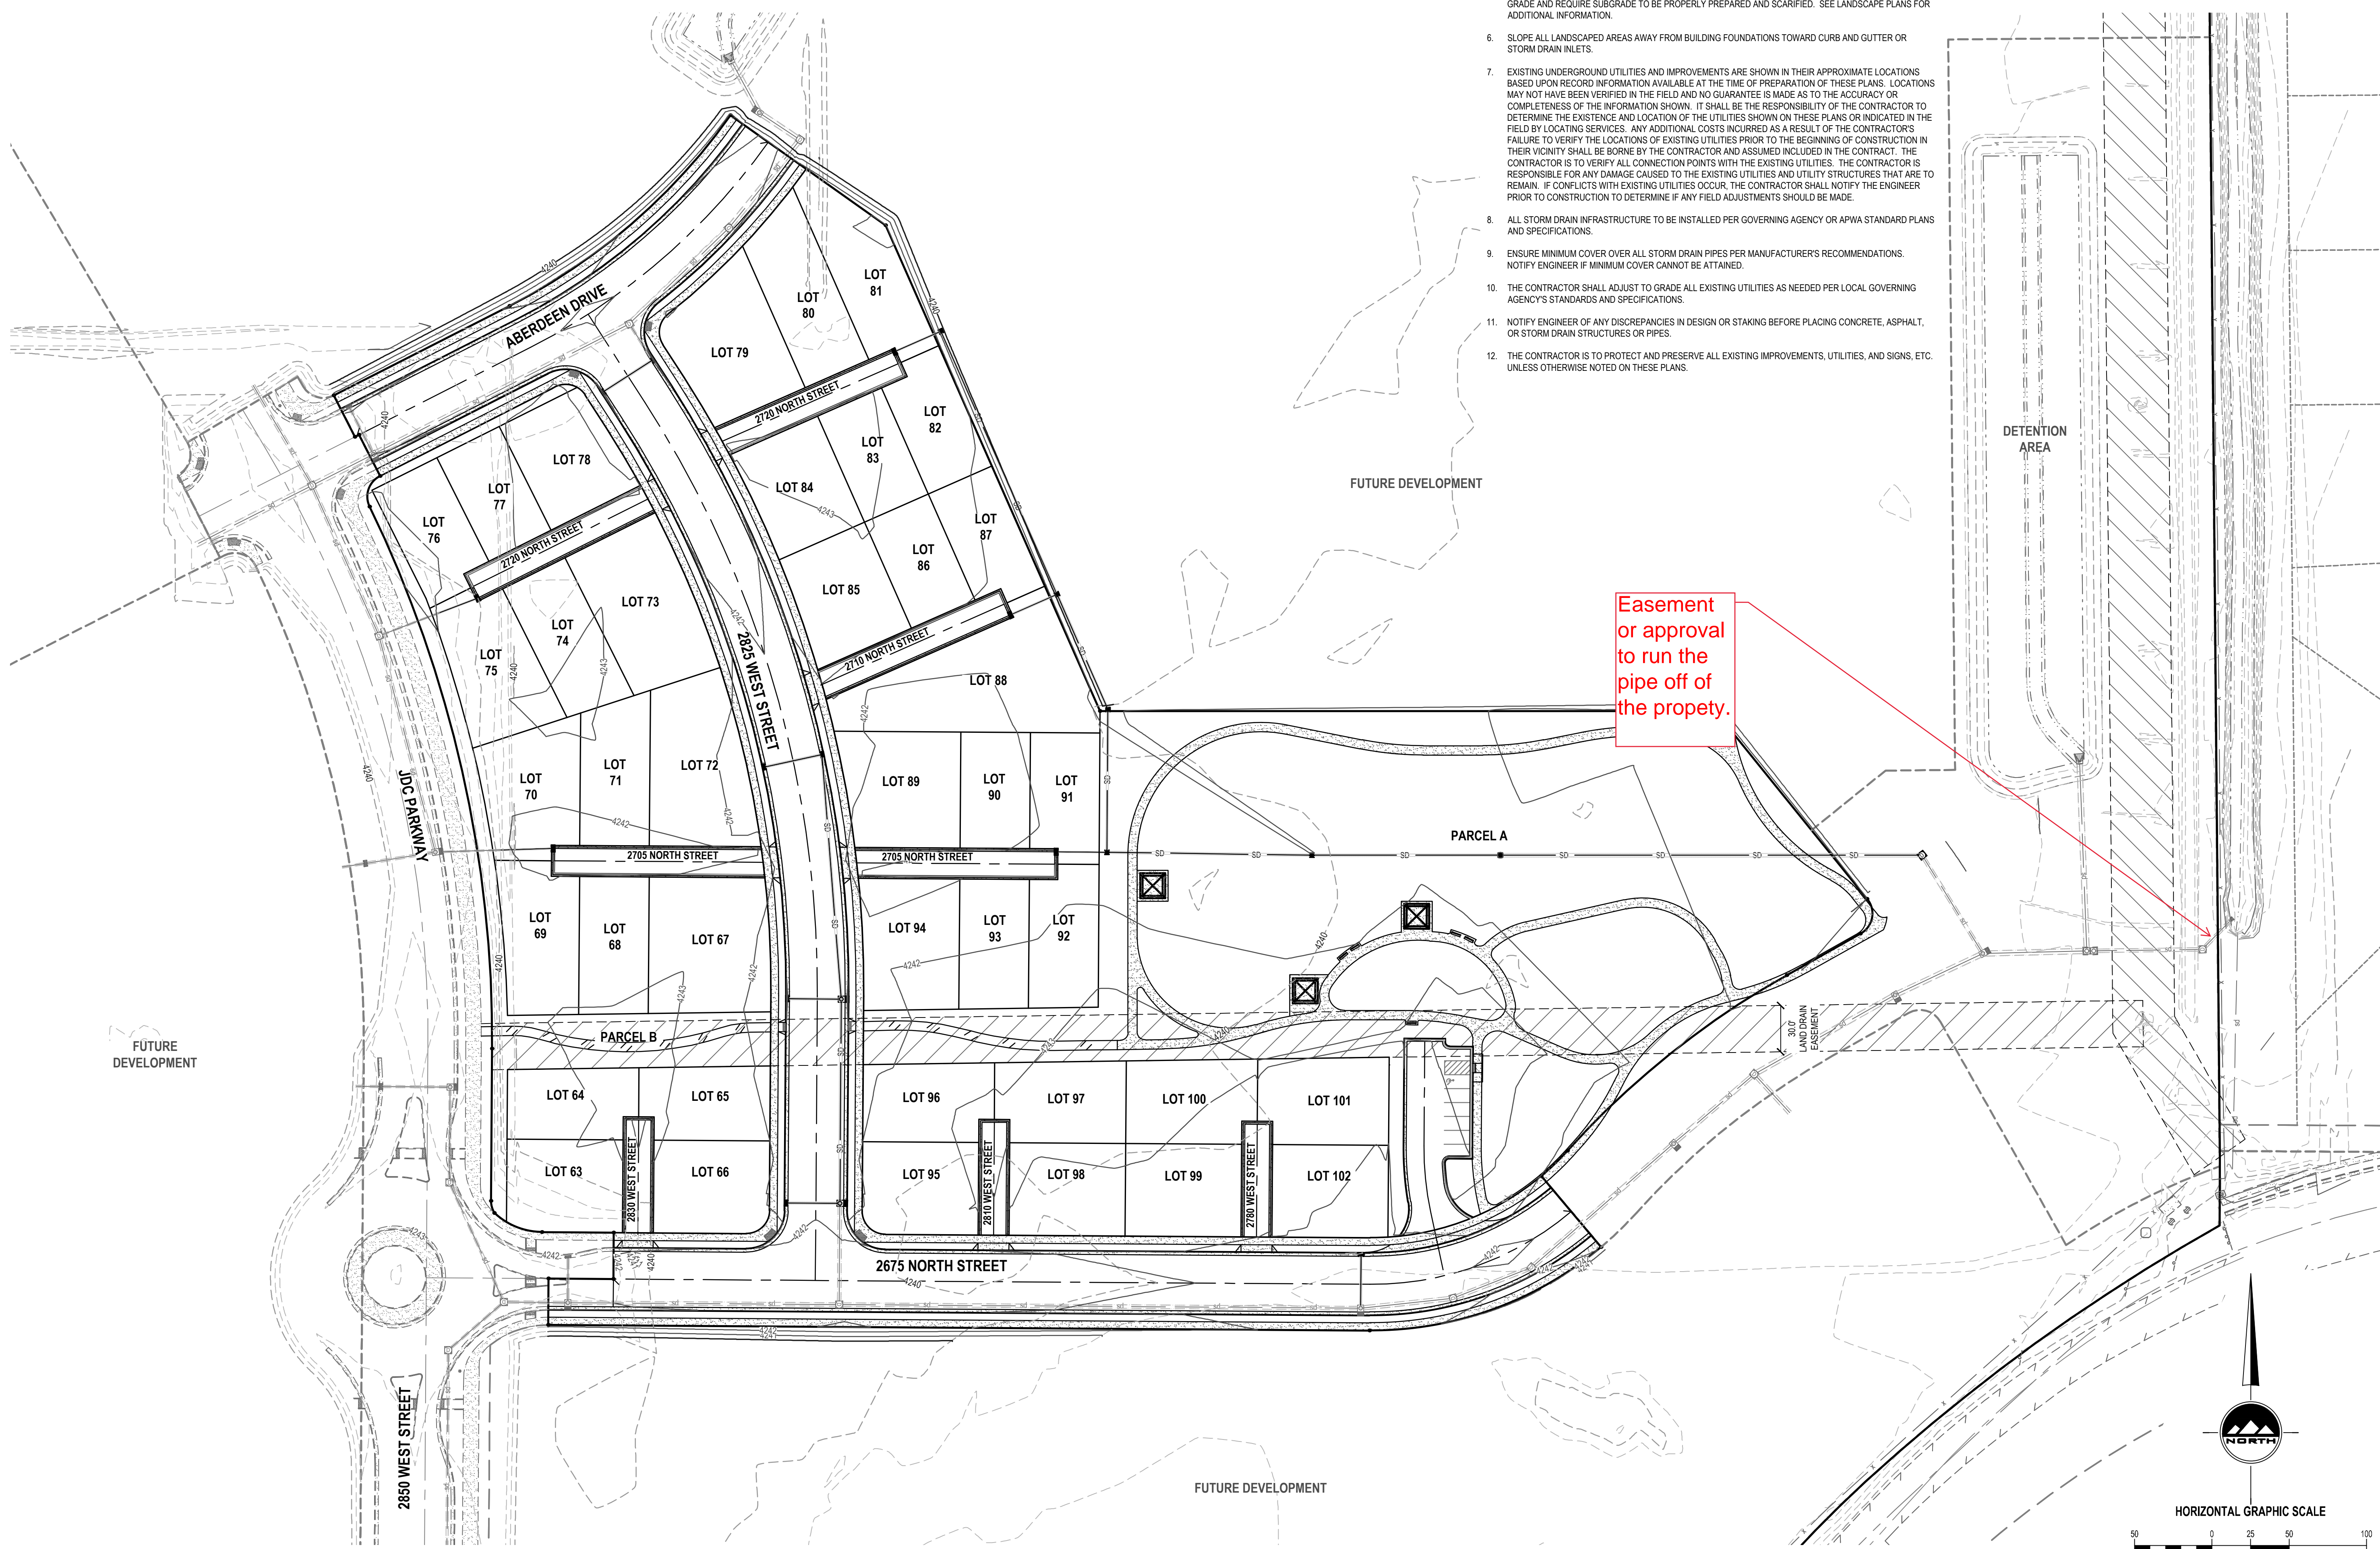

**ENSIGN**  
 THE STANDARD IN ENGINEERING

**LAYTON**  
 919 North 400 West  
 Layton, UT 84041  
 Phone: 801.547.1100

**SANDY**  
 Phone: 801.255.0529

**TOOELE**  
 Phone: 435.843.3590

**CEDAR CITY**  
 Phone: 435.865.1453

**RICHFIELD**  
 Phone: 435.896.2983

**WWW.ENSIGNENG.COM**

FOR:  
 NILSON HOMES  
 1740 COMBE RD, SUITE 2  
 SOUTH OGDEN, UT 84403

CONTACT:  
 STEVE ANDERSON  
 PHONE: 801.392.8100

**THE ORCHARDS AT JDC RANCH**  
**PHASE 1**  
 2800 WEST 2600 NORTH STREET  
 WEBER COUNTY, UTAH




NO. DATE REVISION FOR REVIEW

**OVERALL GRADING AND DRAINAGE PLAN**

PROJECT NUMBER 9872 PRINT DATE 2023-10-09  
 PROJECT MANAGER CP DESIGNED BY TS


**C-200**

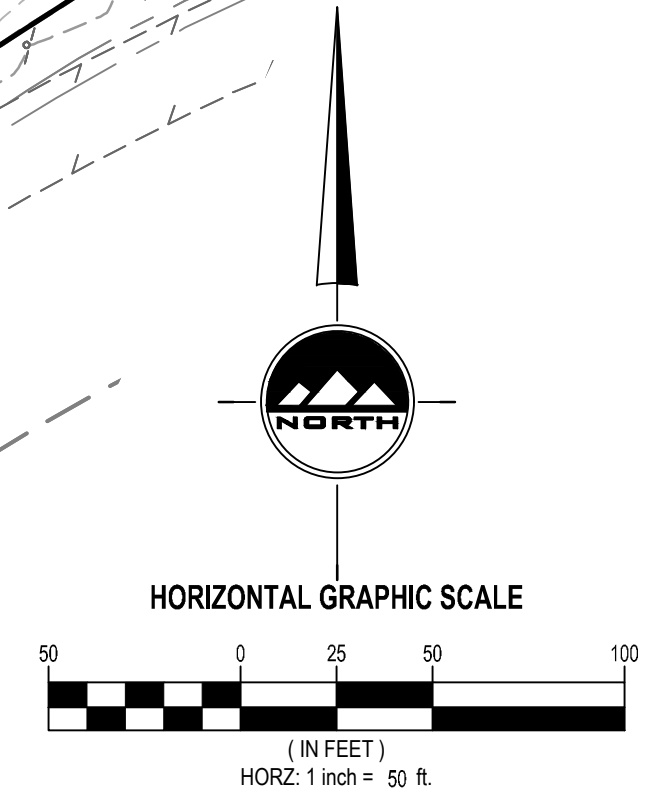



**811**  
Know what's below.  
Call before you dig.

**BENCHMARK**  
NORTHWEST CORNER OF SECTION 27  
TOWNSHIP 7 NORTH, RANGE 2 WEST  
SALT LAKE BASE AND MERIDIAN  
ELEV = 4231.00'

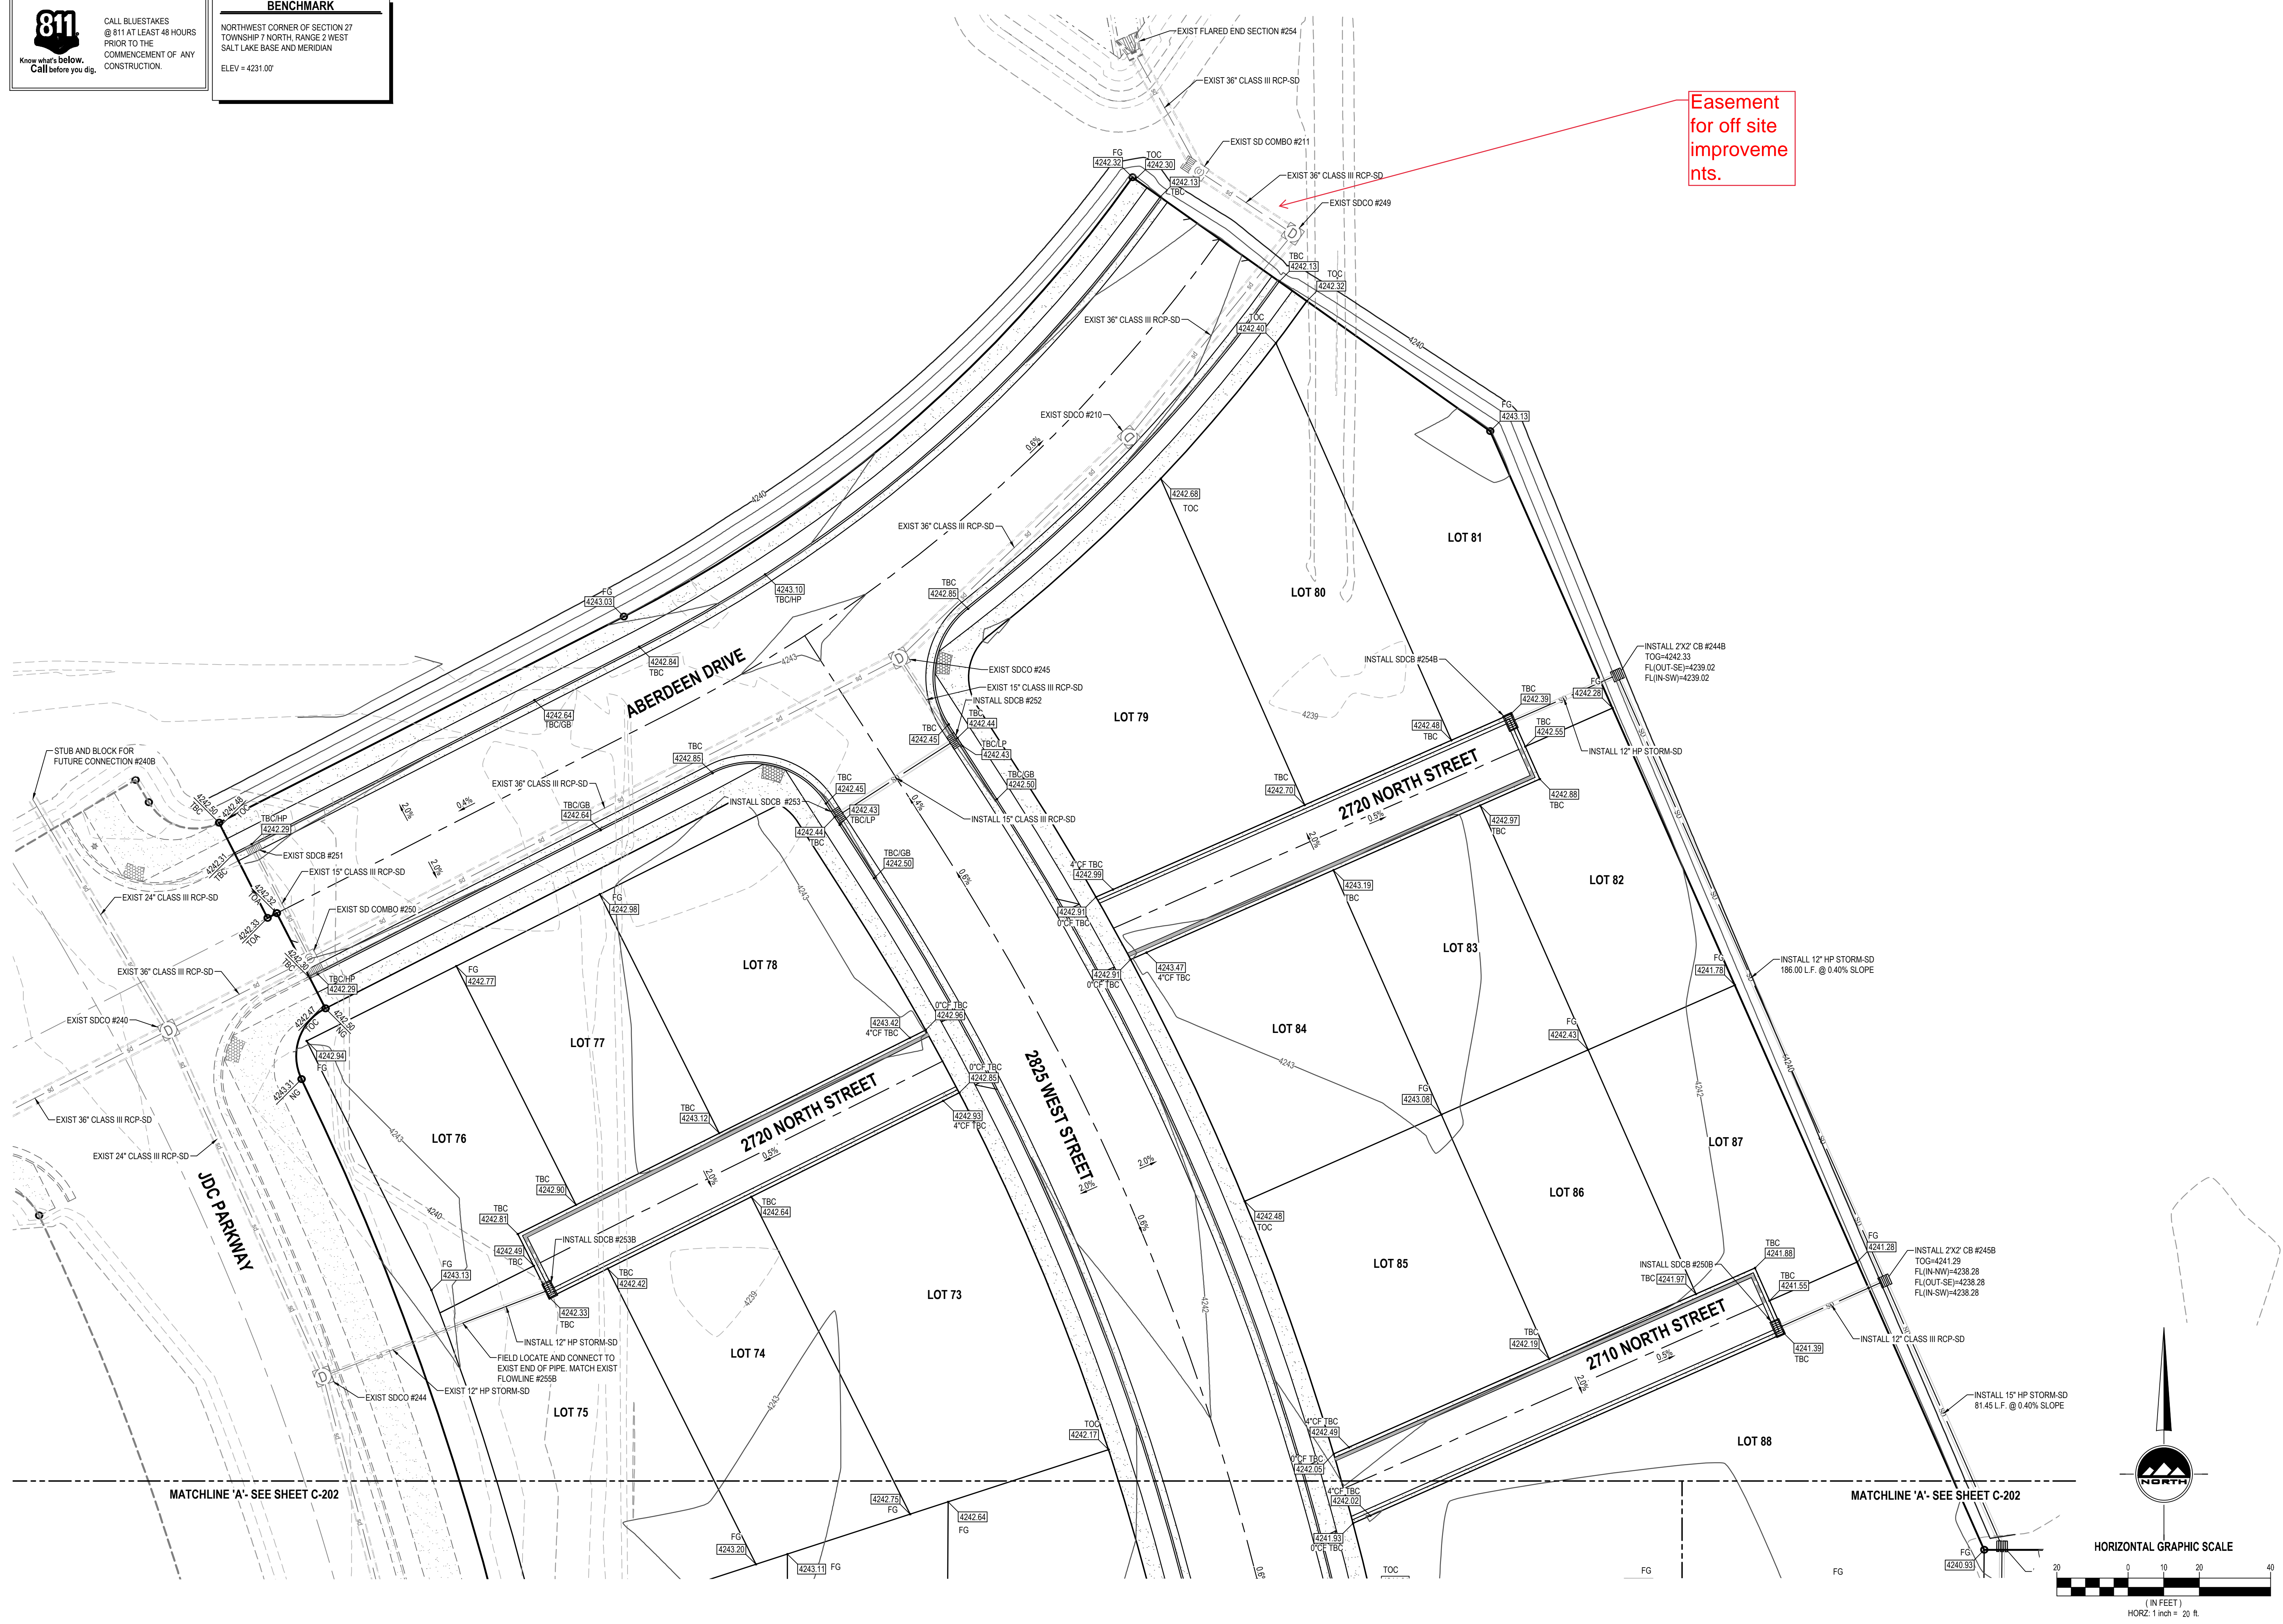

Easement  
for off site  
improvements.

**ENSIGN**  
THE STANDARD IN ENGINEERING

LAYTON  
919 North 400 West  
Layton, UT 84041  
Phone: 801.547.1100

SANDY  
Phone: 801.255.0529

TOOELE  
Phone: 435.843.3590

CEDAR CITY  
Phone: 435.865.1453


RICHFIELD  
Phone: 435.896.2983

WWW.ENSIGNENG.COM

FOR:  
NILSON HOMES  
1740 COMBE RD, SUITE 2  
SOUTH OGDEN, UT 84403

CONTACT:  
STEVE ANDERSON  
PHONE: 801.392.8100

**THE ORCHARDS AT JDC RANCH**  
**PHASE 1**  
2800 WEST 2600 NORTH STREET  
WEBER COUNTY, UTAH

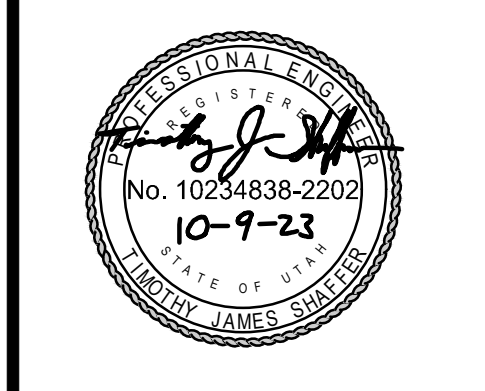



NO. DATE REVISION FOR REVIEW

**GRADING AND DRAINAGE PLAN**

PROJECT NUMBER 9872  
PROJECT MANAGER CP

PRINT DATE 2023-10-09  
DESIGNED BY TS

**C-201**

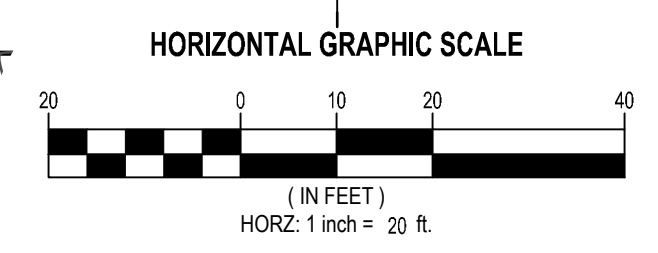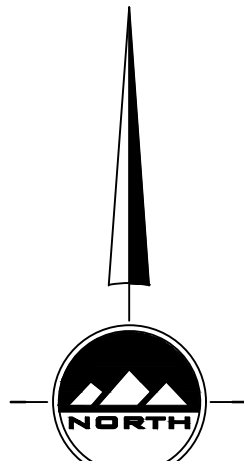

MATCHLINE 'A' - SEE SHEET C-202

MATCHLINE 'A' - SEE SHEET C-202



**811**  
Know what's below.  
Call before you dig.

**BENCHMARK**  
NORTHWEST CORNER OF SECTION 27  
TOWNSHIP 7 NORTH, RANGE 2 WEST  
SALT LAKE BASE AND MERIDIAN  
ELEV = 4231.00'

**ENSIGN**  
THE STANDARD IN ENGINEERING

**LAYTON**  
919 North 400 West  
Layton, UT 84041  
Phone: 801.547.1100

**SANDY**  
Phone: 801.255.0529

**TOEELE**  
Phone: 435.843.3590

**CEDAR CITY**  
Phone: 435.865.1453

**RICHFIELD**  
Phone: 435.896.2983

**WWW.ENSIGNENG.COM**

FOR:  
NILSON HOMES  
1740 COMBE RD, SUITE 2  
SOUTH OGDEN, UT 84403

CONTACT:  
STEVE ANDERSON  
PHONE: 801.392.8100

**THE ORCHARDS AT JDC RANCH**  
**PHASE 1**  
2800 WEST 2600 NORTH STREET  
WEBER COUNTY, UTAH




NO. DATE REVISION FOR REVIEW

**GRADING AND DRAINAGE PLAN**

PROJECT NUMBER: 9872  
PRINT DATE: 2023-10-09  
PROJECT MANAGER: CP  
DESIGNED BY: TS

**C-202**

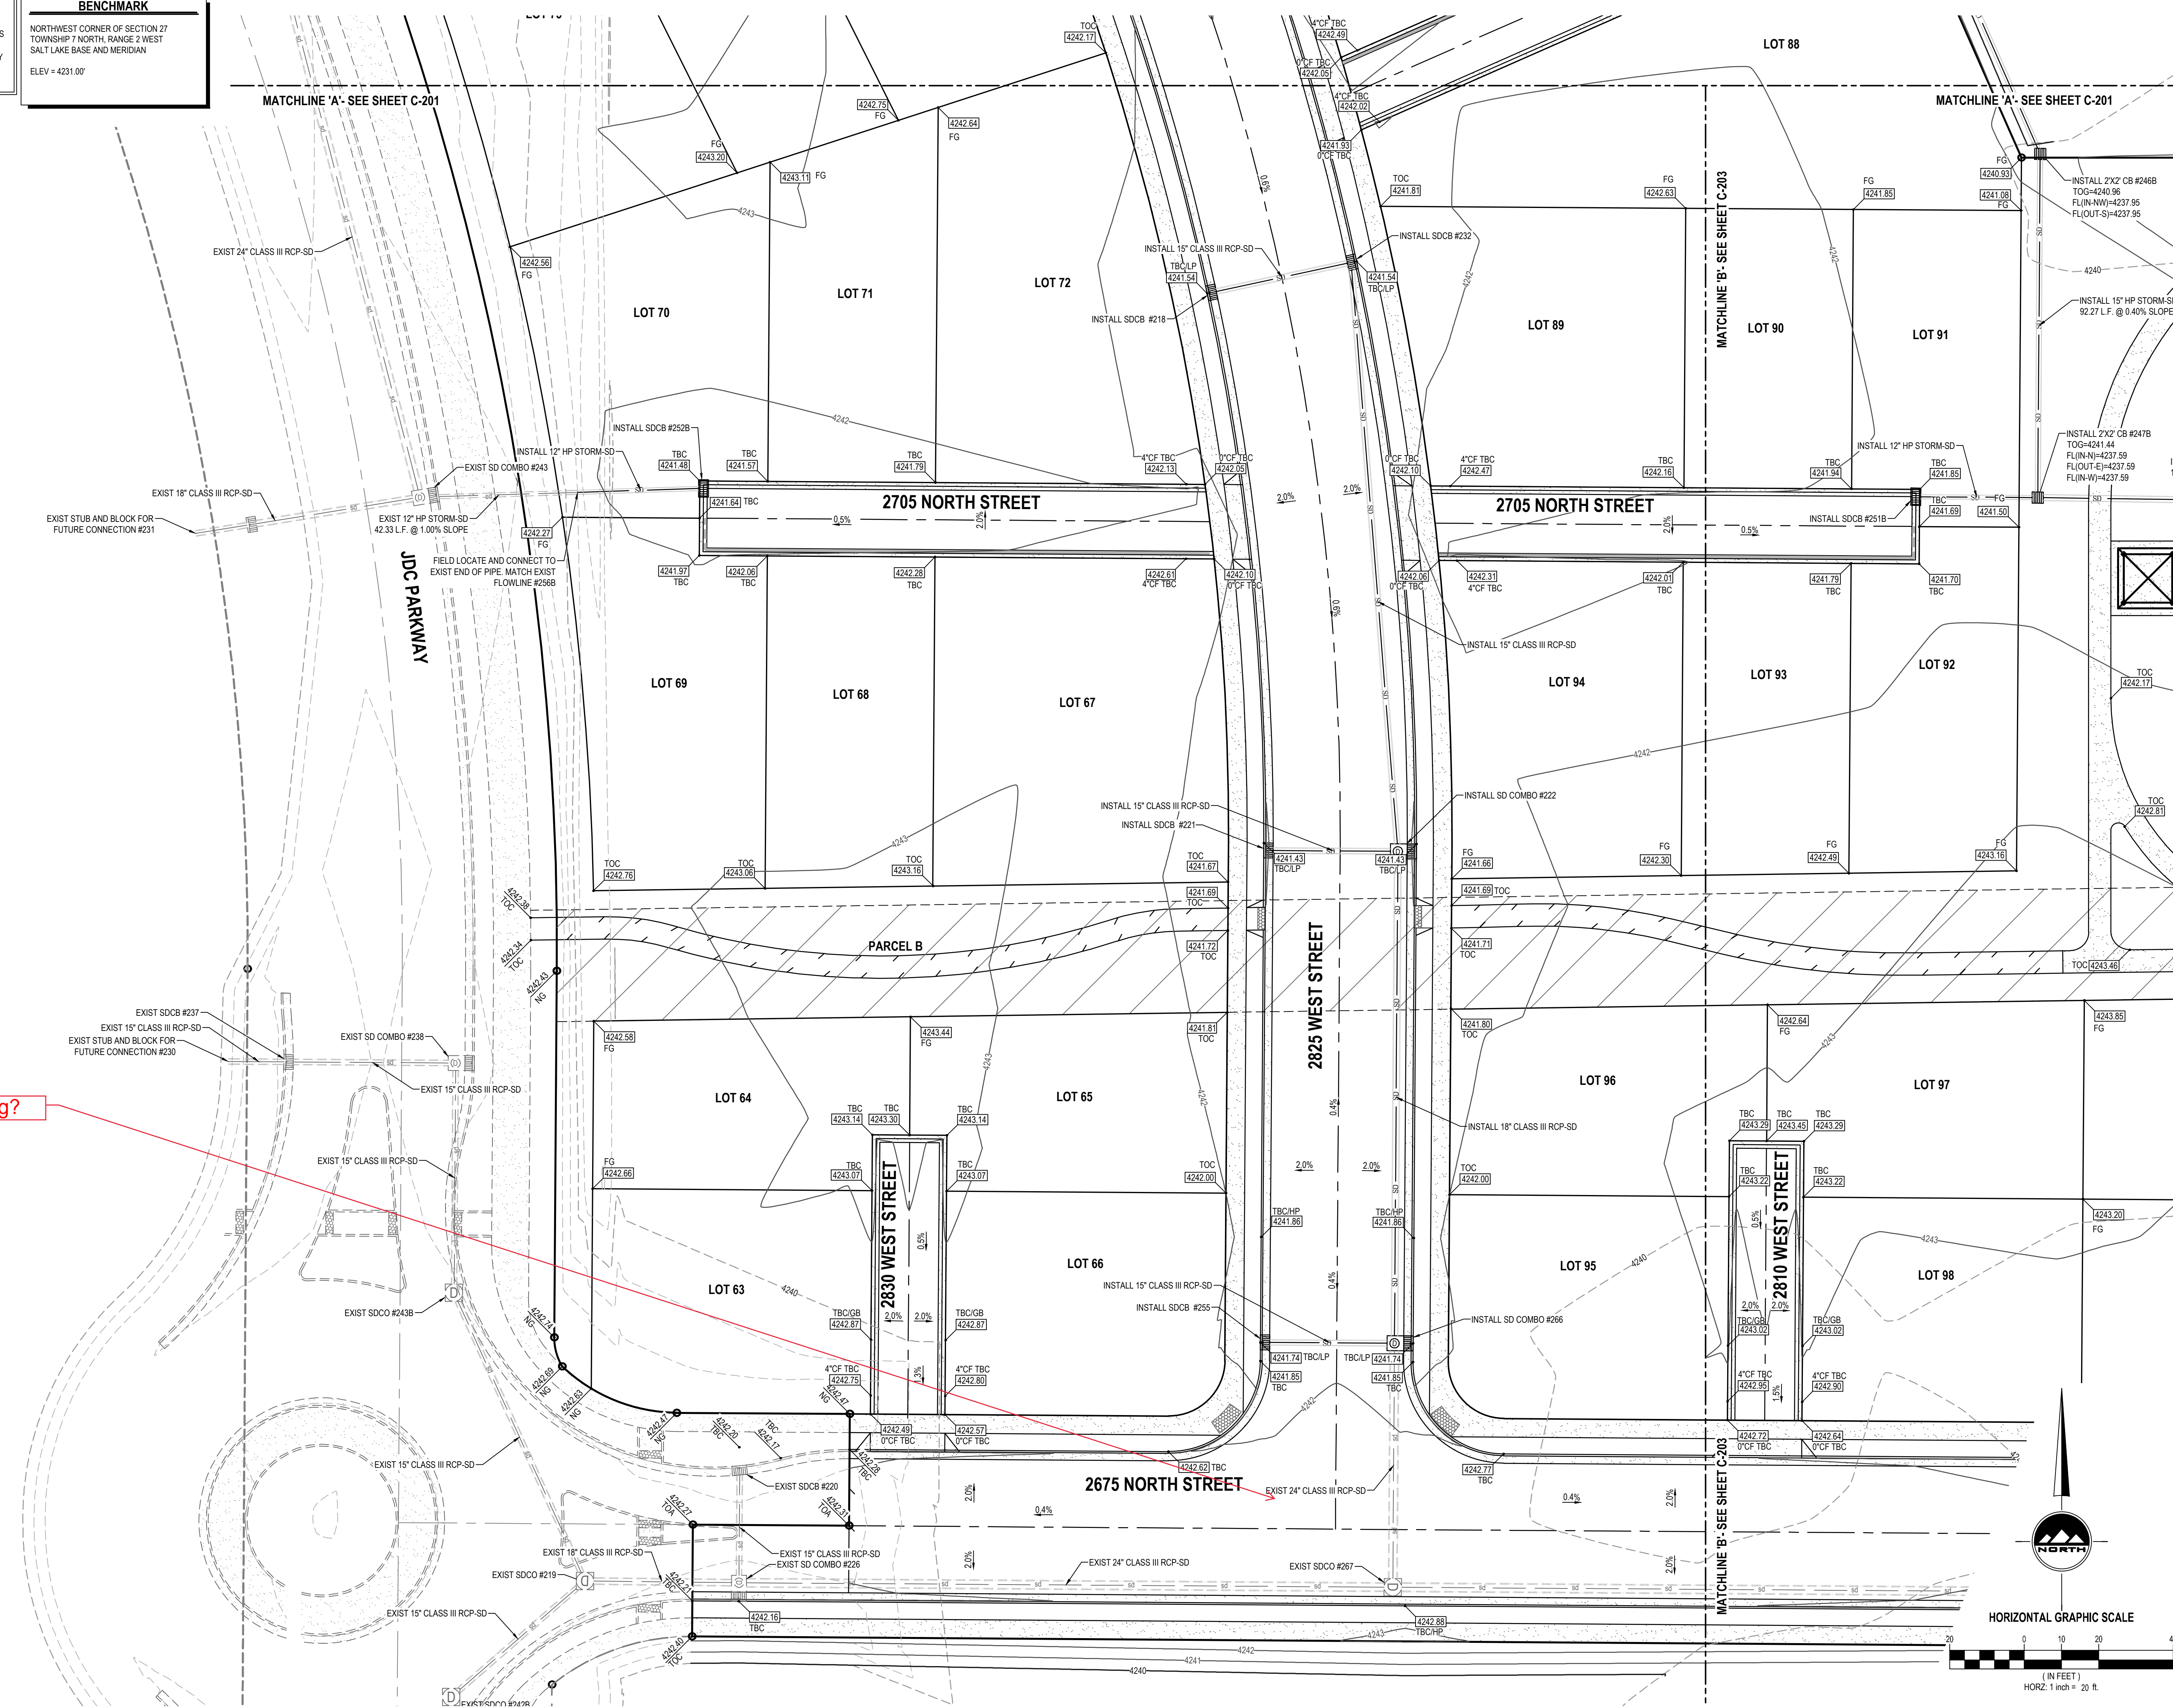


Existing?



**811**  
Know what's below.  
Call before you dig.

**BENCHMARK**  
NORTHWEST CORNER OF SECTION 27  
TOWNSHIP 7 NORTH, RANGE 2 WEST  
SALT LAKE BASE AND MERIDIAN  
ELEV = 4231.00'

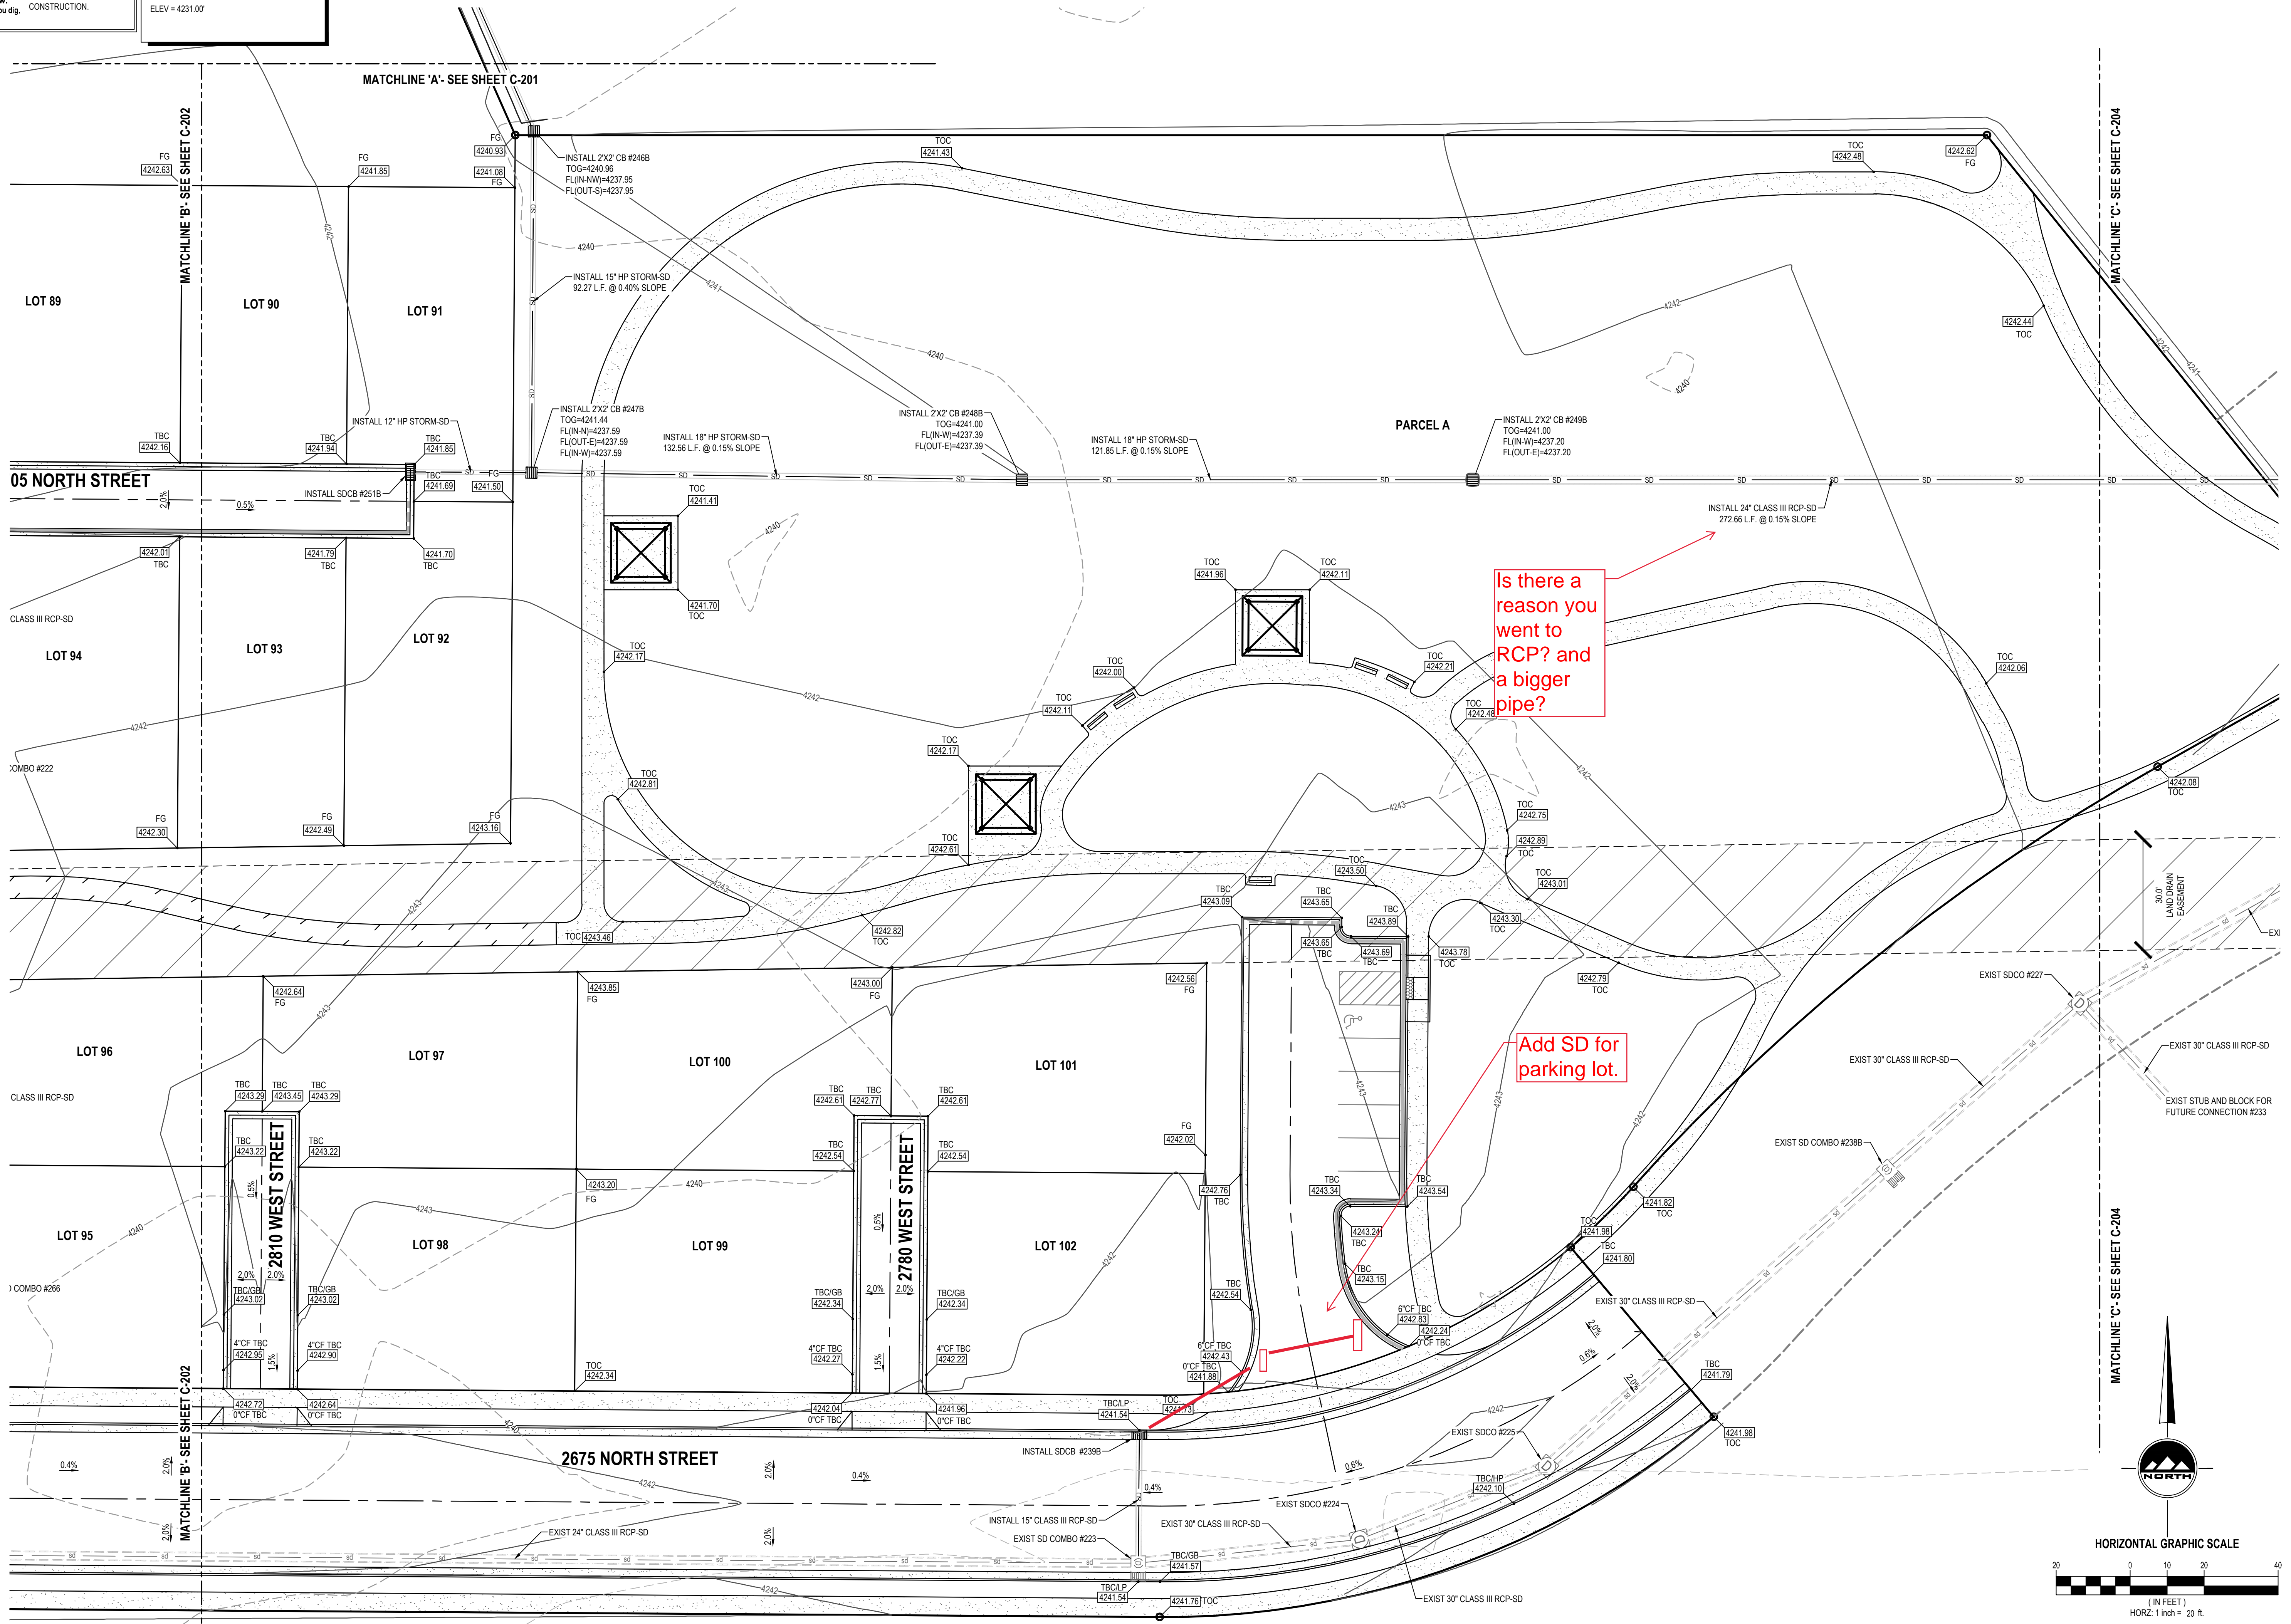

**ENSIGN**  
THE STANDARD IN ENGINEERING

**LAYTON**  
919 North 400 West  
Layton, UT 84041  
Phone: 801.547.1100

**SANDY**  
Phone: 801.255.0529

**TOOELE**  
Phone: 435.843.3590

**CEDAR CITY**  
Phone: 435.865.1453

**RICHFIELD**  
Phone: 435.896.2983

**WWW.ENSIGNENG.COM**

FOR:  
NILSON HOMES  
1740 COMBE RD, SUITE 2  
SOUTH OGDEN, UT 84403

CONTACT:  
STEVE ANDERSON  
PHONE: 801.392.8100

**THE ORCHARDS AT JDC RANCH**  
**PHASE 1**  
**2800 WEST 2600 NORTH STREET**  
**WEBER COUNTY, UTAH**




NO. DATE REVISION FOR REVIEW

**GRADING AND DRAINAGE PLAN**

PROJECT NUMBER 9872 PRINT DATE 2023-10-09  
PROJECT MANAGER CP DESIGNED BY TS

**C-203**

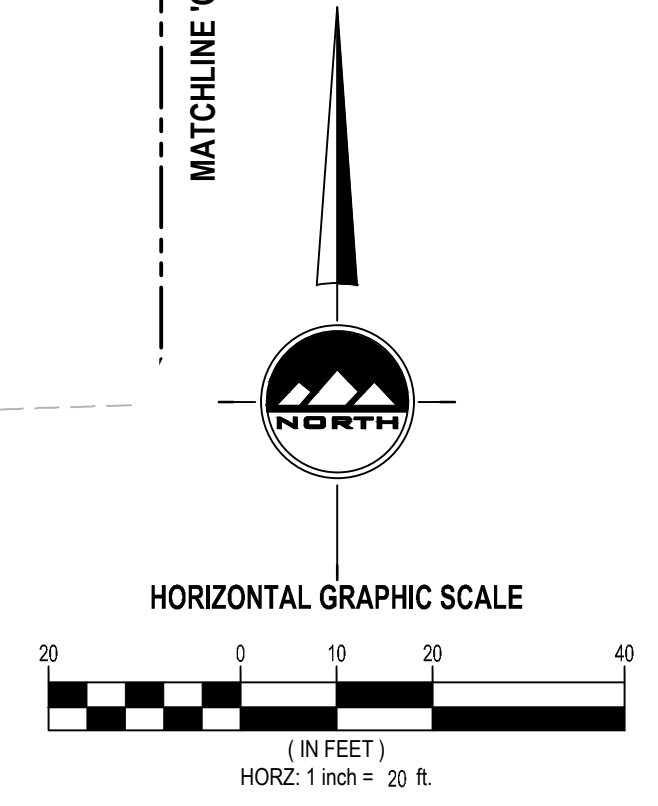



**811**  
Know what's below.  
Call before you dig.

**BENCHMARK**  
NORTHWEST CORNER OF SECTION 27  
TOWNSHIP 7 NORTH, RANGE 2 WEST  
SALT LAKE BASE AND MERIDIAN  
ELEV = 4231.00'

**ENSIGN**  
THE STANDARD IN ENGINEERING

**LAYTON**  
919 North 400 West  
Layton, UT 84041  
Phone: 801.547.1100

**SANDY**  
Phone: 801.255.0529

**TOOELE**  
Phone: 435.843.3590

**CEDAR CITY**  
Phone: 435.865.1453


**RICHFIELD**  
Phone: 435.896.2983

**WWW.ENSIGNENG.COM**

FOR:  
NILSON HOMES  
1740 COMBE RD, SUITE 2  
SOUTH OGDEN, UT 84403

CONTACT:  
STEVE ANDERSON  
PHONE: 801.392.8100

**THE ORCHARDS AT JDC RANCH**  
**PHASE 1**  
2800 WEST 2600 NORTH STREET  
WEBER COUNTY, UTAH

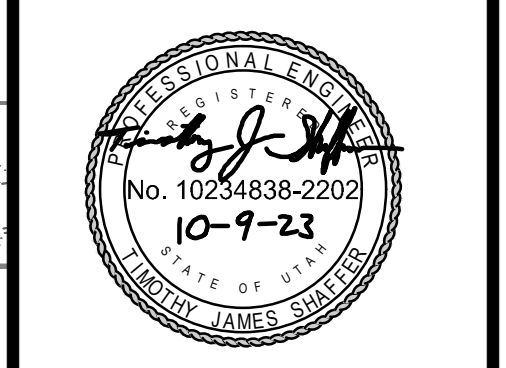


NO. DATE REVISION FOR REVIEW

**GRADING AND DRAINAGE PLAN**

PROJECT NUMBER 9872 PRINT DATE 2023-10-09  
PROJECT MANAGER CP DESIGNED BY TS


**C-204**

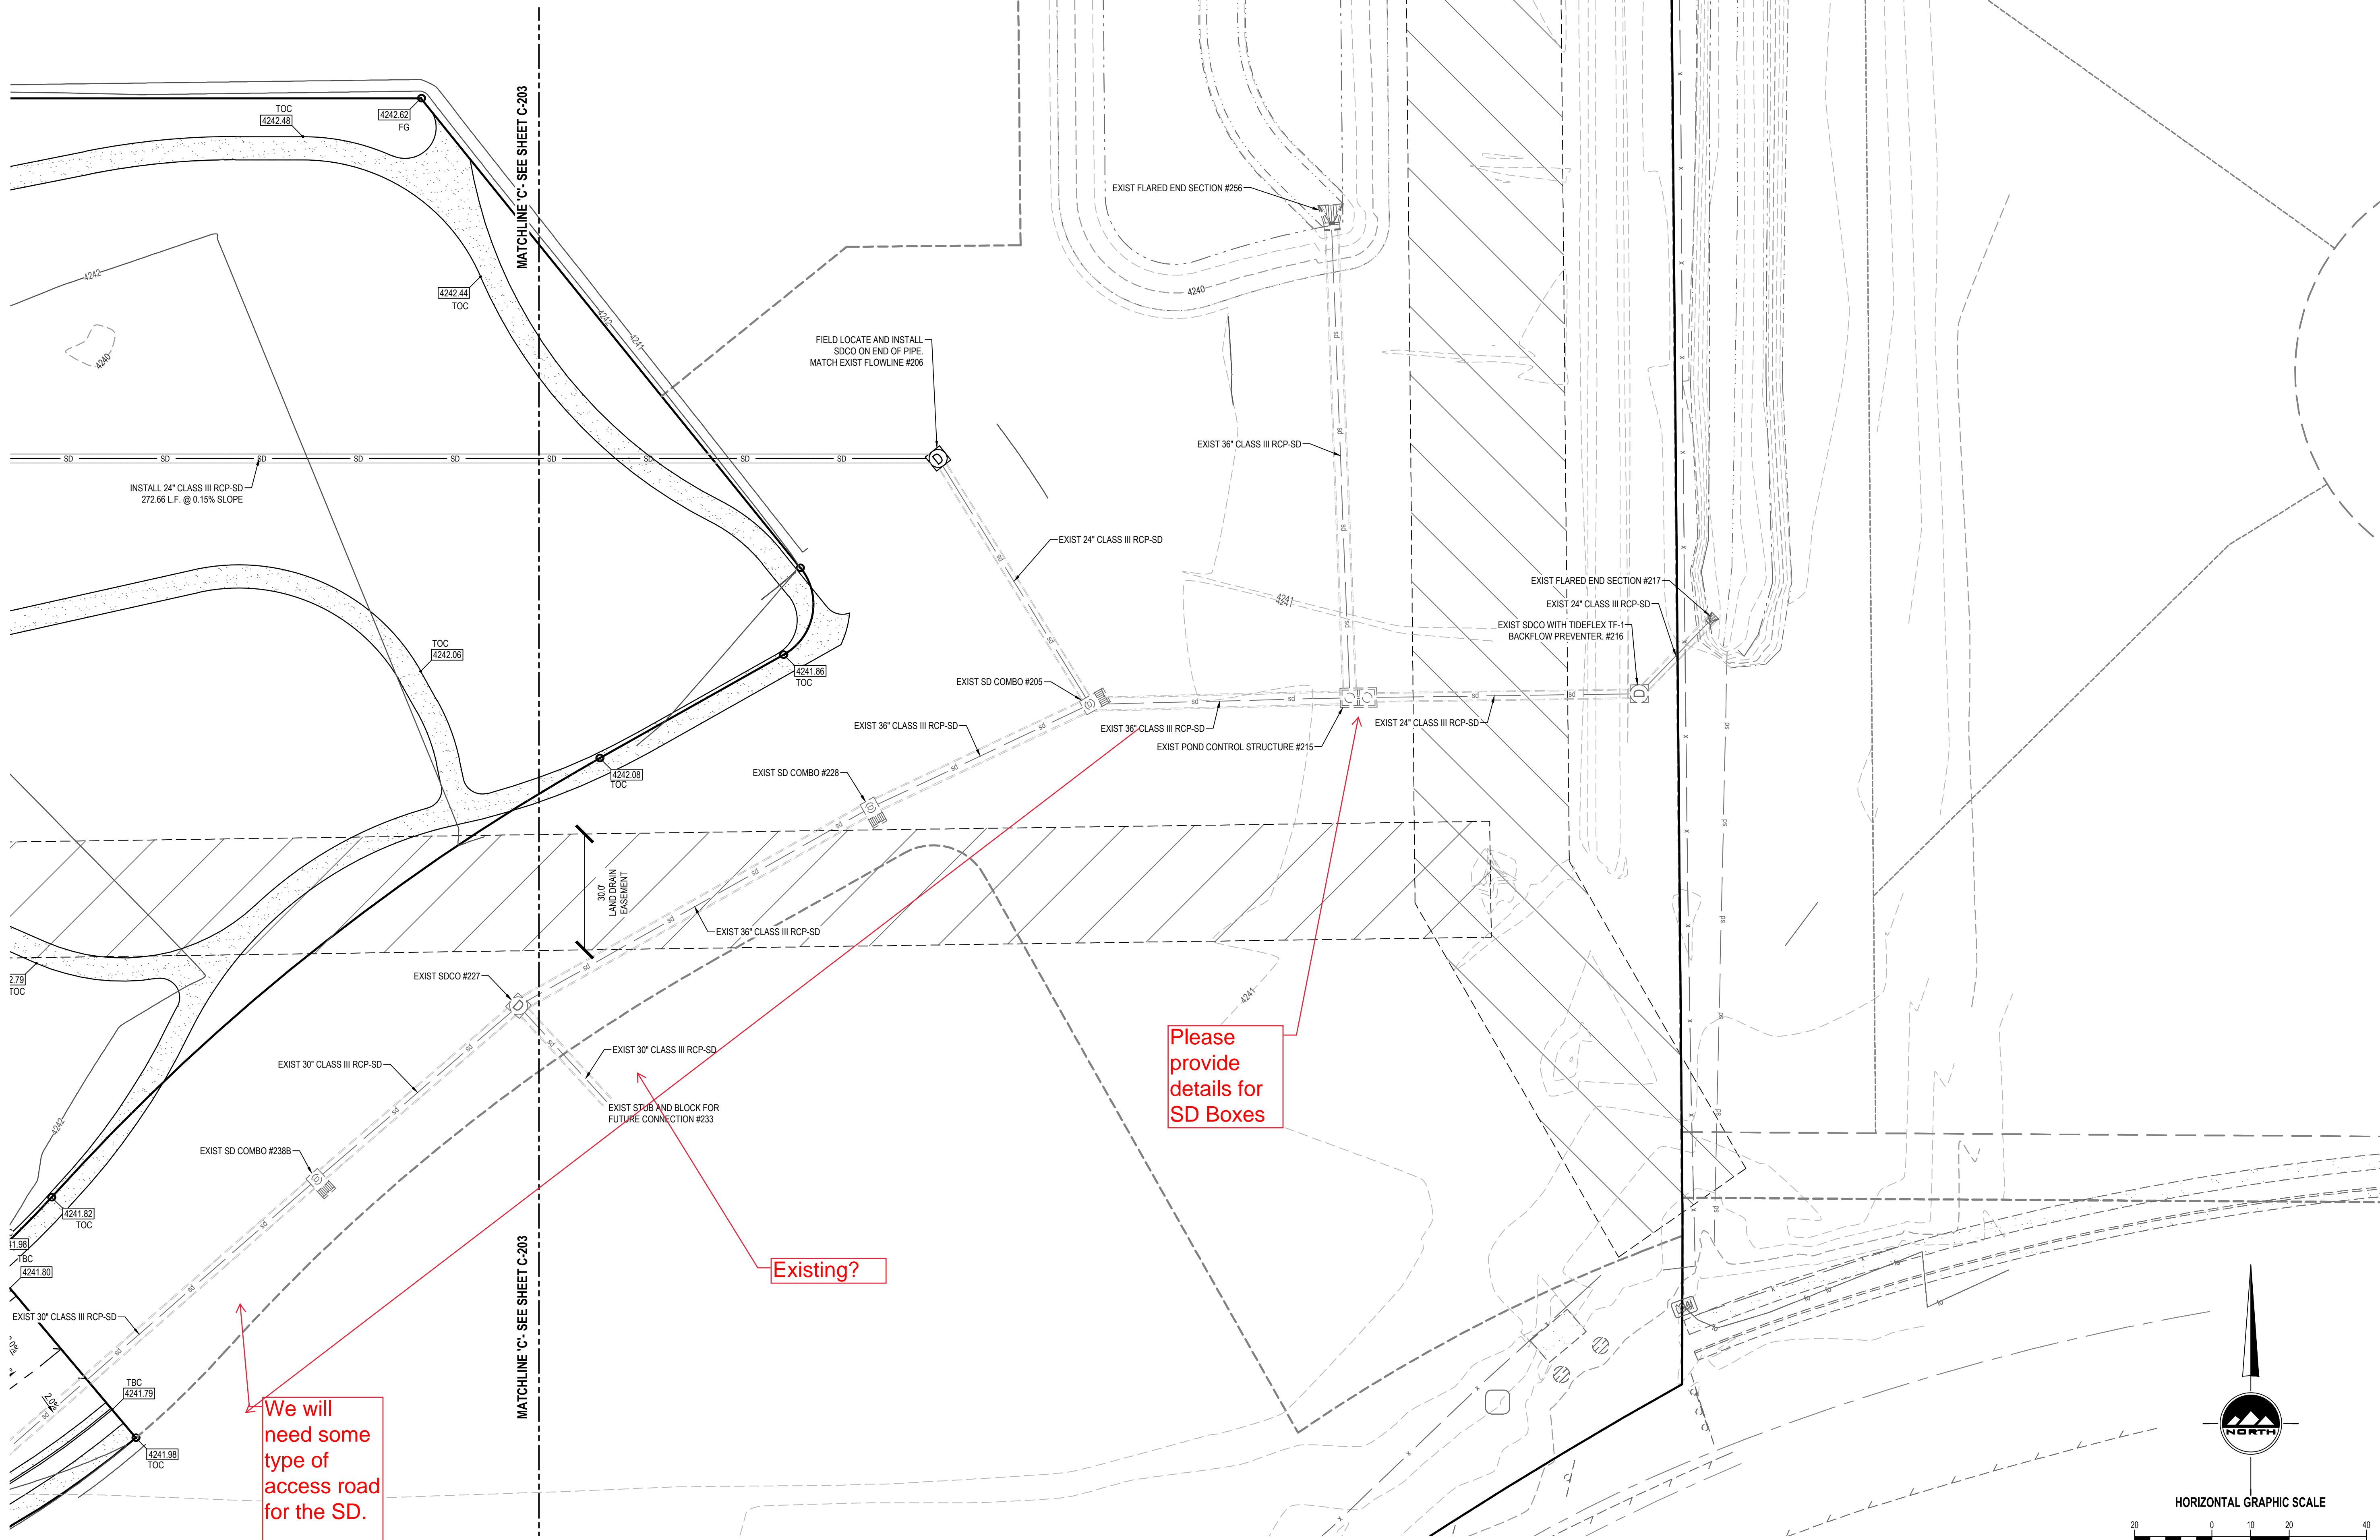

We will need some type of access road for the SD.

Existing?

Please provide details for SD Boxes

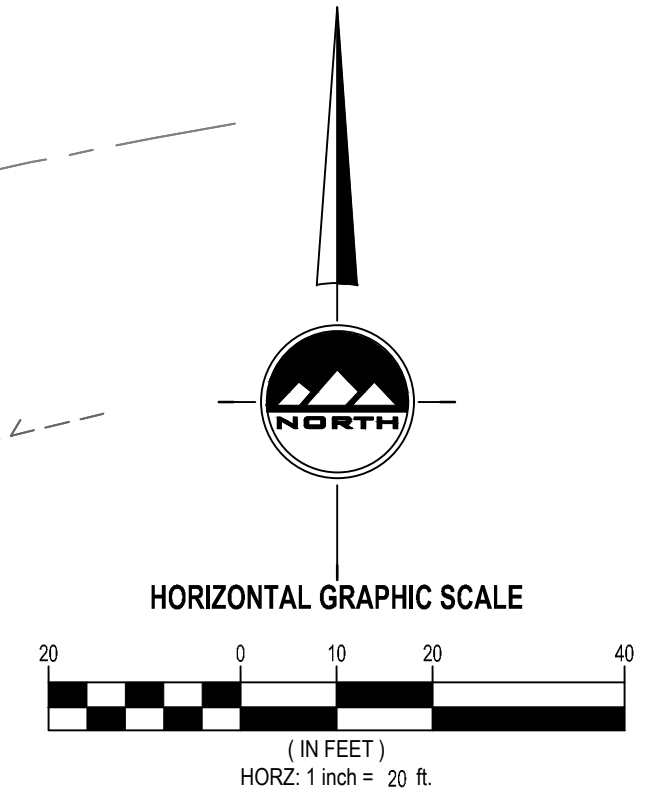



**811**  
Know what's below.  
Call before you dig.


CALL BLUESTAKES  
@ 811 AT LEAST 48 HOURS  
PRIOR TO THE  
COMMENCEMENT OF ANY  
CONSTRUCTION.

**BENCHMARK**

NORTHWEST CORNER OF SECTION 27  
TOWNSHIP 7 NORTH, RANGE 2 WEST  
SALT LAKE BASE AND MERIDIAN  
ELEV = 4231.00'

- SCOPE OF WORK:**  
PROVIDE, INSTALL AND/OR CONSTRUCT THE FOLLOWING PER THE SPECIFICATIONS GIVEN OR REFERENCED, THE DETAILS NOTED, AND/OR AS SHOWN ON THE CONSTRUCTION DRAWINGS:
1. INSTALL TYPICAL WATER CONNECTION PER BONA VISTA WATER IMPROVEMENT DISTRICT STANDARDS AND SPECIFICATIONS
  2. INSTALL 4" SANITARY SEWER SERVICE LATERAL @ 2.00% MINIMUM SLOPE PER PLAIN CITY STANDARDS AND SPECIFICATIONS.
  3. INSTALL 1-1/2" PVC DUAL TURNOUT SECONDARY WATER SERVICE LINE PER PINEVIEW WATER SYSTEMS STANDARDS AND SPECIFICATIONS.
  4. INSTALL 1" SECONDARY WATER SERVICE LINE PER PINEVIEW WATER SYSTEMS STANDARDS AND SPECIFICATIONS.
  5. INSTALL 8" C900 DR18 PVC CULINARY WATERLINE PER BONA VISTA WATER IMPROVEMENT STANDARDS AND SPECIFICATIONS
  6. INSTALL 8" C900 DR18 PVC "PURPLE" SECONDARY WATERLINE PER PINEVIEW WATER SYSTEMS STANDARDS AND SPECIFICATIONS
  7. FIELD LOCATE AND CONNECT TO EXISTING CULINARY WATERLINE PER BONA VISTA WATER IMPROVEMENT STANDARDS AND SPECIFICATIONS
  8. FIELD LOCATE AND CONNECT TO EXISTING SECONDARY WATERLINE PER PINEVIEW WATER SYSTEMS STANDARDS AND SPECIFICATIONS
  9. INSTALL FIRE HYDRANT AND VALVE PER BONA VISTA WATER IMPROVEMENT DISTRICT STANDARDS AND SPECIFICATIONS
  10. INSTALL STREET LIGHT PER PLAIN CITY STANDARDS AND SPECIFICATIONS. COORDINATE ALL PROPOSED STREET LIGHT LOCATIONS WITH PLAIN CITY AND THE STREET LIGHT INSTALLATION WITH ROCKY MOUNTAIN POWER.
  11. PLUG AND BLOCK FOR FUTURE CONNECTION
  12. INSTALL 2" POLY SECONDARY WATER SERVICE LINE PER PINEVIEW WATER SYSTEMS STANDARDS AND SPECIFICATIONS (TYP)
  13. EXISTING FIRE HYDRANT
  14. EXISTING STREET LIGHT
  15. EXISTING 8" C900 DR18 PVC CULINARY WATERLINE
  16. EXISTING 8" C900 DR18 PVC "PURPLE" SECONDARY WATERLINE
  17. INSTALL 2" BLOW-OFF
  18. INSTALL 4" C900 DR18 PVC PRIVATE CULINARY WATERLINE PER BONA VISTA STANDARDS AND SPECIFICATIONS
  19. INSTALL 2" TEMPORARY BLOW-OFF PER BONA VISTA STANDARDS AND SPECIFICATIONS

- GENERAL NOTES**
1. ALL WORK TO COMPLY WITH THE GOVERNING AGENCY'S STANDARDS AND SPECIFICATIONS.
  2. EXISTING UNDERGROUND UTILITIES AND IMPROVEMENTS ARE SHOWN IN THEIR APPROXIMATE LOCATIONS BASED UPON RECORD INFORMATION AVAILABLE AT THE TIME OF PREPARATION OF THESE PLANS. LOCATIONS MAY NOT HAVE BEEN VERIFIED IN THE FIELD AND NO GUARANTEE IS MADE AS TO THE ACCURACY OR COMPLETENESS OF THE INFORMATION SHOWN. IT SHALL BE THE RESPONSIBILITY OF THE CONTRACTOR TO DETERMINE THE EXISTENCE AND LOCATION OF THE UTILITIES SHOWN ON THESE PLANS OR INDICATED IN THE FIELD BY LOCATING SERVICES. ANY ADDITIONAL COSTS INCURRED AS A RESULT OF THE CONTRACTOR'S FAILURE TO VERIFY THE LOCATIONS OF EXISTING UTILITIES PRIOR TO THE BEGINNING OF CONSTRUCTION IN THEIR VICINITY SHALL BE BORNE BY THE CONTRACTOR AND ASSUMED INCLUDED IN THE CONTRACT. THE CONTRACTOR IS TO VERIFY ALL CONNECTION POINTS WITH THE EXISTING UTILITIES. THE CONTRACTOR IS RESPONSIBLE FOR ANY DAMAGE CAUSED TO THE EXISTING UTILITIES AND UTILITY STRUCTURES THAT ARE TO REMAIN. IF CONFLICTS WITH EXISTING UTILITIES OCCUR, THE CONTRACTOR SHALL NOTIFY THE ENGINEER PRIOR TO CONSTRUCTION TO DETERMINE IF ANY FIELD ADJUSTMENTS SHOULD BE MADE.
  3. ALL SANITARY SEWER INFRASTRUCTURE TO BE INSTALLED PER GOVERNING AGENCY STANDARD PLANS AND SPECIFICATIONS.
  4. ALL WATER INFRASTRUCTURE TO BE INSTALLED PER GOVERNING AGENCY OR APWA STANDARD PLANS AND SPECIFICATIONS.
  5. DEFLECT OR LOOP ALL WATERLINES TO AVOID CONFLICTS WITH OTHER UTILITIES PER GOVERNING AGENCY'S STANDARDS AND SPECIFICATIONS.
  6. PROJECT SHALL COMPLY WITH ALL UTAH DIVISION OF DRINKING WATER RULES AND REGULATIONS INCLUDING, BUT NOT LIMITED TO, THOSE PERTAINING TO BACKFLOW PROTECTION AND CROSS CONNECTION PREVENTION.
  7. NOTIFY ENGINEER OF ANY DISCREPANCIES IN DESIGN OR STAKING BEFORE PLACING UTILITY STRUCTURES OR PIPES.
  8. THE CONTRACTOR SHALL ADJUST TO GRADE ALL EXISTING UTILITIES AS NEEDED PER LOCAL GOVERNING AGENCY'S STANDARDS AND SPECIFICATIONS.
  9. THE CONTRACTOR IS TO PROTECT AND PRESERVE ALL EXISTING IMPROVEMENTS, UTILITIES, AND SIGNS, ETC. UNLESS OTHERWISE NOTED ON THESE PLANS.

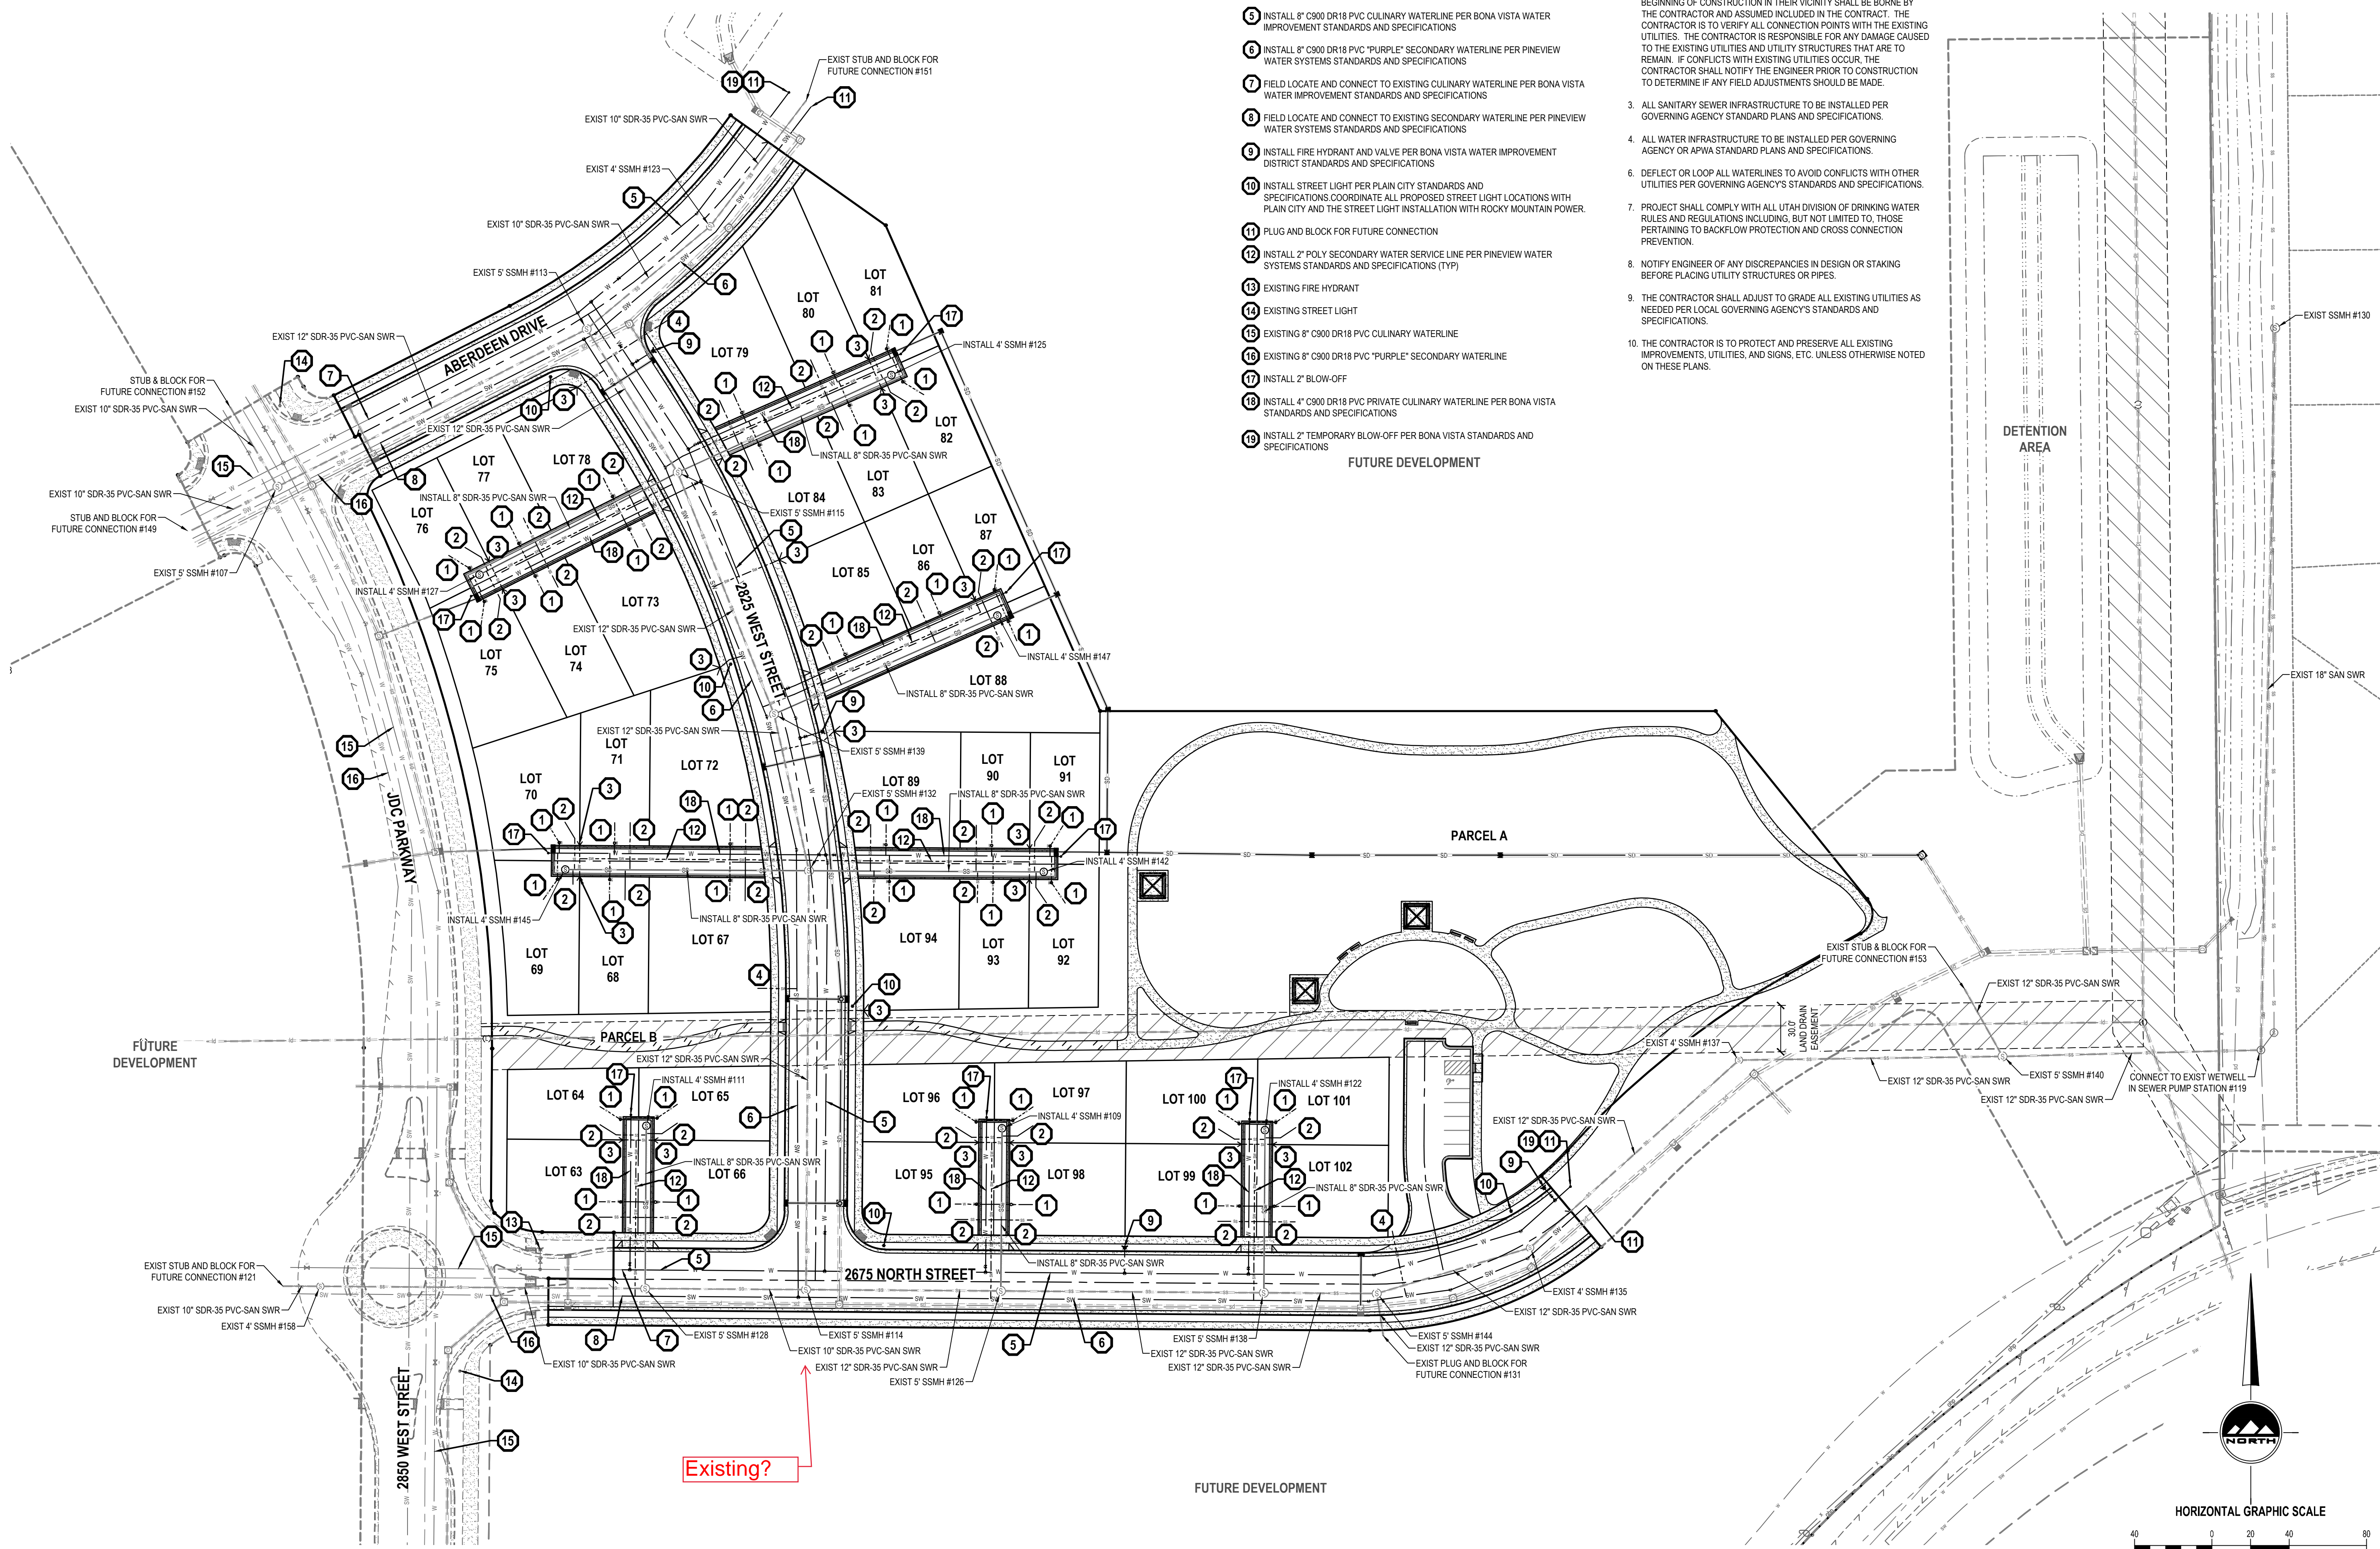

**ENSIGN**  
THE STANDARD IN ENGINEERING

LAYTON  
919 North 400 West  
Layton, UT 84041  
Phone: 801.547.1100

SANDY  
Phone: 801.255.0529

TOEELE  
Phone: 435.843.3590

CEDAR CITY  
Phone: 435.865.1453

RICHFIELD  
Phone: 435.896.2983

WWW.ENSIGNENG.COM

FOR:  
NILSON HOMES  
1740 COMBE RD. SUITE 2  
SOUTH OGDEN, UT 84403

CONTACT:  
STEVE ANDERSON  
PHONE: 801.392.8100

**THE ORCHARDS AT JDC RANCH**  
**PHASE 1**  
2800 WEST 2600 NORTH STREET  
WEBER COUNTY, UTAH


PROFESSIONAL ENGINEER  
No. 10234838-2202  
10-9-23  
STATE OF UTAH  
JAMES SUTHER

NO. DATE REVISION FOR REVIEW

**UTILITY PLAN**

PROJECT NUMBER 9872 PRINT DATE 2023-10-09  
PROJECT MANAGER CP DESIGNED BY TS

**C-300**

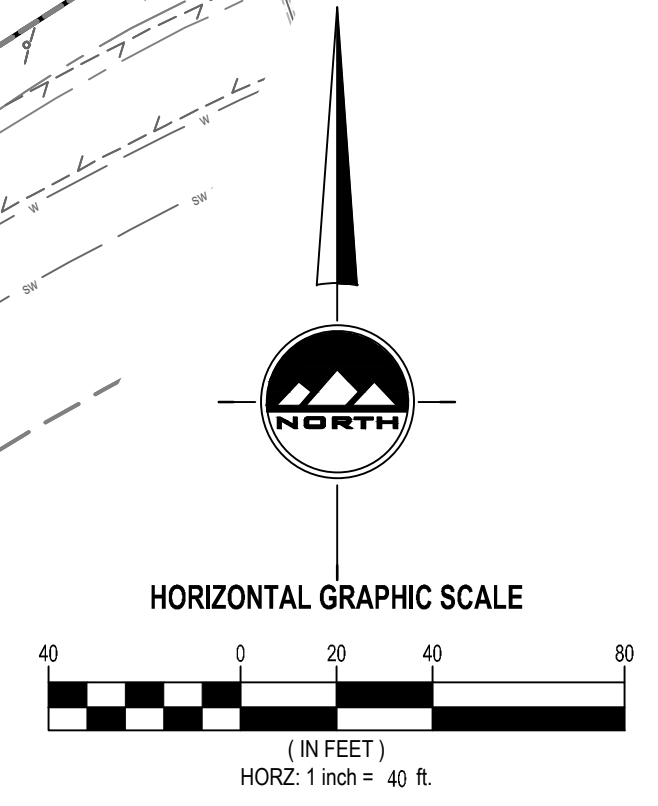



**811**  
Know what's below.  
Call before you dig.

CALL BLUESTAKES  
@ 811 AT LEAST 48 HOURS  
PRIOR TO THE  
COMMENCEMENT OF ANY  
CONSTRUCTION.


**BENCHMARK**

NORTHWEST CORNER OF SECTION 27  
TOWNSHIP 7 NORTH, RANGE 2 WEST  
SALT LAKE BASE AND MERIDIAN  
ELEV = 4231.00'

- SCOPE OF WORK:**  
PROVIDE, INSTALL AND/OR CONSTRUCT THE FOLLOWING PER THE SPECIFICATIONS GIVEN OR REFERENCED. THE DETAILS NOTED, AND/OR AS SHOWN ON THE CONSTRUCTION DRAWINGS:
- 1 INLET PROTECTION PER DETAIL 1/C-500.
  - 2 VEHICLE WASHDOWN AND STABILIZED CONSTRUCTION ENTRANCE PER DETAIL 2/C-500.
  - 3 SUGGESTED TEMPORARY CONSTRUCTION SITE PARKING, STAGING, DUMPSTER, AND MATERIAL STORAGE AREA.
  - 4 CONCRETE CLEANOUT LINED BASIN OR DUMPSTER
  - 5 LIMITS OF DISTURBANCE
  - 6 INSTALL TEMPORARY SILT FENCE PER DETAIL 5/C-500
  - 7 BARRICADE ENTRANCE DURING CONSTRUCTION
  - 8 INSTALL INLET PROTECTION PER DETAIL 6/C-500

- GENERAL NOTES**
1. THIS PLAN IS DESIGNED AS A FIRST APPRAISAL OF NECESSARY MEANS TO PROTECT THE WATERS OF THE STATE FROM POTENTIAL POLLUTION. IT IS THE RESPONSIBILITY OF THE OWNER/OPERATOR TO ADD WARRANTED BEST MANAGEMENT PRACTICES (BMP'S) AS NECESSARY. MODIFY THOSE SHOWN AS APPROPRIATE, AND DELETE FROM THE PROJECT THOSE FOUND TO BE UNNECESSARY. FEDERAL AND STATE LAW ALLOWS THESE UPDATES TO BE MADE BY THE OWNER/OPERATOR ONSITE AND RECORDED BY THE OWNER/OPERATOR ON THE COPY OF THE SWPPP KEPT ONSITE.
  2. DISTURBED LAND SHALL BE KEPT TO A MINIMUM. STABILIZATION MEASURES SHALL BE INITIATED AS SOON AS PRACTICABLE IN PORTIONS OF THE SITE WHERE CONSTRUCTION ACTIVITIES HAVE TEMPORARILY OR PERMANENTLY CEASED, BUT IN NO CASE MORE THAN 14 DAYS AFTER THE CONSTRUCTION ACTIVITY IN THAT PORTION OF THE SITE HAS TEMPORARILY OR PERMANENTLY CEASED. HOWEVER, WHERE CONSTRUCTION ACTIVITY ON A PORTION OF THE SITE IS TEMPORARILY CEASED, AND EARTH DISTURBING ACTIVITIES WILL BE RESUMED WITHIN 21 DAYS, TEMPORARY STABILIZATION MEASURES DO NOT HAVE TO BE INITIATED ON THAT PORTION OF THE SITE.
  3. RESEED DISTURBED LAND WITH NATIVE GRASS MIXTURE WITHIN 14 CALENDAR DAYS OF ACHIEVEMENT OF FINISH GRADE TO STABILIZE SOILS IF LAND IS NOT TO BE RE-WORKED WITHIN 14 CALENDAR DAYS OF THE CESSATION OF CONSTRUCTION ACTIVITIES AT THAT LOCATION.
  4. DETAILS SHOWN ARE TO BE EMPLOYED TO PROTECT RUNOFF AS APPROPRIATE DURING CONSTRUCTION. NOT ALL DETAILS ARE NECESSARY AT ALL PHASES OF THE PROJECT. IT SHALL BE THE RESPONSIBILITY OF THE OWNER/OPERATOR TO USE APPROPRIATE BEST MANAGEMENT PRACTICES AT THE APPROPRIATE PHASE OF CONSTRUCTION. SEE SWPPP FOR BMP IMPLEMENTATION SCHEDULE.
  5. VARIOUS BEST MANAGEMENT PRACTICES HAVE BEEN SHOWN ON THE PLANS AT SUGGESTED LOCATIONS. THE CONTRACTOR MAY MOVE AND RECONFIGURE THESE BMP'S TO OTHER LOCATIONS IF PREFERRED, PROVIDED THE INTENT OF THE DESIGN IS PRESERVED.
  6. NOT ALL POSSIBLE BMP'S HAVE BEEN SHOWN. THE CONTRACTOR IS RESPONSIBLE TO APPLY CORRECT MEASURES TO PREVENT THE POLLUTION OF STORM WATER PER PROJECT SWPPP.
  7. A UPDES (UTAH POLLUTANT DISCHARGE ELIMINATION SYSTEM) PERMIT IS REQUIRED FOR ALL CONSTRUCTION ACTIVITIES 1 ACRE OR MORE.

REVISION SCHEDULE			
NUMBER	DATE	AUTHOR	COMPANY REPRESENTATIVE SIGNATURE
1			
2			
3			
4			
5			
6			
7			
8			
9			
10			
11			
12			

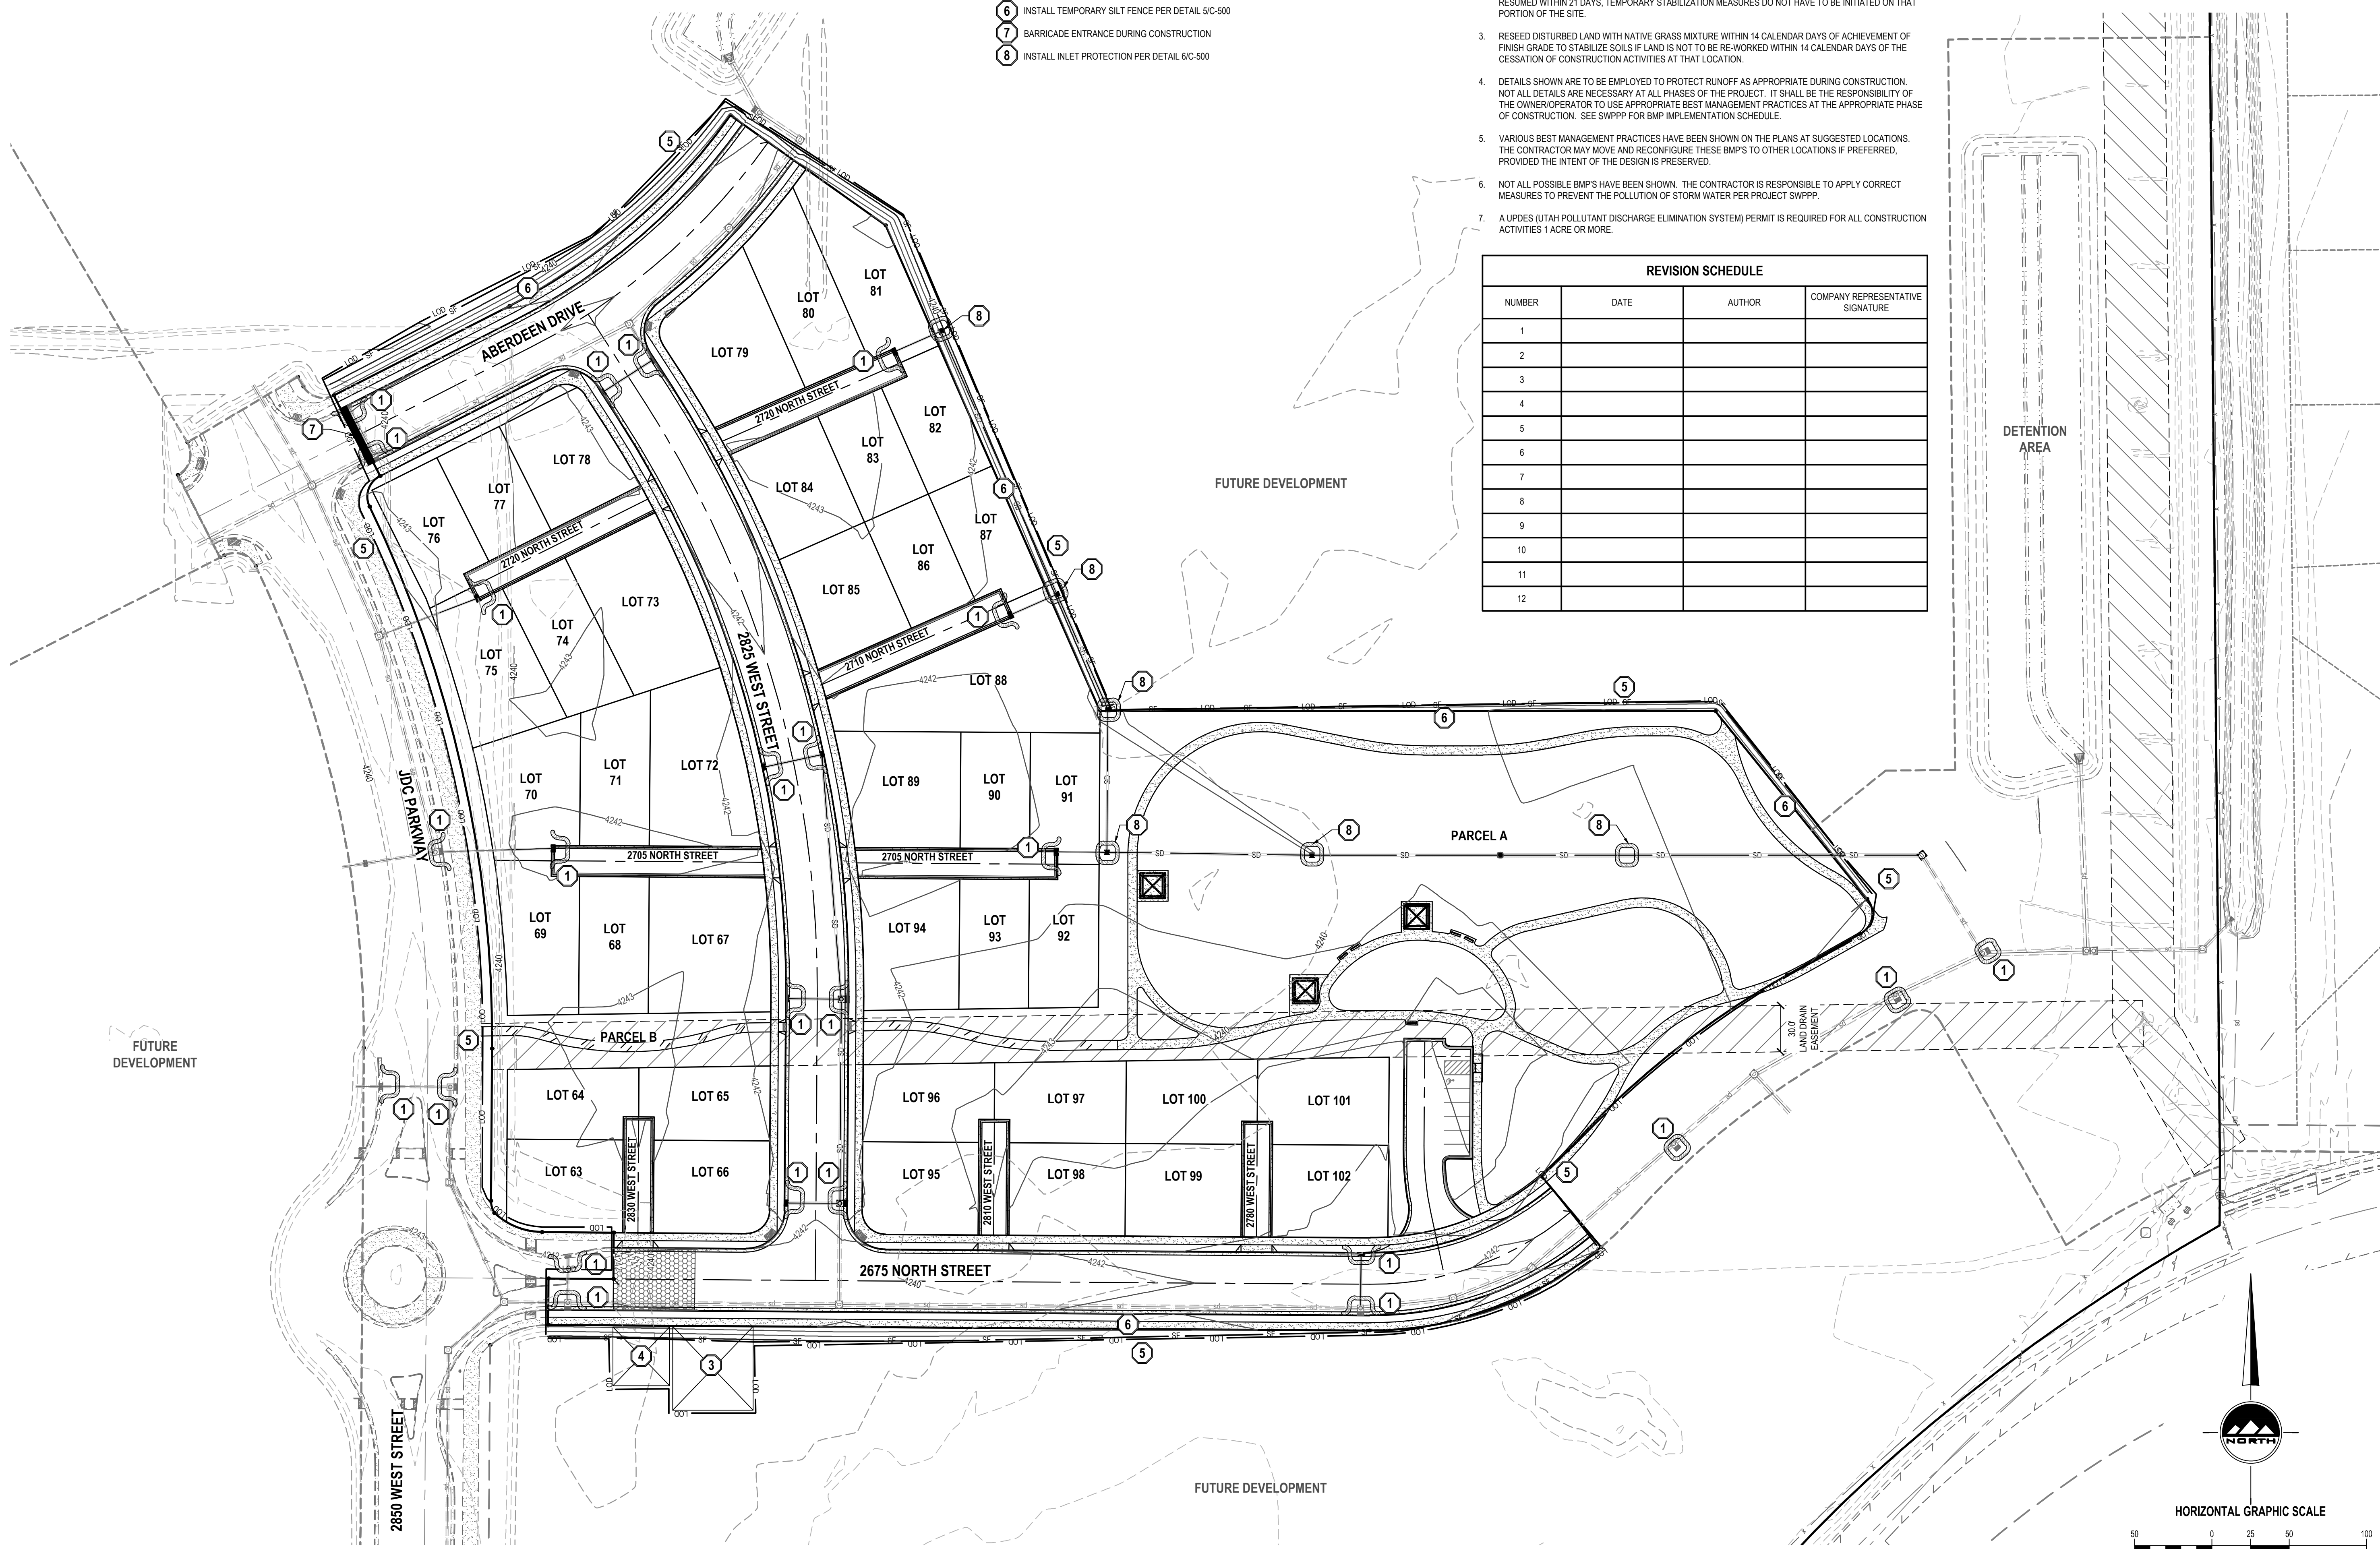

**ENSIGN**  
THE STANDARD IN ENGINEERING

**LAYTON**  
919 North 400 West  
Layton, UT 84041  
Phone: 801.547.1100

**SANDY**  
Phone: 801.255.0529

**TOOELE**  
Phone: 435.843.3590

**CEDAR CITY**  
Phone: 435.865.1453

**RICHFIELD**  
Phone: 435.896.2983

**WWW.ENSIGNENG.COM**

FOR:  
NILSON HOMES  
1740 COMBE RD, SUITE 2  
SOUTH OGDEN, UT 84403

CONTACT:  
STEVE ANDERSON  
PHONE: 801.392.8100

**THE ORCHARDS AT JDC RANCH  
PHASE 1  
2800 WEST 2600 NORTH STREET  
WEBER COUNTY, UTAH**

PROFESSIONAL ENGINEER  
No. 10234838-2202  
10-9-23  
STATE OF UTAH  

NO. DATE REVISION FOR REVIEW

**EROSION CONTROL PLAN**

PROJECT NUMBER 9872 PRINT DATE 2023-10-09  
PROJECT MANAGER CP DESIGNED BY TS

**C-400**

**NORTH**

HORIZONTAL GRAPHIC SCALE  
0 25 50 100  
(IN FEET)  
HORZ: 1 inch = 50 ft.





Know what's below.  
Call before you dig.

CALL BLUESTAKES  
@ 811 AT LEAST 48 HOURS  
PRIOR TO THE  
COMMENCEMENT OF ANY  
CONSTRUCTION.

**BENCHMARK**

NORTHWEST CORNER OF SECTION 27  
TOWNSHIP 7 NORTH, RANGE 2 WEST  
SALT LAKE BASE AND MERIDIAN  
ELEV = 4231.00'



**LAYTON**  
919 North 400 West  
Layton, UT 84041  
Phone: 801.547.1100

**SANDY**  
Phone: 801.255.0529

**TOOELE**  
Phone: 435.843.3590

**CEDAR CITY**  
Phone: 435.865.1453


**RICHFIELD**  
Phone: 435.896.2983

WWW.ENSGNENG.COM

FOR:  
NILSON HOMES  
1740 COMBE RD, SUITE 2  
SOUTH OGDEN, UT 84403

CONTACT:  
STEVE ANDERSON  
PHONE: 801.392.8100

**THE ORCHARDS AT JDC RANCH  
PHASE 1  
2800 WEST 2600 NORTH STREET  
WEBER COUNTY, UTAH**



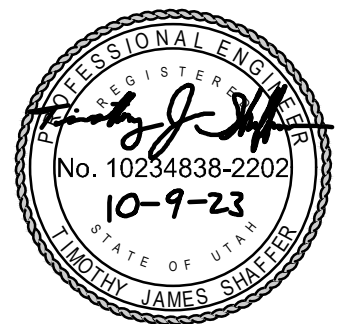


NO. DATE REVISION  
FOR REVIEW

**PLAN AND PROFILE  
KEY MAP**

PROJECT NUMBER 9872 PRINT DATE 2023-10-09  
PROJECT MANAGER CP DESIGNED BY TS

**PP-0**

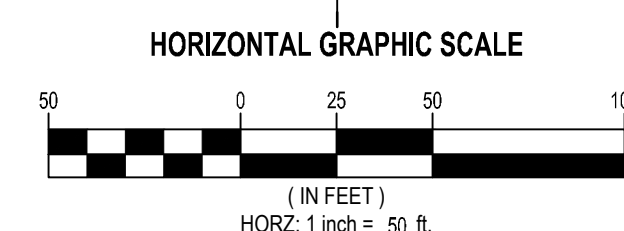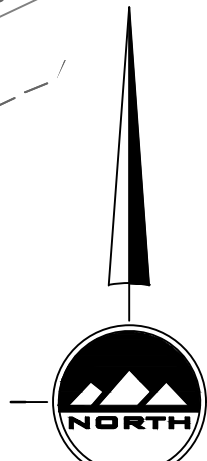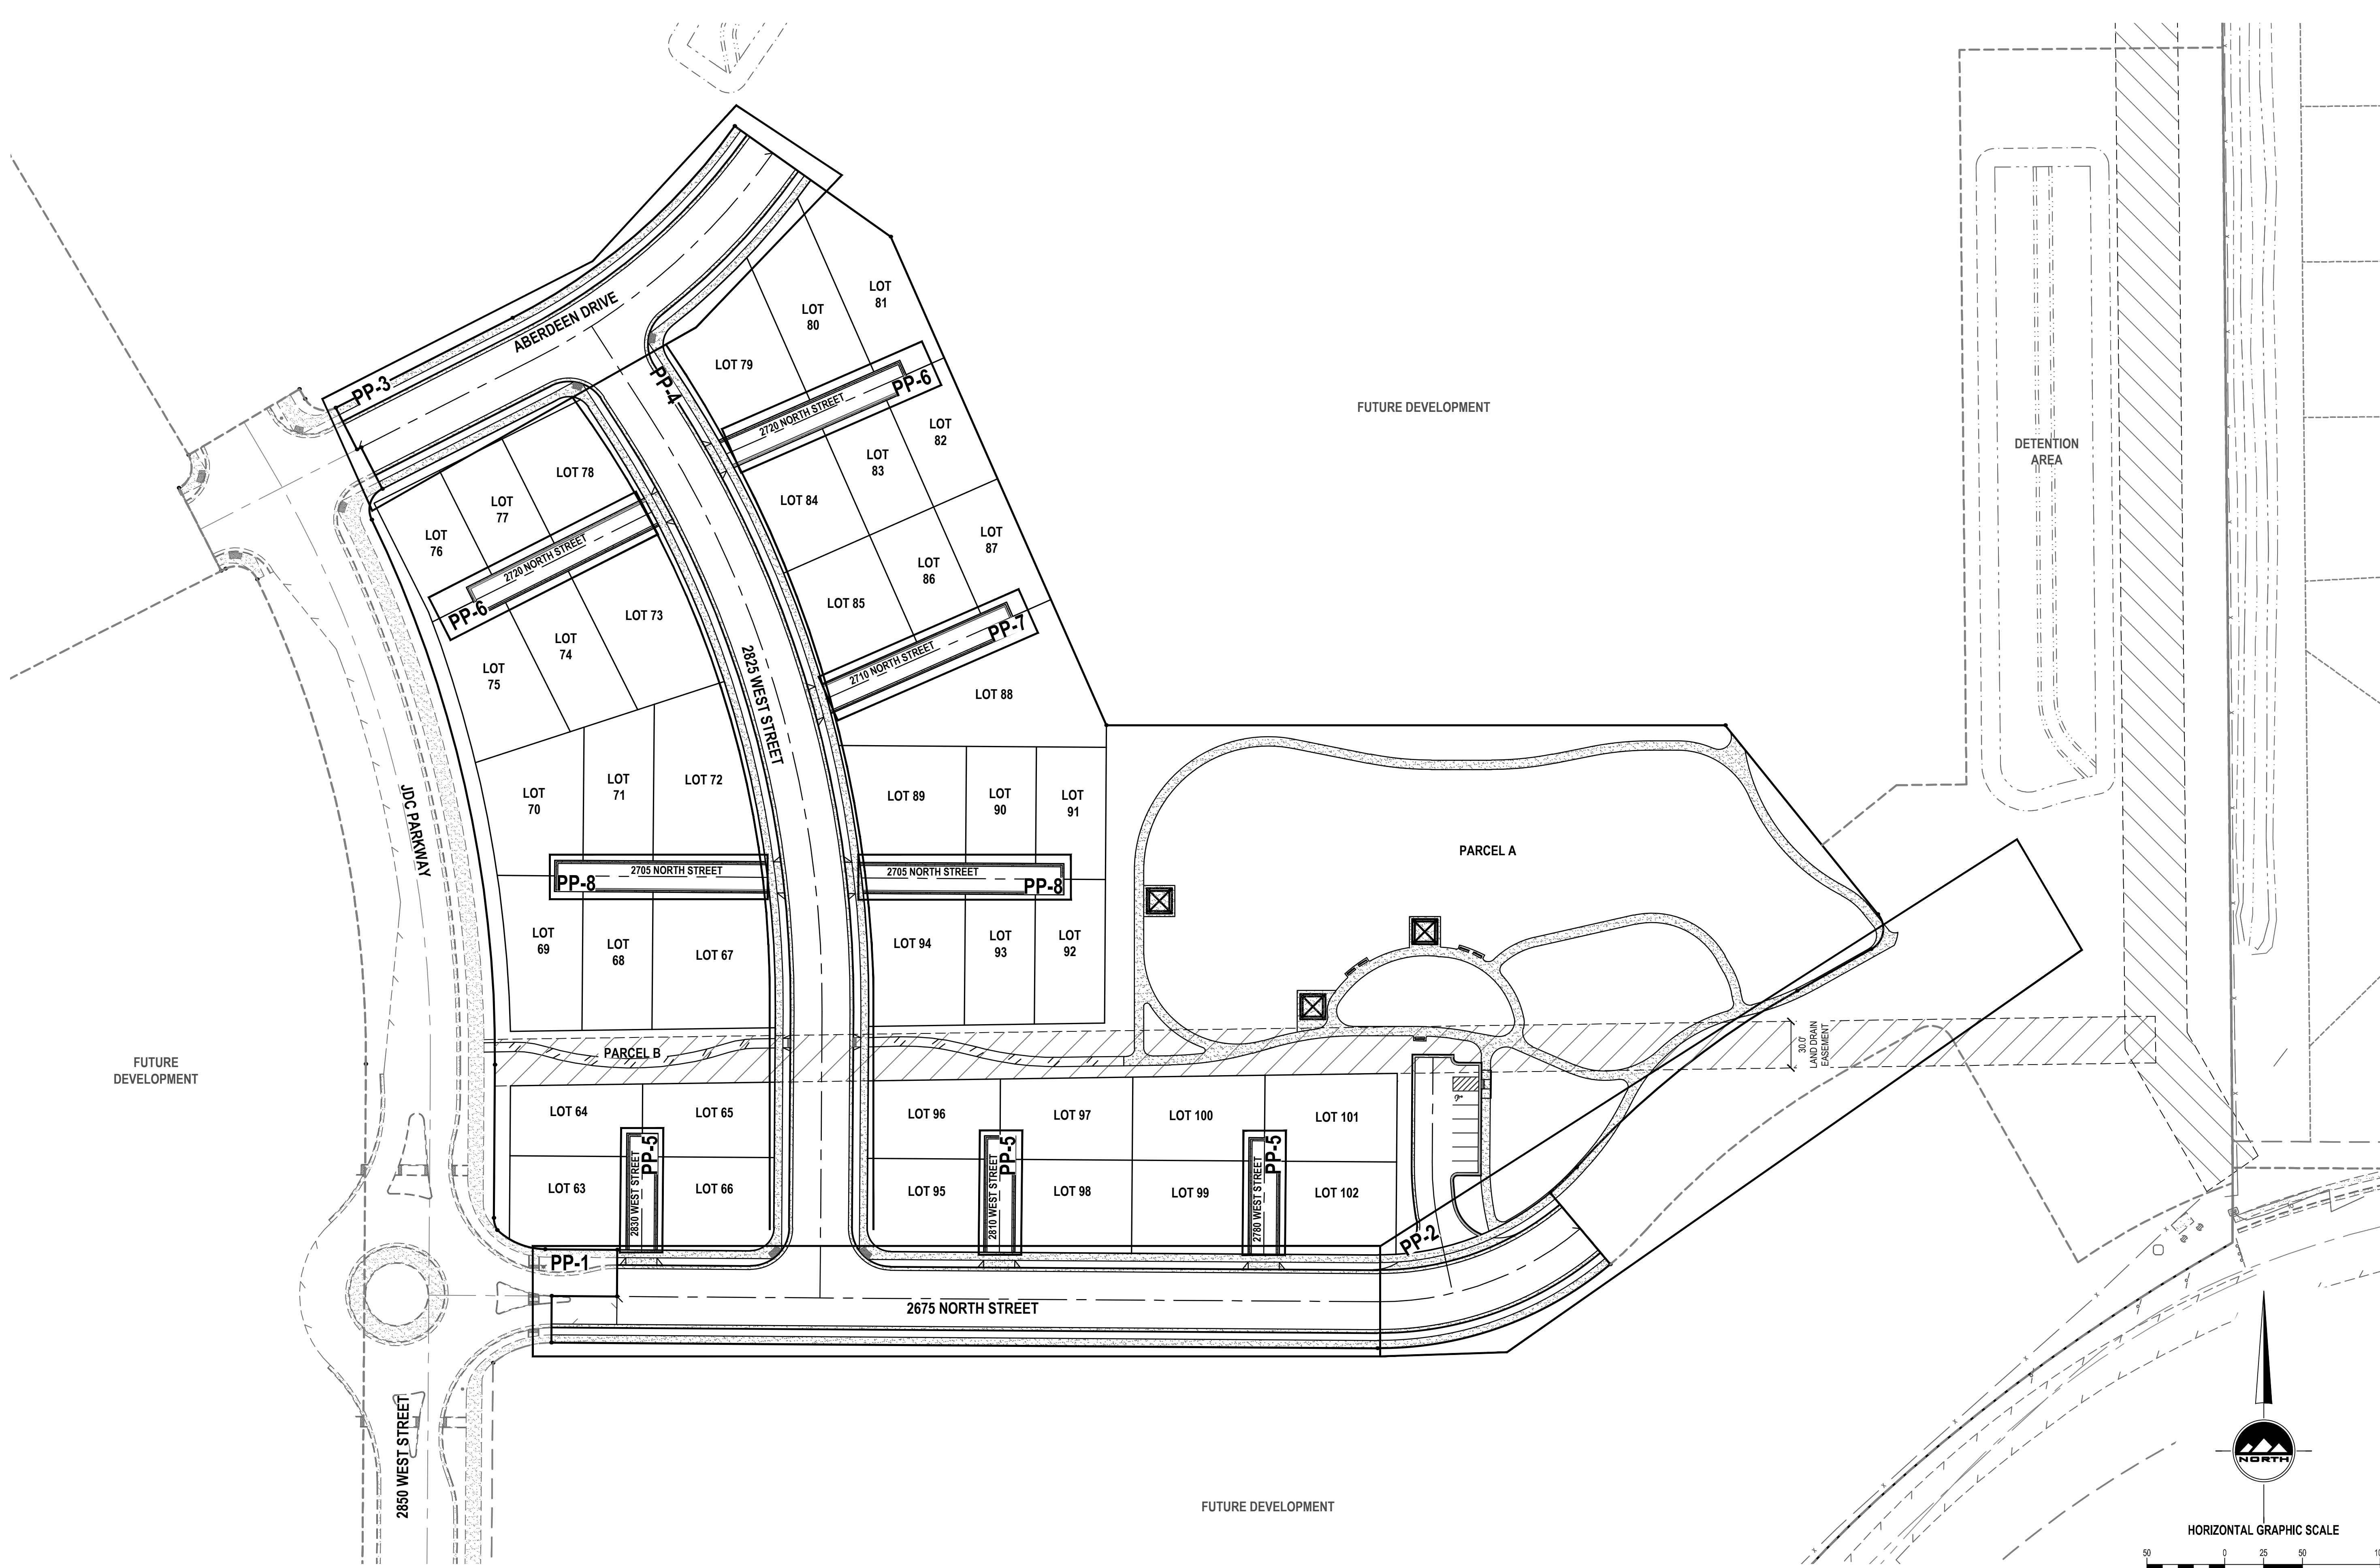




**811**  
Know what's below.  
Call before you dig.

**BENCHMARK**  
NORTHWEST CORNER OF SECTION 27  
TOWNSHIP 7 NORTH, RANGE 2 WEST  
SALT LAKE BASE AND MERIDIAN  
ELEV = 4231.00'

- SCOPE OF WORK:**  
PROVIDE, INSTALL AND/OR CONSTRUCT THE FOLLOWING PER THE SPECIFICATIONS GIVEN OR REFERENCED, THE DETAILS NOTED, AND/OR AS SHOWN ON THE CONSTRUCTION DRAWINGS:
- INSTALL TYPICAL WATER CONNECTION PER BONA VISTA WATER IMPROVEMENT DISTRICT STANDARDS AND SPECIFICATIONS
  - INSTALL 4" SANITARY SEWER SERVICE LATERAL @ 2.00% MINIMUM SLOPE PER PLAIN CITY STANDARDS AND SPECIFICATIONS.
  - INSTALL 1-1/2" PVC DUAL TURNOUT SECONDARY WATER SERVICE LINE PER PINEVIEW WATER SYSTEMS STANDARDS AND SPECIFICATIONS.
  - INSTALL 1" SECONDARY WATER SERVICE LINE PER PINEVIEW WATER SYSTEMS STANDARDS AND SPECIFICATIONS.
  - INSTALL 8" C900 DR18 PVC CULINARY WATERLINE PER BONA VISTA WATER IMPROVEMENT STANDARDS AND SPECIFICATIONS
  - INSTALL 8" C900 DR18 PVC "PURPLE" SECONDARY WATERLINE PER PINEVIEW WATER SYSTEMS STANDARDS AND SPECIFICATIONS
  - FIELD LOCATE AND CONNECT TO EXISTING CULINARY WATERLINE PER BONA VISTA WATER IMPROVEMENT STANDARDS AND SPECIFICATIONS
  - FIELD LOCATE AND CONNECT TO EXISTING SECONDARY WATERLINE PER PINEVIEW WATER SYSTEMS STANDARDS AND SPECIFICATIONS
  - INSTALL FIRE HYDRANT AND VALVE PER BONA VISTA WATER IMPROVEMENT DISTRICT STANDARDS AND SPECIFICATIONS
  - INSTALL STREET LIGHT PER PLAIN CITY STANDARDS AND SPECIFICATIONS COORDINATE ALL PROPOSED STREET LIGHT LOCATIONS WITH PLAIN CITY AND THE STREET LIGHT INSTALLATION WITH ROCKY MOUNTAIN POWER.
  - PLUG AND BLOCK FOR FUTURE CONNECTION
  - INSTALL 2" POLY SECONDARY WATER SERVICE LINE PER PINEVIEW WATER SYSTEMS STANDARDS AND SPECIFICATIONS (TYP)
  - EXISTING FIRE HYDRANT
  - EXISTING STREET LIGHT
  - EXISTING 8" C900 DR18 PVC CULINARY WATERLINE
  - EXISTING 8" C900 DR18 PVC "PURPLE" SECONDARY WATERLINE
  - INSTALL 2" BLOW-OFF
  - INSTALL 4" C900 DR18 PVC PRIVATE CULINARY WATERLINE PER BONA VISTA STANDARDS AND SPECIFICATIONS
  - INSTALL 2" TEMPORARY BLOW-OFF PER BONA VISTA STANDARDS AND SPECIFICATIONS

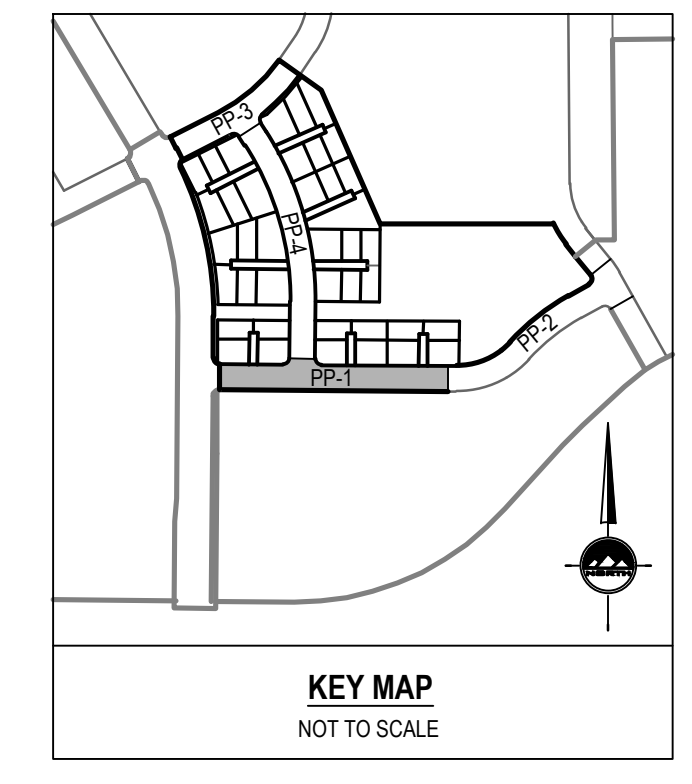

**ENSIGN**  
THE STANDARD IN ENGINEERING

LAYTON  
919 North 400 West  
Layton, UT 84041  
Phone: 801.547.1100

SANDY  
Phone: 801.255.0529

TOOELE  
Phone: 435.843.3590




CEDAR CITY  
Phone: 435.865.1453

RICHFIELD  
Phone: 435.896.2983

WWW.ENSIGNENG.COM

FOR:  
NILSON HOMES  
1740 COMBE RD, SUITE 2  
SOUTH OGDEN, UT 84403

CONTACT:  
STEVE ANDERSON  
PHONE: 801.392.8100

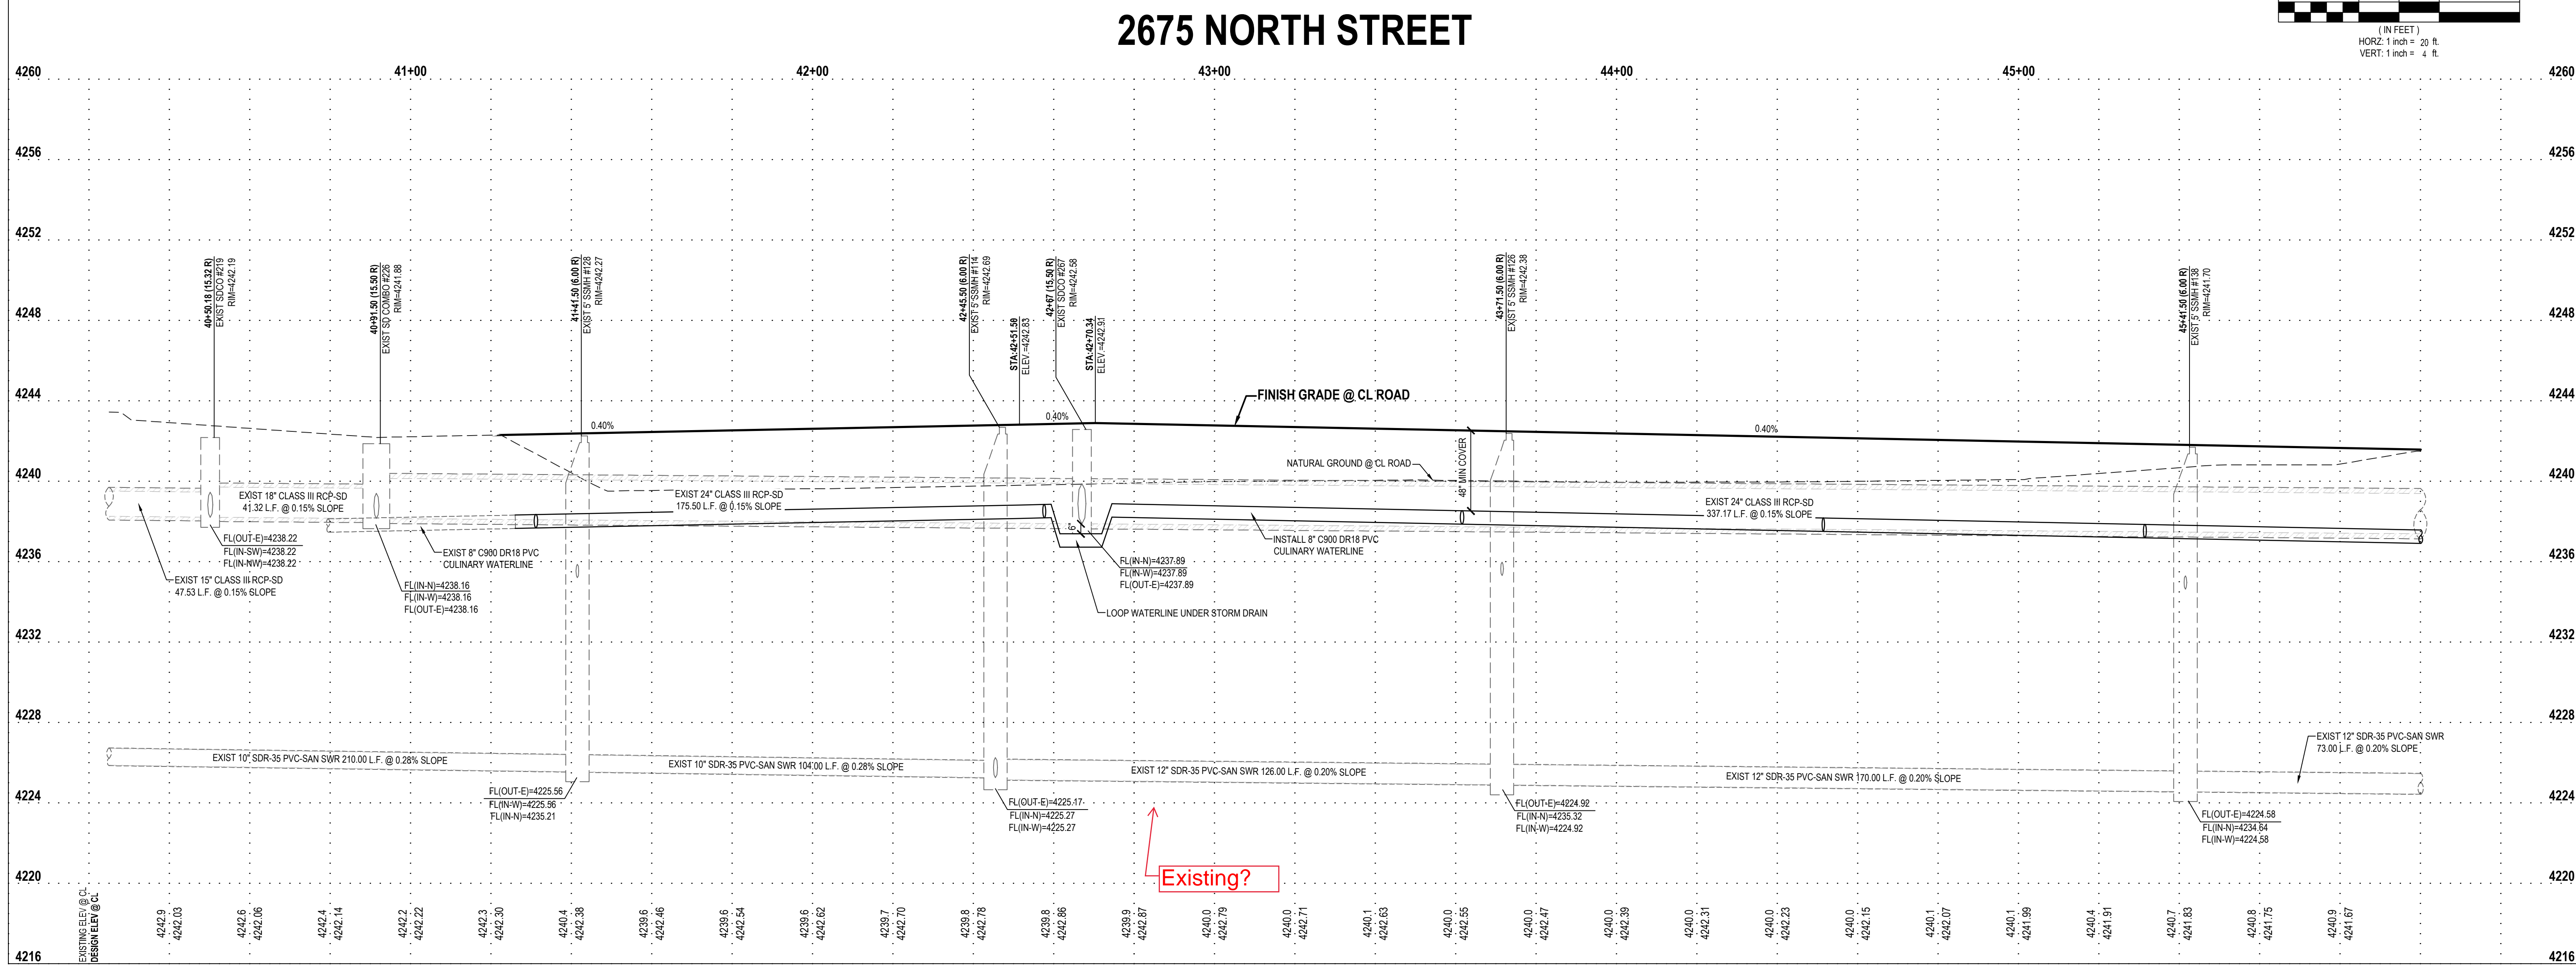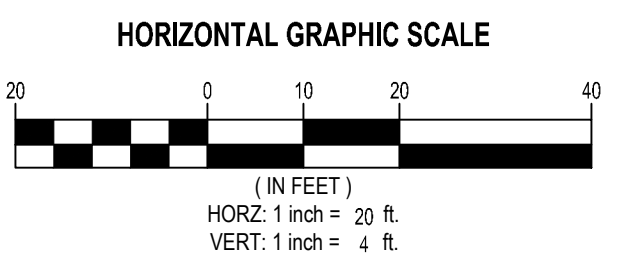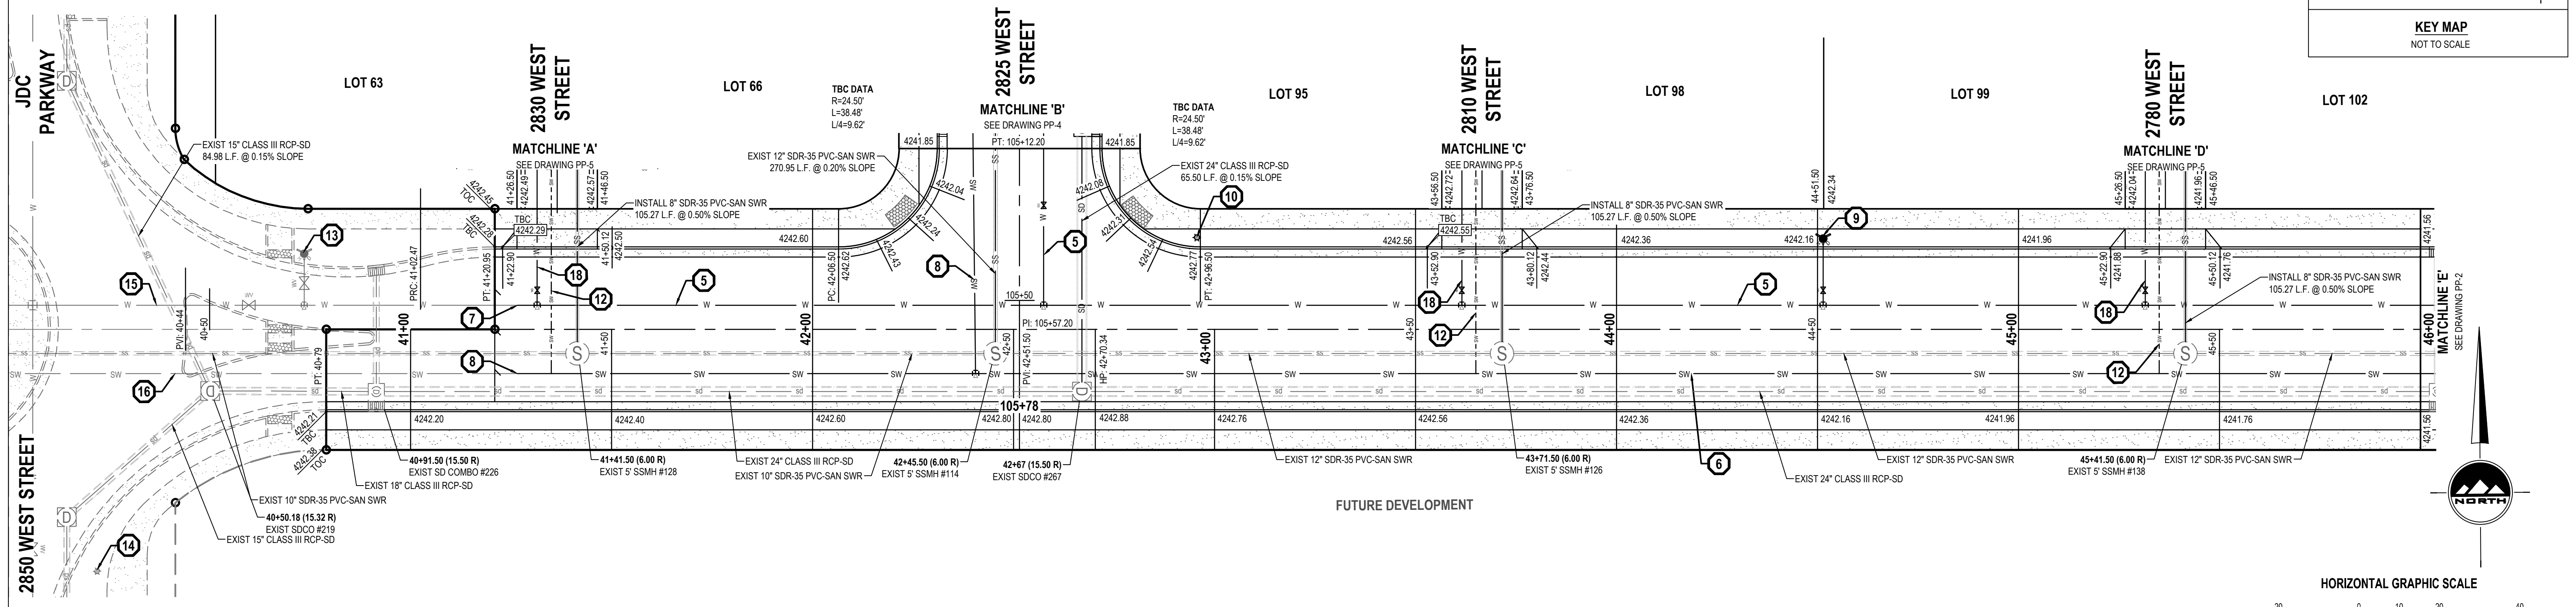

**THE ORCHARDS AT JDC RANCH**  
**PHASE 1**  
2800 WEST 2600 NORTH STREET  
WEBER COUNTY, UTAH



NO. DATE REVISION FOR REVIEW

**2675 NORTH STREET**  
**PLAN AND PROFILE**

PROJECT NUMBER 9872 PRINT DATE 2023-10-09  
PROJECT MANAGER CP DESIGNED BY TS

**PP-1**






**BENCHMARK**

NORTHWEST CORNER OF SECTION 27  
TOWNSHIP 7 NORTH, RANGE 2 WEST  
SALT LAKE BASE AND MERIDIAN  
ELEV = 4231.00'

**SCOPE OF WORK:**

PROVIDE, INSTALL AND/OR CONSTRUCT THE FOLLOWING PER THE SPECIFICATIONS GIVEN OR REFERENCED, THE DETAILS NOTED, AND/OR AS SHOWN ON THE CONSTRUCTION DRAWINGS:

- 1 INSTALL TYPICAL WATER CONNECTION PER BONA VISTA WATER IMPROVEMENT DISTRICT STANDARDS AND SPECIFICATIONS
- 2 INSTALL 4" SANITARY SEWER SERVICE LATERAL @ 2.00% MINIMUM SLOPE PER PLAIN CITY STANDARDS AND SPECIFICATIONS.
- 3 INSTALL 1-1/2" PVC DUAL TURNOUT SECONDARY WATER SERVICE LINE PER PINEVIEW WATER SYSTEMS STANDARDS AND SPECIFICATIONS.
- 4 INSTALL 1" SECONDARY WATER SERVICE LINE PER PINEVIEW WATER SYSTEMS STANDARDS AND SPECIFICATIONS.
- 5 INSTALL 8" C900 DR18 PVC CULINARY WATERLINE PER BONA VISTA WATER IMPROVEMENT STANDARDS AND SPECIFICATIONS
- 6 INSTALL 8" C900 DR18 PVC "PURPLE" SECONDARY WATERLINE PER PINEVIEW WATER SYSTEMS STANDARDS AND SPECIFICATIONS
- 7 FIELD LOCATE AND CONNECT TO EXISTING CULINARY WATERLINE PER BONA VISTA WATER IMPROVEMENT STANDARDS AND SPECIFICATIONS
- 8 FIELD LOCATE AND CONNECT TO EXISTING SECONDARY WATERLINE PER PINEVIEW WATER SYSTEMS STANDARDS AND SPECIFICATIONS
- 9 INSTALL FIRE HYDRANT AND VALVE PER BONA VISTA WATER IMPROVEMENT DISTRICT STANDARDS AND SPECIFICATIONS
- 10 INSTALL STREET LIGHT PER PLAIN CITY STANDARDS AND SPECIFICATIONS. COORDINATE ALL PROPOSED STREET LIGHT LOCATIONS WITH PLAIN CITY AND THE STREET LIGHT INSTALLATION WITH ROCKY MOUNTAIN POWER.
- 11 PLUG AND BLOCK FOR FUTURE CONNECTION
- 12 INSTALL 2" POLY SECONDARY WATER SERVICE LINE PER PINEVIEW WATER SYSTEMS STANDARDS AND SPECIFICATIONS (TYP)
- 13 EXISTING FIRE HYDRANT
- 14 EXISTING STREET LIGHT
- 15 EXISTING 8" C900 DR18 PVC CULINARY WATERLINE
- 16 EXISTING 8" C900 DR18 PVC "PURPLE" SECONDARY WATERLINE
- 17 INSTALL 2" BLOW-OFF
- 18 INSTALL 4" C900 DR18 PVC PRIVATE CULINARY WATERLINE PER BONA VISTA STANDARDS AND SPECIFICATIONS
- 19 INSTALL 2" TEMPORARY BLOW-OFF PER BONA VISTA STANDARDS AND SPECIFICATIONS

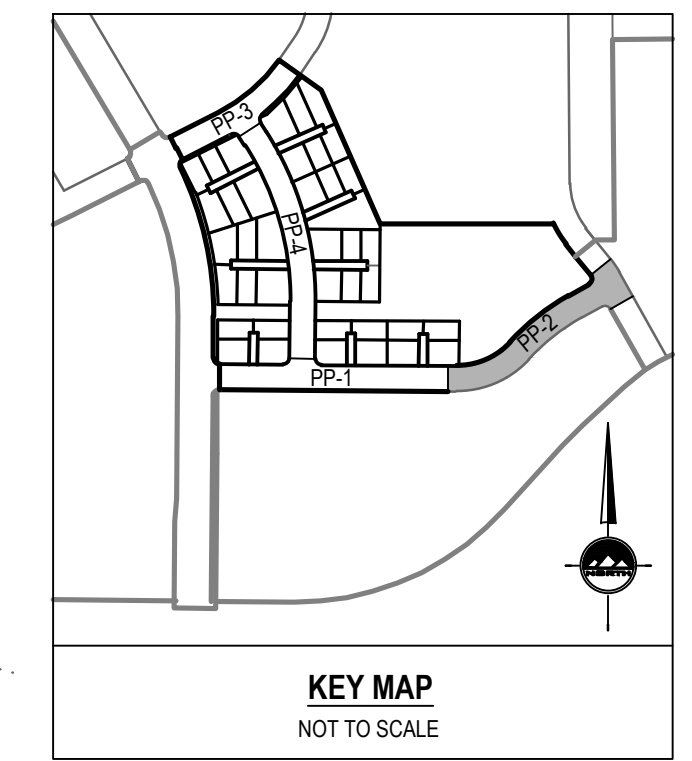

**ENSIGN**  
THE STANDARD IN ENGINEERING

LAYTON  
919 North 400 West  
Layton, UT 84041  
Phone: 801.547.1100

SANDY  
Phone: 801.255.0529

TOOELE  
Phone: 435.843.3590




CEDAR CITY  
Phone: 435.865.1453

RICHFIELD  
Phone: 435.896.2983

WWW.ENSIGNENG.COM

FOR:  
NILSON HOMES  
1740 COMBE RD, SUITE 2  
SOUTH OGDEN, UT 84403

CONTACT:  
STEVE ANDERSON  
PHONE: 801.392.8100

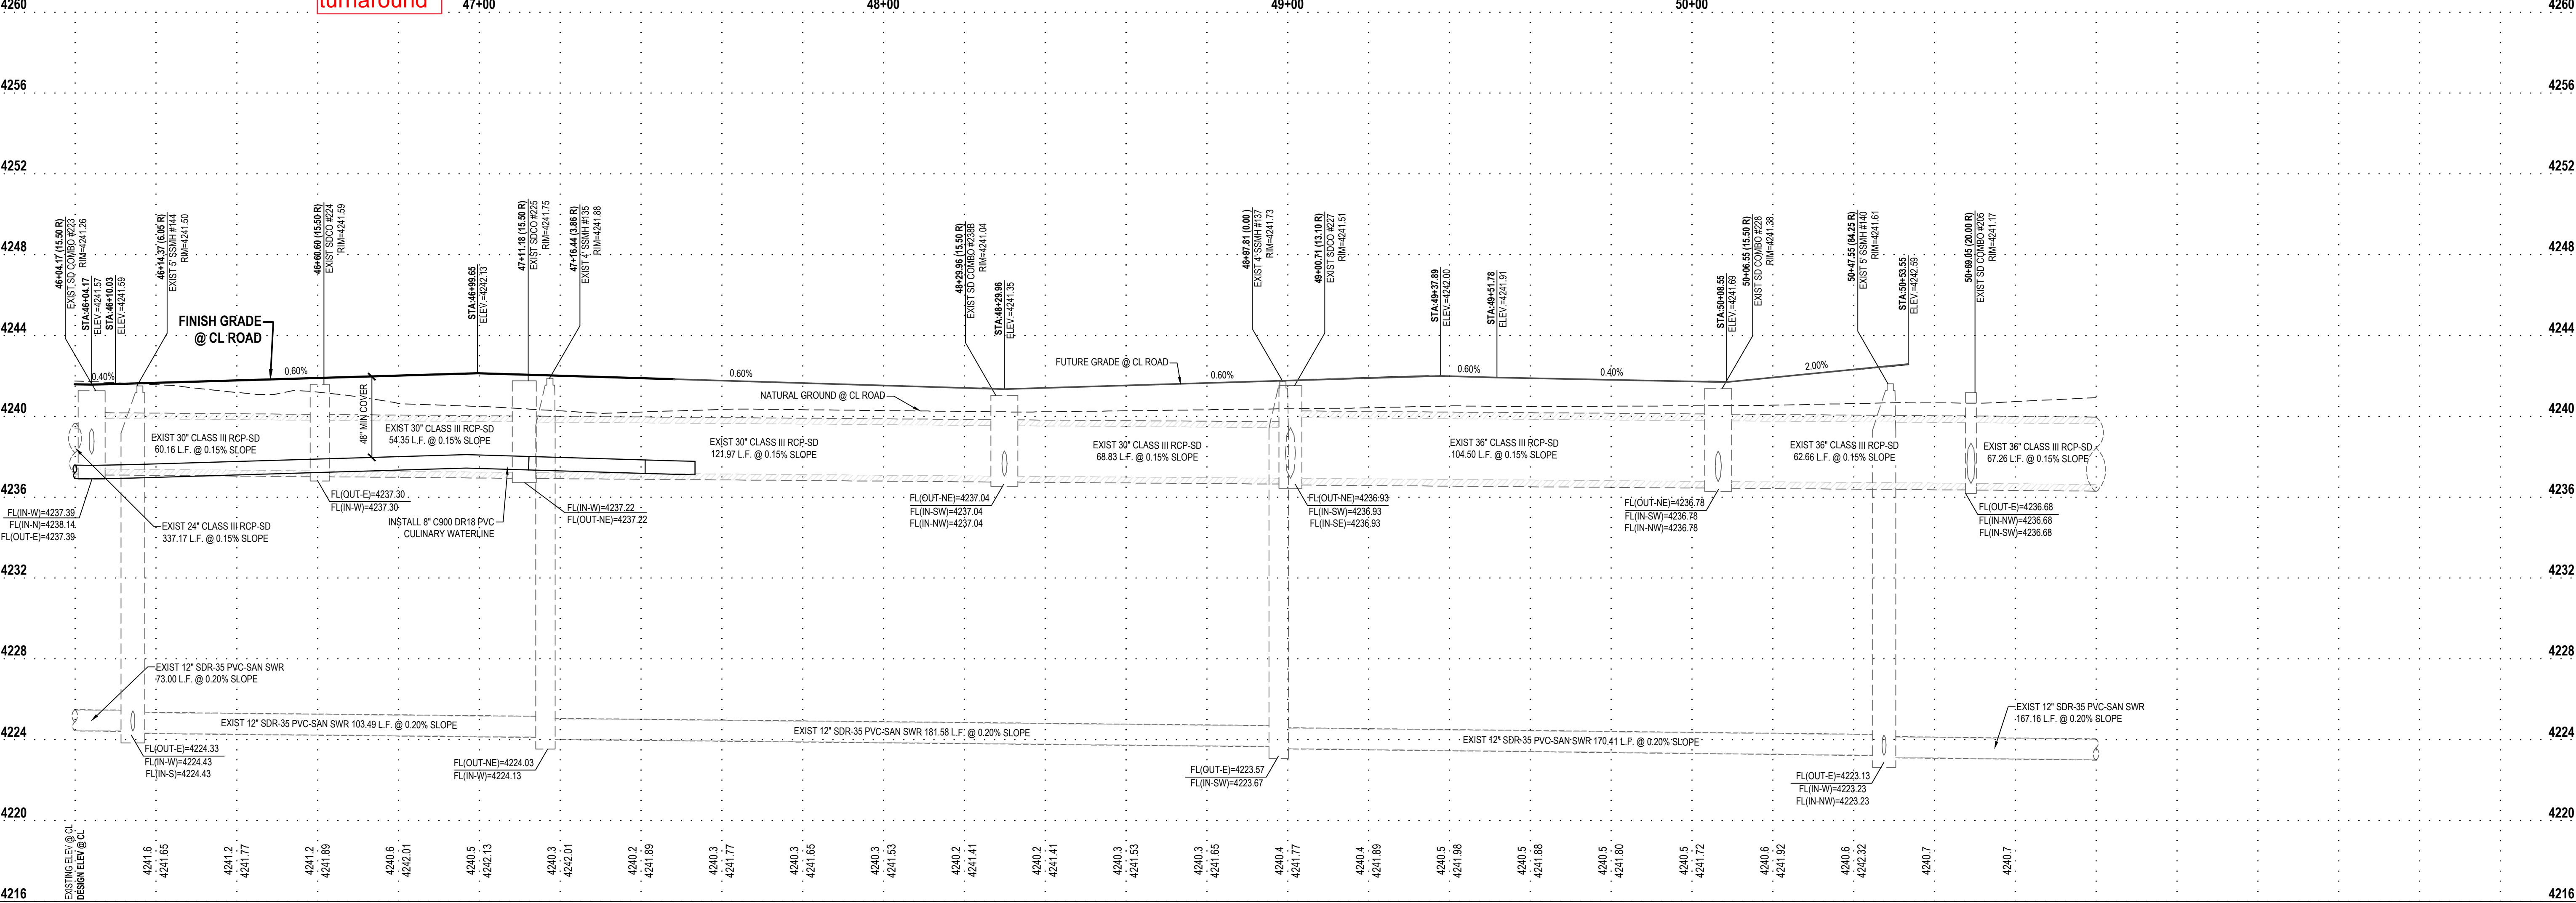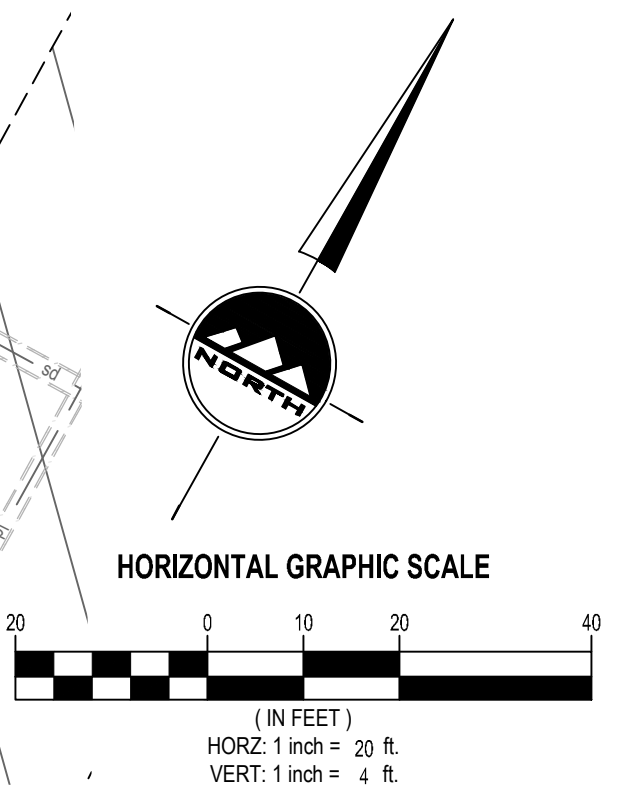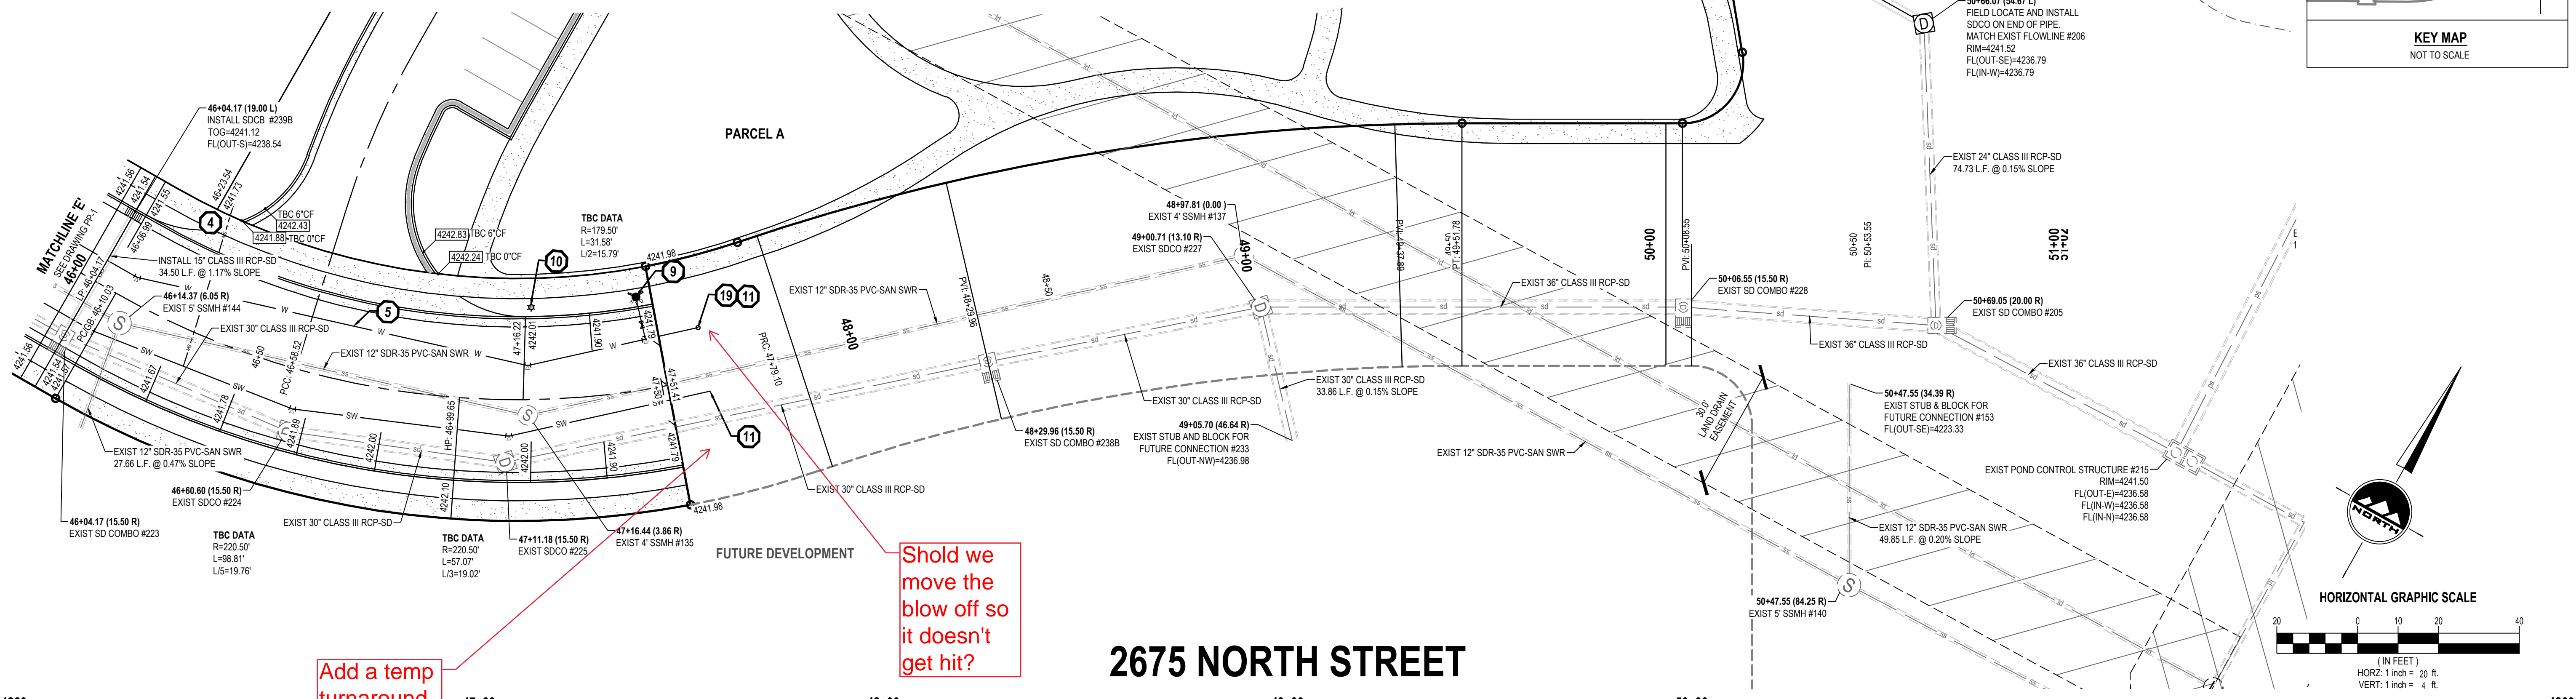

**THE ORCHARDS AT JDC RANCH**  
**PHASE 1**  
2800 WEST 2600 NORTH STREET  
WEBER COUNTY, UTAH



NO. DATE REVISION FOR REVIEW

**2675 NORTH STREET**  
**PLAN AND PROFILE**

PROJECT NUMBER 9872 PRINT DATE 2023-10-09  
PROJECT MANAGER CP DESIGNED BY TS

**PP-2**





CALL BLUESTAKES  
@ 811 AT LEAST 48 HOURS  
PRIOR TO THE  
COMMENCEMENT OF ANY  
CONSTRUCTION.





**BENCHMARK**

NORTHWEST CORNER OF SECTION 27  
TOWNSHIP 7 NORTH, RANGE 2 WEST  
SALT LAKE BASE AND MERIDIAN  
ELEV = 4231.00'

**SCOPE OF WORK:**

PROVIDE, INSTALL AND/OR CONSTRUCT THE FOLLOWING PER THE SPECIFICATIONS GIVEN OR REFERENCED, THE DETAILS NOTED, AND/OR AS SHOWN ON THE CONSTRUCTION DRAWINGS:

- 1 INSTALL TYPICAL WATER CONNECTION PER BONA VISTA WATER IMPROVEMENT DISTRICT STANDARDS AND SPECIFICATIONS
- 2 INSTALL 4" SANITARY SEWER SERVICE LATERAL @ 2.00% MINIMUM SLOPE PER PLAIN CITY STANDARDS AND SPECIFICATIONS.
- 3 INSTALL 1-1/2" PVC DUAL TURNOUT SECONDARY WATER SERVICE LINE PER PINEVIEW WATER SYSTEMS STANDARDS AND SPECIFICATIONS.
- 4 INSTALL 1" SECONDARY WATER SERVICE LINE PER PINEVIEW WATER SYSTEMS STANDARDS AND SPECIFICATIONS.
- 5 INSTALL 8" C900 DR18 PVC CULINARY WATERLINE PER BONA VISTA WATER IMPROVEMENT STANDARDS AND SPECIFICATIONS
- 6 INSTALL 8" C900 DR18 PVC "PURPLE" SECONDARY WATERLINE PER PINEVIEW WATER SYSTEMS STANDARDS AND SPECIFICATIONS
- 7 FIELD LOCATE AND CONNECT TO EXISTING CULINARY WATERLINE PER BONA VISTA WATER IMPROVEMENT STANDARDS AND SPECIFICATIONS
- 8 FIELD LOCATE AND CONNECT TO EXISTING SECONDARY WATERLINE PER PINEVIEW WATER SYSTEMS STANDARDS AND SPECIFICATIONS
- 9 INSTALL FIRE HYDRANT AND VALVE PER BONA VISTA WATER IMPROVEMENT DISTRICT STANDARDS AND SPECIFICATIONS
- 10 INSTALL STREET LIGHT PER PLAIN CITY STANDARDS AND SPECIFICATIONS COORDINATE ALL PROPOSED STREET LIGHT LOCATIONS WITH PLAIN CITY AND THE STREET LIGHT INSTALLATION WITH ROCKY MOUNTAIN POWER.
- 11 PLUG AND BLOCK FOR FUTURE CONNECTION
- 12 INSTALL 2" POLY SECONDARY WATER SERVICE LINE PER PINEVIEW WATER SYSTEMS STANDARDS AND SPECIFICATIONS (TYP)
- 13 EXISTING FIRE HYDRANT
- 14 EXISTING STREET LIGHT
- 15 EXISTING 8" C900 DR18 PVC CULINARY WATERLINE
- 16 EXISTING 8" C900 DR18 PVC "PURPLE" SECONDARY WATERLINE
- 17 INSTALL 2" BLOW-OFF
- 18 INSTALL 4" C900 DR18 PVC PRIVATE CULINARY WATERLINE PER BONA VISTA STANDARDS AND SPECIFICATIONS
- 19 INSTALL 2" TEMPORARY BLOW-OFF PER BONA VISTA STANDARDS AND SPECIFICATIONS

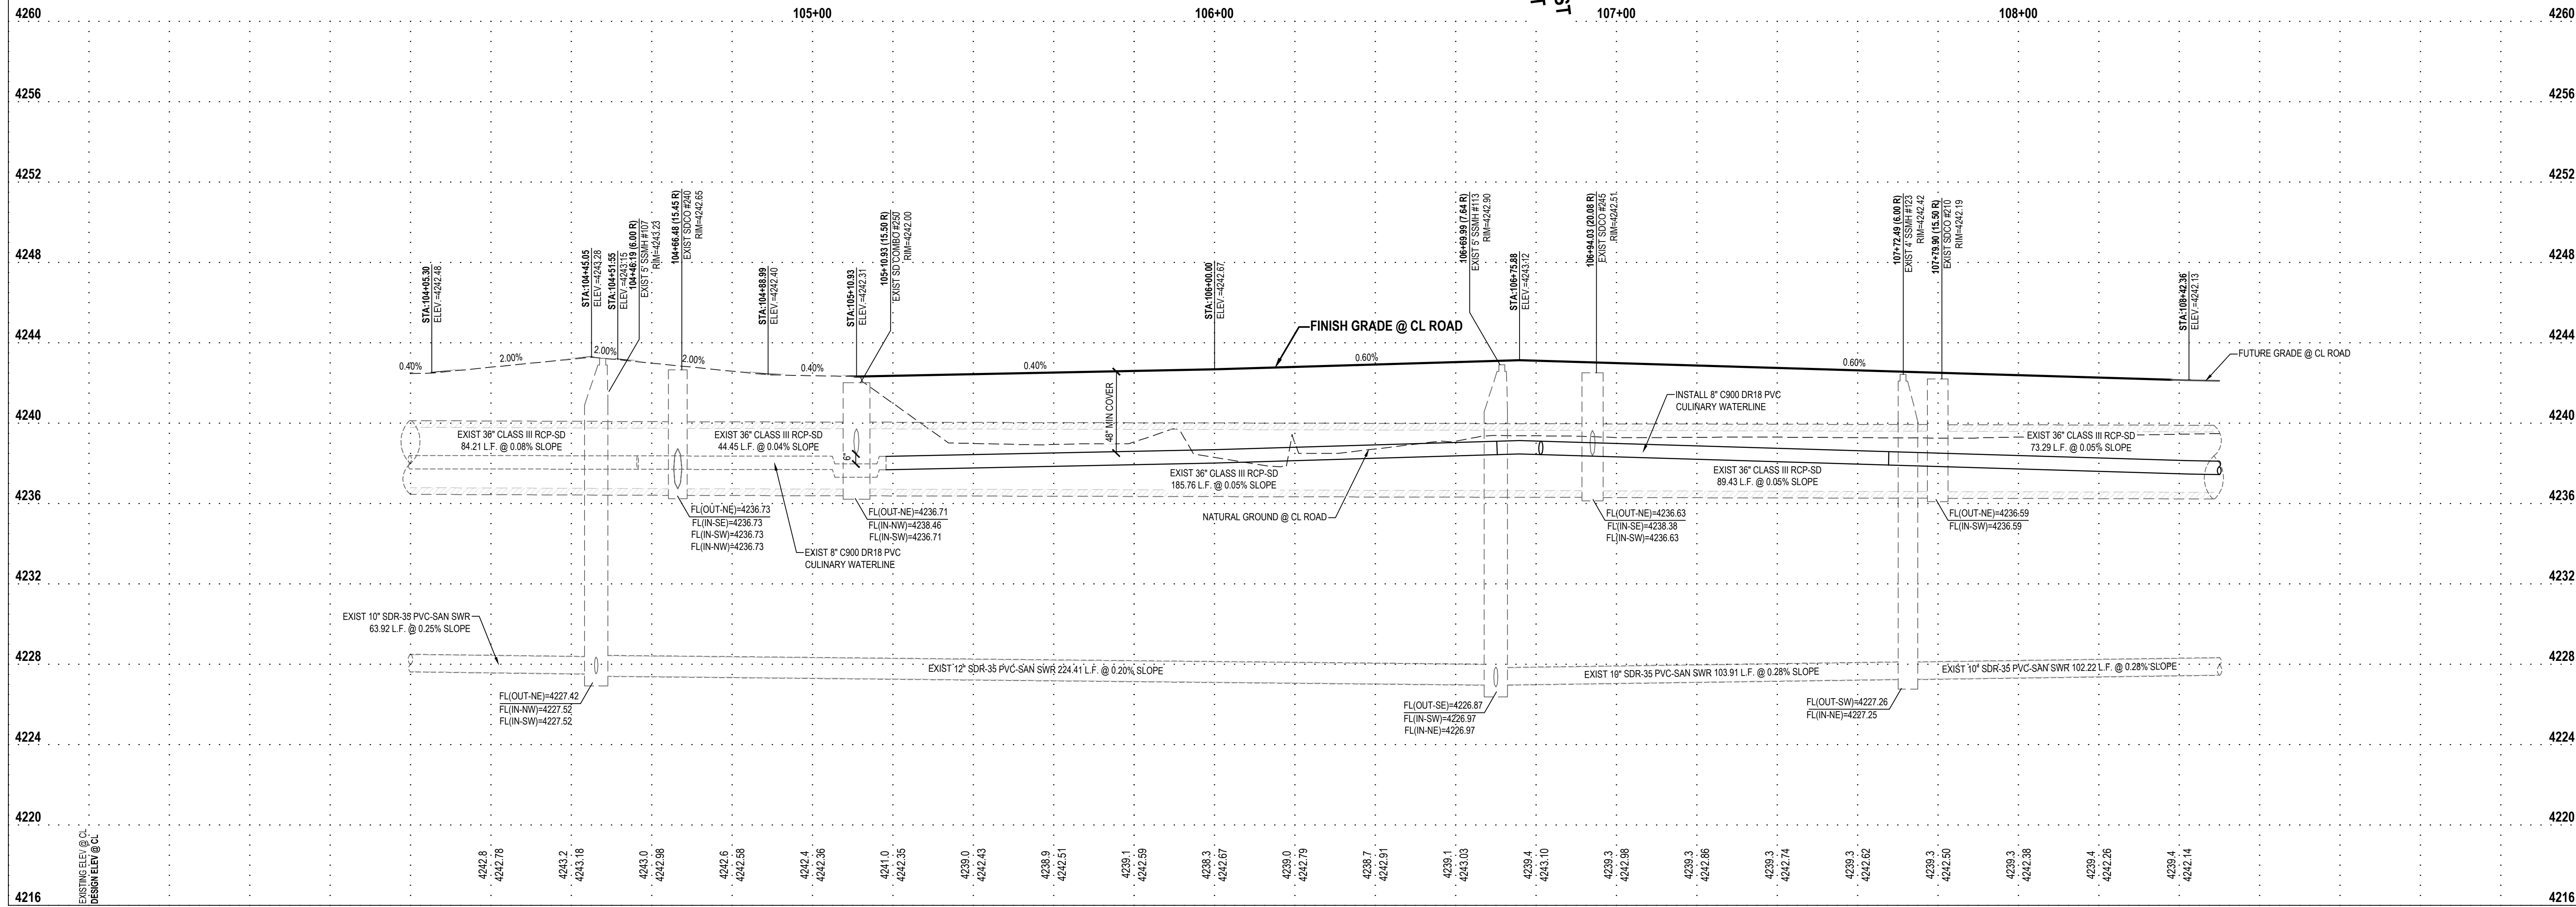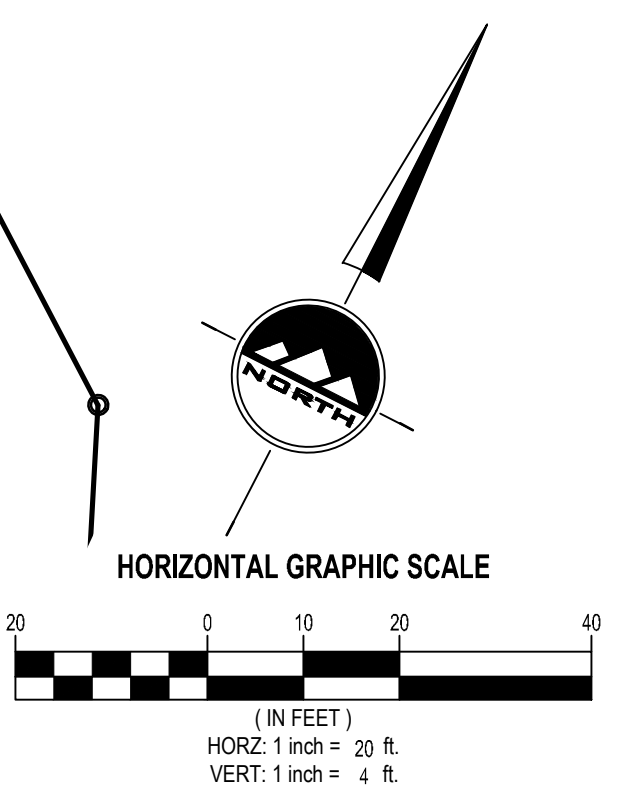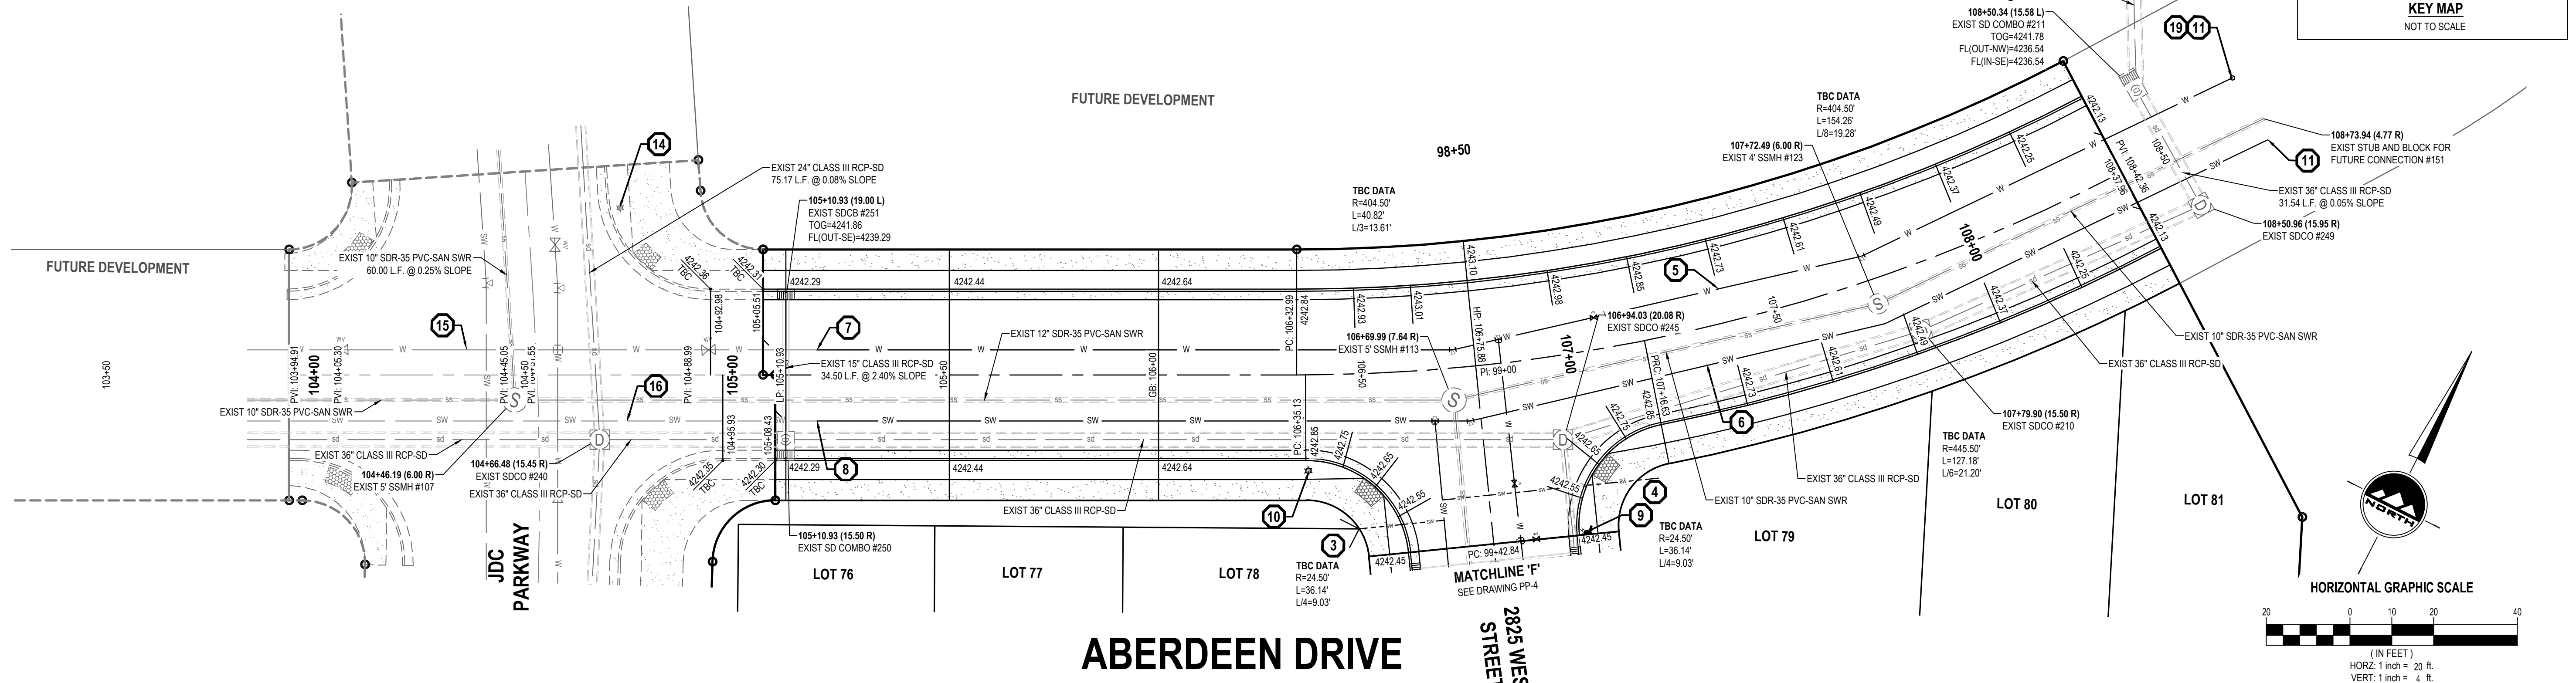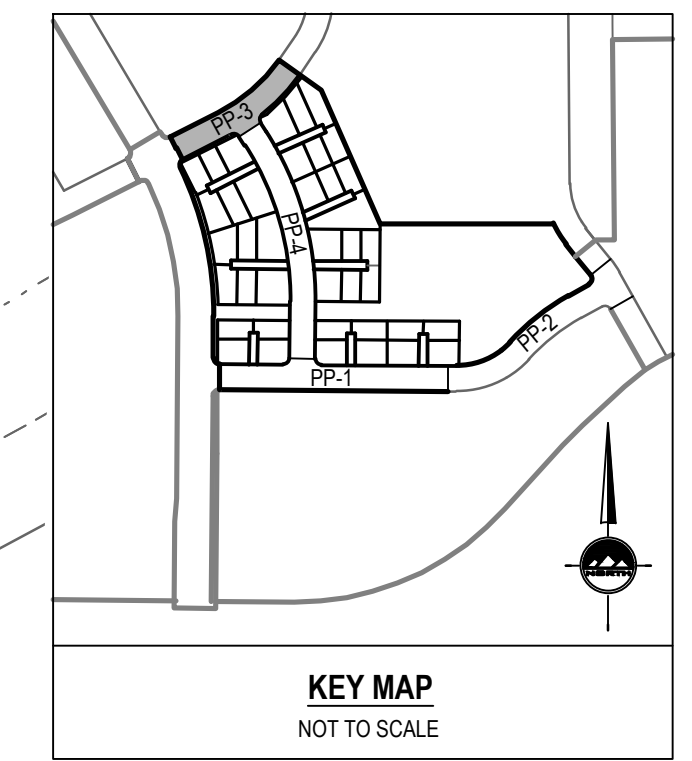

**ENSIGN**  
THE STANDARD IN ENGINEERING

LAYTON  
919 North 400 West  
Layton, UT 84041  
Phone: 801.547.1100

SANDY  
Phone: 801.255.0529

TOOELE  
Phone: 435.843.3590

CEDAR CITY  
Phone: 435.865.1453

RICHFIELD  
Phone: 435.896.2983

WWW.ENSIGNENG.COM

FOR:  
NILSON HOMES  
1740 COMBRO RD, SUITE 2  
SOUTH OGDEN, UT 84403

CONTACT:  
STEVE ANDERSON  
PHONE: 801.392.8100

**THE ORCHARDS AT JDC RANCH**  
**PHASE 1**  
2800 WEST 2600 NORTH STREET  
WEBER COUNTY, UTAH



NO. DATE REVISION FOR REVIEW

**ABERDEEN DRIVE**  
**PLAN AND PROFILE**

PROJECT NUMBER 9872 PRINT DATE 2023-10-09  
PROJECT MANAGER CP DESIGNED BY TS

**PP-3**





**BENCHMARK**

NORTHWEST CORNER OF SECTION 27  
TOWNSHIP 7 NORTH, RANGE 2 WEST  
SALT LAKE BASE AND MERIDIAN  
ELEV = 4231.00'

**SCOPE OF WORK:**

PROVIDE, INSTALL AND/OR CONSTRUCT THE FOLLOWING PER THE SPECIFICATIONS GIVEN OR REFERENCED, THE DETAILS NOTED, AND/OR AS SHOWN ON THE CONSTRUCTION DRAWINGS:

- 1 INSTALL TYPICAL WATER CONNECTION PER BONA VISTA WATER IMPROVEMENT DISTRICT STANDARDS AND SPECIFICATIONS
- 2 INSTALL 4" SANITARY SEWER SERVICE LATERAL @ 2.00% MINIMUM SLOPE PER PLAIN CITY STANDARDS AND SPECIFICATIONS.
- 3 INSTALL 1-1/2" PVC DUAL TURNOUT SECONDARY WATER SERVICE LINE PER PINEVIEW WATER SYSTEMS STANDARDS AND SPECIFICATIONS.
- 4 INSTALL 1" SECONDARY WATER SERVICE LINE PER PINEVIEW WATER SYSTEMS STANDARDS AND SPECIFICATIONS.
- 5 INSTALL 8" C900 DR18 PVC CULINARY WATERLINE PER BONA VISTA WATER IMPROVEMENT STANDARDS AND SPECIFICATIONS
- 6 INSTALL 8" C900 DR18 PVC "PURPLE" SECONDARY WATERLINE PER PINEVIEW WATER SYSTEMS STANDARDS AND SPECIFICATIONS
- 7 FIELD LOCATE AND CONNECT TO EXISTING CULINARY WATERLINE PER BONA VISTA WATER IMPROVEMENT STANDARDS AND SPECIFICATIONS
- 8 FIELD LOCATE AND CONNECT TO EXISTING SECONDARY WATERLINE PER PINEVIEW WATER SYSTEMS STANDARDS AND SPECIFICATIONS
- 9 INSTALL FIRE HYDRANT AND VALVE PER BONA VISTA WATER IMPROVEMENT DISTRICT STANDARDS AND SPECIFICATIONS
- 10 INSTALL STREET LIGHT PER PLAIN CITY STANDARDS AND SPECIFICATIONS.COORDINATE ALL PROPOSED STREET LIGHT LOCATIONS WITH PLAIN CITY AND THE STREET LIGHT INSTALLATION WITH ROCKY MOUNTAIN POWER.
- 11 PLUG AND BLOCK FOR FUTURE CONNECTION
- 13 EXISTING FIRE HYDRANT
- 14 EXISTING STREET LIGHT
- 15 EXISTING 8" C900 DR18 PVC CULINARY WATERLINE
- 16 EXISTING 8" C900 DR18 PVC "PURPLE" SECONDARY WATERLINE
- 17 INSTALL 2" BLOW-OFF
- 18 INSTALL 4" C900 DR18 PVC PRIVATE CULINARY WATERLINE PER BONA VISTA STANDARDS AND SPECIFICATIONS
- 19 INSTALL 2" TEMPORARY BLOW-OFF PER BONA VISTA STANDARDS AND SPECIFICATIONS

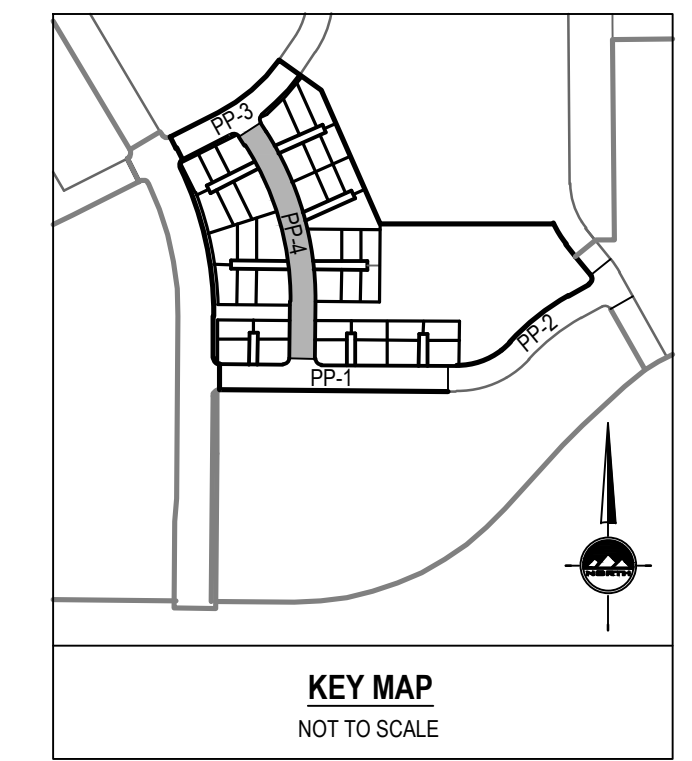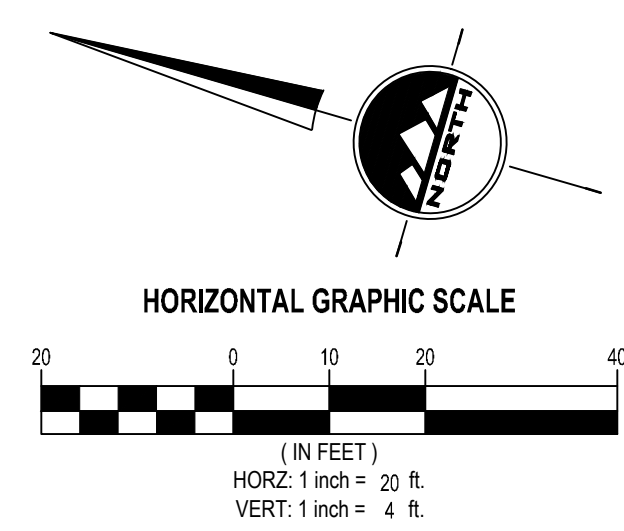

**ENSIGN**  
THE STANDARD IN ENGINEERING

LAYTON  
919 North 400 West  
Layton, UT 84041  
Phone: 801.547.1100

SANDY  
Phone: 801.255.0529

TOOELE  
Phone: 435.843.3590


CEDAR CITY  
Phone: 435.865.1453

RICHFIELD  
Phone: 435.896.2983


WWW.ENSIGNENG.COM

FOR:  
NILSON HOMES  
1740 COMBE RD, SUITE 2  
SOUTH OGDEN, UT 84403

CONTACT:  
STEVE ANDERSON  
PHONE: 801.392.8100

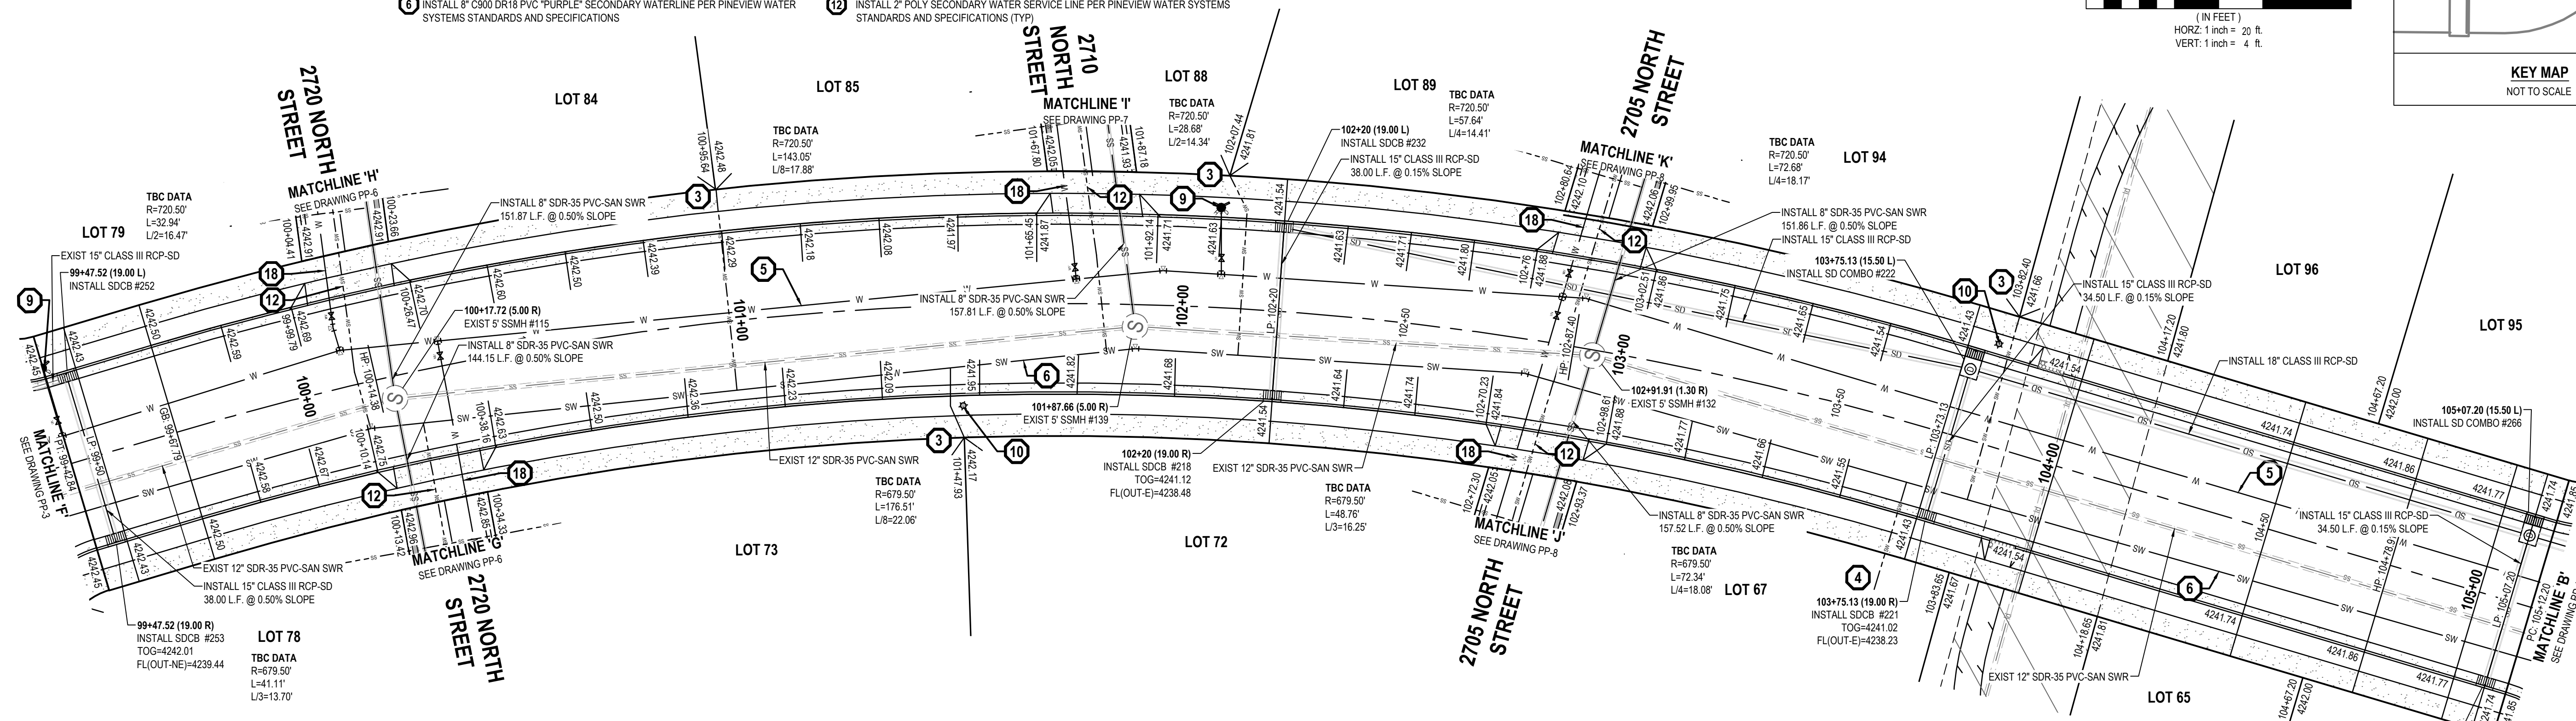

**2825 WEST STREET**

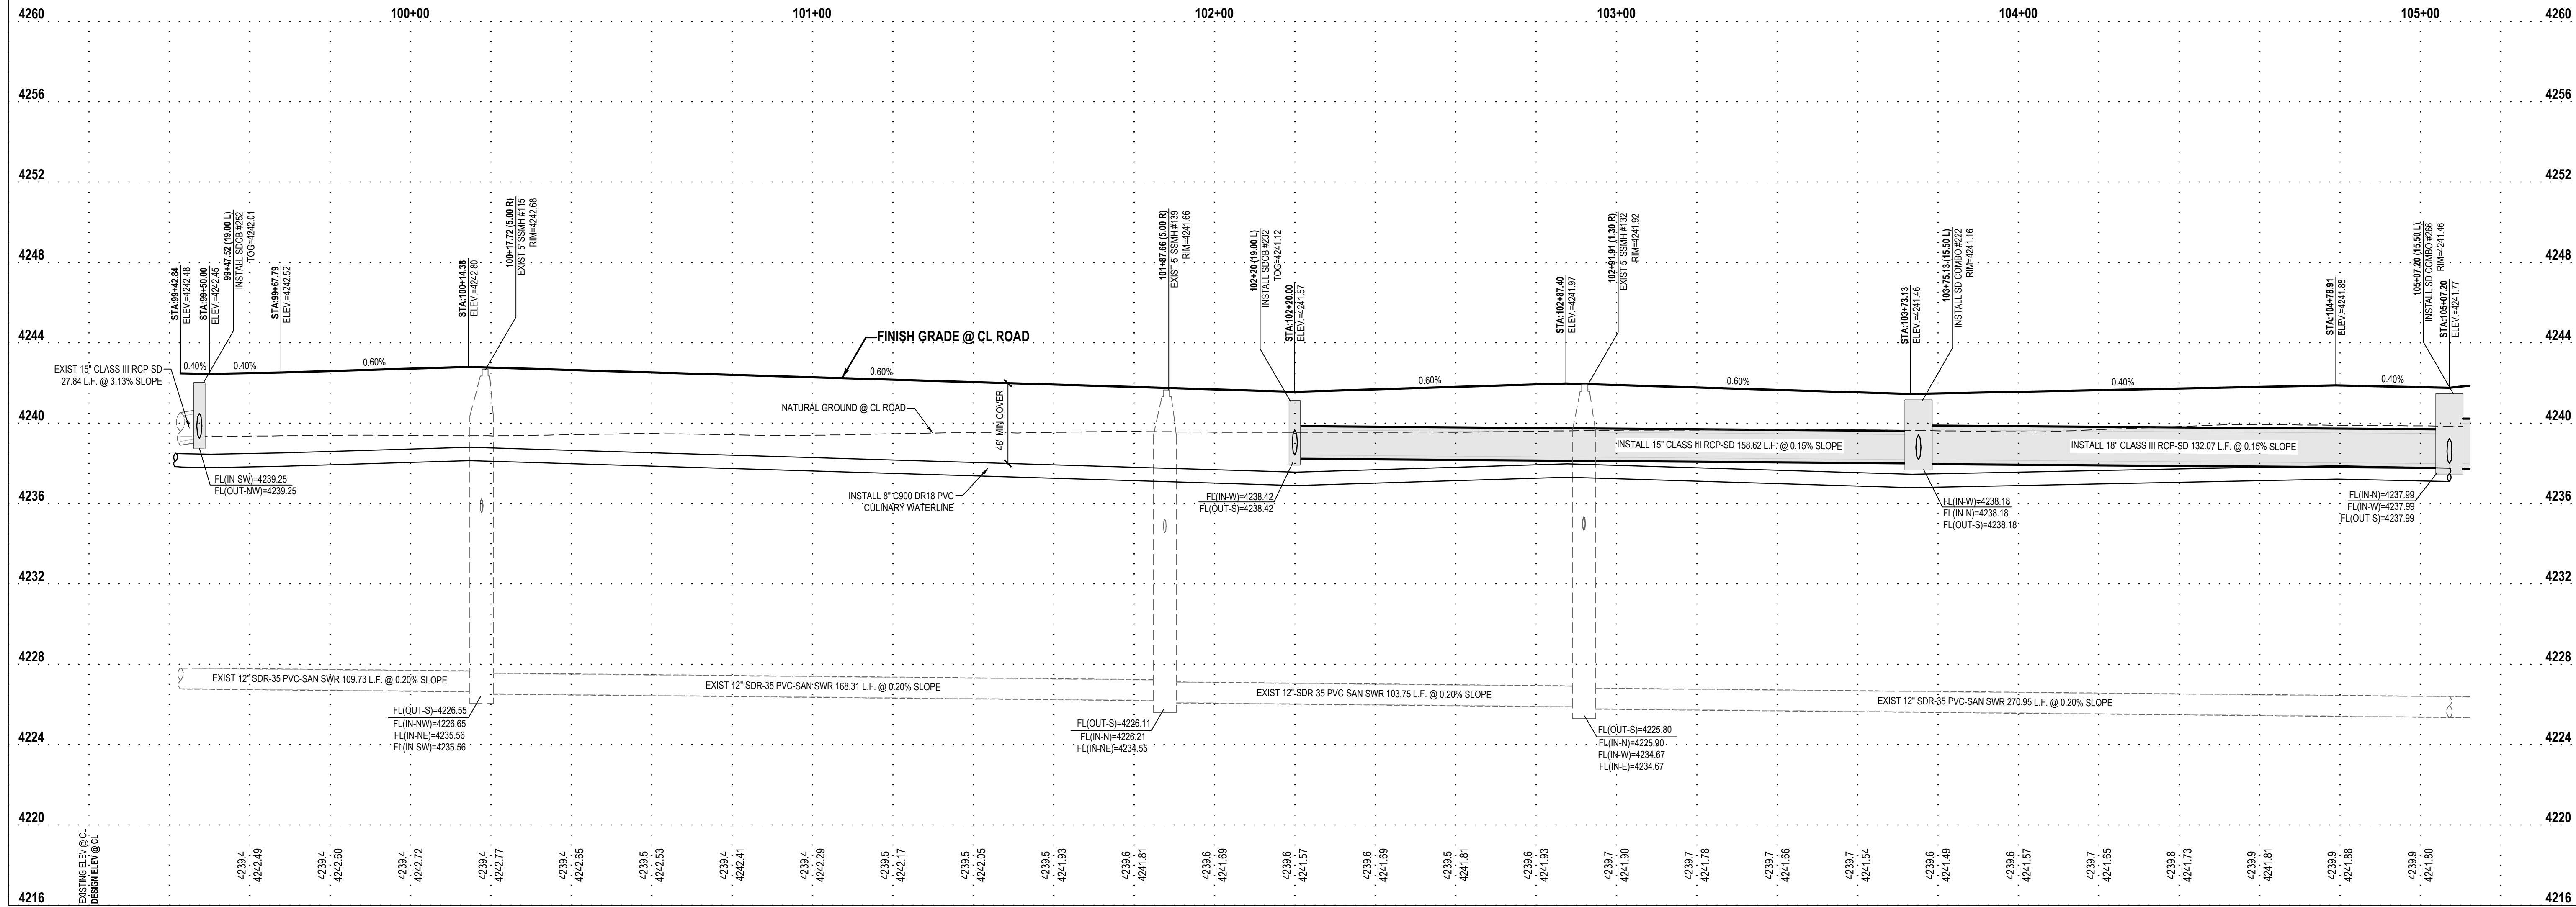

**THE ORCHARDS AT JDC RANCH**  
**PHASE 1**  
**2800 WEST 2600 NORTH STREET**  
**WEBER COUNTY, UTAH**









**2825 WEST STREET  
PLAN AND PROFILE**

PROJECT NUMBER: 9872  
PRINT DATE: 2023-10-09  
PROJECT MANAGER: CP  
DESIGNED BY: TS

**PP-4**



- SCOPE OF WORK:**  
PROVIDE, INSTALL AND/OR CONSTRUCT THE FOLLOWING PER THE SPECIFICATIONS GIVEN OR REFERENCED, THE DETAILS NOTED, AND/OR AS SHOWN ON THE CONSTRUCTION DRAWINGS:
- INSTALL TYPICAL WATER CONNECTION PER BONA VISTA WATER IMPROVEMENT DISTRICT STANDARDS AND SPECIFICATIONS
  - INSTALL 4" SANITARY SEWER SERVICE LATERAL @ 2.00% MINIMUM SLOPE PER PLAIN CITY STANDARDS AND SPECIFICATIONS.
  - INSTALL 1-1/2" PVC DUAL TURNOUT SECONDARY WATER SERVICE LINE PER PINEVIEW WATER SYSTEMS STANDARDS AND SPECIFICATIONS.
  - INSTALL 1" SECONDARY WATER SERVICE LINE PER PINEVIEW WATER SYSTEMS STANDARDS AND SPECIFICATIONS.
  - INSTALL 8" C900 DR18 PVC CULINARY WATERLINE PER BONA VISTA WATER IMPROVEMENT STANDARDS AND SPECIFICATIONS
  - INSTALL 8" C900 DR18 PVC "PURPLE" SECONDARY WATERLINE PER PINEVIEW WATER SYSTEMS STANDARDS AND SPECIFICATIONS
  - FIELD LOCATE AND CONNECT TO EXISTING CULINARY WATERLINE PER BONA VISTA WATER IMPROVEMENT STANDARDS AND SPECIFICATIONS
  - FIELD LOCATE AND CONNECT TO EXISTING SECONDARY WATERLINE PER PINEVIEW WATER SYSTEMS STANDARDS AND SPECIFICATIONS
  - INSTALL FIRE HYDRANT AND VALVE PER BONA VISTA WATER IMPROVEMENT DISTRICT STANDARDS AND SPECIFICATIONS
  - INSTALL STREET LIGHT PER PLAIN CITY STANDARDS AND SPECIFICATIONS.COORDINATE ALL PROPOSED STREET LIGHT LOCATIONS WITH PLAIN CITY AND THE STREET LIGHT INSTALLATION WITH ROCKY MOUNTAIN POWER.
  - PLUG AND BLOCK FOR FUTURE CONNECTION
  - INSTALL 2" POLY SECONDARY WATER SERVICE LINE PER PINEVIEW WATER SYSTEMS STANDARDS AND SPECIFICATIONS (TYP)
  - EXISTING FIRE HYDRANT
  - EXISTING STREET LIGHT
  - EXISTING 8" C900 DR18 PVC CULINARY WATERLINE
  - EXISTING 8" C900 DR18 PVC "PURPLE" SECONDARY WATERLINE
  - INSTALL 2" BLOW-OFF
  - INSTALL 4" C900 DR18 PVC PRIVATE CULINARY WATERLINE PER BONA VISTA STANDARDS AND SPECIFICATIONS
  - INSTALL 2" TEMPORARY BLOW-OFF PER BONA VISTA STANDARDS AND SPECIFICATIONS

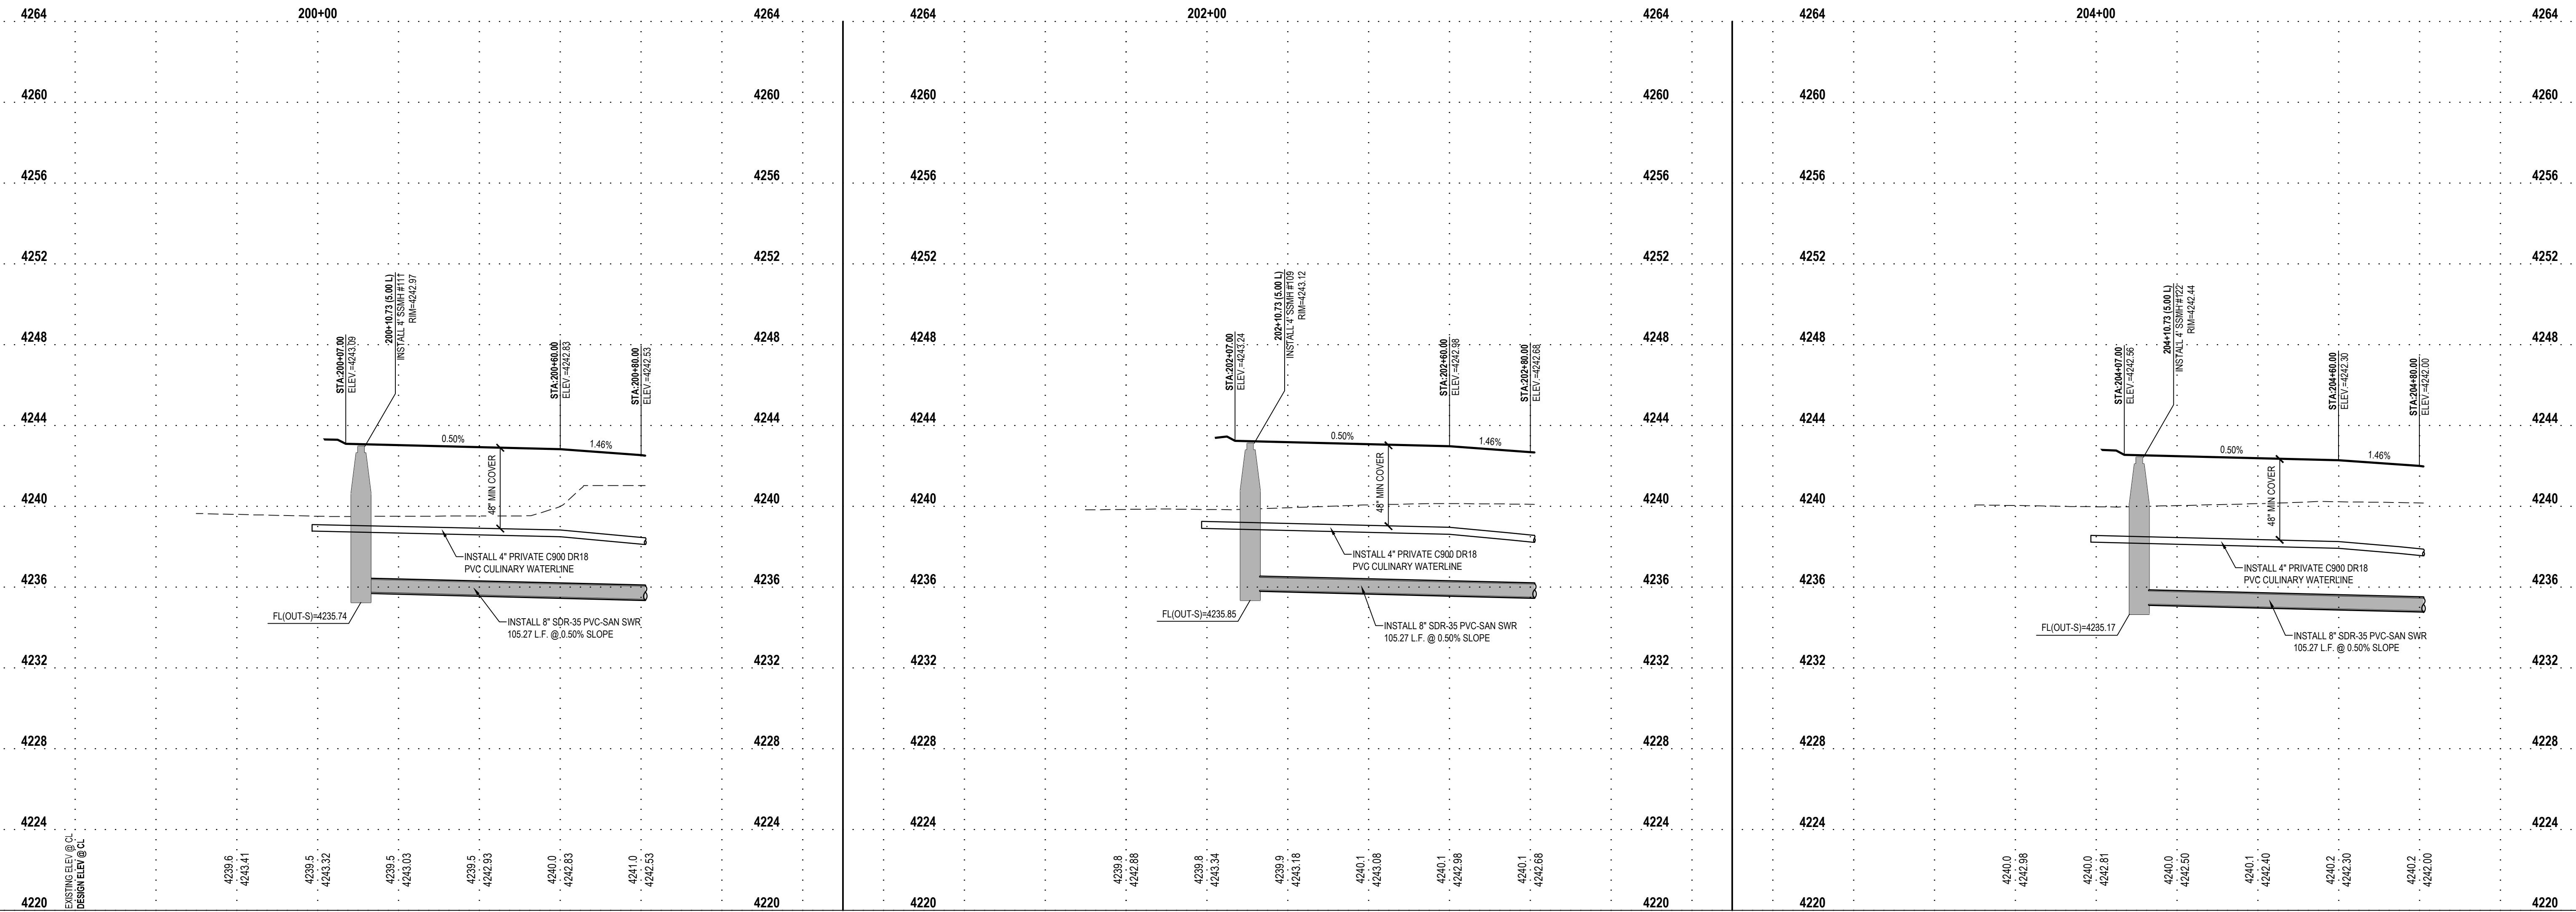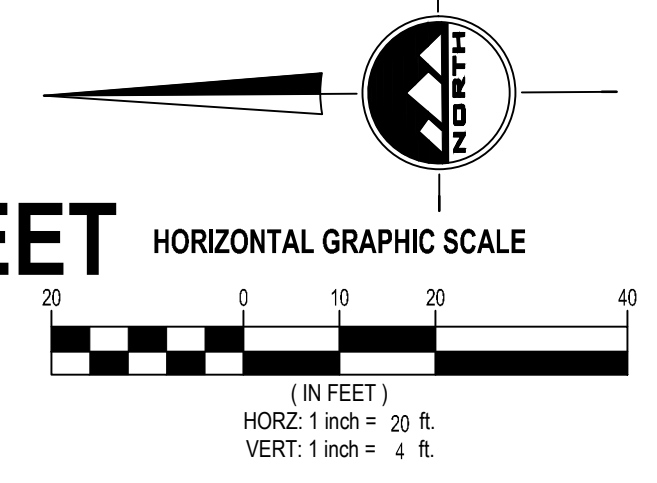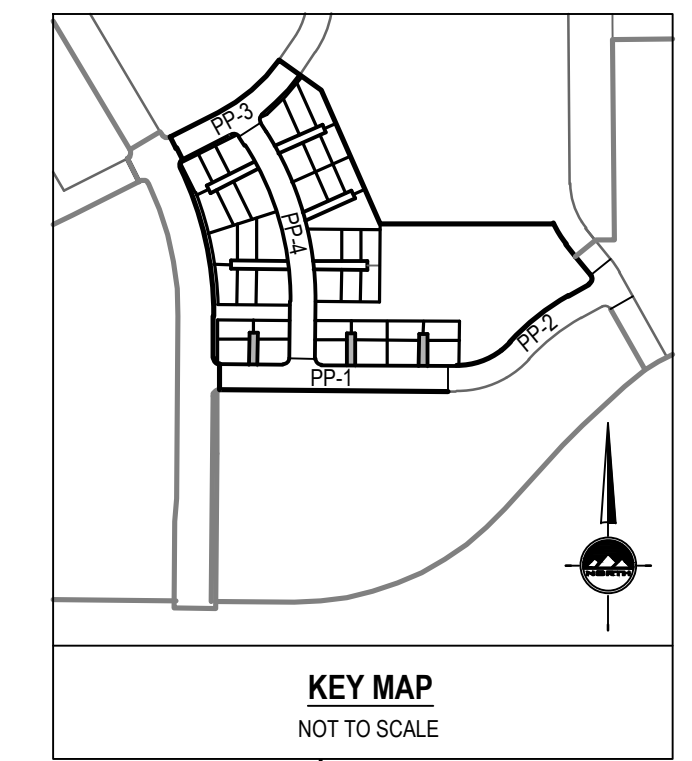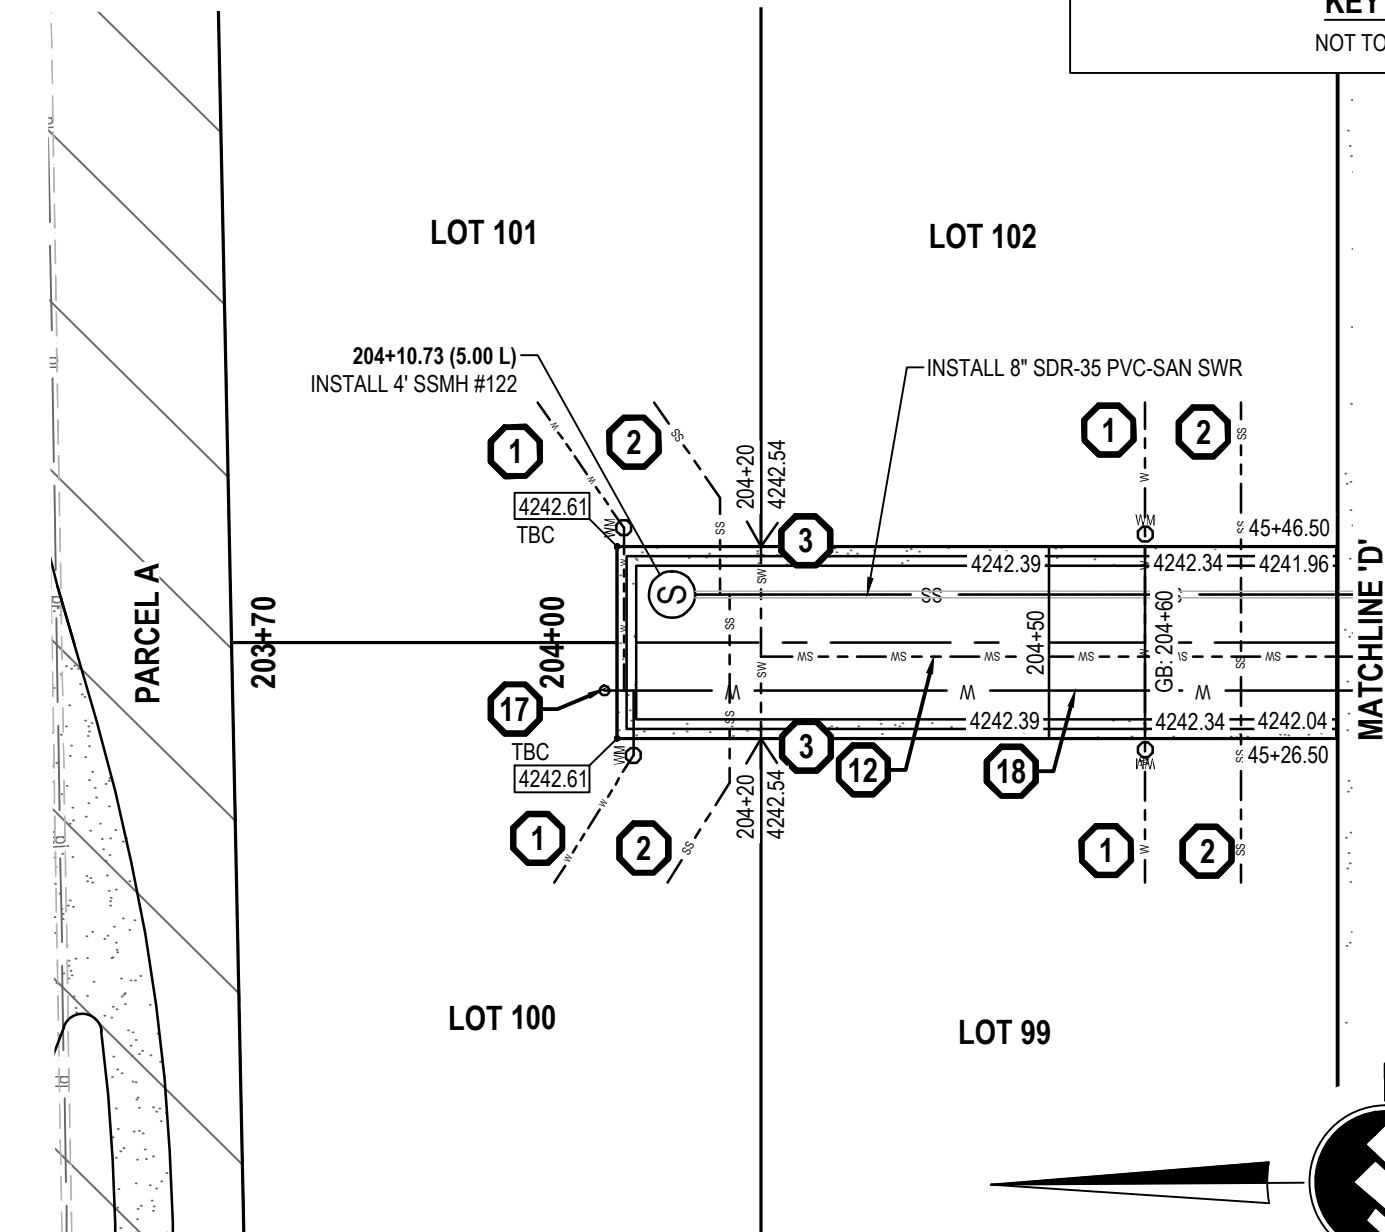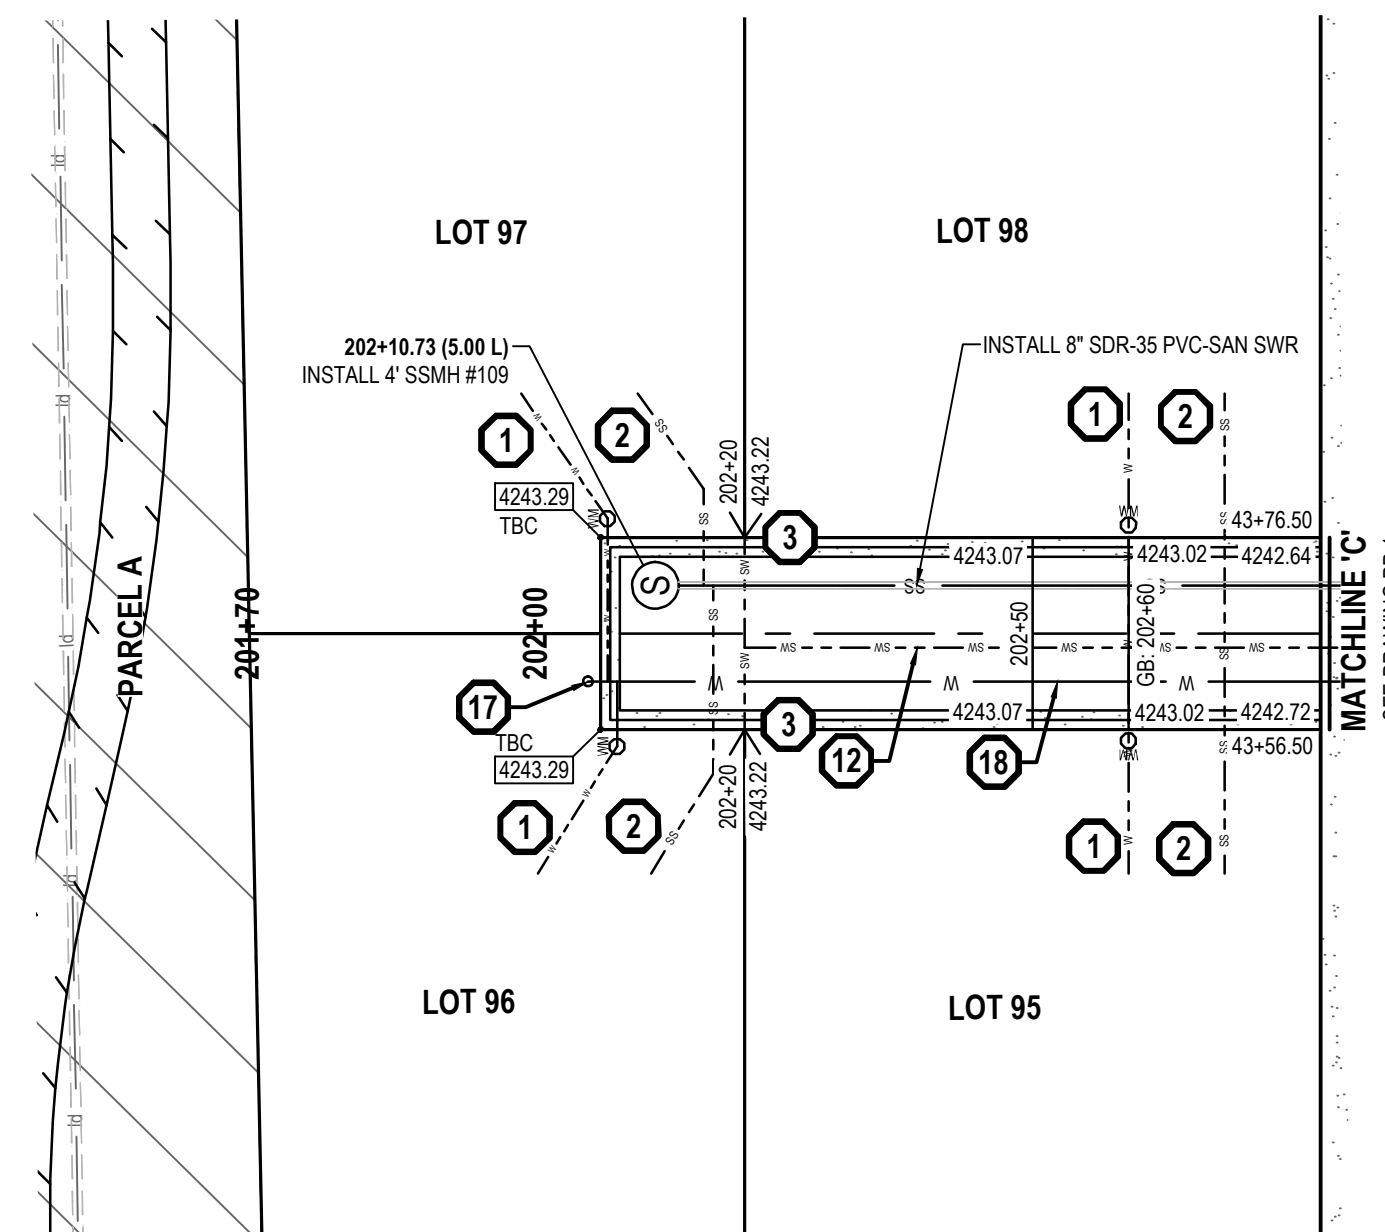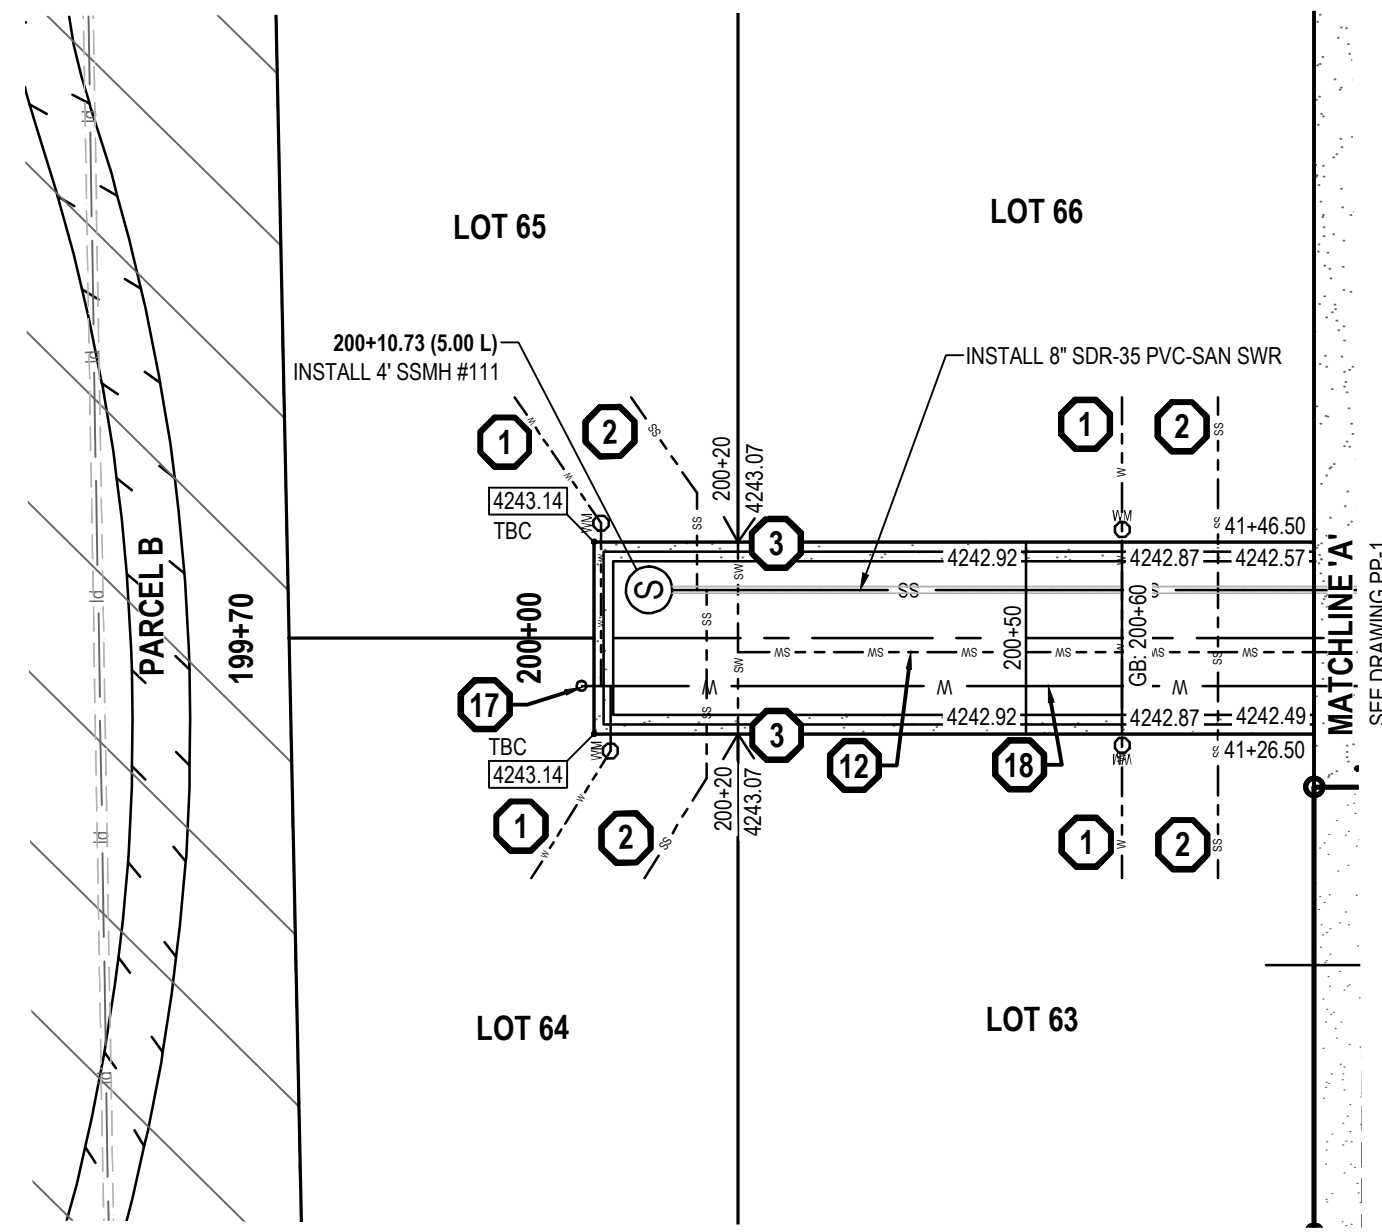

**ENSIGN**  
THE STANDARD IN ENGINEERING

LAYTON  
919 North 400 West  
Layton, UT 84041  
Phone: 801.547.1100

SANDY  
Phone: 801.255.0529

TOOELE  
Phone: 435.843.3590

CEDAR CITY  
Phone: 435.865.1453

RICHFIELD  
Phone: 435.896.2983

WWW.ENSIGNENG.COM

FOR:  
NILSON HOMES  
1740 COMBE RD, SUITE 2  
SOUTH OGDEN, UT 84403

CONTACT:  
STEVE ANDERSON  
PHONE: 801.392.8100

**THE ORCHARDS AT JDC RANCH**  
**PHASE 1**  
2800 WEST 2600 NORTH STREET  
WEBER COUNTY, UTAH



NO. DATE REVISION FOR REVIEW

**2830 WEST STREET,  
2810 WEST STREET,  
AND 2780 WEST STREET  
PLAN AND PROFILE**

PROJECT NUMBER 9872 PRINT DATE 2023-10-09  
PROJECT MANAGER CP DESIGNED BY TS



**811**  
Know what's below.  
Call before you dig.

CALL BLUESTAKES  
@ 811 AT LEAST 48 HOURS  
PRIOR TO THE  
COMMENCEMENT OF ANY  
CONSTRUCTION.


**BENCHMARK**

NORTHWEST CORNER OF SECTION 27  
TOWNSHIP 7 NORTH, RANGE 2 WEST  
SALT LAKE BASE AND MERIDIAN  
ELEV = 4231.00'

- SCOPE OF WORK:**  
PROVIDE, INSTALL AND/OR CONSTRUCT THE FOLLOWING PER THE SPECIFICATIONS GIVEN OR REFERENCED, THE DETAILS NOTED, AND/OR AS SHOWN ON THE CONSTRUCTION DRAWINGS:
1. INSTALL TYPICAL WATER CONNECTION PER BONA VISTA WATER IMPROVEMENT DISTRICT STANDARDS AND SPECIFICATIONS
  2. INSTALL 4" SANITARY SEWER SERVICE LATERAL @ 2.00% MINIMUM SLOPE PER PLAIN CITY STANDARDS AND SPECIFICATIONS.
  3. INSTALL 1-1/2" PVC DUAL TURNOUT SECONDARY WATER SERVICE LINE PER PINEVIEW WATER SYSTEMS STANDARDS AND SPECIFICATIONS.
  4. INSTALL 1" SECONDARY WATER SERVICE LINE PER PINEVIEW WATER SYSTEMS STANDARDS AND SPECIFICATIONS.
  5. INSTALL 8" C900 DR18 PVC CULINARY WATERLINE PER BONA VISTA WATER IMPROVEMENT STANDARDS AND SPECIFICATIONS
  6. INSTALL 8" C900 DR18 PVC "PURPLE" SECONDARY WATERLINE PER PINEVIEW WATER SYSTEMS STANDARDS AND SPECIFICATIONS
  7. FIELD LOCATE AND CONNECT TO EXISTING CULINARY WATERLINE PER BONA VISTA WATER IMPROVEMENT STANDARDS AND SPECIFICATIONS
  8. FIELD LOCATE AND CONNECT TO EXISTING SECONDARY WATERLINE PER PINEVIEW WATER SYSTEMS STANDARDS AND SPECIFICATIONS
  9. INSTALL FIRE HYDRANT AND VALVE PER BONA VISTA WATER IMPROVEMENT DISTRICT STANDARDS AND SPECIFICATIONS
  10. INSTALL STREET LIGHT PER PLAIN CITY STANDARDS AND SPECIFICATIONS. COORDINATE ALL PROPOSED STREET LIGHT LOCATIONS WITH PLAIN CITY AND THE STREET LIGHT INSTALLATION WITH ROCKY MOUNTAIN POWER.
  11. PLUG AND BLOCK FOR FUTURE CONNECTION
  12. INSTALL 2" POLY SECONDARY WATER SERVICE LINE PER PINEVIEW WATER SYSTEMS STANDARDS AND SPECIFICATIONS (TYP)
  13. EXISTING FIRE HYDRANT
  14. EXISTING STREET LIGHT
  15. EXISTING 8" C900 DR18 PVC CULINARY WATERLINE
  16. EXISTING 8" C900 DR18 PVC "PURPLE" SECONDARY WATERLINE
  17. INSTALL 2" BLOW-OFF
  18. INSTALL 4" C900 DR18 PVC PRIVATE CULINARY WATERLINE PER BONA VISTA STANDARDS AND SPECIFICATIONS
  19. INSTALL 2" TEMPORARY BLOW-OFF PER BONA VISTA STANDARDS AND SPECIFICATIONS



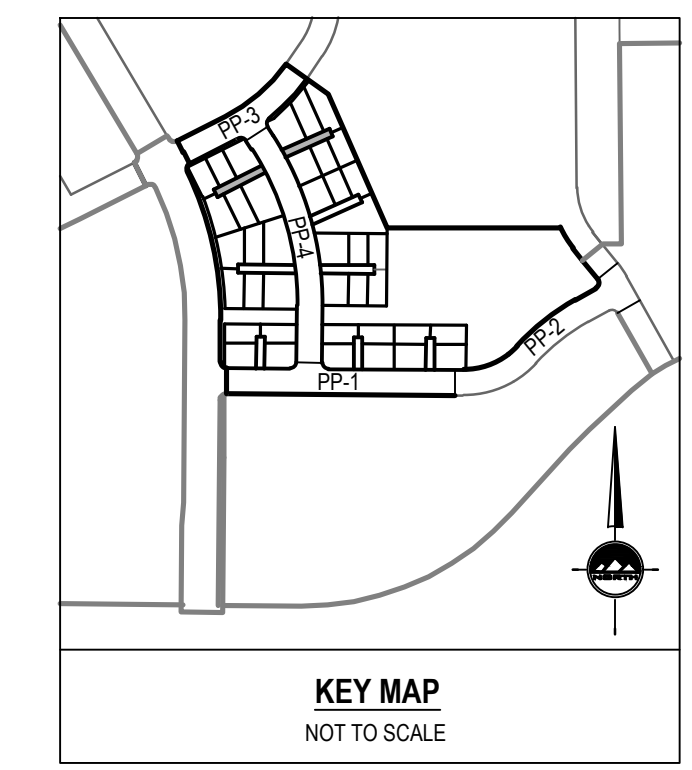

**ENSIGN**  
THE STANDARD IN ENGINEERING

**LAYTON**  
919 North 400 West  
Layton, UT 84041  
Phone: 801.547.1100

**SANDY**  
Phone: 801.255.0529

**TOOELE**  
Phone: 435.843.3590





**CEDAR CITY**  
Phone: 435.865.1453

**RICHFIELD**  
Phone: 435.896.2983


**WWW.ENSIGNENG.COM**

FOR:  
NILSON HOMES  
1740 COMBE RD, SUITE 2  
SOUTH OGDEN, UT 84403

CONTACT:  
STEVE ANDERSON  
PHONE: 801.392.8100

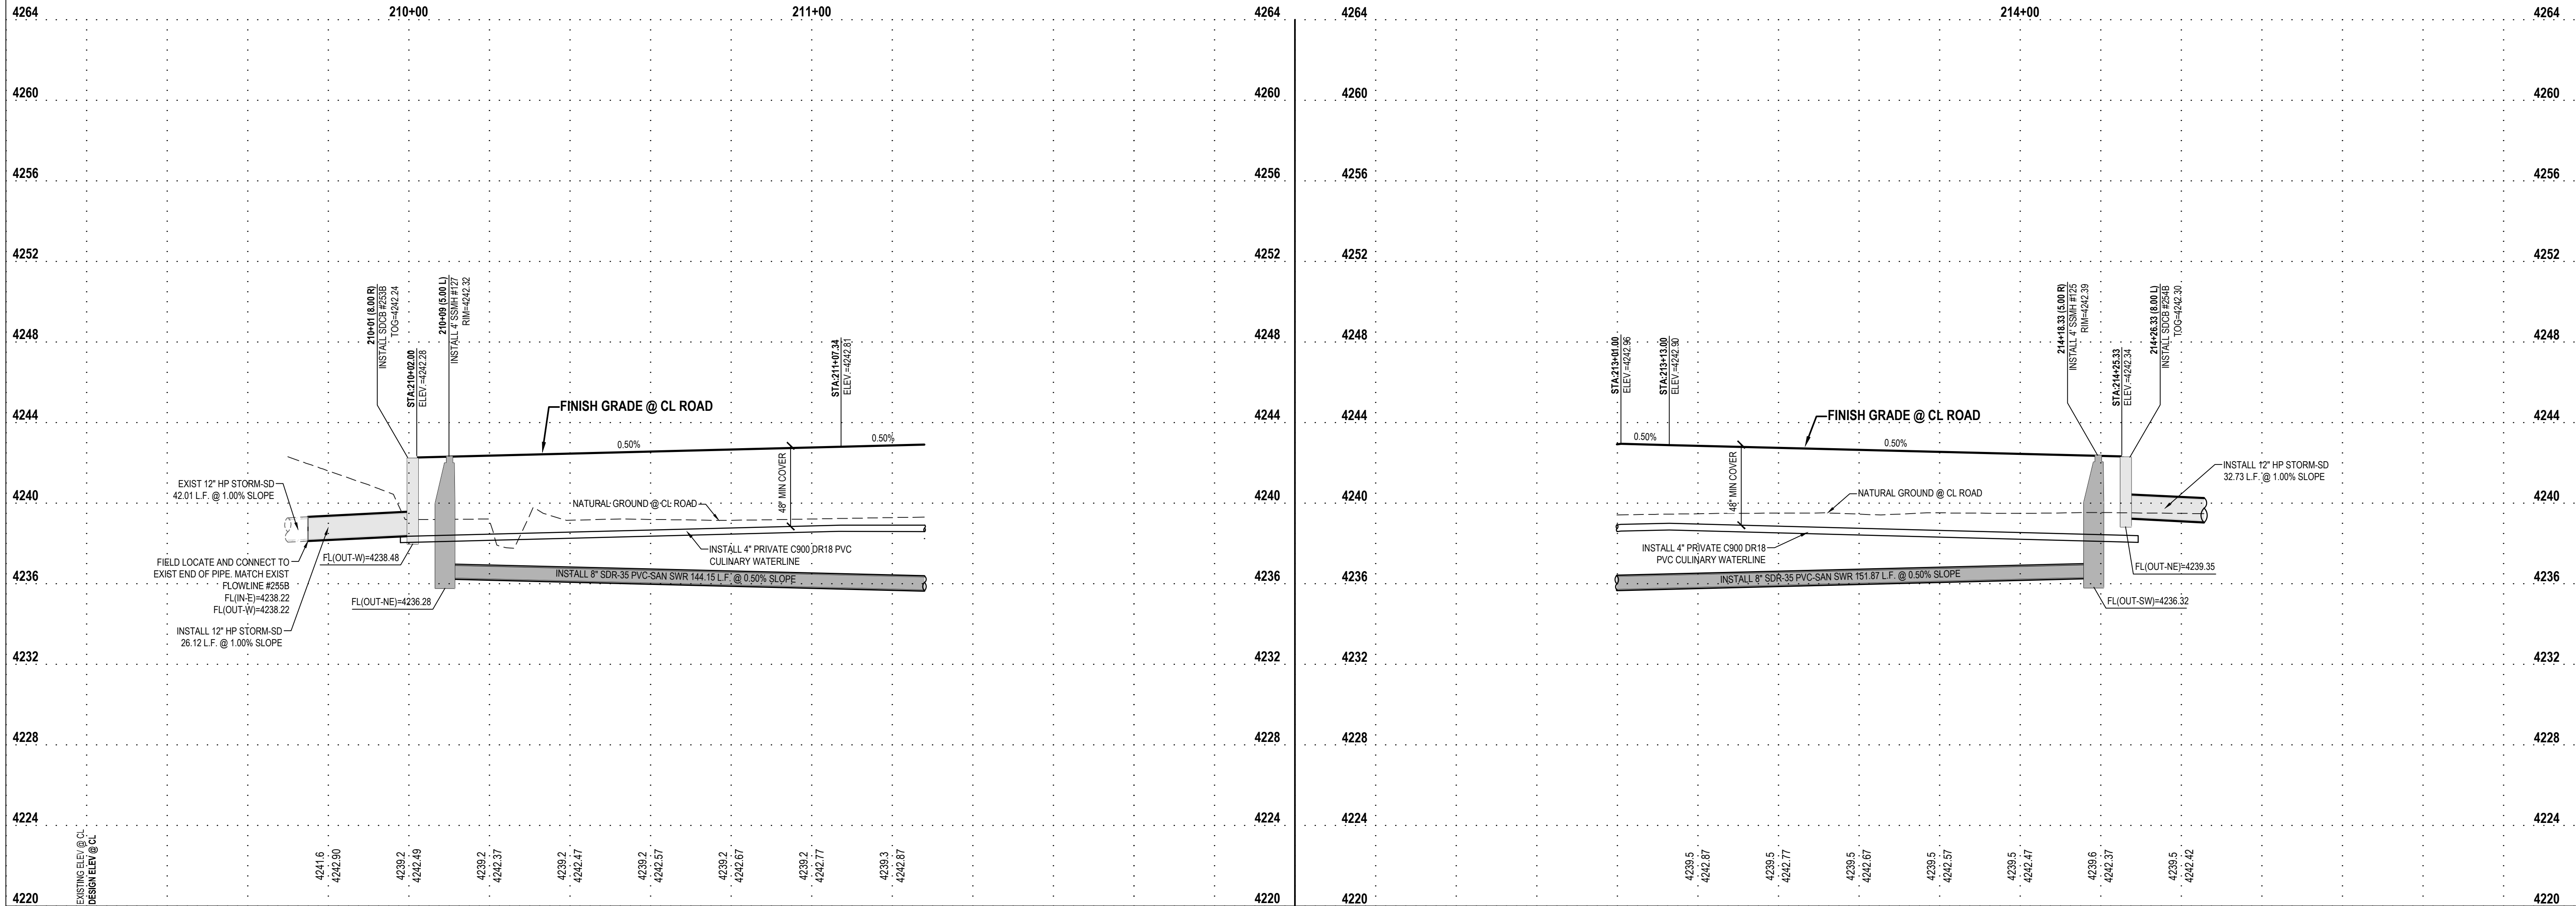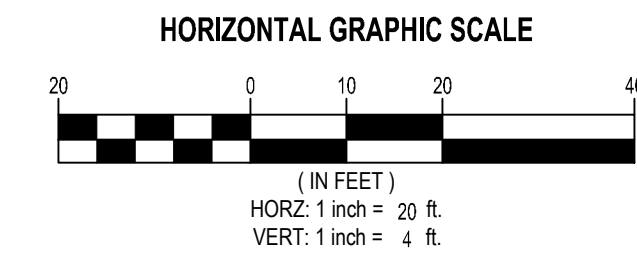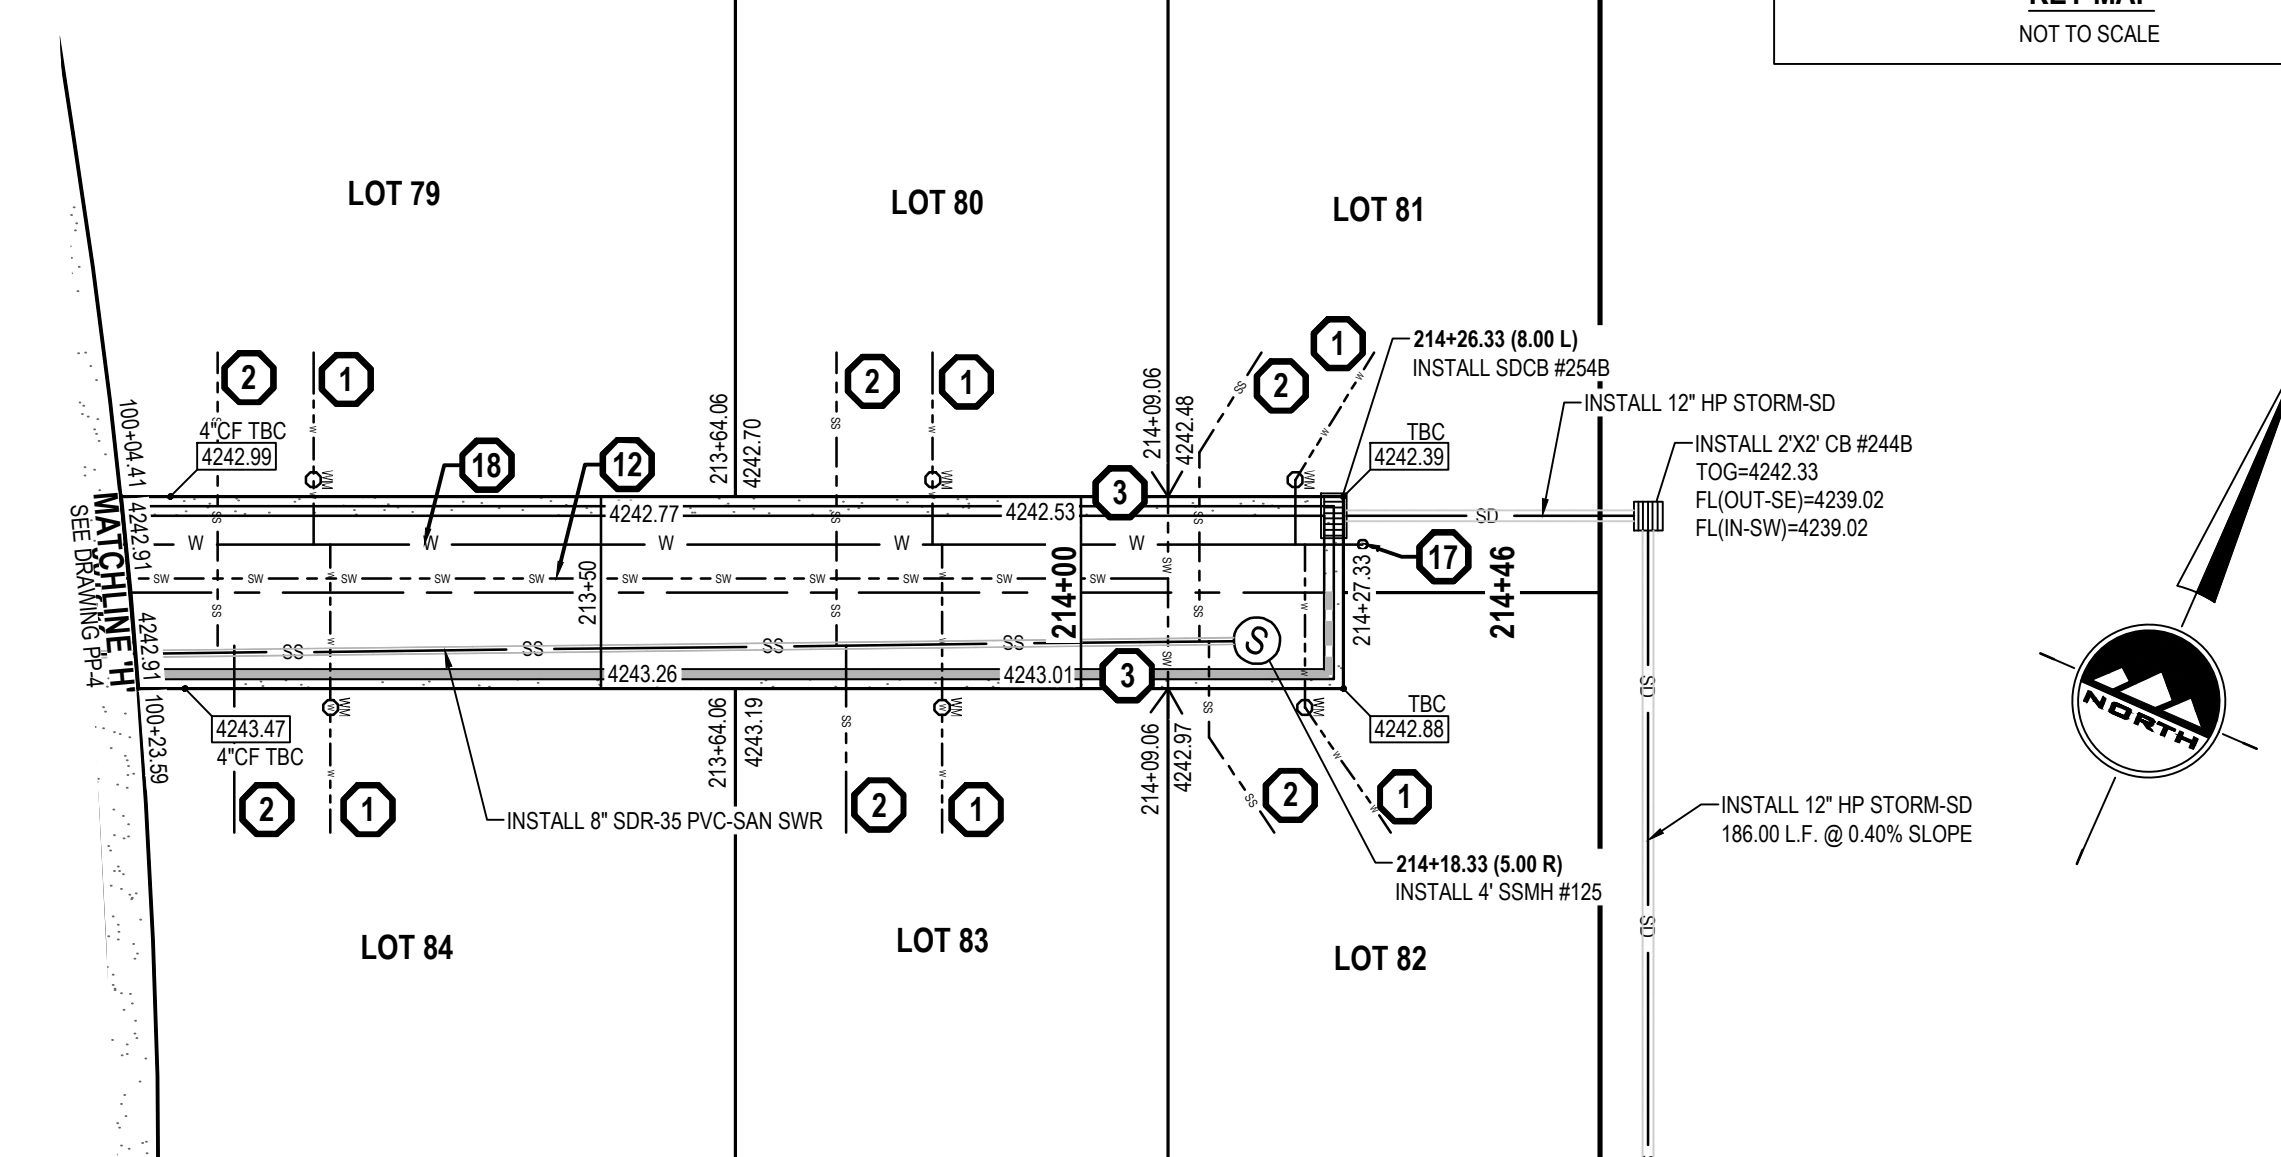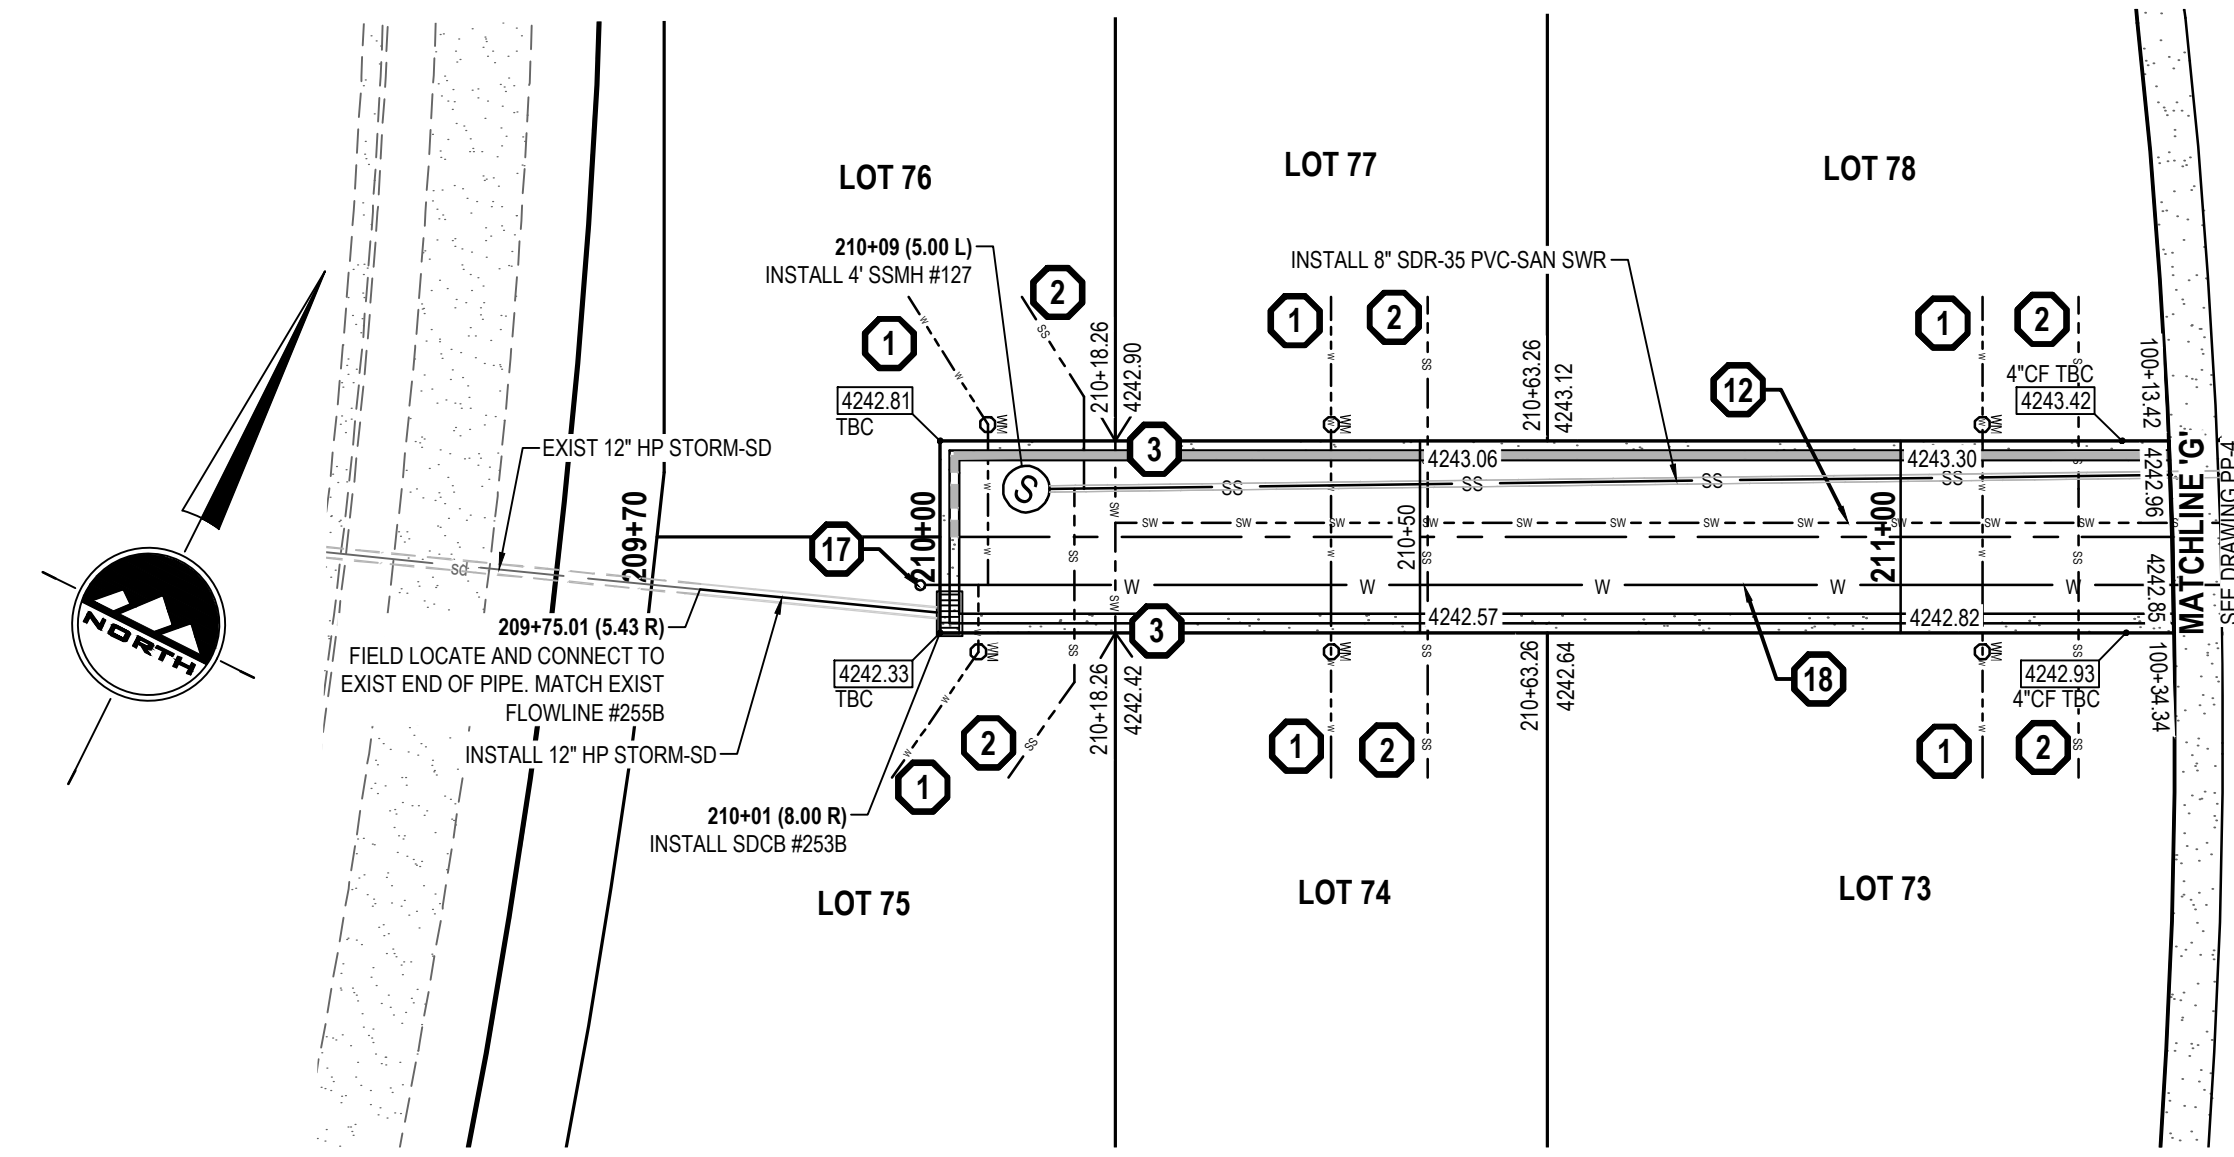

**THE ORCHARDS AT JDC RANCH**  
**PHASE 1**  
2800 WEST 2600 NORTH STREET  
WEBER COUNTY, UTAH

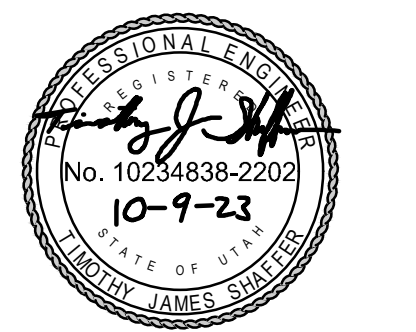

NO. DATE REVISION FOR REVIEW

**2720 NORTH STREET**  
**PLAN AND PROFILE**

PROJECT NUMBER: 9872  
PRINT DATE: 2023-10-09  
PROJECT MANAGER: CP  
DESIGNED BY: TS

**PP-6**





CALL BLUESTAKES  
@ 811 AT LEAST 48 HOURS  
PRIOR TO THE  
COMMENCEMENT OF ANY  
CONSTRUCTION.


**BENCHMARK**

NORTHWEST CORNER OF SECTION 27  
TOWNSHIP 7 NORTH, RANGE 2 WEST  
SALT LAKE BASE AND MERIDIAN  
ELEV = 4231.00'




**SCOPE OF WORK:**

PROVIDE, INSTALL AND/OR CONSTRUCT THE FOLLOWING PER THE SPECIFICATIONS GIVEN OR REFERENCED, THE DETAILS NOTED, AND/OR AS SHOWN ON THE CONSTRUCTION DRAWINGS:

- 1 INSTALL TYPICAL WATER CONNECTION PER BONA VISTA WATER IMPROVEMENT DISTRICT STANDARDS AND SPECIFICATIONS
- 2 INSTALL 4" SANITARY SEWER SERVICE LATERAL @ 2.00% MINIMUM SLOPE PER PLAIN CITY STANDARDS AND SPECIFICATIONS.
- 3 INSTALL 1-1/2" PVC DUAL TURNOUT SECONDARY WATER SERVICE LINE PER PINEVIEW WATER SYSTEMS STANDARDS AND SPECIFICATIONS.
- 4 INSTALL 1" SECONDARY WATER SERVICE LINE PER PINEVIEW WATER SYSTEMS STANDARDS AND SPECIFICATIONS.
- 5 INSTALL 8" C900 DR18 PVC CULINARY WATERLINE PER BONA VISTA WATER IMPROVEMENT STANDARDS AND SPECIFICATIONS
- 6 INSTALL 8" C900 DR18 PVC "PURPLE" SECONDARY WATERLINE PER PINEVIEW WATER SYSTEMS STANDARDS AND SPECIFICATIONS
- 7 FIELD LOCATE AND CONNECT TO EXISTING CULINARY WATERLINE PER BONA VISTA WATER IMPROVEMENT STANDARDS AND SPECIFICATIONS
- 8 FIELD LOCATE AND CONNECT TO EXISTING SECONDARY WATERLINE PER PINEVIEW WATER SYSTEMS STANDARDS AND SPECIFICATIONS
- 9 INSTALL FIRE HYDRANT AND VALVE PER BONA VISTA WATER IMPROVEMENT DISTRICT STANDARDS AND SPECIFICATIONS
- 10 INSTALL STREET LIGHT PER PLAIN CITY STANDARDS AND SPECIFICATIONS. COORDINATE ALL PROPOSED STREET LIGHT LOCATIONS WITH PLAIN CITY AND THE STREET LIGHT INSTALLATION WITH ROCKY MOUNTAIN POWER.
- 11 PLUG AND BLOCK FOR FUTURE CONNECTION
- 12 INSTALL 2" POLY SECONDARY WATER SERVICE LINE PER PINEVIEW WATER SYSTEMS STANDARDS AND SPECIFICATIONS (TYP)
- 13 EXISTING FIRE HYDRANT
- 14 EXISTING STREET LIGHT
- 15 EXISTING 8" C900 DR18 PVC CULINARY WATERLINE
- 16 EXISTING 8" C900 DR18 PVC "PURPLE" SECONDARY WATERLINE
- 17 INSTALL 2" BLOW-OFF
- 18 INSTALL 4" C900 DR18 PVC PRIVATE CULINARY WATERLINE PER BONA VISTA STANDARDS AND SPECIFICATIONS
- 19 INSTALL 2" TEMPORARY BLOW-OFF PER BONA VISTA STANDARDS AND SPECIFICATIONS

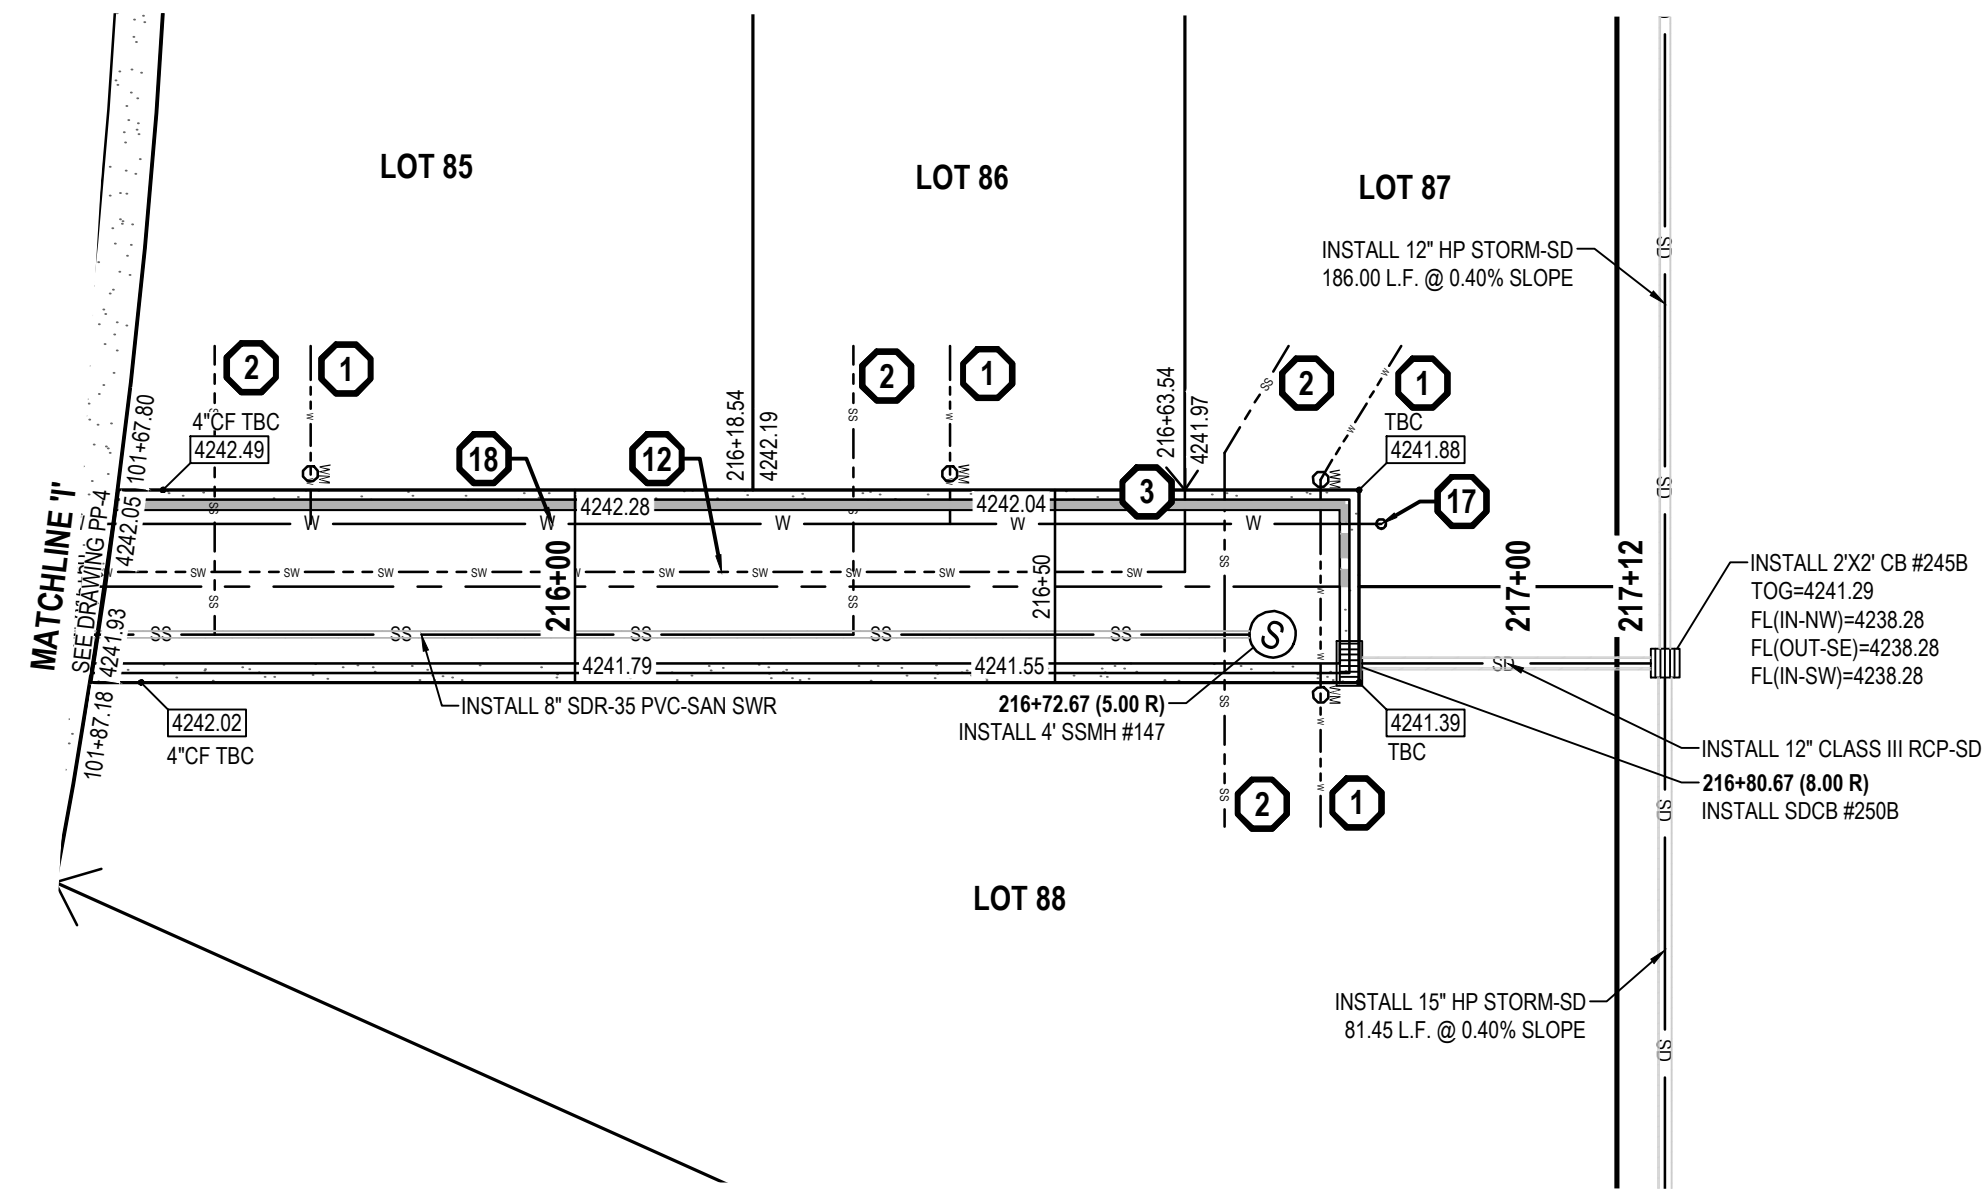


**2710 NORTH STREET**

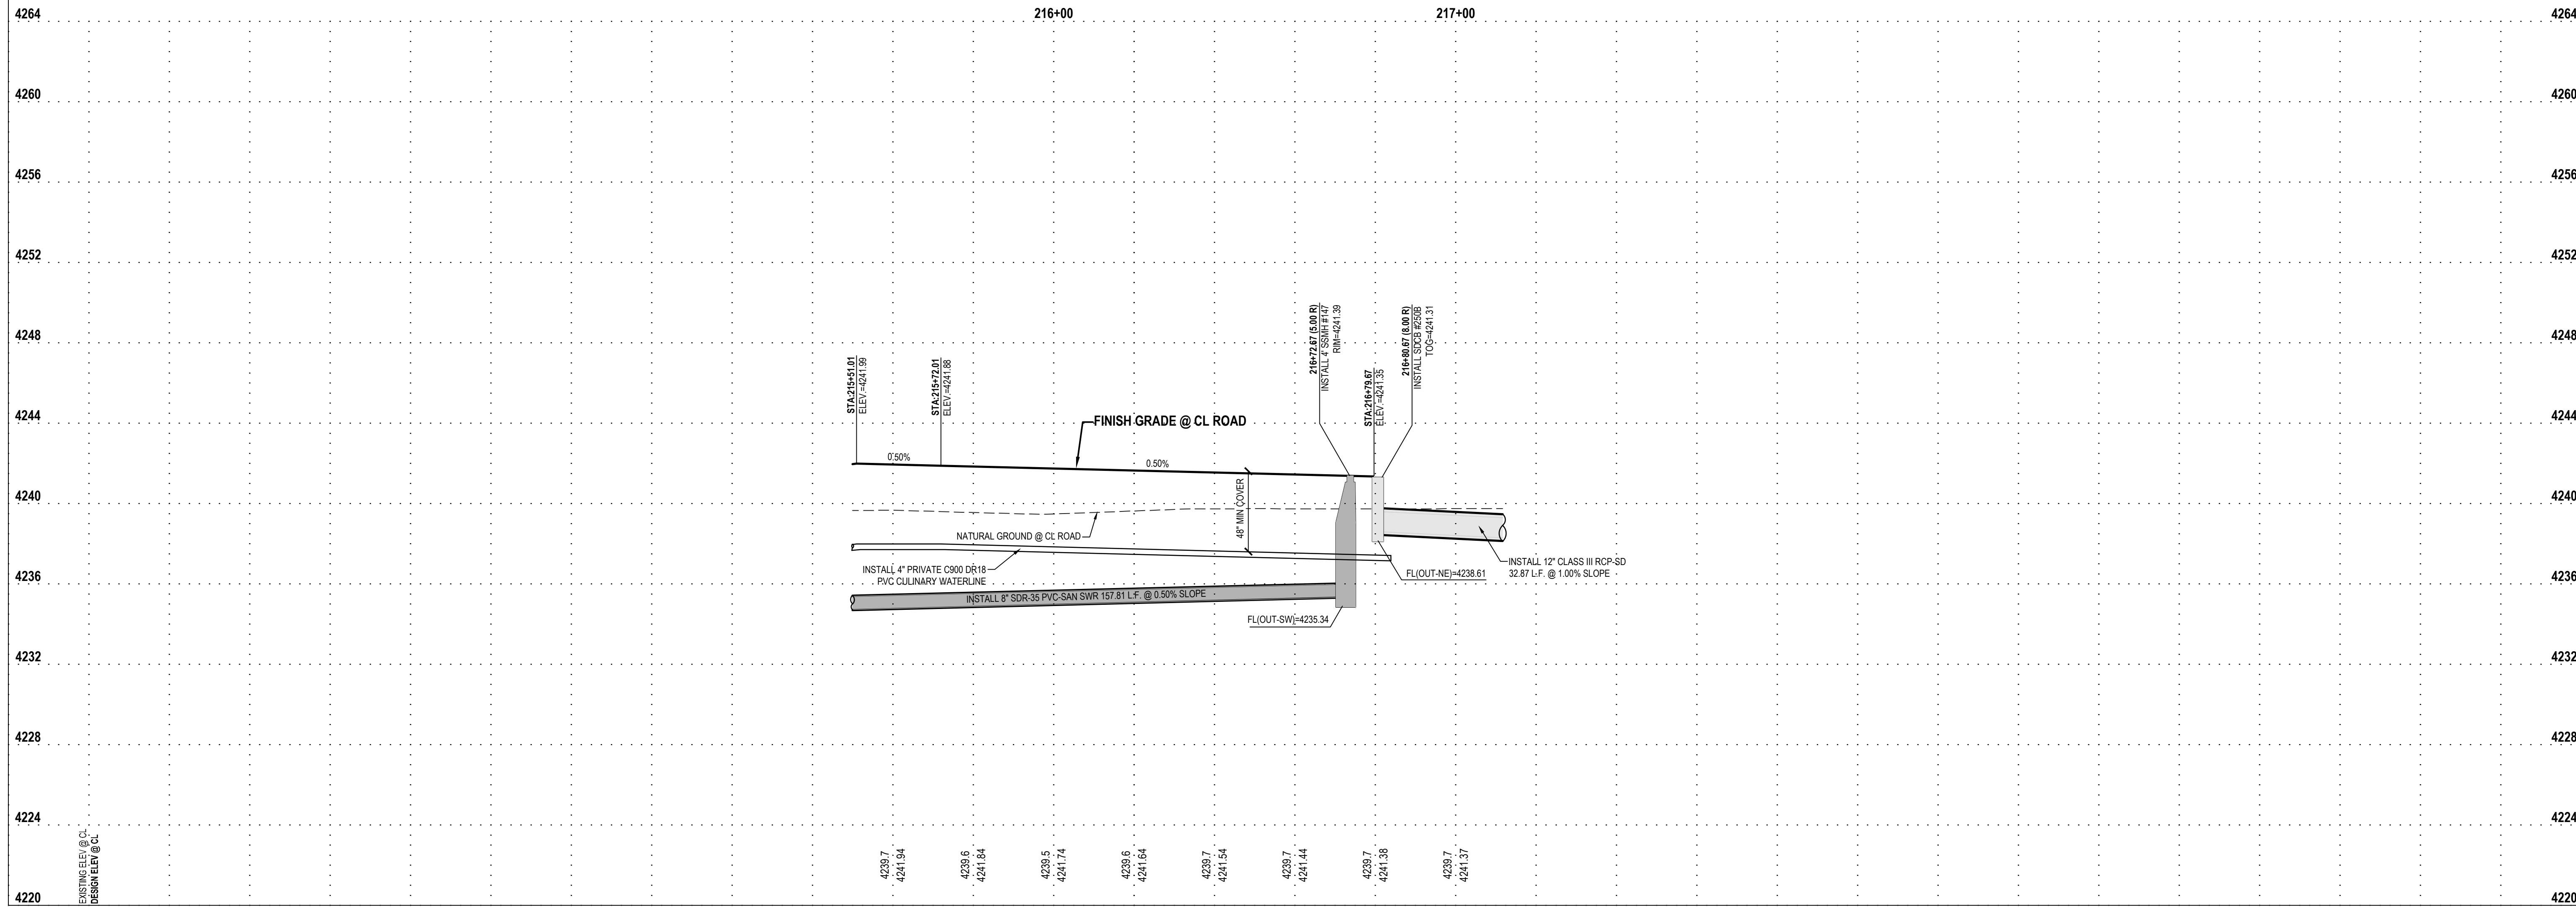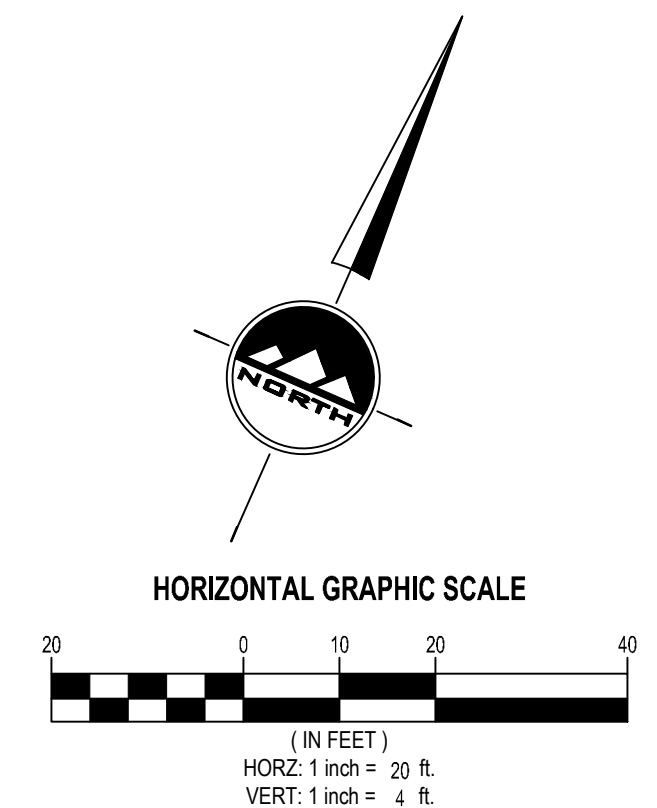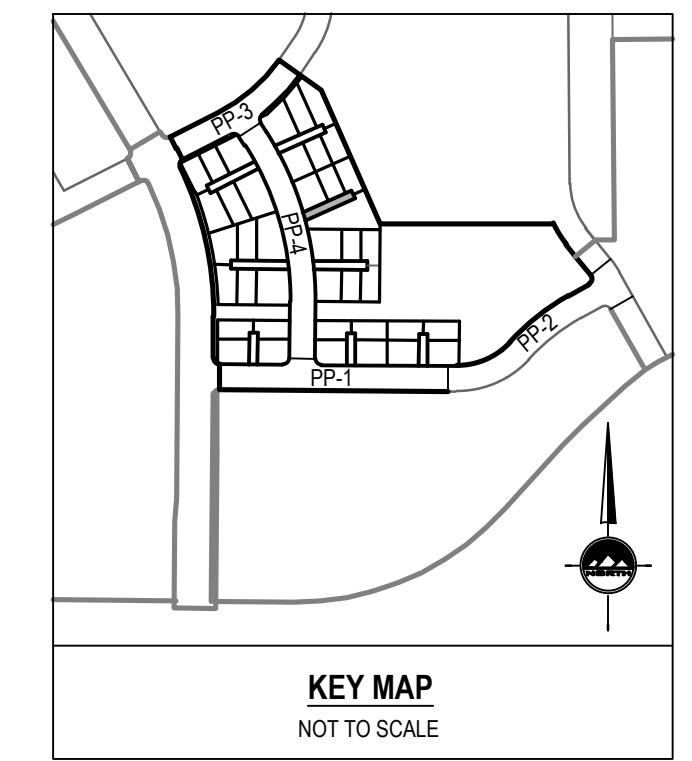

**THE ORCHARDS AT JDC RANCH**  
**PHASE 1**  
2800 WEST 2600 NORTH STREET  
WEBER COUNTY, UTAH

**ENSIGN**  
THE STANDARD IN ENGINEERING  
LAYTON  
919 North 400 West  
Layton, UT 84041  
Phone: 801.547.1100  
SANDY  
Phone: 801.255.0529  
TOOELE  
Phone: 435.843.3590  
CEDAR CITY  
Phone: 435.865.1453  
RICHFIELD  
Phone: 435.896.2983  
[WWW.ENSIGNENG.COM](http://WWW.ENSIGNENG.COM)

FOR:  
NILSON HOMES  
1740 COMBE RD, SUITE 2  
SOUTH OGDEN, UT 84403  
CONTACT:  
STEVE ANDERSON  
PHONE: 801.392.8100

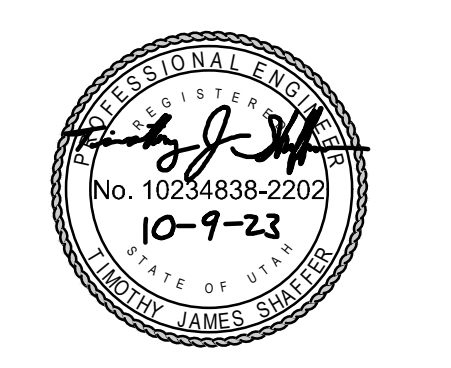

2710 NORTH STREET  
PLAN AND PROFILE

PROJECT NUMBER: 9872  
PRINT DATE: 2023-10-09  
PROJECT MANAGER: CP  
DESIGNED BY: TS

**PP-7**





CALL BLUESTAKES  
@ 811 AT LEAST 48 HOURS  
PRIOR TO THE  
COMMENCEMENT OF ANY  
CONSTRUCTION.



**BENCHMARK**

NORTHWEST CORNER OF SECTION 27  
TOWNSHIP 7 NORTH, RANGE 2 WEST  
SALT LAKE BASE AND MERIDIAN  
ELEV = 4231.00'


**SCOPE OF WORK:**

PROVIDE, INSTALL AND/OR CONSTRUCT THE FOLLOWING PER THE SPECIFICATIONS GIVEN OR REFERENCED, THE DETAILS NOTED, AND/OR AS SHOWN ON THE CONSTRUCTION DRAWINGS:



- 1 INSTALL TYPICAL WATER CONNECTION PER BONA VISTA WATER IMPROVEMENT DISTRICT STANDARDS AND SPECIFICATIONS
- 2 INSTALL 4" SANITARY SEWER SERVICE LATERAL @ 2.00% MINIMUM SLOPE PER PLAIN CITY STANDARDS AND SPECIFICATIONS.
- 3 INSTALL 1-1/2" PVC DUAL TURN-OUT SECONDARY WATER SERVICE LINE PER PINEVIEW WATER SYSTEMS STANDARDS AND SPECIFICATIONS.
- 4 INSTALL 1" SECONDARY WATER SERVICE LINE PER PINEVIEW WATER SYSTEMS STANDARDS AND SPECIFICATIONS.
- 5 INSTALL 8" C900 DR18 PVC CULINARY WATERLINE PER BONA VISTA WATER IMPROVEMENT STANDARDS AND SPECIFICATIONS
- 6 INSTALL 8" C900 DR18 PVC "PURPLE" SECONDARY WATERLINE PER PINEVIEW WATER SYSTEMS STANDARDS AND SPECIFICATIONS
- 7 FIELD LOCATE AND CONNECT TO EXISTING CULINARY WATERLINE PER BONA VISTA WATER IMPROVEMENT STANDARDS AND SPECIFICATIONS
- 8 FIELD LOCATE AND CONNECT TO EXISTING SECONDARY WATERLINE PER PINEVIEW WATER SYSTEMS STANDARDS AND SPECIFICATIONS
- 9 INSTALL FIRE HYDRANT AND VALVE PER BONA VISTA WATER IMPROVEMENT DISTRICT STANDARDS AND SPECIFICATIONS
- 10 INSTALL STREET LIGHT PER PLAIN CITY STANDARDS AND SPECIFICATIONS.COORDINATE ALL PROPOSED STREET LIGHT LOCATIONS WITH PLAIN CITY AND THE STREET LIGHT INSTALLATION WITH ROCKY MOUNTAIN POWER.
- 11 PLUG AND BLOCK FOR FUTURE CONNECTION
- 12 INSTALL 2" POLY SECONDARY WATER SERVICE LINE PER PINEVIEW WATER SYSTEMS STANDARDS AND SPECIFICATIONS (TYP)
- 13 EXISTING FIRE HYDRANT
- 14 EXISTING STREET LIGHT
- 15 EXISTING 8" C900 DR18 PVC CULINARY WATERLINE
- 16 EXISTING 8" C900 DR18 PVC "PURPLE" SECONDARY WATERLINE
- 17 INSTALL 2" BLOW-OFF
- 18 INSTALL 4" C900 DR18 PVC PRIVATE CULINARY WATERLINE PER BONA VISTA STANDARDS AND SPECIFICATIONS
- 19 INSTALL 2" TEMPORARY BLOW-OFF PER BONA VISTA STANDARDS AND SPECIFICATIONS

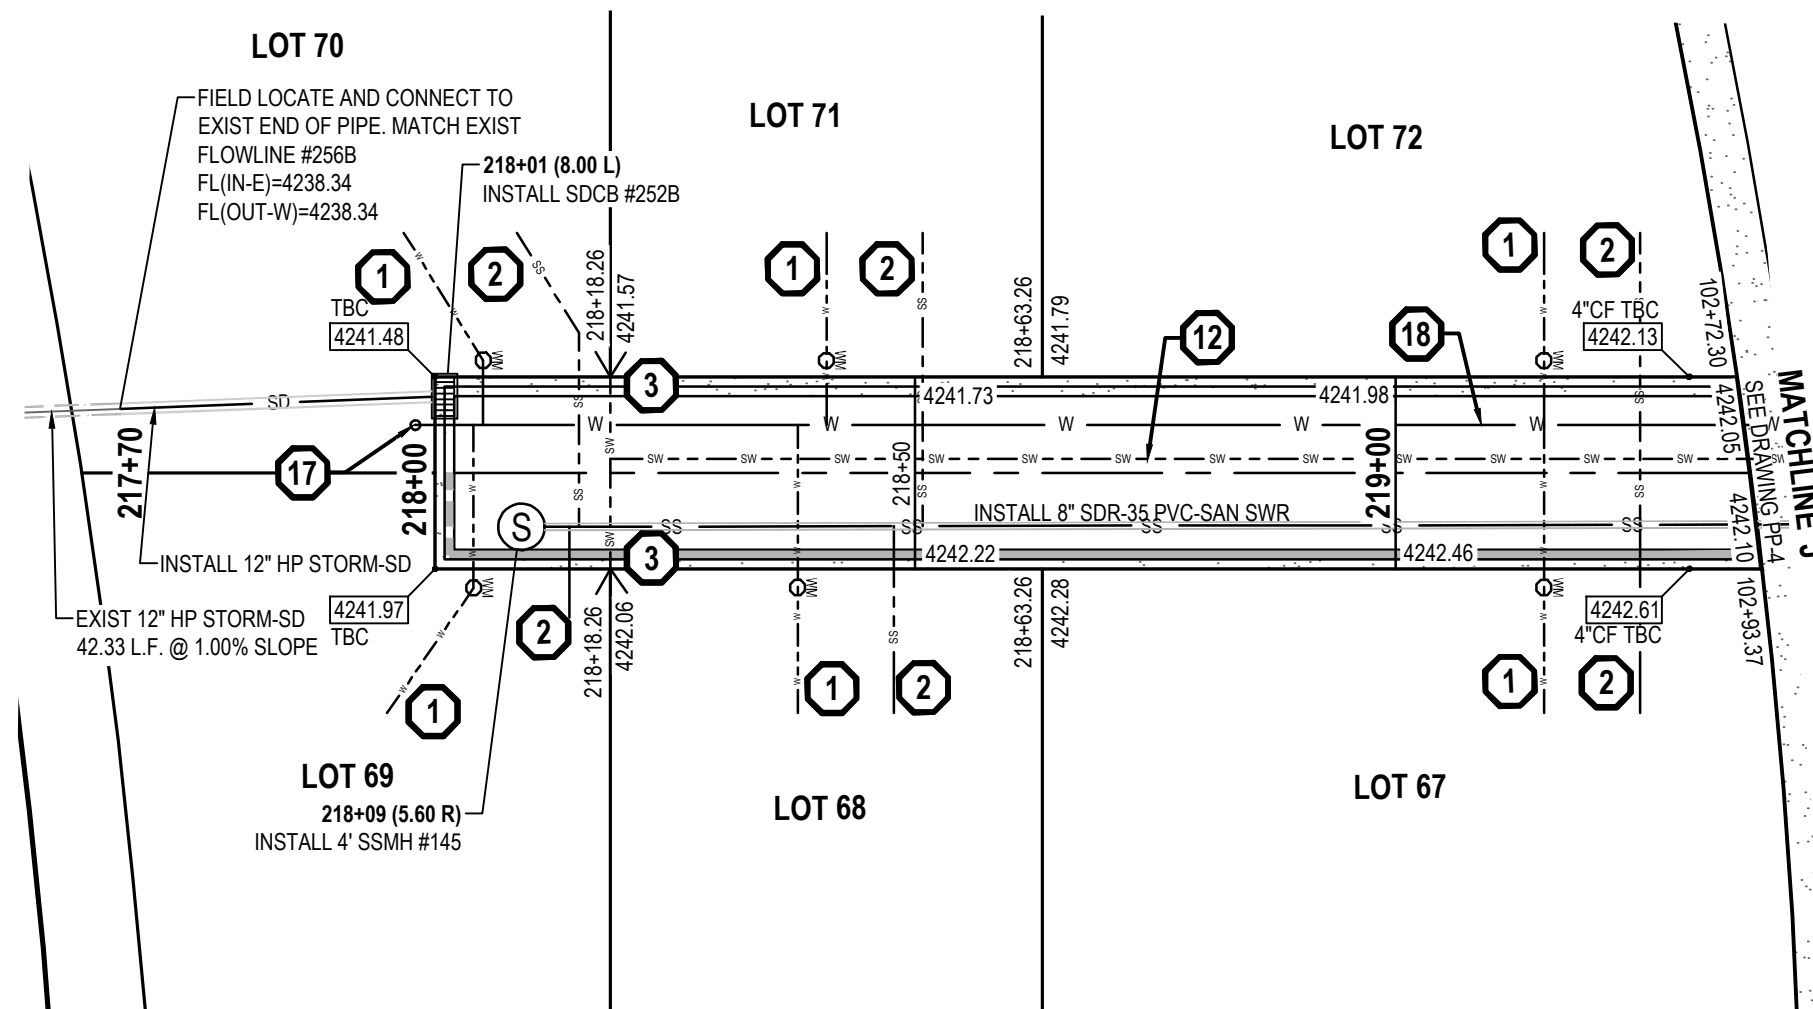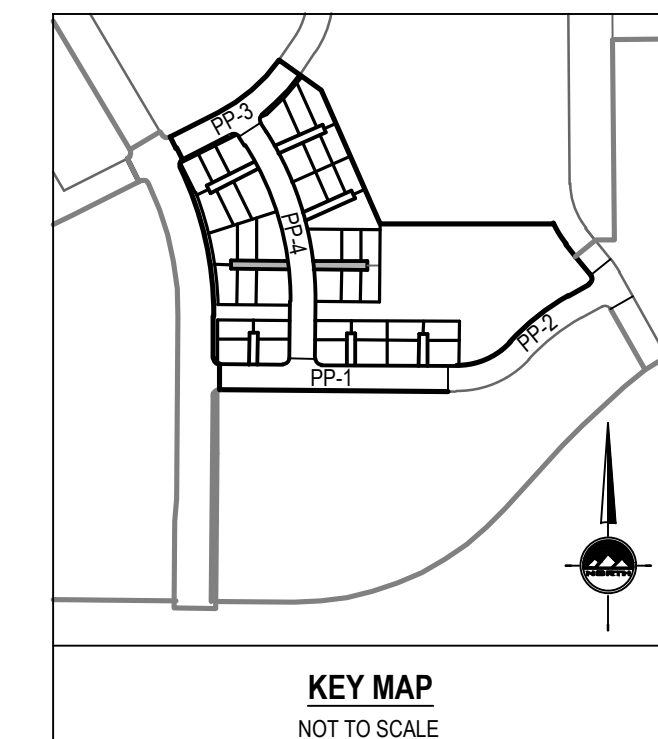

**2705 NORTH STREET**

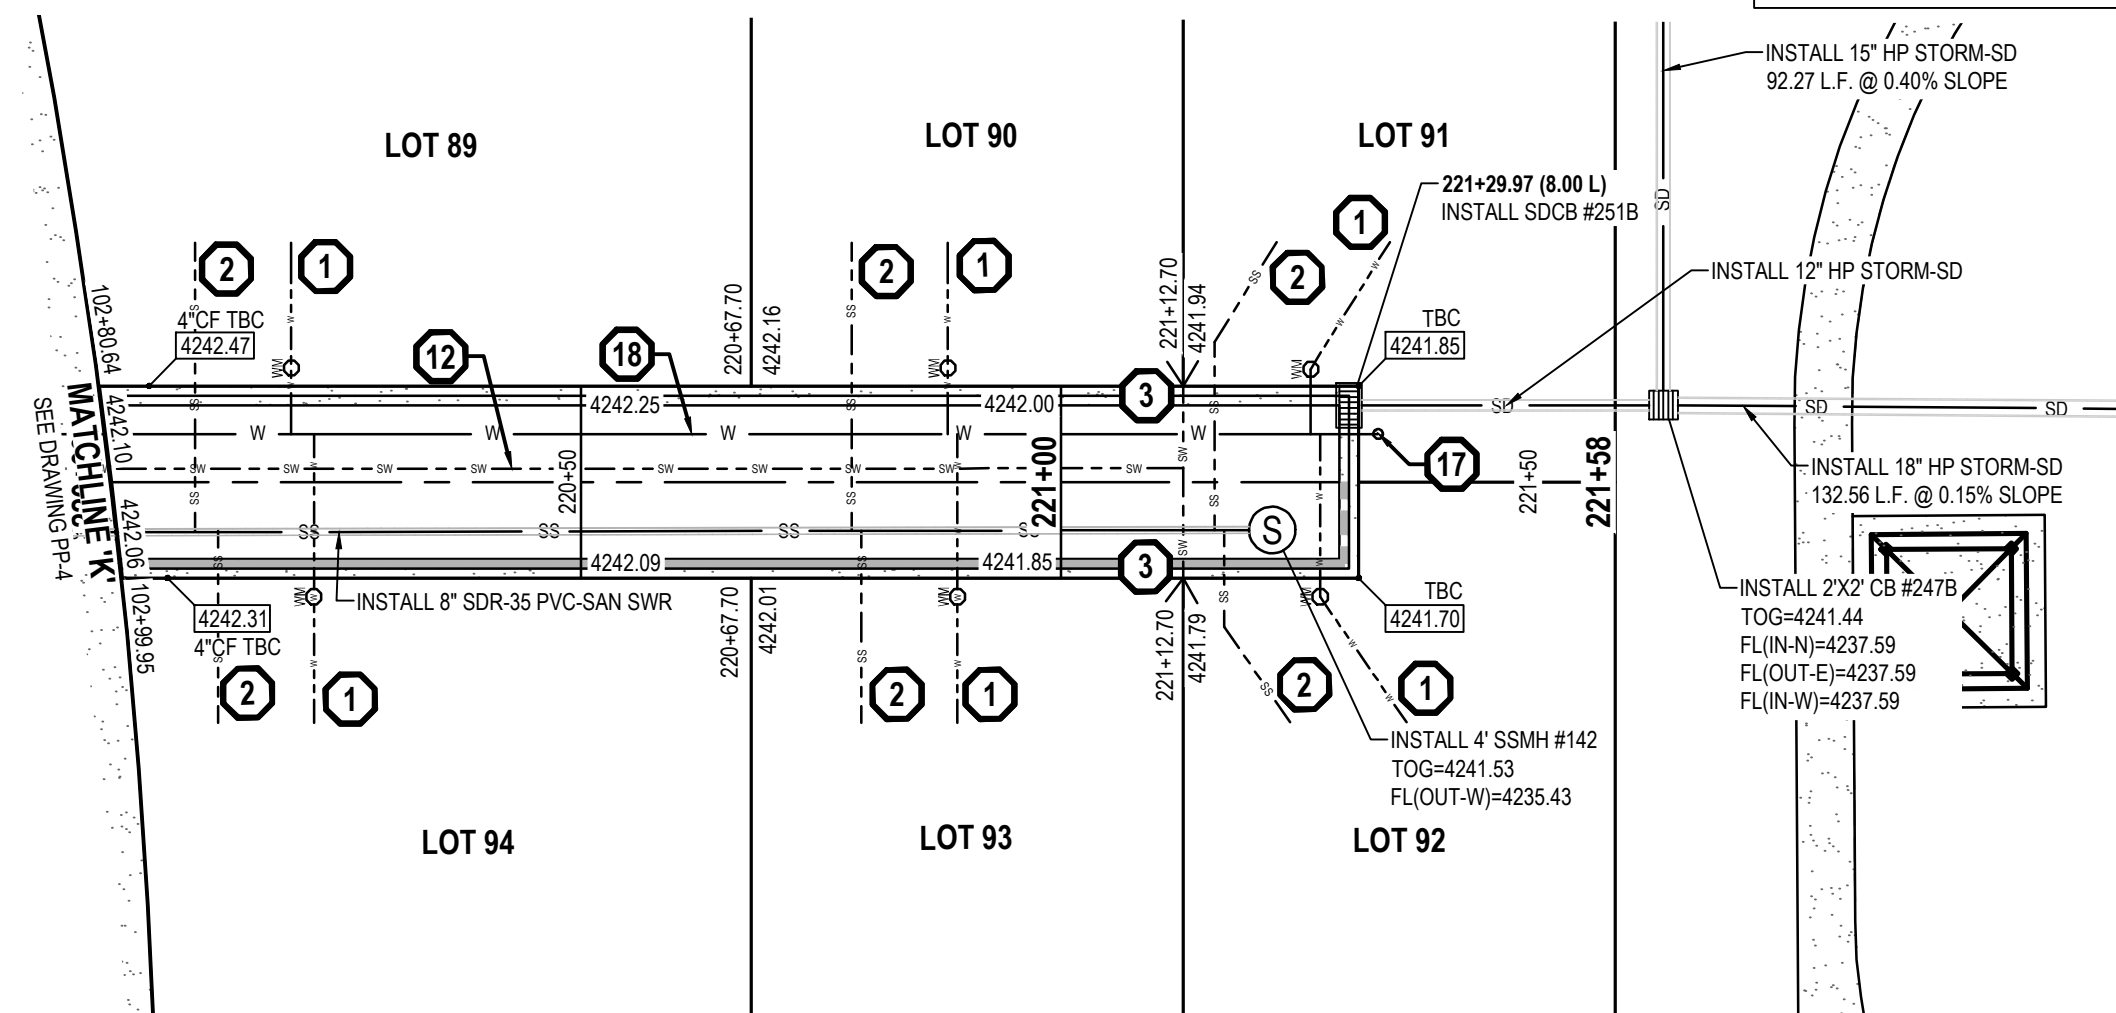

**2705 NORTH STREET**

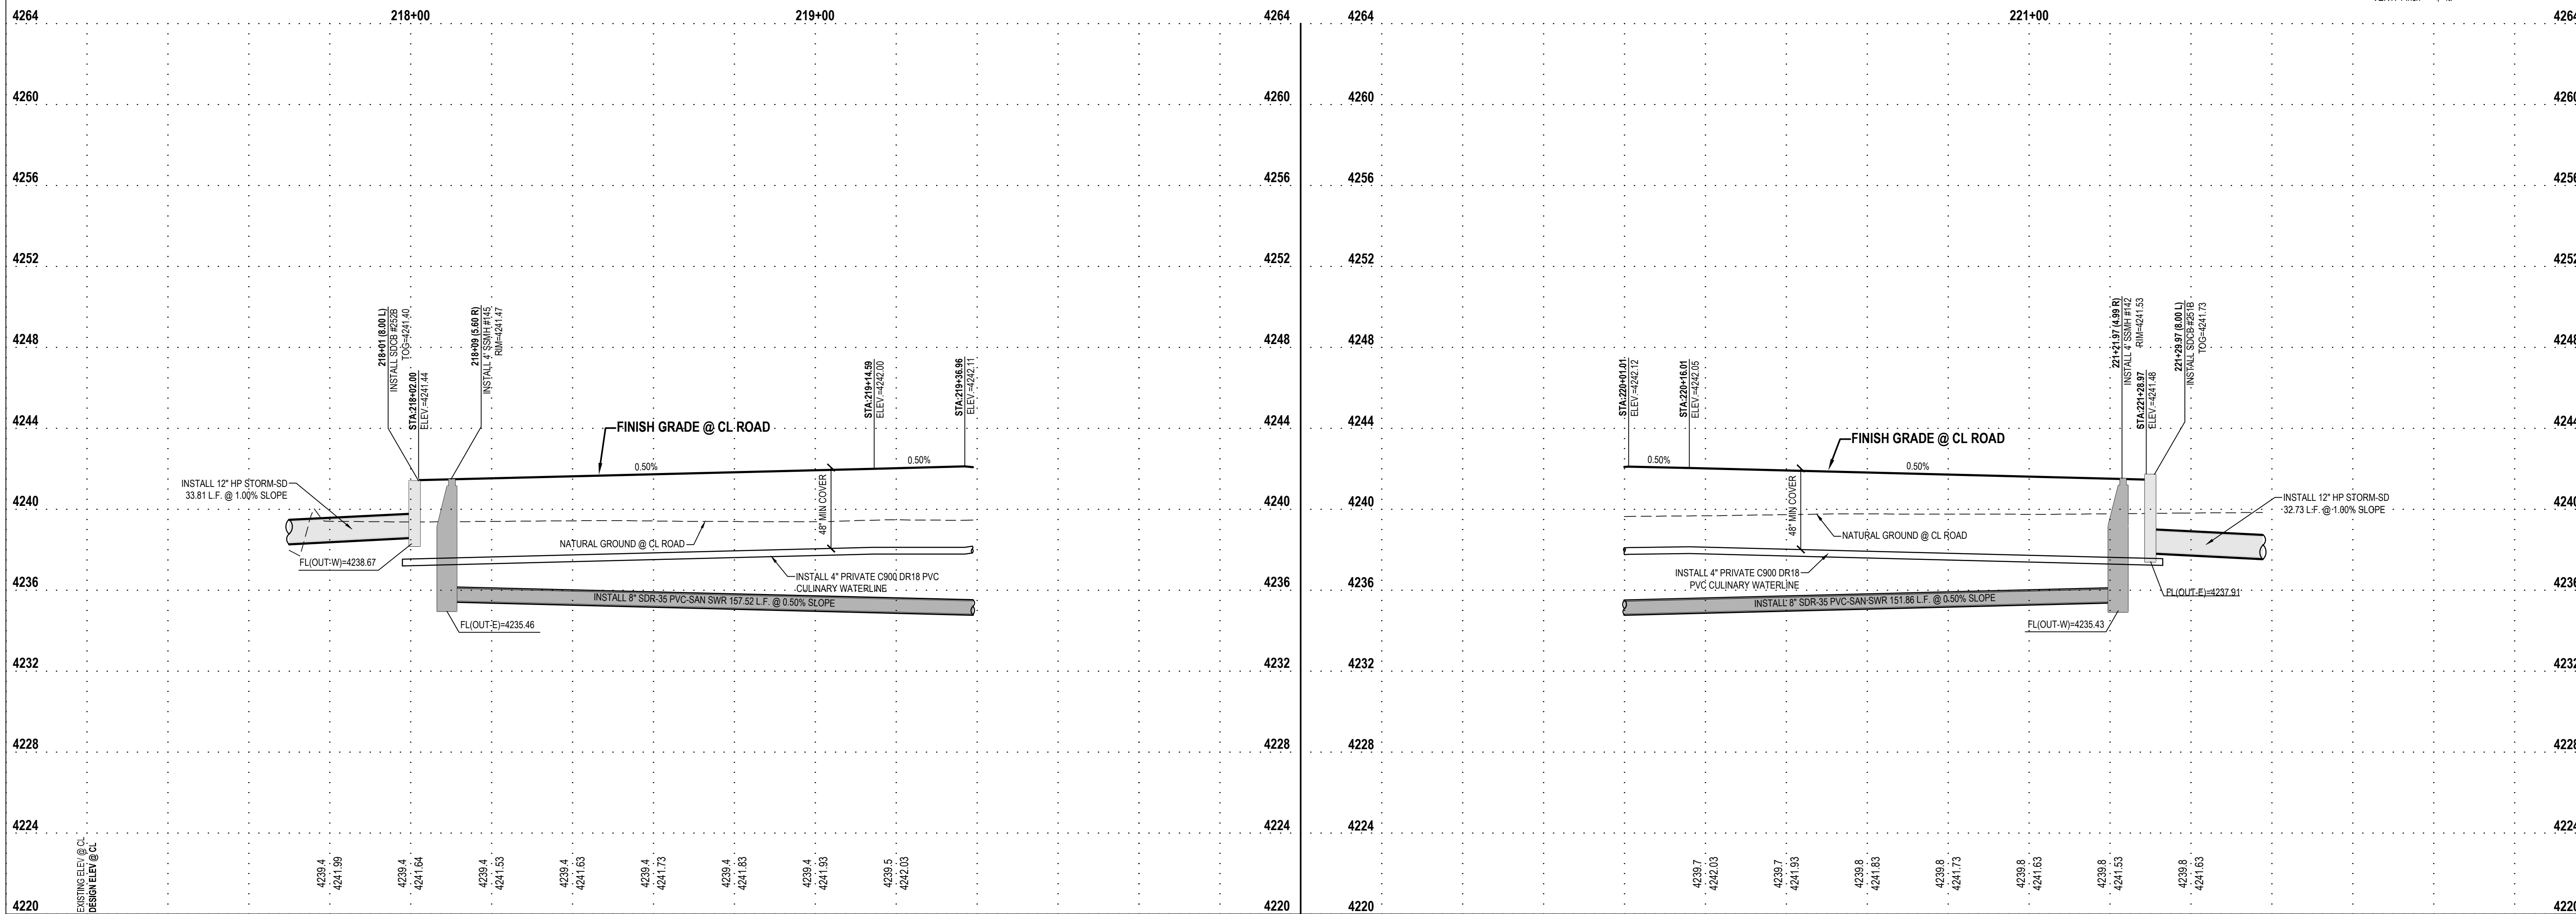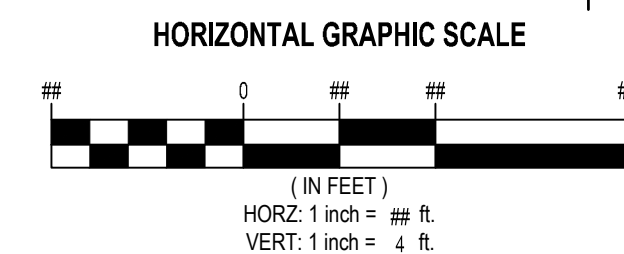

**THE ORCHARDS AT JDC RANCH**  
**PHASE 1**  
2800 WEST 2600 NORTH STREET  
WEBER COUNTY, UTAH

**ENSIGN**  
THE STANDARD IN ENGINEERING

LAYTON  
919 North 400 West  
Layton, UT 84041  
Phone: 801.547.1100

SANDY  
Phone: 801.255.0529

TOOELE  
Phone: 435.843.3590

CEDAR CITY  
Phone: 435.865.1453

RICHFIELD  
Phone: 435.896.2983

WWW.ENSIGNENG.COM

FOR:  
NILSON HOMES  
1740 COMBE RD, SUITE 2  
SOUTH OGDEN, UT 84403

CONTACT:  
STEVE ANDERSON  
PHONE: 801.392.8100





2705 NORTH STREET  
PLAN AND PROFILE

PROJECT NUMBER: 9872  
PRINT DATE: 2023-10-09

PROJECT MANAGER: CP  
DESIGNED BY: TS

**PP-8**




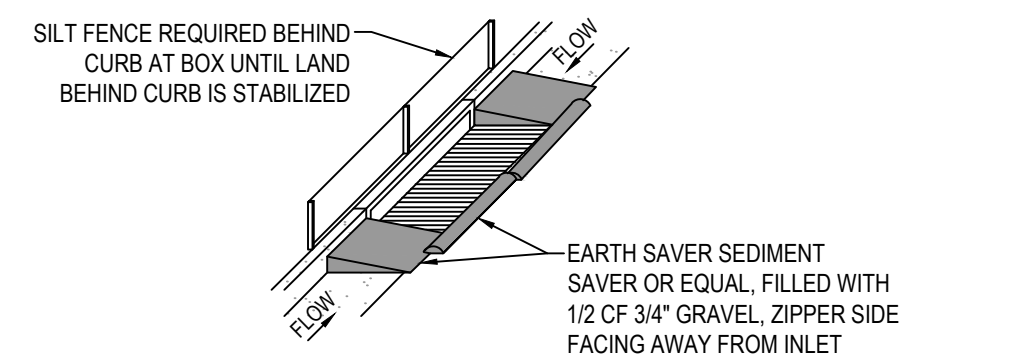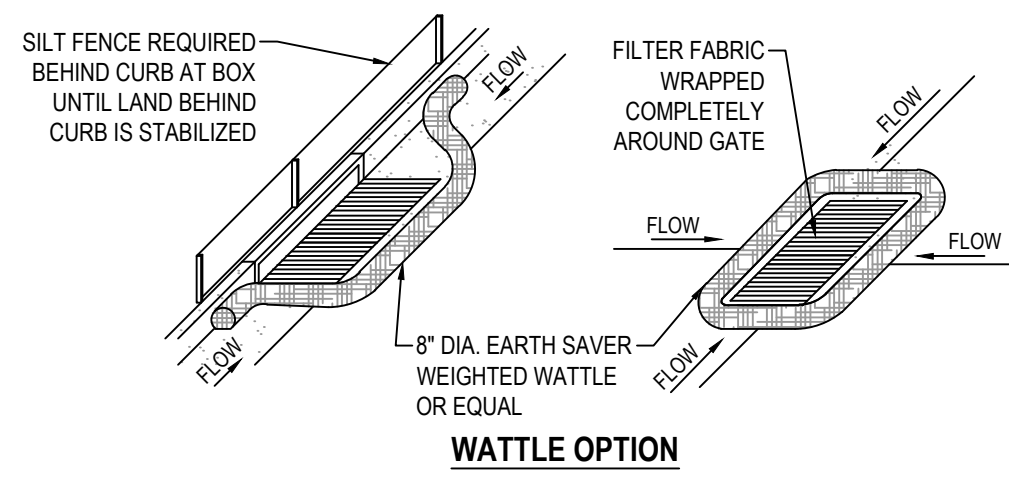

1 SAG INLET PROTECTION

SCALE: NONE

- NOTES:
1. PLACE WATTLES OR GRAVEL BAGS TIGHT AGAINST CURB TO PREVENT SEDIMENT-LADEN WATER FROM GETTING BETWEEN CURB AND WATTLEBAG.
  2. PLACE WATTLES OR GRAVEL BAGS SUCH THAT FLOW DOES NOT OVERTOP CURB OR ROAD CENTERLINE.
  3. INSPECT INLET PROTECTION AFTER EVERY LARGE STORM EVENT AND AT LEAST BIWEEKLY, OR PER SWPPP REQUIREMENTS, WHICHEVER IS MORE STRINGENT, TO ENSURE THAT SEDIMENT CONTROL IS MEETING ITS DESIGN INTENT. MAINTAIN AND/OR REPLACE AS NEEDED.
  4. REMOVE SEDIMENT ACCUMULATED WHEN IT REACHES 50% OF GRAVEL BAG OR WATTLE HEIGHT.
  5. CONTRACTOR MAY SUBMIT AN ALTERNATIVE METHOD OF INLET PROTECTION. THE ALTERNATIVE METHOD SHALL BE APPROVED BY THE CITY INSPECTOR AND THE ENGINEER OF RECORD.
  6. BEFORE PLACEMENT OF CURB, STABILIZATION OF LAND BEHIND CURB, AND/OR PAVING, MAINTAIN TOP OF INLET AT 6" ABOVE GRADE. AND SURROUND WITH SILT FENCE FOR SEDIMENTATION AROUND BOX. MAINTAIN SILT FENCE BEHIND BOX UNTIL LAND BEHIND CURB IS STABILIZED.

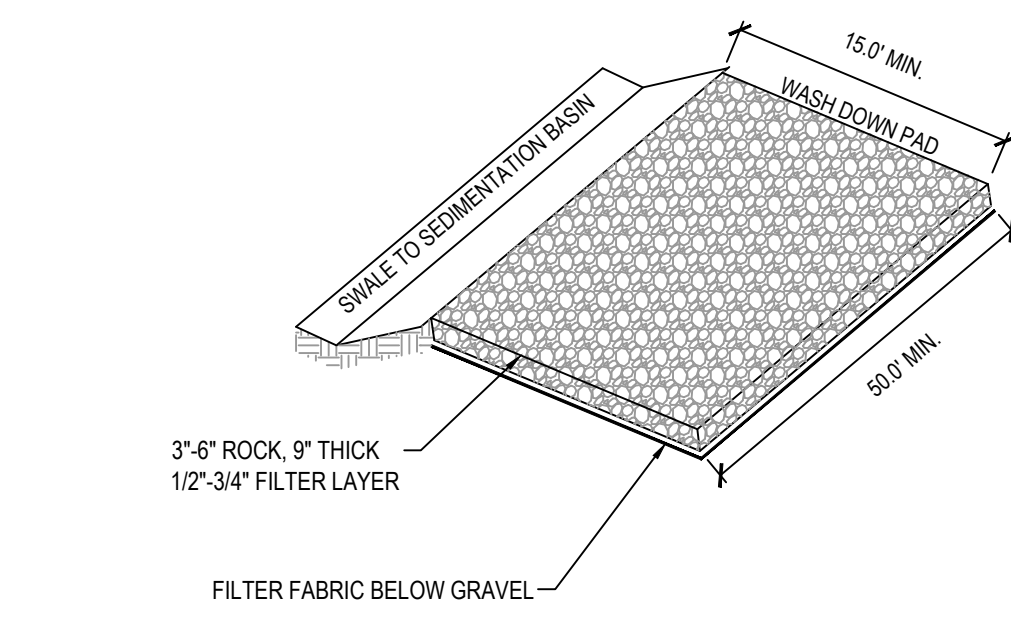


NOTE:

1. PLACE SIGN ADJACENT TO ENTRANCE \* CONSTRUCTION TRAFFIC ONLY - ALL CONSTRUCTION TRAFFIC SHALL ENTER AND EXIT SITE AT THIS LOCATION \*


2 STABILIZED CONSTRUCTION ENTRANCE

SCALE: NONE

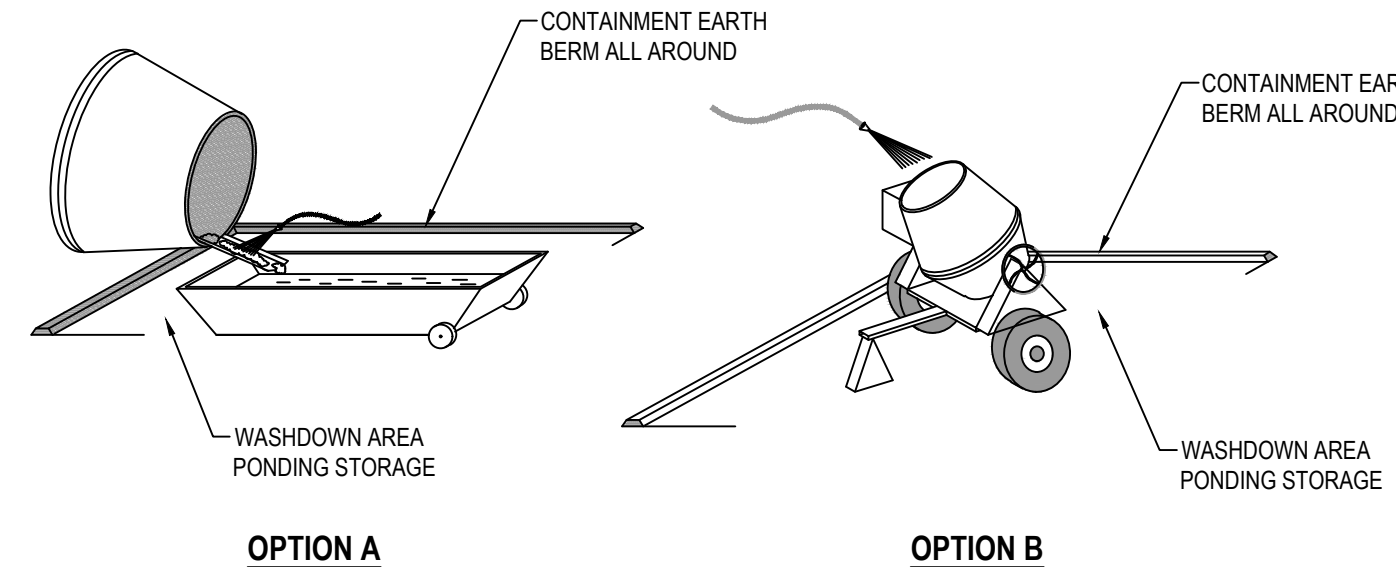


3 CONCRETE WASTE MANAGEMENT

SCALE: NONE

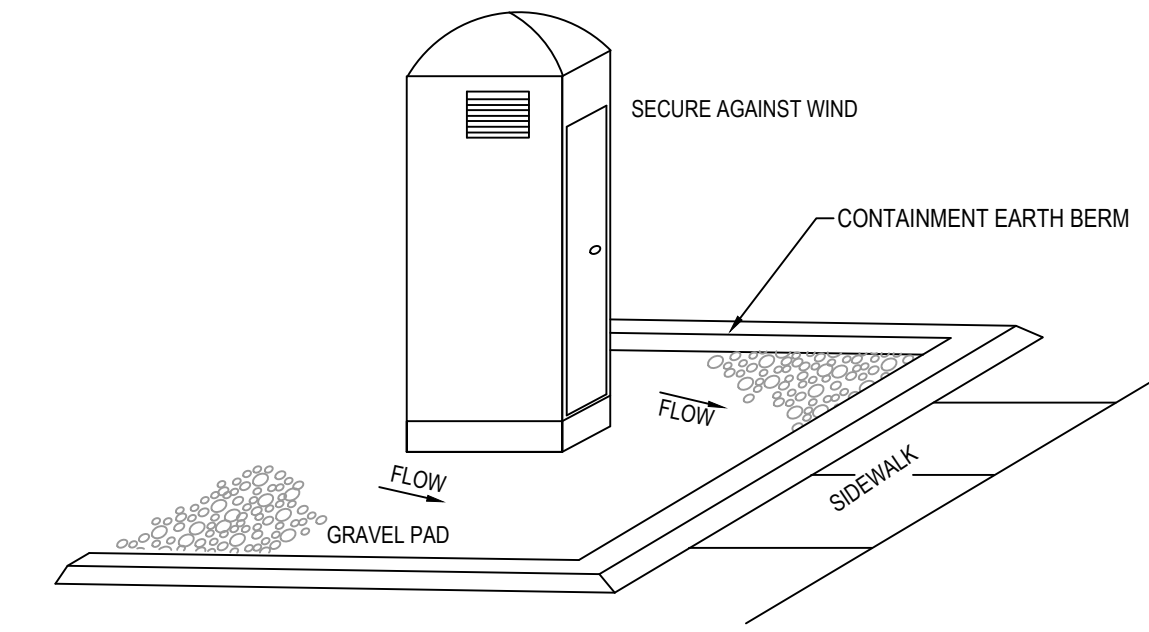

4 PORTABLE TOILET


SCALE: NONE

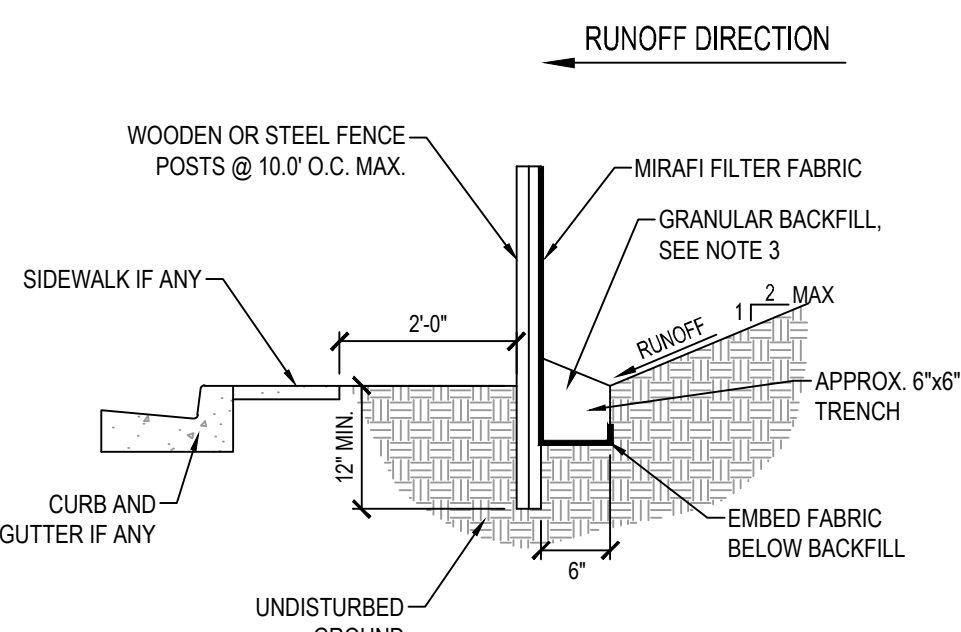

5 TEMPORARY SILT FENCE


SCALE: NONE

- NOTES:
1. EXCAVATE 6"x6" TRENCH ALONG LIMITS OF DISTURBANCE AS SHOWN ON CONSTRUCTION DRAWINGS.
  2. POSTS SHALL BE POSITIONED ON DOWNSTREAM SIDE OF FENCE.
  3. LAY TOE-IN FABRIC FLAP IN BOTTOM OF TRENCH. BACKFILL TRENCH WITH FREE DRAINING GRANULAR MATERIAL. COMPACT TRENCH TO SATISFACTION OF THE ENGINEER OF RECORD.
  4. SILT FENCE GEOTEXTILE SHALL MEET AASHTO M288-92 REQUIREMENTS.
  5. REMOVE & DISPOSE OF SEDIMENT WHEN ACCUMULATION IS 50% OF EXPOSED FENCE HEIGHT.
  6. 10' MAX. SPACING BETWEEN STAKES. SILT FENCES SHALL BE INSTALLED ALONG CONTOURS, NOT UP AND DOWN SLOPES, WITH 10' OVERLAP AT BREAKS.

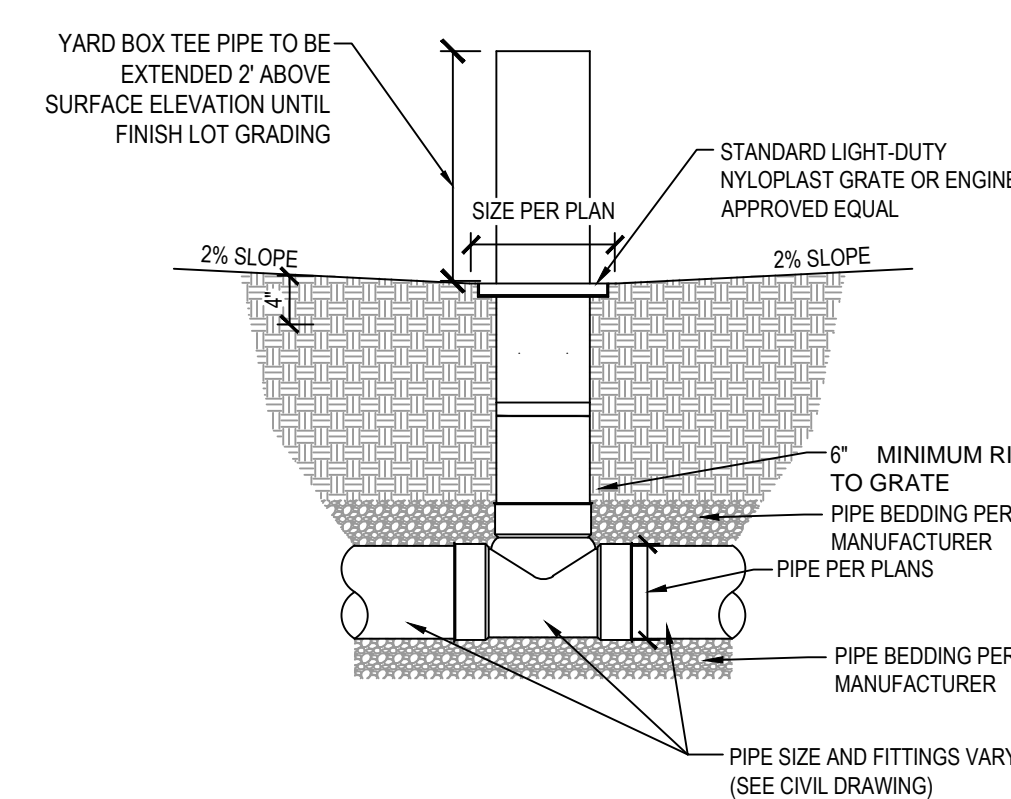


6 YARD DRAIN

SCALE: NONE

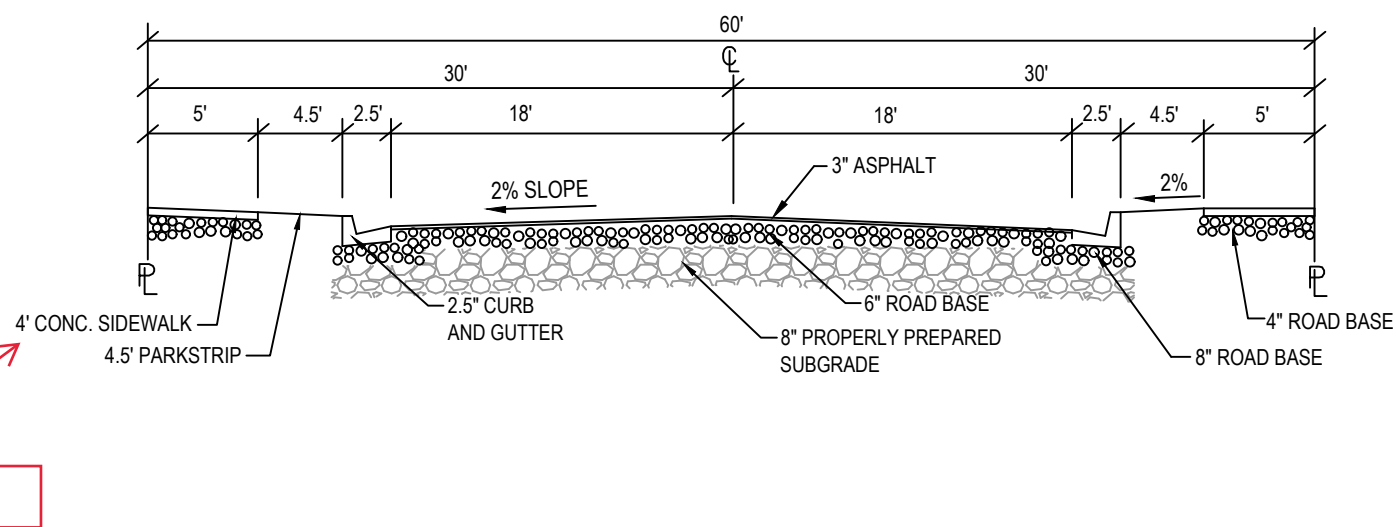


7 TYPICAL 60' STREET CROSS SECTION

SCALE: NONE

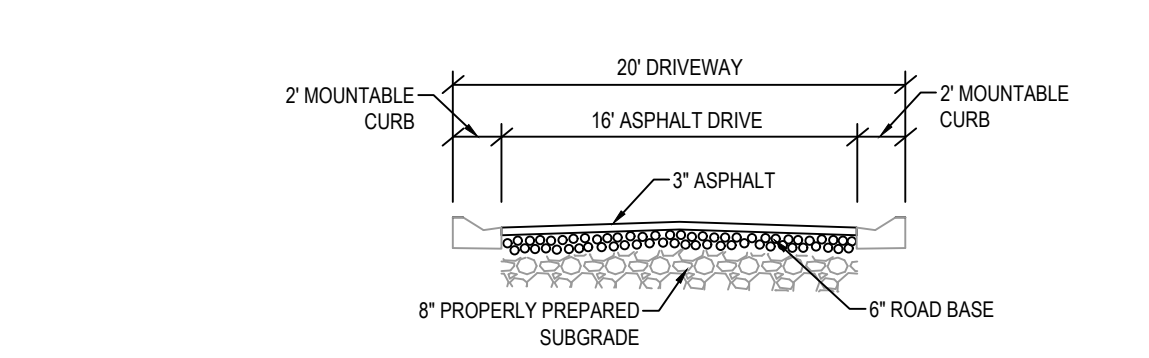

8 2830 WEST, 2810 WEST AND 2780 WEST ALLEY SECTION


SCALE: NONE

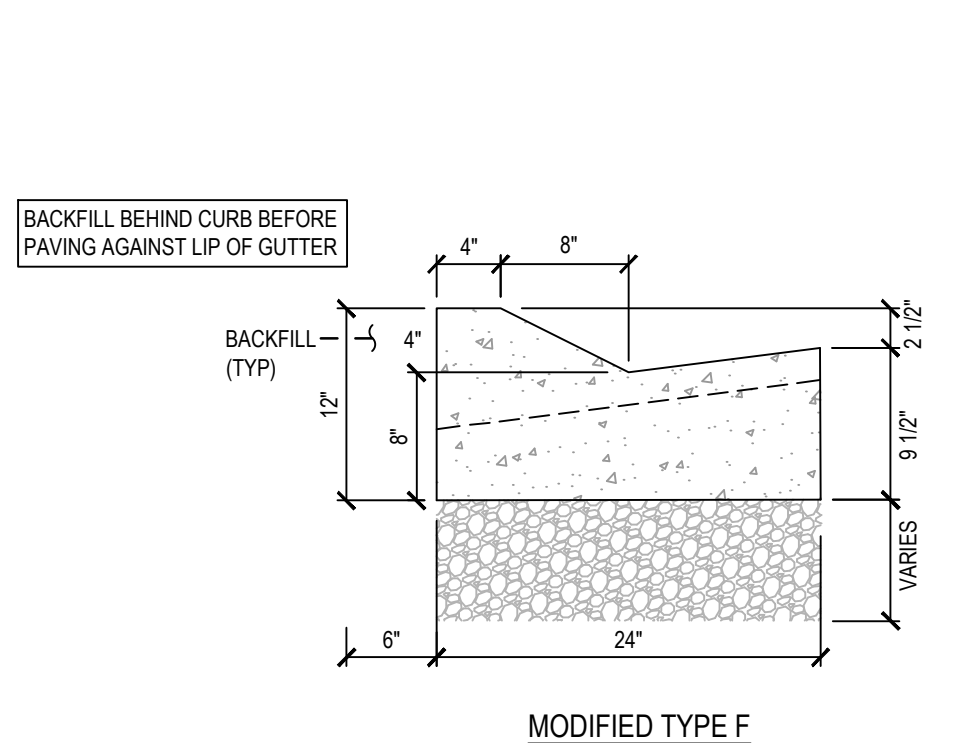

9 MODIFIED 24" TYPE 'F' CURB AND GUTTER

SCALE: NONE

1. GENERAL
- A. Variance from specified dimensions and slopes must be acceptable to the ENGINEER. System configuration may be changed at ENGINEER'S discretion.
  - B. Additional requirements are specified in APWA Section 32 16 13.
2. PRODUCTS
- A. Base Course: Untreated base course, APWA section 32 11 23. Do not use gravel as a base course without ENGINEER'S permission.
  - B. Expansion Joint Filler: 1/2-inch thick type F1 full depth, APWA Section 32 13 73.
  - C. Concrete: Class 4000, APWA Section 03 30 04. If necessary, provide concrete that achieves design strength in less than 7 days. Use caution; however, as concrete crazing (spider cracks) may develop if air temperature exceeds 90 degrees F.
  - D. Concrete Curing Agent: Clear membrane forming compound with fugitive dye (Type ID Class A), APWA Section 03 39 00.
3. EXECUTION
- A. Base Course Placement: APWA Section 32 05 10. Thickness is 6-inches if flow-line grade is 0.5 percent (s=0.005) or greater. If slope is less, provide 8-inches. Maximum lift thickness before compaction is 8-inches when using riding equipment or 6-inches when using hand held equipment. Compaction is 95 percent or greater relative to a modified proctor density, APWA Section 31 23 26.
  - B. Concrete Placement: APWA Section 03 30 10.
    1. Install expansion joints vertical, full depth, with top of filler set flush with concrete surface. Install at the start or end of a street intersection curb return. Expansion joints are not required in concrete placement using slip-form construction.
    2. Install contraction joints vertical, 1/8-inch wide or 1/4 slab thickness if the slab is greater than 8-inches thick. Match joint location in adjacent Portland-cement concrete roadway pavement.
    3. Provide 1/2-inch radius edges. Apply a broom finish. Apply a curing agent.
  - C. Protection and Repair: Protect concrete from deicing chemicals during cure. Repair construction that does not drain. If necessary, fill flow-line with water to verify.

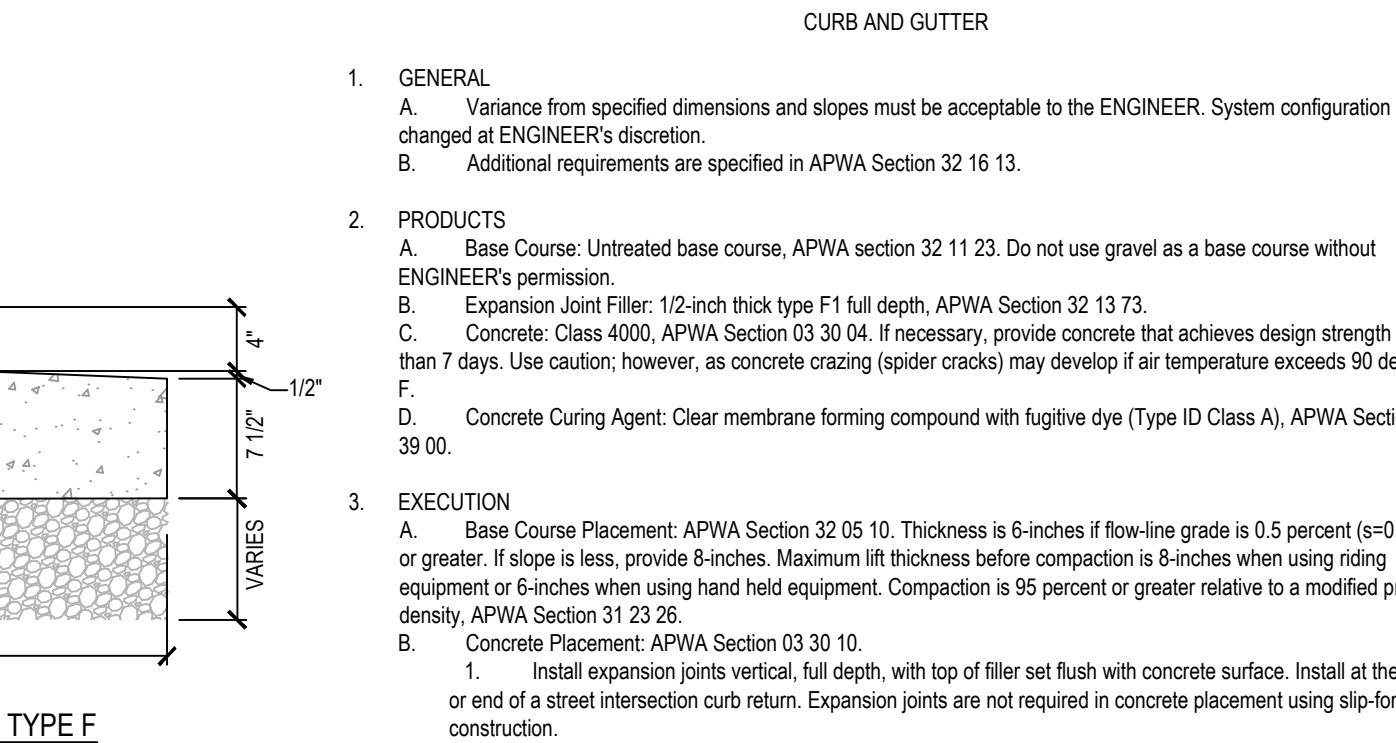


10 MODIFIED 24" REVERSE PAN TYPE 'F' CURB AND GUTTER

SCALE: NONE

1. GENERAL
- A. Variance from specified dimensions and slopes must be acceptable to the ENGINEER. System configuration may be changed at ENGINEER'S discretion.
  - B. Additional requirements are specified in APWA Section 32 16 13.
2. PRODUCTS
- A. Base Course: Untreated base course, APWA section 32 11 23. Do not use gravel as a base course without ENGINEER'S permission.
  - B. Expansion Joint Filler: 1/2-inch thick type F1 full depth, APWA Section 32 13 73.
  - C. Concrete: Class 4000, APWA Section 03 30 04. If necessary, provide concrete that achieves design strength in less than 7 days. Use caution; however, as concrete crazing (spider cracks) may develop if air temperature exceeds 90 degrees F.
  - D. Concrete Curing Agent: Clear membrane forming compound with fugitive dye (Type ID Class A), APWA Section 03 39 00.
3. EXECUTION
- A. Base Course Placement: APWA Section 32 05 10. Thickness is 6-inches if flow-line grade is 0.5 percent (s=0.005) or greater. If slope is less, provide 8-inches. Maximum lift thickness before compaction is 8-inches when using riding equipment or 6-inches when using hand held equipment. Compaction is 95 percent or greater relative to a modified proctor density, APWA Section 31 23 26.
  - B. Concrete Placement: APWA Section 03 30 10.
    1. Install expansion joints vertical, full depth, with top of filler set flush with concrete surface. Install at the start or end of a street intersection curb return. Expansion joints are not required in concrete placement using slip-form construction.
    2. Install contraction joints vertical, 1/8-inch wide or 1/4 slab thickness if the slab is greater than 8-inches thick. Match joint location in adjacent Portland-cement concrete roadway pavement.
    3. Provide 1/2-inch radius edges. Apply a broom finish. Apply a curing agent.
  - C. Protection and Repair: Protect concrete from deicing chemicals during cure. Repair construction that does not drain. If necessary, fill flow-line with water to verify.

ASPHALT NOTES

1. ALL PAVING TO BE PLACED OVER PROPERLY PREPARED NATURAL SOILS AND/OR PROPERLY PREPARED EXISTING FILL SOILS AND PROPERLY COMPACTED STRUCTURAL FILL WHERE SPECIFIED.
2. ALL STRUCTURAL FILL TO BE PLACED AND COMPACTED PER THE PROJECT GEOTECHNICAL REPORT OR TO A MINIMUM OF 95% OF THE MAXIMUM DRY DENSITY AS DETERMINED BY THE AASHTO T-180 (D-1557) METHOD OF COMPACTION. LIFTS SHOULD BE PLACED PER GEOTECHNICAL RECOMMENDATIONS BUT SHOULD NOT EXCEED 8" IN LOOSE THICKNESS.
3. REMOVE SURFACE VEGETATION AND OTHER DELETERIOUS MATERIALS OVER THE ENTIRE SITE IN PREPARATION OF PROPOSED IMPROVEMENTS.

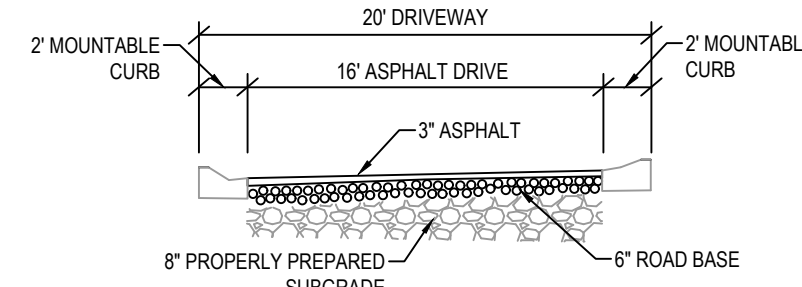

11 24" COLLECTION CURB AND GUTTER

SCALE: NONE

- NOTE:
1. CONSTRUCT PER NOTES AND SPECIFICATIONS ASSOCIATED WITH APWA STANDARD PLAN NO. 205.

12 24" REVERSE PAN CURB AND GUTTER


SCALE: NONE

13 2720 NORTH, 2710 NORTH AND 2705 NORTH ALLEY SECTION

SCALE: NONE

14 STANDARD ASPHALT SECTION

SCALE: NONE

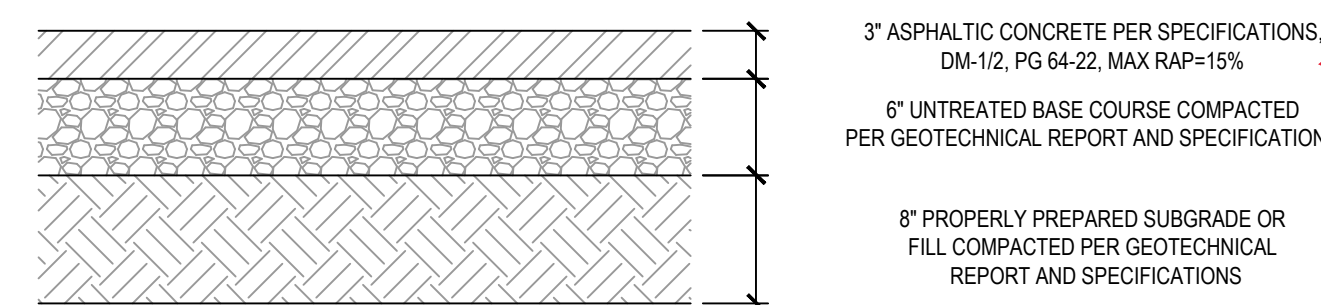

- 3" ASPHALTIC CONCRETE PER SPECIFICATIONS, DM-1/2, PG 64-22, MAX RAP=15%
- 6" UNTREATED BASE COURSE COMPACTED PER GEOTECHNICAL REPORT AND SPECIFICATIONS
- 8" PROPERLY PREPARED SUBGRADE OR FILL COMPACTED PER GEOTECHNICAL REPORT AND SPECIFICATIONS

APWA Class II road

Provide Geotech report





NO. DATE REVIEW FOR REVIEW

DETAILS

PROJECT NUMBER 9872 PRINT DATE 2023-10-09  
PROJECT MANAGER CP DESIGNED BY TS



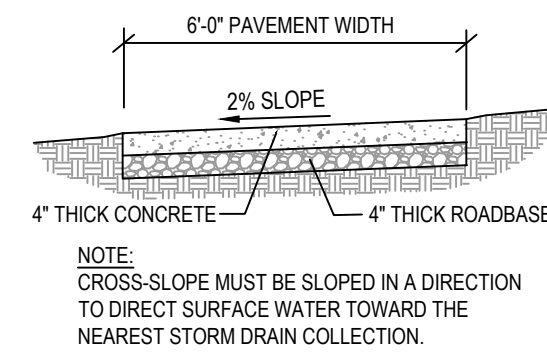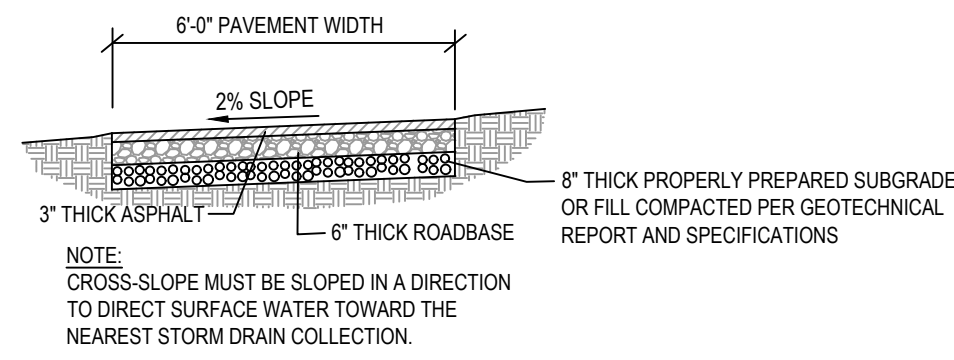

1 CLASS 2 TRAIL SECTION SCALE: NONE

2 CLASS 3 TRAIL SECTION SCALE: NONE



**LAYTON**  
919 North 400 West  
Layton, UT 84041  
Phone: 801.547.1100

**SANDY**  
Phone: 801.255.0529

**TOOELE**  
Phone: 435.843.3590

**CEDAR CITY**  
Phone: 435.865.1453


**RICHFIELD**  
Phone: 435.896.2983

[WWW.ENSIGNENG.COM](http://WWW.ENSIGNENG.COM)

FOR:  
NILSON HOMES  
1740 COMBE RD. SUITE 2  
SOUTH OGDEN, UT 84403

CONTACT:  
STEVE ANDERSON  
PHONE: 801.392.8100

**THE ORCHARDS AT JDC RANCH**  
**PHASE 1**  
**2800 WEST 2600 NORTH STREET**  
**WEBER COUNTY, UTAH**

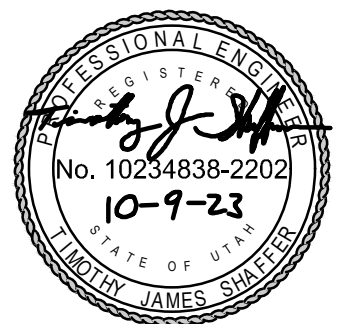

NO.	DATE	REVISION FOR REVIEW

**DETAILS**

PROJECT NUMBER: 9872  
PRINT DATE: 2023-10-09  
PROJECT MANAGER: CP  
DESIGNED BY: TS

**C-501**