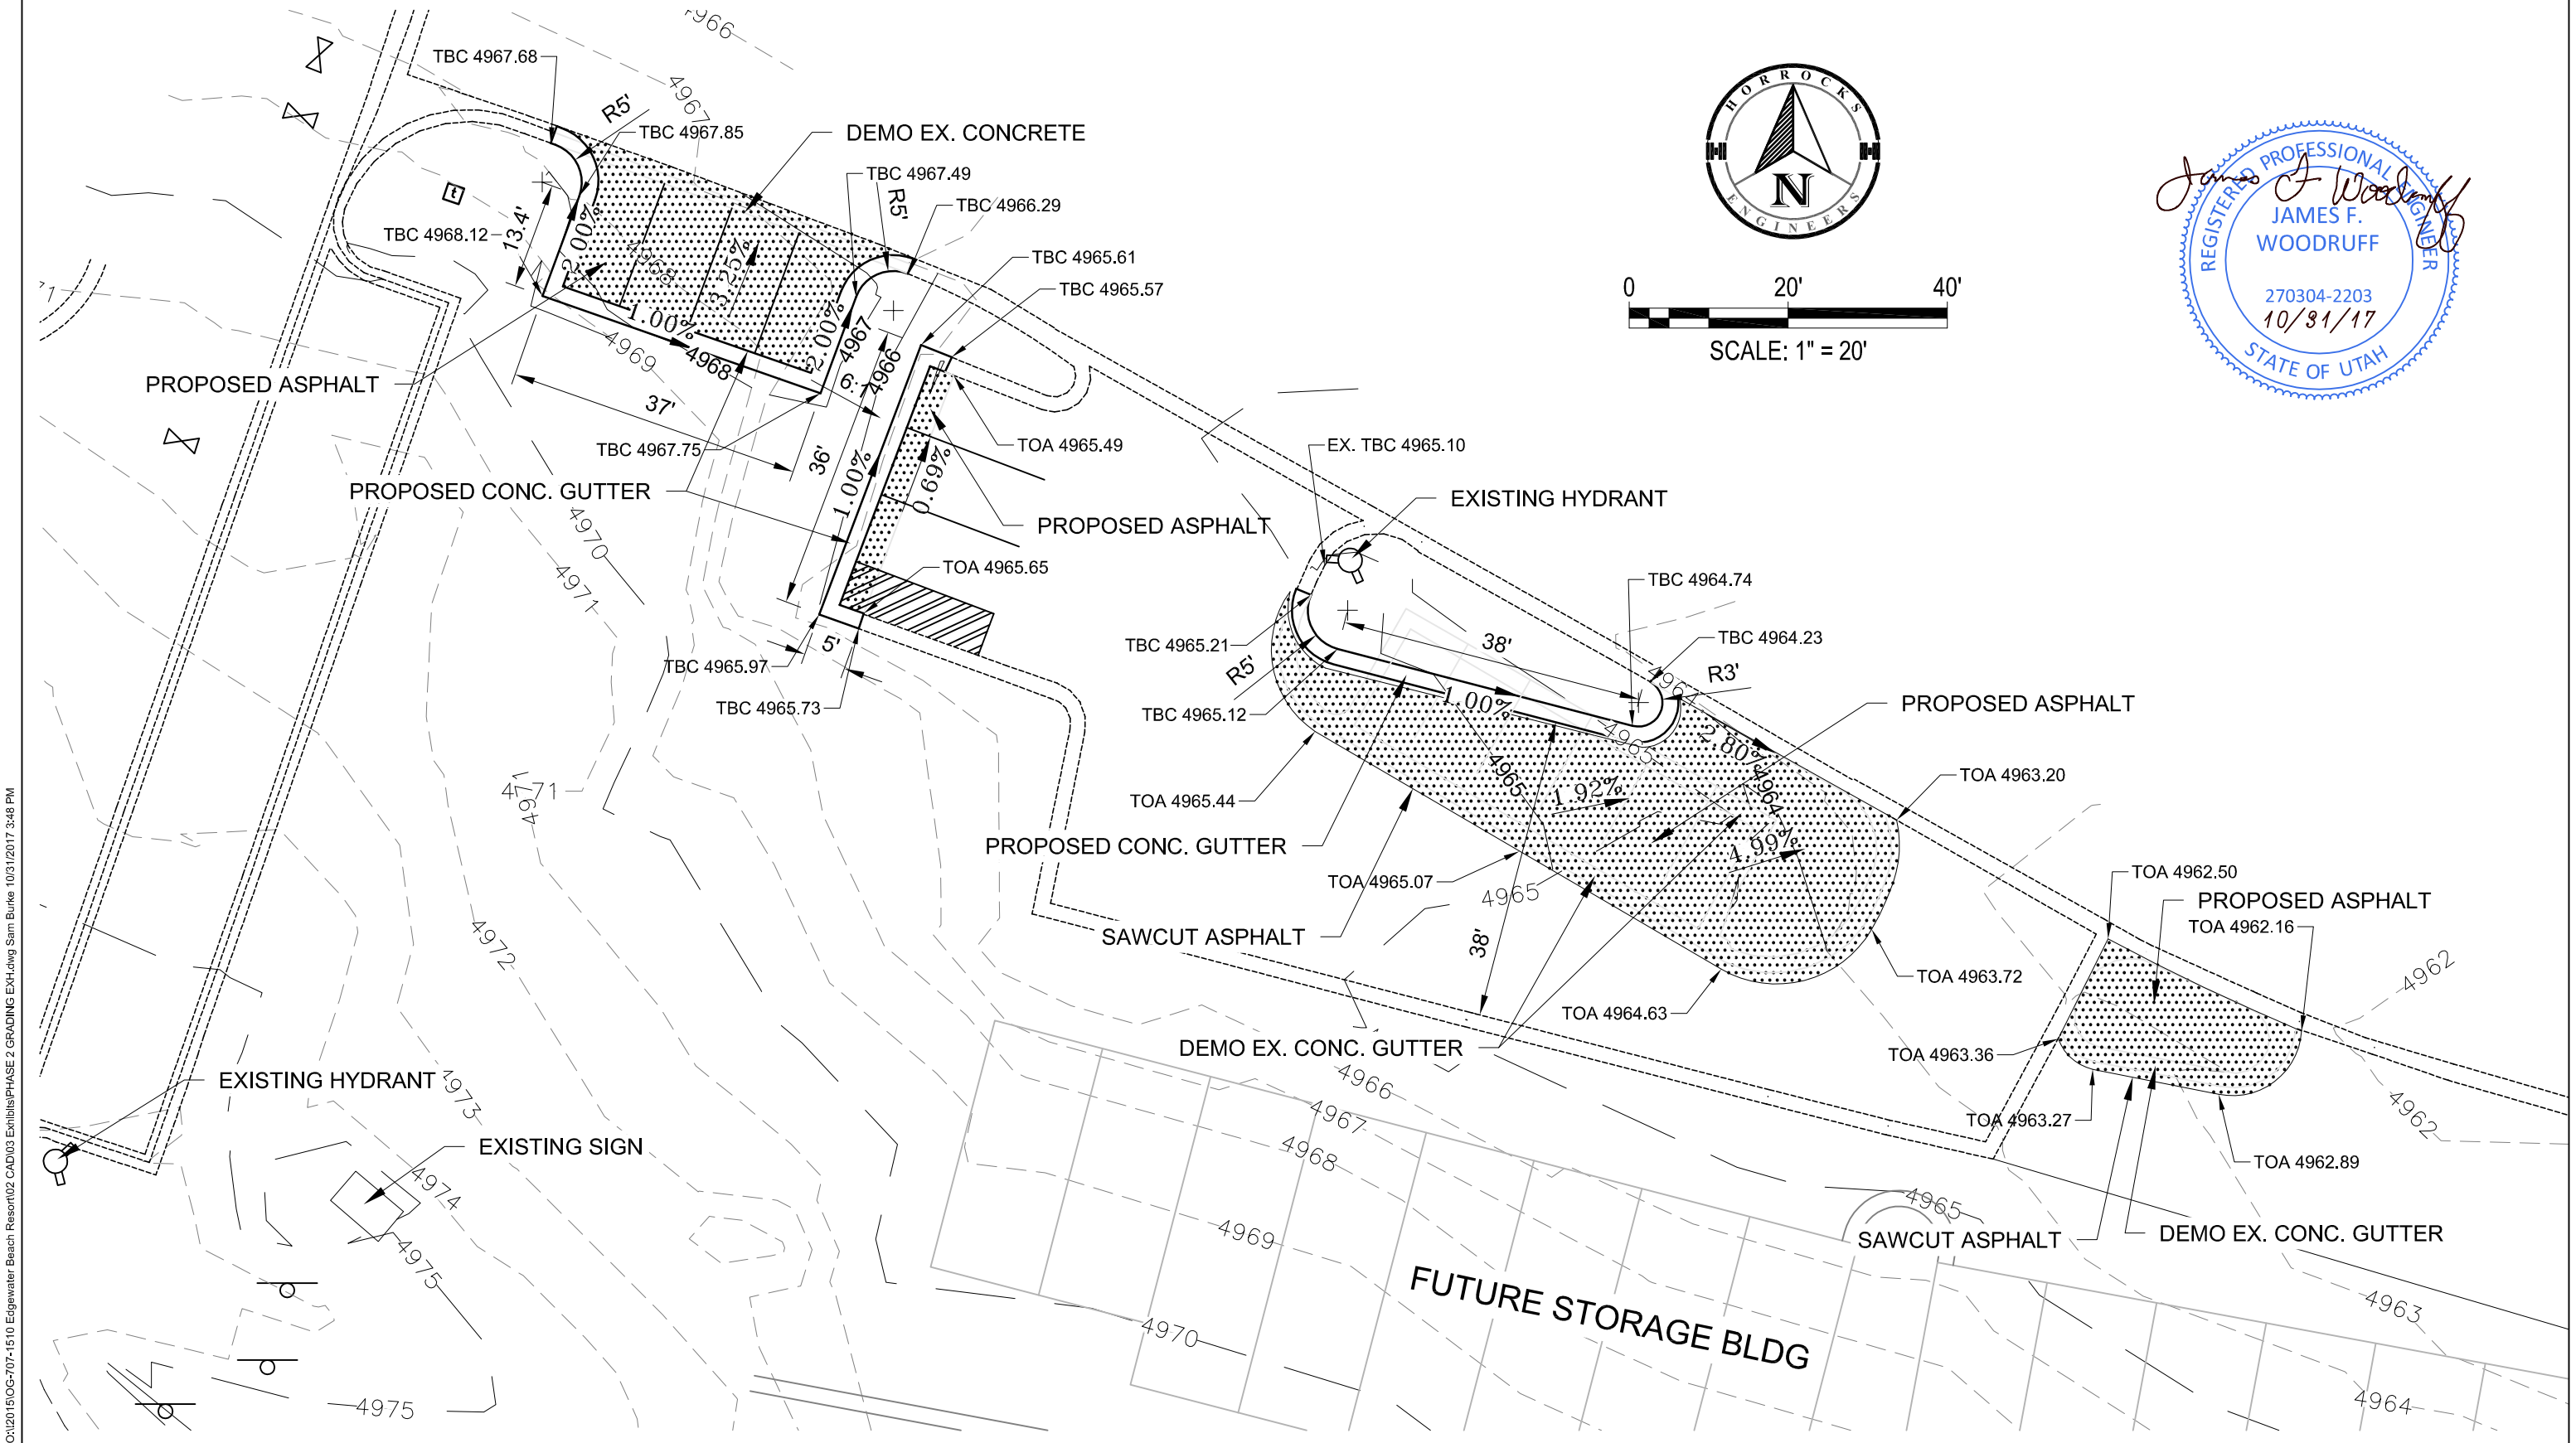

C:\2015\OG-707-1510 Edgewater Beach Resort\02 CAD\03 Exhibits\PHASE 2 GRADING EXH.dwg Sam Burke 10/31/2017 3:48 PM

HORROCKS ENGINEERS
2162 West Grove Pkwy., Suite 400
Pleasant Grove, UT 84062
(801) 763-5100
www.horrocks.com

OWNER:

CITY:

WARNING
0 1/2 1
IF THIS BAR DOES NOT MEASURE 1" THEN DRAWING IS NOT TO SCALE

EDGEWATER PHASE 2 AS-BUILT EXHIBIT

SITE & GRADING

DRAWING INFO

DATE	10/31/17
SCALE	1" = 20'
REV #	DATE

*SEE 2nd SHEET FOR LISTING
PROJ. NO:

1