#### PROPERTY LINE CURVE DATA PROPERTY LINE CURVE DATA Curve Delta Radius Length Chord Chord Bearing Curve | Delta | Radius | Length | Chord | Chord Bearing (C1) | 15°42'21" | 225.00' | 61.68' | 61.48' | N 41°21'26" E | (C21) | 85°52'48" | 15.00' | 22.48' | 20.44' | N 52°10'03" W (C2) 89°49'10" 10.00' 15.68' 14.12' N 78°24'50" E (C22) | 5°31'12" | 567.64' | 54.69' | 54.67' | N 6°28'24" W (C3) | 2°44'11" | 442.54' | 21.14' | 21.13' | S 58°14'47" E | (C23) | 5°29'26" | 567.64' | 54.40' | 54.38' | N 0°58'05" W (C4) 7°00'39" 442.54' 54.15' 54.12' S 63°07'12" E (C24) | 6°10'10" | 567.64' | 61.12' | 61.09' | N 4°51'44" E (C5) 80°51'07" 10.08' 14.22' 13.07' S 26°01'47" E | (C25) | 6°20'55" | 567.64' | 62.90' | 62.86' | N 11°07'16" E (C6) | 4°42'42" | 617.64' | 50.79' | 50.78' | S 12°24'53" W | (C26) | 89°15'24" | 10.03' | 15.63' | 14.10' | N 59°06'17" E (C7) | 4°56'49" | 617.64' | 53.33' | 53.31' | S 7°35'08" W (C27) | 9°11'09" | 425.00' | 68.14' | 68.06' | S 80°40'22" E (C8) | 5°35'43" | 617.64' | 60.32' | 60.29' | S 2°18'52" W | (C28) | 6°06'39" | 425.00' | 45.33' | 45.31' | S 88°19'16" E (C9) | 5°45'55" | 617.64' | 62.15' | 62.12' | S 3°21'57" E | (C29) | 23°54'38" | 125.00' | 52.16' | 51.79' | N 76°40'06" E (C10) | 5°59'12" | 617.64' | 64.53' | 64.51' | S 9°14'30" E | (C30) | 5°38'41" | 10.00' | 0.99' | 0.98' | N 67°32'07" E (C31) | 68°51'43" | 10.00' | 12.02' | 11.31' | S 75°12'40" E (C11) | 13°04'28" | 15.00' | 3.42' | 3.42' | S 5°41'29" E | (C12) | 30°21'49" | 15.00' | 7.95' | 7.86' | S 16°01'39" W (C32) | 1°28'01" | 3701.68' | 94.78' | 94.78' | S 41°30'49" E (C13) | 35°03'23" | 80.00' | 48.95' | 48.19' | S 13°40'52" W (C33) | 0°55'40" | 3701.68' | 59.95' | 59.94' | S 42°42'40" E (C14) 38°27'31" 80.00' 53.70' 52.70' S 23°04'35" E | (C34) | 0°55'38" | 3701.68' | 59.90' | 59.90' | S 43°38'19" E | (C15) | 43°33'19" | 80.00' | 60.81' | 59.36' | S 64°05'00" E | (C35) | 0°55'38" | 3701.68' | 59.91' | 59.91' | S 44°33'57" E (C16) | 42°04'39" | 80.00' | 58.75' | 57.44' | N 73°06'00" E (C36) | 1°15'56" | 3701.68' | 81.76' | 81.76' | S 45°39'45" E (C17) 39°57'44" 80.00' 55.80' 54.67' N 32°04'49" E (C37) | 0°17'53" | 3701.68' | 19.26' | 19.26' | S 46°26'39" E (C18) 36°03'01" 80.00' 50.34' 49.51' N 5°55'34" W | (C38) | 64°48'27" | 15.00' | 16.97' | 16.08' | S 14°11'22" E (C19) 32°55'22" 80.00' 45.97' 45.34' N 40°24'45" W (C39) | 33°13'35" | 80.00' | 46.39' | 45.75' | S 1°36'04" W (C20) | 38°14'01" | 80.00' | 53.38' | 52.40' | N 75°59'27" W (C40) | 36°33'40" | 80.00' | 51.05' | 50.19' | S 33°17'34" E PROPERTY LINE CURVE DATA PROPERTY LINE CURVE DATA | Curve | Delta | Radius | Length | Chord | Chord Bearing Curve | Delta | Radius | Length | Chord | Chord Bearing (C41) | 43°35'14" | 80.00' | 60.86' | 59.40' | S 73°22'01" E (C61) | 1°00'14" | 3551.68' | 62.23' | 62.23' | S 45°07'48" E (C42) 33°58'41" 80.00' 47.44' 46.75' N 67°51'01" E (C62) | 0°08'51" | 3551.68' | 9.14' | 9.14' | S 45°42'20" E (C43) | 32°35'32" | 80.00' | 45.51' | 44.90' | N 34°33'55" E (C63) | 45°05'36" | 15.00' | 11.81' | 11.50' | S 68°19'33" E

(C64) | 1°45'07" | 180.00' | 5.50' | 5.50' | S 89°55'29" E

(C65) 31°41'39" | 180.00' | 99.57' | 98.31' | S 73°12'06" E

(C66) | 41°06'56" | 180.00' | 129.17' | 126.41' | S 36°47'48" E

(C67) | 20°02'50" | 180.00' | 62.98' | 62.66' | S 6°12'55" E

(C68) | 16°23'38" | 180.00' | 51.50' | 51.33' | S 12°00'19" W

(C69) 33°46'02" 180.00' 106.08' 104.55' S 37°05'09" W

(C70) 32°12'22" | 180.00' | 101.18' | 99.85' | S 70°04'21" W

(C71) | 37°57'55" | 180.00' | 119.27' | 117.10' | N 74°50'31" W

(C72) | 33°08'50" | 180.00' | 104.13' | 102.69' | N 39°17'08" W

(C73) | 19°58'20" | 180.00' | 62.74' | 62.43' | N 12°43'33" W

(C74) | 0°04'59" | 3801.68' | 5.52' | 5.52' | N 45°48'36" W

(C75) | 43°11'32" | 15.00' | 11.31' | 11.04' | N 24°15'20" W

(C76) | 0°45'29" | 3801.68' | 50.30' | 50.30' | N 45°23'22" W

(C77) 0°54'34" 3801.68' 60.34' 60.34' N 44°33'21" W

(C78) | 0°54'10" | 3801.68' | 59.90' | 59.90' | N 43°38'59" W

(C79) | 0°54'12" | 3801.68' | 59.94' | 59.94' | N 42°44'48" W

(C80) | 0°36'44" | 3801.68' | 40.63' | 40.63' | N 41°59'19" W

PROPERTY LINE CURVE DATA

(C81) | 37°12'29" | 180.00' | 116.89' | 114.85' | S 44°57'48" E

(C82) | 35°25'13" | 180.00' | 111.28' | 109.51' | S 8°38'57" E

(C83) | 40°35'59" | 180.00' | 127.55' | 124.90' | S 29°21'39" W

(C84) | 49°05'35" | 180.00' | 154.23' | 149.56' | S 74°12'26" W

(C85) 37°36'58" | 180.00' | 118.17' | 116.06' | N 62°26'18" W

(C86) 37°41'48" 180.00' 118.43' 116.30' N 24°46'55" W

(C87) | 5°41'17" | 180.00' | 17.87' | 17.86' | N 3°05'22" W

LINE DATA

L3 N 0°56'57" E 5.66

| L101 | S 89°13'13" E | 37.95

L102 N 49°12'36" E 37.95

L103 N 49°12'36" E 27.81

L104 N 33°22'43" E 27.81

L106 | S 56°40'35" E | 124.97

L107 N 88°37'25" E | 124.97

L108 N 88°37'25" E 53.32

(C44) 34°47'28" 80.00' 48.58' 47.83' N 0°52'25" E

(C45) | 39°51'07" | 80.00' | 55.64' | 54.53' | N 36°26'52" W

(C46) | 43°52'02" | 80.00' | 61.25' | 59.77' | N 78°18'27" W

(C47) | 11°44'31" | 80.00' | 16.39' | 16.37' | S 73°53'17" W

(C48) | 65°23'46" | 15.00' | 17.12' | 16.21' | N 79°17'05" W

(C49) | 1°01'08" | 3651.68' | 64.93' | 64.93' | N 46°04'39" W

(C50) | 0°58'09" | 3651.68' | 61.78' | 61.78' | N 45°05'00" W

(C51) | 0°59'18" | 3651.68' | 62.99' | 62.99' | N 44°06'16" W

(C52) | 0°56'58" | 3651.68' | 60.52' | 60.52' | N 43°08'08" W

(C53) | 1°04'46" | 3651.68' | 68.81' | 68.80' | N 42°07'15" W

(C54) | 0°47'31" | 3651.68' | 50.48' | 50.48' | N 41°11'07" W

(C55) 75°26'56" | 10.00' | 13.17' | 12.24' | N 3°03'53" W

(C56) | 25°34'51" | 125.00' | 55.81' | 55.35' | N 21°52'10" E

(C57) | 0°17'31" | 3551.68' | 18.09' | 18.09' | S 41°26'51" E

(C58) | 1°09'21" | 3551.68' | 71.64' | 71.64' | S 42°10'17" E

(C59) 0°53'17" 3551.68' 55.06' 55.06' S 43°11'36" E

(C60) | 0°59'26" | 3551.68' | 61.40' | 61.40' | S 44°07'58" E

PROPERTY LINE CURVE DATA

Curve Delta Radius Length Chord Chord Bearing

(C61) | 1°00'14" | 3551.68' | 62.23' | 62.23' | S 45°07'48" E

(C62) | 0°08'51" | 3551.68' | 9.14' | 9.14' | S 45°42'20" E

(C63) | 45°05'36" | 15.00' | 11.81' | 11.50' | S 68°19'33" E

(C64) | 1°45'07" | 180.00' | 5.50' | 5.50' | S 89°55'29"

(C65) 31°41'39" | 180.00' | 99.57' | 98.31' | S 73°12'06" E

(C66) | 41°06'56" | 180.00' | 129.17' | 126.41' | S 36°47'48" E

| (C67) | 20°02'50" | 180.00' | 62.98' | 62.66' | S 6°12'55" E

(C68) | 16°23'38" | 180.00' | 51.50' | 51.33' | S 12°00'19" W

(C69) 33°46'02" | 180.00' | 106.08' | 104.55' | S 37°05'09" W

| (C70) | 32°12'22" | 180.00' | 101.18' | 99.85' | S 70°04'21" W

| (C71) | 37°57'55" | 180.00' | 119.27' | 117.10' | N 74°50'31" W |

| (C72) | 33°08'50" | 180.00' | 104.13' | 102.69' | N 39°17'08" W

(C73) | 19°58'20" | 180.00' | 62.74' | 62.43' | N 12°43'33" N

(C74) 0°04'59" 3801.68' 5.52' 5.52' N 45°48'36" W

(C75) | 43°11'32" | 15.00' | 11.31' | 11.04' | N 24°15'20" W

| (C76) | 0°45'29" | 3801.68' | 50.30' | 50.30' | N 45°23'22" W

| (C77) | 0°54'34" | 3801.68' | 60.34' | 60.34' | N 44°33'21" W

(C78) | 0°54'10" | 3801.68' | 59.90' | 59.90' | N 43°38'59" W

| (C79) | 0°54'12" | 3801.68' | 59.94' | 59.94' | N 42°44'48" W

(C80) | 0°36'44" | 3801.68' | 40.63' | 40.63' | N 41°59'19" W

DEVELOPER:

GREAT BASIN

ENGINEERING

5746 SOUTH 1475 EAST OGDEN, UTAH 84403 MAIN (801)394-4515 S.L.C (801)521-0222 FAX (801)392-7544

W W W . G R E A T B A S I N E N G I N E E R I N G . C (

Terakee Investments, LLC

North Ogden, UT 84414


c/o Brad Blanch

(801) 668-8565

# Terakee Farm® - No. 1

#### A PRUD Subdivision

A part of the Southeast Quarter of Section 9, T6N, R2W, SLB&M, U.S. Survey Weber County, Utah November 2021

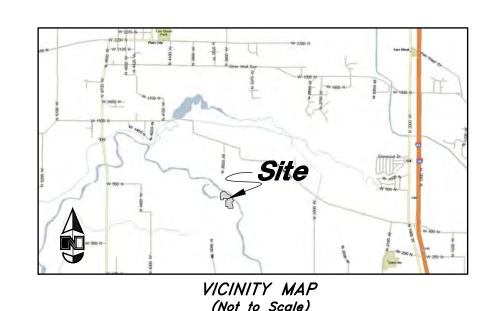

### NARRATIVE

This Subdivision Plat was requested by Mr. Brad Blanch for the purpose of creating forty (40) residential Lots and five (1) Open Space Parcel.

Brass Cap Monuments were found at the Southeast Corner and the South Quarter Corner of Section 17, T6N, R2W, SLB&M.

- A line bearing North 89°05'07" West between these two monuments was used as the Basis of Bearings.
- Property Corners were monumented as depicted on this plat.
- If Curb and Gutter is installed, "Rivets will be set in the Top Back of Curb on the extension of the Property Line.
- If Curb and Gutter is deferred, the front Property Corners will be required to have Rebar and Cap set.
- SEE ROS# \_\_\_\_\_ Filed with the Weber County Surveyor's Office for Overall Boundary Retracement Details.

#### DESCRIPTION

A part of the Southeast Quarter of Section 9, Township 6 North, Range 2 West, Salt Lake Base and Meridian, Beginning at the Northwest corner of Lot 1 McFarland Subdivision (Weber County Recorder Entry # 1672850) said point being 397.19 feet South 89°26'19" East along the Section line and 1.049.27 feet North 00°33'41" East from the South Quarter corner of said Section, and running thence North 89°03'30" West 17.49 feet along the North Line of said McFarland Subdivision to the Easterly line of the Richard and Carisa Hipwell property (Parcel #15-028-0054); thence North 00°46'31" East 55.61 feet along said Easterly line; thence South 89°13'13" East 64.06 feet to a point of curvature; thence Easterly along the arc of a 74.97 foot radius curve to the left a distance of 54.39 feet (Central Angle equals 41°34'11" and Long Chord bears North 69°59'42" East 53.21 feet); thence North 49°12'36" East 448.50 feet to a point of curvature; thence Northeasterly along the arc of a 175.00 foot radius curve to the left a distance of 47.74 feet (Central Angle equals 15°37'45" and Long Chord bears North 41°23'44" East 47.59 feet) to a point of compound curvature thence Northerly along the arc of a 10.00 foot radius curve to the left a distance of 15.75 feet (Central Angle equals 90°15'26" and Long Chord bears North 11°32'52" West 14.17 feet); thence along a line non-tangent to said curve, North 33°19'25" East, a distance of 50.00 feet; thence South 56°40'35" East 233.49 feet to a point of curvature: thence Easterly along the arc of a 375.00 foot radius curve to the left a distance of 227.11 feet (Central Angle equals 34°42'00" and Long Chord bears South 74°01'35" East 223.66 feet): thence North 88°37'25" East 53.32 feet to a point of curvature; thence Northeasterly along the arc of a 75.00 foot radius curve to the left a distance of 107.01 feet (Central Angle equals 81°45'10" and Long Chord bears North 47°44'49" East 98.16 feet); thence along a line non-tangent to said curve, South 83°07'46" East, a distance of 50.00 feet to the point of curve of a non-tangent curve, of which the radius point lies North 83°07'46" West; thence Southerly along the arc of a 125.00 foot radius curve to the right a distance of 4.82 feet (Central Angle equals 02°12'30" and Long Chord bears South 07°58'29" West 4.82 feet); thence along a line non-tangent to said curve, South 73°49'55" East, a distance of 79.81 feet to the point of curve of a non-tangent curve, of which the radius point lies North 48°41'54" East; thence Southeasterly along the arc of a 3,551.68 foot radius curve to the left a distance of 277.57 feet (Central Angle equals 04°28'40" and Long Chord bears South 43°32'26" East 277.50 feet) to a point of compound curvature thence Easterly along the arc of a 15.00 foot radius curve to the left a distance of 11.81 feet (Central Angle equals 45°05'36" and Long Chord bears South 68°19'33" East 11.50 feet) to the point of curve of a non-tangent curve, of which the radius point lies South 00°55'17" East; thence Southeasterly along the arc of a 179.65 foot radius curve to the right a distance of 297.40 feet (Central Angle equals 94°51'02" and Long Chord bears South 43°29'46" East 264.59 feet); thence along a line non-tangent to said curve, South 01°26'04" West, 292.07 feet; thence North 89°04'28" West 1,056.69 feet to the Southeast corner of said McFarland Subdivision; thence two (2) courses along the East and North Boundaries of said Subdivision as follows (1) North 00°56'30" East 362.32 feet: and (2) North 89°03'30" West 438.81 feet to the point of curve of a non-tangent curve, of which the radius point lies South 30°56'09" East; thence Southwesterly along the arc of a 88.67 foot radius curve to the left a distance of 89.65 feet (Central Angle equals 57°55'36" and Long Chord bears South 30°06'03" West 85.88 feet) tot eh East right of way line of 3600 West Street as dedicated on said Subdivision; thence North 00°49'22" East 75.00 feet along said East right of way line to the POINT OF BEGINNING.

## Containing 17.704 acres, more or less.

#### OWNERS DEDICATION

Andy Hubbard

SURVEYOR'S CERTIFICATE

Utah, and that I hold Certificate No. 6242920 in accordance with Title 58, Chapter 22, of the Professional Engineers and Land Surveyors Licensing Act. I also certify that I have completed a

survey of the property described hereon In accordance with Section 17-23-17 and that I have verified all measurements shown hereon this plat of Terakee Farm No. 1 - A RRUD Subdivision in

Weber County, Utah and that it has been correctly drawn to the designated scale and is a true

been found or placed as represented on this plat. I furthermore certify that all lots within this

Subdivision hereby meet all current lot width and area requirements of the Weber County Zoning

and correct representation of the following description of lands included in said subdivision, based on data compiled from records in the Weber County Recorder's Office. Monuments have

Signed this \_\_\_\_\_ day of \_\_\_\_\_


6242920 License No

I, Andy Hubbard, do hereby certify that I am a Professional Land Surveyor in the State of

We the undersigned owners of the herein described tract of land, do hereby set apart and subdivide the same into lots as shown on the plat and name said tract Terakee Farms No. 1 -A PRUD Subdivision and do hereby dedicate and grant to Weber County a perpetual right and easement on and over the Open Space parcels for agriculture preservation easements to guarantee to Weber County that the Open Space parcels remain open and undeveloped except for approved agricultural, recreational, and open space purposes except to be used and maintained by the owner of said parcel(s) for approved agricultural purposes, and also do grant and dedicate a perpetual right and easement over, upon and under the lands designated hereon as Private Streets and/or public utility easements, the same to be used for the maintenance and operation of Sanitary Sewer lines and Structures, Storm Drainage Lines and Structures and/or public utility service lines and storm drainage facilities, whichever is applicable as may be authorized by the governing authority, with no buildings or structures being erected within such

We also dedicate and reserve unto themselves, their heirs, their grantees and assigns, a right-of-way to be used in common with all others within said Subdivision (and those adjoining Subdivisions that may be subdivided by the undersigned owners, their successors, or assigns) on, over and across all those portions or parts of said tract of land designated on said plat as Private Streets (Private rights-of-way) as access to the individual lots, to be maintained by Terakee Farms, Inc., their grantees, successors, or assigns.

We also do hereby dedicate, grant and convey to Terakee Farm, Inc. the Parcels and also dedicate and grant a perpetual right and easement over, upon and under the lands designated hereon as Parcels, for Storm Water Detention, Landscaping, and Secondary Water facility purposes. The same to be used for the maintenance and operation of storm drainage facilities, Secondary Water facilities as applicable as may be authorized by the governing authority, with no residential buildings or structures being erected within such parcels unless otherwise defined in the Codes, Covenants, and Restrictions (CC&R's) for this development.

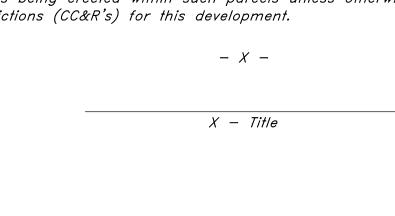

County	of		<i>y ss</i>							
	The	foregoing	instrument _ 2021 by _		acknowledge 	d before	me	this	day of	

**ACKNOWLEDGMENT** 

Residing At: A Notary Public commissioned in Utah Commission Number: Commission Expires: Print Name

WEBER COUNTY ENGINEER

improvement standards and drawings for this subdivision

conform with County standards and the amount of the

financial quarantee is sufficient for the installation of

I hereby certify that the required public

#### AGRICULTURAL NOTE

Agriculture is the preferred use in the agriculture zones. Agricultural operations as specified in the Land Use Code for a particular zone are permitted at any time including the operation of farm machinery and no allowed agricultural use shall be subject to restrictions on the basis that it interferes with activities of future residents of this subdivision.

these improvements.

Signed this \_\_\_\_\_ of \_\_\_

This is to certify that this subdivision plat was duly approved by the Weber County Planning Commission.

WEBER COUNTY PLANNING

COMMISSION APPROVAL

State of Utah

} *SS* 

## Chairman, Weber County Planning Comission

# Weber County Engineer

# WEBER COUNTY COMMISSION ACCEPTANCE

dedication of streets and other public ways and financial guarantee of public improvements associated with this subdivision, thereon are hereby approved and accepted by the Commissioners of Weber County, Utah.
Signed this, day of, 2021
Chairman, Weber County Comission
Attest:

			She	et 1	of 2

WEBER COUNTY RECORDER FEE PAID \_\_FILED FOR RECORD AND RECORDED\_ \_\_\_\_\_ IN BOOK\_\_\_\_\_ OF OFFICIAL RECORDS, PAGE\_\_\_ WEBER COUNTY RECORDER DEPUTY

W:\16N704 - Terakee\DWG\16N704 - AP.dwg, 11/11/2021 3:08:59 PM, KyleD, 1:1

Great Basin Engineering Inc

5746 South 1475 East Suite 200

c/o Andy Hubbard, PLS

Ogden, Utah 84405

(801) 394-4515

### WEBER COUNTY ATTORNEY

CENTERLINE CURVE DATA

Curve Delta Radius Length Chord Chord Bearing

(C201) | 41°34'11" | 99.97' | 72.53' | 70.95' | N 69°59'42" E

(C202) | 15°49'53" | 200.00' | 55.26' | 55.09' | N 41°17'40" E

(C2O3) | 34°42'00" | 400.00' | 242.25' | 238.57' | S 74°01'35" E

(C2O4) | 14°34'35" | 400.00' | 101.76' | 101.49' | S 63°57'53" E

(C205) | 20°07'25" | 400.00' | 140.49' | 139.77' | S 81°18'53" |

(C206) | 81°45'10" | 100.00' | 142.69' | 130.89' | N 47°44'49" E

(C207) | 38°51'57" | 100.00' | 67.83' | 66.54' | N 69°11'26" E

| (C208) | 42°53'13" | 100.00' | 74.85' | 73.12' | N 28°18'51" E

(C209) 36°46'19" 592.92' 380.53' 374.03' S 0°35'45" E

(C210) | 7°37′18" | 3676.68' | 489.09' | 488.72' | S 44°07′19" E

I have examined the financial guarantee and other documents associated with this subdivision plat, and in my opinion they conform with the County Ordinance applicable thereto and now in force and

Sianed this day of

Weber County Attorney

Office has reviewed this plat for mathematical correctness, section corner data, and for harmony with lines and monument on record in County Offices. The approval of this plat by the Weber County Surveyor does not relieve the licensed Land Surveyor who executed this plat from the responsibilities and/or liabilities associated therewith.

WEBER COUNTY SURVEYOR

I hereby certify that the Weber County Surveyor's

AGRICULTURAL NOTE

Agriculture is the preferred use in the

agriculture zones. Agricultural operations as

particular zone are permitted at any time

including the operation of farm machinery

and no allowed agricultural use shall be

this subdivision.

subject to restrictions on the basis that it

interferes with activities of future residents of

specified in the Land Use Code for a

Signed this \_\_\_\_\_ day of \_\_\_\_

Weber County Surveyor

1. 10' wide Public Utility and Drainage Easements (P.U.&D.E.) on front lot lines as indicated by dashed lines except as otherwise

2. All Lots will have a 20' and Rear Yard Building Setback except as otherwise shown.

3. Second Fire Apparatus Access Road approved by the Weber County Fire Marshall must be capable of carrying 75,000 pounds in all weather conditions year-round. The Second Fire Apparatus Access Road surface will include 8" road base to support this capacity.

# Signed this \_\_\_\_\_ day of

Frontage and 5' Side (20' Corner)

This is to certify that this subdivision plat, the

16N704 - Terakee Farm - PRUD No. 1

#### Terakee Farm® PRUD No. 1 A PRUD Subdivision Northeast Corner of Section 9 A part the Southeast Quarter of Section 9, T6N, R2W, SLB&M, U.S. Survey T6N, R2W, SLB&M, U.S. Survey Weber County, Utah November 2021 (S 89°15'28" E W.C.S.) (2640.03' W.C.S.) Northeast Corner of Section S Center of Section 9, T6N, R2W, SLB&M, U.S Survey T6N, R2W, SLB&M, U.S. Survey ✓ △ = 90°15′26″ *50.00'* L = 15.75'S 33°19'25" W R = 10.00'LC = 14.17'△ = 34°42′00″ △ = 2°12'30" S 11°32'52" E L = 227.11' L = 4.82'N 83°07'46" W R = 375.00'R = 125.00' $L^{\circ} = 47.74'$ LC = 223.66' $\Delta = 81^{\circ}18'06''$ LC = 4.82'R = 175.00'N 74°01'35" W L = 107.08'N 7°58'29" E LC = 47.59'*R/= 75.46'*-79.81' \$ 41°23'44" W LC = 98.32'N 73°49'55" W \$ 47°50'30" W -53.32° S 88°37'25" W △ = 4°28'40" Graphic Scale 40 L = 277.57'Terakee Farme -R = 3551.71' LC = 277.50'△ = 41°34′11″ 39 N 43°32'26" W L = 54.39'(C28) 24.29° 29.03° R = 74.97'LC = 53.21'*38* 6,362 sq.ft. S 69°59'42" W 20 56,000 R 6,442 sq.ff. L = 11.81'6,415 sq.ft. -R = 15.00'LC = 11.50'*N <del>88°21</del>'54" ₩* **18** 6,001 sq.ft. N 68°19'33" W Parcel A 64.06' N 90°00'00" E 110.49' N 89°13'13" W S 87°46'56" E *36* 6,760 sq.ft. $\Delta = 94^{\circ}51'02''$ 5,878 sq.ft. L = 297.40'--S-<del>89°06</del>'43" <del>W</del> *- 55.61*° R = 179.65'S 88°22'37" E S 0°46'31" W 34 LC = 264.59' 6,570 sq.ft. R = 124.97'N 43°29'46" W *16* 60' Right\of Way $\Delta = 4^{\circ}10'09"$ R = 3801.68'S69°59'42"W L = 276.63'- LC = 276.57S 89°03'30" E 17.49' 438.81 S43°46'02"E 6,993 sq.ft. △ = 57°55'36" L = 89.65'-R = 88.67' 75.00' Set Rebar LC = 85.88'S 0°49'22" W 32 \_S 42°27'31" W Show all structures immediately 6,484 sq.ft. N 30°06'03" E adjacent to the subdivision \$-82°23'57"₩ N 67°43'40" E 5 83.21.51" + McFarland 31 Subdivision **29** 8,985 sq.ft. $\Delta = 173^{\circ}27'06''$ R = 180.00'= 243°19'19" L = 544.91' LC = 359.41L = 764.42LC = 306.42N58°05/37"E boundary if within plat dedication S 89°04'26" E 1056.92' Jed J. & Pamela McCormick (2644.81' W.C.S.) (S 89°26'19" E W.C.S.) Southeast Corner of Section 9, T6N, R2W, SLB&M, U.S. Survey South Quarter Corner of Section 9, T6N, R2W, SLB&M, U.S Survey (Found Weber County Brass Cap Sheet 2 of 2 -(Found Weber County Brass Cap Dated 1988 in Good Condition) Dated 1988 in Good Condition) NOTES: WEBER COUNTY RECORDER AGRICULTURAL NOTE 1. 10' wide Public Utility and Drainage Easements FEE PAID ENTRY NO.\_ (P.U.&D.E.) on front lot lines as indicated by dashed lines Agriculture is the preferred use in the agriculture zones. \_\_\_FILED FOR RECORD AND except as otherwise shown. Agricultural operations as specified in the Land Use Code for a particular zone are permitted at any time including the \_ IN BOOK\_\_\_\_\_OF OFFICIA 2. Setbacks for the Lots are as Follows: operation of farm machinery and no allowed agricultural use RECORDS, PAGE\_\_\_\_\_\_. RECORDE 2.1. Small Lots (60' wide): 20' front, 5' side and 5' shall be subject to restrictions on the basis that it interferes GREAT BASIN O ENGINEERING Z with activities of future residents of this subdivision. DEVELOPER: 2.2. All Other Lots (80' feet wide or more): 20' front, Great Basin Engineering Inc c/o Andy Hubbard 5746 South 1475 East Suite 200 Terakee Investments, LLC 10' foot side and 5' back. c/o Brad Blanch WEBER COUNTY RECORDER 1060 East 3400 North North Ogden, UT 84414 Ogden, Utah 84405 5746 SOUTH 1475 EAST OGDEN, UTAH 84403 MAIN (801)394-4515 S.L.C (801)521-0222 FAX (801)392-7544 W W W . G R E A T B A S I N E N G I N E E R I N G . C O M (801) 394-4515 (801) 668-8565

DEPUTY

#### \* See All Sheets\*

- 1. All construction shall conform to Weber County standards and specifications. 2. All Construction on the Secondary Water Line shall meet or exceed Davis & Weber Canal Company Standards and Specifications.
- 3. Underground utility piping materials will meet or exceed West Point City
- 4. Culinary water services will be 3/4" Dia. C-900 DR14 PVC to be centered on the frontage and extended 10' beyond the right of way line.
- 5. 4" Sanitary sewer laterals to be constructed 10' down slope from the center of the lot and extended 10' beyond the right of way line.
- 6. 4" Land drain laterals to be constructed at the low corner of the lot and
- extended 10' beyond the right of way line. 4. Saw Cut Existing Asphalt to provide a smooth clean edge.
- 5. All Utility trenches within the Street right of way shall have a City approved imported granular backfill.
- 6. Thrust block all water line fittings.
- 7. All inlet grates shall be bicycle safe. 8. All fire hydrants and access roads shall be installed prior to any construction of any buildings.
- 9. All fire hydrants shall be placed with 4  $\frac{1}{2}$  inch connections facing the point of access for the Fire Department Apparatus.
- 10. Prior to the beginning of construction of any buildings, a fire flow test of new hydrants shall be conducted to verify the actual fire flow for this project. The Fire Prevention Division shall witness this test and shall be
- notified a minimum of 48 hours prior to the test. 11. Curb & gutter installed along 2200 South Street will be set to ensure a 1.5% minimum/3.0% Maximum cross slope from edge of asphalt. Contractor
- to verify prior to construction of curb. 12. An excavation permit is required for all work done within the existing Right
- 13. A Storm Water Construction Activity Permit is required for any construction that disturbs more than 5000 Sq. Ft. or 200 Cubic Yards.
- 14. All improvements need to be either installed or escrowed prior to recording of the subdivision.
- 15. If construction activity will disturb more than an acre then a State SWPPP will be required. This includes the construction of the homes etc. on each

#### GENERAL UTILITY NOTES:

- 1. Coordinate all utility connections to building with plumbing plans and building
- 2. Verify depth and location of all existing utilities prior to constructing any new utility lines. Notify Civil Engineer of any discrepancies or conflicts prior to any connections being made.
- 3. All catch basin and inlet box grates are to be bicycle proof. 4. All inlet boxes located in curb and gutter are to be placed parallel to the curb and gutter and set under the frame and grate. Improperly placed boxes will be removed and replaced at no additional cost to the owner. Precast or
- cast in place boxes are acceptable. 5. Refer to the site electrical plan for details and locations of electrical lines,
- transformers and light poles. 6. Gas lines, telephone lines, and cable TV lines are not a part of these plans unless otherwise noted.
- 7. Water meters are to be installed per city standards and specifications. It will be the contractor's responsibility to install all items required.
- 8. Water lines, valves, fire hydrants, fittings etc. are to be constructed as shown. Contractor is responsible to construct any vertical adjustments necessary to clear sewer, storm drain or other utilities as necessary including valve boxes and hydrant spools to proper grade.
- 9. Field verify all existing and/or proposed Roof Drain/Roof Drain down spout connections to Storm Water System with Civil, Plumbing & Architectural plans.
- Notify Engineer of any discrepancies. 10. All gravity flow utility lines shall be installed prior to any pressurized utilities unless written permission is obtained from the engineer of record before construction begins.

## UTILITY PIPING MATERIALS:

All piping to be installed per manufacturers recommendations. Refer to project specifications for more detailed information regarding materials,

#### CULINARY SERVICE LATERALS

1. 3/4" to 2" diameter pipe — copper tube ASTM B, Type K, Soft Temper

2. Over 2" diameter pipe - AWWA C-900 Class 150 pipe

### WATER MAIN LINES AND FIRE LINES

1. Pipe material as shown on utility plan view or to meet city standards.

#### 1. All sewer piping to be Polyvinyl Chloride (PVC) sewer pipe, ASTM D 3034, Type PSM, SDR 35

STORM DRAIN LINES 1. 10" pipes or smaller — Polyvinyl Chloride (PVC) sewer pipe, ASTM D3034, Type

- PSM, SDR 35 2. 12" to 21" pipes - Concrete Pipe, ASTM C14, Class III up to 13' of cover. For greater than 13' feet of cover, use reinforced concrete pipe and classes
- 3. 24" pipes or larger Reinforced Concrete Pipe, ASTM C76, Class III up to 13' of cover, Class IV for 13' to 21' of cover, Class V for 21' to 32' of cover, and Special Design for cover greater than 32 feet.

#### CAUTION NOTICE TO CONTRACTOR

The contractor is specifically cautioned that the location and/or elevation of existing utilities as shown on these plans are based on records of the various utility companies and, where possible, measurements taken in the field. The information is not to be relied on as being exact or complete. The contractor must call the appropriate utility company at least 48 hours before any excavation to request exact field location of utilities. It shall be the responsibility of the contractor to relocate all existing utilities which conflict with the propose improvements shown on the plans.


#### PRIVATE ENGINEER'S NOTICE TO CONTRACTORS


The Contractor agrees that he shall assume sole and complete responsibility for job site conditions during the course of construction of this project, including safety of all persons and property: that this requirement shall apply continuously and not be limited to normal working hours, and that the contractor shall defend, indemnify, and hold the owner and the engineer harmless from any and all liability, real or alleged, in connection with the performance of work on this project, excepting for liability arising from the sole negligence of the owner or the engineer.


# Tarakee Farm® - No. 1

### A PRUD Subdivision

A part of Section 9, T6N, R2W, SLB&M, U.S. Survey Weber County, Utah November 2021

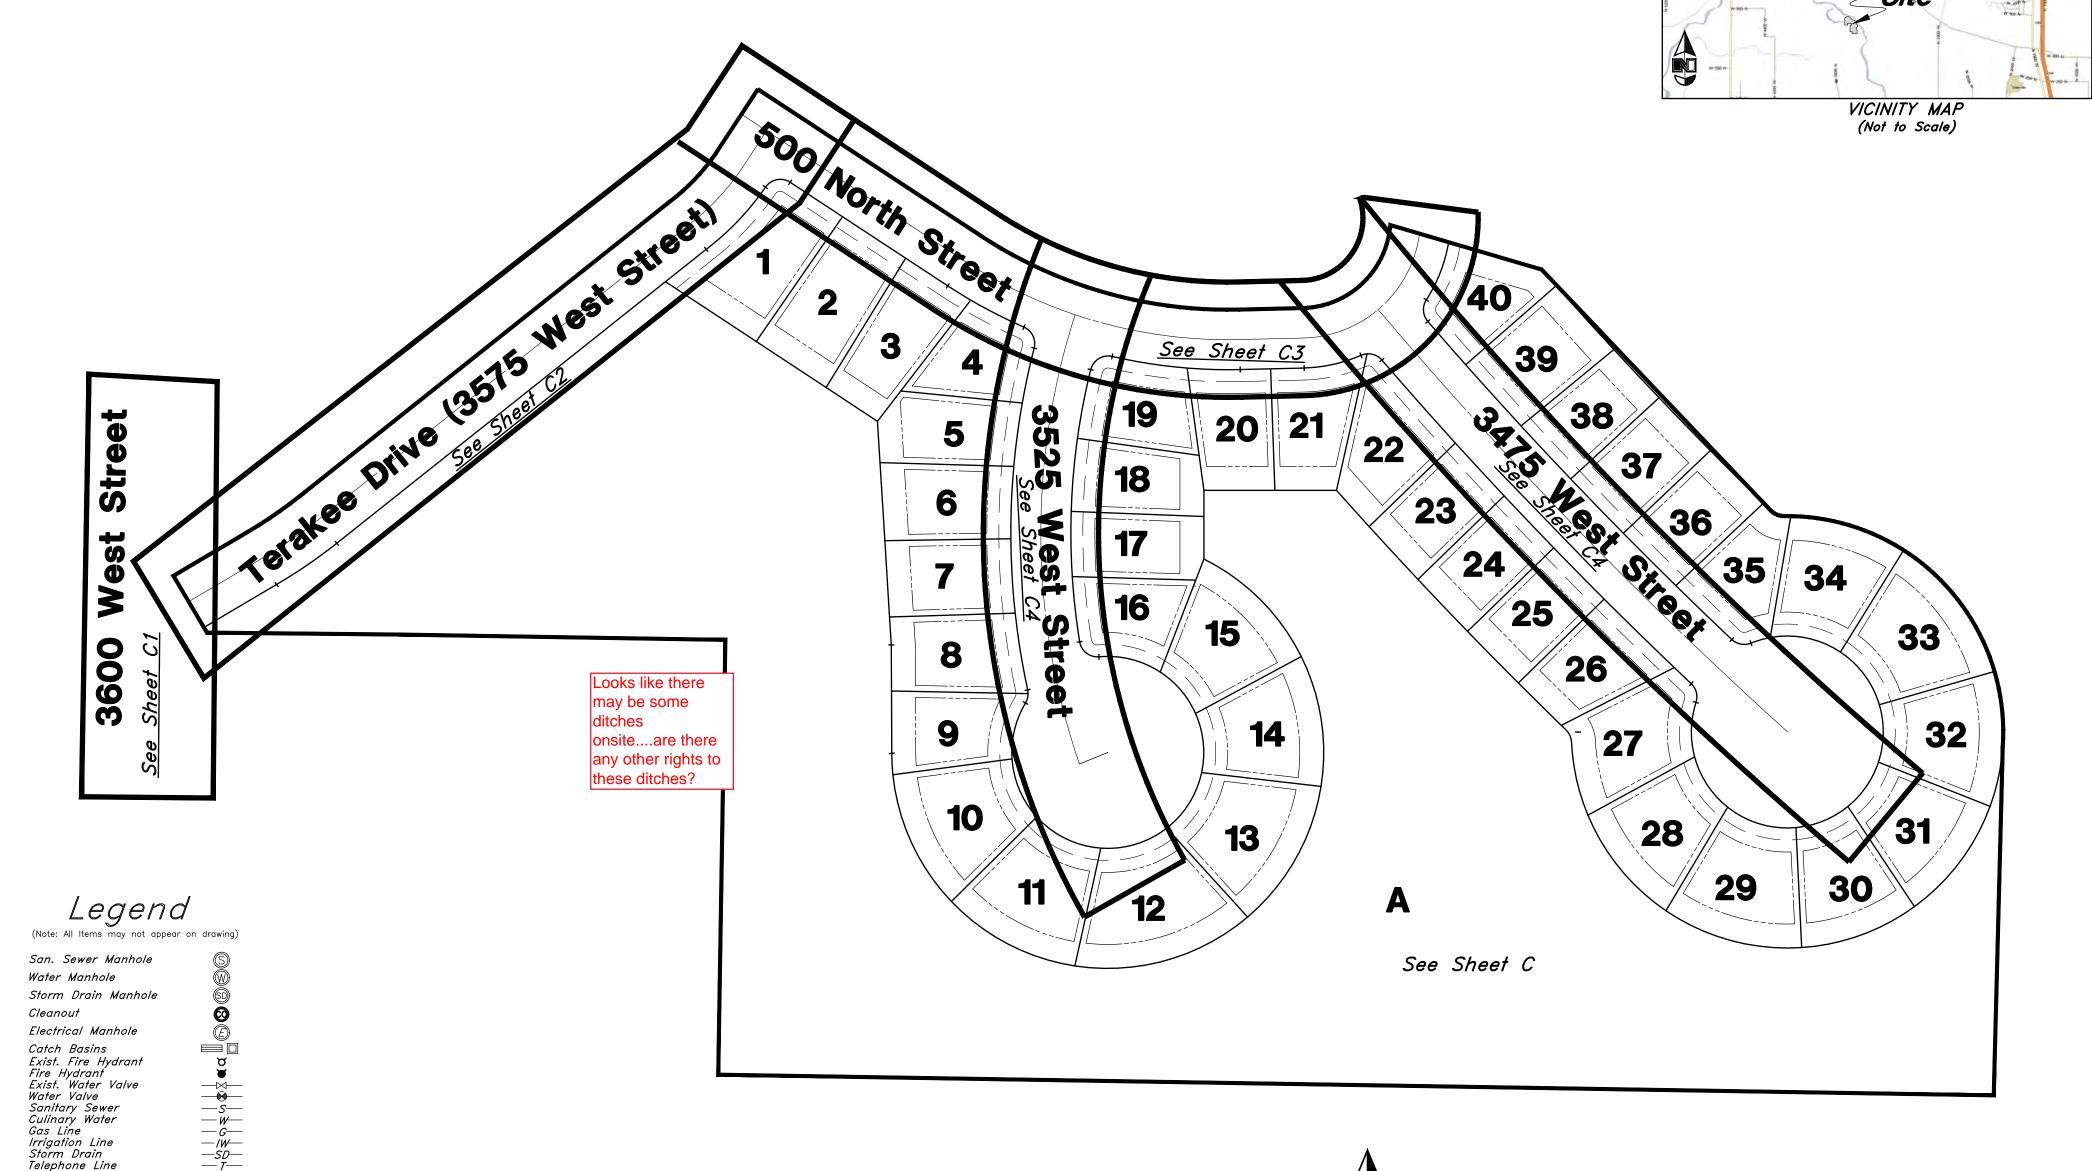

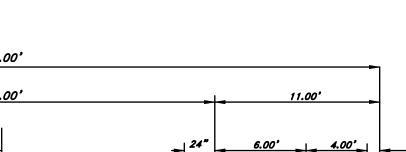

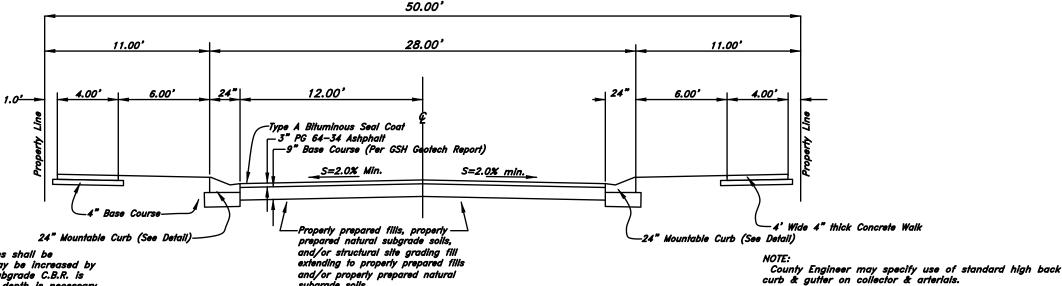

1 — These pavement thicknesses shall be considered as minimums and may be increased by the County Engineer when the subgrade C.B.R. is less than 10 or when a greater depth is necessary to provide sufficient stability. Developer may submit and alternate pavement design based on a detailed soils analysis for approval by the County Engineer. 2 - Minor & Major arterial shall be constructed with a 9" untreaded base course & 3" bituminous surface course as detailed in the Pavement Study Report prepared by GSH Geotechnical Inc. for Terakee Village Dated October 14, 2021.

Secondary Waterline

Flowline of ditch

Polyvinyl Chloride Top of Asphalt Edge of Asphalt

Concrete Pipe

Ductile Iron

Centerline Flowline Finish Floor

Top of Curb

Top of Wall

Top of Walk

Top of Concrete

Natural Ground

Finish Grade

Match Existing

Finish Contour

Ridge Line Direction of Flow

Existing Asphalt

Existing Concrete

New Asphalt

New Concrete

Exist. Contour Finish Grade Exist. Grade

Overhead Power line Corrugated Metal Pipe

Reinforced Concrete Pipe

Fire Department Connection FDC

TCN NG FG

*—90*—

--90--95.33TA

95.72TA

--R--\_\_\_

Power Line Fire Line

Land Drain Power pole Power pole w/guy

Light Pole

Fence

3 - County Engineer has discretion to call for more 4 - Provide 4" Thickness of 3/4" or 1" gravel base course under sidewalk, driveway approaches and curb & gutter when subgrade is clay or C.B.R. is less than 10 or as directed by the Geotechnical

# 50' Private Roadway Section


1 - Maximum difference in elevation between curbs on \*2- On arterial streets the County Engineer will provide a pavement design. Location of sidewalk and rolled curb & gutter may vary on individual arterial streets per direction of the County Engineer.

Call before you Dig Avoid cutting underground utility lines. It's costly. Call

W:\16N704 - Terakee\DWG\16N704 - AM.dwg, 11/11/2021 2:47:28 PM, KyleD, 1:1


**ΟΝΙ** 42


10 Nov, 2021

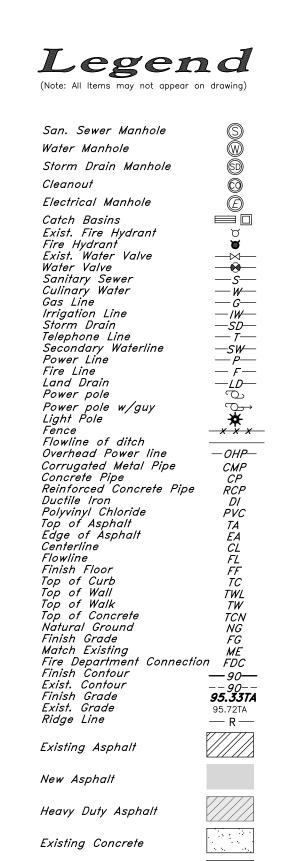

New Concrete

Spill Curb & Gutter

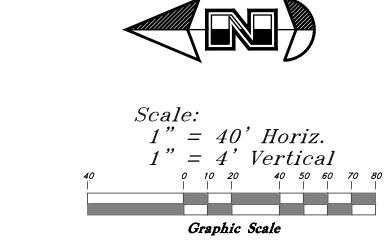

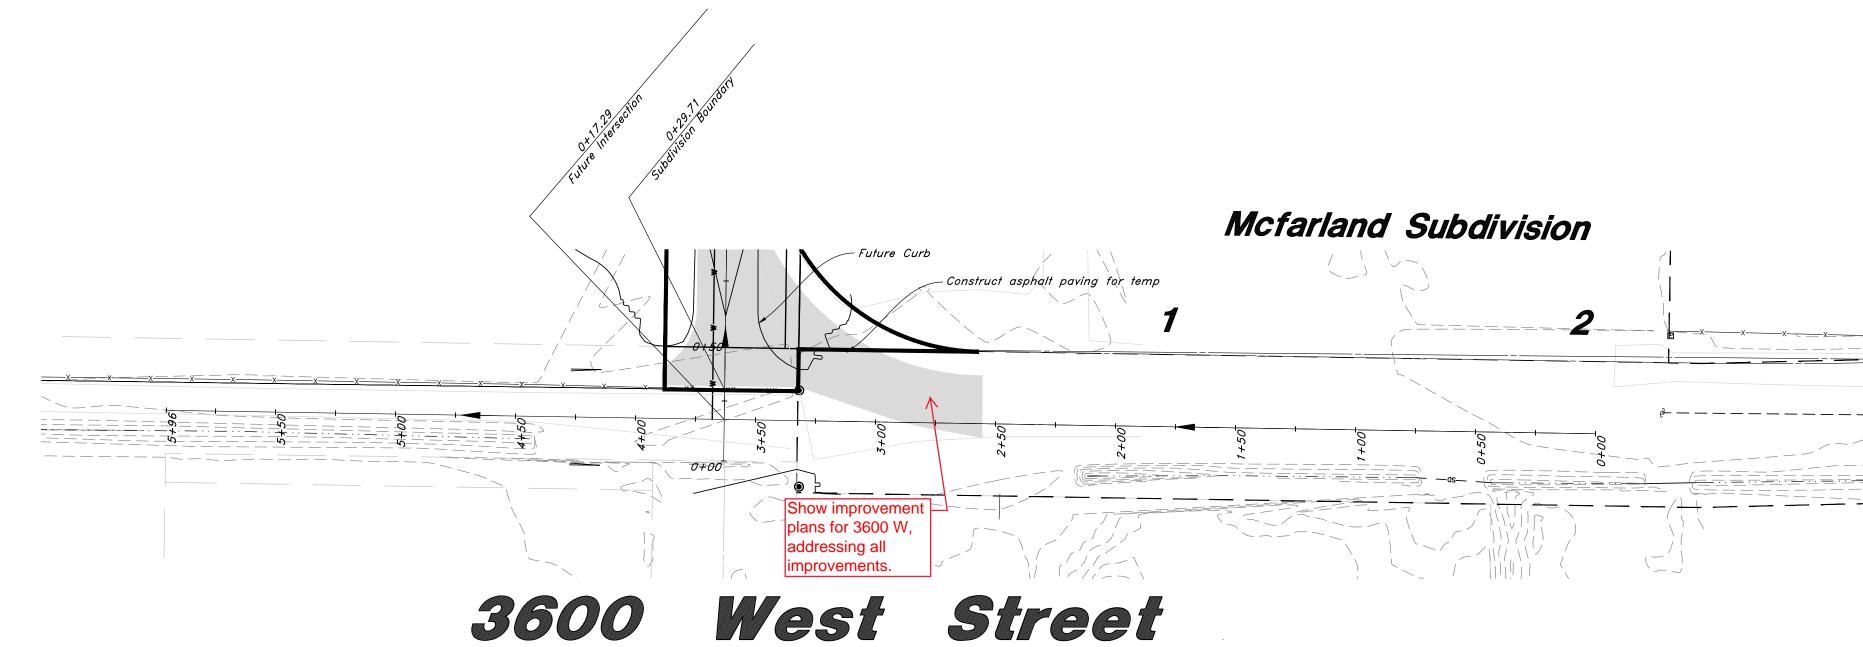

## 6+00 *5+00* 4+00 *3+00* 2+00 1+00 0+00 4244<sub>F</sub> 4216 7+00 4216 -1+00 6+00 *5+00* 4+00 *3+00* 2+00 1+00 0+00

G G G G G T H 1 4 7 5 E AAIN (801)394-4515 S.L.C (

**UD NO. 1**O West


an & Profile

erakee Farm F Approximately 1000 North Weber County, Ut


10 Nov, 2021

Call before you Dig Avoid cutting underground utility lines. It's costly.


TENTATIVE FINAL

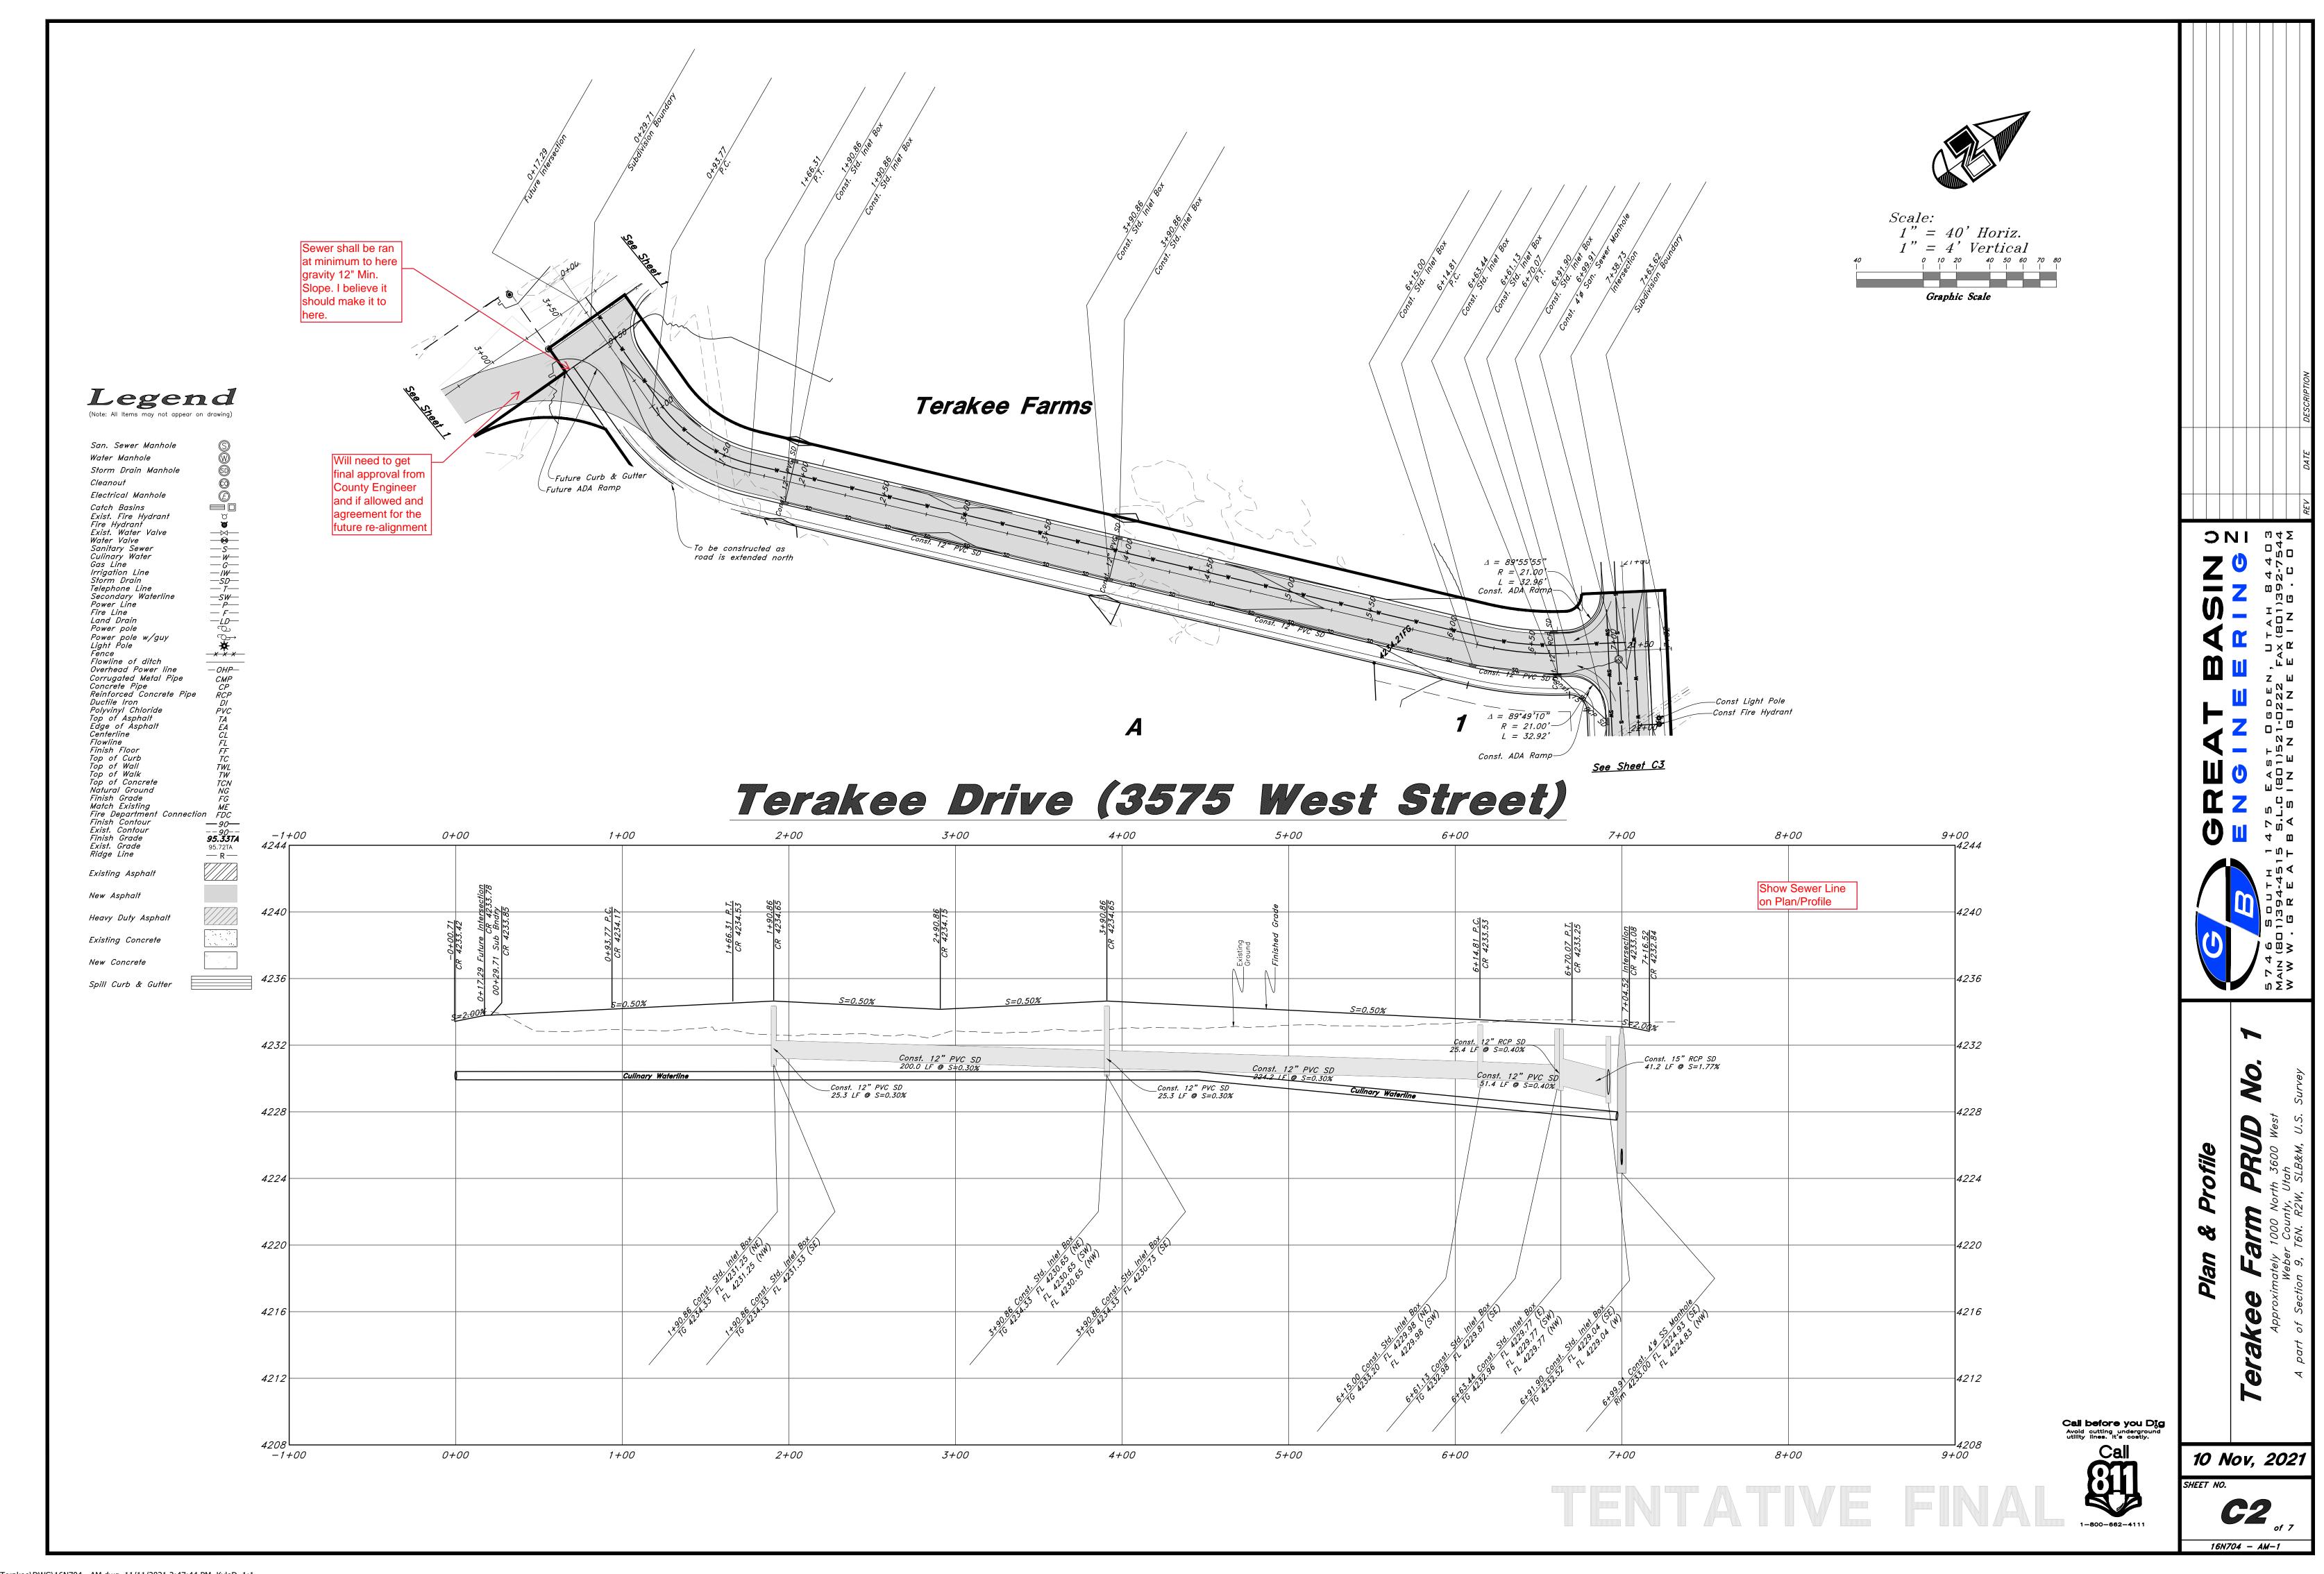

W:\16N704 - Terakee\DWG\16N704 - AM.dwg, 11/11/2021 2:47:44 PM, KyleD, 1:1

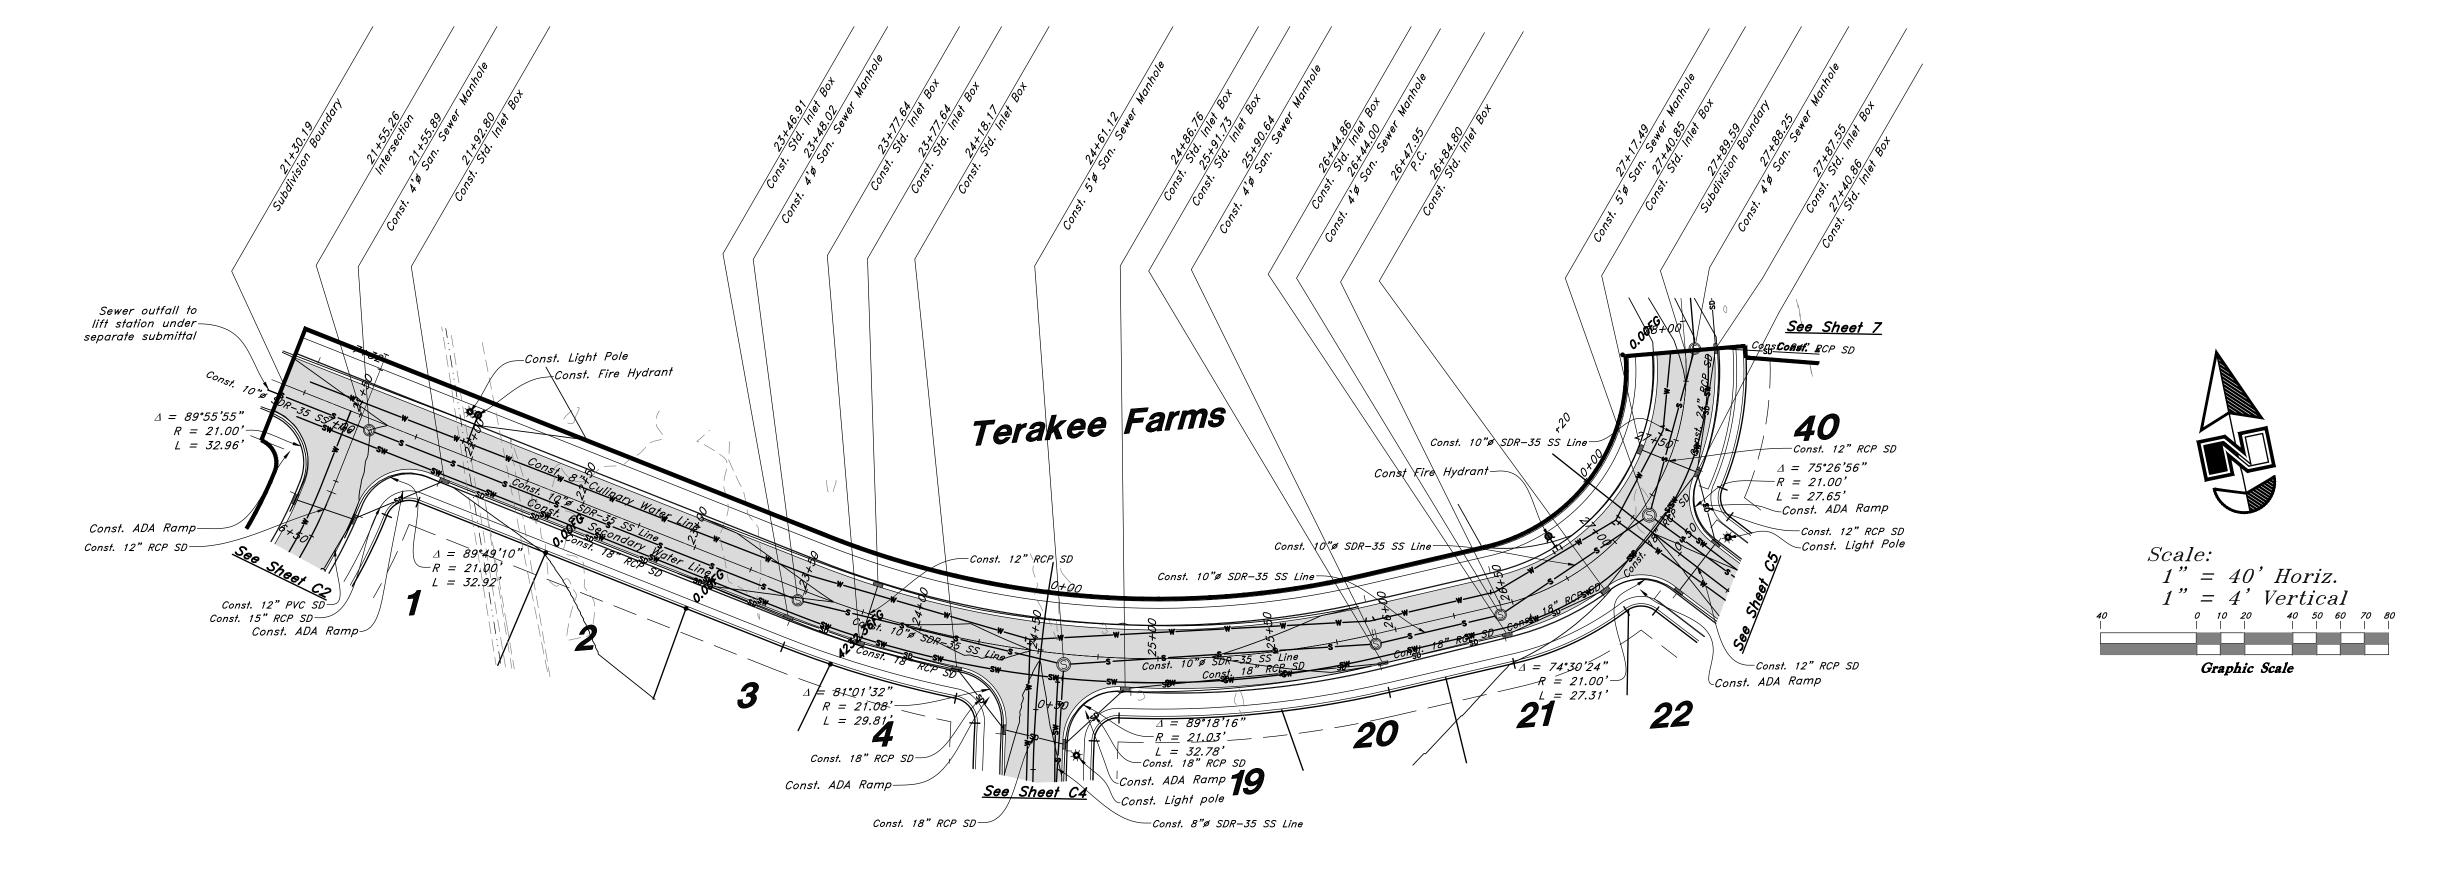

# 500 North Street

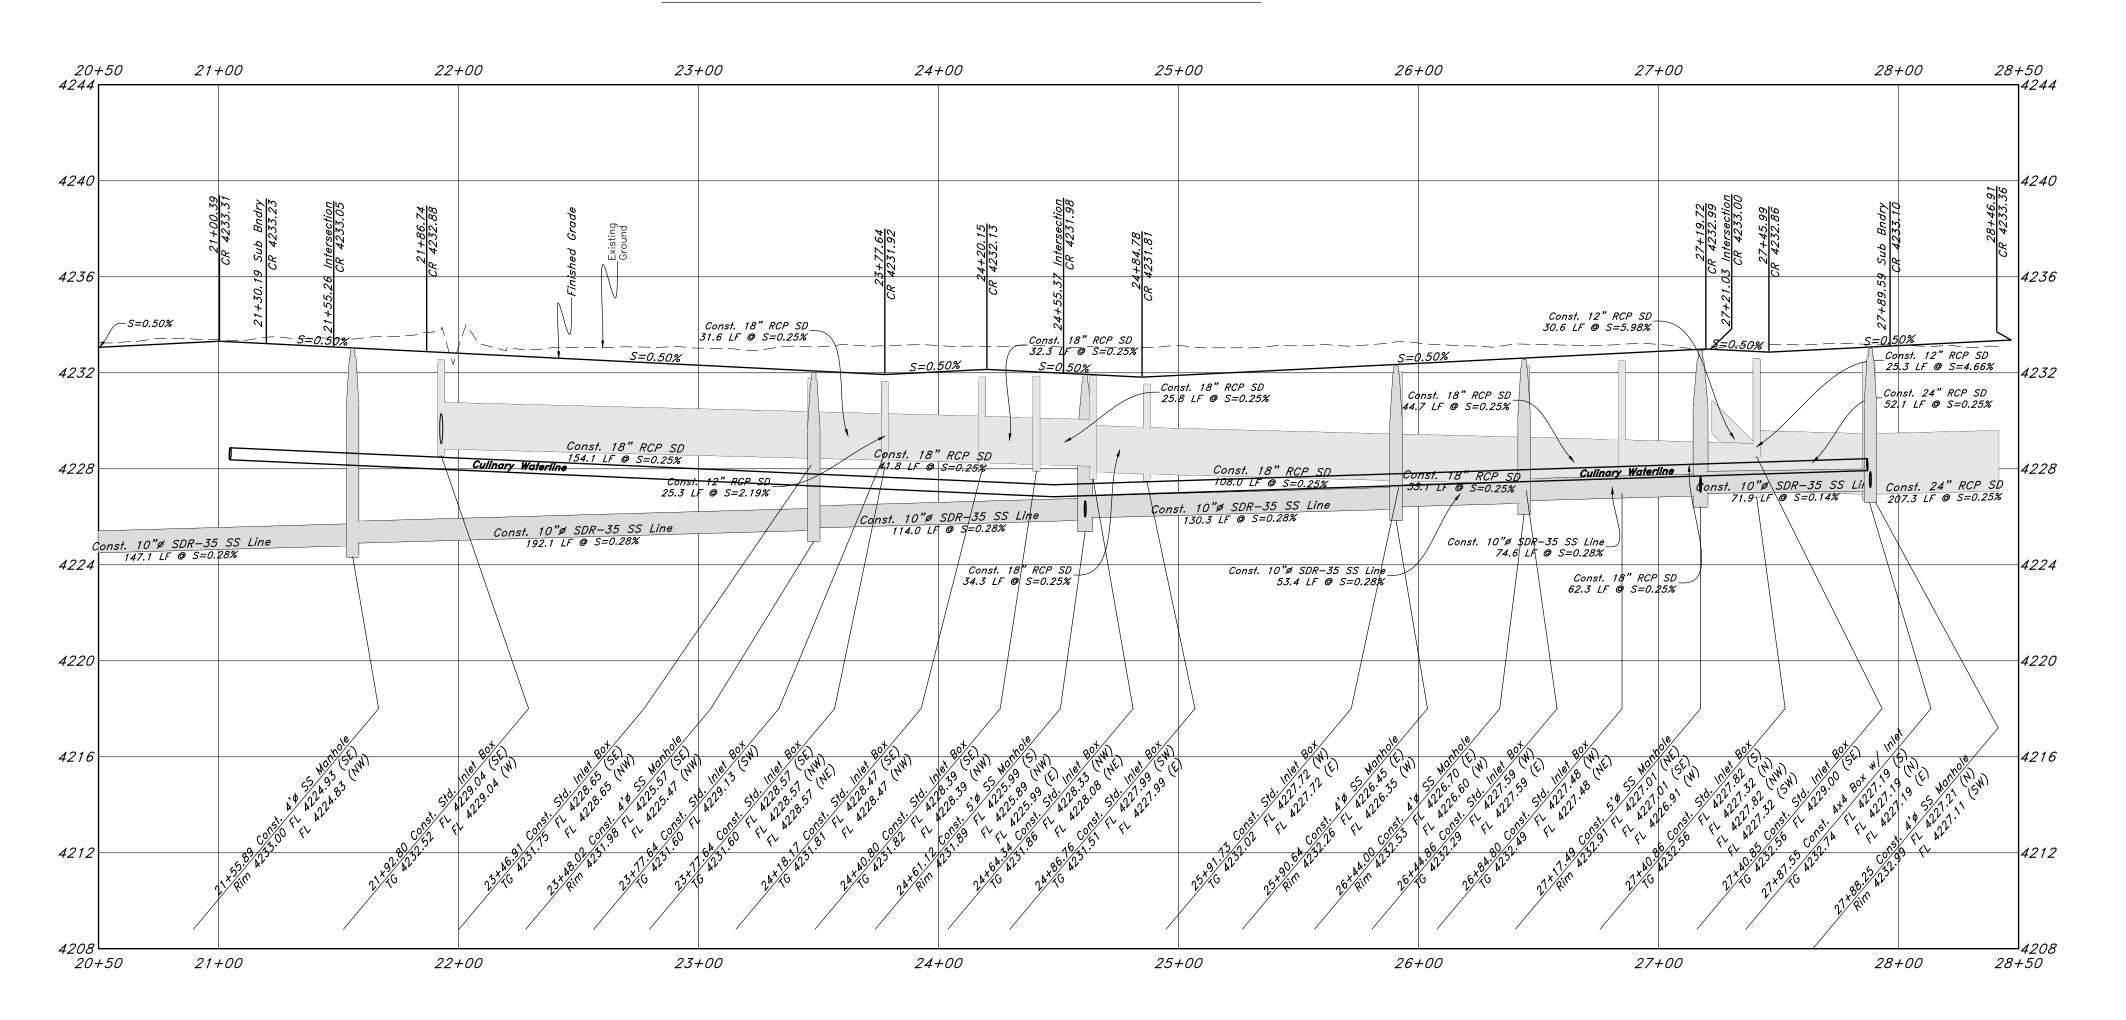

Call before you Dig

Avoid cutting underground
utility lines. It's costly.

10 Nov, 2021 16N704 - AM-1

Legend

Storm Drain Manhole

Electrical Manhole

Electrical Manhole

Catch Basins
Exist. Fire Hydrant
Fire Hydrant
Exist. Water Valve
Water Valve
Sanitary Sewer
Culinary Water
Gas Line
Irrigation Line
Storm Drain
Telephone Line
Secondary Waterline
Power Line
Land Drain
Power pole
Power pole w/guy
Light Pole
Fence
Fineal Metal Pipe
Concrete Pipe
Reinforced Concrete Pipe
Ductile Iron
Polyvinyl Chloride
Top of Asphalt
Edge of Asphalt
Edge of Asphalt
Centerline
Flowline
Finish Floor
Top of Walk
Top of Concrete
Natural Ground
Finish Grade
Match Existing
Fire Department Connection
Finish Grade
Stists. Grade
Ridge Line

Existing Asphalt

Existing Asphalt

Heavy Duty Asphalt

Existing Concrete


Spill Curb & Gutter

New Concrete

New Asphalt


— 90— -- 90--**95.337A** 95.72TA


Cleanout

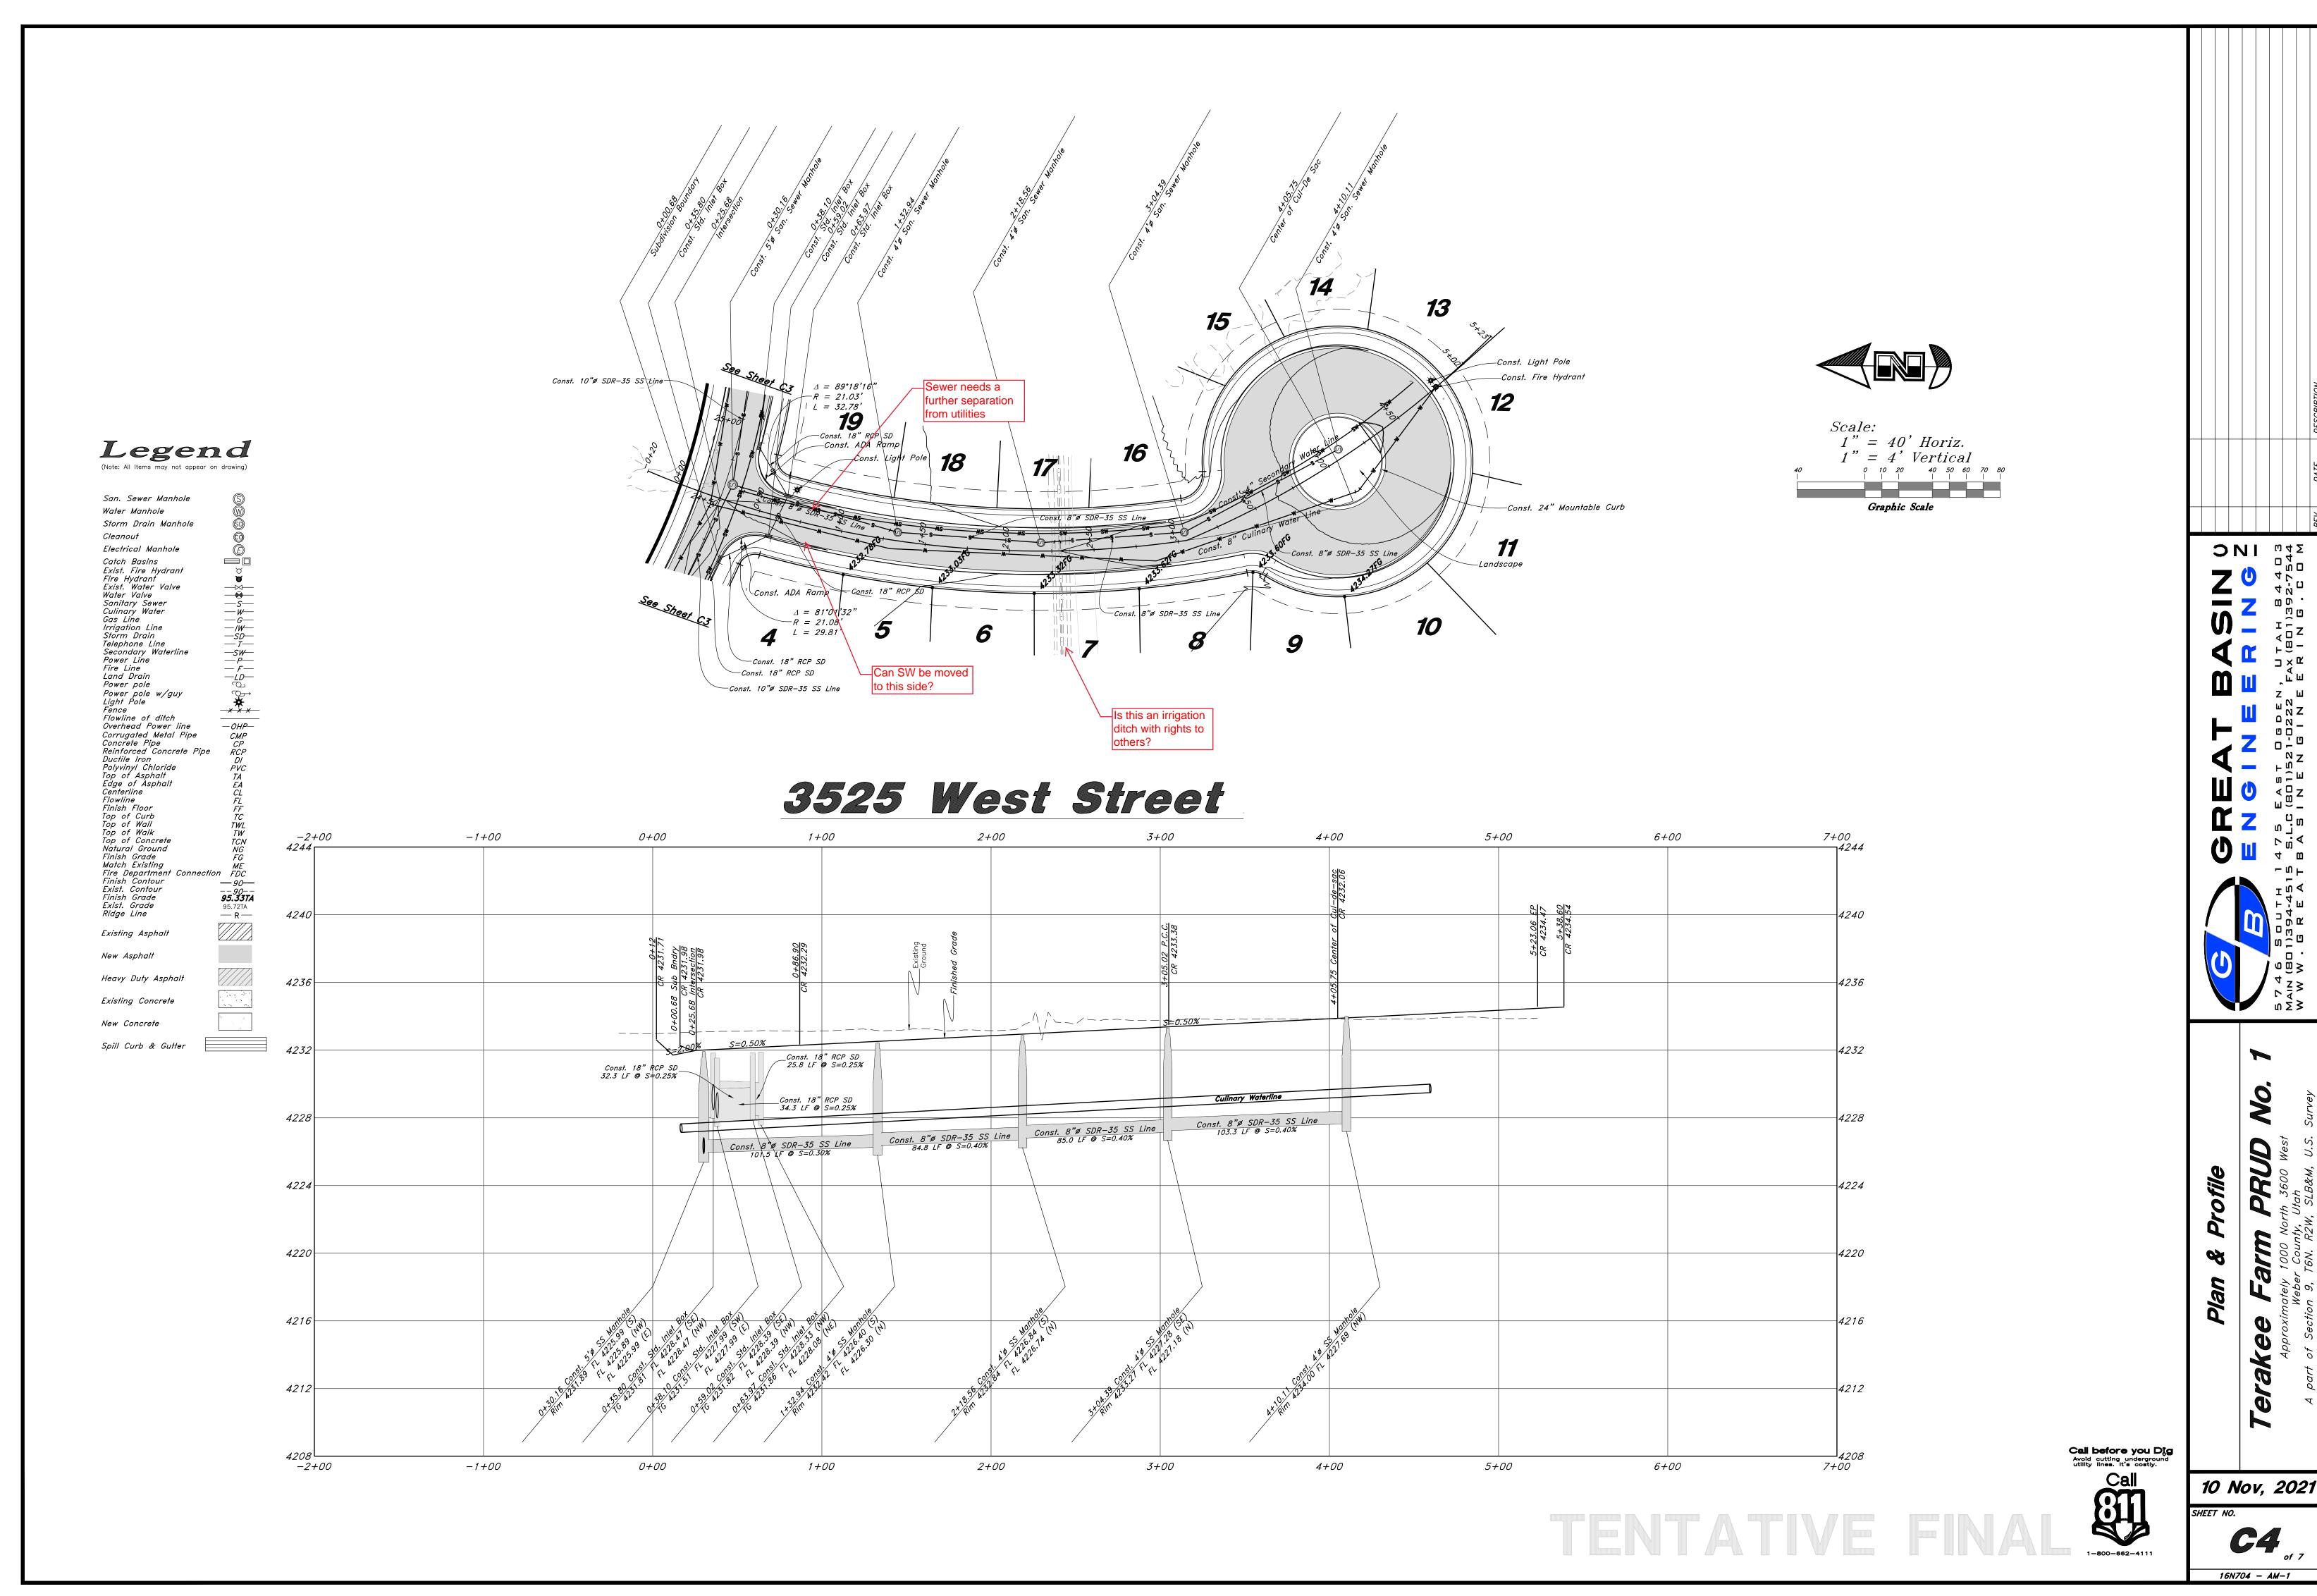


No.


W:\16N704 - Terakee\DWG\16N704 - AM.dwg, 11/11/2021 2:48:02 PM, KyleD, 1:1

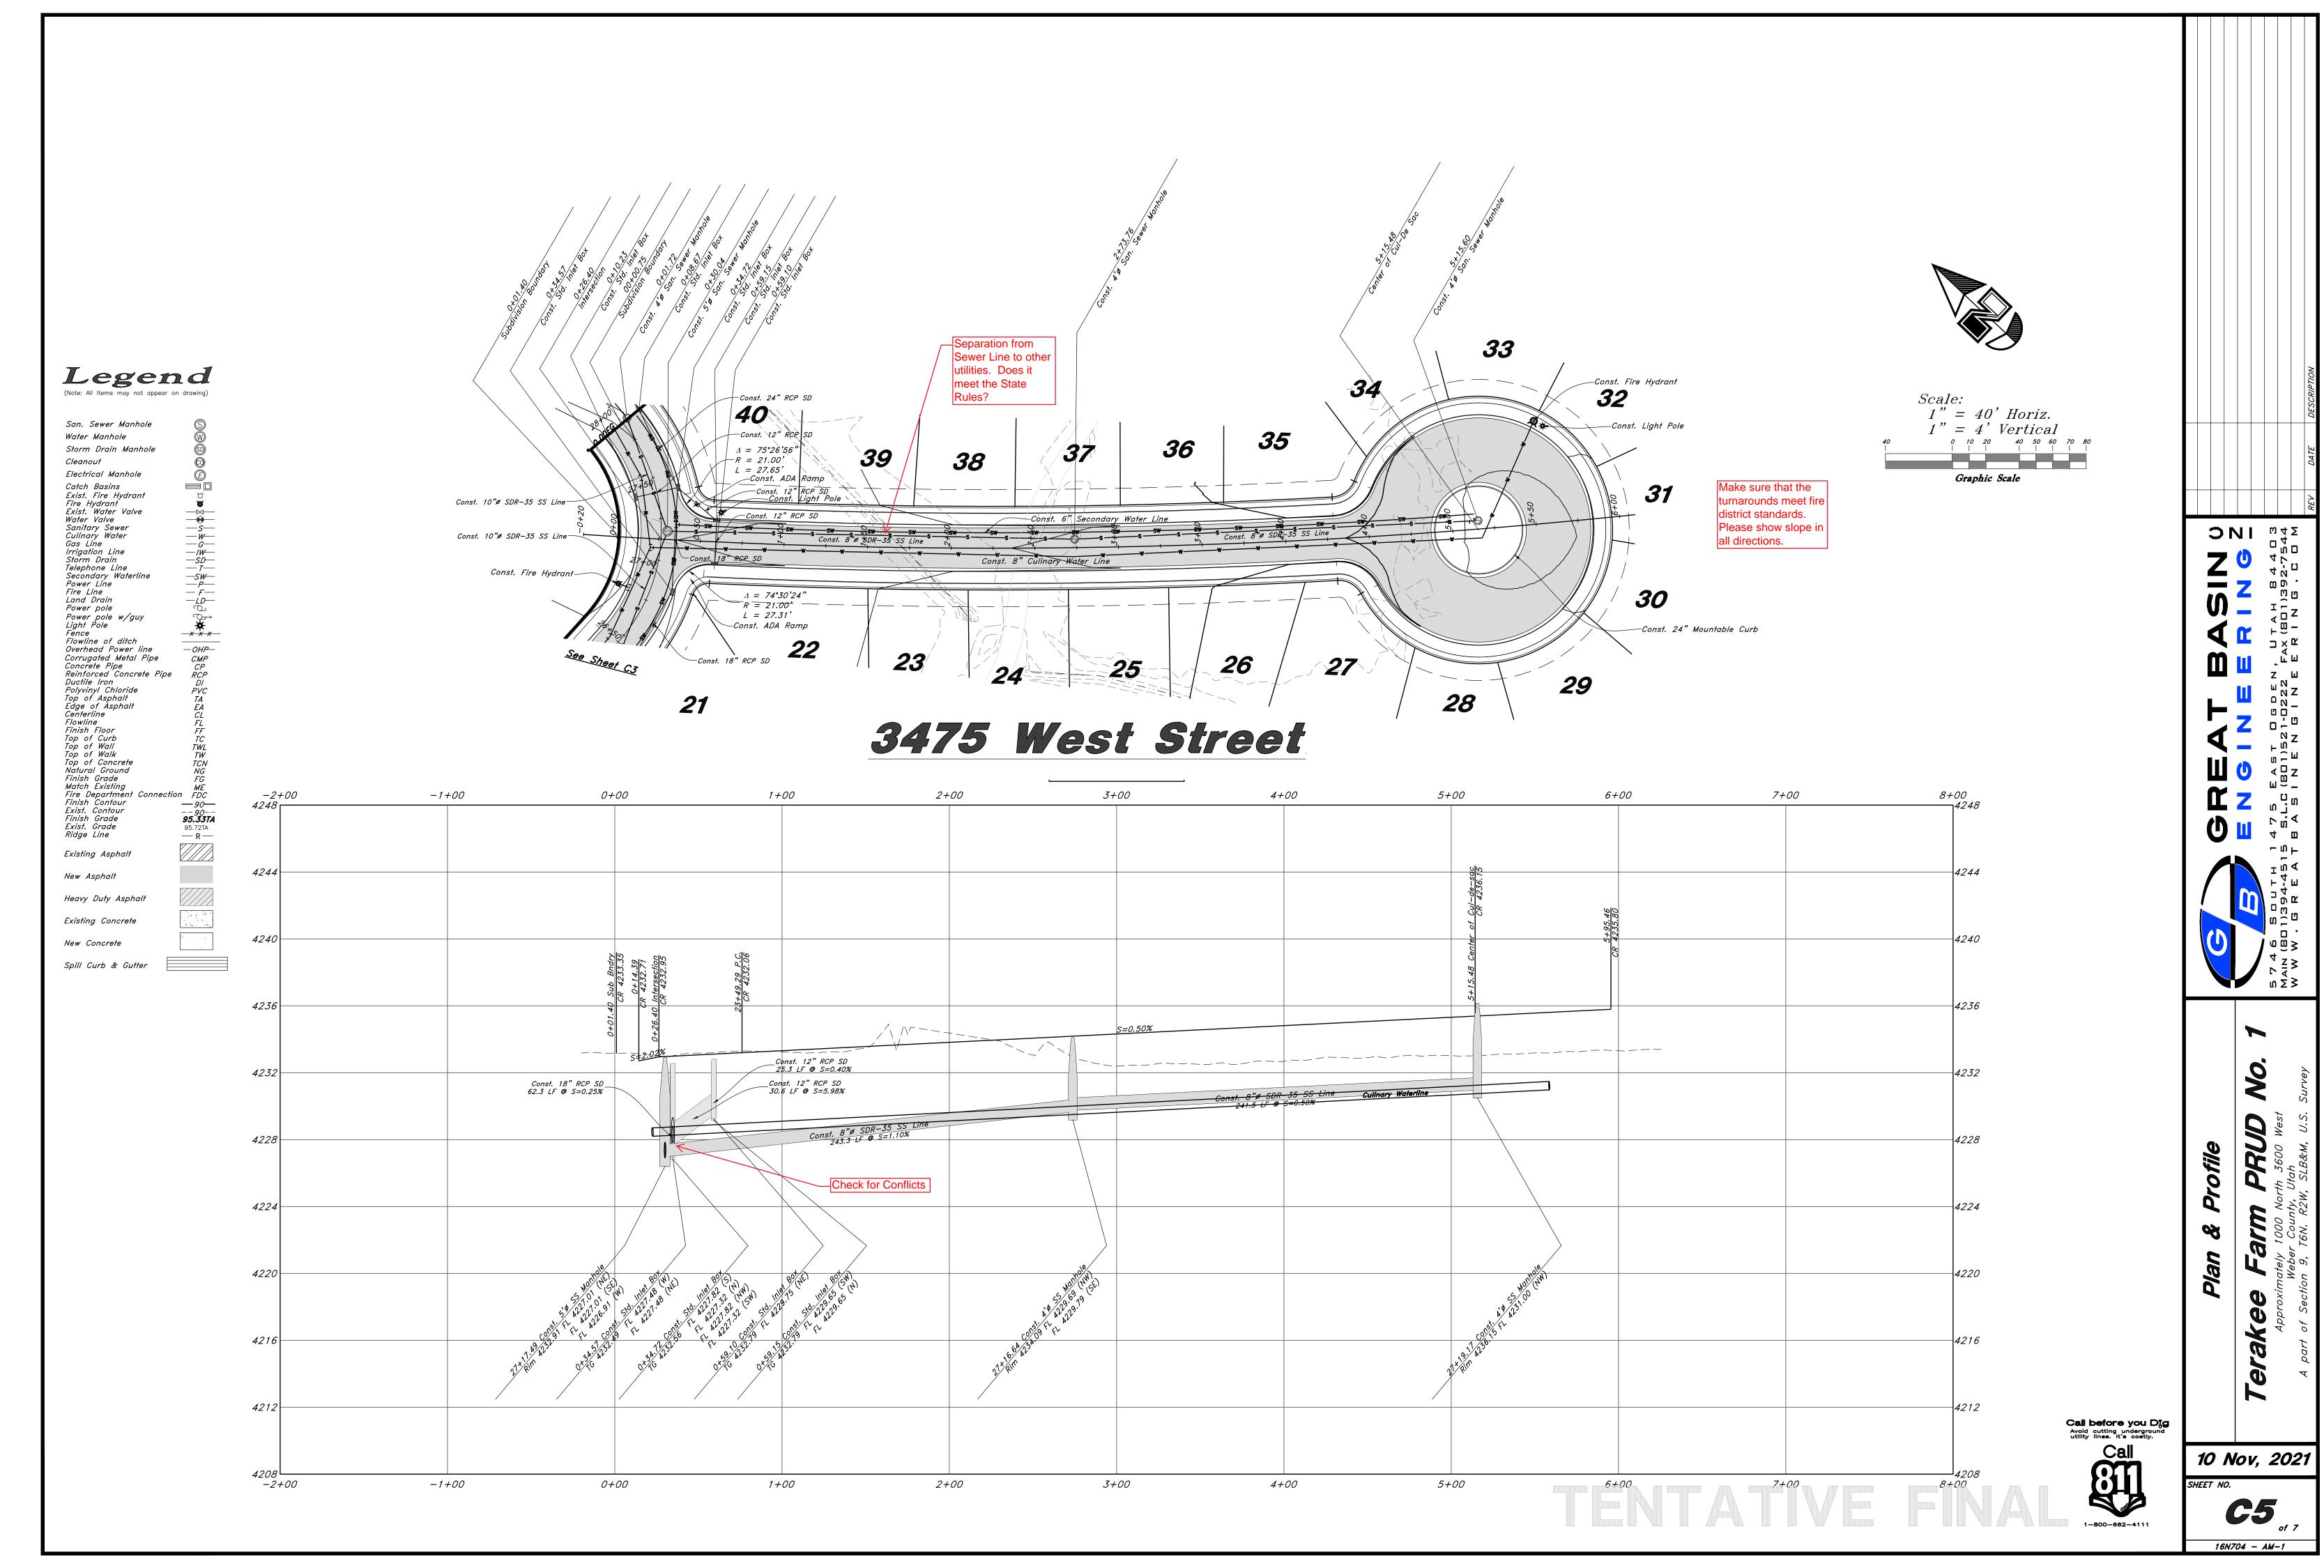

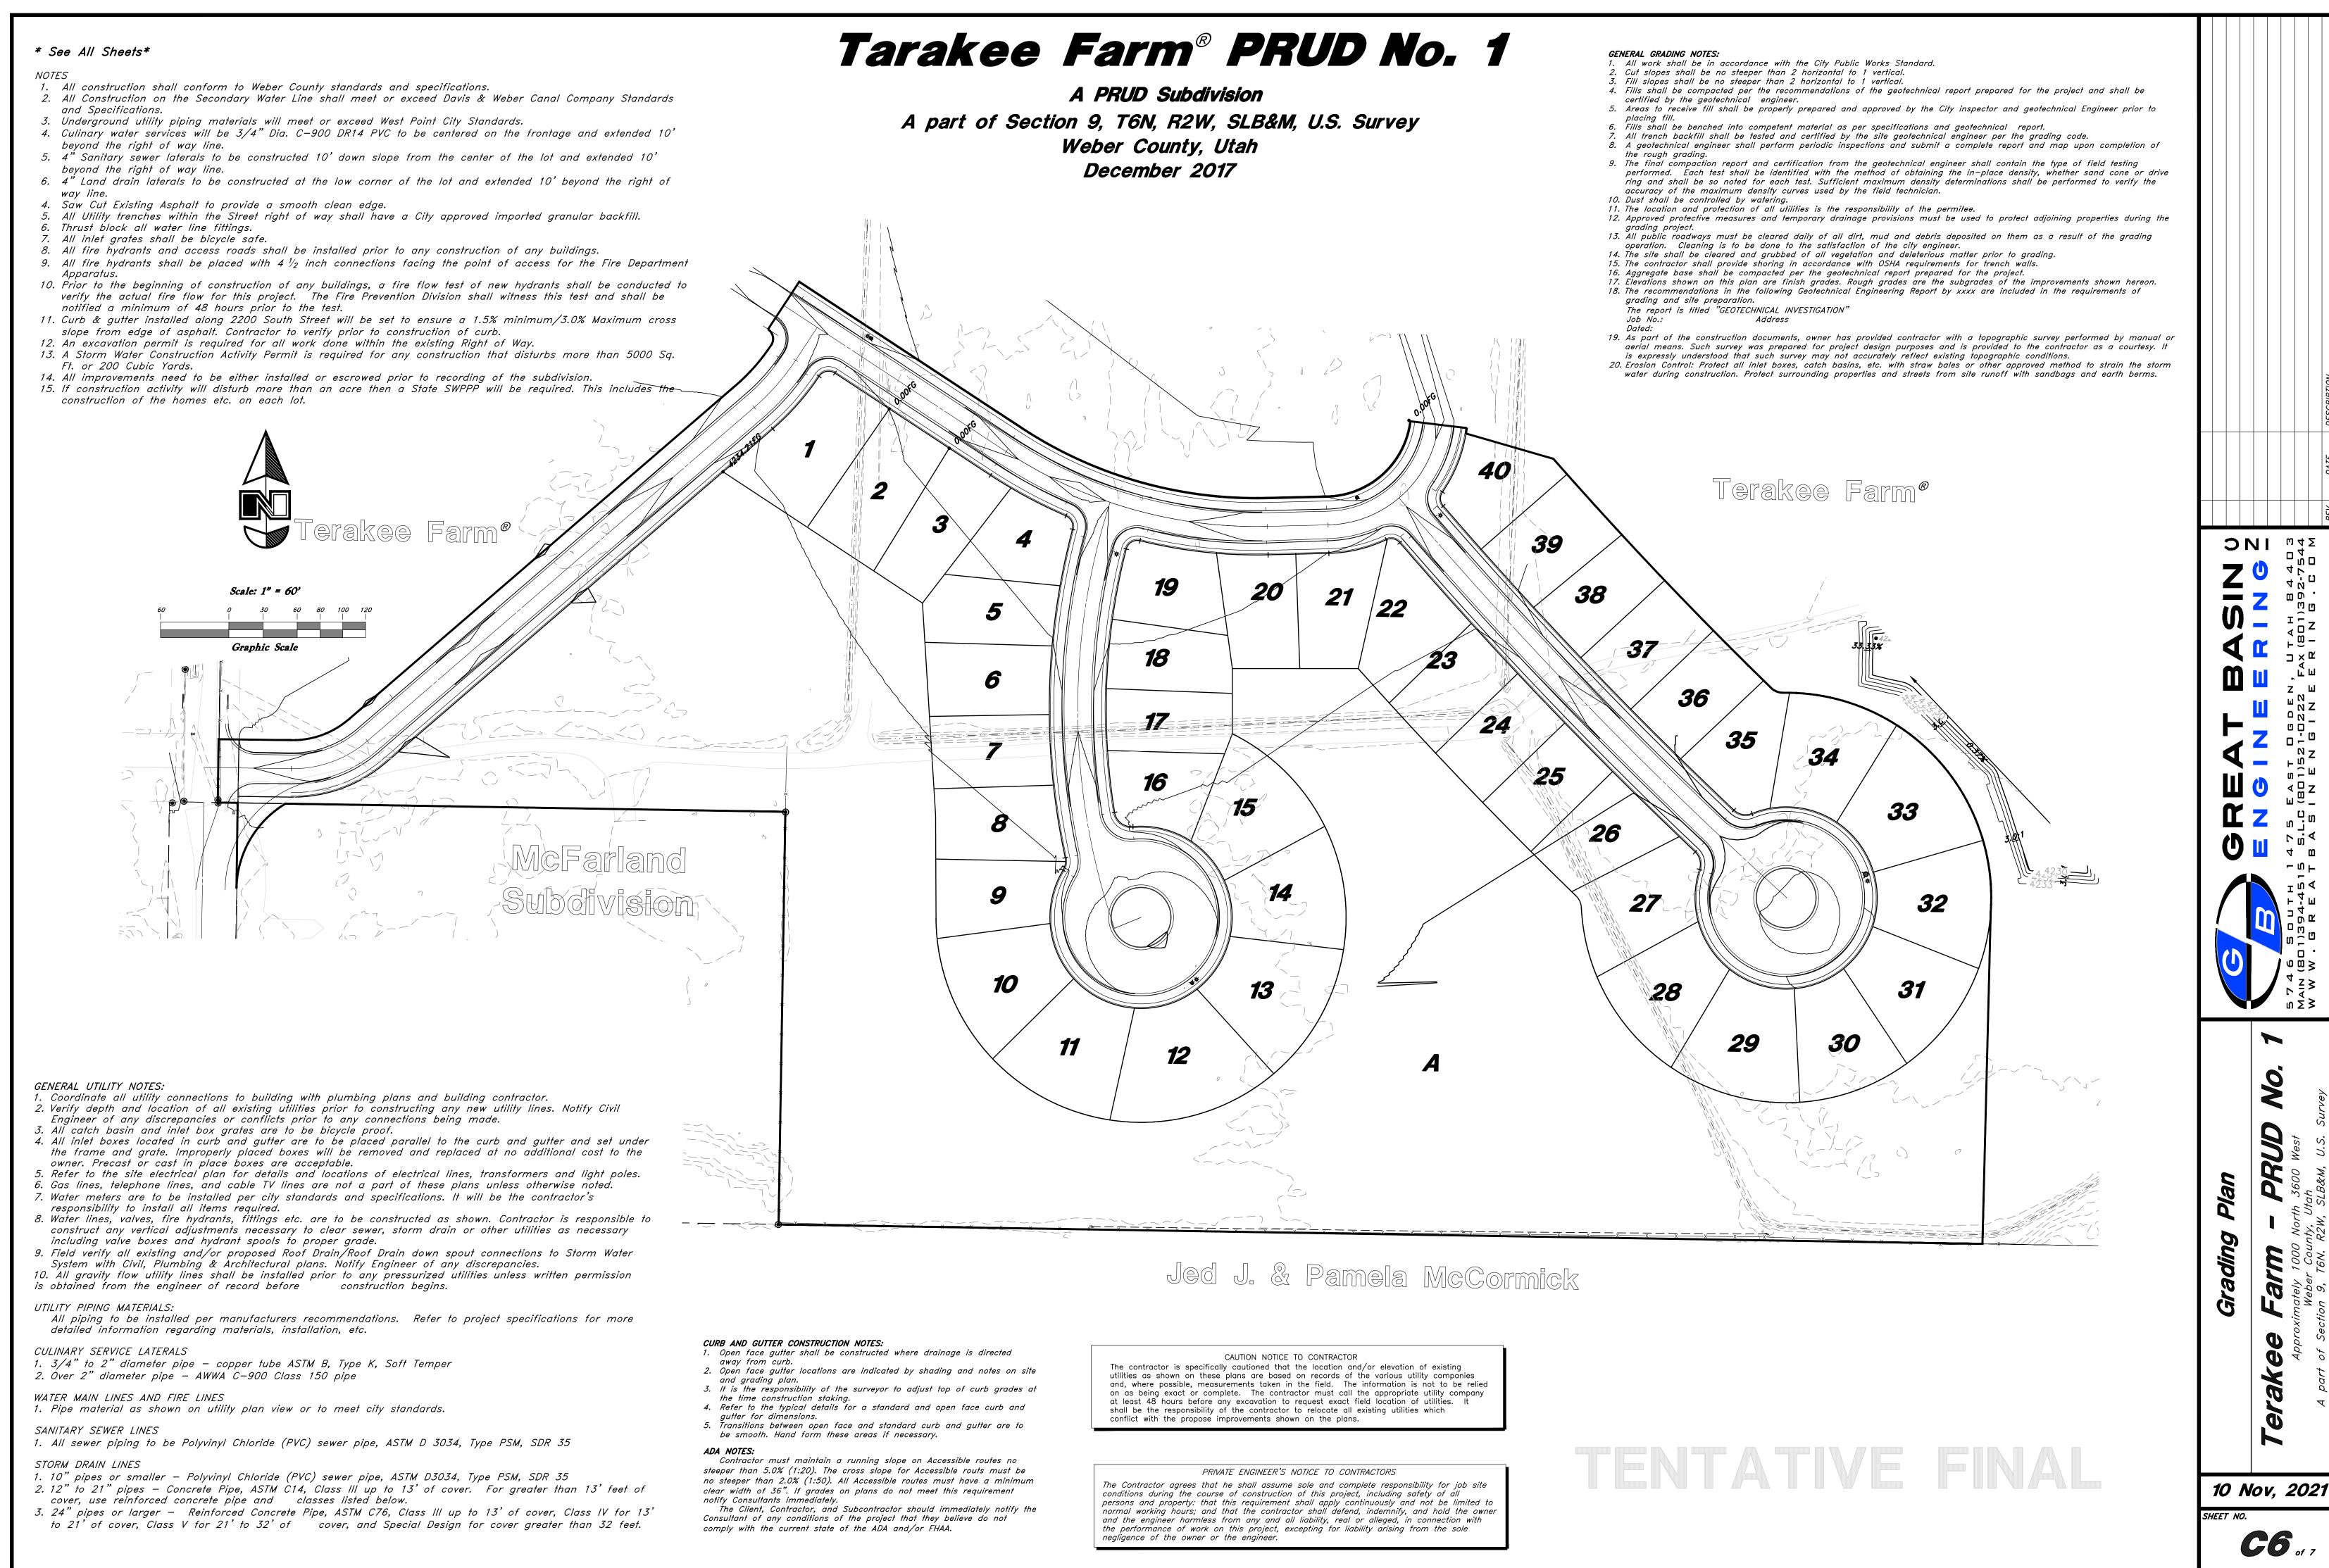

ΝΙ ω4Σ

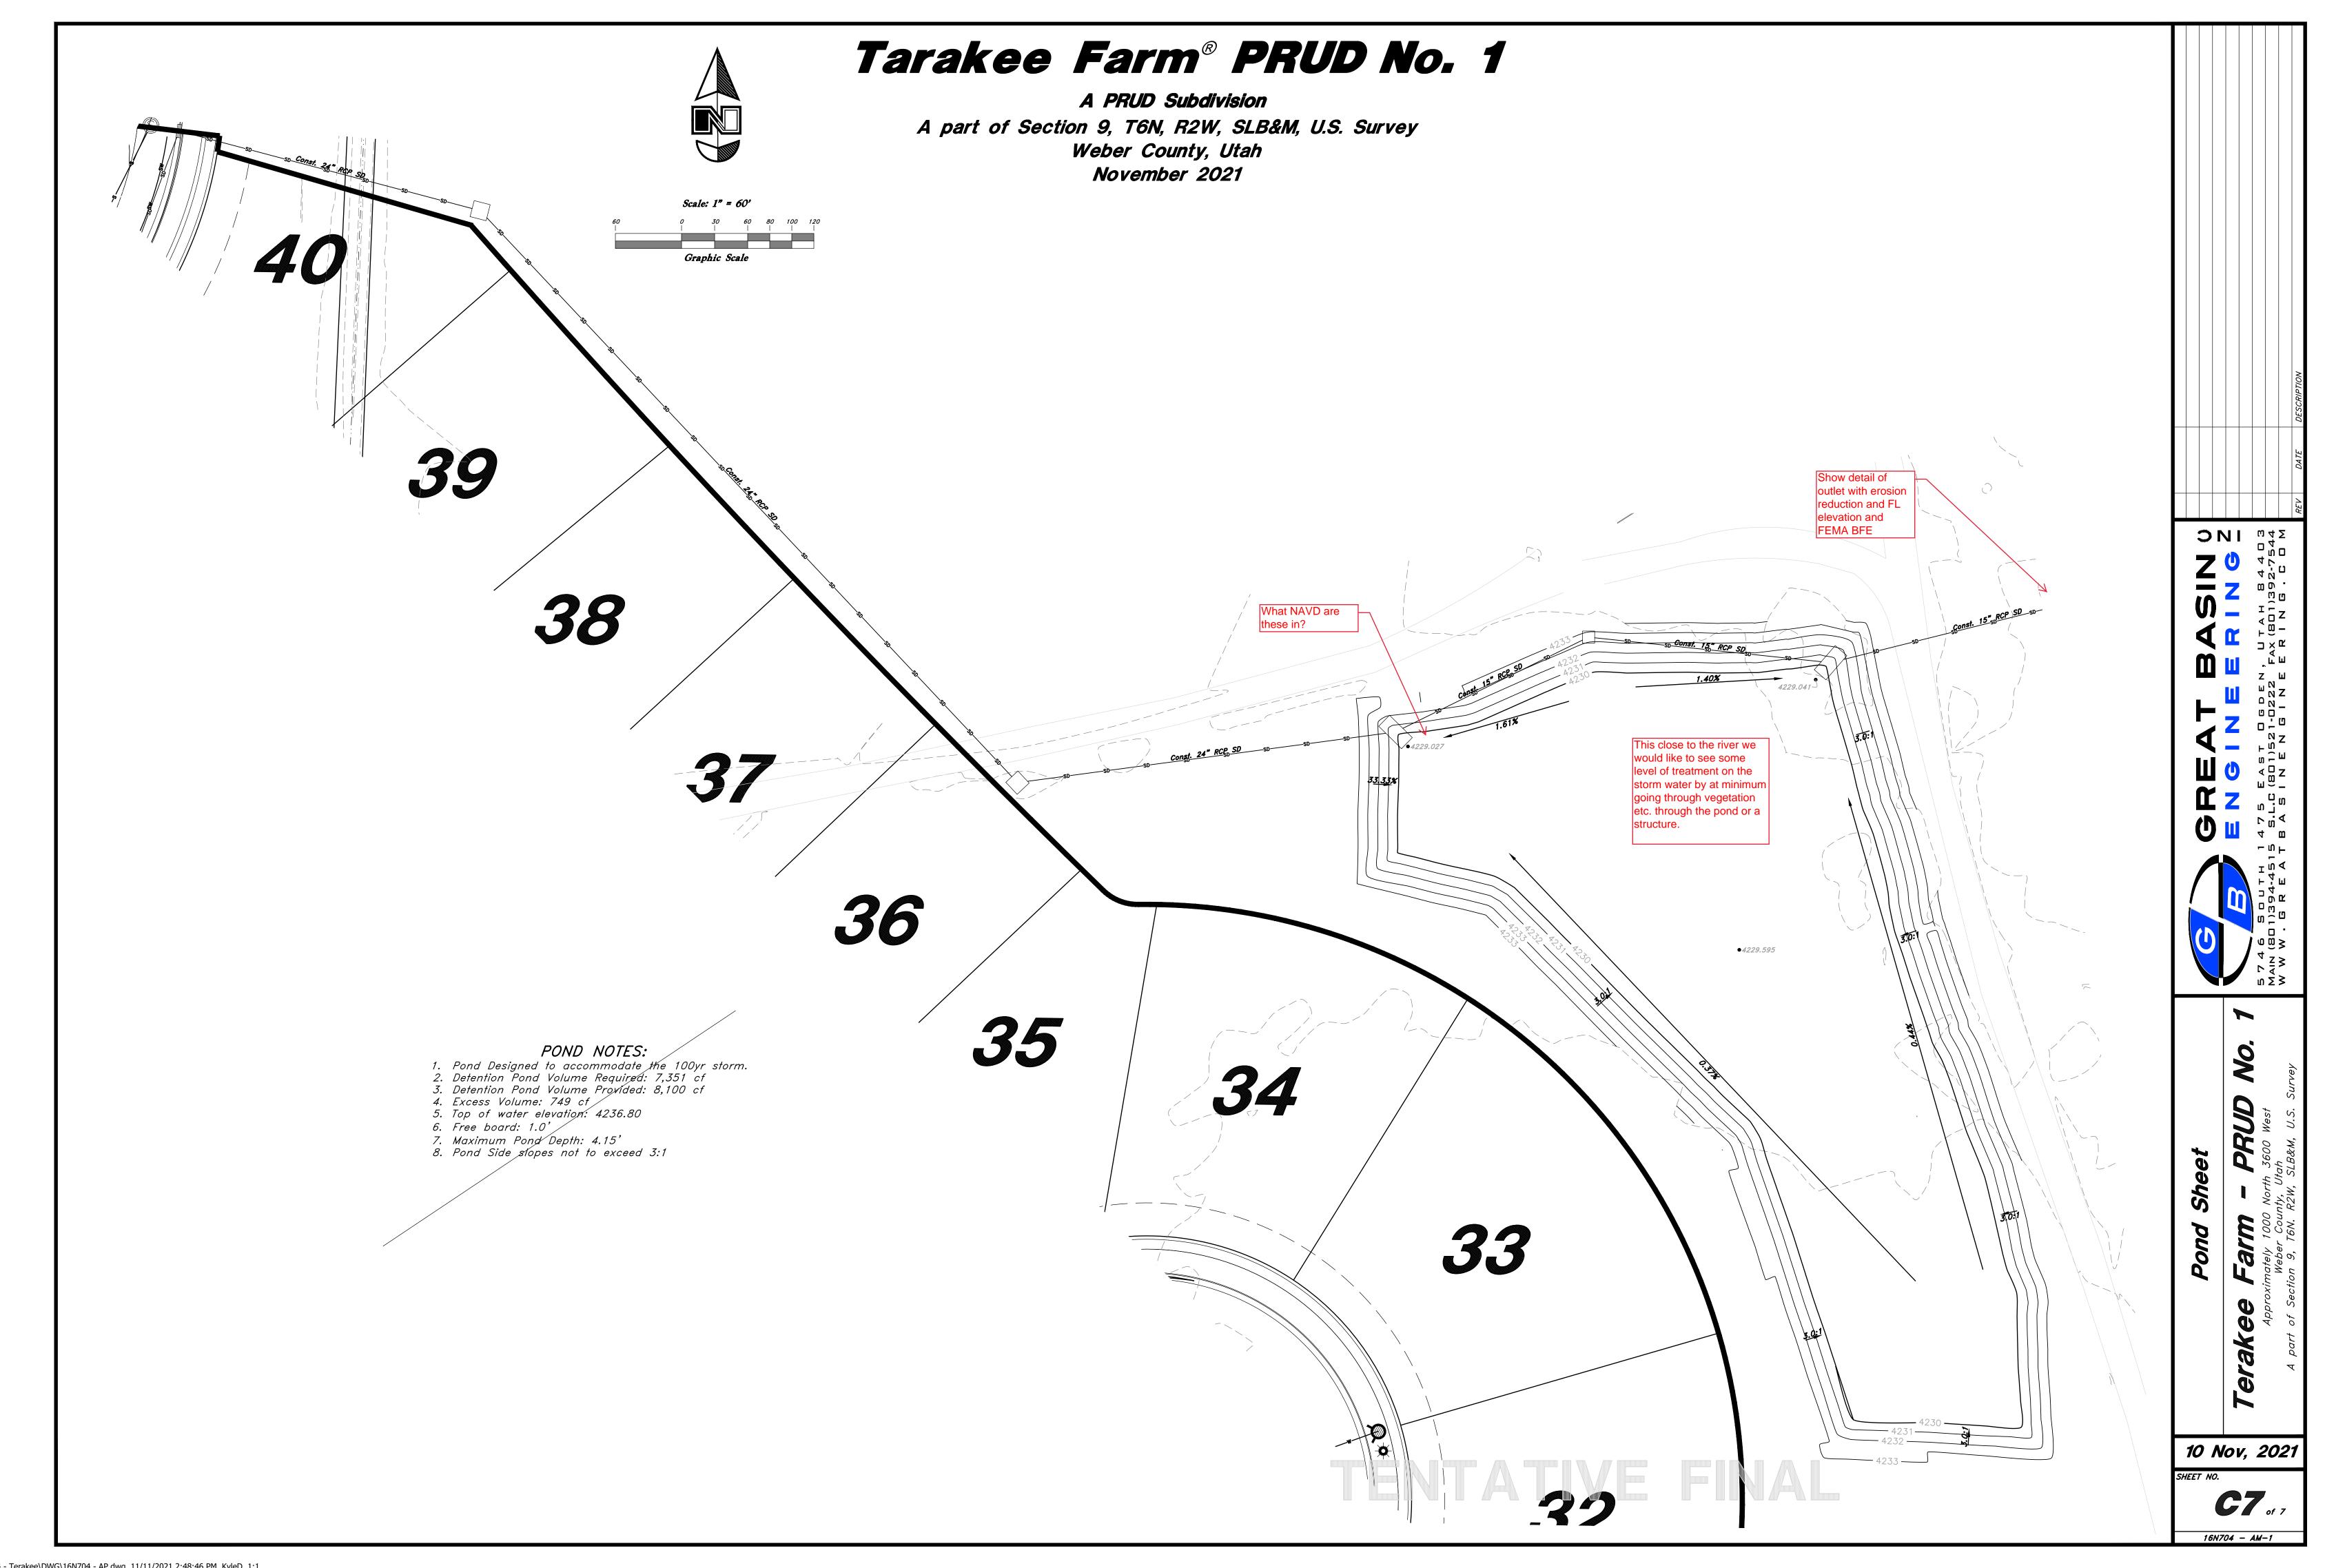

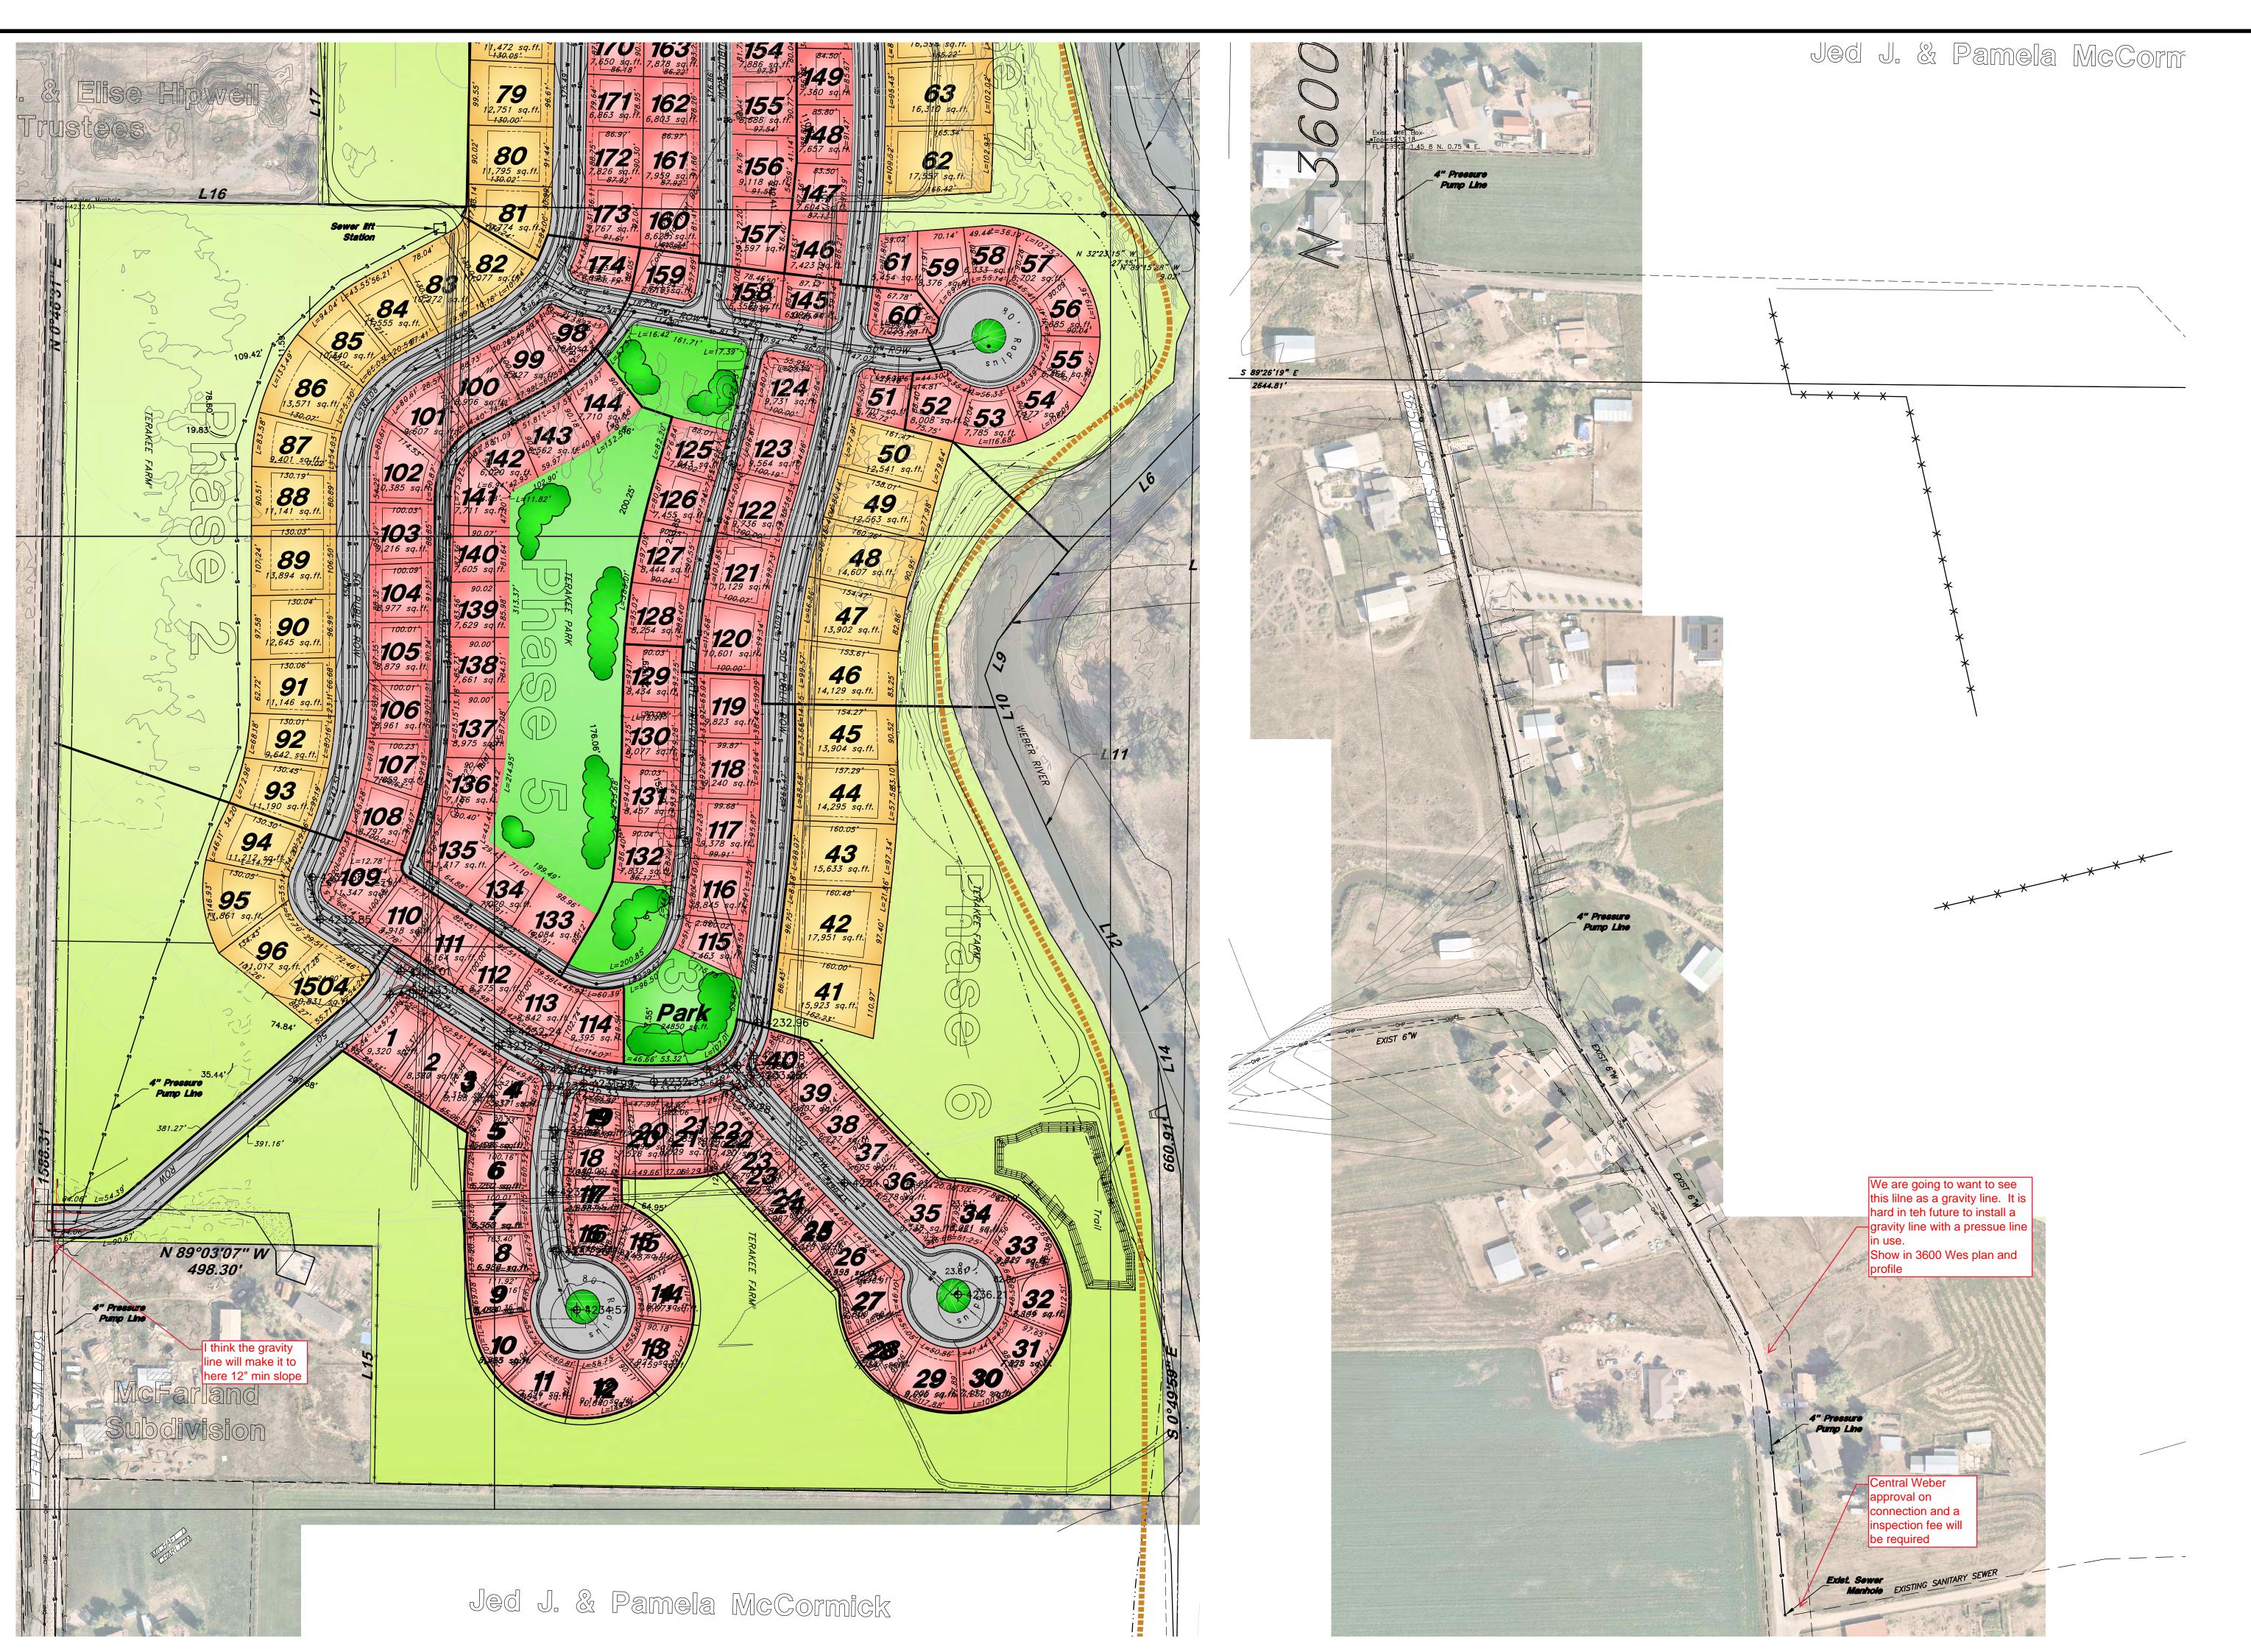

W:\16N704 - Terakee\DWG\16N704 Master Topo.dwg, 11/19/2021 5:18:08 PM, drew, 1:1

Alignment

Pressure

Sep, 2021

SHEET NO.