Washout site and staging for soil

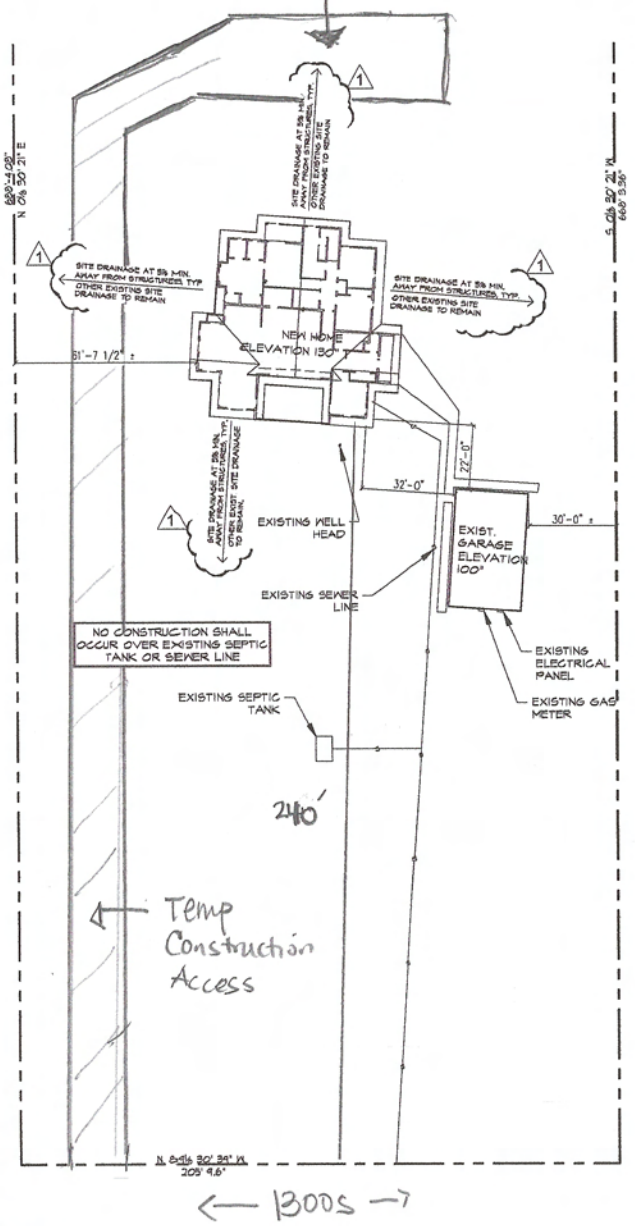

Existing Site

Site Plan

1/128" = 1'-0"

GENERAL NOTES

1. WRITTEN DIMENSIONS ALWAYS TAKE PRECEDENT OVER SCALE ON THE CONSTRUCTION DOCUMENTS. DO NOT SCALE THE DRAWINGS.

2. ALL MANUFACTURED ARTICLES, MATERIALS AND EQUIPMENT SHALL BE CONDITIONED, USED, APPLIED, INSTALLED, CONNECTED, ERECTED AND CLEANED IN ACCORDANCE WITH THE MANUFACTURER'S WRITTEN SPECIFICATIONS OR INSTRUCTIONS.

Existing Site — Not to Scale — NORTH

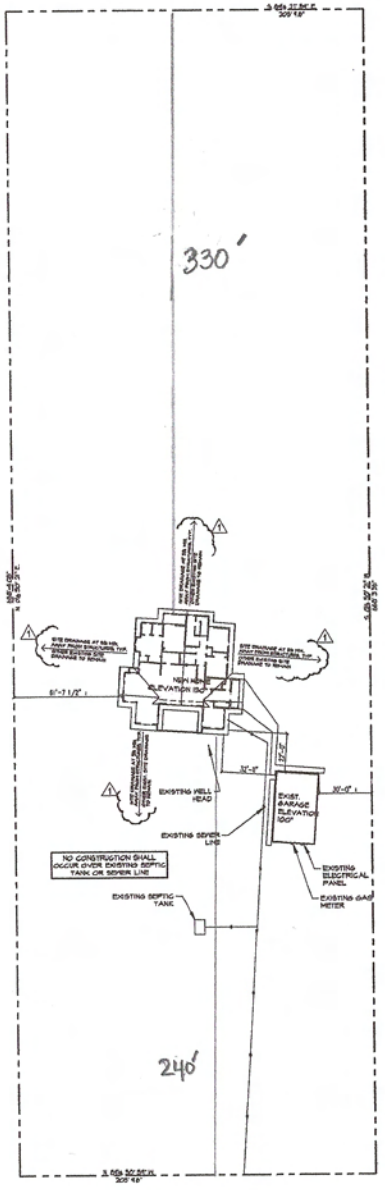

Site Plan — 1/128" = 1'-0" — NORTH

THOBE KUNKLE RES.

PARCEL #21-113-0001

9162 E 1300 S
HUNTSVILLE, UT 84317

ARCHITECTURAL SITE PLAN

PCR

REVISIONS

NO.	DESCRIPTION
1	PLAN CHECK
2	
3	
4	

DATE: OCT. 15, 2013

SHEET No: A1-0

OF x SHTS